

**Four Rivers Sanitation Authority
Rockford, Illinois**

Bidding Requirements and Contract Forms

for

2024 Service Cleanout Installations

Capital Project No. 2501

Four Rivers Sanitation Authority Rockford, Illinois

**Bidding Requirements and Contract Forms
and
General Provisions and Technical Specifications
for
Sanitary Sewer Construction**

for

2024 Service Cleanout Installations

Capital Project No. 2501

Board of Trustees

Richard Pollack	President
Ben Bernstein	Vice President
Ginger Haas	Clerk/Treasurer
Elmer Jones	Trustee
Richard Mowris	Trustee

Officials

Timothy S. Hanson	Executive Director
Christopher T. Baer, PE	Director of Engineering

Table of Contents

I. Bidding Requirements

Article 1 Notice to Bidders

Article 2 Instructions to Bidders

- 1 General
- 2 Legal Requirements
- 3 General Instructions

Article 3 Detailed Specifications

- 1 General
- 2 Permit Requirements
- 3 Notification & Access
- 4 Sanitary Sewer Service Replacement
- 5 Sanitary Sewer Service Cleanout Installation
- 6 Bedding, Backfill, & Compaction
- 7 Exploratory Excavation
- 8 Restoration Work
- 9 Safety & Traffic Control
- 10 Extra Work

II. Contract Forms

- Proposal
- Fair Employment Practices Affidavit of Compliance
- Bid Bond
- Agreement
- Labor & Material Payment Bond
- Performance Bond

III. Overall Project Location Maps & Service List

IV. Individual Location Maps

V. Standard Details & Record Drawing Information for Select Locations

VI. General Provisions and Technical Specifications for Sanitary Sewer Construction (separate document incorporated by reference)

Section I

Bidding Requirements

Not to be used for bidding purposes

Article 1 — Notice to Bidders

The Four Rivers Sanitation Authority (FRSA) will receive signed and sealed bids for the 2024 Service Cleanout Installations, Capital Project No. 2501, at the Steve Graceffa Administration Building (Administration Building) at 3501 Kishwaukee Street, Rockford, Illinois until 10:30 a.m. on Tuesday, April 16, 2024 at which time and place responsive / responsible bids will be publicly opened and read aloud.

The 2024 Service Cleanout Installations project consists of the installation of cleanout risers on existing sanitary sewer services, the replacement of existing clay sewer services with PVC pipe, the connection of PVC sewer services to sewer mains, and all other appurtenances as indicated on the plans and in the specifications.

Bidder's attention is called to Article 2 – Instructions to Bidders 3.8 requirements for Statement of Qualifications. Bidder must have a permanent business office within forty (40) miles of FRSA's office at 3501 Kishwaukee Street in Rockford, Illinois.

All demolition, construction, installation and associated Project work shall be completed by October 31, 2024. Liquidated damages shall be \$300.00 per calendar day.

Bid documents may be obtained at a cost of \$50.00 per set (non-refundable) by contacting the FRSA Engineering Department at 815-387-7660.

Plans and specifications may also be viewed at the offices of the Northern Illinois Building Contractors Association at 1111 S. Alpine Rd, Rockford, Illinois. For more information, visit the FRSA website at fourrivers.illinois.gov.


All construction shall be done in accordance with specifications on file with FRSA, including the *General Provisions and Technical Specifications for Sanitary Sewer Construction, Four Rivers Sanitation Authority* (Current Edition).

Each Proposal must be accompanied by the FRSA Bid Bond form with an acceptable Bid Security attached, in the amount of five percent (5%) of the total bid price. This amount is a guarantee that, if the Proposal is accepted, a Contract will be entered into and its performance properly secured.

The successful bidder will be required to furnish a satisfactory Performance Bond in the full amount of the Bid or Proposal. No Bid shall be withdrawn without FRSA's consent for a period of sixty (60) days after the scheduled closing time for receipt of bids.

FRSA reserves the right to reject any or all bids, or any part thereof, or to accept any bid or any part thereof, or to waive any formalities in any bids, deemed to be in the best interest of FRSA.

Dated this 21st day of March, 2024.

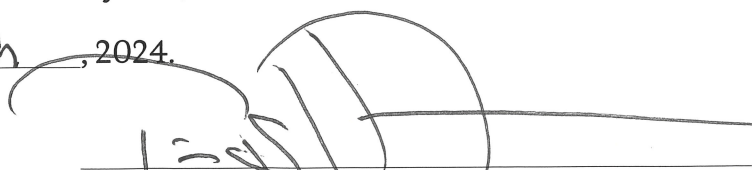
BY: Timothy S. Hanson, Executive Director

Article 2 — Instructions to Bidders

1 General

1.1 Scope and Intent

This section of the Contract Documents provides detailed information and requirements for preparing bids to prospective bidders, bidders' responsibility, the preparation and the submission of bids, basis for awarding the Contract and other general information concerned with bidding and executing the Contract.

1.2 Contradictions

If in the case of apparent contradictions between or among the Contract Documents, the Contract Documents shall be consulted in the following order: Addenda, Agreement, Supplementary Drawings, Instructions to Bidders, Detailed Specifications, Plans, General Provisions and Technical Specifications for Sanitary Sewer Construction. The language in the first such document in which language regarding the conflict, error or discrepancy occurs shall control.

2 Legal Requirements

2.1 Illinois Regulations

- A. Public Act 100-1177 (820 ILCS 130/) entitled the "Prevailing Wage Act" requires the Bidder to comply with prevailing wages in accordance with the Illinois Department of Labor Standards. The State of Illinois requires contractors and subcontractors on FRSA projects to submit certified payroll reports via the State's Certified Transcript of Payroll Portal currently found at: <https://www2.illinois.gov/idol/Laws-Rules/CONMED/Pages/certifiedtranscriptofpayroll.aspx>. The Bidder is responsible for verifying current information at the State's website.
- B. Public Act 83-1030 (30 ILCS 565/) entitled the "Steel Products Procurement Act" requires that steel products used or supplied in performance of this Contract or subcontract must be manufactured or produced in the United States with three exceptions.

The provisions of this Section shall not apply:

1. Where the Contract involves an expenditure of less than \$500.
2. Where the executive head of the public agency certifies in writing that
 - a) the specified products are not manufactured or produced in the United States in sufficient quantities to meet the agency's requirements, or
 - b) obtaining the specified products, manufactured or produced in the United States would increase the cost of the Contract by more than 10%.
3. When its application is not in the public interest.

- C. Public Act 96-929 (30 ILCS 570/) entitled the "Illinois Workers on Public Works Act" provides that Illinois residents be employed on Illinois public works projects, provided there has been a period of excessive unemployment (5%) in the State of Illinois as defined in the Act; and, further, that Illinois workers are available and capable of performing the particular type work involved.

D. Public Act 101-0221 entitled the “Workplace Transparency Act” requires that any party to a contract adopt and promulgate written sexual harassment policies that include, as a minimum, the following information:

1. the illegality of sexual harassment
2. the definition of sexual harassment under Illinois State law
3. a description of sexual harassment, utilizing examples
4. my (our) organization's internal complaint process including penalties
5. the legal recourse, investigative and complaint process available through the Illinois Department of Human Rights and the Illinois Human Rights Commission
6. directions on how to contact the Department and the Commission
7. protection against retaliation as provided by Section 6-101 of the Illinois Human Rights Act

Upon request, this information must be provided to the Illinois Department of Human Rights and the FRSA.

E. With regard to nondiscrimination in employment, the Contractor for this project will be required to comply with the Illinois Fair Employment Practices Commission's Rules and Regulations.

F. The Contractor for this project must comply with the Occupational Safety and Health Act.

G. The Contractor for this project must comply with the Federal Drug-Free Workplace Act.

H. Public Act 96-1416 requires the Certification of Clean Construction and Demolition Debris (CCDD) and uncontaminated soil prior to disposal at a CCDD fill site. The Contractor for this project must comply with Public Act 96-1416 and be responsible for the certifications and any fees associated with the disposal at a CCDD fill site.

1. In the event that contaminated soil is uncovered on the project, the Contractor must notify FRSA immediately. Any extra costs resulting from the presence of contaminated soil must be evaluated in accordance with FRSA General Provisions & Technical Specs for Sanitary Sewer Construction; General Conditions: Article 5 – Time Provisions and Article 8 – Changes.

2.2 Americans with Disabilities Act

The Contractor for this project will comply with all applicable requirements of the Americans with Disabilities Act of 1990 (ADA). The Contractor will hold harmless and indemnify Four Rivers Sanitation Authority (FRSA) and their representatives from all:

A. suits, claims, or actions

B. costs, either for defense (including but not limited to reasonable attorney's fees and expert witness fees) or for settlement

C. damages of any kind (including but not limited to actual, punitive, and compensatory damages)

relating in any way to or arising out of the ADA, to which said firm is exposed or which it incurs in the execution of the Contract.

3 General Instructions

3.1 Bidder's Responsibility

Bidders are cautioned not to submit proposals until having carefully examined the entire site of the proposed work and adjacent premises and the various means of approach and access to the site, and having made all necessary investigations to inform themselves thoroughly as to the facilities for delivering, placing and handling the materials at the site, and having informed themselves thoroughly as to all difficulties involved in the completion of all the work under this Contract in accordance with its requirements.

Bidders must examine the Plans, Specifications and other Contract Documents and shall exercise their own judgment as to the nature and amount of the whole of the work to be done and for the bid prices must assume all risk of variance, by whomsoever made, in any computation or statement of amount or quantities necessary to complete fully the work in strict compliance with the Contract Documents. The Bidder must satisfy himself by making borings or test pits, or by such methods as he may prefer, as to the character and location of the materials to be encountered or work to be performed. No pleas of ignorance of conditions that exist or that may hereafter exist, or of conditions or difficulties that may be encountered in the execution of the work under this Contract, as a result of failure to make the necessary examinations and investigations, will be accepted as an excuse for any failure or omission on the part of the Contractor to fulfill, in every detail, all of the requirements of the Contract Documents, or will be accepted as a basis for any claims whatsoever for extra compensation or for an extension of time.

The Contractor is responsible for verifying the location of all existing utilities in the project areas.

The Bidder, therefore, shall satisfy himself by such means as he may deem proper as to the location of all structures that may be encountered in construction of the work.

3.2 Addenda and Interpretations

No interpretation of the meaning of the Plans, Specifications, or other Contract Documents will be made to any bidder orally. Every request for such interpretation must be in writing addressed to Four Rivers Sanitation Authority, 3501 Kishwaukee Street, Rockford, Illinois. To be given consideration, such request must be received at least five (5) days prior to the date fixed for the opening of bids. Any and all such interpretations and any supplemental instructions will be in the form of written addenda which, if issued, will be sent by email, fax, or certified mail with acknowledgement of receipt requested, to all prospective bidders, at the respective addresses furnished for such purposes, not later than three (3) days prior to the date fixed for the opening of bids. Failure of any bidder to receive any such addenda or interpretation shall not relieve said bidder from any obligation under his bid as submitted. All addenda so issued shall become part of the Contract Documents.

3.3 Laws and Regulations

The prospective bidder is warned that he must comply with all laws of the United States Government, State of Illinois, all ordinances and regulations of FRSA in the performance of the work under this Contract. The Bidder's attention is specifically called to that provision of the General Conditions regarding the rate of wage to be paid on the work.

3.4 Quantities Estimated Only

Bidders are warned that the estimate of quantities of the various items of work and materials, as set forth in the Proposal form, is approximate only and is given solely to be used as a uniform basis for

the comparison of bids. The quantities actually required to complete the Contract work may be less or more than so estimated, and if awarded a contract for the work specified, the Contractor further agrees that he will not make any claim for damages or for loss of profits or for an extension of time because of a difference between the quantities of the various classes of work assumed for comparison of bids and quantities of work actually performed.

3.5 Form, Preparation, and Presentation of Proposals

For particulars as to the quantity and quality of the supplies, materials and equipment to be furnished, and the nature and extent of the work or labor to be done, prospective bidders are referred to the Contract Documents, which may be examined or obtained at the office of FRSA.

Each bid will be submitted upon the prescribed Proposal form. All blank spaces for bid prices must be filled in, in ink, with the unit or total sum or both for which the Proposal is made. If the Proposal contains any omissions, erasures, alterations, additions or items not called for in the itemized Proposal, or contains irregularities of any kind, such may constitute sufficient cause for rejection of bid. In case of any discrepancy in the unit price or amount bid for any item in the Proposal, the unit price as expressed in figures will govern. In no case is the agreement form to be filled out or signed by the bidder.

Bidders may opt to contact FRSA's Engineering Department at 815.387.7660 to obtain an electronic Proposal form. If used, this form must be attached to the hard copy Proposal form and appropriately signed and executed with the bid.

The bid must be verified and be presented on the prescribed form in a sealed envelope on or before the time and at the place stated in the Advertisement for Bids, endorsed with the name of the person, firm or corporation presenting it, the date of presentation, and the title of the work for which the bid is made. If forwarded by mail, the sealed envelope containing the Proposal and marked as directed above, must be enclosed in another envelope addressed to Clerk of the Four Rivers Sanitation Authority, 3501 Kishwaukee Street, Rockford, Illinois, 61109 and be sent preferably by certified mail. FRSA will not accept facsimile generated bids.

3.6 Bid Security

Each Proposal must be accompanied by the FRSA Bid Bond form with an acceptable Bid Security attached, in the amount specified in Article One, Notice to Bidders. This sum is a guarantee that, if the Proposal is accepted, a contract will be entered into and its performance properly secured. The FRSA's Bid Bond Form included in the bid packet must be used. No other Bid Bond form may be substituted.

Within ten (10) days after the opening of bids, the deposits of all but the three lowest bidders will be returned. The deposits of the remaining two unsuccessful bidders will be returned within three (3) days after the execution of the Contract, or, if no such Contract has been executed, within sixty (60) days after the date of opening bids. The deposit of the successful bidder will be returned only after he has duly executed the Contract and furnished the required bond and insurance.

3.7 Affidavit of Compliance

Each proposal must be accompanied by an executed Affidavit of Compliance. A separate Affidavit of Compliance form is enclosed with the Proposal packet. Failure to submit an executed Affidavit of Compliance with the Proposal may constitute sufficient cause for rejection of the bid.

3.8 Statement of Qualifications

Each Proposal must be accompanied by a Statement of Qualifications certifying that the bidder is registered to do business in the State of Illinois, has a permanent business office within forty (40) miles of the FRSA office at 3501 Kishwaukee Street in Rockford, IL, and provides documentation that the bidder possesses the appropriate financial, material, equipment, facility and personnel resources and expertise necessary to meet all contractual obligations. The bidder shall document no less than three (3) contracts for sanitary sewer system work within the past five (5) years having equal or greater value to the bid being submitted. FRSA reserves the right to request additional information, as needed, to evaluate bids prior to making an award.

3.9 Comparison of Proposals

Bids on item contracts will be compared on the basis of a total computed price arrived at by taking the sum of the estimated quantities of each item, multiplied by the corresponding unit prices and including any lump sum bids on individual items, in accordance with the estimate of quantities set forth in the Proposal form. Bids on lump sum contracts will be considered upon the basis of the lowest sum bid.

3.10 Acceptance of Bids and Basis of Award

The contract will be award, if at all, to the lowest responsive, responsible bidder. No bidder may withdraw his bid after the scheduled closing time for receipt of bids, for at least sixty (60) days. Four Rivers Sanitation Authority also reserves the right to reject any of all bids.

The bidder whose proposal is accepted will be notified of the Notice of Award issued by FRSA Executive Director. Within ten (10) days of issuance of a Notice of Award by the FRSA Executive Director, the successful bidder shall enter into a written contract for the performance of the Proposal work and shall furnish the required bonds and insurance certificates upon being served such Notice, personally, by mailing, or via email.

If the bidder does not comply with the Notice of Award, FRSA will issue a Deficiency Notice. If the bidder to whom the contract is awarded refuses or neglects to execute it or fails to furnish the required bond and insurance within five (5) days after receipt by him of Deficiency Notice, the amount of his deposit shall be forfeited and shall be retained by FRSA as liquidated damage and not as a penalty. It being now agreed that said sum is a fair estimate of the amount of damages that FRSA will sustain in case said bidder fails to enter into a contract and furnish the required bond and insurance. No plea of mistake in the bid shall be available to the bidder for the recovery of his deposit or as a defense to any action based upon the neglect or refusal to execute a contract.

3.10.1 Evaluation of Responsiveness

The responsiveness of bidders will be judged on the basis of the completeness of the bid submitted. To be responsive, a Bid must be submitted on the forms provided as part of the Bid Documents and comply with all the requirements of the Instruction to Bidders.

3.10.2 Evaluation of Responsibility

To be judged as responsible, the bidder shall:

- A. Have adequate financial resources for performance, the necessary experience, organization, technical qualifications, and facilities, or a firm commitment to obtain such by subcontracts;
- B. Be able to comply with the required completion schedule for the project;

- C. Have a satisfactory record of integrity, judgment, and performance, including, in particular, any prior performance on contracts from FRSA;
- D. Have an adequate financial management system and audit procedures, that provide efficient and effective accountability and control of all property, funds, and assets;
- E. Conform to the civil rights, equal employment opportunity and labor law requirements of the Bid Documents.
- F. Have satisfactorily completed no less than three (3) sanitary sewer system repair contracts within the past five (5) years of equal or greater value to the bid being submitted.

3.11 The Rejection of Bids

FRSA reserves the right to reject any bid if the evidence submitted in the statement of the bidder's qualifications, or if investigation of such bidder fails to satisfy FRSA that such bidder is properly qualified to carry out the obligations and to complete the work contemplated therein. Any or all proposals will be rejected if there is reason to believe that collusion exists among the bidders. Conditional bids will not be accepted. FRSA reserves the right to reject any and all bids and to accept the bid which they deem most favorable to the interest of FRSA after all Proposals have been examined and canvassed.

3.12 Insurance and Bonding

Contractor shall provide all necessary insurance and bonds required to complete the project. No more than ten (10) calendar days subsequent to FRSA's issuance of an award letter, the Contractor shall provide documentation to prove that he has obtained all required insurance and bonds. FRSA shall be the sole judge as to the acceptability of any such proof.

Contractor shall provide and maintain all insurance and bonds as required by FRSA.

3.12.1 General

The Contractor shall ensure that:

- A. All insurance policies shall be specific to the project.
- B. The insurance certificate shall state: This certifies that the insurance coverage meets or exceeds that required for 2024 Service Cleanout Installations, Capital Project No. 2501.
- C. FRSA shall be named as Additional Insured in all policies; this shall include the Owners' Contractors' Protective Policy option.
- D. All completed operations coverages and bonds shall remain in force for a period of two (2) years following acceptance of the Project and completed operations shall stay in force for two (2) years following completion of the Project.

3.12.2 Insurance

The Contractor shall, for the duration of the Contract and for two (2) years following project acceptance, maintain the following:

- A. **General Liability:** \$1,000,000 combined single limit per occurrence for bodily injury, personal injury and property damage. If Commercial General Liability Insurance or other form with a general aggregate limit is used, either the general aggregate limit shall apply separately to this project or the general aggregate limit shall be twice the required occurrence limit. The Contractor shall provide "XCU" coverage.

- B. Automobile Liability: \$1,000,000 combined single limit per accident for bodily injury and property damage including coverages for owned, hired or non—owned vehicles, as applicable.
- C. Workers' Compensation and Employers Liability: Workers' Compensation limits as required by statute and Employers Liability limits of \$500,000 per accident and \$500,000 per disease.
- D. Umbrella: \$2,000,000 per occurrence/aggregate for contracts valued at \$500,000 or over, or \$1,000,000 for contracts below \$500,000. \$10,000 is maximum allowable self-retained limit.
- E. Errors and Omissions: If the Contractor performs professional services, he shall maintain errors and omissions insurance with a limit no lower than \$1,000,000 for the duration of the contract.

The policies shall contain, or be endorsed to contain, the following provisions in the General Liability and Automobile Liability Coverage's:

1. Unless otherwise provided in paragraph "c" of this section, FRSA, its officers, officials, employees and volunteers shall be covered as additional insureds as respects liability arising out of activities performed by or on insured's general supervision of the Contractor, products and completed operations of the Contractor, premises owned, occupied or used by the Contractor, or automobiles owned, leased, hired or borrowed by the Contractor. The coverage shall contain no special limitations on the scope of protection afforded to FRSA, its officers, officials, employees, volunteers, or agents.
2. Unless otherwise provided in paragraph "c" of this section, the Contractor's insurance coverage shall be primary insurance as respects FRSA, its officers, officials, employees, volunteers, and agents. Any insurance or self-insurance maintained by FRSA, its officers, officials, employees, volunteers, or agents shall be excess of the Contractor's insurance and shall not contribute with it.
3. As an acceptable alternative to provisions "a" and "b" of this section, the Contractor may provide owner's and contractor's protective liability insurance with coverage limits, named insureds, and in conformity with all applicable specifications of this section.
4. Any failure to comply with reporting provisions of the policies shall not affect coverage provided to FRSA, its officers, officials, employees, volunteers, or agents.
5. The Contractor's insurance shall apply separately to each insured against whom claim is made or suit is brought, except with respect to the limits of the insurer's liability.
6. All Coverages — Each insurance policy required by this clause shall not be suspended, voided, canceled by either party, reduced in coverage, or in limits except after thirty (30) days' prior written notice by certified mail, return receipt requested, has been given to FRSA.

3.12.3 Best's Ratings

FRSA shall be the sole judge of whether or not said insurer's ratios are satisfactory. FRSA's decision shall be final and FRSA's bidding procedures contain no appeal provision.

- A. Alphabetical Rating: For purposes of this Request for Bids, "insurer" shall mean any surety, insurance carrier, or other organization which proposes to provide an insurance policy or bond for the Contractor. No insurer or surety rated lower than "A-, Excellent" in the current *Best's Key Rating Guide* shall be acceptable to FRSA.
- B. Financial Size Rating: Provided an insurer's alphabetical rating is satisfactory, FRSA will examine said insurer's financial size rating.

1. If Best classifies the insurer XII or larger, said insurer shall be acceptable to FRSA.
2. If Best classifies the insurer as smaller than XII, but larger than VI, said insurer shall be submitted to FRSA's Director of Management Services and/or FRSA's insurance consultant for review.

Financial Size ratings less than VII are not acceptable and will disqualify the Contractor.

3.12.4 Performance Bond and Labor & Materials Payment Bond Form

The Contractor shall provide a Performance Bond and Labor & Materials Payment Bond form acceptable to FRSA. The performance bond shall be for either 100% of the contract price or for the Contractor's unit price times the estimated number of units, as applicable.

This Request for Bids contains a Performance Bond and a Labor & Material Bond form for the Contractor's use.

If the Contractor fails to provide acceptable bonds within the specified time, he shall be in default.

3.12.5 Correction of Contractor's Insurance or Bond Deficiencies

If FRSA determines that the Contractor's insurance or bond documentation does not conform to these specifications, FRSA shall inform said Contractor of the non-conformity. If said Contractor fails to provide conforming insurance or bond documentation within five (5) calendar days of FRSA's deficiency notice, he shall be in default.

3.12.6 Indemnification Clause

Contractor shall protect, indemnify, hold and save harmless and defend FRSA, its officers, officials, employees, volunteers, and agents against any and all claims, costs, causes, actions and expenses, including but not limited to attorney's fees incurred by reason of a lawsuit or claim for compensation arising in favor of any person, including the employees, officers, independent contractors, or subcontractors of the Contractor or FRSA, on account of personal injuries or death, or damages to property occurring, growing out of, incident to, or resulting directly or indirectly from the performance by the Contractor or subcontractor, whether such loss, damage, injury or liability is contributed to by the negligence of FRSA or by premises themselves or any equipment thereon whether latent or patent, or from other causes whatsoever, except that the successful bidder shall have no liability for damages or the costs incident thereto caused by the sole negligence of FRSA.

The indemnification shall not be limited by a limitation on amount or type of damages payable by or for the Contractor or its subcontractor under any employee benefits act including, but not limited, to the Workers Compensation Act.

No inspection by FRSA, its employees, or agents shall be deemed a waiver by FRSA of full compliance with the requirements of the Contract. This indemnification shall not be limited by the required minimum insurance coverages in the Contract.

3.13 Tax Exemption

FRSA is exempt, by law, from paying bidder Federal Excise Tax and Illinois Retailers' Occupational Tax. Therefore, the bidder shall exclude those taxes from his bid. FRSA's tax exemption number is E9992-3696-06. The bidder shall include all other applicable taxes in his bid price.

Article 3 — Detailed Specifications

1 General

This article contains detailed specifications related to Proposal items. The work to be done under each item is discussed along with units for payment and measurement for payment. However, the descriptions given do not necessarily outline all the work to be done under any item. All work shall conform to current editions of the following: *Standard Specifications for Water and Sewer Main Construction in Illinois, Four Rivers Sanitation Authority (FRSA) General Provisions and Technical Specifications for Sanitary Sewer Construction*, and the *Illinois Department of Transportation's (IDOT's) Standard Specifications for Road and Bridge Construction*.

Throughout these specifications, the term "Owner" and "FRSA" shall be synonymous.

In case of apparent contradictions between *Article 3 - Detailed Specifications*, *IDOT Standard Specifications*, and *General Provisions and Technical Specifications for Sanitary Sewer Construction*, *Article 3 - Detailed Specifications* shall govern.

Utility locations shown on the plans are based on records of varying degrees of reliability and are not guaranteed. The orientation and location (horizontal and vertical) of all existing underground utilities, such as gas mains, water mains, electric lines, field tiles, irrigation pipes, etc., shall be ascertained by the Contractor. The Contractor shall assume full responsibility for all utility location.

The general location of the proposed work is governed by existing field conditions. Minor variations in alignment may be made to facilitate construction operations with prior FRSA approval.

Any construction not supervised by a FRSA Inspector will not be accepted.

No work shall be permitted on Sundays or FRSA Holidays without prior approval by the FRSA Director of Engineering.

The FRSA will not supervise, direct, control, have authority over or be responsible for the Contractor's means, methods, techniques, sequences, procedures of construction, safety precautions and programs incident thereto, or for any failure by the Contractor to comply with all applicable laws and regulations in performance of the specified work. The FRSA shall not be responsible for the Contractor's failure to perform or furnish the work in accordance with the Contract documents.

2 Permit Requirements

2.1 General

All work within public Right-of-Ways shall be subject to the regulations and requirements of the jurisdictional agencies. Should conflicts or contradictions arise between the plans, specifications and Right-of-Way permits, the permits shall govern.

The Contractor shall comply with the requirements of any and all permits obtained and required for the construction of this project, including but not limited to, those from all jurisdictional

roadway authorities. The following agency contacts are provided for the roadways impacted by this project:

Roadway Authority	Contact	Phone	Email
City of Rockford	Jordan Masemoore	(779) 348-7634	Jordan.masemoore@rockfordil.gov
Machesney Park	Mitch Hilden	(815) 877-5432	mitchh@machesneypark.org

Unless otherwise noted, the Contractor shall be responsible for securing all necessary permits and for all bonds, insurance, etc., and all fees required by any and all permits. Copies of all Contractor-secured permits shall be provided to the FRSA prior to the start of construction.

Prior to tree trimming or removal within City of Rockford Right-of-Ways, the Contractor shall submit a Tree Maintenance Permit to the City of Rockford Forestry Supervisor at 523 S. Central Ave., Rockford, IL 61102. All tree removal and/or trimming shall be in accordance with the City of Rockford Forestry Division's requirements. Contact Taylor Hennelly of the Forestry Division, forty-eight (48) hours prior to performing tree removal or trimming operations at taylor.hennelly@rockfordil.gov.

No trees located on private property shall be disturbed in the construction of this project without written permission from the property owner.

2.2 Required Submittals

1. Copies of issued permits.

2.3 Payment

Payment for permit requirements (procurement and compliance) shall be included in the Contract Lump Sum (LS) unit price per street address for the various sanitary sewer service repairs.

3 Notification & Access

3.1 Notification

The Contractor shall notify all utility companies prior to beginning any work. All underground utilities shall be located by the utility owner and special care shall be taken when excavating near underground utilities to avoid damage. Contractor shall call JULIE at (800) 892-0123 for utility locations in the project area, forty-eight (48) hours, minimum, prior to construction. More advanced notification shall be provided if required by permits.

The Contractor shall make every effort to maintain the current level of sanitary sewer service for the duration of the project. Property owners shall not be without sewer service for more than eight (8) hours. A public notification program shall be implemented and, shall as a minimum, require the Contractor to be responsible for contacting each home or business affected and informing them of the work to be conducted and when the sewer will be out of service. Adjustment to the construction schedule shall be made, as necessary, to accommodate property owners.

The Contractor shall also provide the following:

- (a) A minimum of forty-eight (48) hours advanced written notice, or door hanger, to be delivered to each home or business describing the work, the work schedule, how it affects them, and a toll free or local telephone number of the Contractor they can call to

discuss the project and any concerns. Written notice shall also include contact information for the FRSA's Surveyor and Field Operations Manager, Ben Christiansen, (815) 209-7952, bchristiansen@fourrivers.illinois.gov. Contractor shall submit a draft of the proposed written notification for FRSA-approval prior to issuance.

- (b) Personal contact with any home or business that cannot be reconnected within the time stated on the written notice.

3.2 Access

The proposed work will disturb private property. Disturbance necessary to expose the limit of public sanitary sewer service pipe is allowed under license for the FRSA to perform the proposed repairs. This license does not provide for equipment access, stockpiling of materials, or use of private property in any other way. Contractor shall minimize disturbance to private property by any means necessary. Please refer to the detail provided in *Section V* which depicts the limits of public and private sewer construction.

It shall be the Contractor's responsibility to secure any temporary access, storage or construction easements needed to perform the work on private property from the individual property owners. The cost of obtaining these items shall be considered incidental to the work.

3.3 Special Considerations

Site specific considerations are indicated on the location item list provided in *Section III, Service List*. Special considerations include, but are not limited to, the following:

- Item No. 65 – The public sanitary sewer is located in an easement in the backyard of 3710 Peterson Court. Contractor shall notify the owners of 3710 Peterson Court and 3803 Charles Street five (5) business days, minimum, prior to starting construction.
- Item No. 66 – The public sanitary sewer is located in an easement in the backyard of 3706 Peterson Court. Contractor shall notify the owners of 3706 Peterson Court and 1205 Eastgate Parkway five (5) business days, minimum, prior to starting construction.
- Item No. 67 – The public sanitary sewer is located in an easement in the backyard of 3706 Peterson Court. Contractor shall notify the owners of 3706 Peterson Court and 3807 Charles Street five (5) business days, minimum, prior to starting construction.
- Item No. 75 – Contractor shall coordinate work with North Park Public Water. Sanitary service reconnection may conflict with existing 6-inch asbestos cement water main in the vicinity of the work. Contact Josh Beeman at JBeeman@northparkwater.org. Contractor shall coordinate pavement restoration with the Village of Machesney Park. Contact Public Works Director Mitch Hilden at mitchh@machesneypark.org or (815) 877-5432.

3.4 Required Submittals

- I. Draft written notification (door hanger).

3.5 Payment

Payment for all notification and access efforts shall be included in the Contract Lump Sum (LS) unit price per street address for the various sanitary sewer service repairs.

4 Sanitary Sewer Service Replacement

4.1 General

This item shall include all labor, equipment and materials needed to replace existing sanitary sewer services from the existing sanitary sewer main or manhole to existing property lines or sanitary sewer easement limits, as indicated in *Sections III and IV*, and the installation of a service cleanout at the property or easement line (point of connection) in accordance with *Part 5* of these specifications.

All work shall be in accordance with State and local plumbing codes, and the FRSA's *General Provisions and Technical Specifications* and *Standard Detail Sheet*, except that the cleanout shall be installed on the property line or at the easement limit, and not beyond, as indicated on the *Standard Detail Sheet*. Pipe connections shall be in accordance with *Article 3, Part 5.3, Pipe and Connections*.

Material shop drawings for pipe, fittings and any other appurtenances shall be submitted to the FRSA for approval prior to delivery to the site.

4.2 Sleeved Services

Many existing sanitary services throughout this project are 6-inch diameter vitrified clay pipe (VCP) connected to existing sanitary mains. The existing services may be used as a casing pipe for the new 4-inch diameter PVC service pipe to minimize excavation where site conditions allow. Prior to inserting 4-inch diameter PVC pipe, Contractor shall remove all roots and debris from existing pipe in accordance with *Article 3, Part 5.2, Existing Pipe Cleaning*.

4.3 Service Reconnection

For services connected to existing sanitary mains, the Contractor shall install a flexible tap saddle over the existing main line connection. Flexible tap saddle shall be as manufactured by Fernco or FRSA-approved equivalent and appropriately sized to facilitate a watertight connection. Any fittings required to connect the proposed 4-inch service line to the flexible tap saddle shall be incidental.

4.4 Service Cleanout

Contractor shall install a sanitary sewer service cleanout at the property line or sanitary sewer easement line. Construction shall conform to the FRSA *Standard Detail Sheet* and *Part 5* of these specifications, including castings as required in paved areas.

4.5 Materials

All piping used for sleeved services shall be 4-inch diameter Schedule 40 pipe and fittings with glued joints conforming to ASTM D1785 / D2665.

Upstream pipe may be clay, cast or ductile iron of 4-inch or 6-inch diameter. Contractor shall provide and install eccentric reducers as required to connect to existing pipe.

Clay-to-PVC and Cast Iron or Ductile Iron-to-PVC pipe transition couplings shall be Fernco 5000 series or Mission Flex-Seal ARC shear resistant repair couplings, or approved equivalent, made of a flexible PVC compound with 316 stainless steel clamps and stainless steel rings. Transition couplings shall conform to the applicable sections of ASTM D5926 and C1173. Connections shall be made to structurally sound pipe.

4.6 Required Submittals

1. Schedule 40 PVC pipe and fittings, ASTM D1785/D2665.
2. Repair Couplings, Mission Flex ARC, Fernco 5000 Series, or equal
3. Cleanout casting.

4.7 Payment

Payment for sanitary sewer service replacement – 4-inch PVC and sanitary sewer service replacement – 6-inch PVC shall be included in the Contract Lump Sum (LS) unit price per applicable street address as indicated in *Section III, Service List*.

5 Sanitary Sewer Service Cleanout Installation

5.1 General

This work shall consist of installing a sanitary sewer service cleanout on existing clay service pipe in accordance with the detail provided in *Section V* of these specifications. This item shall include all materials, labor, and equipment necessary to complete this work.

Cleanouts shall be installed at the public Right-of-Way line or sanitary sewer easement limit. The finished cleanout elevation shall be 6 inches below grade in turf areas. A cleanout casting shall be provided in paved areas (Neenah Foundry R-1974-A or FRSA approved equal). A magnetic marker shall be secured to the cleanout riser to facilitate future locating. The magnetic marker shall be DEEP1 as manufactured by Berntsen International, Inc. or FRSA approved equivalent.

The FRSA will mark the approximate locations of existing sanitary sewer service pipes at the Right-of-Way line or easement limits. The location information provided for existing sewer services is based on record information. No claims for additional compensation will be entertained if the service point of connection is within 5 feet of the location marked in the field. If the service point of connection varies from that marked by FRSA personnel by more than 5 feet, attention is directed to *Part 7, Exploratory Excavation* of these specifications.

5.2 Existing Pipe Cleaning

Prior to installation of the sanitary sewer cleanout pipe and fittings, contractor shall clean the existing public portion of the sewer service from the public Right-of-Way or easement line to the existing sanitary sewer main. Cleaning shall include removal of all debris including roots. No power equipment shall be used in service cleaning or root removal to ensure existing piping is not damaged. Contractor shall submit proposed equipment/tools to be used in cleaning operations for FRSA review and approval.

Contractor shall verify the sewer service pipe is free of obstructions from the proposed service cleanout location to the sanitary sewer main by means of televised inspection. The camera used for televising the service pipe shall be a push service camera. Markings shall be made on the push camera cable to measure distances, and the distances shall be verified above ground with a measuring tape. Lighting and camera quality shall be suitable to provide a clear, in-focus picture of the entire inside periphery of the service pipe.

A FRSA Inspector shall be present for the televising of each sewer service pipe. Should the Contractor encounter roots or other obstructions that cannot be removed from the service using

hand tools, the FRSA Inspector shall be notified. Contractor shall make another genuine attempt to remove the obstruction using hand tools with the FRSA Inspector present. If the obstruction remains incapable of being removed by hand tools, as verified by the FRSA Inspector, FRSA crews will remove the obstruction with the necessary power equipment within 48 hours of notification.

5.3 Pipe and Connections

All piping shall be Schedule 40 pipe with glued fittings conforming to ASTM D1785/ D2665.

Contractor shall connect to existing 6-inch diameter vitrified clay pipe (VCP) downstream of the new service cleanout with a 6-inch clay-to-6-inch PVC Mission Flex ARC or Fernco 5000 series repair coupling. Contractor shall install a minimum of 2 feet of new pipe downstream of the new cleanout. Connection shall be made to structurally sound pipe. The new cleanout riser and service pipe shall be 6-inch diameter Schedule 40 PVC. The cleanout riser shall be connected to the service pipe by a 6-inch X 6-inch PVC tee fitting. The cleanout shall include a threaded cap installed at the top.

To connect to 4-inch diameter cast iron or ductile iron service pipe upstream of the new cleanout, the Contractor shall install a 6-inch X 4-inch PVC eccentric reducer, a minimum of 1 foot of new 4-inch diameter Schedule 40 PVC service pipe and connect to existing 4-inch diameter cast iron or ductile iron with a Mission Flex ARC or Fernco 5000 series repair coupling.

Where private service pipe is 4-inch cast or ductile iron, Contractor shall remove all 4-inch cast iron downstream of the property line and connect to existing 6-inch diameter VCP service pipe to allow for future CIPP lining of the 6-inch VCP.

FRSA records indicate a majority of private cast iron services end at the property line. Private cast iron services that may extend into the public Right-of-Way near the curb and gutter or edge of pavement are indicated on the *Service List* in *Section III*.

5.4 Required Submittals

1. Pipe Cleaning equipment list and specifications.
2. Schedule 40 PVC pipe and fittings, ASTM D1785/D2665.
3. Repair Couplings, Mission Flex ARC, Fernco 5000 Series, or equal
4. Cleanout casting

5.5 Payment

Payment for sanitary sewer service cleanout installation shall be included in the Contract Lump Sum (LS) unit price per street address as indicated in *Section III, Service List*.

6 Bedding, Backfill & Compaction

6.1 General

6.2 Pipe Bedding

Pipe bedding for PVC pipe shall be Class IA per ASTM Standard D2321. The trench bottom shall be bedded with a minimum of 6 inches of crushed stone. Crushed stone shall be placed to a

minimum of 12 inches above the top of the pipe, as shown on the FRSA's *Standard Detail Sheet*.

Bedding shall be graded such that it precludes the migration of trench wall material into the bedding; the FRSA shall approve this bedding material after the characteristics of the trench are determined.

If the water table is above the bottom of the pipe bedding, or the trench bottom is unstable or unsuitable, as determined by the FRSA, a porous granular foundation meeting *IDOT Standard Specifications* of CA-5 or CA-3 stone shall be installed as necessary below the granular bedding material, extending to the limits of the bedding diagram at no extra cost to the FRSA.

Should boulders, frozen material, etc., which could damage the pipe be present in the native backfill material, the Contractor shall bring the bedding material to a point 24 inches above the crown of the pipe (cost incidental).

6.3 Backfill and Compaction

The Contractor shall use approved select trench backfill to the level of the base under all roads, shoulders, sidewalks, driveways, parking lots or pavements of any kind and beyond such pavements as set forth in General Provisions and Technical Specifications T.S. 2:4-c. Select trench backfill under said structures shall meet FA 6 gradation and be mechanically compacted in 6--inch to 18-inch loose lifts to the sub-grade elevation of the road shoulder, sidewalk, driveway, parking lot or pavement. The materials and compaction shall be in accordance with *Section 208 and 550.07, Method 1 of the IDOT Standard Specifications*.

For granular backfill, The Contractor must use a vibratory plate or other approved equipment-mounted compaction equipment to compact the backfill in lifts not to exceed 18 inches. Water-jetting, ponding, or flooding will not be permitted as a means of trench compaction.

All select trench backfill shall be compacted to ninety-five percent (95%) of Proctor density; all other backfill shall be compacted to ninety percent (90%) minimum of Proctor density. Contractor shall provide third-party confirmation of subgrade compaction as directed by the FRSA.

The Contractor shall furnish a backhoe and operator during the testing of the backfill placed during construction. All compaction tests will be performed at the Contractor's expense by an approved, independent geotechnical-testing firm. If the tests do not meet the compaction requirement specified above, the area shall be both re-compacted and re-tested at the Contractor's expense until the test requirements are met. If initial tests indicate compaction requirements are being met, no further lift testing will be required unless method, equipment, or material changes. The final lift forming the sub-grade must be tested.

In trenches not requiring select trench backfill, no excavated material larger than 8 inches in any dimension shall be used in the backfill.

Contractor shall properly dispose of all spoil at no additional cost to the FRSA. The Contractor shall exercise care not to disturb any existing utilities during backfilling and compaction operations.

The Contractor shall provide a three (3) year guarantee against trench settlement throughout this project upon completion of construction.

6.4 Submittals

1. Pipe bedding material grading certifications.
2. Select trench backfill material gradation certifications, and Proctor test results for use in density testing.

6.5 Payment

Payment for bedding, backfill and compaction shall be included in the Contract Lump Sum (LS) unit price per street address as indicated in *Section III, Service List*.

7 Exploratory Excavation

7.1 General

As stated previously herein, FRSA personnel will mark the approximate service point of connection in the field at the Right-of-Way or easement line. This work shall only apply if the mark placed by FRSA personnel for the service point of connection varies from the actual point of connection by more than 5 feet horizontally in any direction. If the actual point of connection and marked location fall within 5 feet or less horizontally in any direction, this item shall not apply.

This work includes all material, labor, and equipment necessary to excavate to a depth typical of residential sanitary sewer services, backfill and restore the surface to a condition equal to or better than conditions that existed prior to excavation.

This item shall include up to 36 square feet (SF) of pavement removal and replacement.

Restoration of turf area shall be in conformance with *Part 8* of these specifications.

7.2 Required Submittals – Not used.

7.3 Payment

Payment for this item shall be made at the Contract unit price per Each (EA) for Exploratory Excavation, complete.

8 Restoration Work

8.1 General

All restoration of private and public property, including sidewalks, concrete steps and railings, landscaping, fences, driveways, all other slab work, concrete and asphalt, drainage channels, storm sewers and dry wells, disturbed or damaged as a result of this construction project, including damages caused by sewer backups, shall be promptly completed, in conformance with roadway authority standards or on private property equal to or better than the pre-construction conditions as directed by the FRSA and guaranteed by the Contractor for a period of two (2) years following satisfactory completion and final acceptance of the total Contract.

All excavated areas shall be guaranteed against subsidence and settlement for a period of three (3) years after final completion of the contract. Any additional restoration work needed because of subsidence or settlement shall be performed by the Contractor at no cost to the FRSA.

All water main, gas main, storm sewer, corrugated metal pipe, drainage tile or other drainage devices shall be repaired, re-laid or replaced to original elevations. Pipes which in the estimation of the FRSA have been significantly damaged by the Contractor, shall be replaced with new pipe of the same diameter, length and type, at no added expense to the FRSA; any necessary couplings and fittings shall be provided as necessary, and the work shall be to the FRSA's satisfaction. When necessary, temporary restoration of roads, drives, fences, etc., will be required.

Restoration work shall include the following provisions:

1. All soil, brush and debris resulting from construction shall be removed and disposed of in a satisfactory manner. The ground surface, all fences and other structures on the premises or adjacent premises touched or in any manner altered by the construction of the sewer, shall be restored to a condition equal to or better than existed before the commencement of the work.
2. Ground surfaces that were covered with grass prior to construction shall be restored to original grade and seeded per these specifications. Excavated and stockpiled topsoil may be used for this item if acceptable to the FRSA; otherwise, approved topsoil may need to be imported.
3. On private property, the Contractor shall remove and replace (or replant) all bushes, shrubs and plants damaged or destroyed with species of similar type, size and quantity. These shall be guaranteed for a period of one (1) year after final completion.

8.2 Minimum Sidewalk and Pavement Restoration

PCC sidewalk work shall be in accordance with *Section 424 of IDOT Standard Specifications*. Installed PCC sidewalk thickness shall match existing (4-inch minimum). Sidewalk shall be placed over 4 inches of compacted aggregate base course of CA-6 gradation.

PCC driveway work shall be in accordance with *Section 423 of IDOT Standard Specifications*. Replacement PCC driveway pavement thickness shall match existing (6-inch minimum). PCC driveway pavement shall be placed over 8-inch compacted aggregate base course of CA-6 gradation.

When a sanitary service is located under new concrete, the Contractor shall stamp the concrete with the letter "S" directly over the service on the sidewalk or driveway pavement. The letter "S" shall be 3-4 inches tall. Exact location of the stamp shall be determined in the field.

HMA driveway work shall be in accordance with *Section 406 of IDOT Standard Specifications*. Minimum compacted thickness of HMA driveway pavement shall be 2 inches. HMA mix IL-9.5, N50, Mix "C" in accordance with *Section 1030 of IDOT Standard Specifications*. Tack coat shall be SS-1 in accordance with *Section 1032 of IDOT Standard Specifications*. HMA Driveway pavement shall be placed over 8-inch compacted aggregate base course of CA-6 gradation.

Public HMA roadway work shall be in accordance with *Section 406 of IDOT Standard Specifications*. HMA binder shall be IL-19.0, N70 with a minimum compacted lift thickness of 2.5 inches. HMA Surface shall be IL-9.5, N50, with a minimum compacted lift thickness of 2.0 inches. Pavement shall be placed over 12 inches compacted aggregate base course of CA-6 gradation.

Additionally, public HMA roadway work at 7516 & 7519 Grenville Street (Items 74 & 75) shall be saw-cut full depth prior to removal at a width equal to one (1) entire lane. The HMA pavement

shall match the recently installed existing pavement of 1.5 inches of IL-9.5, N50 surface over 3 inches of IL-19.0, N70 binder. Pavement shall be placed over 12-inch compacted aggregate base course of CA-6 gradation.

PCC Curb and Gutter work shall be in accordance with *Section 606 of IDOT Standard Specifications* and Standard 606001. Curb and gutter shall match existing type.

8.3 Restoration of Existing Landscaping, Fencing, and Miscellaneous

Work at several locations will inevitably impact existing landscaping features, fencing or other features that are situated near the proposed service repair. The FRSA will document pre-existing conditions by video recording prior to the start of work. It is recommended the Contractor do the same.

Where special landscaping, fencing or other items will be impacted they shall be removed and stored for reinstallation, if possible, or replaced. Any items/materials damaged by construction shall be removed and disposed of by the Contractor. Replacement materials shall be of same manufacturer, color, type, grade, etc., as the items removed. If materials of same manufacture are not available, Contractor shall submit material specifications and samples for FRSA-approval prior to delivery to the site or installation.

8.4 Seeding

Turf areas disturbed by construction shall be seeded in *Section 250 of IDOT Standard Specifications* and as directed by the FRSA. The Contractor shall make certain that all disturbed areas have the same depth (4" minimum) and quality of approved topsoil as existed prior to construction.

The seeding mixture used shall be compatible with the existing ground and shall be acceptable to the FRSA. Maintainable lawn areas shall be seeded with IDOT Class I seeding mixture. Existing non-maintained turf areas shall be seeded with IDOT Class 3-slope mixture.

Reference is made to the *General Provisions and Technical Specifications for Sanitary Sewer Construction*, T.S. 4:2, for specifications on seeding and sodding and fertilizer, and to *Sections 250, and 251 of the IDOT Standard Specifications for Road and Bridges Construction*, current edition.

8.5 Machesney Park

For all work occurring on Grenville Street, Borodell Street, and Rogers Street (Items 74-81), the Contractor shall take measures to avoid damaging the recently paved roadway surfaces outside of the construction limits. When excavating near existing curb and gutter on these streets, the Contractor shall take measures to protect the curb and gutter due to the sandy soils which are present.

The Contractor shall provide protection (i.e., rock sock, wattle, inlet protection, etc.) for the first storm inlet located downstream of the construction limits for all work occurring in Machesney Park (Items 74-86).

8.6 Required Submittals

1. Concrete mix design; specify driveway, sidewalk or curb and gutter.
2. HMA mix design; specify private drive or public roadway.
3. Aggregate material certifications.

4. Seeding mixture certifications.

8.7 Payment

Payment for restoration work shall be included in the Contract Lump Sum (LS) unit price per street address for the various sanitary sewer service repairs.

9 Safety & Traffic Control

9.1 General

The work described under this Contract includes sanitary sewer work, an environment deemed hazardous by State and Federal authorities. The Contractor shall employ all safety measures appropriate for such work and shall be solely responsible for the safety of all operations, including compliance with all State, Local and OSHA regulations.

During the course of construction, the Contractor shall keep a minimum of one lane of traffic open through any affected streets.

The Contractor shall comply with all rules and regulations of the State, County and City authorities regarding closing or restricting the use of public streets or highways. No public or private road shall be closed, except by express permission of the FRSA. All work shall be conducted in a manner that will minimize any impact to vehicular traffic and normal commercial activities. Contractor shall protect all disturbed work areas within traveled roadways by installing approved signs, barricades, and lights where necessary for the safety of the public.

Contractor shall provide and install signage for sidewalk closures in accordance with IDOT Standard 701801-06.

The Contractor shall notify the appropriate roadway authority a minimum of seventy-two (72) hours prior to beginning any work for approval of traffic control in any affected streets, as well as required detour routes, signing and permits.

The Contractor shall provide access to the residences and/or businesses, schools, etc., at all times (i.e., drives and roadways must remain open; ramps must be provided as necessary) for the duration of this Contract.

When required by regulation or when deemed necessary for safety, the Contractor shall furnish flagmen and/or guards and other traffic regulatory devices.

9.2 Required Submittals – Not Used.

9.3 Payment

Payment for safety and traffic control shall be included in the Contract Lump Sum (LS) price per street address for the various sanitary sewer service repairs.

10 Extra Work

10.1 General

Work described in this specification shall only apply to items scheduled to receive a 6-inch cleanout installation in *Section III – Service List*.

As stated in *Part 5.3*, proposed cleanouts must be connected to 6-inch diameter pipe. Unless noted otherwise in *Section III – Service List*, cleanout installation work is not expected to impact public roadway features, such as curb and gutter or pavement. If existing conditions prevent connection to 6-inch diameter pipe without removal of curb and gutter and/or public roadway pavement, Extra Work pay items shall apply. Extra Work shall apply if the transition from 4-inch diameter to 6-inch diameter piping is located more than 10 feet horizontally from the proposed cleanout location (property or easement line) or if exposing the 6-inch diameter pipe requires removal of curb and gutter or public roadway pavement.

Contractor shall notify the FRSA Inspector and receive the FRSA Inspector's approval prior to proceeding with Extra Work. Payment for unapproved extra work is not guaranteed.

10.2 Pipe and Connections

All pipe and connections shall conform to *Article 3, Part 5.3*.

10.3 Restoration Work

All restoration work shall conform to *Article 3, Part 8*.

10.4 Payment

Payment for Extra Work – 6" Dia. Service Pipe will be made at the Contract unit price per Linear Foot (LF).

Payment for Extra Work – Remove and Replace PCC Curb and Gutter will be made at the Contract unit price per Linear Foot (LF).

Payment for Extra Work – Remove and Replace PCC Pavement will be made at the Contract unit price per Square Yard (SY).

Payment for Extra Work – Remove and Replace HMA Pavement will be made at the Contract unit price per Square Yard (SY).

Payment for Extra Work – Turf Restoration will be made at the Contract unit price per Square Yard (SY).

Section II
Contract Forms

Not to be used for bidding purposes

Proposal

Project: 2024 Service Cleanout Installations, Capital Project No. 2501

Location: Various locations within the public Right-of-Ways in the Village of Machesney Park and City of Rockford Winnebago County, Illinois

Completion Date: October 31, 2024

Liquidated Damages: \$300/calendar day

To: Board of Trustees
Four Rivers Sanitation Authority
3501 Kishwaukee Street
Rockford, IL 61109

From: _____
(Individual, Partnership or Corporation, as case may be)

(Address of Individual, Partnership or Corporation)

Gentlemen:

I (We), the undersigned, hereby propose to furnish all materials, equipment, tools, services, labor, and whatever else may be required to construct and place in service the above subject Sanitary Sewer for the Four Rivers Sanitation Authority all in accordance with the plans and specifications, provided by Four Rivers Sanitation Authority. The undersigned also affirms and declares:

1. That I (we), have, examined and am (are) familiar with all the related contract documents and found that they are accurate and complete and are approved by the undersigned.
2. That I (we), have carefully examined the site of the work, and that, from my (our) investigation, has satisfied myself (ourselves) as to the nature and location of the work, the character, quality, and quantity of materials and the kind and extent of equipment and other facilities needed for the performance of the work, the general and local conditions and all difficulties to be encountered, and all other items which may, in any way, effect the work or its performance.
3. That this bid is made without any understanding, agreement or connection with any other person, firm, or corporation making a bid for the same purposes, and is in all respects fair and without collusion or fraud; and that I (we) are not barred from bidding as a result of a bid-rigging or bid-rotating conviction.

4. That accompanying the Proposal is a Bidder's Bond in the amount specified in Article 1, Notice to Bidders, payable to the Board of Trustees of the Four Rivers Sanitation Authority, which it is agreed, shall be retained as liquidated damages by said Four Rivers Sanitation Authority if the undersigned fails to execute the Contract in conformity with the contract documents incorporated in the contract documents and furnish bond as specified, within ten (10) days after notification of the award of the contract to the undersigned.
5. The Bidder is of lawful age and that no other person, firm or corporation has any interest in this Proposal or in the Contract proposed to be entered into.
6. The Bidder is not in arrears to the Four Rivers Sanitation Authority, upon debt or contract, and is not a defaulter, as surety or otherwise, upon any obligation to the Four Rivers Sanitation Authority.
7. No officer or employee or person whose salary is payable in whole or in part by the Four Rivers Sanitation Authority is, shall be or become interested, directly or indirectly as a contracting party, partner, stockholder, surety or otherwise, in this Proposal, or in the performance of the Contract, or in the work to which it is related, or in any portion of the profits thereof.
8. The Bidder which I represent complies with all applicable requirements of the Americans with Disabilities Act (ADA) and the Occupational Safety and Health Act (OSHA) and that if said bidder is awarded a contract, it will complete all OSHA-required or ADA-required employee and customer training, will make available all required information, and will hold harmless and indemnify the Four Rivers Sanitation Authority and the Four Rivers Sanitation Authority's representatives.

In regard to participation in an approved Apprenticeship program, upon request, Contractor will be required to provide written proof of participation.
9. The undersigned, as Bidder, declares that he has adopted and promulgated written sexual harassment policies in accordance with Public Act 101-0221 and will make this information available upon request.
10. The undersigned, as Bidder, declares he will comply with prevailing wages in accordance with the Illinois Department of Labor Standards. The State of Illinois requires contractors and subcontractors on public works projects (including Four Rivers Sanitation Authority) to submit certified payroll reports via the State's Certified Transcript of Payroll Portal found at <https://labor.illinois.gov/laws-rules/conmed/certifiedtranscriptofpayroll.html>.
11. The undersigned, as Bidder, declares he will comply with the Federal Drug Free Workplace Act.
12. The undersigned, as Bidder, declares he will comply with Public Act 83-1030 entitled "Steel Products Procurement Act".
13. The undersigned, as Bidder, declares he will comply with Public Act 96-929 (30 ILCS 570) regarding Illinois residents' employment.
14. The undersigned, as Bidder, declares he will comply with non-discrimination in employment in accordance with the Illinois Fair Employment Practices Commissions Rules & Regulations.

15. The undersigned, as Bidder, declares that he currently participates in an apprenticeship or training program that is registered with the United States Department of Labor's Bureau of Apprenticeship and Training or other acceptable State of Illinois Department of Labor monitored program.

In submitting this bid, it is understood that the right is reserved by the Four Rivers Sanitation Authority to reject any and all bids. It is agreed that this bid may not be withdrawn for a period of sixty (60) days from the opening thereof.

The undersigned further declares that he (they) has (have) carefully examined the following items of work and that the cost of all the work to complete this project is given in this Proposal.

Not to be used for bidding purposes

Base Bid							
Item No.	Quantity	Unit	Description		Unit Price (in Writing)	Unit Price (in Figures)	Total Price (in Figures)
1	1	LS	2015 Arizona Avenue	6" CO			
2	1	LS	2231 Eastgate Parkway	6" CO			
3	1	LS	3007 18th Avenue	6" CO			
4	1	LS	3012 18th Avenue	Replace w/CO & Saddle Tee - 4"			
5	1	LS	1906 Ohio Parkway	Replace w/CO & Saddle Tee - 6"			
6	1	LS	1908 Ohio Parkway	Reconnect 4" PVC w/ Saddle Tee & New Riser			
7	1	LS	3207 Maryland Road	6" CO			
8	1	LS	3212 Maryland Road	6" CO			
9	1	LS	3215 Maryland Road	6" CO			
10	1	LS	3219 Maryland Road	6" CO			
11	1	LS	3111 Maryland Road	6" CO			
12	1	LS	3115 Maryland Road	6" CO			
13	1	LS	3119 Maryland Road	6" CO			
14	1	LS	3112 Maryland Road	6" CO			
15	1	LS	3123 Maryland Road	6" CO			
16	1	LS	1710 Ohio Parkway	6" CO			
17	1	LS	1714 Ohio Parkway	6" CO			
18	1	LS	1719 Ohio Parkway	6" CO			
19	1	LS	3335 California Road	6" CO			
20	1	LS	3227 California Road	6" CO			
21	1	LS	3231 California Road	6" CO			

Item No.	Quantity	Unit	Description		Unit Price (in Writing)	Unit Price (in Figures)	Total Price (in Figures)
22	1	LS	3242 California Road	6" CO			
23	1	LS	3303 California Road	6" CO			
24	1	LS	3250 California Road	6" CO			
25	1	LS	2108 Idaho Parkway	6" CO			
26	1	LS	3518 Westgate Parkway	6" CO			
27	1	LS	3526 Westgate Parkway	6" CO			
28	1	LS	2008 Idaho Parkway	6" CO			
29	1	LS	2012 Idaho Parkway	6" CO			
30	1	LS	2020 Nebraska Road	Replace w/CO & Saddle Tee - 6"			
31	1	LS	1727 Eastgate Parkway	Reconnect 4" PVC w/ Saddle Tee			
32	1	LS	1731 Eastgate Parkway	6" CO			
33	1	LS	1708 Eastgate Parkway	6" CO			
34	1	LS	1703 Eastgate Parkway	6" CO			
35	1	LS	3432 Minnesota Drive	6" CO			
36	1	LS	3431 Minnesota Drive	6" CO			
37	1	LS	3435 Minnesota Drive	6" CO			
38	1	LS	3439 Minnesota Drive	6" CO			
39	1	LS	3444 Minnesota Drive	6" CO			
40	1	LS	3420 Minnesota Drive	6" CO			
41	1	LS	3407 Minnesota Drive	6" CO			
42	1	LS	3419 Minnesota Drive	6" CO			
43	1	LS	3419 Broadway	6" CO			
44	1	LS	3422 Broadway	6" CO			
45	1	LS	3431 Broadway	6" CO			
46	1	LS	1324 Widergren Drive	6" CO			
47	1	LS	1331 Widergren Drive	6" CO			
48	1	LS	1408 30th Street	6" CO			

Item No.	Quantity	Unit	Description		Unit Price (in Writing)	Unit Price (in Figures)	Total Price (in Figures)
49	1	LS	1415 30th Street	6" CO			
50	1	LS	1409 30th Street	6" CO			
51	1	LS	1403 30th Street	6" CO			
52	1	LS	1414 30th Street	6" CO			
53	1	LS	1411 29th Street	Reconnect 4" PVC w/ Saddle Tee			
54	1	LS	1411 Florist Drive	6" CO			
55	1	LS	1412 Florist Drive	6" CO			
56	1	LS	1416 Florist Drive	6" CO			
57	1	LS	1204 Florist Drive	6" CO			
58	1	LS	1207 Florist Drive	6" CO			
59	1	LS	1208 Florist Drive	6" CO			
60	1	LS	1219 Florist Drive	6" CO			
61	1	LS	1303 Florist Drive	6" CO			
62	1	LS	1308 Florist Drive	6" CO			
63	1	LS	1307 Florist Drive	6" CO			
64	1	LS	1312 Florist Drive	6" CO			
65	1	LS	3803 Charles Street	Replace w/CO & Saddle Tee - 6"			
66	1	LS	1205 Eastgate Parkway	Replace w/CO & Saddle Tee - 6"			
67	1	LS	3807 Charles Street	Replace w/CO & Saddle Tee - 6"			
68	1	LS	1315 Florist Drive	6" CO			
69	1	LS	1320 Florist Drive	6" CO			
70	1	LS	1323 Florist Drive	6" CO			
71	1	LS	2227 Eastgate Parkway	Replace w/CO & Saddle Tee - 6"			
72	1	LS	1818 26th Street	6" CO			
73	1	LS	1819 26th Street	6" CO			

Item No.	Quantity	Unit	Description		Unit Price (in Writing)	Unit Price (in Figures)	Total Price (in Figures)
74	1	LS	7516 Grenville Street	Replace w/CO & Saddle Tee - 6"			
75	1	LS	7519 Grenville Street	Reconnect 4" PVC w/ Saddle Tee			
76	1	LS	7521 Borodell Street	6" CO			
77	1	LS	7520 Borodell Street	6" CO			
78	1	LS	7513 Borddell Street	6" CO			
79	1	LS	7502 Borodell Street	6" CO			
80	1	LS	7636 Rogers Street	6" CO			
81	1	LS	7632 Rogers Street	6" CO			
82	1	LS	7607 Elm Avenue	6" CO			
83	1	LS	1028 Maple Avenue	6" CO			
84	1	LS	1020 Maple Avenue	6" CO			
85	1	LS	628 Sycamore Lane	6" CO			
86	1	LS	702 Sycamore Lane	6" CO			
87	1	LS	2015 19th Avenue	6" CO			
88	1	LS	2022 19th Avenue	6" CO			
89	1	LS	2203 19th Avenue	6" CO			
90	1	LS	2204 19th Avenue	6" CO			
91	1	LS	2205 19th Avenue	6" CO			
92	1	LS	2215 19th Avenue	6" CO			
93	1	LS	2032 21st Street	6" CO			
94	1	LS	2103 21st Street	Reconnect 4" PVC w/ Saddle Tee			
95	1	LS	2108 21st Street	6" CO			
96	1	LS	2420 Wesleyan Avenue	6" CO			
97	1	LS	2207 22nd Street	6" CO			
98	1	LS	2516 Heritage Court	6" CO			
99	1	LS	2519 Heritage Court	6" CO			
100	1	LS	2520 Heritage Court	6" CO			

Item No.	Quantity	Unit	Description		Unit Price (in Writing)	Unit Price (in Figures)	Total Price (in Figures)
101	1	LS	2523 Heritage Court	6" CO			
102	1	LS	2524 Heritage Court	6" CO			
103	10	EA	Exploratory Excavation				
104	100	LF	Extra Work - 6" Dia. Service Pipe				
105	80	LF	Extra Work - Remove & Replace PCC Curb & Gutter				
106	30	SY	Extra Work - Remove & Replace PCC Pavement				
107	30	SY	Extra Work - Remove & Replace HMA Pavement				
108	80	SY	Extra Work - Turf Restoration				
Subtotal, Base Bid Price:							
					(In Writing)		(In Figures)
Alternate Bid							
Item No.	Quantity	Unit	Description		Unit Price (in Writing)	Unit Price (in Figures)	Total Price (in Figures)
1001	1	LS	2527 Heritage Court	6" CO			
1002	1	LS	2215 22nd Street	6" CO			
1003	1	LS	2515/2517 Pilgrim Court	6" CO			
1004	1	LS	2520 Pilgrim Court	6" CO			
1005	1	LS	2208 23rd Street	6" CO			
1006	1	LS	2215 23rd Street	6" CO			
1007	1	LS	2216 23rd Street	6" CO			
1008	1	LS	2320 23rd Street	6" CO			
1009	1	LS	2407 26th Street	6" CO			
1010	1	LS	2411 26th Street	6" CO			
Subtotal, Alternate Bid Price:							
					(In Writing)		(In Figures)
Total, Base Bid + Alternate Bid Price:							
					(In Writing)		(In Figures)

Please note: This Project will be awarded, if at all, to a single bidder. Bids will be compared on the total price bid for Base Bid work plus any combination (Base Bid or Base Bid + Alternate). In accordance with Section I, Article 2, Parts 3.10 and 3.11, FRSA is responsible for selecting the lowest, responsive, responsible bidders. Bids submitted that omit the Bid Alternate may be deemed unresponsive at the sole discretion of FRSA. FRSA reserves the right to reject any and all bids and to accept the bid which they deem most favorable to the interest of FRSA after all proposals have been canvassed.

The undersigned acknowledges receiving Addendum numbers ____, ____, ____, and realizes that all Addenda are considered part of the Contract.

By: _____

Name: _____ Title: _____ Date: _____

Not to be used for bidding purposes

Fair Employment Practices Affidavit of Compliance

Project: 2024 Service Cleanout Installations, Capital Project No. 2501

NOTE: THE BIDDER MUST EXECUTE THIS AFFIDAVIT AND SUBMIT IT WITH ITS SIGNED BID. THE FOUR RIVERS SANITATION AUTHORITY CANNOT ACCEPT ANY BID WHICH DOES NOT CONTAIN THIS AFFIDAVIT

_____, being first duly sworn, deposes and says that:
(Name of person making affidavit)

They are: _____ of _____
(Officer's Title) (Company Name)

that said company is and "Equal Opportunity Employer" as defined by Section 2000(e) of Chapter 21, Title 42 of the United States Code annotated and Federal Executive Orders #11375 which are incorporated herein by reference;

and that said company will comply with any and all requirements of Title 44 Admin. Code 750. APPENDIX A – Equal Opportunity Clause, Rules and Regulations, Illinois Department of Human Rights, which read as follows:

"In the event of the contractor's non-compliance with the provisions of this Equal Employment Opportunity Clause, the Illinois Human Rights Act or the Rules and Regulations of the Illinois Department of Human Rights ("Department"), the contractor may be declared ineligible for future contracts or subcontracts with the State of Illinois or any of its political subdivisions or municipal corporations, and the contract may be cancelled or voided in whole or in part, and such other sanctions or penalties may be imposed or remedies invoked as provided by statute or regulation. During the performance to this contract, the contractor agrees as follows:

1. That it will not discriminate against any employee or applicant for employment because of race, color, religion, sex, sexual orientation, marital status, national origin or ancestry, citizen status, age, physical or mental handicap unrelated to ability, sexual orientation, military status or an unfavorable discharge from military service; and further that it will examine all job classifications to determine if minority persons or women are underutilized and will take appropriate affirmative action to rectify any such underutilization.
2. That, if he or she hires additional employees in order to perform this contract or any portion of this contract, he or she will determine the availability (in accordance with the Department's Rules and Regulations) of minorities and women in the areas from which he or she may reasonably recruit and he or she will hire for each job classification for which employees are hired in a way that minorities and women are not underutilized.
3. That, in all solicitations or advertisements for employees placed by him or her or on his or her behalf, he or she will state that all applicants will be afforded equal opportunity without discrimination because of race, color, religion, sex, sexual orientation, marital status, national origin or ancestry, citizenship status, age, physical or mental handicap unrelated to ability, sexual orientation, military status or an unfavorable discharge from military service.
4. That he or she will send to each labor organization or representative of workers with which he or she has or is bound by a collective bargaining or other agreement or understanding, a notice advising such labor organization or representative of the contractor's obligations under the Illinois Human Rights Act and the Department's Rules and Regulations. If any labor organization or representative fails or refuses to cooperate with the contractor in his or her efforts to comply with such Act and Rules and Regulations, the contractor will promptly so notify the Department and the contracting agency and will recruit employees from other sources when necessary to fulfill its obligations under the contract.
5. That he or she will submit reports as required by the Department's Rules and Regulations, furnish all relevant information as may from time to time be requested by the Department or the contracting agency, and in all respects comply with the Illinois Human Rights Act and the Departments Rules and Regulations.
6. That he or she will permit access to all relevant books, records, accounts and work sites by personnel of the contracting agency and the Department for purposes of investigation to ascertain compliance with the Illinois Human Rights Act and the Department's Rules and Regulations.
7. That he or she will include verbatim or by reference the provisions of this clause in every subcontract awarded under which any portion of the contract obligations are undertaken or assumed, so that the provisions will be binding upon the subcontractor. In the same manner as with other provisions of this contract, the contractor will be liable for compliance with applicable provisions of this clause by such subcontractors; and further it will promptly notify the contracting agency and the Department in the event any subcontractor fails or refuses to comply with the provisions. In addition, the contractor will not utilize any subcontractor declared by the Illinois Human Rights Commission to be ineligible for contracts or subcontracts with the State of Illinois or any of its political subdivisions or municipal corporations.

(Source: Amended at 32 Ill. Reg. 16484, effective September 23, 2008)"

Ill. Dept of Human Rights Registration No.: _____ Expiration Date: _____

Signature

Subscribed and sworn to before me this _____ day of _____, 20_____.

Notary Public

Bid Bond

KNOW ALL MEN BY THESE PRESENTS, that we:

_____ (hereinafter called the Principal) and

_____ (hereinafter called the Surety)

a Corporation chartered and existing under the laws of the State of _____ with its principal offices in the City of _____ and authorized to do business in the State of Illinois are held and firmly bound unto the Four Rivers Sanitation Authority (FRSA) of Winnebago County, Illinois, in the full and just sum of: **FIVE (5%) OF THE TOTAL BID PRICE** good lawful money of the United States of America, to be paid upon demand of the FRSA, to which payment will and truly to be made we bind ourselves, our heirs, executors, administrators, and assigns, jointly and severally and firmly by these presents.

WHEREAS, the Principal is about to submit, or has submitted to FRSA, a proposal for the installation of cleanout risers on existing sanitary sewer services, the replacement of existing clay sewer services with PVC pipe, the connection of PVC sewer services to sewer mains, and all other appurtenances as indicated on the plans and in the specifications.

WHEREAS, the Principal desires to file this bond, in accordance with law, to accompany this Proposal.

NOW THEREFORE, The conditions of this obligation are such that if the Proposal be accepted, the Principal shall, within ten days after the date of receipt of a written notice of award of Contract, execute a Contract in accordance with the Proposal and upon the terms, conditions, and prices set forth therein, in the form and manner required by FRSA, and execute a sufficient and satisfactory Contract Performance Bond payable to said FRSA in an amount of one hundred percent (100%) of the Contract price (including alternates) in form and with security satisfactory to said FRSA, then this obligation to be void, otherwise to be and remain in full force and virtue in law; and the Surety shall, upon failure of the Principal to comply with any or all of the foregoing requirements within the time specified above, immediately pay to the aforesaid FRSA, upon demand, the amount hereof in good and lawful money of the United States of America, not as a penalty, but as liquidated damages.

IN TESTIMONY THEREOF, the Principal and Surety have caused these presents to be duly signed and sealed this _____ day of _____, 20_____.

Principal

(Seal)

By _____

Name: _____

Title: _____

Date: _____

Attest:

Secretary

Surety

(Seal)

By _____

Name: _____

Title: _____

Date: _____

Not to be used for bidding purposes

Agreement

1. General

THIS AGREEMENT, made and concluded this _____ day of _____, 2024, between the Four Rivers Sanitation Authority (FRSA), Rockford, Illinois, acting by and through the Board of Trustees, and _____, his/their executors, administrators, successors or assigns:

2. Scope of Work

WITNESSETH: That for and in consideration of the payments and agreements made in the Proposal attached hereto, to be made and performed by FRSA and according to the terms expressed in the Bond referring to these presents, the Contractor agrees with FRSA at his/their own proper cost and expense to do all the work, furnish all equipment, materials and all labor necessary to complete the work in accordance with the plans and specifications hereinafter described, and in full compliance with all of the terms of this agreement and the requirements of FRSA and its representative.

And it is also understood and agreed that the Bidding Requirements, Detailed Specifications, Contract Forms, General Conditions, General Requirements, Technical Specifications, Plans, Addenda, and provisions required by law are all essential documents of the contract, and are a part hereof, as if herein set out verbatim or as if attached, except for titles, subtitles, headings, table of contents and portions specifically excluded.

3. Contract Price

FRSA shall pay to the Contractor, and the Contractor shall accept, in full payment for the performance of this Contract, subject to any additions or deductions provided for hereby, in current funds, the Total Contract Price of _____ and 00/100 (\$ _____).

Payments are to be made to the Contractor in accordance with and subject to the provisions of Section 7 of this Agreement, which is a part of this Contract.

4. Bond

The Contractor has entered into and herewith tenders a bond of even date herewith, in the penal sum of _____ and 00/100 (\$ _____) to insure the faithful performance of this Contract, which said bond is hereby made a part of this Contract by reference.

5. Maintenance and Guarantee

The Contractor shall promptly repair, replace, restore or rebuild any imperfections that may arise and shall maintain satisfactory to FRSA all work for a period three years from the date of final acceptance of the Contract for trench settlement and for a period of two years all other work, except where periods of maintenance and guarantee are provided for. The Contractor shall, for this period, indemnify and save harmless the FRSA, its officers and agents from any injury done to property or persons as a direct or alleged result of imperfections in the Contractors' work, and shall immediately assume and take charge of the defense of such action or suits in like manner and to all intents and purposes as if said actions and suits had been brought directly against the Contractor.

If the Contractor shall fail to repair, replace, rebuild or restore such defective or damaged work promptly after receiving notice given by FRSA, the FRSA shall have the right to have the work done by others and to call on the Contractor and his bondsman to pay the costs thereof.

6. Contract Execution

IT IS EXPRESSLY UNDERSTOOD AND AGREED that the entire improvement shall be done in a thorough and workmanlike manner, under the direction and to the satisfaction of FRSA and in full compliance with all the requirements of its representative under them. All loss or damage arising out of the nature of the work to be done, or from any detention of unforeseen obstruction or difficulty which may be encountered in the prosecution of the work, or from the action of the elements, shall be sustained by the Contractor.

The Contractor will be held responsible for all accidents, and hereby agrees to indemnify and protect FRSA from all suits, claims, and actions brought against it, and all cost, and damages which FRSA may be put to by reason of an injury or alleged injury, to the person or property of another in the execution of this contract, or the performance of the work, or in guarding the same, or for any material used in its prosecution or in its construction.

Any person employed on the work who shall refuse or neglect to obey the directions of FRSA or its representative, or who shall be deemed by FRSA to be incompetent, or who shall be guilty of any disorderly conduct, or who shall commit any trespass on any public or private property in the vicinity of the work, shall at once be removed from the work by the Contractor when so requested by FRSA.

Any request to extend the contract completion date must be considered by the Board at the Board meeting prior to the then-existing contract termination date. Any deviation from this action will result in the liquidated damage clause in the contract to be exercised.

7. Payments to Contractor

FRSA hereby covenants and agrees, in consideration of the covenants and agreements in this Contract, specified to be kept and performed by the Contractor and subject to the conditions herein contained, and if FRSA receives an acceptable invoice prior to the tenth day of the month and receives approval of the work by the FRSA's Director of Engineering, FRSA shall issue payment before the fifth day of the succeeding month. If FRSA receives an acceptable invoice on or after the tenth day of the month, FRSA shall issue payment before the fifth day of the second succeeding month.

FRSA reserves the right at all times to refuse to issue payment in case the Contractor has neglected or failed to pay any subcontractors, workmen or employee on the work.

8. Subcontracts

No part of the work herein provided for shall be sublet or subcontracted without the express consent of FRSA, to be entered in the records, and in no case shall consent relieve the Contractor from the obligation herein entered into, or change the terms of this Agreement.

9. Contractor's Responsibility

This Contract shall extend to and be binding upon the successors and assigns, and upon the heirs, administrators, executors, and legal representatives of the Contractor.

In consideration of and to induce the award of this Contract to him, the Contractor represents and warrants: that he is not in arrears to FRSA upon debt of the Contract and that he is not a defaulter, as surety, contractor or otherwise; that he is financially solvent and sufficiently experienced and competent to perform the work; that the work can be performed as called for by the Contract; that the facts stated in his proposal and the information given by him is true and correct in all respects, and that he is fully informed regarding all the conditions affecting the work to be done and labor and materials to be furnished for the completion of this Contract and that his information was secured by personal investigation and research.

The Contractor shall pay not less than the prevailing wage rate as determined by the Department of Labor, to all laborers, workmen and mechanics performing work under this Contract. Contractor shall comply with current revisions of the wage standards; as required by law. The Contractor shall be responsible for verifying the prevailing wages each month and notifying all subcontractors of the appropriate monthly rates. The State of Illinois requires contractors and subcontractors on FRSA projects to submit certified payroll reports via the State's Certified Transcript of Payroll Portal currently found at: <https://labor.illinois.gov/laws-rules/conmed/certifiedtranscriptofpayroll.html>. The Contractor is responsible for verifying current website.

In regard to nondiscrimination in employment, Contractor will be required to comply with the Illinois Fair Employment Practices Commission's Rules and Regulations as provided herein.

The Contractor shall comply with the American Disabilities Act of 1990 (ADA). The Contractor will hold harmless and indemnify FRSA and their representatives from all:

- (a) suits, claims, or actions;
- (b) costs, either for defense (including but not limited to reasonable attorney's fees and expert witness fees) or for settlement, and;
- (c) damages of any kind (including but not limited to actual, punitive, and compensatory damages)

relating in any way to or arising out of the ADA, to which said firm is exposed or which it incurs in the execution of the contract.

Contractor shall also comply with Public Act 101-0221, which requires any party to a contract to adopt and enforce a written policy regarding sexual harassment that includes, as a minimum, the following information:

- (a) the illegality of sexual harassment
- (b) the definition of sexual harassment under Illinois State law;
- (c) a description of sexual harassment, utilizing examples;
- (d) my (our) organization's internal complaint process including penalties;
- (e) through the Illinois Department of Human Rights and the Illinois Human Rights Commission;
- (f) directions on how to contact the Department and the Commission; and
- (g) protection against retaliation as provided by Section 6-101 of the Illinois Human Rights Act.

Upon request this information will be provided to the Illinois Department of Human Rights. Upon FRSA award of a contract, FRSA will be provided this information described no more than ten working days after FRSA issues its award notification.

The Contractor shall comply with Public Act 96-929 (30 ILCS 570) which provides that Illinois residents be employed on Illinois public works projects, provided there has been a period of excessive unemployment (5%) in the State of Illinois as defined in the Act; and further, that Illinois workers are available and capable of performing the particular type work involved.

The Contractor shall comply with all rules and regulations of OSHA during the execution of this Contract.

The Contractor shall comply with the Federal Drug Free Workplace Act.

The Steel Products Procurement Act, Illinois Public Act 83-1030, requires that steel products used or supplied in performance of this Contract or subcontract shall be manufactured or produced in the United States with three exceptions, as explained in the Instructions to Bidders.

The Contractor shall comply with Public Act 96-1416 regarding the disposal of CCDD and uncontaminated soil at CCDD fill sites as explained in the Instructions to Bidders.

10. Time

Work under this Agreement shall be commenced upon written Notice to Proceed. The completion date for this project shall be October 31, 2024.

11. Liquidated Damages

The amount of liquidated damages shall be \$300.00 per calendar day.

12. Counterparts

This Agreement may be executed and recorded in counterparts, each of which shall be deemed an original and all of which, when taken together, shall constitute one and the same instrument. The Parties hereby acknowledge and agree that facsimile signatures or signatures transmitted by electronic mail in so-called "pdf" format shall be legal and binding and shall have the same full force and effect as if an original of this Agreement had been delivered. Each of the parties (a) intend to be bound by the signatures on any document sent by facsimile or electronic mail, (b) are aware that the other party will rely on such signatures, and (c) hereby waive any defenses to the enforcement of the terms of this Agreement based on the foregoing forms of signature.

13. Seals

IN WITNESS WHEREOF, the parties have hereunto set their hands and seals, and such of them as are corporations have caused these presents to be signed by their duly authorized officers.

(Seal)

Four Rivers Sanitation Authority
Winnebago County, Illinois

By _____
President, Board of Trustees

ATTEST: _____
Clerk of the Board

Contractor

(Corporate Seal)

By _____
Contractor's Officer

Name: _____
Title: _____
Date: _____

ATTEST: _____

Not to be used for bidding purposes

Labor & Material Payment Bond

TO: _____ Contractor Name
_____ Contractor City, State

KNOW ALL MEN BY THESE PRESENTS

That _____ (Contractor)

as Principal, and _____

a corporation of the State of _____ as Surety, are held and firmly bound unto the Four Rivers Sanitation Authority, as Obligee, for the use and benefit of claimants as hereinafter defined in the amount of

_____ Dollars (\$ _____), for the payment where of Principal and Surety bind themselves, their heirs, executors, administrators, successors and assigns, jointly and severally, firmly by these presents.

WHEREAS, Principal has by written agreement dated _____ 20__ Entered into a Contract with Obligee for _____ in accordance with contract documents prepared by the Four Rivers Sanitation Authority which Contract is by reference made a part hereof, and is hereinafter referred to as "the Contract".

NOW, THEREFORE, THE CONDITION OF THIS OBLIGATION is such that if Principal shall promptly pay for all laborers, workers and mechanics engaged in the work under the Contract, and not less than the general prevailing rate of hourly wages of a similar character in the locality in which the work is performed, as determined by the State of Illinois Department of Labor pursuant to the Illinois Compiled Statutes 280 ILCS 130 / 1-12 et.seq. and for all material used or reasonably required for use in the performance of the Contract, then this obligation shall be void; otherwise it shall remain in full force and effect.

1. A claimant is deemed as any person, firm, or corporation having contracts with the Principal or with any of Principal's subcontractors for labor or materials furnished in the performance of the Contract on account of which this Bond is given.
2. Nothing in this Bond contained shall be taken to make the Obligee liable to any subcontractor, material man or laborer, or to any other person to any greater extent than it would have been liable prior to the enactment of The Public Construction Bond Act, approved June 20, 1931, as amended; provided further, that any person having a claim for labor and materials furnished in the performance of the Contract shall have no right of action unless he shall have filed a verified notice of such claim with the Obligee within 180 days after the date of the last item of work or the furnishing of the last item of materials, which claim shall have been verified and shall contain the name and address of the claimant, the business address of the claimant within the State of Illinois, if any, or if the claimant be a foreign corporation having no place of business within the State the principal place of business of the corporation, and in all cases of partnership the names and residences of each of the partners, the name of the Contractor

for the Obligee, the name of the person, firm or corporation by whom the claimant was employed or to whom such claimant furnished materials, the amount of the claim and a brief description of the public improvement for the construction or installation of which the contract is to be performed. No defect in the notice herein provided for shall deprive the claimant of its right of action under the terms and provisions of this Bond unless it shall affirmatively appear that such defect has prejudiced the rights of an interested party asserting the same.

3. No action shall be brought on this Bond until the expiration of 120 days after the date of the last item of work or of the furnishing of the last item of material except in cases where the final settlement between Obligee and the Contractor shall have been made prior to the expiration of the 120 day period, in which case action may be taken immediately following such final settlement; nor shall any action of any kind be brought later than 6 months after the acceptance by the Obligee of the work. Such suit shall be brought only in the circuit court of this State in the judicial district in which the Contract is to be performed.
4. Surety hereby waives notice of any changes in the Contract, including extensions of time for the performance thereof.
5. The amount of this Bond shall be reduced by and to the extent of any payment or payments made in good faith hereunder.
6. The Principal and Surety shall be liable for any attorneys' fees, engineering costs, or court costs incurred by the Obligee relative to claims made against this Bond.

Signed and Sealed this _____ day of _____, 20__.

CONTRACTOR

SURETY

Contractor Firm Name

By: _____
Signature

Printed Name

Title

By: _____
Attorney-in-Fact Signature

Printed Name

Resident Agent

ATTEST:

Corporate Secretary (Corporations only)

Performance Bond

KNOW ALL MEN BY THESE PRESENTS, that WHEREAS, the Four Rivers Sanitation Authority has awarded to: _____ hereinafter designated as the “Principal”, a contract, dated, _____, for the Four Rivers Sanitation Authority.

WHEREAS, said Principal is required under the terms of said Contract to furnish a bond for the faithful performance of said Contract (the “Bond”);

NOW, THEREFORE, we the Principal and _____, as Surety, are firmly bound unto the Four Rivers Sanitation Authority in the penal sum of _____

Dollars (\$ _____) lawful money of the United States for the payment of which sum well and truly to be made, we bind ourselves, our heirs, executors, administrators, successors and assigns, jointly and severally firmly by these presents for a performance bond. The conditions of this obligation is such that if the said Principal does well and faithfully performs all the conditions and covenants of said Contract, according to the true intent and meaning thereof, upon its part to be kept and performed, then the above obligation is to be null and void, otherwise to remain in full force and effect.

THE CONDITION OF THIS OBLIGATION IS SUCH, that if the above bounden Principal, its heirs, executors, administrators, successors or assigns, shall in all things stand to and abide by, and well and truly keep and perform the covenants, conditions and agreements in the said Contract, including the provisions for liquidated damages in the said Contract, any changes, additions or alterations thereof made as therein provided, on its part, to be kept and performed at the time and in the manner therein specified, and in all respects according to their true intent and meaning, and shall indemnify and save harmless the Four Rivers Sanitation Authority, its officers and agents, as therein stipulated, then this obligation shall become null and void; otherwise it shall be and remain in full force and effect. And the said Surety, for value received, hereby stipulates and agrees that no change, extension of time, alteration or addition to the terms of the Contract or to the work to be performed thereunder or the specifications accompanying the same and no inadvertent overpayment of progress payments shall in any way affect its obligations on this Bond, and it does hereby waive notice of any such change, extension of time, alteration or addition to the terms of the Contract or to the work or to the specifications or of any inadvertent overpayment of progress payments. The Four Rivers Sanitation Authority shall be named as beneficiary on this Performance Bond.

IN WITNESS WHEREOF, the above-bounden parties have executed this instrument under their seal this _____ day of _____, 20_____, the name and corporate seal of each corporate party being hereto affixed and these presents duly signed by its undersigned representative, pursuant to authority of its governing body.

CONTRACTOR

SURETY

Contractor Firm Name

By: _____
Signature

Printed Name

Title

By: _____
Attorney-in-Fact Signature

Printed Name

Resident Agent

ATTEST:


Corporate Secretary (Corporations only)

Not to be used for bidding purposes

Section III

**Overall Project Location Maps &
Service List**

Not to be used for bidding purposes

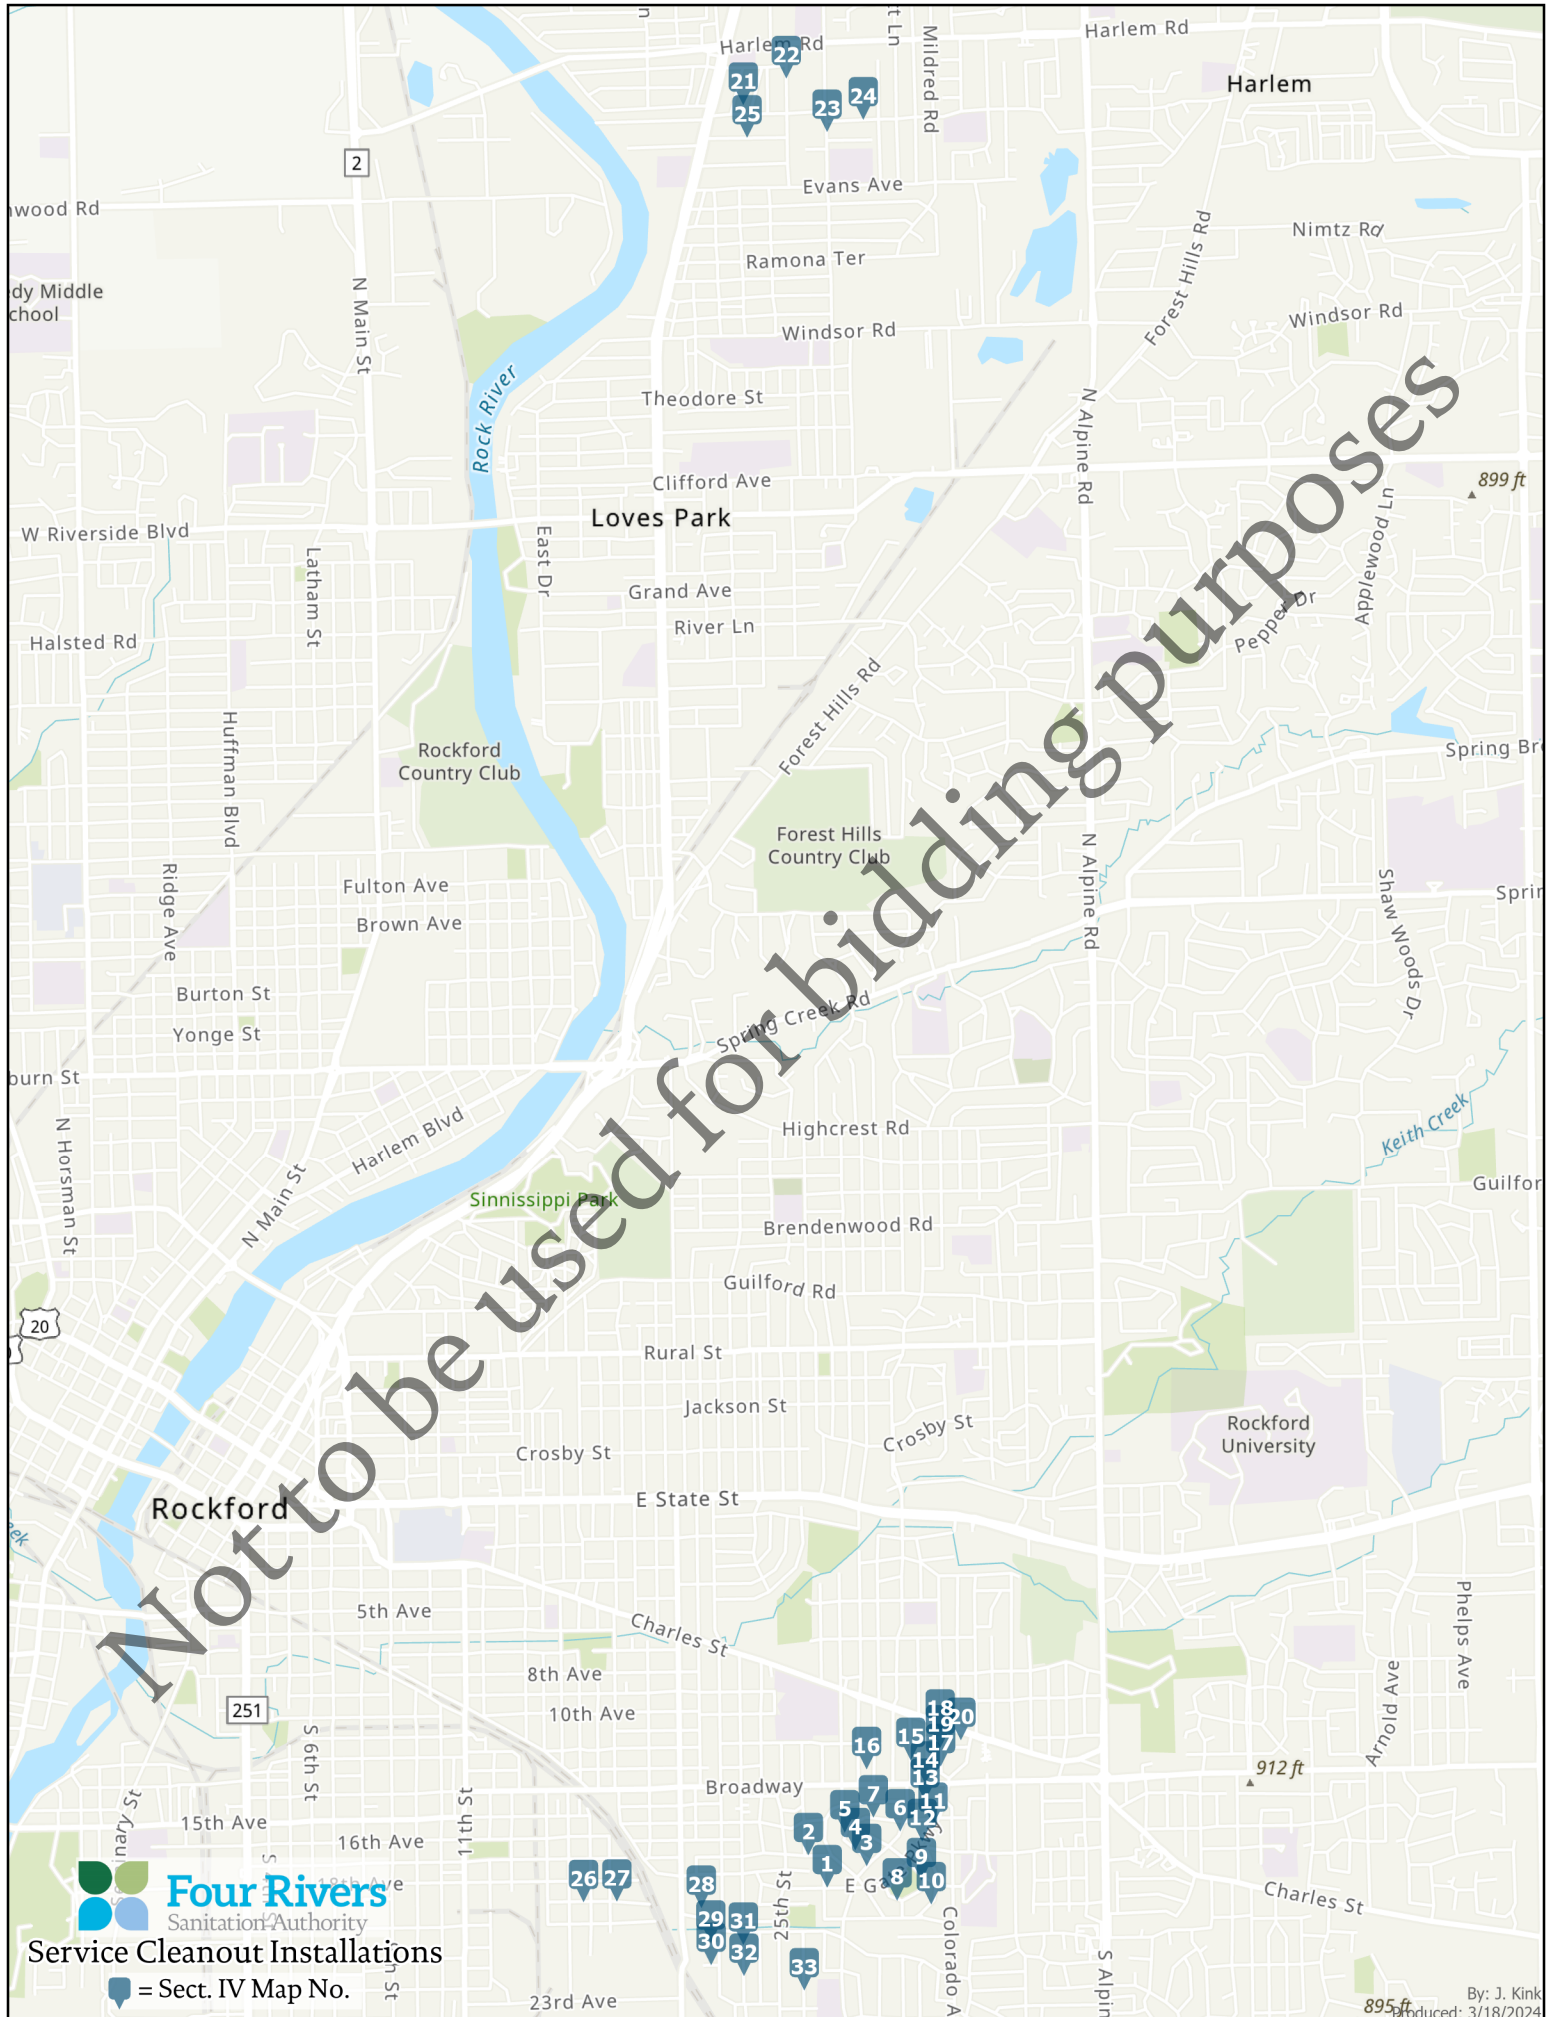

Not to be used for bidding purposes

2024 Service Cleanout Installations
 Capital Project 2501
 Cleanout Repair List

BASE BID Item No.	Address	PIN	UP Basin	UP MH	DN Basin	DN MH	Service Location	Estimated Depth (FT)	Cast Iron Pipe to Curb or Public Roadway ²	Work Description	POTENTIAL CONSTRUCTION RELATED ISSUES ¹								Notes
											Roadway Authority	Map No.	Sidewalk	Curb & Gutter	Driveway (HMA/PCC)	Landscape	OH Utilities	Tree Removal or Trimming	
1	2015 Arizona Avenue	12-31-251-008	017	006	017	005	40.4 NS	9.0	N-CP_081_(1)	6" CO	Rockford	1	Y	N	N	N	N	N	SIDEWALK STEPS
2	2231 Eastgate Parkway	12-31-252-023	017	006	017	005	37.0 NS	8.0	N-CP_081_(1)	6" CO	Rockford	1	Y	N	Y - PCC	N	N	N	
3	3007 18th Avenue	12-31-178-010	017	026	017	162	28.0 WE	12.0	Y-CP_127_(1)	6" CO	Rockford	2	Y	N	N	N	N	N	
4	3012 18th Avenue	12-31-205-009	017	026	017	162	31.6 EW	11.5	CP_127_(1)	Replace w/CO & Saddle Tee - 4"	Rockford	2	Y	Y	N	N	Y	Y	
5	1906 Ohio Parkway	12-31-254-010	017	036	017	166	24.6 SN	7.0	CP_081_(1)	Replace w/CO & Saddle Tee - 6"	Rockford	3	Y	Y	Y - PCC	N	N	N	
6	1908 Ohio Parkway	12-31-254-011	017	036	017	166	39.0 NS	6.0	N-CP_081_(1)	Reconnect 4" PVC w/ Saddle Tee & New Riser	Rockford	3	N	N	N	N	N	N	
7	3207 Maryland Road	12-31-206-041	017	038	017	037	13.0 WE	8.0	N-CP_101_(1)	6" CO	Rockford	4	Y	N	N	N	N	N	SIDEWALK STEP
8	3212 Maryland Road	12-31-209-017	017	038	017	037	46.0 WE	9.0	Y-CP_101_(1)	6" CO	Rockford	4	Y	N	Y - PCC	N	N	N	PCC DRIVEWAY AT 3208 MARYLAND ROAD
9	3215 Maryland Road	12-31-206-043	017	038	017	037	0.0 EW	7.6	N-CP_101_(1)	6" CO	Rockford	4	Y	N	N	Y	N	Y	WOODEN FENCE AND HEAVY LANDSCAPING
10	3219 Maryland Road	12-31-206-044	017	038	017	037	27.5 WE	7.0	N-CP_101_(1)	6" CO	Rockford	4	Y	N	N	N	N	Y	
11	3111 Maryland Road	12-31-206-032	017	040	017	039	1.0 NS	8.5	N-CP_101_(1)	6" CO	Rockford	5	Y	N	Y - PCC	N	N	Y	
12	3115 Maryland Road	12-31-206-033	017	040	017	039	22.0 SN	7.0	Y-CP_101_(1)	6" CO	Rockford	5	Y	N	N	N	N	N	SIDEWALK STEPS
13	3119 Maryland Road	12-31-206-034	017	040	017	039	40.0 NS	9.5	N-CP_101_(1)	6" CO	Rockford	5	Y	N	Y - HMA	Y	N	N	SIDEWALK STEP AND RAILROAD TIE RETAINING WALL
14	3112 Maryland Road	12-31-209-011	017	040	017	039	24.5 NS	11.0	N-CP_101_(1)	6" CO	Rockford	5	Y	N	N	N	N	N	
15	3123 Maryland Road	12-31-206-035	017	040	017	039	36.5 NS	8.2	N-CP_101_(1)	6" CO	Rockford	5	Y	N	Y - PCC	N	N	N	BLOCK RETAINING WALL
16	1710 Ohio Parkway	12-31-230-003	017	048	017	047	44.5 NS	8.0	N-CP_037_(1)	6" CO	Rockford	6	Y	N	N	N	N	N	
17	1714 Ohio Parkway	12-31-230-004	017	048	017	047	28.0 NS	8.6	Y-CP_037_(1)	6" CO	Rockford	6	Y	N	N	N	N	Y	SIDEWALK STEPS
18	1719 Ohio Parkway	12-31-208-026	017	048	017	047	34.3 NS	7.0	N-CP_037_(1)	6" CO	Rockford	6	Y	N	N	N	N	N	
19	3335 California Road	12-31-208-017	017	048	017	047	66.6 NS	8.0	N-CP_037_(1)	6" CO	Rockford	6	Y	N	N	N	Y	N	
20	3227 California Road	12-31-208-006	017	051	017	050	35.0 WE	7.6	N-CP_101_(1)	6" CO	Rockford	7	Y	N	N	N	N	N	
21	3231 California Road	12-31-208-007	017	051	017	050	19.5 WE	8.0	N-CP_101_(1)	6" CO	Rockford	7	Y	N	N	N	N	N	
22	3242 California Road	12-31-207-029	017	051	017	050	28.0 WE	8.0	N-CP_101_(1)	6" CO	Rockford	7	Y	N	N	Y	N	Y	WOODEN RETAINING WALL
23	3303 California Road	12-31-208-009	017	051	017	050	45.0 WE	8.0	N-CP_101_(1)	6" CO	Rockford	7	Y	N	Y - PCC	Y	N	N	
24	3250 California Road	12-31-207-030	017	051	017	050	16.0 WE	8.0	N-CP_101_(1)	6" CO	Rockford	7	Y	N	N	N	N	N	
25	2108 Idaho Parkway	12-31-258-008	017	061	017	060	26.0 EW	8.0	N-CP_043_(1)	6" CO	Rockford	8	Y	N	N	N	N	N	
26	3518 Westgate Parkway	12-31-277-011	017	067	017	066	37.0 SN	7.5	N-CP_043_(1)	6" CO	Rockford	9	Y	N	N	N	N	N	SIDEWALK STEP
27	3526 Westgate Parkway	12-31-277-013	017	067	017	066	30.0 SN	7.5	Y-CP_043_(1)	6" CO	Rockford	9	Y	N	N	N	N	Y	
28	2008 Idaho Parkway	12-31-280-002	017	068	017	067	1.0 NS	7.6	Y-CP_043_(1)	6" CO	Rockford	9	Y	N	N	N	N	Y	SIDEWALK STEPS AND WROUGHT IRON RAILING
29	2012 Idaho Parkway	12-31-280-003	017	068	017	067	31.0 NS	8.0	N-CP_043_(1)	6" CO	Rockford	9	Y	N	N	N	N	Y	
30	2020 Nebraska Road	12-31-281-005	017	073	017	072	30.0 SN	9.0	N-CP_043_(1)	Replace w/CO & Saddle Tee - 6"	Rockford	10	Y	Y	N	N	N	Y	
31	1727 Eastgate Parkway	12-31-230-018	017	085	017	077	18.0 NS	12.0	N-CP_037_(1)	Reconnect 4" PVC w/ Saddle Tee	Rockford	12	N	Y	N	N	N	N	
32	1731 Eastgate Parkway	12-31-230-019	017	085	017	077	1.9 NS	13.0	N-CP_037_(1)	6" CO	Rockford	12	Y	N	Y - SW	N	N	N	DUAL SIDEWALK STRIP DRIVEWAY
33	1708 Eastgate Parkway	12-31-231-002	017	087	017	086	11.5 NS	12.0	N-CP_037_(1)	6" CO	Rockford	11	Y	N	Y - PCC	N	N	N	
34	1703 Eastgate Parkway	12-31-230-014	017	087	017	086	100.6 SN	7.0	N-CP_037_(1)	6" CO	Rockford	11	Y	N	N	Y	N	N	YARD LIGHT POLE
35	3432 Minnesota Drive	12-31-226-021	017	096	017	095	45.4 WE	11.5	N-CP_037_(1)	6" CO	Rockford	13	Y	N	N	N	N	N	
36	3431 Minnesota Drive	12-31-227-008	017	096	017	095	47.8 WE	9.0	N-CP_037_(1)	6" CO	Rockford	13	Y	N	N	N	N	N	
37	3435 Minnesota Drive	12-31-227-009	017	096	017	095	35.4 WE	8.5	N-CP_037_(1)	6" CO	Rockford	13	Y	N	N	N	N	N	
38	3439 Minnesota Drive	12-31-227-010	017	096	017	095	25.0 WE	7.5	N-CP_037_(1)	6" CO	Rockford	13	Y	N	N	N	N	Y	
39	3444 Minnesota Drive	12-31-226-024	017	096	017	095	38.9 WE	8.0	Y-CP_037_(1)	6" CO	Rockford	13	Y	N	N	N	N	Y	
40	3420 Minnesota Drive	12-31-226-018	017	097	017	096	17.4 WE	11.5	N-CP_037_(1)	6" CO	Rockford	13	Y	N	N	N	N	Y	
41	3407 Minnesota Drive	12-31-227-002	017	097	017	096	7.4 WE	7.0	N-CP_037_(1)	6" CO	Rockford	13	Y	N	N	Y	N	Y	
42	3419 Minnesota Drive	12-31-227-005	017	097	017	096	13.4 WE	10.0	N-CP_037_(1)	6" CO	Rockford	13	Y	N	N	N	N	N	
43	3419 Broadway	12-31-226-005	017	104	017	161	6.4 WE	9.7	N-CP_037_(1)	6" CO	Rockford	14	Y	N	Y - PCC	N	N	N	
44	3422 Broadway	12-30-477-047	017	104	017	161	51.0 EW	11.5	N-CP_127_(2)	6" CO	Rockford	14	Y	N	N	N	Y	N	
45	3431 Broadway	12-31-226-008	017	104	017	161	34.3 WE	10.0	N-CP_037_(1)	6" CO	Rockford	14	Y	N	N	N	N	N	
46	1324 Widergren Drive	12-30-477-020	017	111	017	110	29.6 NS	8.5	N-CP_127_(2)	6" CO	Rockford	15	Y	N	Y - HMA	Y	N	N	
47	1331 Widergren Drive	12-30-476-028	017	111	017	110	21.0 NS	8.5	N-CP_127_(2)	6" CO	Rockford	15	Y	N	N	N	N	N	
48	1408 30th Street	12-30-458-020	017	117	017	116	30.4 NS	11.0	N-0122	6" CO	Rockford	16	Y	N	N	Y	N	N	
49	1415 30th Street	12-30-457-018	017	117	017	116	39.0 NS	11.0	N-0122	6" CO	Rockford	16	Y	N	N	N	N	Y	
50	1409 30th Street	12-30-457-017	017	117	017	116	28.7 NS	11.0	N-0122	6" CO	Rockford	16	Y	N	N	N	N	Y	SIDEWALK STEP
51	1403 30th Street	12-30-457-016	017	117	017	116	29.6 NS	11.0	N-0122	6" CO	Rockford	16	Y	N	N	N	N	N	YARD LIGHT POLE AND DECORATIVE PRIVATE STONE/BRICK SIDEWALK
52	1414 30th Street	12-30-458-021	017	117	017	116	20.0 NS	11.0	N-0122	6" CO	Rockford	16	Y	N	N	N	N	N	
53	1411 29th Street	12-30-456-027	017	119	017	118	35.7 NS	8.5	N-0129,CP-126_(1)	Reconnect 4" PVC w/ Saddle Tee	Rockford	16	N	N	N	N	N	N	
54	1411 Florist Drive	12-30-477-042	017	126	017	124	27.0 SN	9.0	Y-CP_127_(2)	6" CO	Rockford	17	Y	N	N	N	N	N	
55	1412 Florist Drive	12-30-479-013	017	126	017	124	22.1 SN	9.0	Y-CP_127_(2)	6" CO	Rockford	17	Y	N	N	N	N	N	
56	1416 Florist Drive	12-30-479-014	017	126	017	124	47.8 SN	9.5	Y-CP_127_(2)	6" CO	Rockford	17	Y	N	N	N	N	N	
57	1204 Florist Drive	12-30-479-001	017	130	017	156	21.4 NS	8.0	Y-CP_127_(2)	6" CO	Rockford	18	Y	N	Y - PCC	N	N	N	YARD LIGHT POLE
58	1207 Florist Drive	12-30-477-007	017	130	017	156	21.0 NS	8.0	Y-CP_127_(2)	6" CO	Rockford	18	Y	N	N	N	N	N	
59	1208 Florist Drive	12-30-479-002	017	130	017	156	25.7 NS	8.0	Y-CP_127_(2)	6" CO	Rockford	18	Y	N	N	N	N	Y	
60	1219 Florist Drive	12-30-478-009	017	130	017	156	26.8 NS	7.0	Y-CP_127_(2)	6" CO	Rockford	18, 19	Y	N	N	N	N	N	
61	1303 Florist Drive	12-30-478-010	017	130	017	156	26.2 SN	8.5	Y-CP_127_(2)	6" CO	Rockford	19	Y	N	N	N	N	N	
62	1308 Florist Drive	12-30-479-006	017	130	017	156	27.5 NS	9.5	Y-CP_127_(2)	6" CO	Rockford	19	Y	N	N	Y	N	N	YARD LIGHT POLE
63	1307 Florist Drive	12-30-478-011	017	130	017	156	24.7 SN	9.5	Y-CP_127_(2)	6" CO	Rockford	19	Y	N	N	N	N	Y	
64	1312 Florist Drive	12-30-479-007	017	130	017	156	31.3 SN	9.5	Y-CP_127_(2)	6" CO	Rockford	19	Y	N	N	N	N	N	
65	3803 Charles Street	12-30-479-017	017	142	017	141	46.0 WE	11.0	N-CP_127_(2)	Replace w/CO & Saddle Tee - 6"	Rockford	20	N	N	N	N	Y	Y	EASEMENT ALONG REAR PROPERTY LINE
66	1205 Eastgate Parkway	12-29-355-002	017	142	017	141	31.0 WE	11.0	N-CP_127_(2)	Replace w/CO & Saddle Tee - 6"	Rockford	20	N	N	N	N	Y	Y	EASEMENT ALONG REAR PROPERTY LINE
67	3807 Charles Street	12-29-355-001	017	142	017	141	4.0 WE	11.0	N-CP_127_(2)	Replace w/CO & Saddle Tee - 6"	Rockford	20	N	N	N	N	Y	Y	EASEMENT ALONG REAR PROPERTY LINE
68	1315 Florist Drive	12-30-478-013	017	156	017	126	36.0 NS	9.0	Y-CP_127_(2)	6" CO	Rockford	19	Y	N	N	N	N	Y	SIDEWALK STEPS
69	1320 Florist Drive	12-30-479-009	017	156	017	126	36.0 NS	9.5	Y-CP_127_(2)	6" CO	Rockford	19	Y	N	N	N	N	N	
70	1323 Florist Drive	12-30-478-015	017	156	017	126	43.0 NS	9.0	Y-CP_127_(2)	6" CO	Rockford	17	Y	N	N	N	N	N	SIDEWALK STEPS, WROUGHT IRON RAILING, AND YARD LIGHT POLE
71	2227 Eastgate Parkway	12-31-252-016	017	164	017	021	39.4 EW	7.0	Y-CP_081_(1)	Replace w/CO & Saddle Tee - 6"	Rockford	1	Y	Y	Y - PCC	Y	N	N	
72	1818 26th Street	12-31-134-011	017	167	017	026	25.0 NS	12.0	N-6720	6" CO	Rockford	2	Y	N	N	N	N	N	

BASE BID Item No.	Address	PIN	UP Basin	UP MH	DN Basin	DN MH	Service Location	Estimated Depth (FT)	Cast Iron Pipe to Curb or Public Roadway ²	Work Description	Roadway Authority	Map No.	Sidewalk	Curb & Gutter	Driveway (HMA/PCC)	Landscape	OH Utilities	Tree Removal or Trimming	Notes
74	7516 Grenville Street	08-31-127-028	123	022	123	021	32.0SN	9.5	N-0438	Replace w/CO & Saddle Tee - 6"	Machesney Park	21	N	N	N	Y	Y	N	MAILBOX. COORDINATE WITH VILLAGE OF MACHESNEY PARK.
75	7519 Grenville Street	08-31-128-010	123	022	123	021	41.0SN	9.5	N-0438	Reconnect 4" PVC w/ Saddle Tee	Machesney Park	21	N	N	N	N	Y	N	MAILBOX. COORDINATE WITH NORTH PARK WATER AND VILLAGE OF MACHESNEY PARK.
76	7521 Borodell Street	08-31-129-009	123	027	123	026	4.0SN	7.6	N-0439	6" CO	Machesney Park	21	N	N	N	N	Y	Y	CHAIN LINK FENCE
77	7520 Borodell Street	08-31-128-030	123	027	123	026	36.0SN	9.5	Y-0439	6" CO	Machesney Park	21	N	N	N	N	N	N	
78	7513 Borodell Street	08-31-129-011	123	027	123	026	45.0SN	8.0	N-0439	6" CO	Machesney Park	21	N	N	N	N	Y	N	
79	7502 Borodell Street	08-31-128-026	123	027	123	026	18.0NS	8.0	N-0439	6" CO	Machesney Park	21	N	N	Y - HMA/PCC	N	N	N	WOODEN FENCE
80	7636 Rogers Street	08-31-130-023	123	036	123	035	14.0NS	8.0	N-0436	6" CO	Machesney Park	22	Y	N	N	N	N	N	STORM SEWER STRUCTURE BETWEEN SIDEWALK AND CURB
81	7632 Rogers Street	08-31-130-015	123	036	123	035	12.5SN	8.5	N-0436	6" CO	Machesney Park	22	Y	N	N	N	N	N	
82	7607 Elm Avenue	08-31-252-035	123	051	123	050	80.6NS	6.5	N-0829	6" CO	Machesney Park	23	Y	N	N	N	N	Y	
83	1028 Maple Avenue	08-31-202-043	123	055	123	054	9.0EW	6.0	N-0555	6" CO	Machesney Park	24	N	N	N	N	Y	Y	
84	1020 Maple Avenue	08-31-202-041	123	055	123	054	25.0EW	7.0	N-0555	6" CO	Machesney Park	24	N	N	N	N	Y	N	MAILBOX
85	628 Sycamore Lane	08-31-176-022	123	071	123	070	31.0WE	8.0	N-0360	6" CO	Machesney Park	25	N	N	N	N	Y	N	
86	702 Sycamore Lane	08-31-176-024	123	071	123	070	15.0EW	6.0	N-0360	6" CO	Machesney Park	25	N	N	Y - HMA	N	Y	N	
87	2015 19th Avenue	11-36-260-004	011	024	011	023	30.0EW	7.5	N-CP_021_(2)	6" CO	Rockford	26	Y	N	N	N	Y	N	CONCRETE STEPS AND WROUGHT IRON RAILING
88	2022 19th Avenue	11-36-257-012	011	024	011	023	11.6WE	7.5	N-CP_021_(2)	6" CO	Rockford	26	Y	N	N	N	N	N	
89	2203 19th Avenue	11-36-280-001	011	027	011	026	13.2EW	7.5	N-CP_021_(2)	6" CO	Rockford	27	Y	N	N	N	Y	N	
90	2204 19th Avenue	11-36-278-013	011	027	011	026	23.1EW	7.1	N-CP_021_(2)	6" CO	Rockford	27	Y	N	N	N	N	N	
91	2205 19th Avenue	11-36-280-002	011	027	011	026	19.7EW	7.3	N-CP_021_(2)	6" CO	Rockford	27	Y	N	N	Y	Y	N	
92	2215 19th Avenue	11-36-280-004	011	027	011	026	20.6EW	7.4	N-CP_021_(2)	6" CO	Rockford	27	Y	N	N	N	Y	Y	
93	2032 21st Street	12-31-153-028	011	064	011	063	44.0SN	8.5	N-CP_248	6" CO	Rockford	28	Y	N	N	N	N	N	
94	2103 21st Street	12-31-153-022	011	064	011	063	46.0SN	9.0	N-CP_248	Reconnect 4" PVC w/ Saddle Tee	Rockford	28	N	N	N	N	N	N	
95	2108 21st Street	12-31-153-030	011	064	011	063	16.0NS	9.0	N-CP_248	6" CO	Rockford	28	Y	N	N	N	N	Y	
96	2420 Wesleyan Avenue	12-31-153-053	011	064	011	063	46.0SN	9.0	N-CP_248	6" CO	Rockford	28	Y	N	N	N	N	N	
97	2207 22nd Street	12-31-301-007	011	073	011	180	42.3NS	9.0	N-CP_201_(2)	6" CO	Rockford	29	Y	N	N	Y	N	Y	
98	2516 Heritage Court	12-31-301-003	011	074	011	073	26.0WE	5.0	N-CP_201_(2)	6" CO	Rockford	29	Y	N	N	N	N	N	
99	2519 Heritage Court	12-31-301-013	011	074	011	073	24.0WE	7.0	N-CP_201_(2)	6" CO	Rockford	29	Y	N	N	N	N	N	
100	2520 Heritage Court	12-31-301-004	011	074	011	073	23.0WE	6.0	N-CP_201_(2)	6" CO	Rockford	29	Y	N	N	N	N	N	YARD LIGHT POLE
101	2523 Heritage Court	12-31-301-014	011	074	011	073	23.8WE	11.5	N-CP_201_(2)	6" CO	Rockford	29	Y	N	N	N	N	N	
102	2524 Heritage Court	12-31-301-005	011	074	011	073	33.0WE	9.0	N-CP_201_(2)	6" CO	Rockford	29	Y	N	N	N	N	N	
ALTERNATE Item No.	Address	PIN	UP Basin	UP MH	DN Basin	DN MH	Service Location	Estimated Depth (FT)	Cast Iron Pipe to Curb or Public Roadway ²	Work Description	Roadway Authority	Map No.	Sidewalk	Curb & Gutter	Driveway (HMA/PCC)	Landscape	OH Utilities	Tree Removal or Trimming	Notes
1001	2527 Heritage Court	12-31-301-015	011	074	011	073	21.0WE	9.5	N-CP_201_(2)	6" CO	Rockford	29	Y	N	N	N	N	Y	
1002	2215 22nd Street	12-31-301-016	011	074	011	073	36.5WE	14.0	N-CP_201_(2)	6" CO	Rockford	29	Y	N	N	Y	N	N	
1003	2515/2517 Pilgrim Court	12-31-301-027	011	077	011	076	41.0WE	10.0	N-CP_201_(2)	6" CO	Rockford	30	Y	N	N	N	N	Y	
1004	2520 Pilgrim Court	12-31-301-021	011	077	011	076	33.0WE	8.5	N-CP_201_(2)	6" CO	Rockford	30	Y	N	N	N	N	Y	
1005	2208 23rd Street	12-31-303-002	011	092	011	088	34.0SN	9.5	N-CP_201_(2)	6" CO	Rockford	31	Y	N	N	Y	N	N	
1006	2215 23rd Street	12-31-302-024	011	092	011	088	30.0SN	8.0	Y-CP_201_(2)	6" CO	Rockford	31	Y	N	N	N	Y	N	
1007	2216 23rd Street	12-31-303-004	011	092	011	088	36.0NS	9.5	N-CP_201_(2)	6" CO	Rockford	31	Y	N	N	N	N	N	
1008	2320 23rd Street	12-31-303-011	011	094	011	093	34.0SN	7.0	N-CP_201_(2)	6" CO	Rockford	32	Y	N	N	N	N	Y	
1009	2407 26th Street	12-31-327-036	011	116	011	115	37.5NS	9.5	N-CP_185_(1)	6" CO	Rockford	33	Y	N	N	N	N	N	
1010	2411 26th Street	12-31-327-037	011	116	011	115	21.7SN	9.5	N-CP_185_(1)	6" CO	Rockford	33	Y	N	N	N	Y	N	



Notes

- "Potential Construction Related Issues" indicated above are based on FRSA site inspections and are provided as a courtesy. Contractor is responsible to inspect the project site(s) prior to preparing their bid to determine impact of existing conditions to the proposed work.
- "Cast Iron Pipe to Curb or Public Roadway" - This column indicates if existing service pipe from the building served extends into the public right of way (Indicated Y = Yes, N = No). The FRSA Construction Record Drawing number used to make the determination is also listed. Where indicated (Y), Contractor shall assume removal and replacement of PCC curb and gutter and pavement

Not to be used for Bidding Purposes

Section IV
Individual Location Maps


Not to be used for bidding purposes

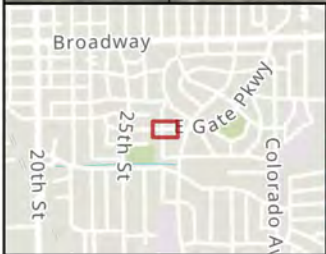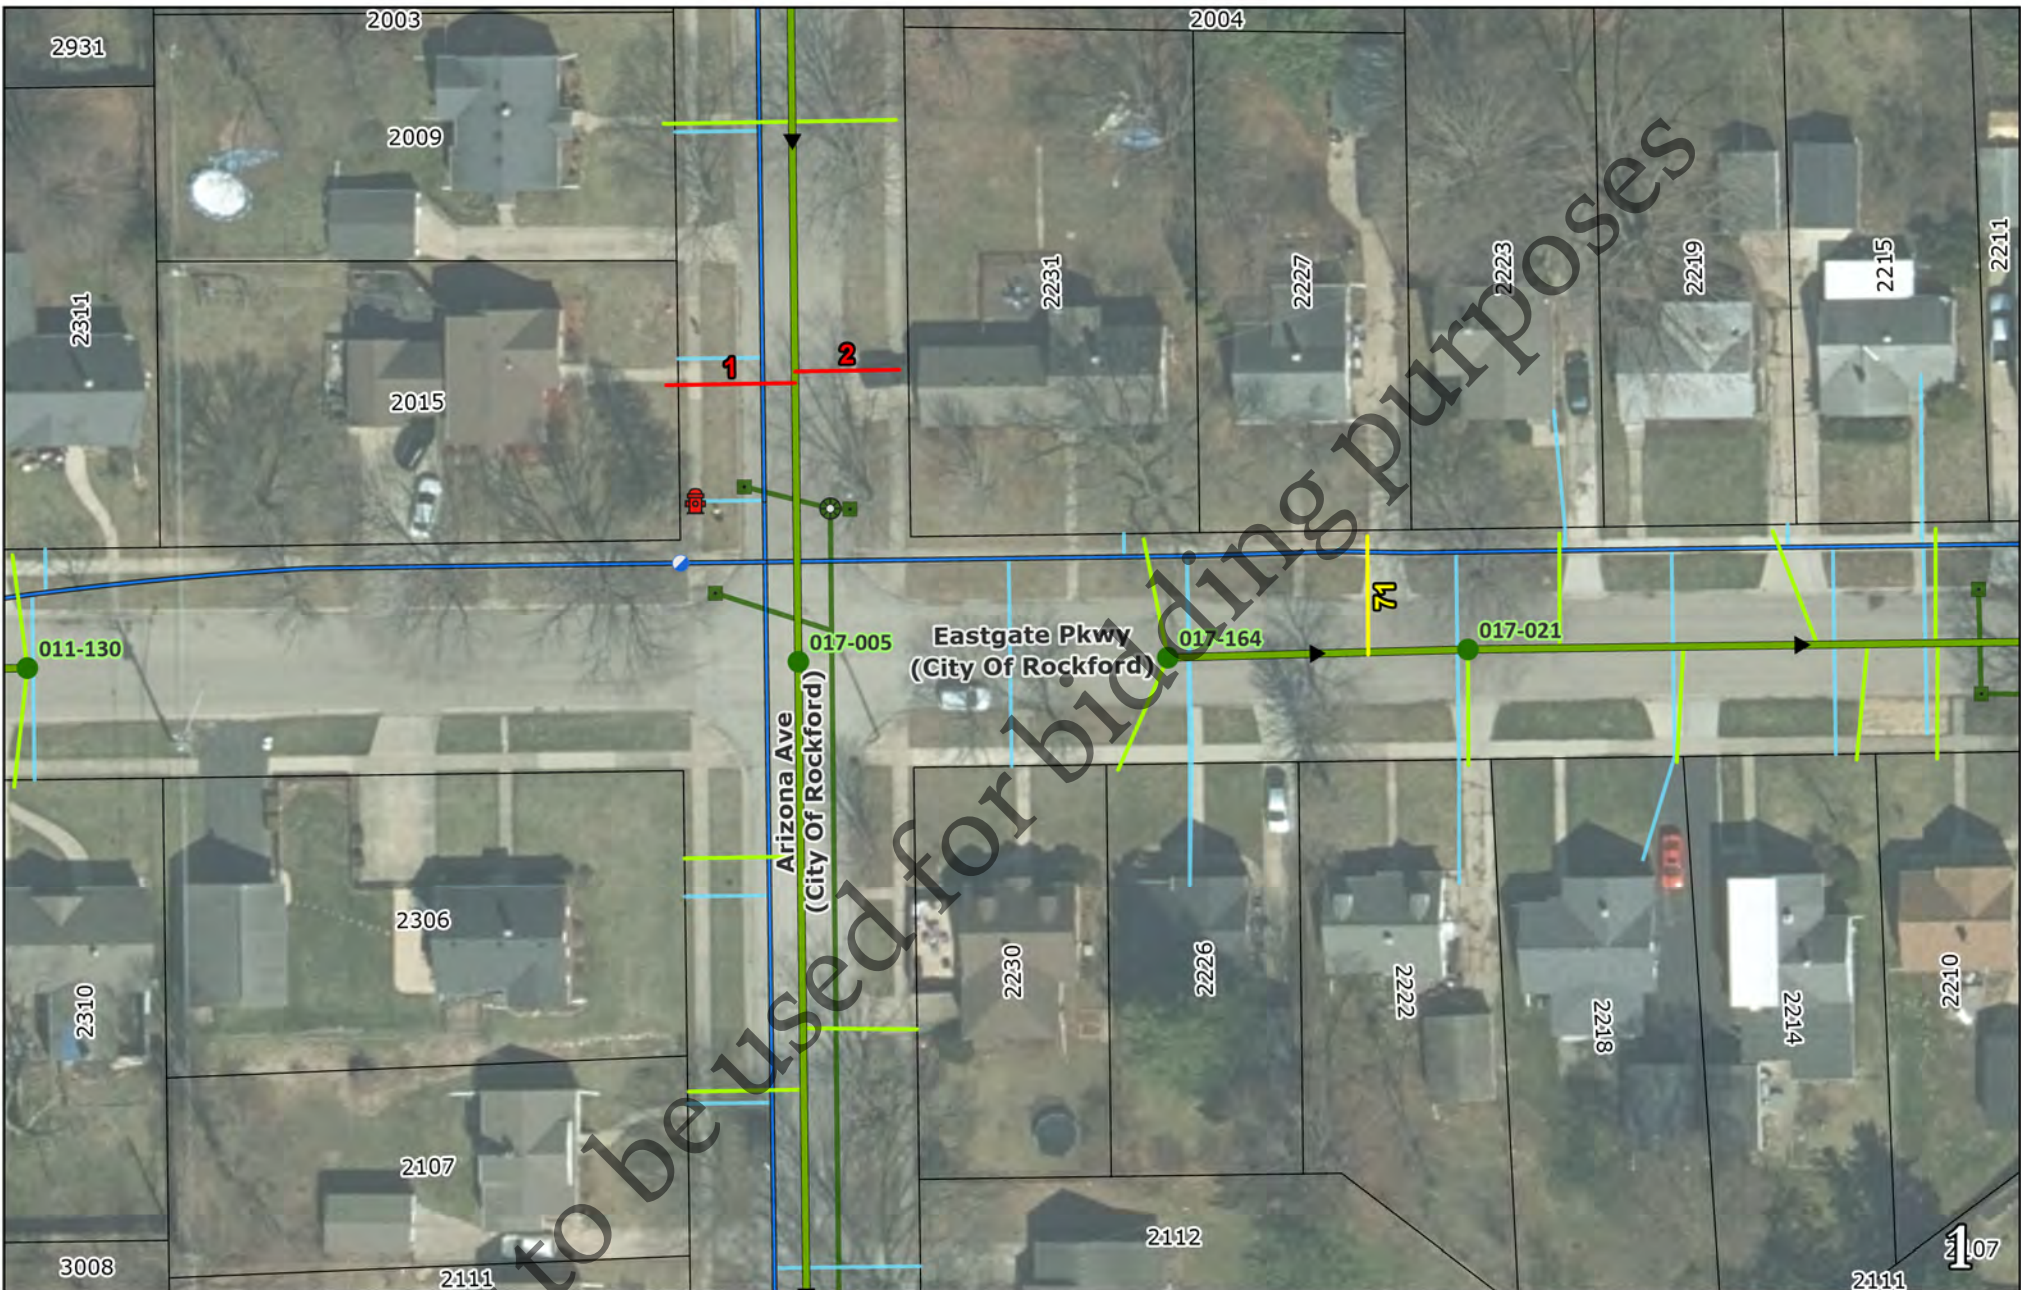

Service Cleanout Installations


Capital Project 2501

- Cleanout Installation
- Service Reconnection
- Service Replacement
- Sanitary Mains
- Watermain
- Storm Sewer



1 inch = 50 ft


Produced: 3/13/2024 By: J. Kink

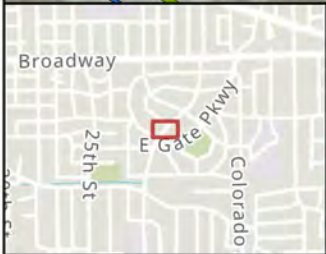

Service Cleanout Installations


Capital Project 2501

- Cleanout Installation
- Service Reconnection
- Service Replacement
- Sanitary Mains
- Watermain
- Storm Sewer



1 inch = 50 ft

Produced: 3/13/2024 By: J. Kink

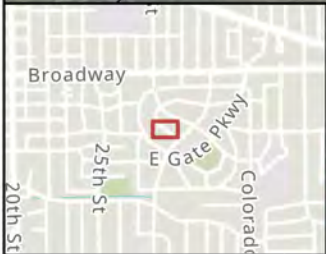



Service Cleanout Installations

Capital Project 2501

- Cleanout Installation
- Service Reconnection
- Service Replacement
- Sanitary Mains
- Watermain
- Storm Sewer

1 inch = 50 ft


Produced: 3/13/2024 By: J. Kink

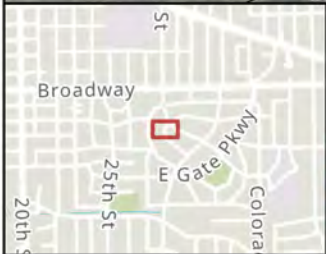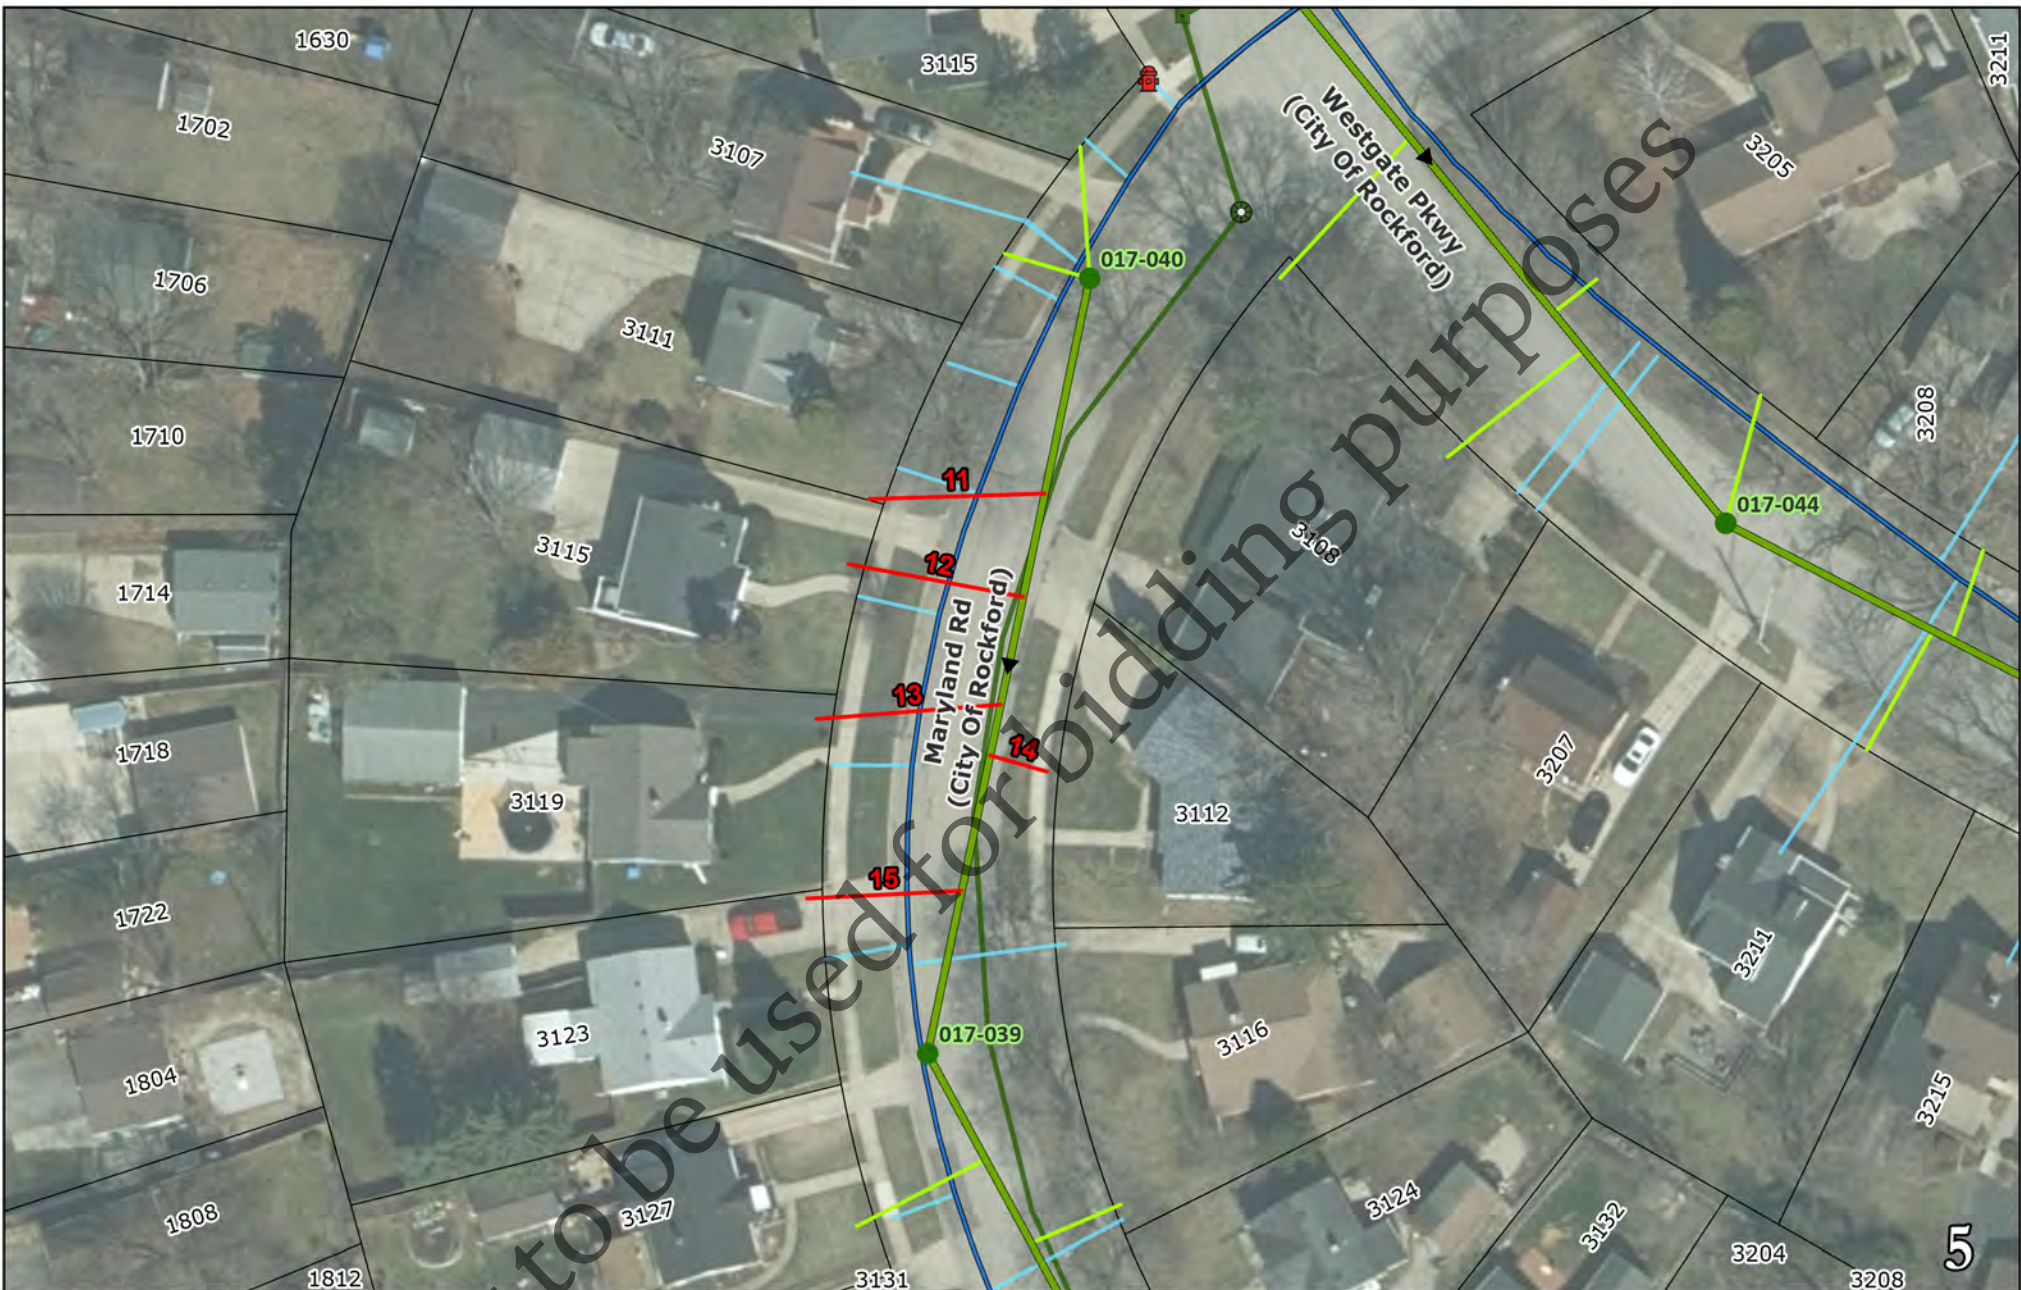

Service Cleanout Installations

Capital Project 2501


- Cleanout Installation
- Service Reconnection
- Service Replacement
- Sanitary Mains
- Watermain
- Storm Sewer



1 inch = 50 ft

Produced: 3/13/2024 By: J. Kink


Not to be used for bidding purposes

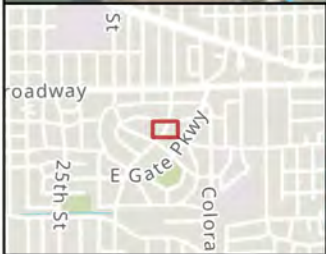

Service Cleanout Installations

Capital Project 2501



- Cleanout Installation
- Service Reconnection
- Service Replacement
- Sanitary Mains
- Watermain
- Storm Sewer



1 inch = 50 ft

Produced: 3/13/2024 By: J. Kink

6

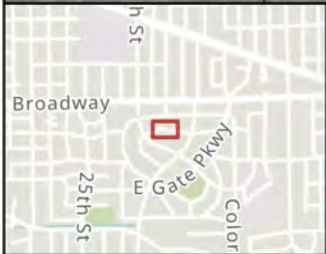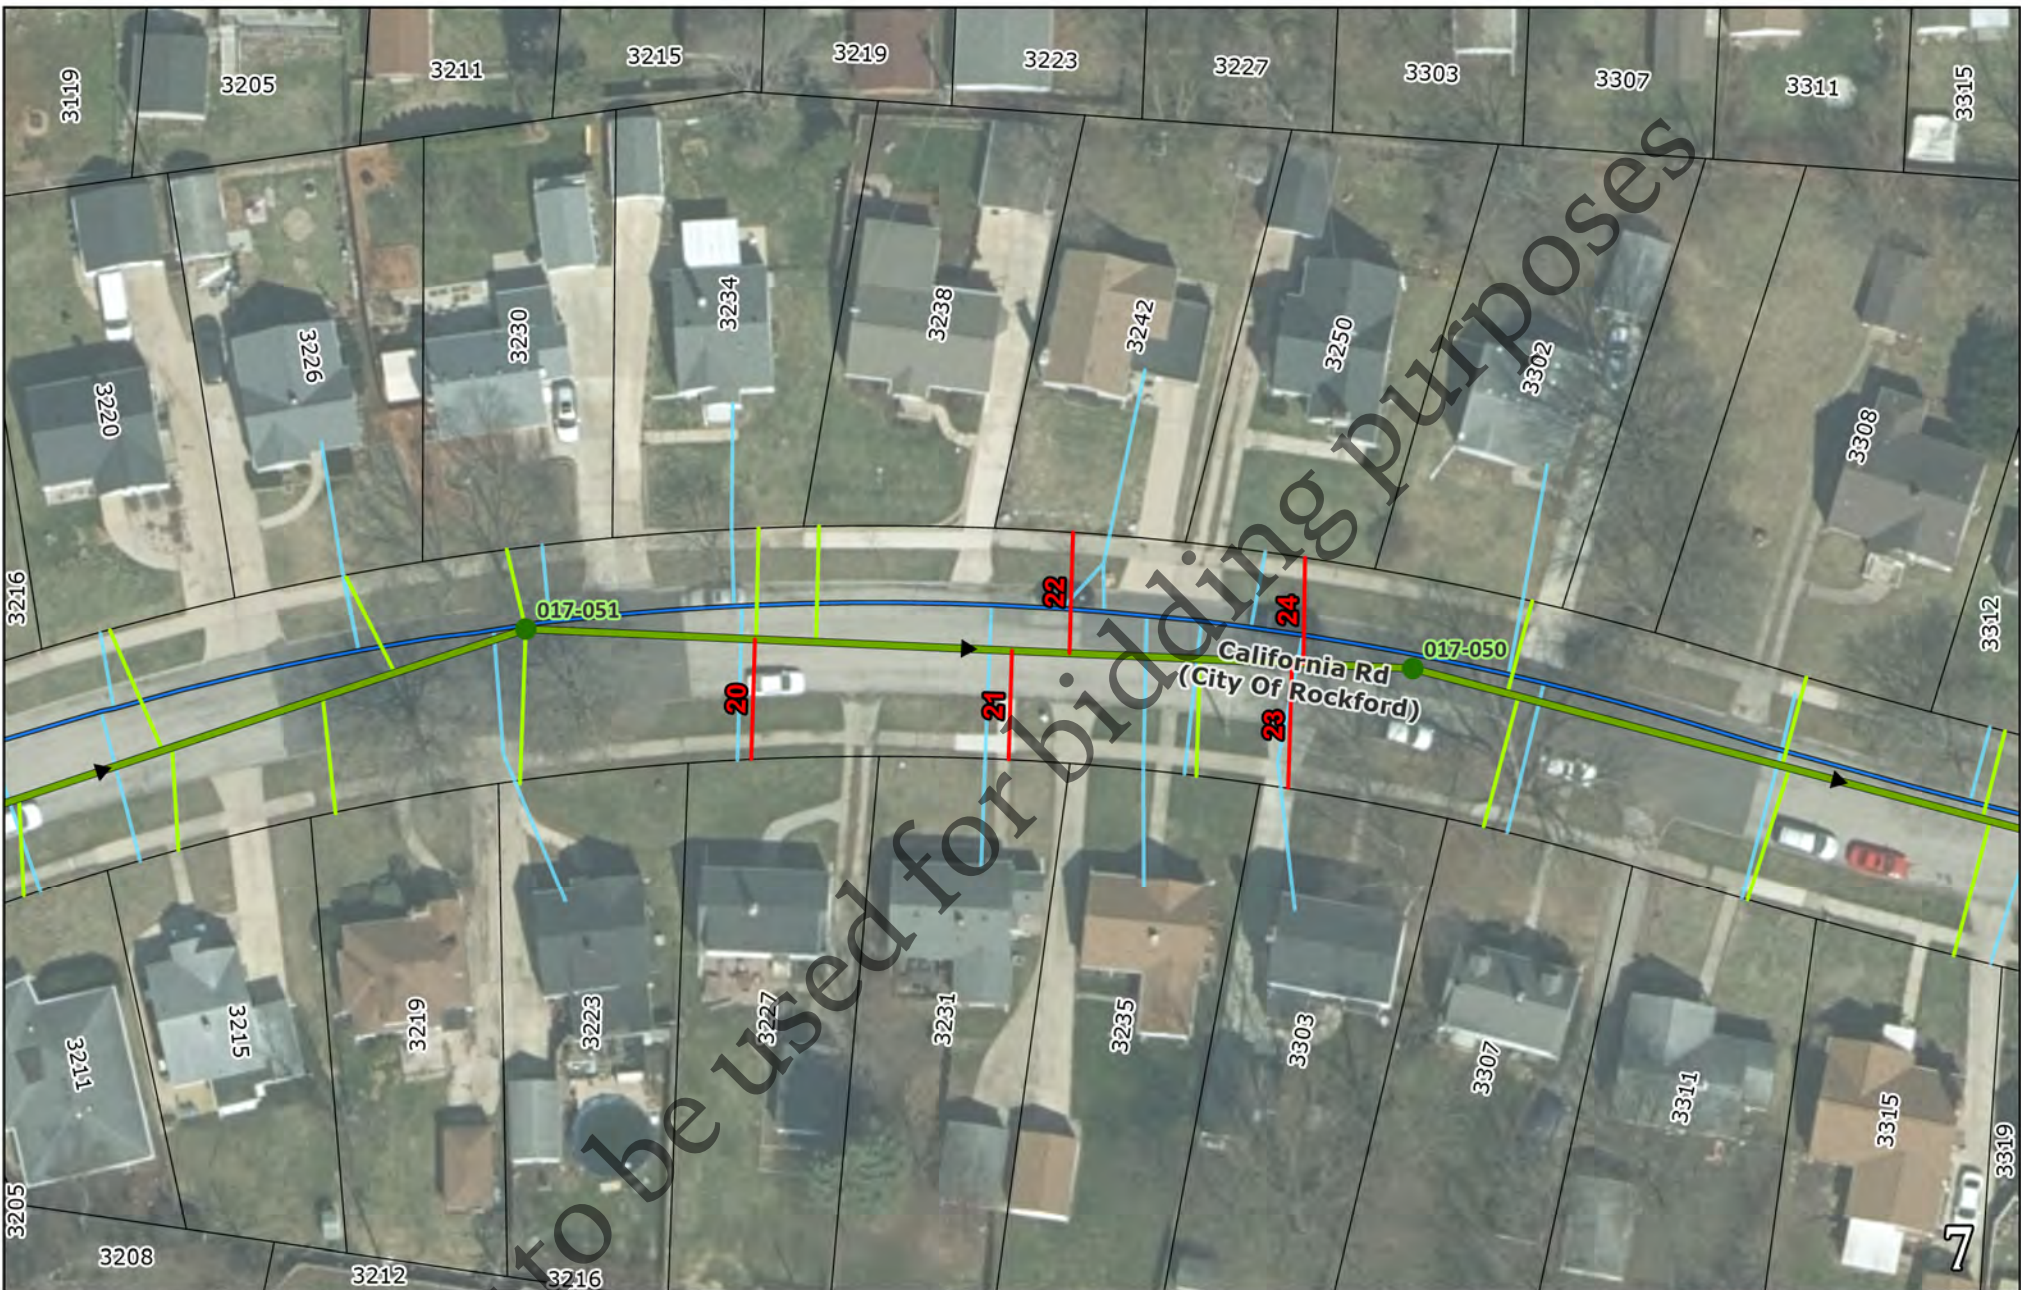


Service Cleanout Installations

Capital Project 2501

- Cleanout Installation
- Service Reconnection
- Service Replacement
- Sanitary Mains
- Watermain
- Storm Sewer


N
 1 inch = 50 ft
 Produced: 3/13/2024 By: J. Kink

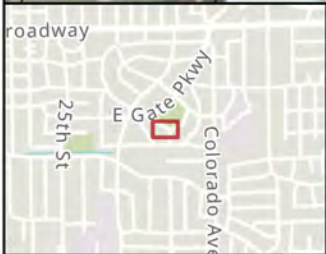

Service Cleanout Installations

Capital Project 2501


- Cleanout Installation
- Service Reconnection
- Service Replacement
- ▶ Sanitary Mains
- Watermain
- Storm Sewer



1 inch = 50 ft

Produced: 3/13/2024 By: J. Kink

Not to be used for bidding purposes

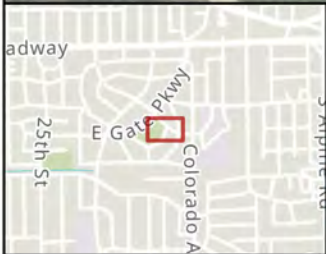

Service Cleanout Installations


Capital Project 2501

	Cleanout Installation
	Service Reconnection
	Service Replacement
	Sanitary Mains
	Watermain
	Storm Sewer

Produced: 3/13/2024

By: J. Kink


1 inch = 70 ft

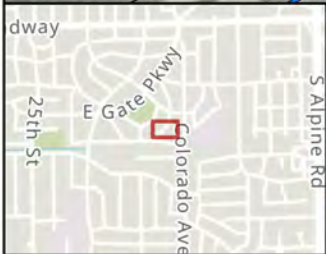

Service Cleanout Installations

Capital Project 2501

- Cleanout Installation
- Service Reconnection
- Service Replacement
- Sanitary Mains
- Watermain
- Storm Sewer




1 inch = 50 ft

Produced: 3/13/2024 By: J. Kink



11

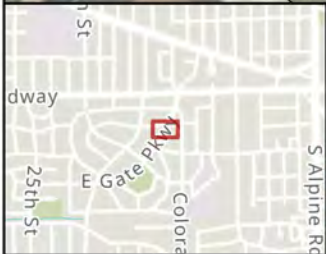

Service Cleanout Installations


Capital Project 2501

- Cleanout Installation
- Service Reconnection
- Service Replacement
- Sanitary Mains
- Watermain
- Storm Sewer



1 inch = 50 ft

Produced: 3/13/2024 By: J. Kink

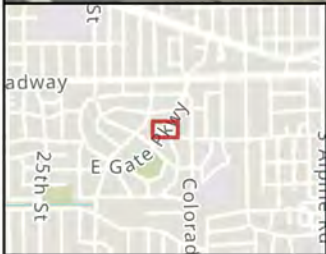



Service Cleanout Installations

Capital Project 2501

	Cleanout Installation
	Service Reconnection
	Service Replacement
	Sanitary Mains
	Watermain
	Storm Sewer

1 inch = 50 ft

Produced: 3/13/2024 By: J. Kink

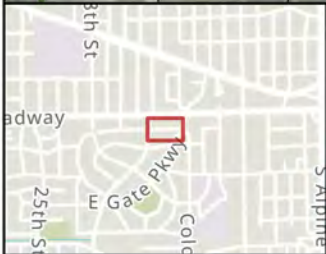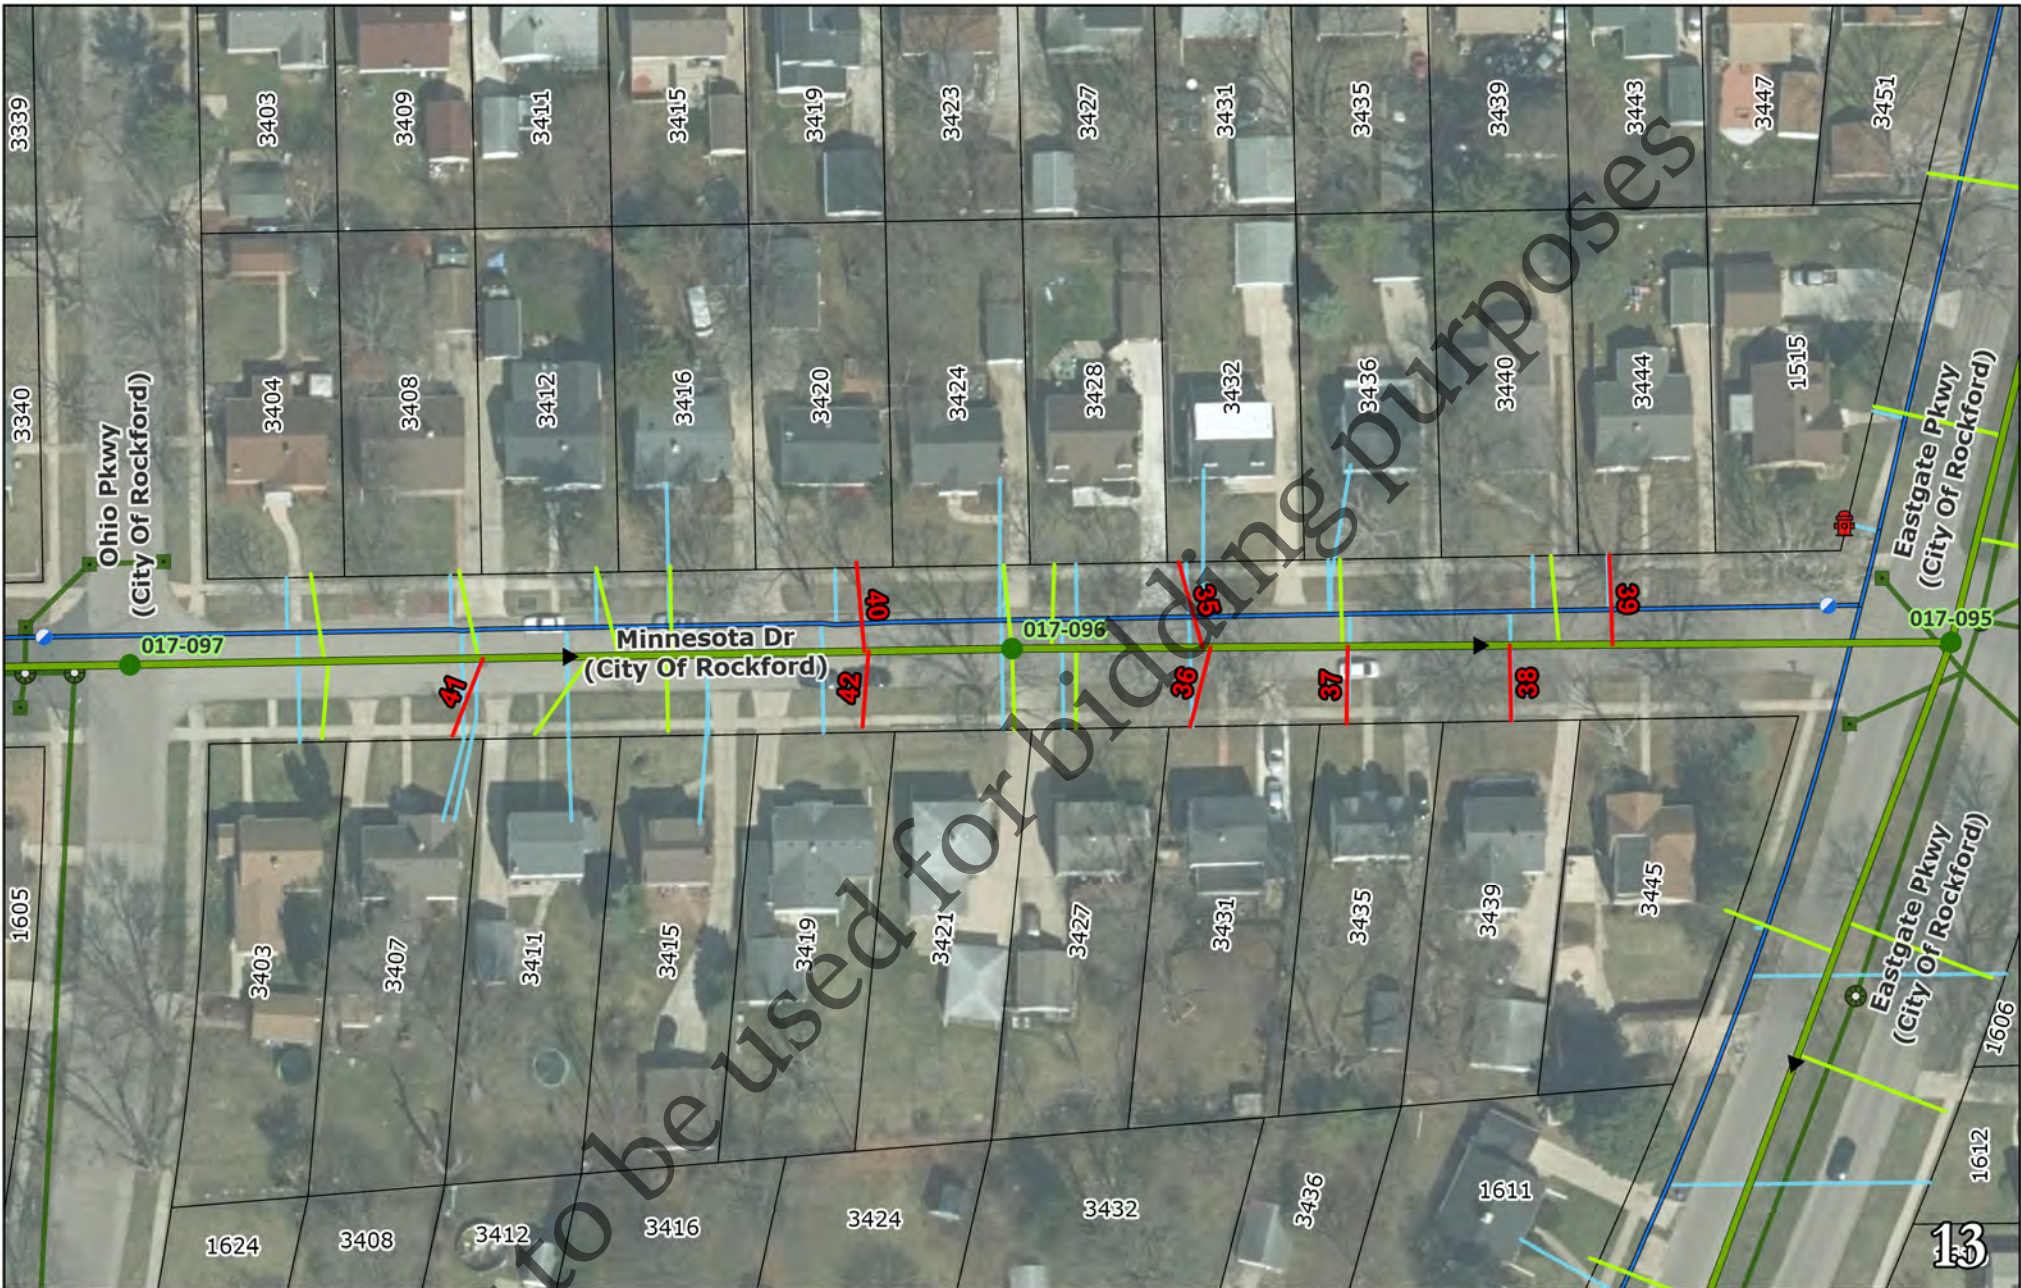


Service Cleanout Installations

Capital Project 2501

- Cleanout Installation
- Service Reconnection
- Service Replacement
- Sanitary Mains
- Watermain
- Storm Sewer

1 inch = 70 ft

Produced: 3/13/2024 By: J. Kink

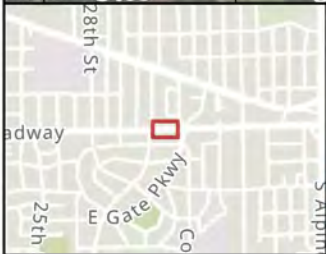


Service Cleanout Installations

Capital Project 2501

	Cleanout Installation
	Service Reconnection
	Service Replacement
	Sanitary Mains
	Watermain
	Storm Sewer

1 inch = 50 ft
 Produced: 3/13/2024 By: J. Kink

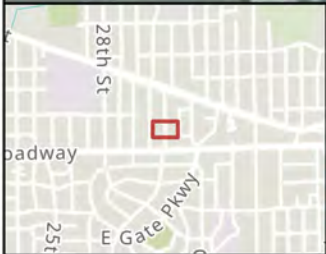


Service Cleanout Installations

Capital Project 2501

- Cleanout Installation
- Service Reconnection
- Service Replacement
- ▶ Sanitary Mains
- Watermain
- Storm Sewer

1 inch = 50 ft


Produced: 3/13/2024 By: J. Kink

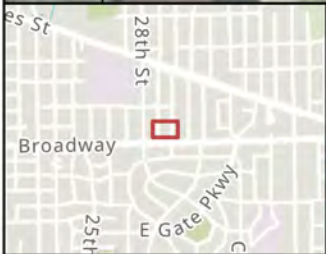

Service Cleanout Installations


Capital Project 2501

—	Cleanout Installation
—	Service Reconnection
—	Service Replacement
—	Sanitary Mains
—	Watermain
—	Storm Sewer



1 inch = 50 ft

Produced: 3/13/2024 By: J. Kink

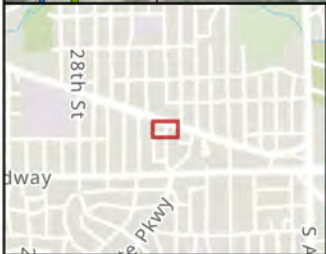


Service Cleanout Installations

Capital Project 2501

- Cleanout Installation
- Service Reconnection
- Service Replacement
- Sanitary Mains
- Watermain
- Storm Sewer

1 inch = 50 ft

Produced: 3/13/2024 By: J. Kink

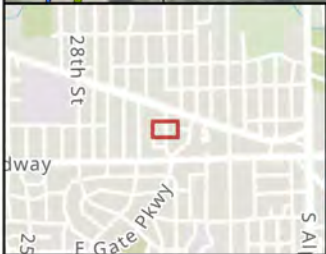



Service Cleanout Installations

Capital Project 2501

- Cleanout Installation
- Service Reconnection
- Service Replacement
- Sanitary Mains
- Watermain
- Storm Sewer

1 inch = 50 ft

Produced: 3/13/2024 By: J. Kink

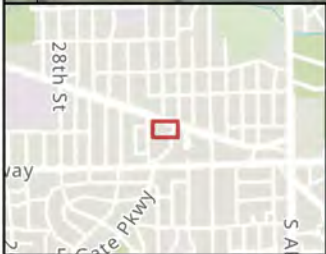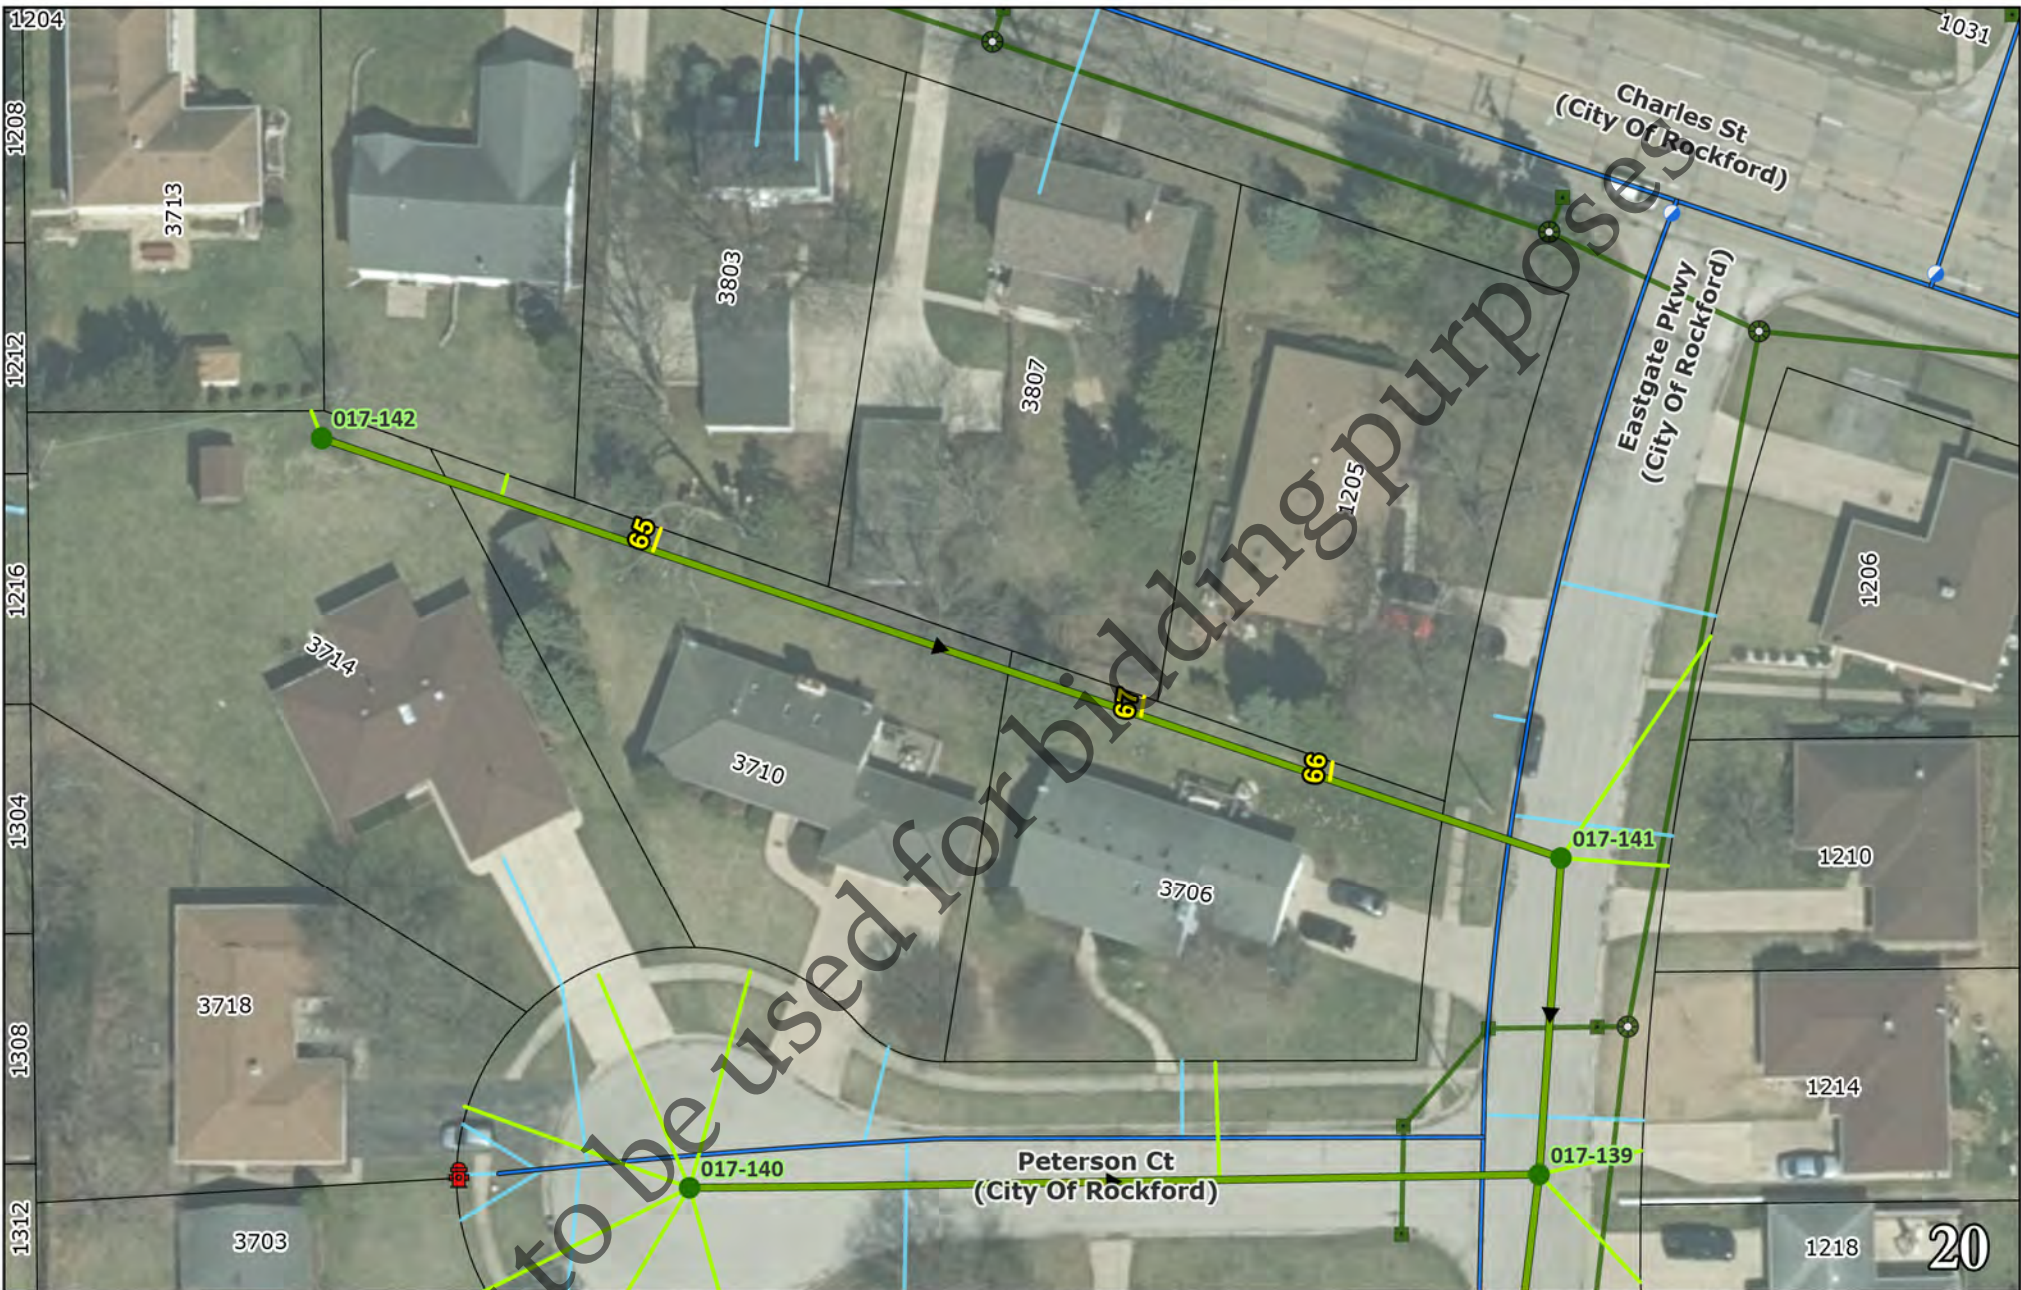


Service Cleanout Installations

Capital Project 2501

- Cleanout Installation
- Service Reconnection
- Service Replacement
- Sanitary Mains
- Watermain
- Storm Sewer

1 inch = 50 ft

Produced: 3/13/2024 By: J. Kink

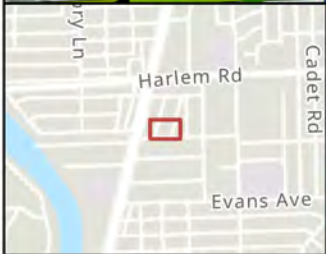


Service Cleanout Installations

Capital Project 2501

- Cleanout Installation
- Service Reconnection
- Service Replacement
- Sanitary Mains
- Watermain
- Storm Sewer

1 inch = 60 ft

Produced: 3/13/2024 By: J. Kink

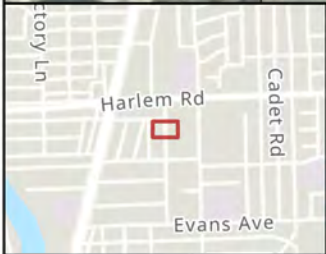


Service Cleanout Installations

Capital Project 2501

- Cleanout Installation
- Service Reconnection
- Service Replacement
- Sanitary Mains
- Watermain
- Storm Sewer

1 inch = 50 ft

Produced: 3/13/2024 By: J. Kink

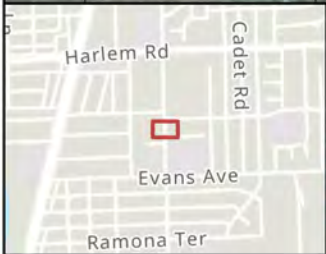

Service Cleanout Installations


Capital Project 2501

- Cleanout Installation
- Service Reconnection
- Service Replacement
- ▶ Sanitary Mains
- Watermain
- Storm Sewer



1 inch = 50 ft

Produced: 3/13/2024 By: J. Kink

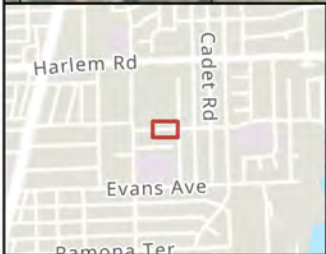



Service Cleanout Installations

Capital Project 2501

- Cleanout Installation
- Service Reconnection
- Service Replacement
- Sanitary Mains
- Watermain
- Storm Sewer

1 inch = 50 ft

Produced: 3/13/2024 By: J. Kink

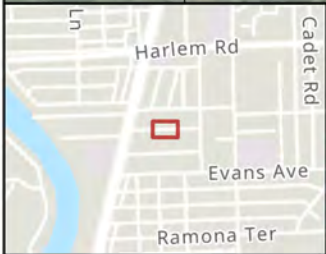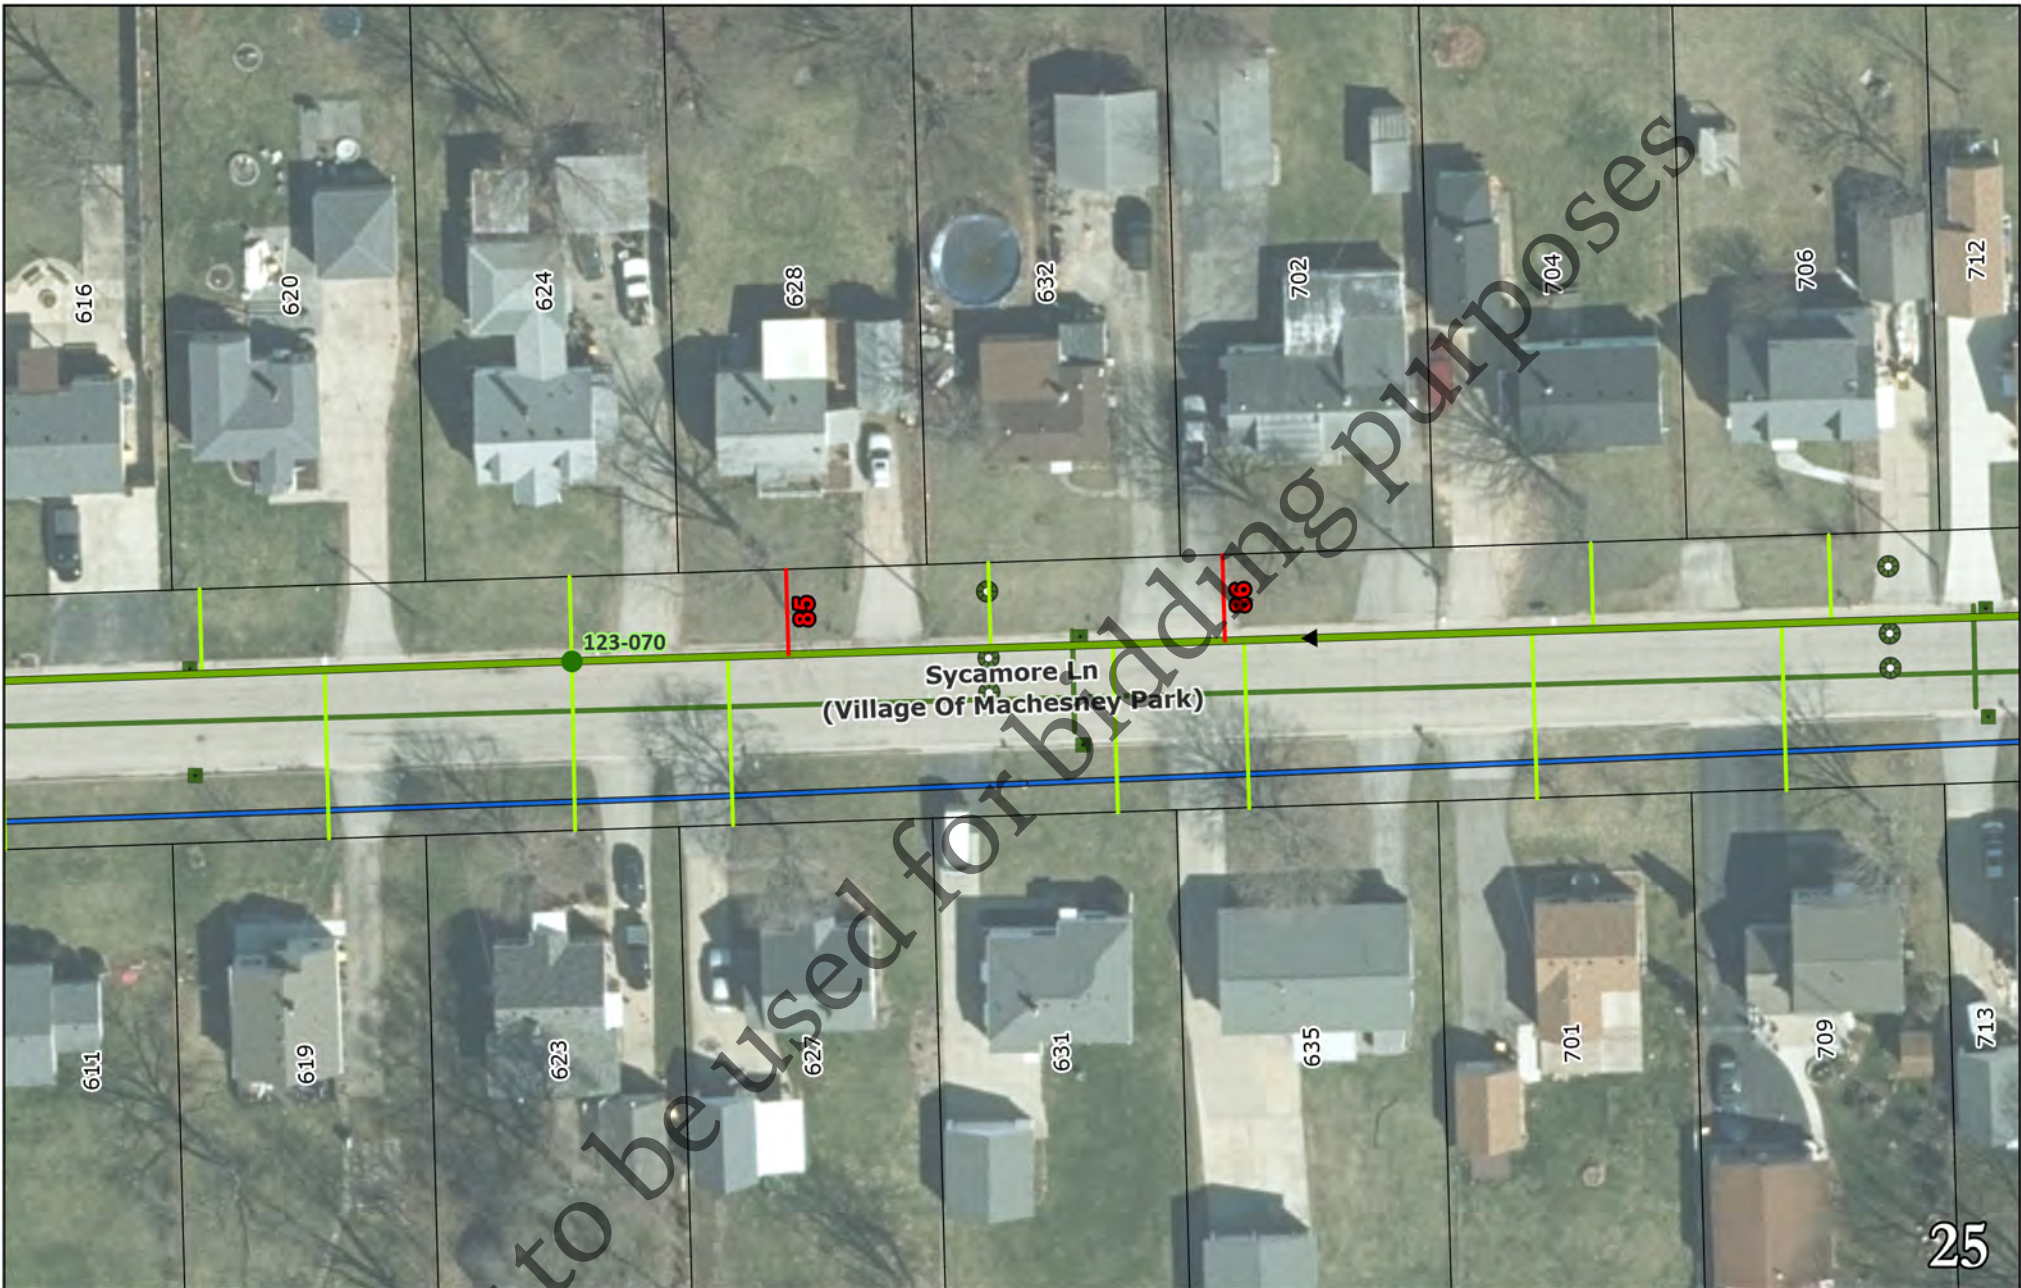

Service Cleanout Installations



Capital Project 2501

- Cleanout Installation
- Service Reconnection
- Service Replacement
- Sanitary Mains
- Watermain
- Storm Sewer

1 inch = 50 ft

Produced: 3/13/2024 By: J. Kink

25

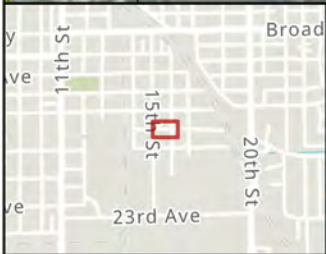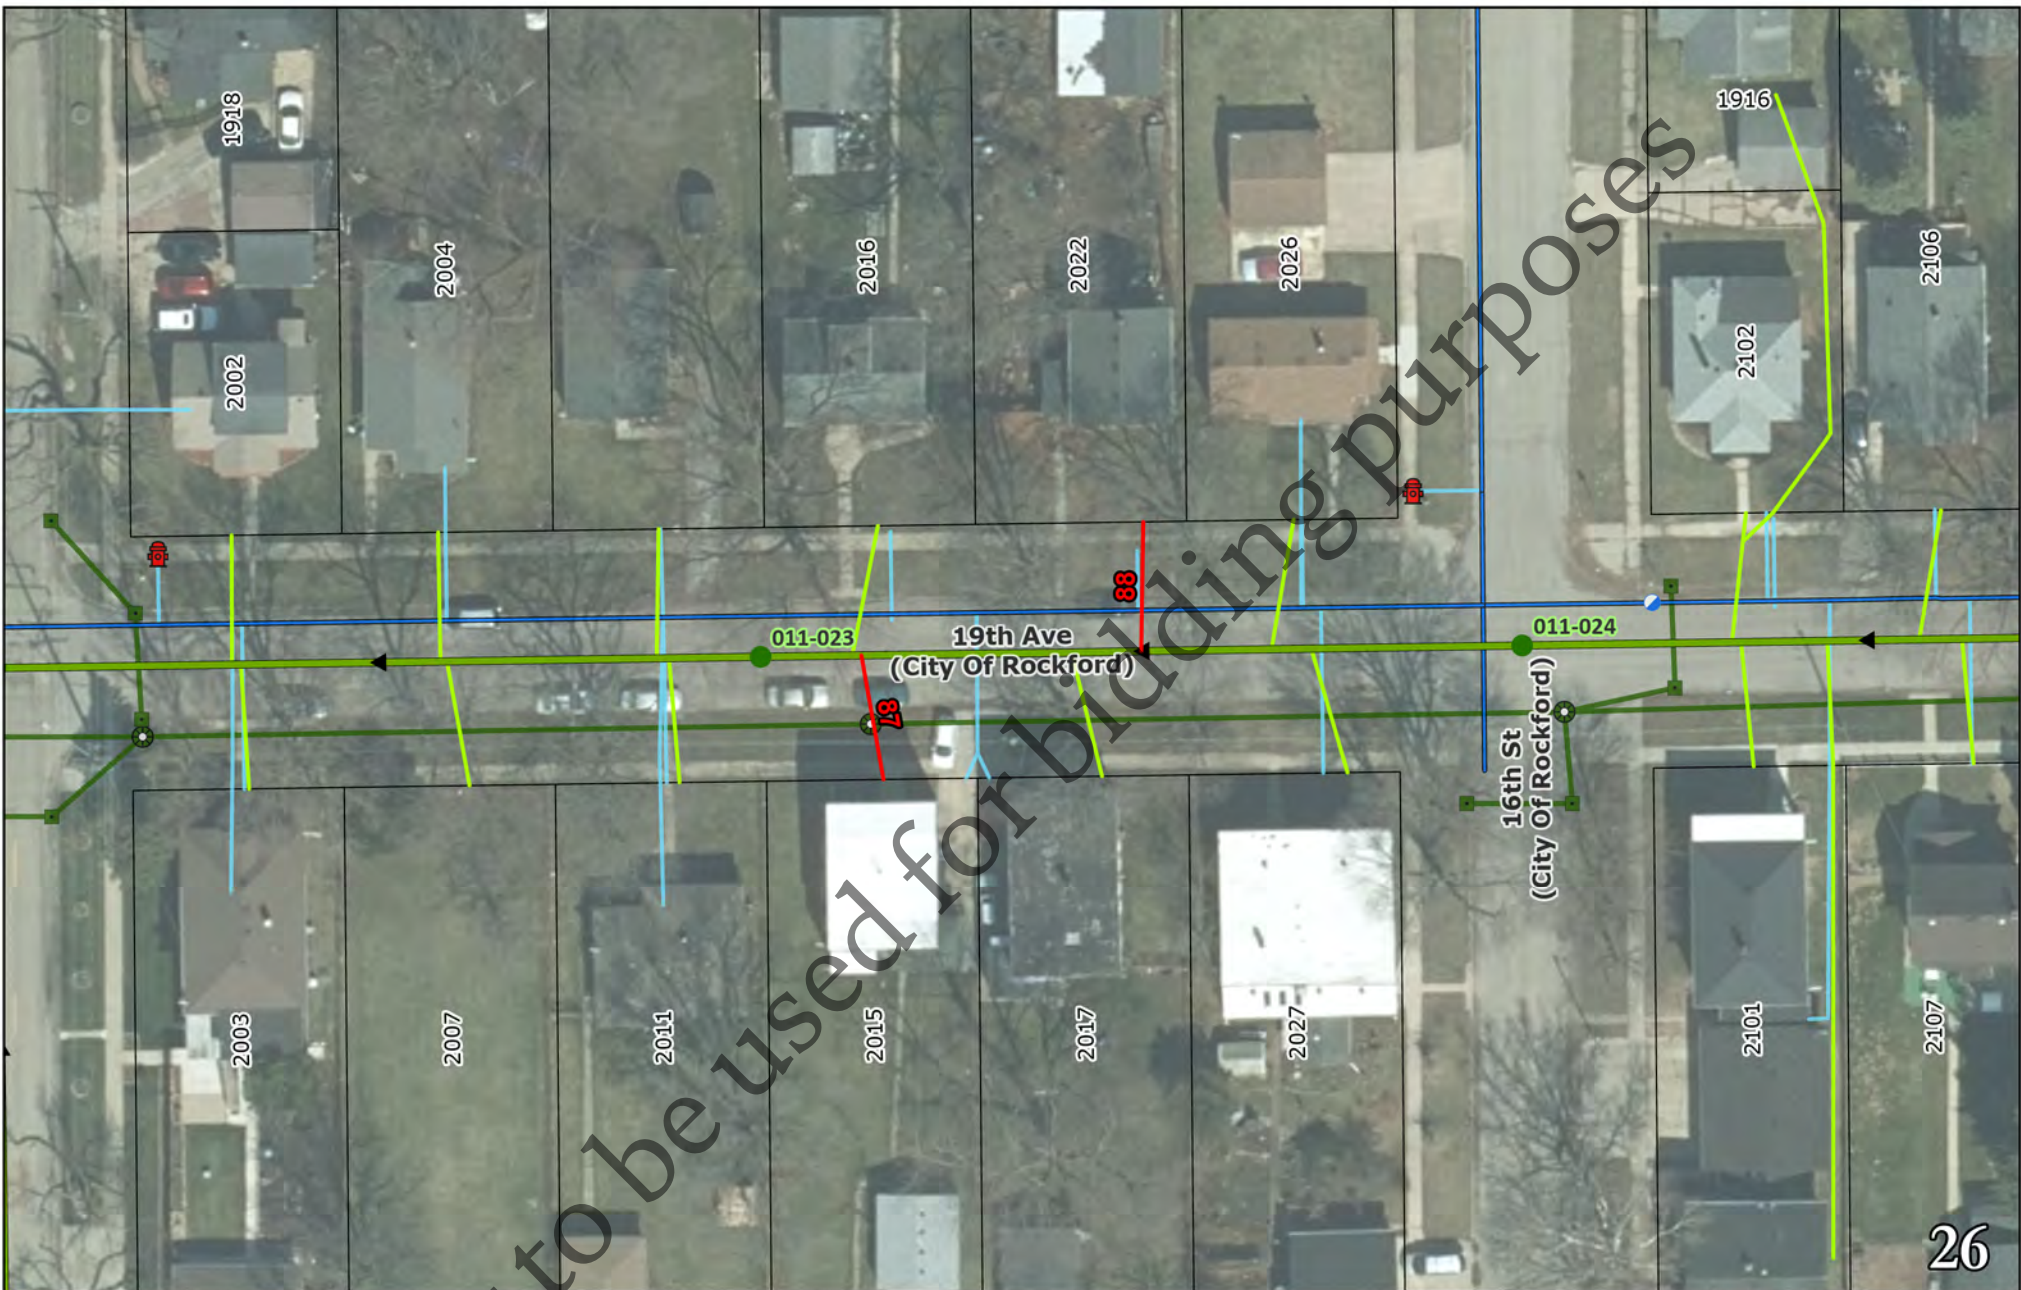



Service Cleanout Installations

Capital Project 2501

- Cleanout Installation
- Service Reconnection
- Service Replacement
- Sanitary Mains
- Watermain
- Storm Sewer

1 inch = 50 ft


Produced: 3/13/2024 By: J. Kink

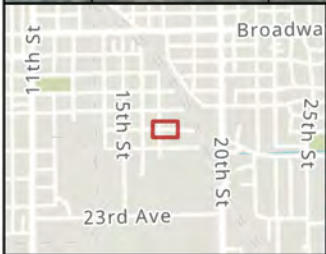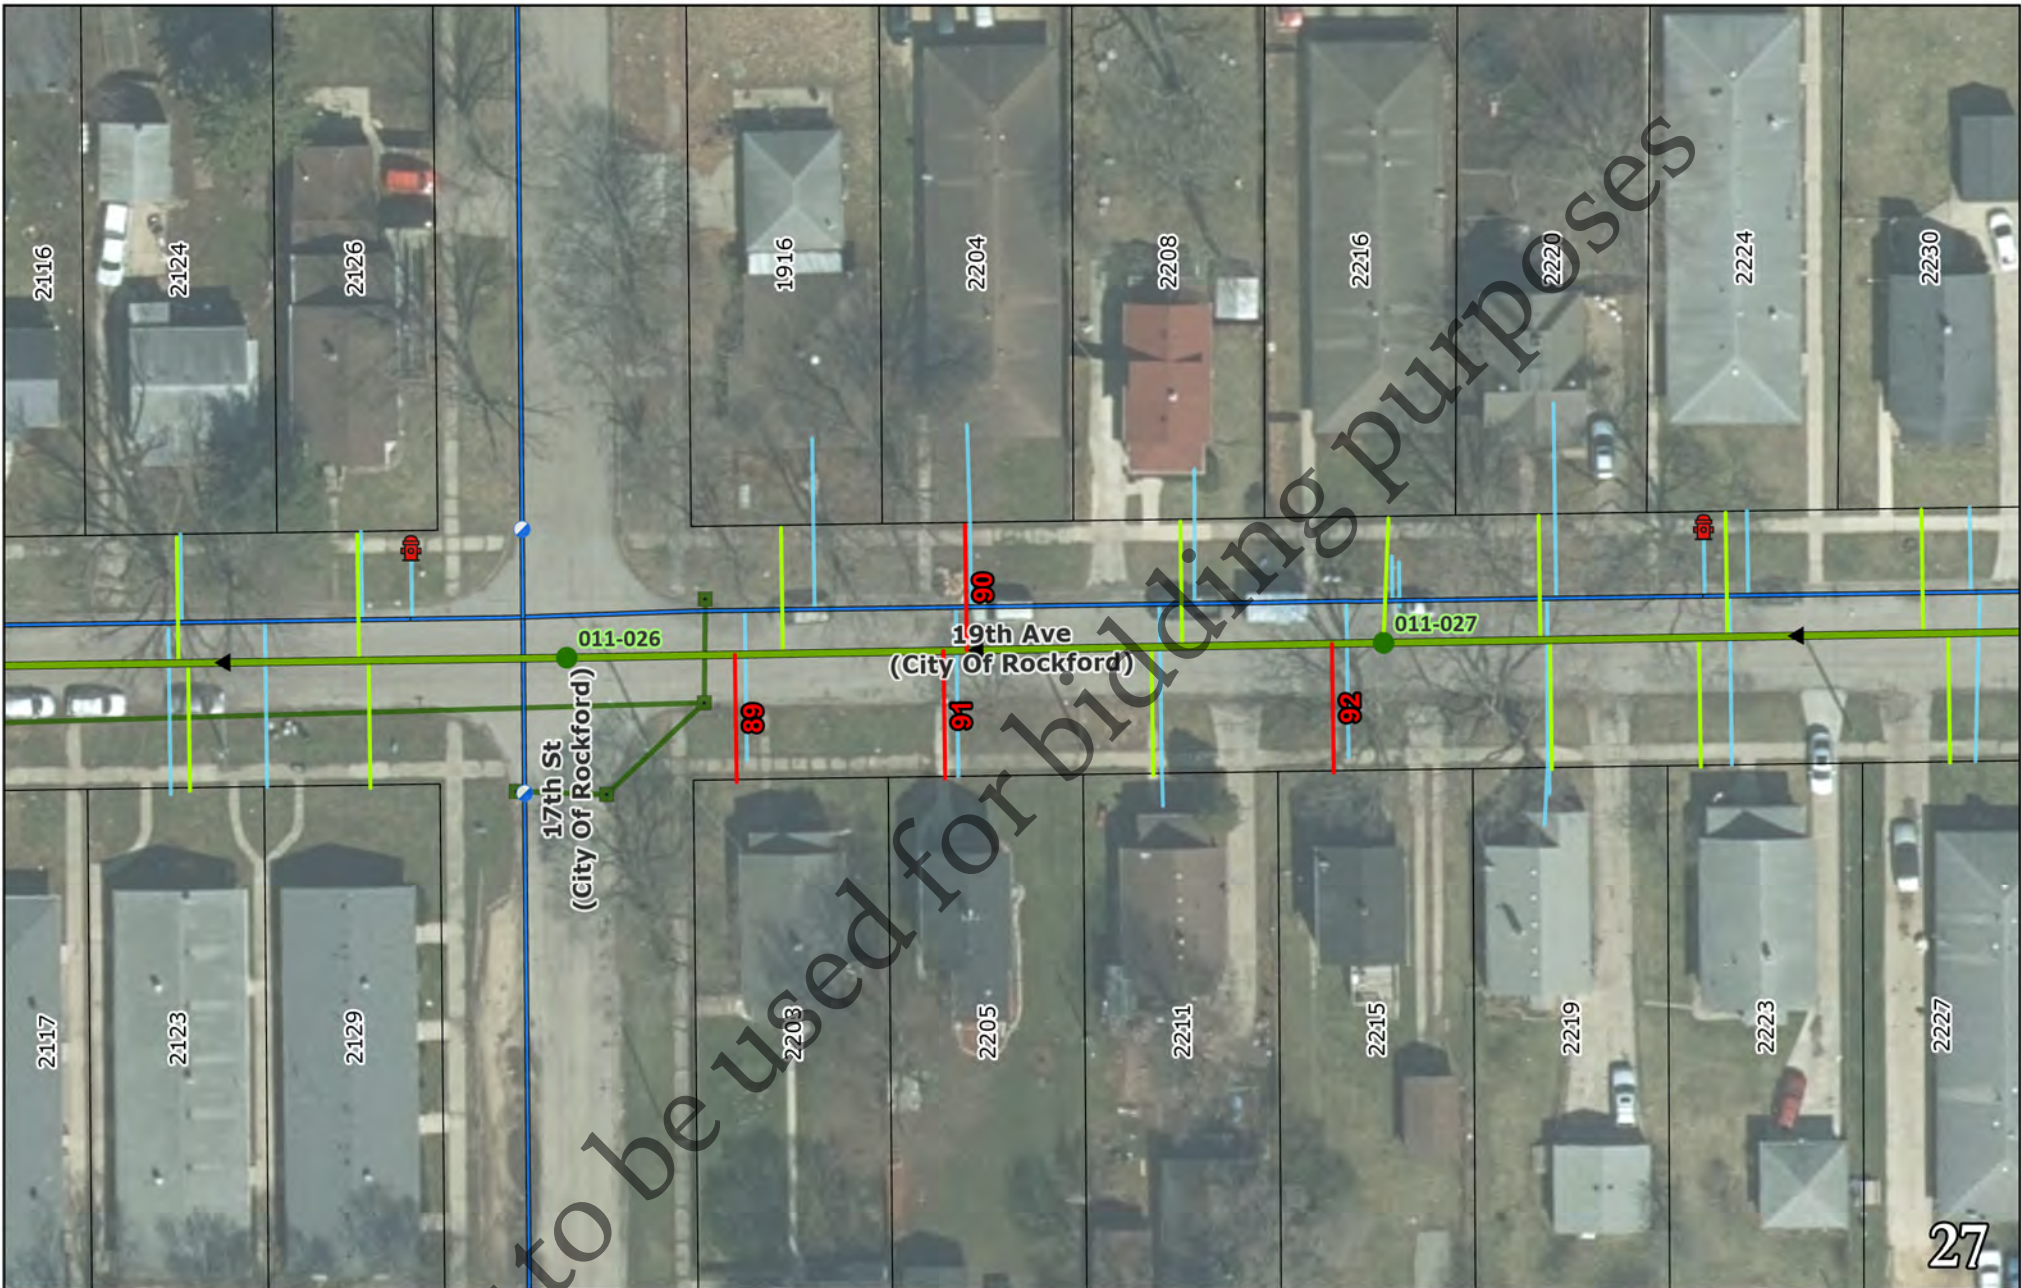

Service Cleanout Installations


Capital Project 2501

- Cleanout Installation
- Service Reconnection
- Service Replacement
- Sanitary Mains
- Watermain
- Storm Sewer



1 inch = 50 ft


Produced: 3/13/2024 By: J. Kink

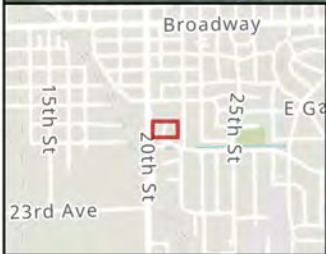

Service Cleanout Installations

Capital Project 2501


- Cleanout Installation
- Service Reconnection
- Service Replacement
- Sanitary Mains
- Watermain
- Storm Sewer



1 inch = 50 ft

Produced: 3/13/2024 By: J. Kink

28

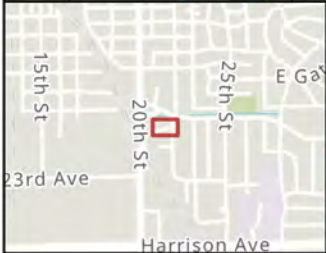

Service Cleanout Installations

Capital Project 2501

- Cleanout Installation
- Service Reconnection
- Service Replacement
- Sanitary Mains
- Watermain
- Storm Sewer





1 inch = 50 ft

Produced: 3/13/2024

By: J. Kink


29

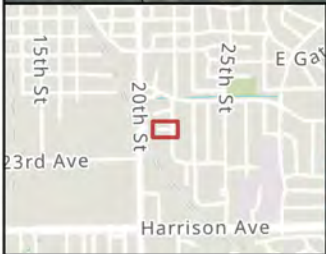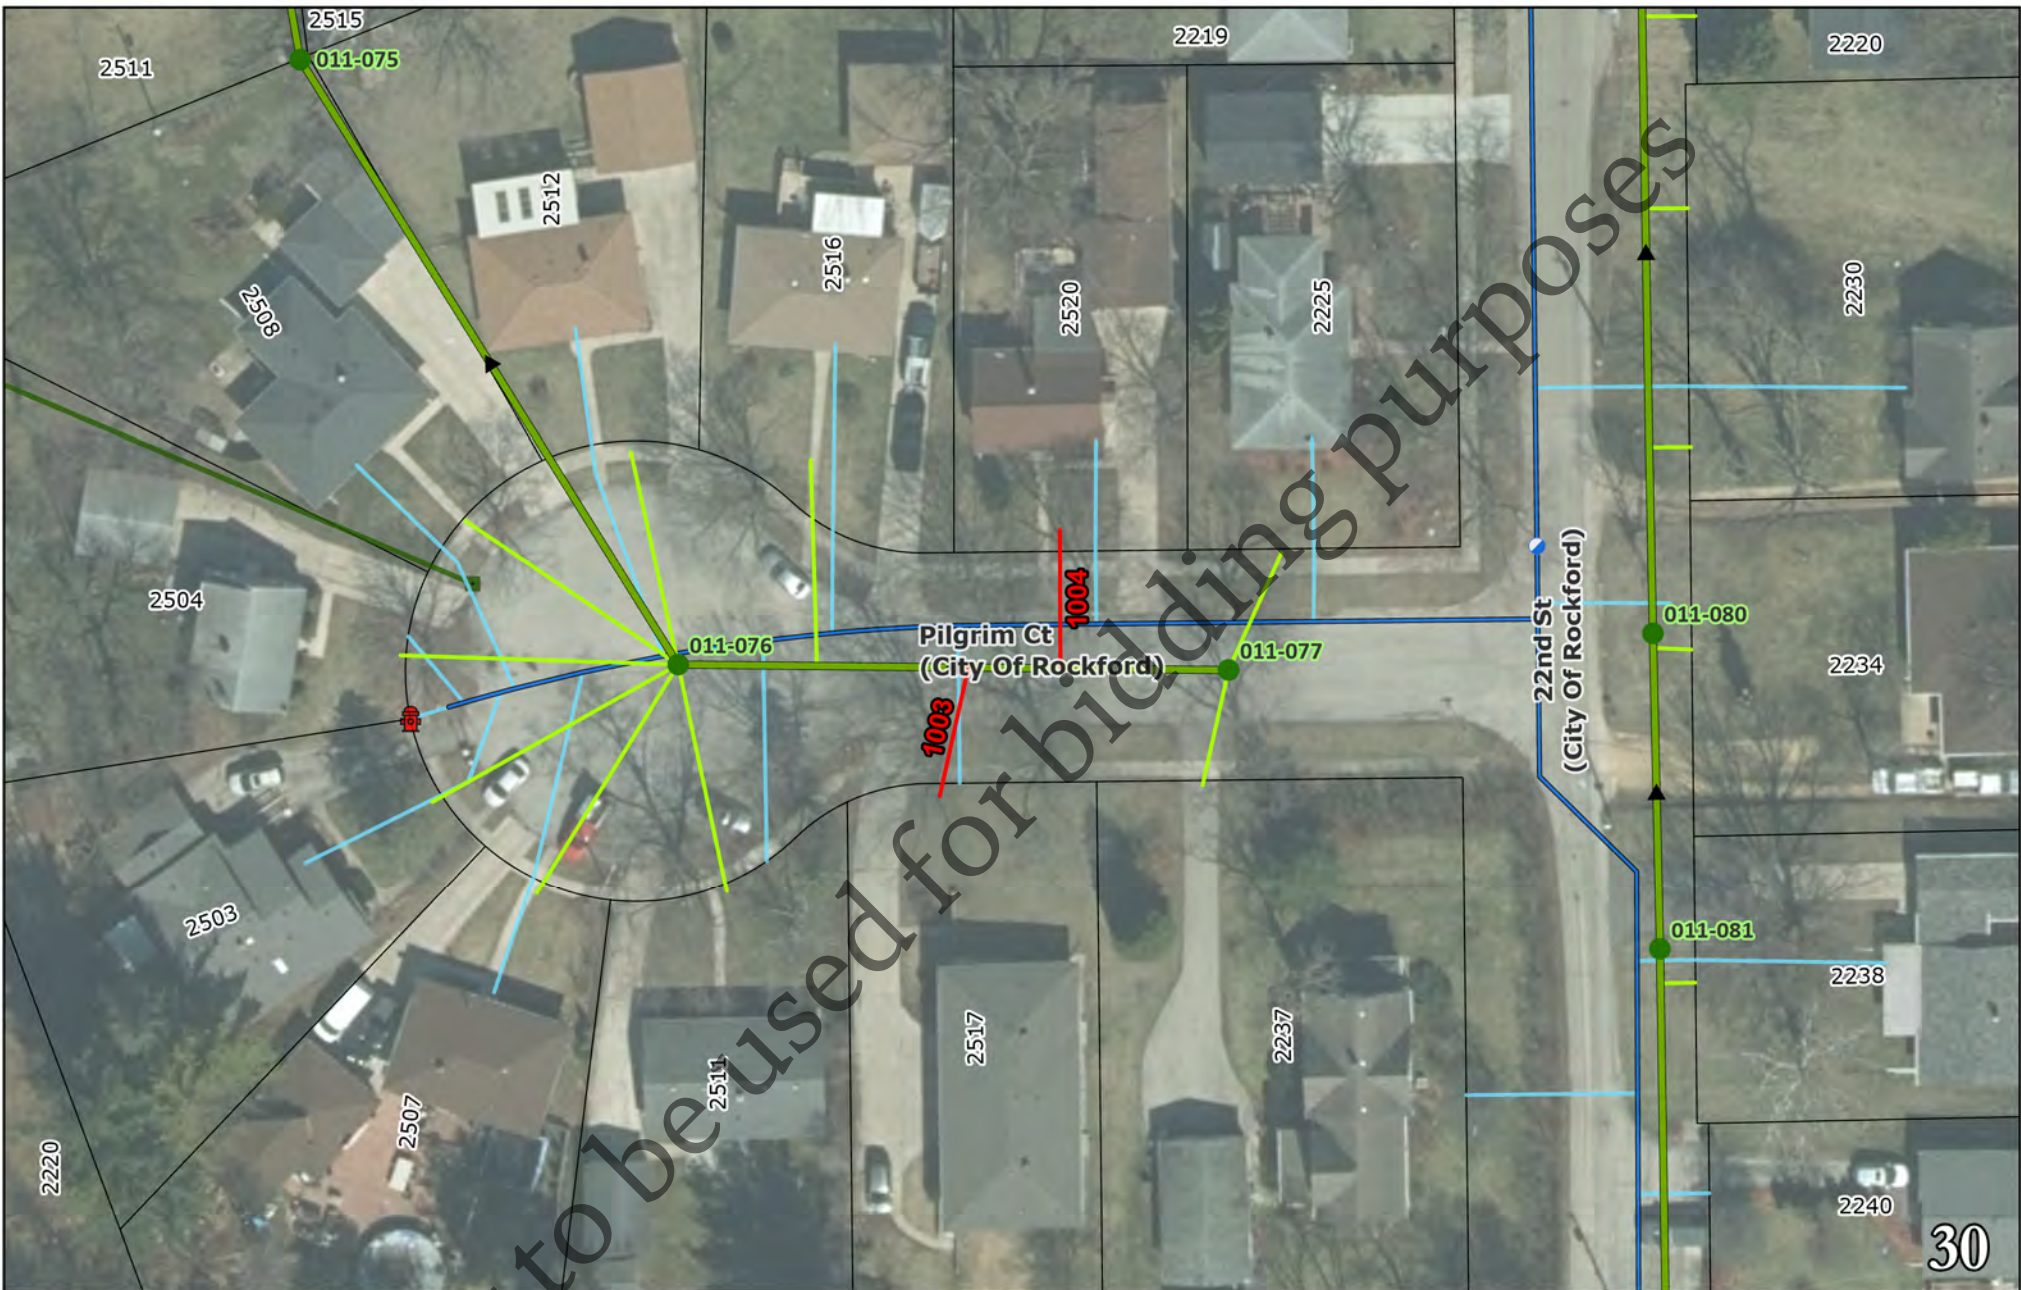

Service Cleanout Installations


Capital Project 2501

- Cleanout Installation
- Service Reconnection
- Service Replacement
- Sanitary Mains
- Watermain
- Storm Sewer



1 inch = 50 ft

Produced: 3/13/2024 By: J. Kink

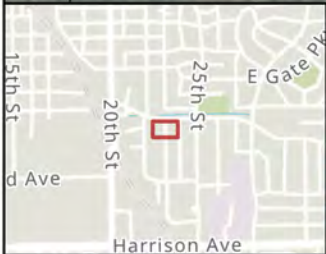


Service Cleanout Installations

Capital Project 2501

- Cleanout Installation
- Service Reconnection
- Service Replacement
- Sanitary Mains
- Watermain
- Storm Sewer

1 inch = 50 ft


Produced: 3/13/2024 By: J. Kink

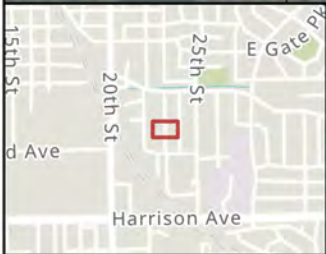


Service Cleanout Installations

Capital Project 2501

- Cleanout Installation
- Service Reconnection
- Service Replacement
- Sanitary Mains
- Watermain
- Storm Sewer


 1 inch = 50 ft
 Produced: 3/13/2024 By: J. Kink

32

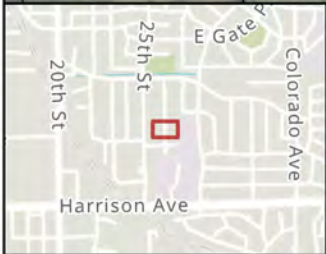

Service Cleanout Installations

Capital Project 2501

- Cleanout Installation
- Service Reconnection
- Service Replacement
- Sanitary Mains
- Watermain
- Storm Sewer

1 inch = 50 ft

Produced: 3/13/2024 By: J. Kink


Section V

**Standard Details & Record Drawing
Information for Select Locations**

Not to be used for bidding purposes


NOTES:

1. PIPE BEDDING FOR SANITARY SERVICE PIPING SHALL BE PER 'FLEXIBLE PIPE BEDDING DETAIL', 6" BELOW AND 12" ABOVE PIPING.
2. ALL SCH 40 PVC PIPE & FITTINGS SHALL BE PER ASTM D-1785/D-2665.
3. ALL SDR26 WMQ PVC PIPE & FITTINGS SHALL BE PER ASTM D-2241/D-3139.
4. ALL DWV FITTINGS SHALL BE CLEANED, PRIMED, & GLUED.
5. CLEANOUT CAP SHALL BE SCH 40 DWV SCH 40 GLUED SCREW CAP AND SHALL HAVE A MAGNETIC MARKER ATTACHED. MARKER SHALL BE DEEP-1 AS MANUFACTURED BY BERNSTEN INTERNATIONAL OR FRSA APPROVED EQUAL.
6. IN TURF AREAS, CLEAN-OUT CAP SHALL BE 6" BELOW FINAL GRADE.
7. IN PAVED AREAS, CLEAN-OUT CAP SHALL BE JUST BELOW FINAL GRADE AND SHALL INCLUDE A CLEAN-OUT FRAME & LID PER FRSA 'SERVICE CLEANOUT CASTING DETAIL'.

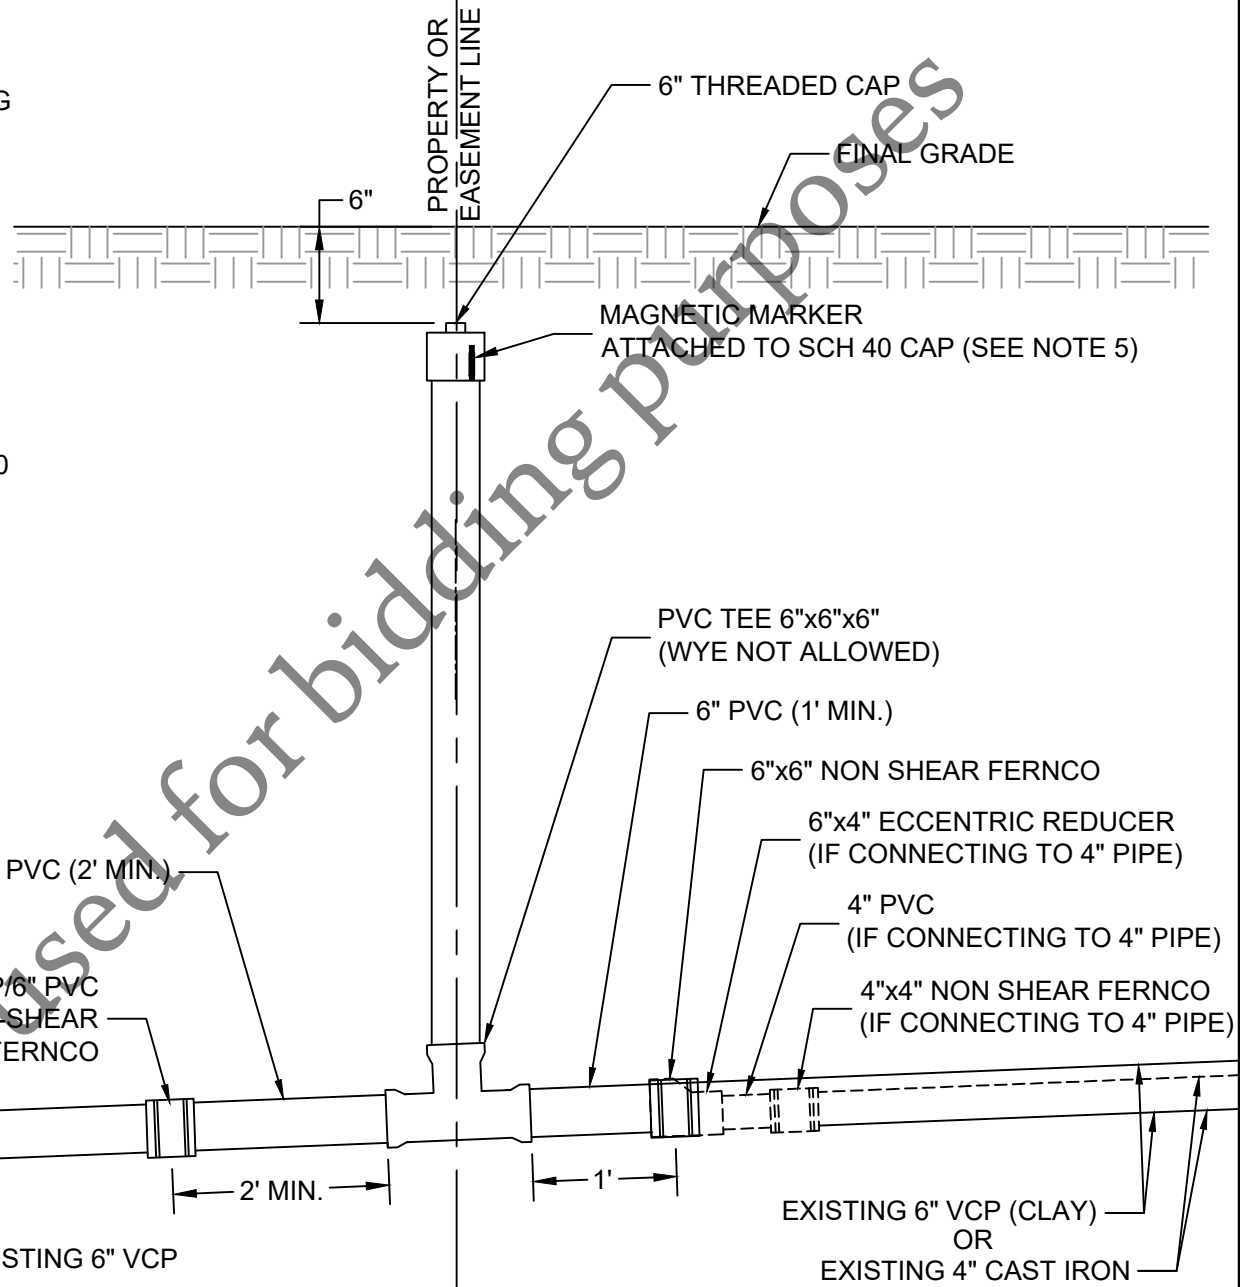

CLEANOUT INSTALLATION ON EXISTING SERVICE DETAIL

- NOTES:**
1. THE MAX. DROP FROM THE INVERT OF ANY PIPE TO THE CONCRETE CHANNEL UNDER THAT PIPE SHALL BE 8".
 2. MANHOLES LOCATED OUTSIDE OF PUBLIC RIGHT-OF-WAY SHALL BE MARKED WITH A STEEL FENCE POST AS DIRECTED.
 3. ALL NEW MANHOLES SHALL BE VACUUM TESTED PER A.S.T.M. C-1244 PRIOR TO ACCEPTANCE.
 4. ALL BARREL JOINTS SHALL BE SEALED WITH 3 1/2" x 3/8" PRE-FORMED RUBBER BUTYL JOINT SEALANT ON THE LOWER SHIPLAP.
 5. ALL BARREL JOINTS SHALL BE SEALED WITH AN EXTERNAL BARREL SEAL CENTERED ON THE JOINT (MAR MAC MACWRAP, OR APPROVED EQUAL).
 6. MANHOLE STRUCTURE SHALL BE CONSTRUCTED OF PRECAST REINFORCED CONCRETE MANHOLE RISER SECTIONS IN ACCORDANCE WITH A.S.T.M. C478-90 OR THE LATEST DESIGNATION.
 7. PRECAST FLAT TOPS ARE NOT APPROVED FOR USE.
 8. SEE 'MANHOLE ADJUSTMENT DETAIL' FOR ADJUSTMENT REQUIREMENTS.
 9. PIPE CONNECTIONS TO NEW MANHOLES SHALL BE MADE BY MEANS OF EITHER RUBBER GASKET SEAL (A-LOK OR APPROVED EQUAL) CONFORMING TO ASTM C-923 CAST INTEGRALLY IN MANHOLE WALL, OR RUBBER GASKET SEAL AND STAINLESS STEEL CLAMP (PSX SERIES SIX OR APPROVED EQUAL) CONFORMING TO ASTM C-923. FOR PIPE CONNECTIONS WITH A DEPTH OF >20 FT., A RUBBER GASKET SEAL (A-LOK OR APPROVED EQUAL) CONFORMING TO ASTM C-923 CAST INTEGRALLY IN MANHOLE WALL SHALL BE USED.
 10. PIPE CONNECTIONS TO EXISTING MANHOLES SHALL BE MADE BY MEANS OF CORE DRILLING MANHOLE WALL AND INSTALLING RUBBER GASKET SEAL AND STAINLESS STEEL CLAMP (PSX SERIES SIX OR APPROVED EQUAL) CONFORMING TO ASTM C-923.
 11. THE MAXIMUM DISTANCE FROM ANY INLET PIPE INVERT TO THE OUTLET PIPE INVERT SHALL BE 2'. DISTANCES GREATER THAN 2' WILL REQUIRE AN INSIDE DROP CONNECTION PER 'INSIDE DROP CONNECTION DETAIL'.
 12. MANHOLE STEPS SHALL BE NEENAH R-1982-F OR M.A. IND. PS-1 OR APPROVED EQUAL INSTALLED AT 16" CENTERS, ORIENTED ABOVE THE OUTLET PIPE UNLESS OTHERWISE SPECIFIED. FOR MANHOLES WITH INSIDE DROP ASSEMBLIES, STEPS IN THE MANHOLE BASE SECTION SHALL BE INSTALLED IN THE FIELD AND NOT CAST IN PLACE. IN THIS CASE, THE ORIENTATION OF THE CONE SHALL BE AS DIRECTED BY FRSA.

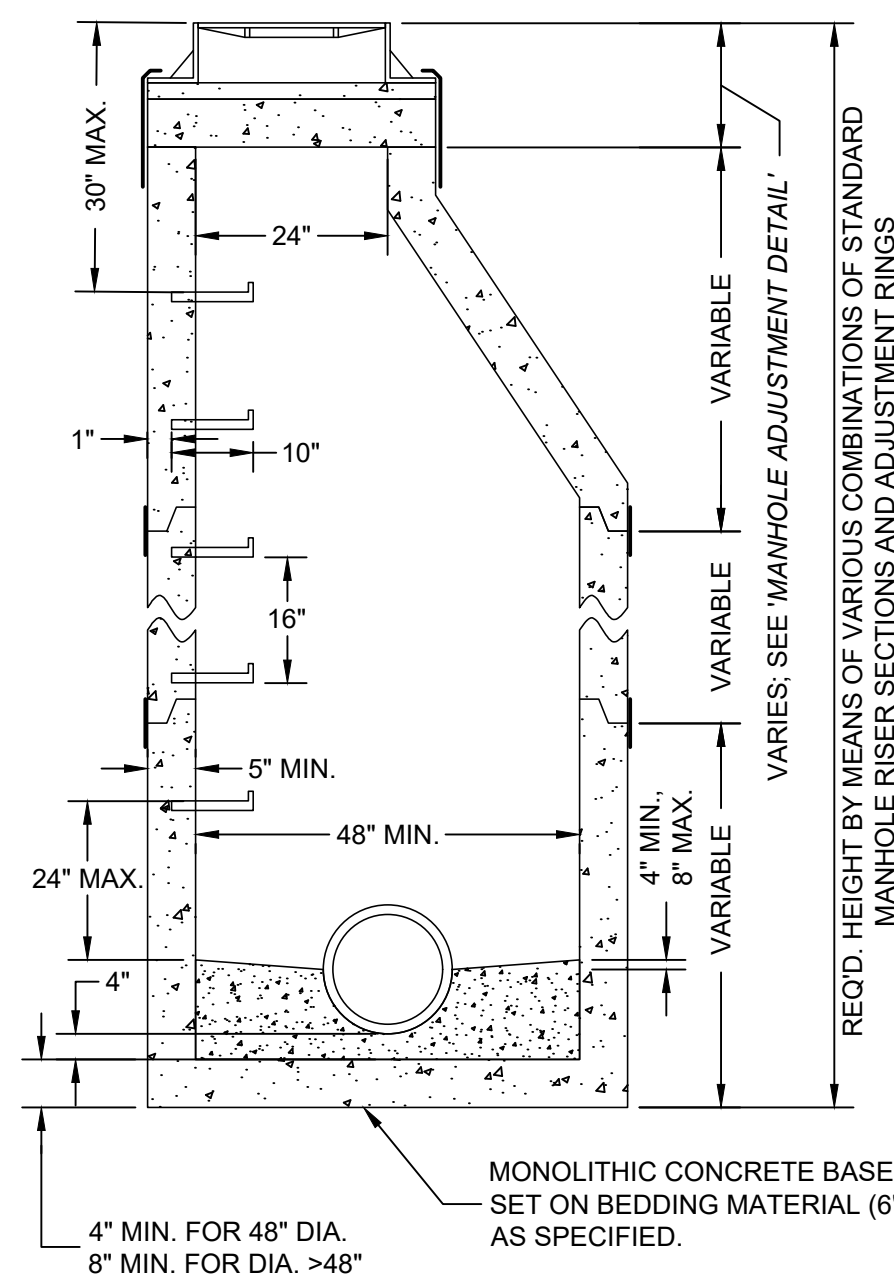


STANDARD MANHOLE DETAIL
(*MANHOLE ADJUSTMENT DETAIL* SHALL APPLY)

- NOTES:**
1. MANHOLE FRAMES & LIDS SHALL BE PER THE TABLE BELOW.
 2. FOR MANHOLES CONNECTED TO MAINS 18" DIAMETER OR LARGER, OR FOR MANHOLES LOCATED IN FLOOD PRONE AREAS, FRAMES & LIDS SHALL BE THE BOLT DOWN TYPE.
 3. ALLOWABLE TYPES OF ADJUSTING RINGS INCLUDE PRECAST CONCRETE (4" HEIGHT MIN.), & EXPANDED POLYPROPYLENE (EPP). THESE CAN BE USED IN CONJUNCTION WITH EACH OTHER, EXCEPT THAT A PRECAST RING SHALL NOT BE PLACED OVER AN EPP RING.
 4. FOR PRECAST ADJUSTING RINGS, ALL ADJUSTING RING JOINTS AS WELL AS THE FRAME TO ADJUSTING RING JOINT SHALL BE SEALED WITH TWO 1" BEADS OF PRE-FORMED RUBBER BUTYL JOINT SEALANT. WHEN A FRAME REQUIRES PITCHING, EPP TAPER RINGS SHALL BE USED PER NOTE 5.
 5. FOR EPP ADJUSTING RINGS, RINGS SHALL BE INSTALLED ACCORDING TO MANUFACTURER'S INSTRUCTIONS. WHEN A FRAME REQUIRES PITCHING, THE TOP RING SHALL BE A TAPERED ADJUSTING RING PER MANUFACTURER'S INSTRUCTIONS.
 6. NO TARRING OR GROUTING IS ALLOWED ON THE INSIDE OF MANHOLE OR ADJUSTMENT JOINTS.
 7. MAXIMUM MANHOLE ADJUSTMENT IS 12". MINIMUM ADJUSTMENT IS 4" UNLESS OFF-ROAD OR IN CURB & GUTTER ROADWAY.
 8. MANHOLE FRAMES SHALL BE SET 1/4" MIN. TO 3/8" MAX. BELOW PAVED SURFACES, AND AT FINAL GRADE IN TURF AREAS.
 9. WHEN ADJUSTING EXISTING MANHOLES, THE ENTIRE EXISTING ADJUSTMENT SHALL BE REMOVED AND REPLACED.
 10. THE COMBINATION OF NEW ADJUSTING RINGS

APPROVED FRAME & LID TABLE

TYPE	NEENAH FRAME	NEENAH LID	EAST JORDAN FRAME	EAST JORDAN LID
REGULAR	1670-2004	R-1670-0358	00111711	00111732
LOW PROFILE	1670-2008	R-1670-0358	---	---
BOLT DOWN	1915JT08	---	---	---

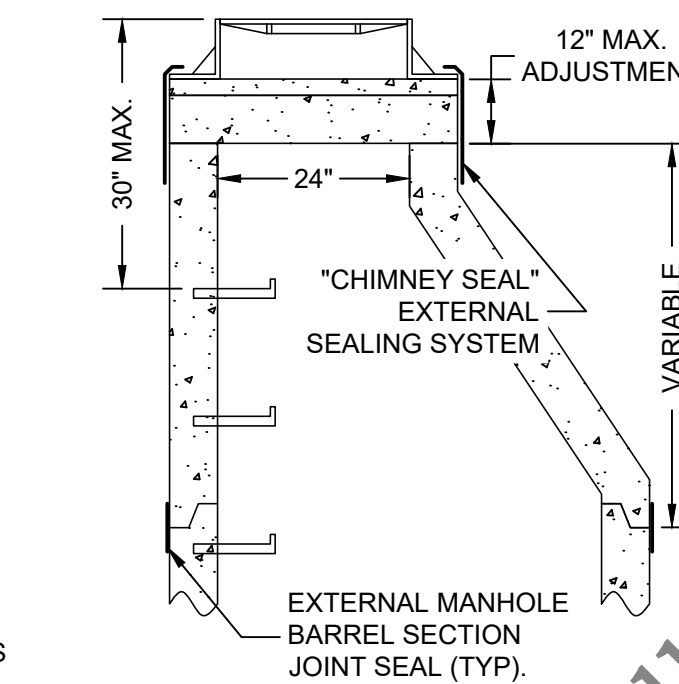

MANHOLE ADJUSTMENT DETAIL
(FOR ADJUSTMENT OF BOTH NEW & EXISTING MANHOLES)

rev. 5/1/23


- SHALL BE SUCH THAT THE MINIMUM NUMBER OF RINGS POSSIBLE ARE USED.
11. FLAT-TOPS ARE NOT PERMITTED ON 4' OR 5' DIA. MANHOLES.
 12. REPLACEMENT OF EXISTING BARREL SECTIONS MAY BE REQUIRED TO MEET THE ABOVE REQUIREMENTS.
 13. MANHOLE ADJUSTMENT INSERT RISER RINGS ARE NOT APPROVED FOR USE.

DROP BOWL & DROP PIPE SIZING TABLE

INLET PIPE DIA.	DROP PIPE DIA. (MIN.)
4-6 INCH	4 INCH
8 INCH	6 INCH
10 INCH	8 INCH
>10 INCH	*


* PER MFG. OR AS DIRECTED BY FRSA

SEE 'STANDARD MANHOLE DETAIL' FOR MANHOLE REQUIREMENTS

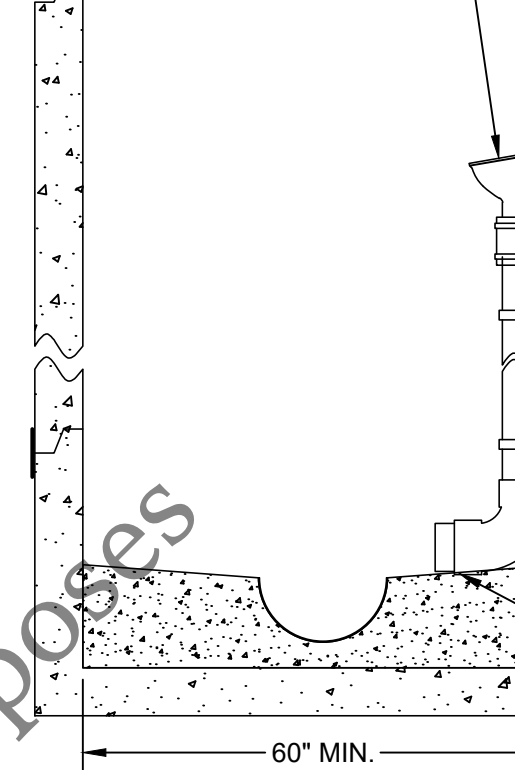

INSIDE DROP CONNECTION DETAIL
(*STANDARD MANHOLE DETAIL* SHALL APPLY)

- NOTES:**
1. INSIDE DROP TYPE MANHOLES SHALL BE 5' MIN. INSIDE DIA.
 2. ALL INSIDE DROP CONNECTIONS FOR SERVICES AND COLLECTOR SEWERS SHALL USE THE DROP AS MFG. BY RELINER-DURAN INC., OR EQUAL.
 3. SEE TABLE FOR DROP BOWL AND DROP PIPE SIZES.
 4. ALL INSIDE DROP PIPING SHALL BE PVC SDR35 ASTM-D3034.
 5. ATTACH THE ROUND BACK DROP BOWL AND EACH CLAMPING BRACKET TO THE MANHOLE WALL WITH 3/8" x 1" MIN. STAINLESS STEEL BOLTS AND EPOXY IMPREGNATED LUGS PER MFR.'S RECOMMENDATIONS.
 6. THE DROP BOWL SHALL BE PLACED AT A HEIGHT SO THAT THE FLOW LINE OF THE BOWL IS 2 INCHES BELOW THE INVERT OF THE INCOMING PIPE.
 7. CUT A 1" DEEP BY 3" WIDE "V" NOTCH IN INVERT OF INLET PIPE.
 8. CUT THE TOP HALF OF THE INLET PIPE FLUSH WITH THE INSIDE OF THE MANHOLE WALL.
 9. ALTERNATE INSIDE DROP SYSTEMS MAY BE CONSIDERED FOR APPROVAL.

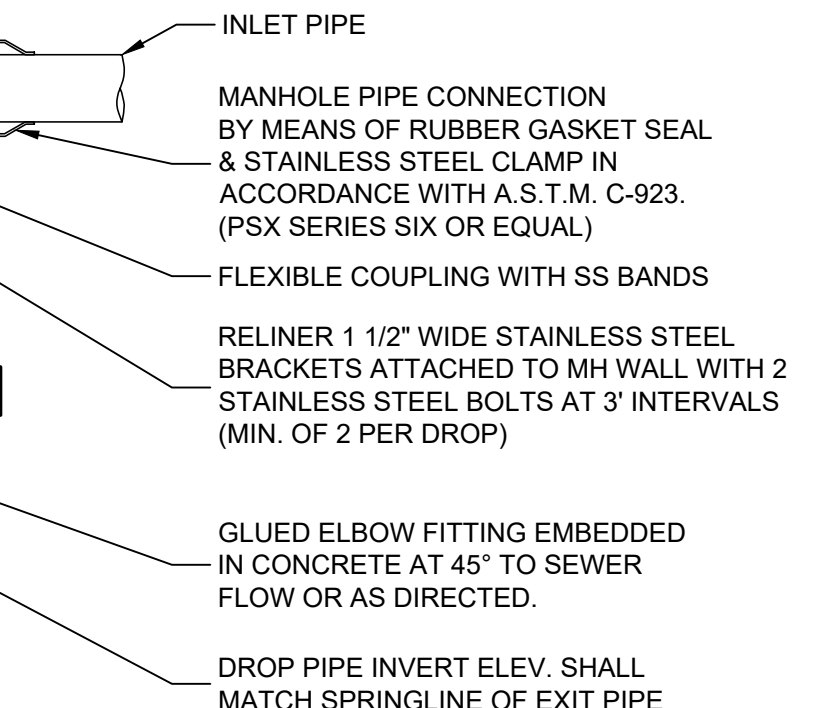


NOTES:

1. FOR NEW MAINLINE, FACTORY PVC WYE FITTING SHALL BE USED.
2. FOR EX. MAINLINE, HOLE SHALL BE CORE DRILLED IN THE MAINLINE PIPE PER MFR.'S REQUIREMENTS. LOCATION OF CORE SHALL BE APPROVED BY THE ENGINEER.
3. PIPE BEDDING FOR SANITARY SERVICE PIPING SHALL BE PER 'FLEXIBLE PIPE BEDDING DETAIL', 6" BELOW AND 12" ABOVE PIPING.
4. THE REMAINDER OF SERVICE TO PROPERTY/EASEMENT LINE SHALL BE INSTALLED PER 'STANDARD SERVICE & ALTERNATE SERVICE DETAIL'.
5. THE COMPRESSION FITTING SHALL BE A WATER-TIGHT FLEXIBLE TEE CONNECTOR OF SPECIFIED SIZE. (INSERT-A-TEE OR APPROVED EQUAL).
6. UNDERGROUND MAGNETIC MARKERS SHALL BE BERNSTEN INTERNATIONAL DEEP-1UG OR FRSA APPROVED EQUAL.

VERTICAL SERVICE RISER DETAIL
(FOR MAINLINE DIA. 8" - 18"; CONNECTION TO >18" MAIN PROHIBITED)

rev. 5/1/23


- NOTES:**
1. REASONABLE CARE SHALL BE USED WHEN BACKFILLING OVER SEWER. NO MATERIALS SUCH AS ROCKS OR BOULDERS SHALL BE PLACED WITHIN 24" OF THE CROWN OF THE PIPE. NO MATERIAL LARGER THAN 8" DIA. SHALL BE USED IN THE BACKFILL.
 2. LOOSE MATERIAL SHALL BE REMOVED OR COMPACTED PRIOR TO PLACING PIPE BEDDING.
 3. BEDDING SHALL BE WELL HAUNCHED ALONG PIPE TO ENSURE VOIDS ARE ELIMINATED.

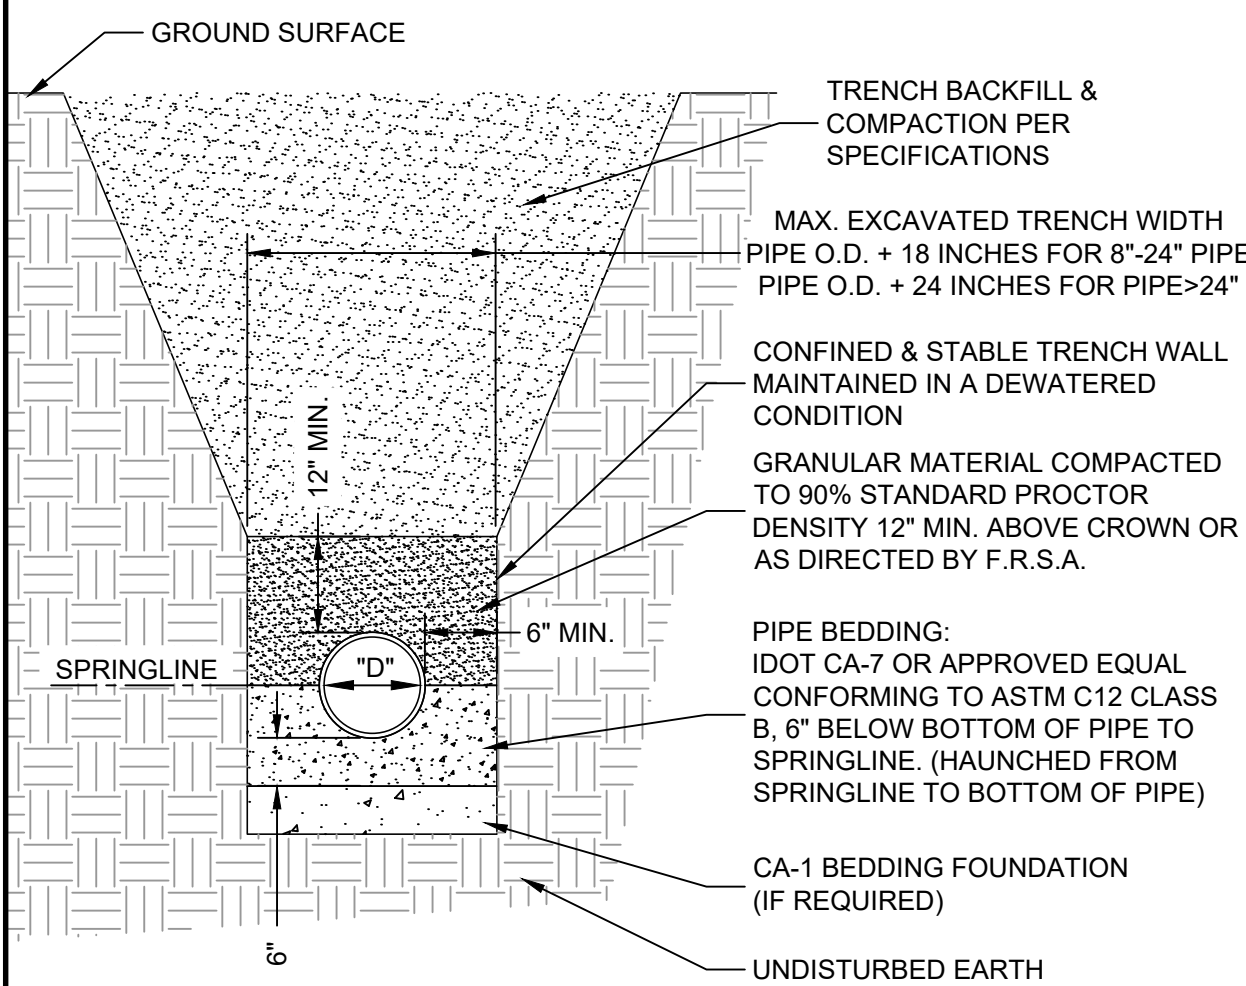

RIGID PIPE BEDDING DETAIL


rev. 3/11/20

- NOTES:**
1. REASONABLE CARE SHALL BE USED WHEN BACKFILLING OVER SEWER. NO MATERIALS SUCH AS ROCKS OR BOULDERS SHALL BE PLACED WITHIN 24" OF THE CROWN OF THE PIPE. NO MATERIAL LARGER THAN 8" DIA. SHALL BE USED IN THE BACKFILL.
 2. LOOSE MATERIAL TO BE REMOVED OR COMPACTED PRIOR TO PLACING PIPE BEDDING.
 3. BEDDING SHALL BE WELL HAUNCHED ALONG PIPE TO ENSURE VOIDS ARE ELIMINATED.

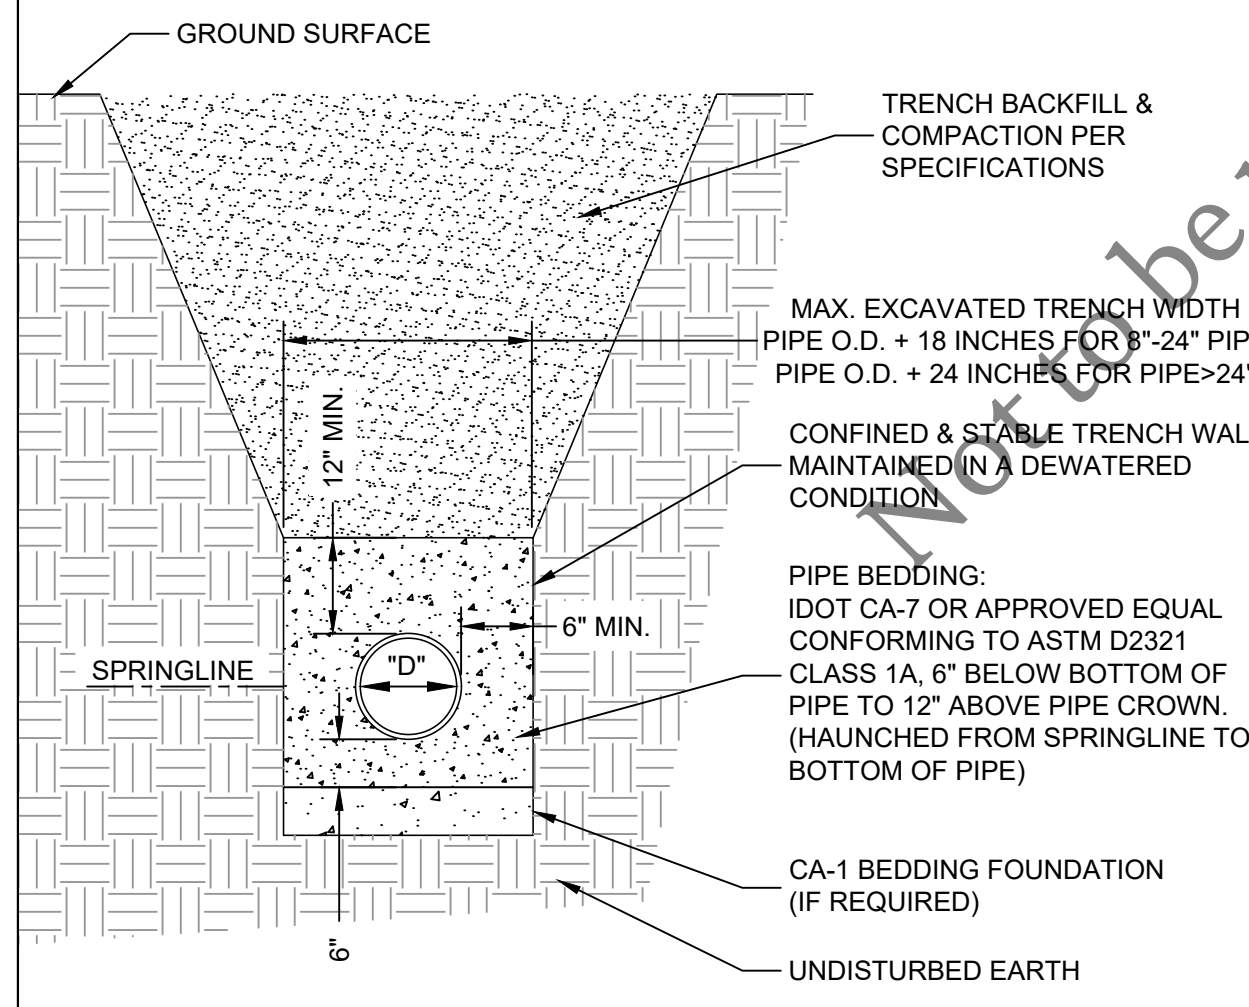

FLEXIBLE PIPE BEDDING DETAIL

rev. 3/11/20

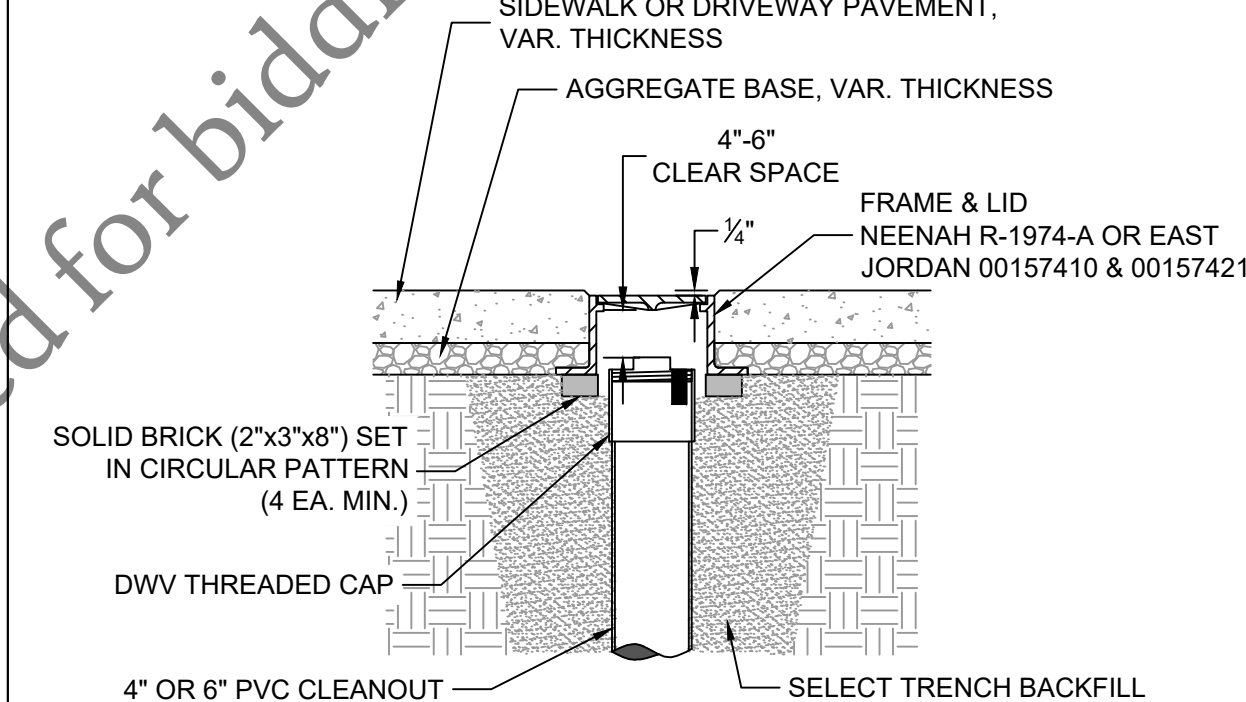


- NOTES:**
1. SERVICE CLEANOUT CASTINGS ARE REQUIRED FOR ALL CLEANOUTS LOCATED IN PAVED AREAS, DRIVEWAYS, OR SIDEWALKS.
 2. THE LOCATION OF THE CLEANOUT SHALL BE APPROVED BY FOUR RIVERS SANITATION AUTHORITY (FRSA).
 3. THE FRAME SHALL BE SET ON BRICKS THAT ARE PLACED IN A CIRCULAR PATTERN THE ENTIRE CIRCUMFERENCE OF THE FRAME. THE BRICKS SHALL BE SET ON COMPACTED TRENCH BACKFILL.
 4. THE FRAME SHALL BE SET TO AN ELEVATION THAT PROVIDES 4"-6" CLEAR SPACE BETWEEN THE TOP OF THE CLEANOUT CAP AND THE BOTTOM OF THE CASTING LID.
 5. THE CONTRACTOR SHALL ENSURE THAT THE CLEANOUT CAP CAN BE UNSCREWED AND REMOVED AND REPLACED WITHOUT HINDRANCE.
 6. THE FRAME SHALL BE SET 1/4" MIN. TO 3/8" MAX. BELOW FINAL PAVEMENT ELEVATION.

SERVICE CLEANOUT CASTING DETAIL

rev. 6/1/22


- NOTES:**
1. SADDLE TEE OR SADDLE WYE ARE BOTH ACCEPTABLE FOR VCP MAIN.
 2. CORE DRILL HOLE IN MAIN OR MODIFY EX. VCP FITTING FOR SADDLE DIMENSIONS.
 3. APPLY 2 BEADS OF SILICONE CAULK TO UNDERSIDE OF SADDLE AROUND OPENING.

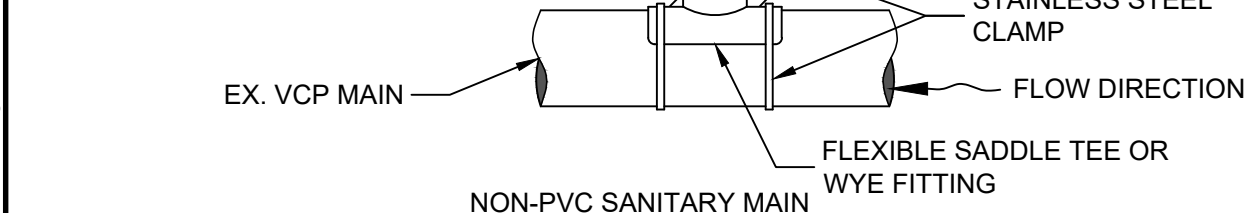

FLEXIBLE SADDLE CONNECTION DETAIL
(FOR SERVICE CONNECTIONS TO NON-PVC SANITARY MAINS LESS THAN 18" DIA.)


rev. 3/11/20

- NOTES:**
1. ONLY A SADDLE WYE IS ACCEPTABLE FOR A PVC MAIN.
 2. CORE DRILL HOLE IN MAIN FOR SADDLE DIMENSIONS.
 3. APPLY 2 BEADS OF SILICONE CAULK TO UNDERSIDE OF SADDLE AROUND OPENING.

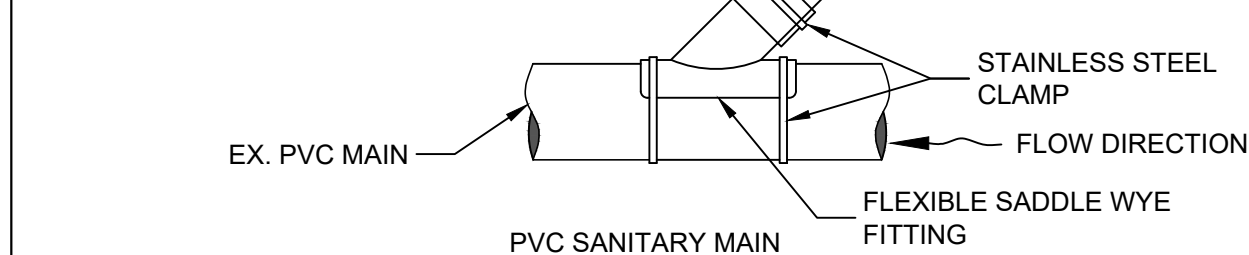

FLEXIBLE SADDLE CONNECTION DETAIL
(FOR SERVICE CONNECTIONS TO PVC SANITARY MAINS LESS THAN 18" DIA.)

rev. 3/11/20

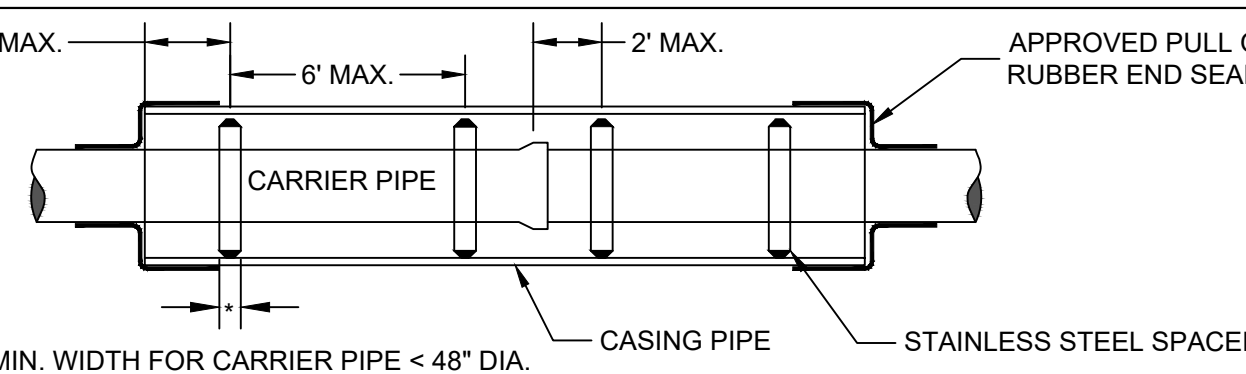


* 8" MIN. WIDTH FOR CARRIER PIPE < 48" DIA.
12" MIN. WIDTH FOR CARRIER PIPE ≥ 48" DIA.

- NOTES:**
1. CASING END SEALS & SPACERS SHALL BE AS MFD. BY CASCADE MFG., OR APPROVED EQUAL.
 2. FOR FLEXIBLE CARRIER PIPE, SPACING OF SPACERS TO BE AS SHOWN, OR PER MFR.'S RECOMMENDATION.
 3. FOR RIGID CARRIER PIPE, SPACING SHALL BE PER MFR.'S RECOMMENDATION.

CASING & SPACER DETAIL

rev. 5/15/18

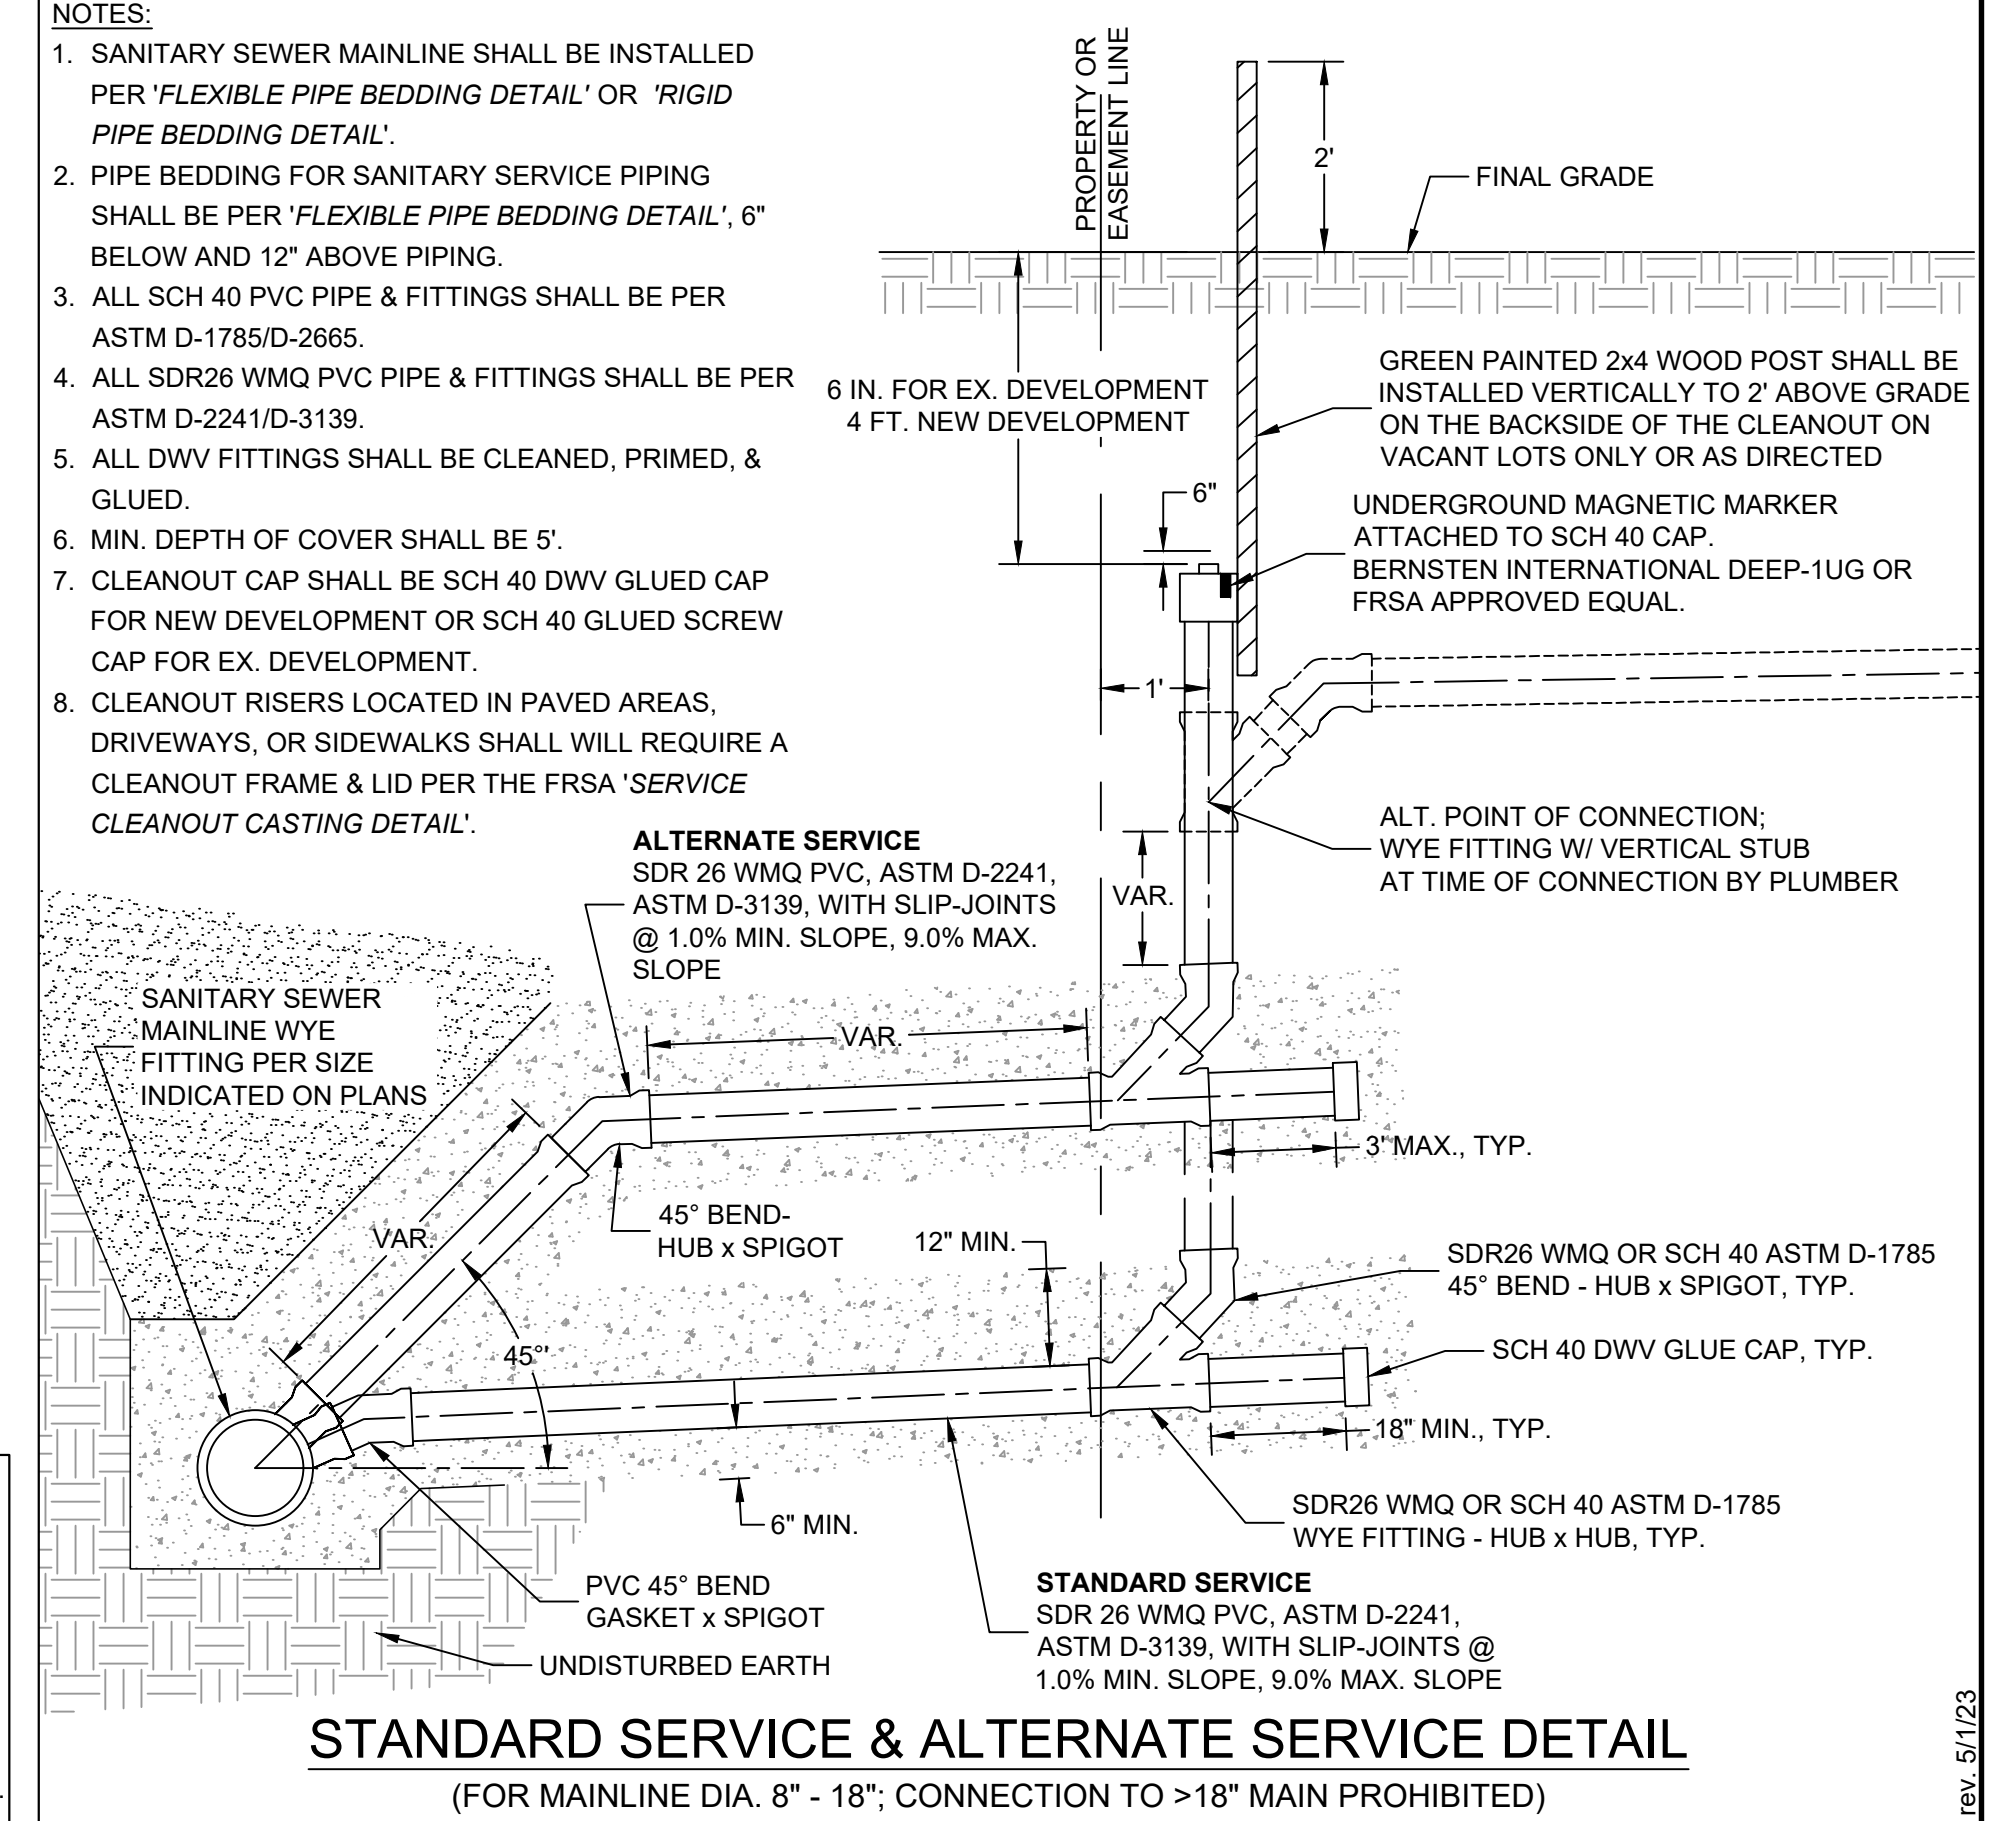

STANDARD SERVICE & ALTERNATE SERVICE DETAIL
(FOR MAINLINE DIA. 8" - 18"; CONNECTION TO >18" MAIN PROHIBITED)


rev. 5/1/23

01/01/2021 Revisions: Manhole Adjustment Detail: Revised notes 1 & 2 with acceptable frames & lids. Modified notes 3, 5, & 7. Added note 8. Revised Rock River Reclamation District to Four Rivers Sanitation Authority. Inside Drop Connection Detail: Revised notes 6 & 7. Added note 8. Service Cleanout Casting Detail: Added this section.

FOUR RIVERS SANITATION AUTHORITY (FRSA) STANDARD DETAIL SHEET
(NOT TO SCALE)

3501 KISHWAUKEE ST.
ROCKFORD, ILLINOIS 61109 PH. (815) 387-7660


ISSUE 05/01/2023

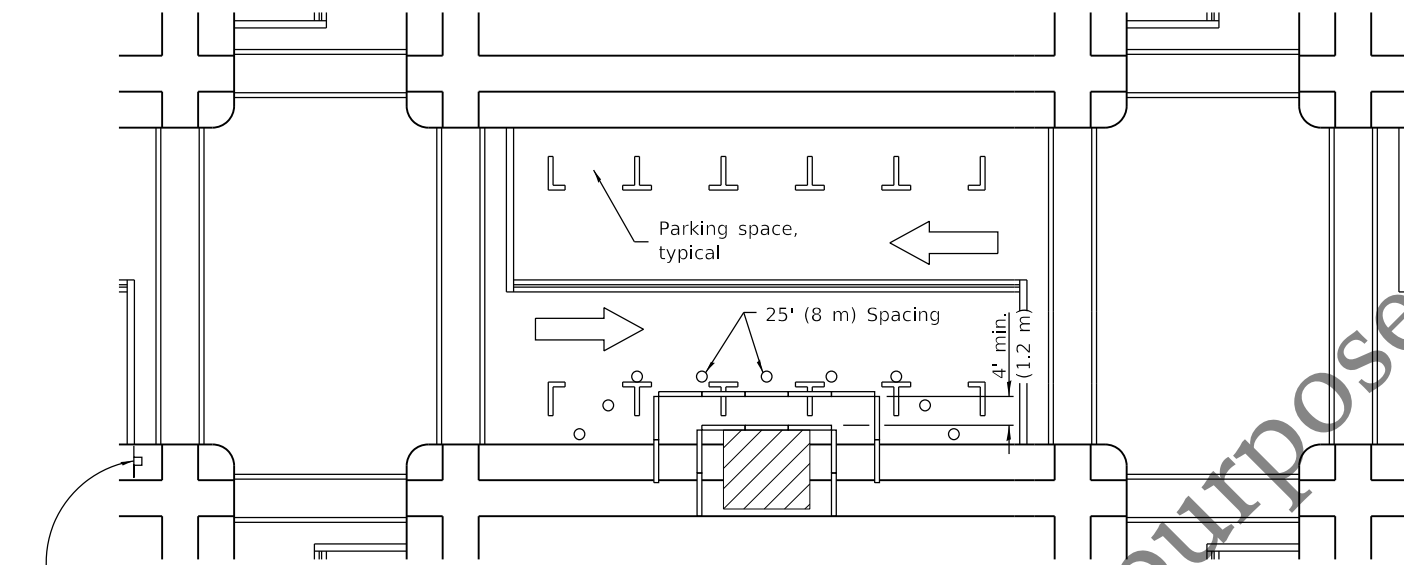

① ROAD CONSTRUCTION AHEAD W20-1103(0)-48 for contract construction projects

Or
① ROAD WORK AHEAD W20-1(0)-48 for maintenance and utility projects

SIDEWALK DIVERSION

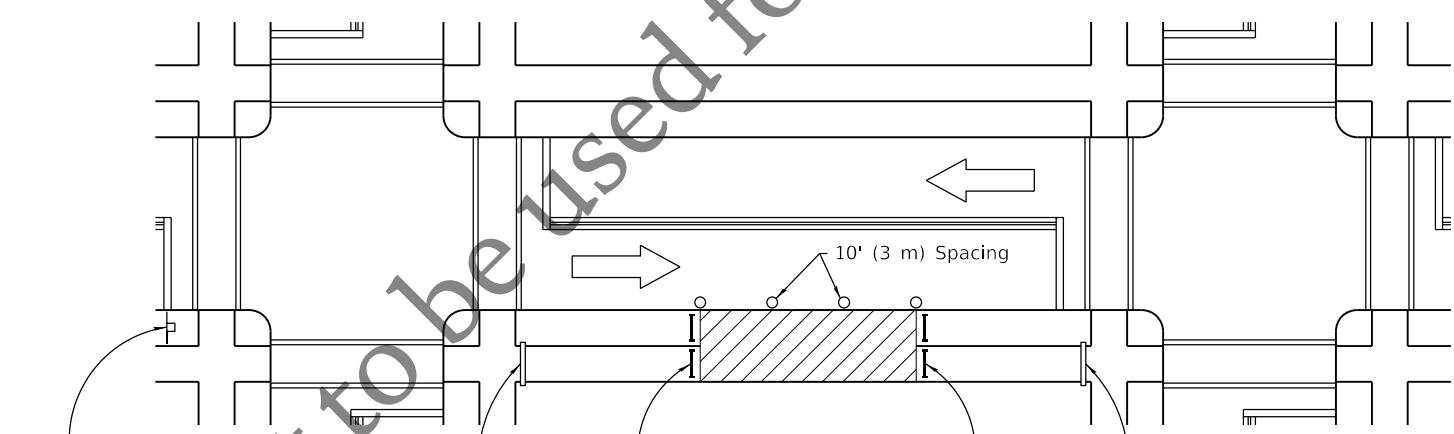

① ROAD CONSTRUCTION AHEAD W20-1103(0)-48 for contract construction projects

Or
① ROAD WORK AHEAD W20-1(0)-48 for maintenance and utility projects

SIDEWALK CLOSED
←
USE OTHER SIDE
R11-I102-2430

SIDEWALK CLOSED
R11-I101-2418

SIDEWALK CLOSED
→
USE OTHER SIDE
R11-I102-2430

SIDEWALK CLOSURE

① Omit whenever duplicated by road work traffic control.

GENERAL NOTES

This Standard is used where, at any time, pedestrian traffic must be rerouted due to work being performed.

This Standard must be used in conjunction with other Traffic Control & Protection Standards when roadway traffic is affected.

Temporary facilities shall be detectable and accessible.

The temporary pedestrian facilities shall be provided on the same side of the closed facilities whenever possible.

The SIDEWALK CLOSED / USE OTHER SIDE sign shall be placed at the nearest crosswalk or intersection to each end of the closure. Where the closure occurs at a corner, the signs shall be erected on the corners across the street from the closure. The SIDEWALK CLOSED signs shall be used at the ends of the actual closures.

Type III barricades and R11-2-4830 signs shall be positioned as shown in "ROAD CLOSED TO ALL TRAFFIC" detail on Standard 701901.

All dimensions are in inches (millimeters) unless otherwise shown.

SYMBOLS

- Work area
- Sign on portable or permanent support
- Barricade or drum
- Cone, drum or barricade
- Type III barricade
- Detectable pedestrian channelizing barricade

Illinois Department of Transportation

PASSED April 1, 2016
[Signature]
ENGINEER OF SAFETY ENGINEERING

APPROVED April 1, 2016
[Signature]
ENGINEER OF DESIGN AND ENVIRONMENT


ISSUED 1-1-97

DATE	REVISIONS
4-1-16	Omitted orange safety fence from standard as this is covered in the std. spec.
1-1-12	Added SIDEWALK DIVERSION. Modified appearance of plan views. Renamed Std.

SIDEWALK, CORNER OR CROSSWALK CLOSURE


(Sheet 1 of 2)

STANDARD 701801-06

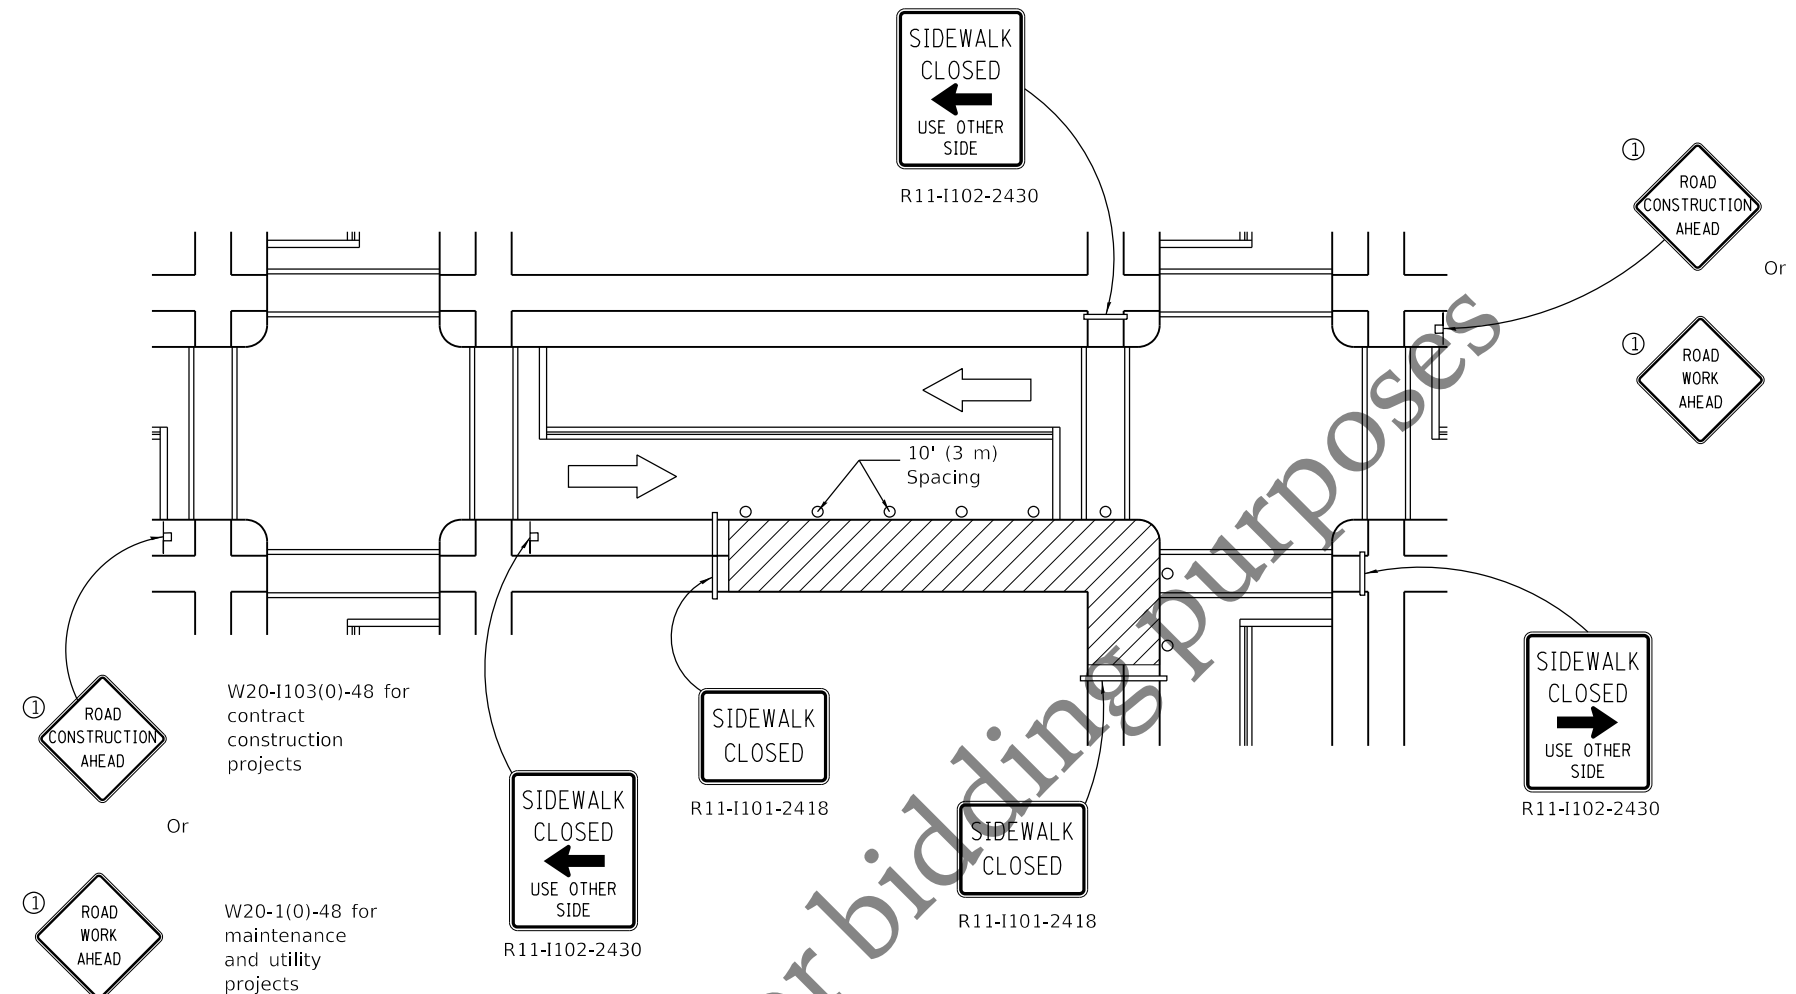

W20-I103(0)-48 for contract construction projects
Or
W20-1(0)-48 for maintenance and utility projects

CORNER CLOSURE

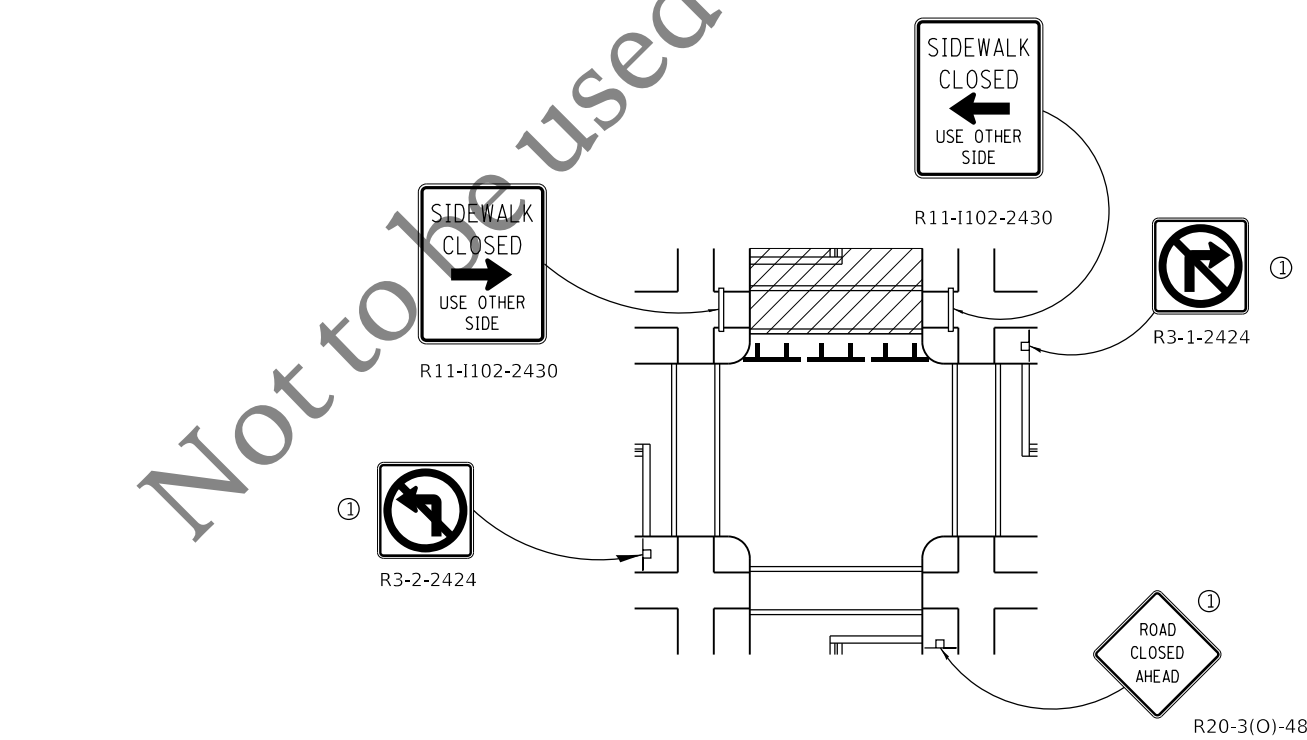

CROSSWALK CLOSURE

SIDEWALK, CORNER OR CROSSWALK CLOSURE

(Sheet 2 of 2)

STANDARD 701801-06

Illinois Department of Transportation

PASSED April 1, 2016


[Signature]
ENGINEER OF SAFETY ENGINEERING

APPROVED April 1, 2016


[Signature]
ENGINEER OF DESIGN AND ENVIRONMENT

ISSUED 1-1-97


Not to be used for bidding purposes

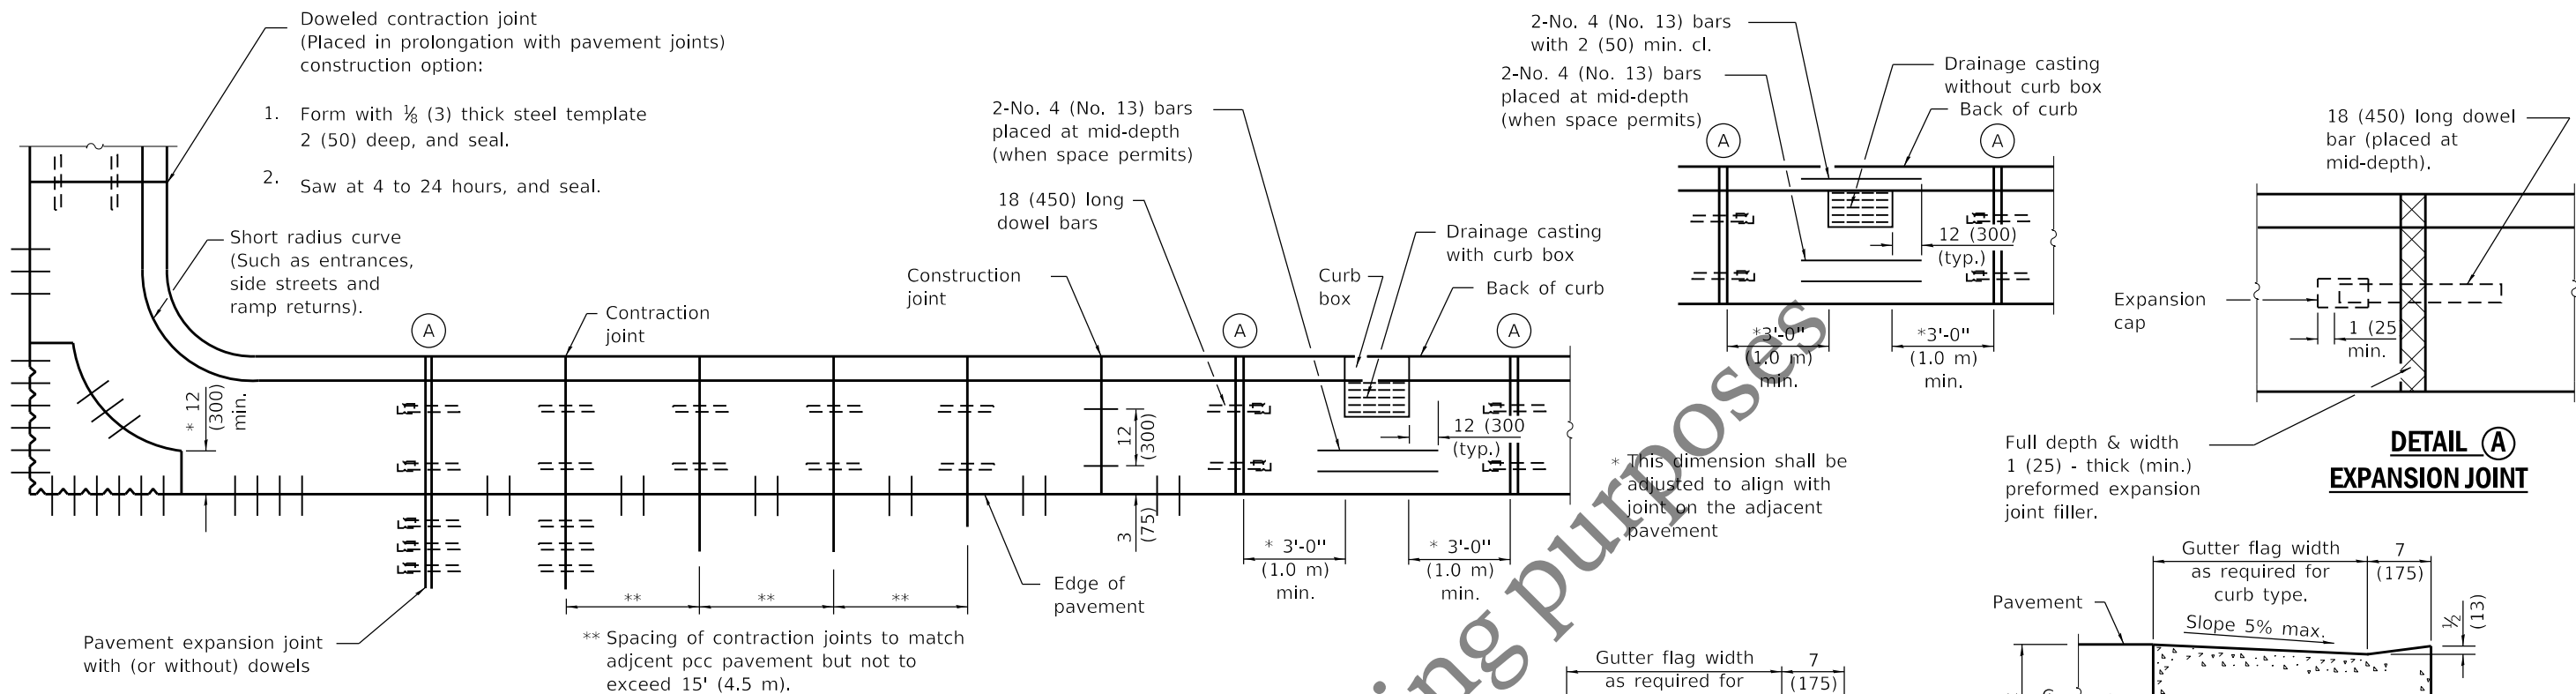


PLAN
ADJACENT TO PCC PAVEMENT OR PCC BASE COURSE

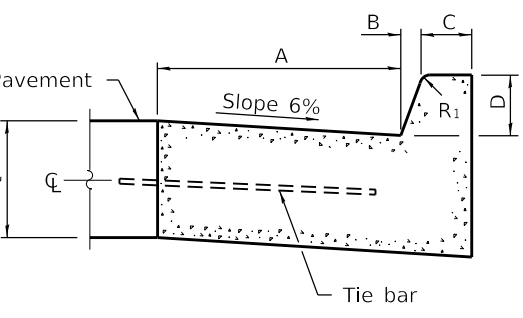


BARRIER CURB

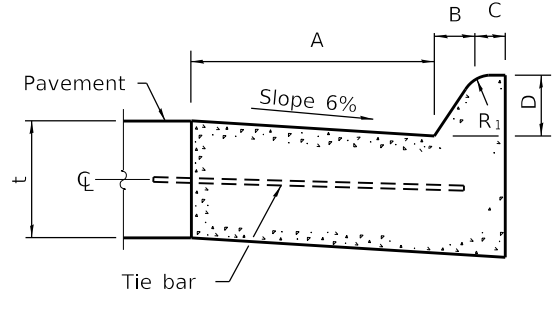


MOUNTABLE CURB

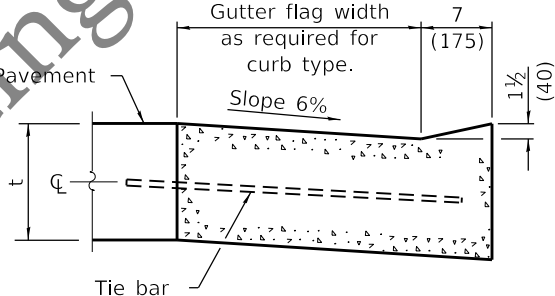


DEPRESSED CURB (TYPICAL)

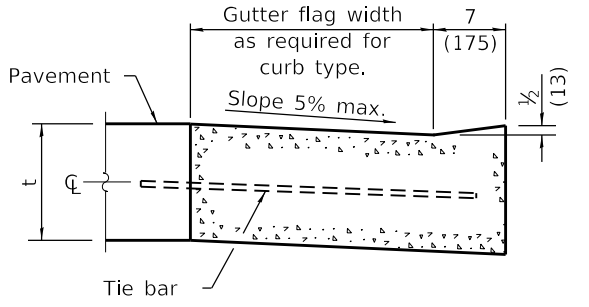

DEPRESSED CURB ADJACENT TO CURB RAMP ACCESSIBLE TO THE DISABLED

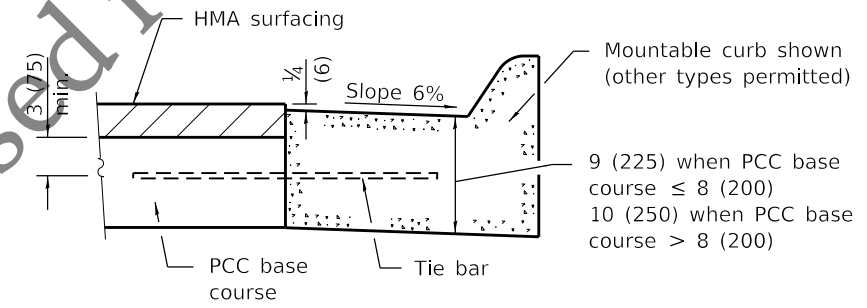

ADJACENT TO PCC BASE COURSE WITH HMA SURFACING

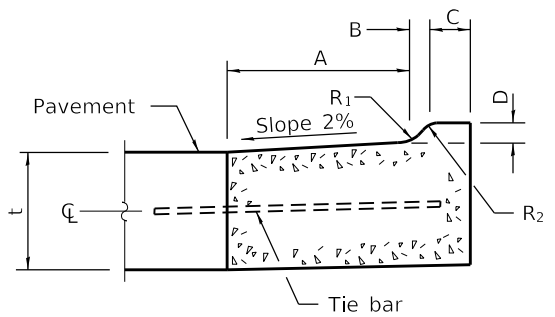

M-2.06 (M-5.15) and M-2.12 (M-5.30)

TABLE OF DIMENSIONS BARRIER CURB

TYPE	A	B	C	D	R ₁
B-6.06 *	6	1	6	6	1
(B-15.15)	(150)	(25)	(150)	(150)	(25)
B-6.12	12	1	6	6	1
(B-15.3)	(300)	(25)	(150)	(150)	(25)
B-6.18	18	1	6	6	1
(B-15.45)	(450)	(25)	(150)	(150)	(25)
B-6.24	24	1	6	6	1
(B-15.60)	(600)	(25)	(150)	(150)	(25)
B-9.12	12	2	5	9	1
(B-22.30)	(300)	(50)	(125)	(225)	(25)
B-9.18	18	2	5	9	1
(B-22.45)	(450)	(50)	(125)	(225)	(25)
B-9.24	24	2	5	9	1
(B-22.60)	(600)	(50)	(125)	(225)	(25)

TABLE OF DIMENSIONS MOUNTABLE CURB

TYPE	A	B	C	D	R ₁	R ₂
M-2.06	6	2	4	2	3	2
(M-5.15)	(150)	(50)	(100)	(50)	(75)	(50)
M-2.12	12	2	4	2	3	2
(M-5.30)	(300)	(50)	(100)	(50)	(75)	(50)
M-4.06	6	4	3	4	3	NA
(M-10.15)	(150)	(100)	(75)	(100)	(75)	NA
M-4.12	12	4	3	4	3	NA
(M-10.30)	(300)	(100)	(75)	(100)	(75)	NA
M-4.18	18	4	3	4	3	NA
(M-10.45)	(450)	(100)	(75)	(100)	(75)	NA
M-4.24	24	4	3	4	3	NA
(M-10.60)	(600)	(100)	(75)	(100)	(75)	NA
M-6.06	6	6	2	6	2	NA
(M-15.15)	(150)	(150)	(50)	(150)	(50)	NA
M-6.12	12	6	2	6	2	NA
(M-15.30)	(300)	(150)	(50)	(150)	(50)	NA
M-6.18	18	6	2	6	2	NA
(M-15.45)	(450)	(150)	(50)	(150)	(50)	NA
M-6.24	24	6	2	6	2	NA
(M-15.60)	(600)	(150)	(50)	(150)	(50)	NA

* For corner islands only.

GENERAL NOTES

The bottom slope of combination curb and gutter constructed adjacent to pcc pavement shall be the same slope as the subbase or 6% when subbase is omitted.

t = Thickness of pavement.

Longitudinal joint tie bars shall be No. 6 (No. 19) at 36 (900) centers in accordance with details for longitudinal construction joint shown on Standard 420001.

A minimum clearance of 2 (50) between the end of the tie bar and the back of the curb shall be maintained.

The dowel bars shown in contraction joints will only be required for monolithic construction.

See Standard 606301 for details of corner islands.

All dimensions are in inches (millimeters) unless otherwise shown.

DATE	REVISIONS
1-1-22	Revised contraction joint spacing adjacent to pcc pavement.
1-1-18	Revised General Note for tie bar spacing to 36 (900) cts.

CONCRETE CURB TYPE B AND COMBINATION CONCRETE CURB AND GUTTER
(Sheet 1 of 2)

STANDARD 606001-08

Illinois Department of Transportation


PASSED January 1, 2022

Michael Brand
ENGINEER OF POLICY AND PROCEDURES

APPROVED January 1, 2022

ENGINEER OF DESIGN AND ENVIRONMENT

ISSUED 1-1-97

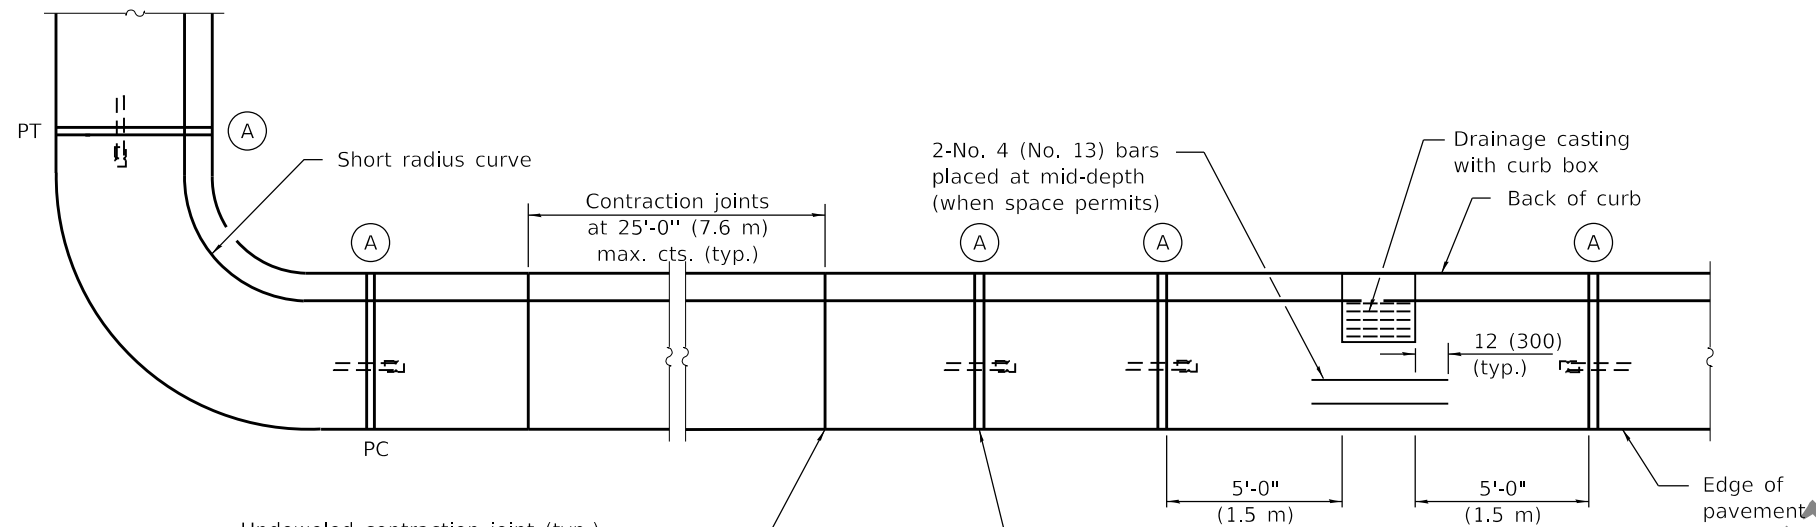


Undoweled contraction joint (typ.) construction options:


1. Form with $\frac{1}{8}$ (3) thick steel template 2 (50) deep, and seal.
2. Saw 2 (50) deep at 4 to 24 hours, and seal.
3. Insert $\frac{3}{4}$ (20) thick preformed joint filler full depth and width.

Construction joint
2-No. 4 (No. 13) bars with 2 (50) min. cl.


2-No. 4 (No. 13) bars placed at mid-depth (when space permits)

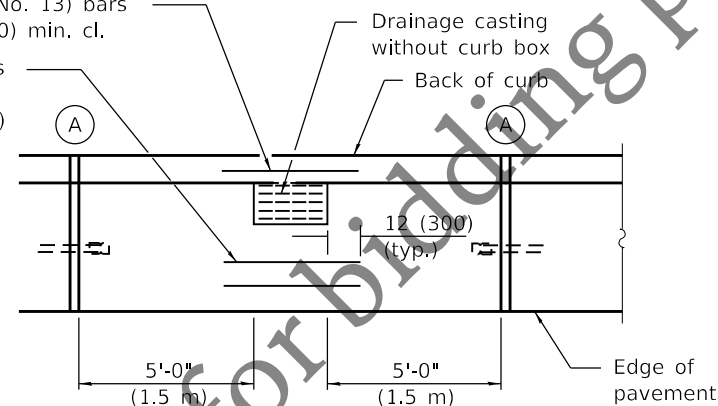

PLAN

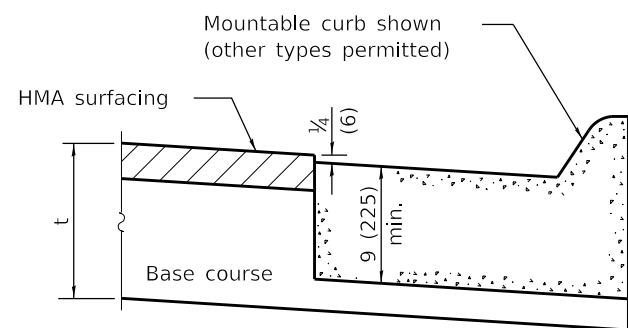


ON DISTURBED SUBGRADE

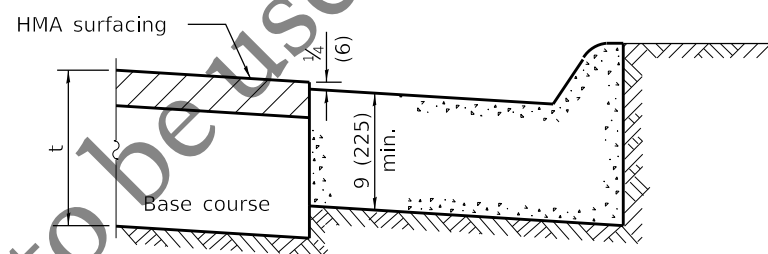


ON UNDISTURBED SUBGRADE

ADJACENT TO FLEXIBLE PAVEMENT

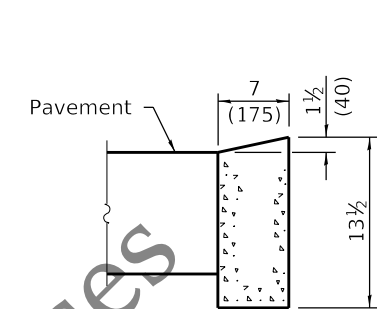


DEPRESSED CURB

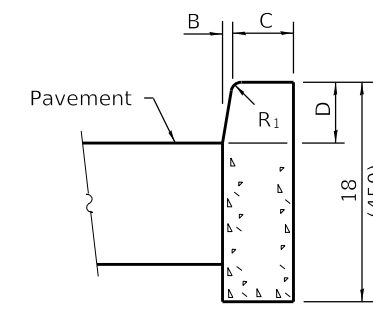


BARRIER CURB

ADJACENT TO FLEXIBLE PAVEMENT

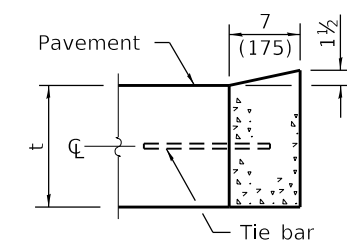

DEPRESSED CURB

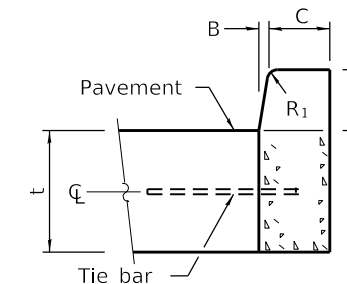

BARRIER CURB

ADJACENT TO PCC PAVEMENT OR PCC BASE COURSE

CONCRETE CURB TYPE B

CONCRETE CURB TYPE B AND COMBINATION CONCRETE CURB AND GUTTER

(Sheet 2 of 2)

STANDARD 606001-08

Illinois Department of Transportation


PASSED January 1, 2022
Michael Beard
 ENGINEER OF POLICY AND PROCEDURES

APPROVED January 1, 2022
John C. ...
 ENGINEER OF DESIGN AND ENVIRONMENT


ISSUED 1-1-97

PLAN	BY	DATE
Surveyed	Paul P. Kowalski	2/17/68
Designed	Paul P. Kowalski	2/17/68
Checked	Engineer J. Johnson	2/21/68
Approved	Engineer J. Johnson	2/21/68
No.	3	

PROFILE	BY	DATE
Surveyed	Paul P. Kowalski	2/17/68
Designed	Paul P. Kowalski	2/17/68
Checked	Engineer J. Johnson	2/21/68
Approved	Engineer J. Johnson	2/21/68
No.	3	

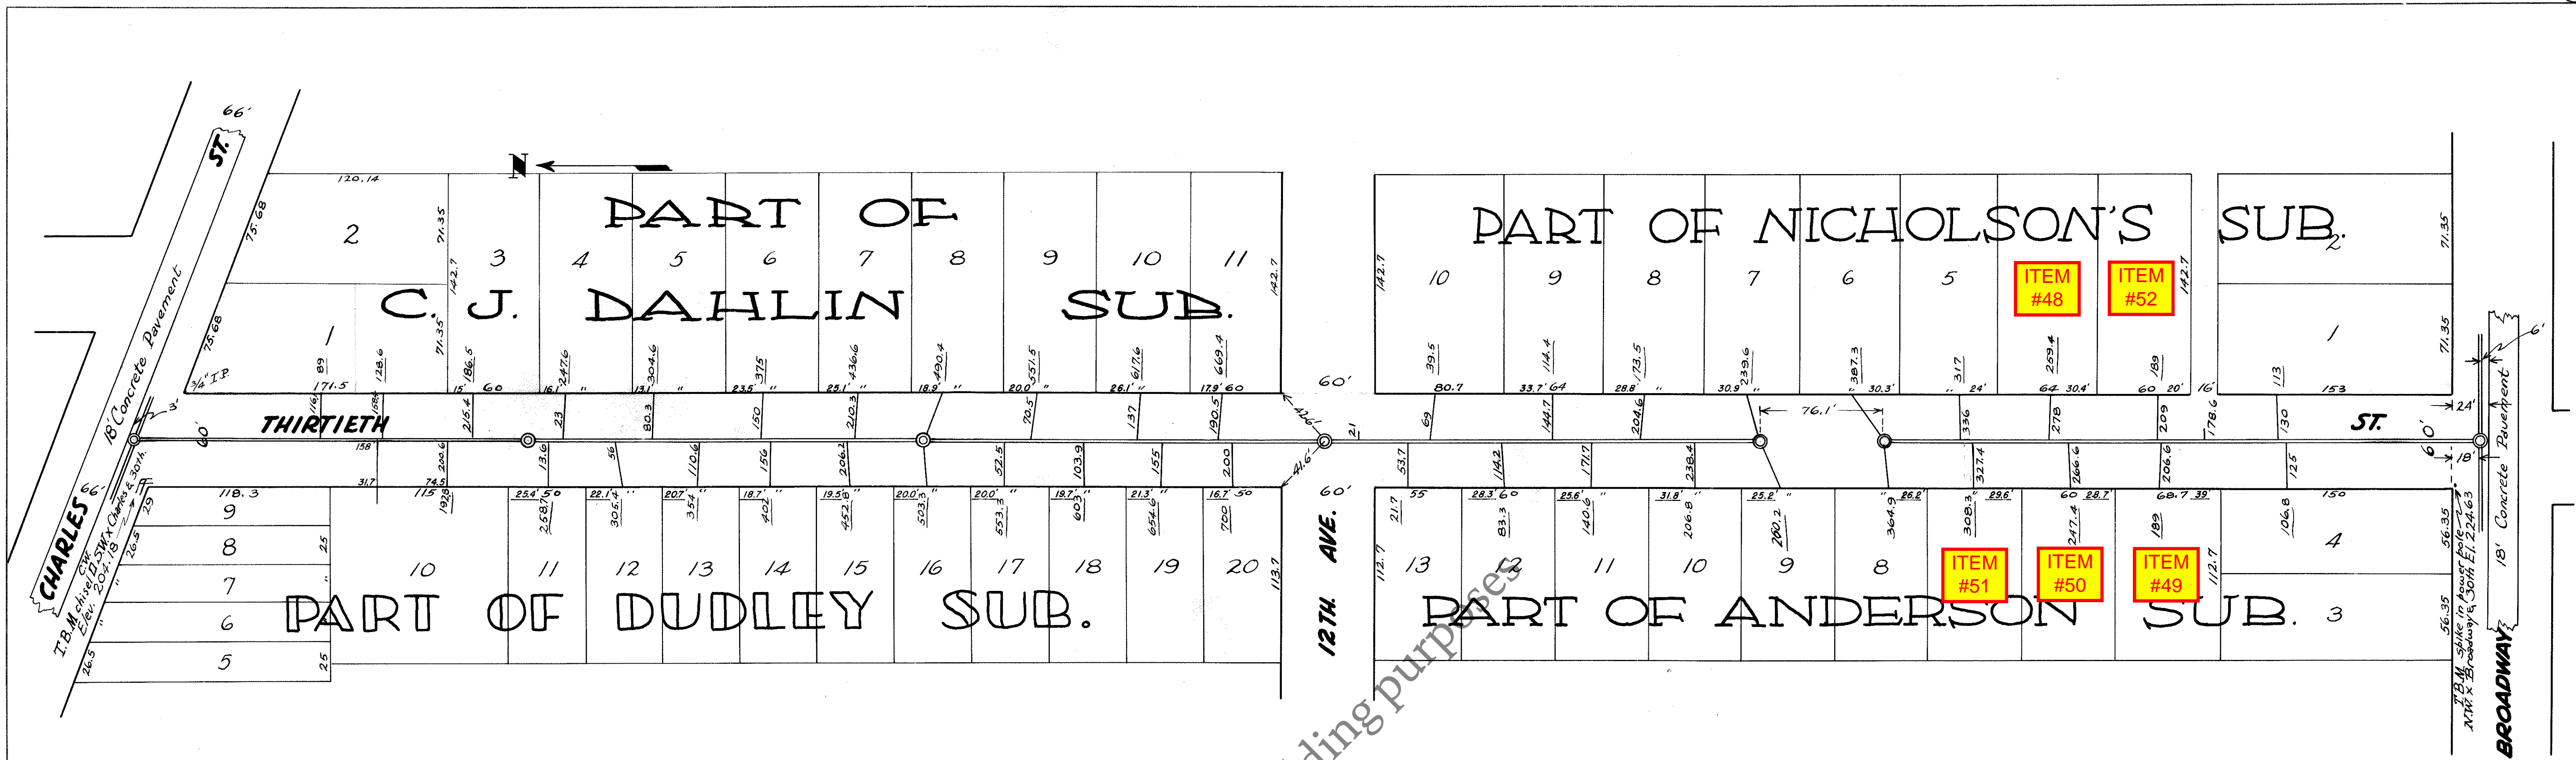

PLAN

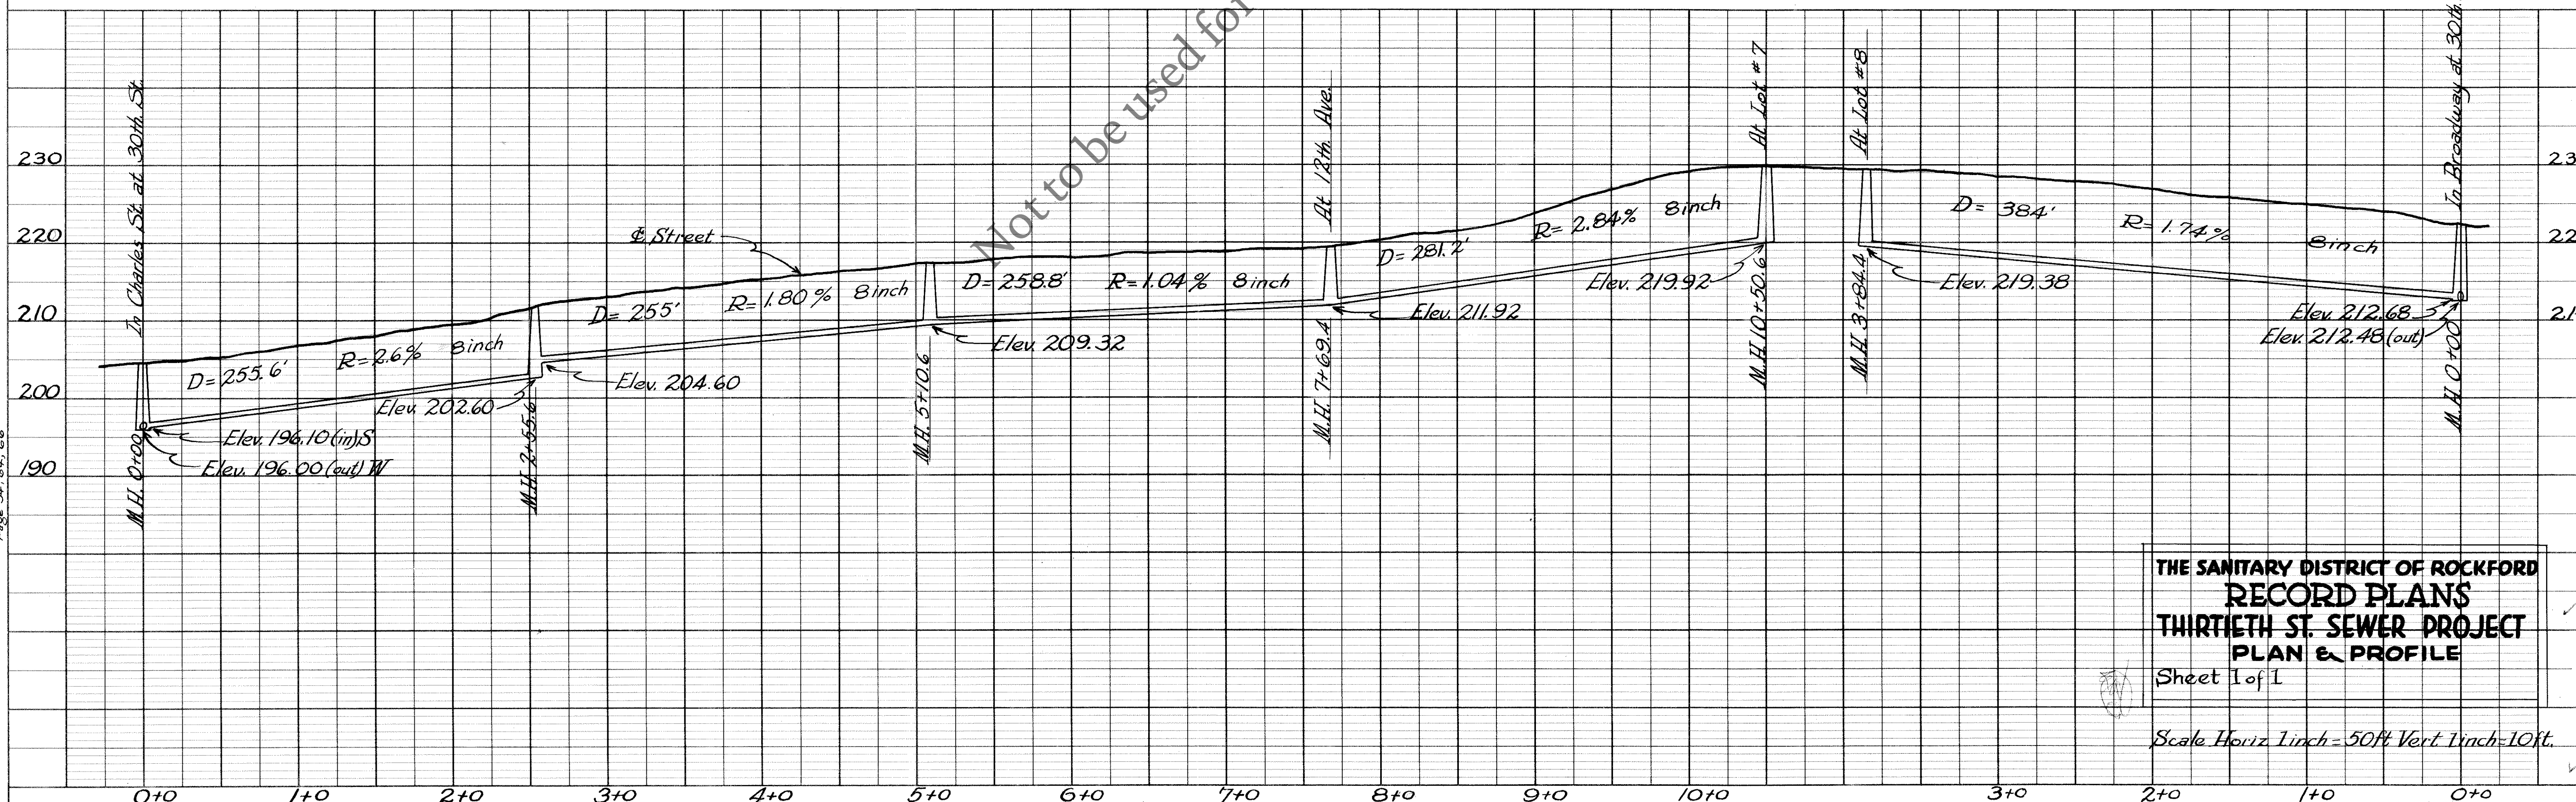

PROFILE

THE SANITARY DISTRICT OF ROCKFORD
 RECORD PLANS
 THIRTIETH ST. SEWER PROJECT
 PLAN & PROFILE
 Sheet 1 of 1

Scale Horiz 1 inch = 50 ft Vert 1 inch = 10 ft.

581

5' 0" 21.0

2337

23 1/2 STREET

HILL VIEW

24-TH

SUB. NO. 3

HIGHLAND

ITEM #1009

ITEM #1010

MARION'S SUB.

CONSTRUCTION CO
NORTHWEST
SUBD. OF
TRACT

School

Not to be used for bidding purposes

see 187(1)


need lift to
for this property
to check point

SEE PLAT 187-1
for INSERT
(BRADLEY MANOR)


25 TH

W

E

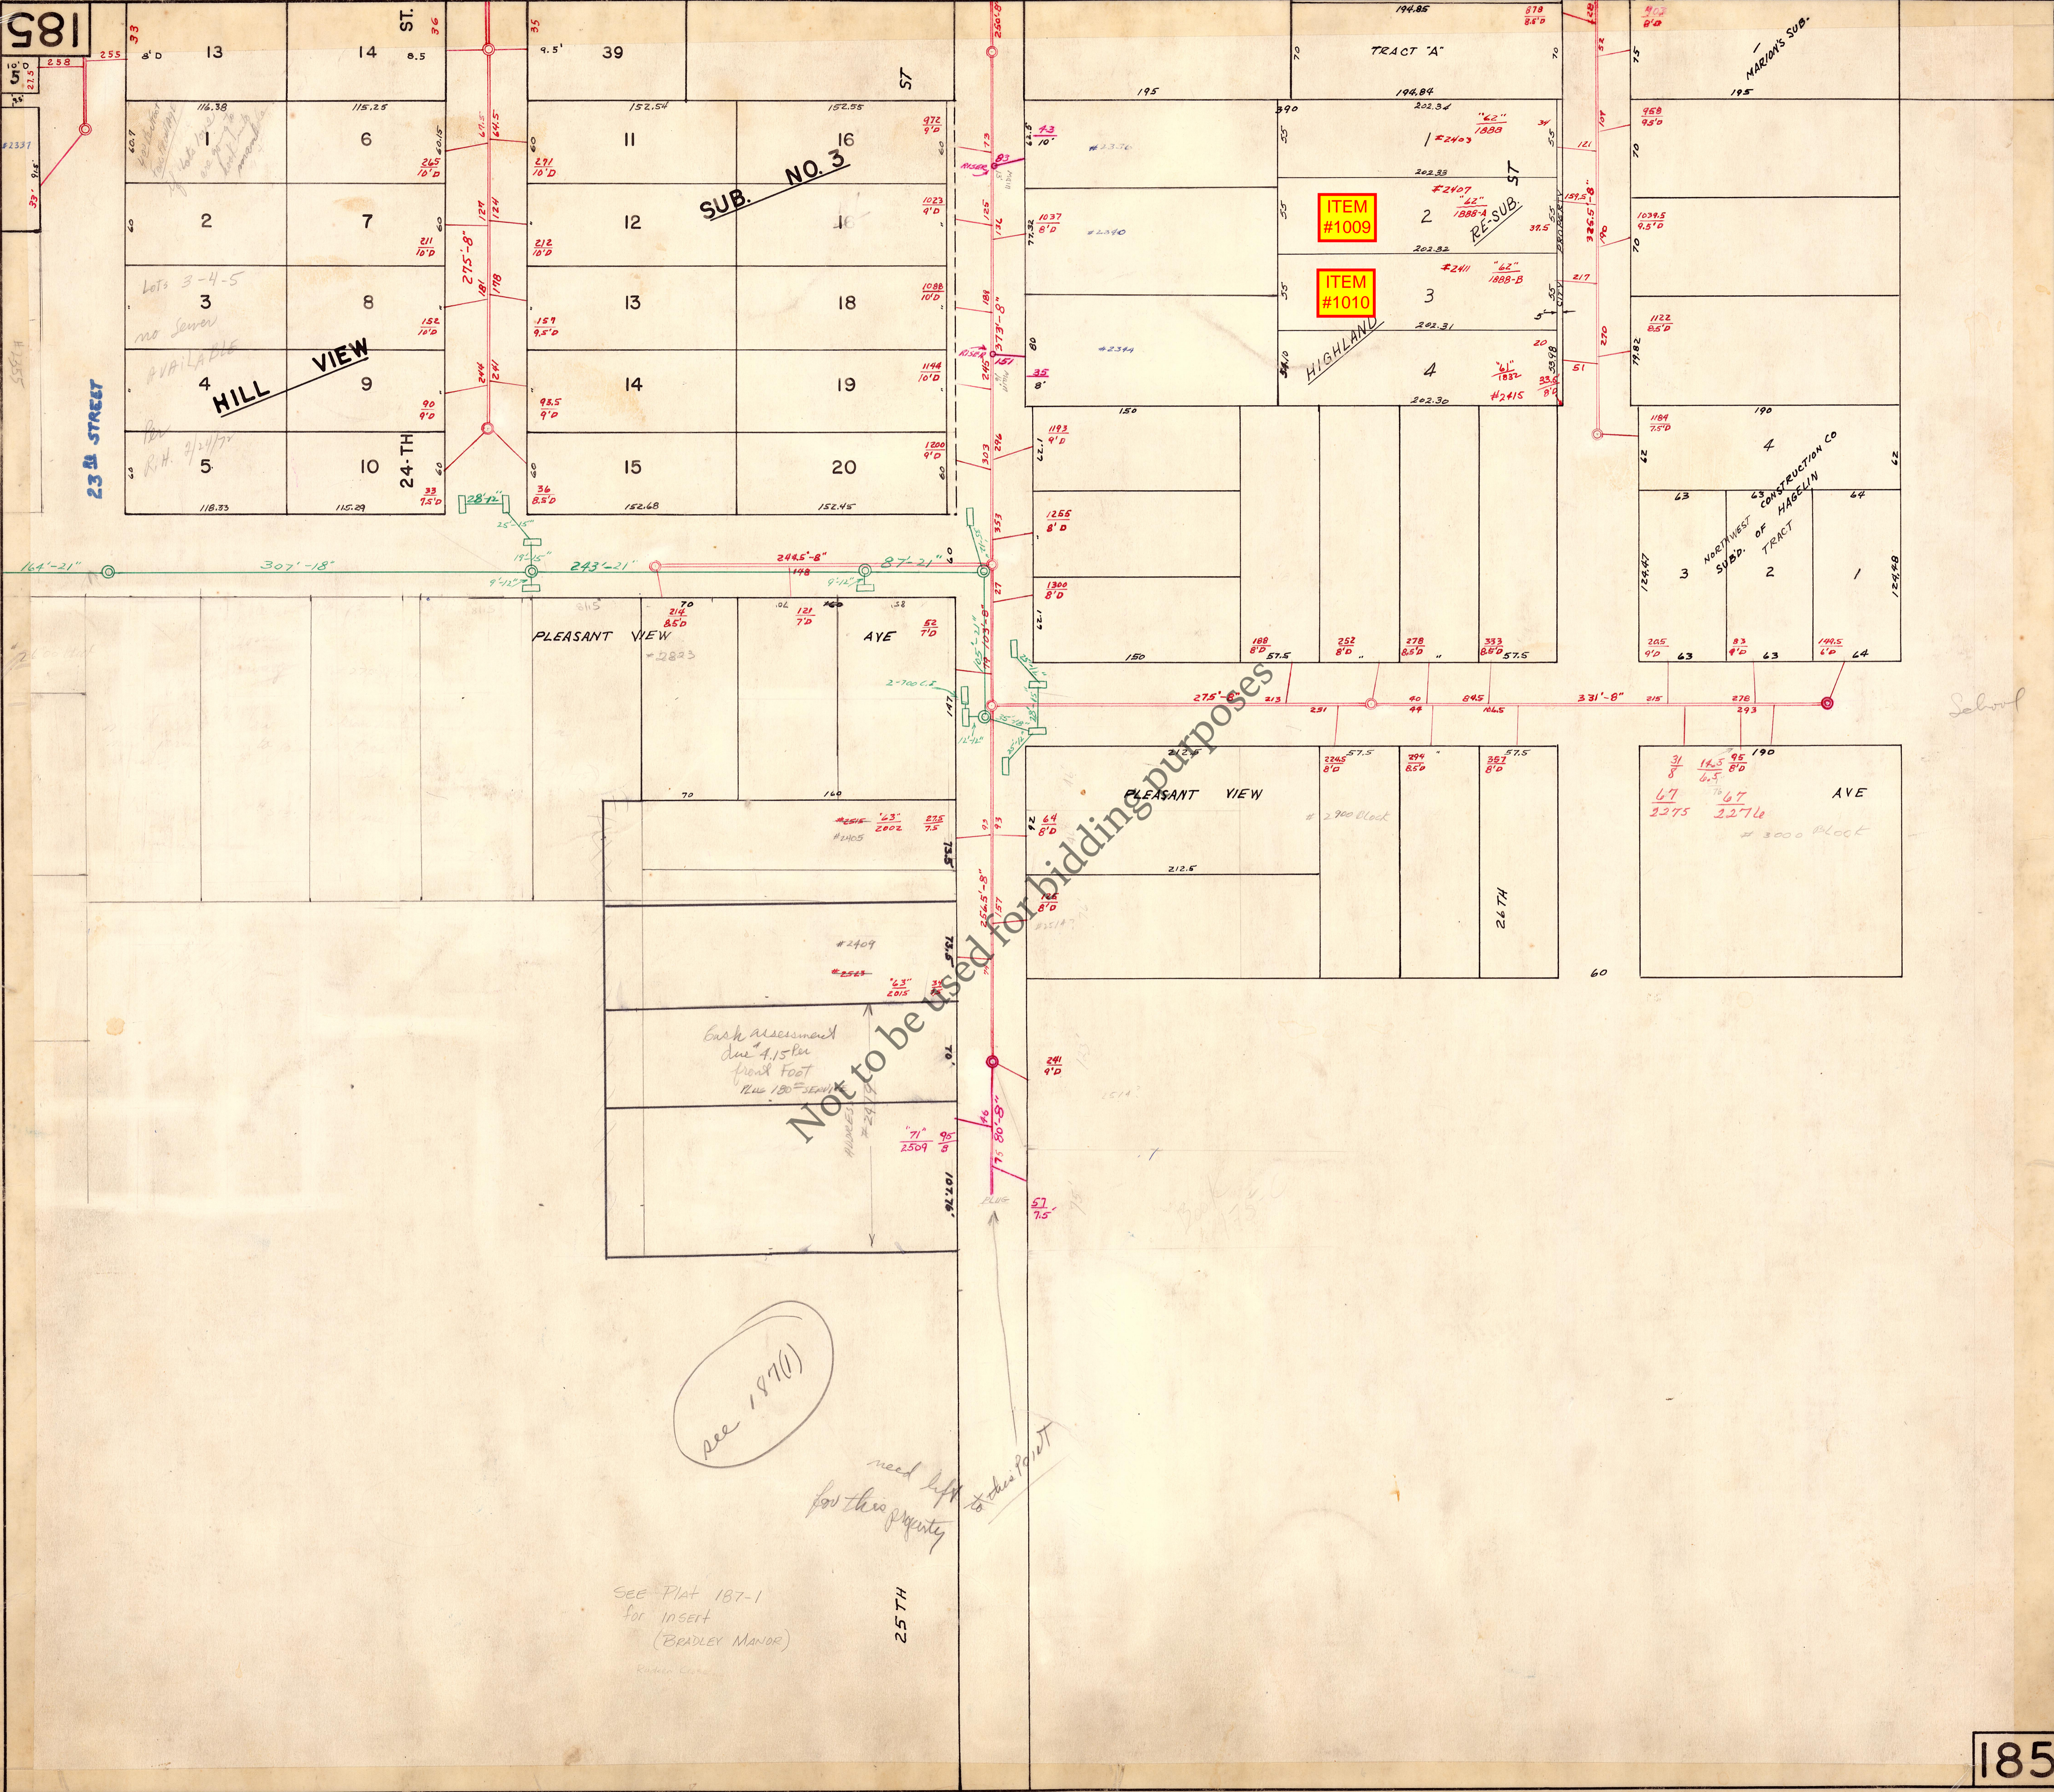



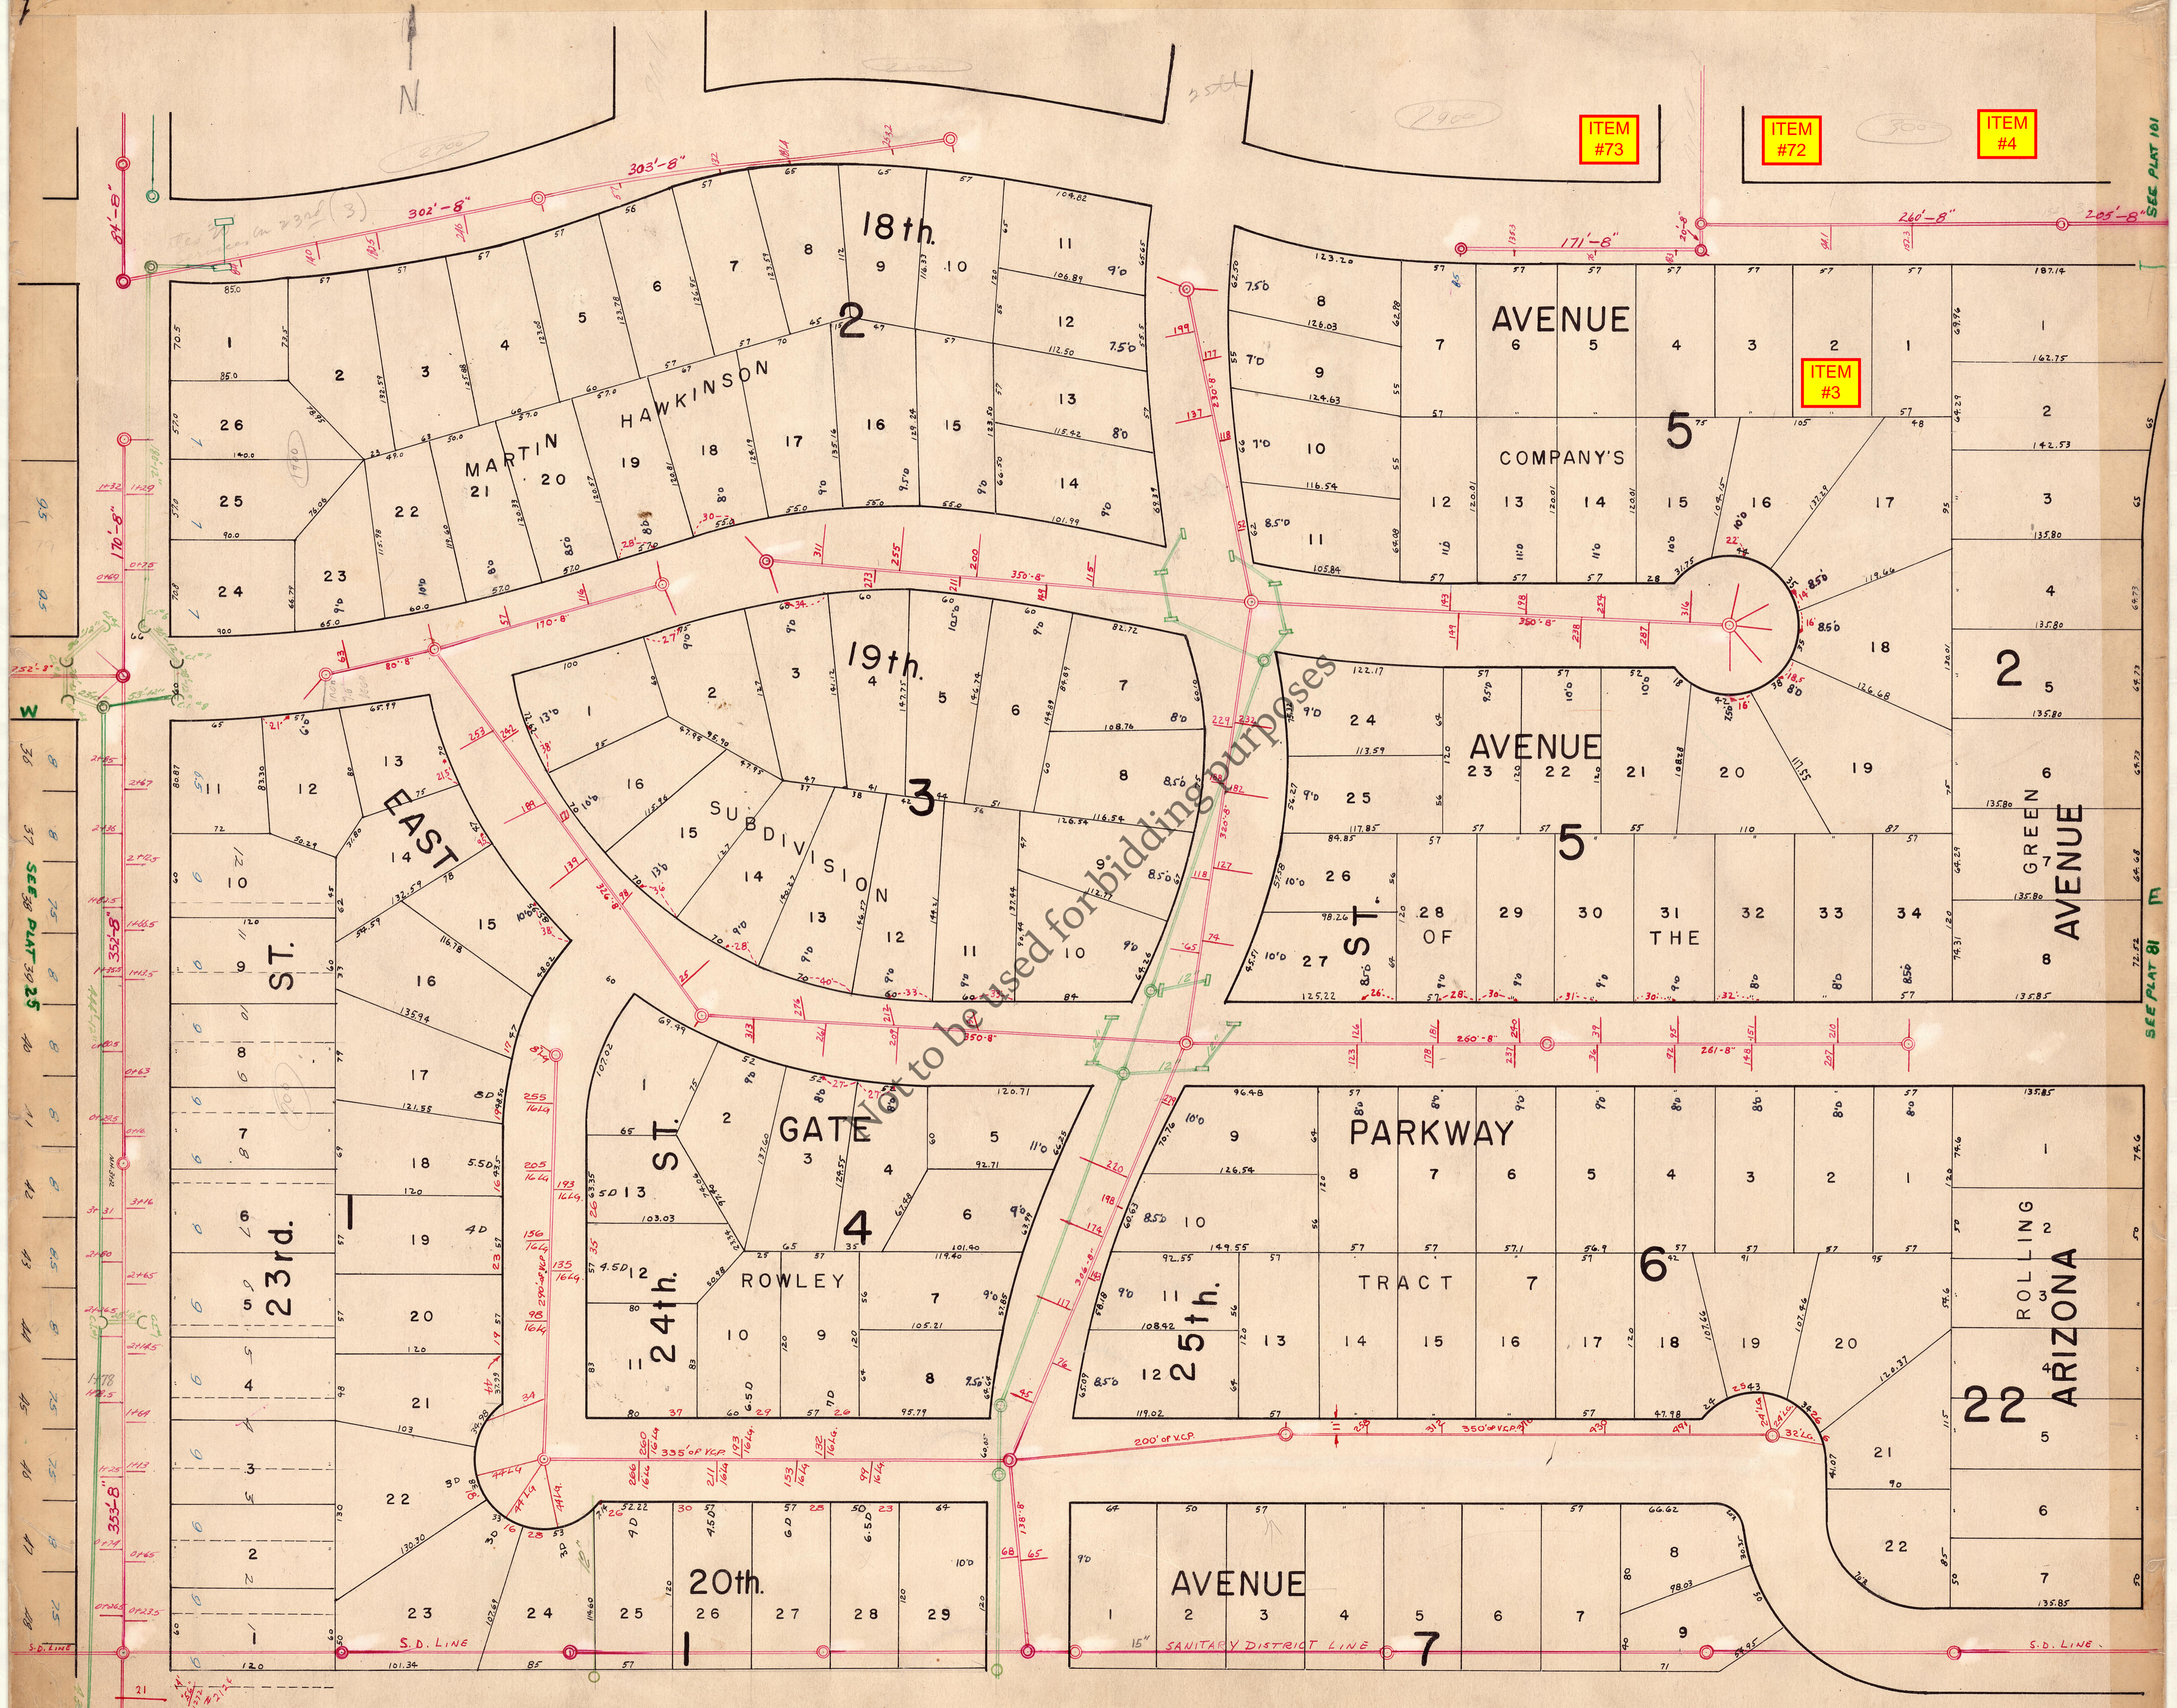


ITEM #73

ITEM #72

ITEM #4

ITEM #3

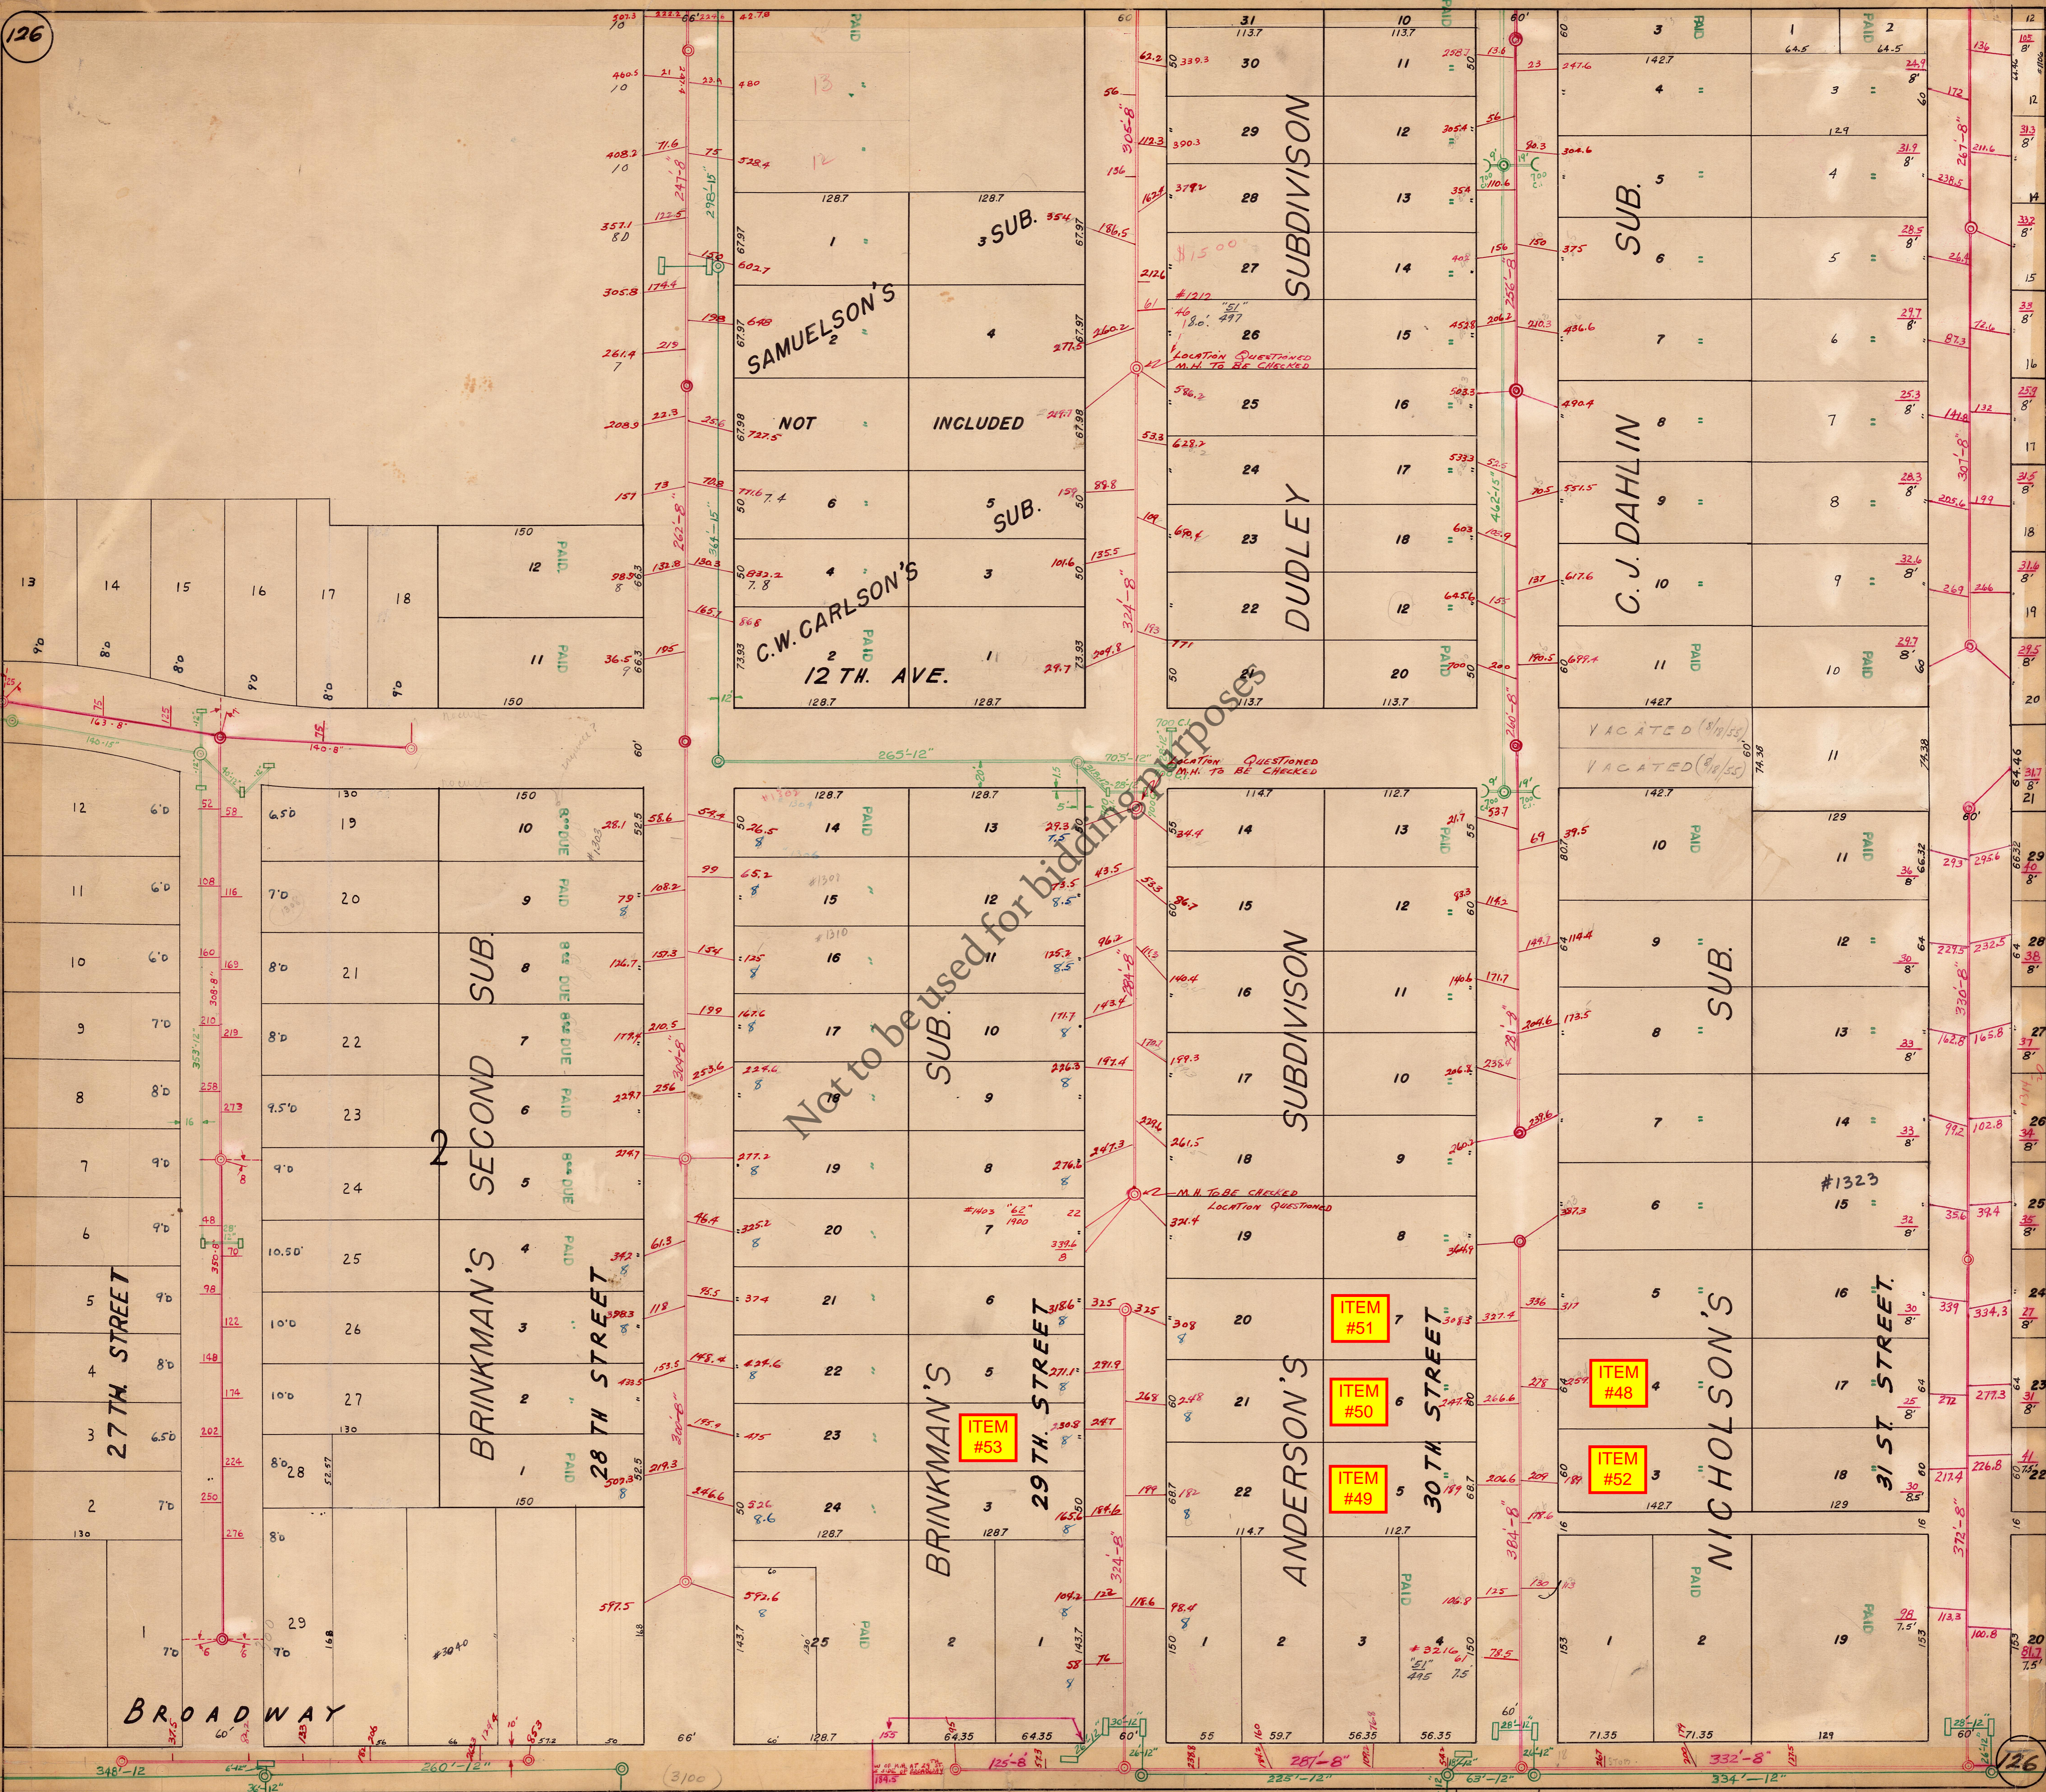

SAMUELSON'S

C.W. CARLSON'S
12 TH. AVE.

BRINKMAN'S
SECOND SUB.

BRINKMAN'S
28 TH STREET

BRINKMAN'S

29 TH STREET

ANDERSON'S

30 TH STREET

NICHOLSON'S

31 ST STREET

SUBDIVISION

DUDLEY

SUBDIVISION

ANDERSON'S

SUB.

C.J. DAHLIN

SUB.

NICHOLSON'S

BROADWAY

27 TH STREET

BRINKMAN'S
28 TH STREET

29 TH STREET

30 TH STREET

31 ST STREET

BROADWAY

27 TH STREET

BRINKMAN'S
28 TH STREET

29 TH STREET

30 TH STREET

31 ST STREET



PARK

BROADWAY

MINNESOTA DRIVE

CALIFORNIA ROAD

WEST GATE PARKWAY

MARYLAND ROAD

UTAH PLACE

18 TH. AVE.

OHIO PARKWAY
SEE PLAT B

SEE PLAT 37

ITEM #7

ITEM #9

ITEM #10

ITEM #11

ITEM #12

ITEM #13

ITEM #15

ITEM #14

ITEM #8

ITEM #20

ITEM #21

ITEM #23

ITEM #22

ITEM #24



21

22

32

9

20

19

23

24

25

30

ITEM #1

ITEM #2

ITEM #7

ITEM #6

ITEM #5

ARIZONA AVENUE

20 TH AVE

SEE SANITARY DIST. 166.3'-15"

OREGON AVENUE


OHIO PARKWAY

PARK

CAROLINA AVENUE

SEE PLAT 127

SEE PLAT 43

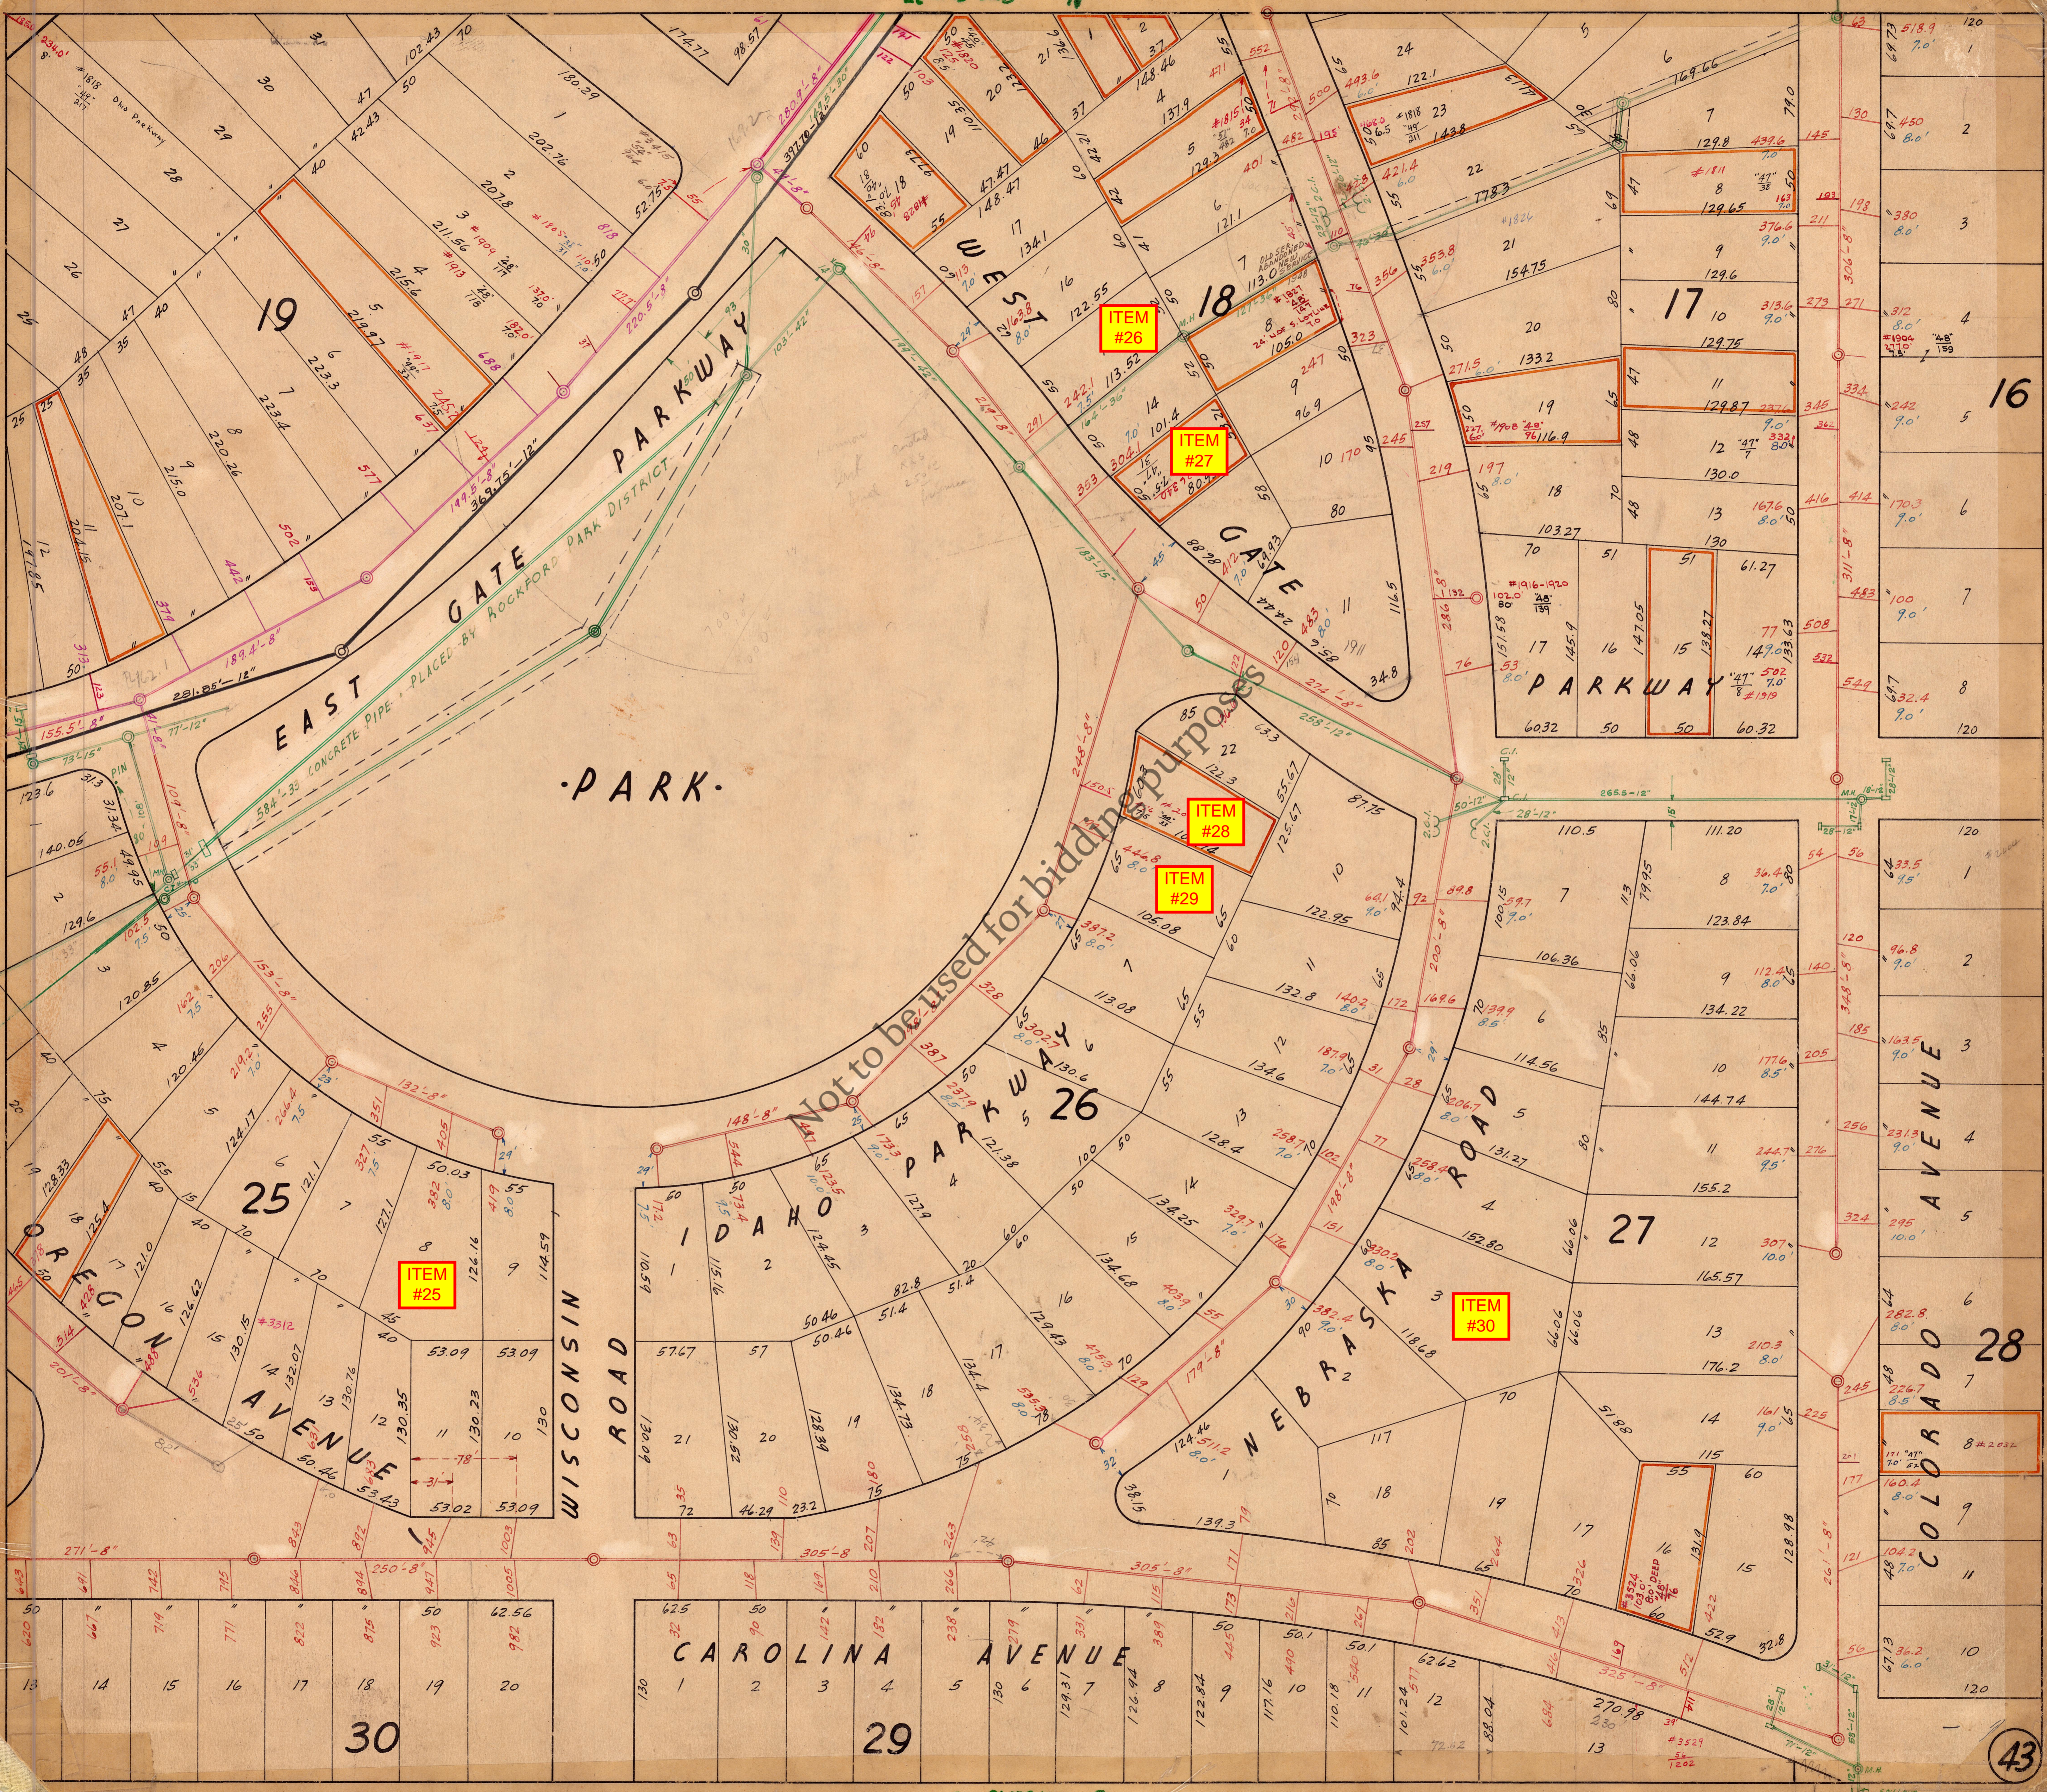

PARK

19

ITEM #26

ITEM #27

ITEM #28

ITEM #29

ITEM #25

ITEM #30

25

26

27

28

30

29

43

Not to be used for bidding purposes

EAST GATE PARKWAY

WEST GATE PARKWAY

OREGON AVENUE


WISCONSIN ROAD

IDAHO PARKWAY

NEBRASKA ROAD


CAROLINA AVENUE

COLORADO AVENUE

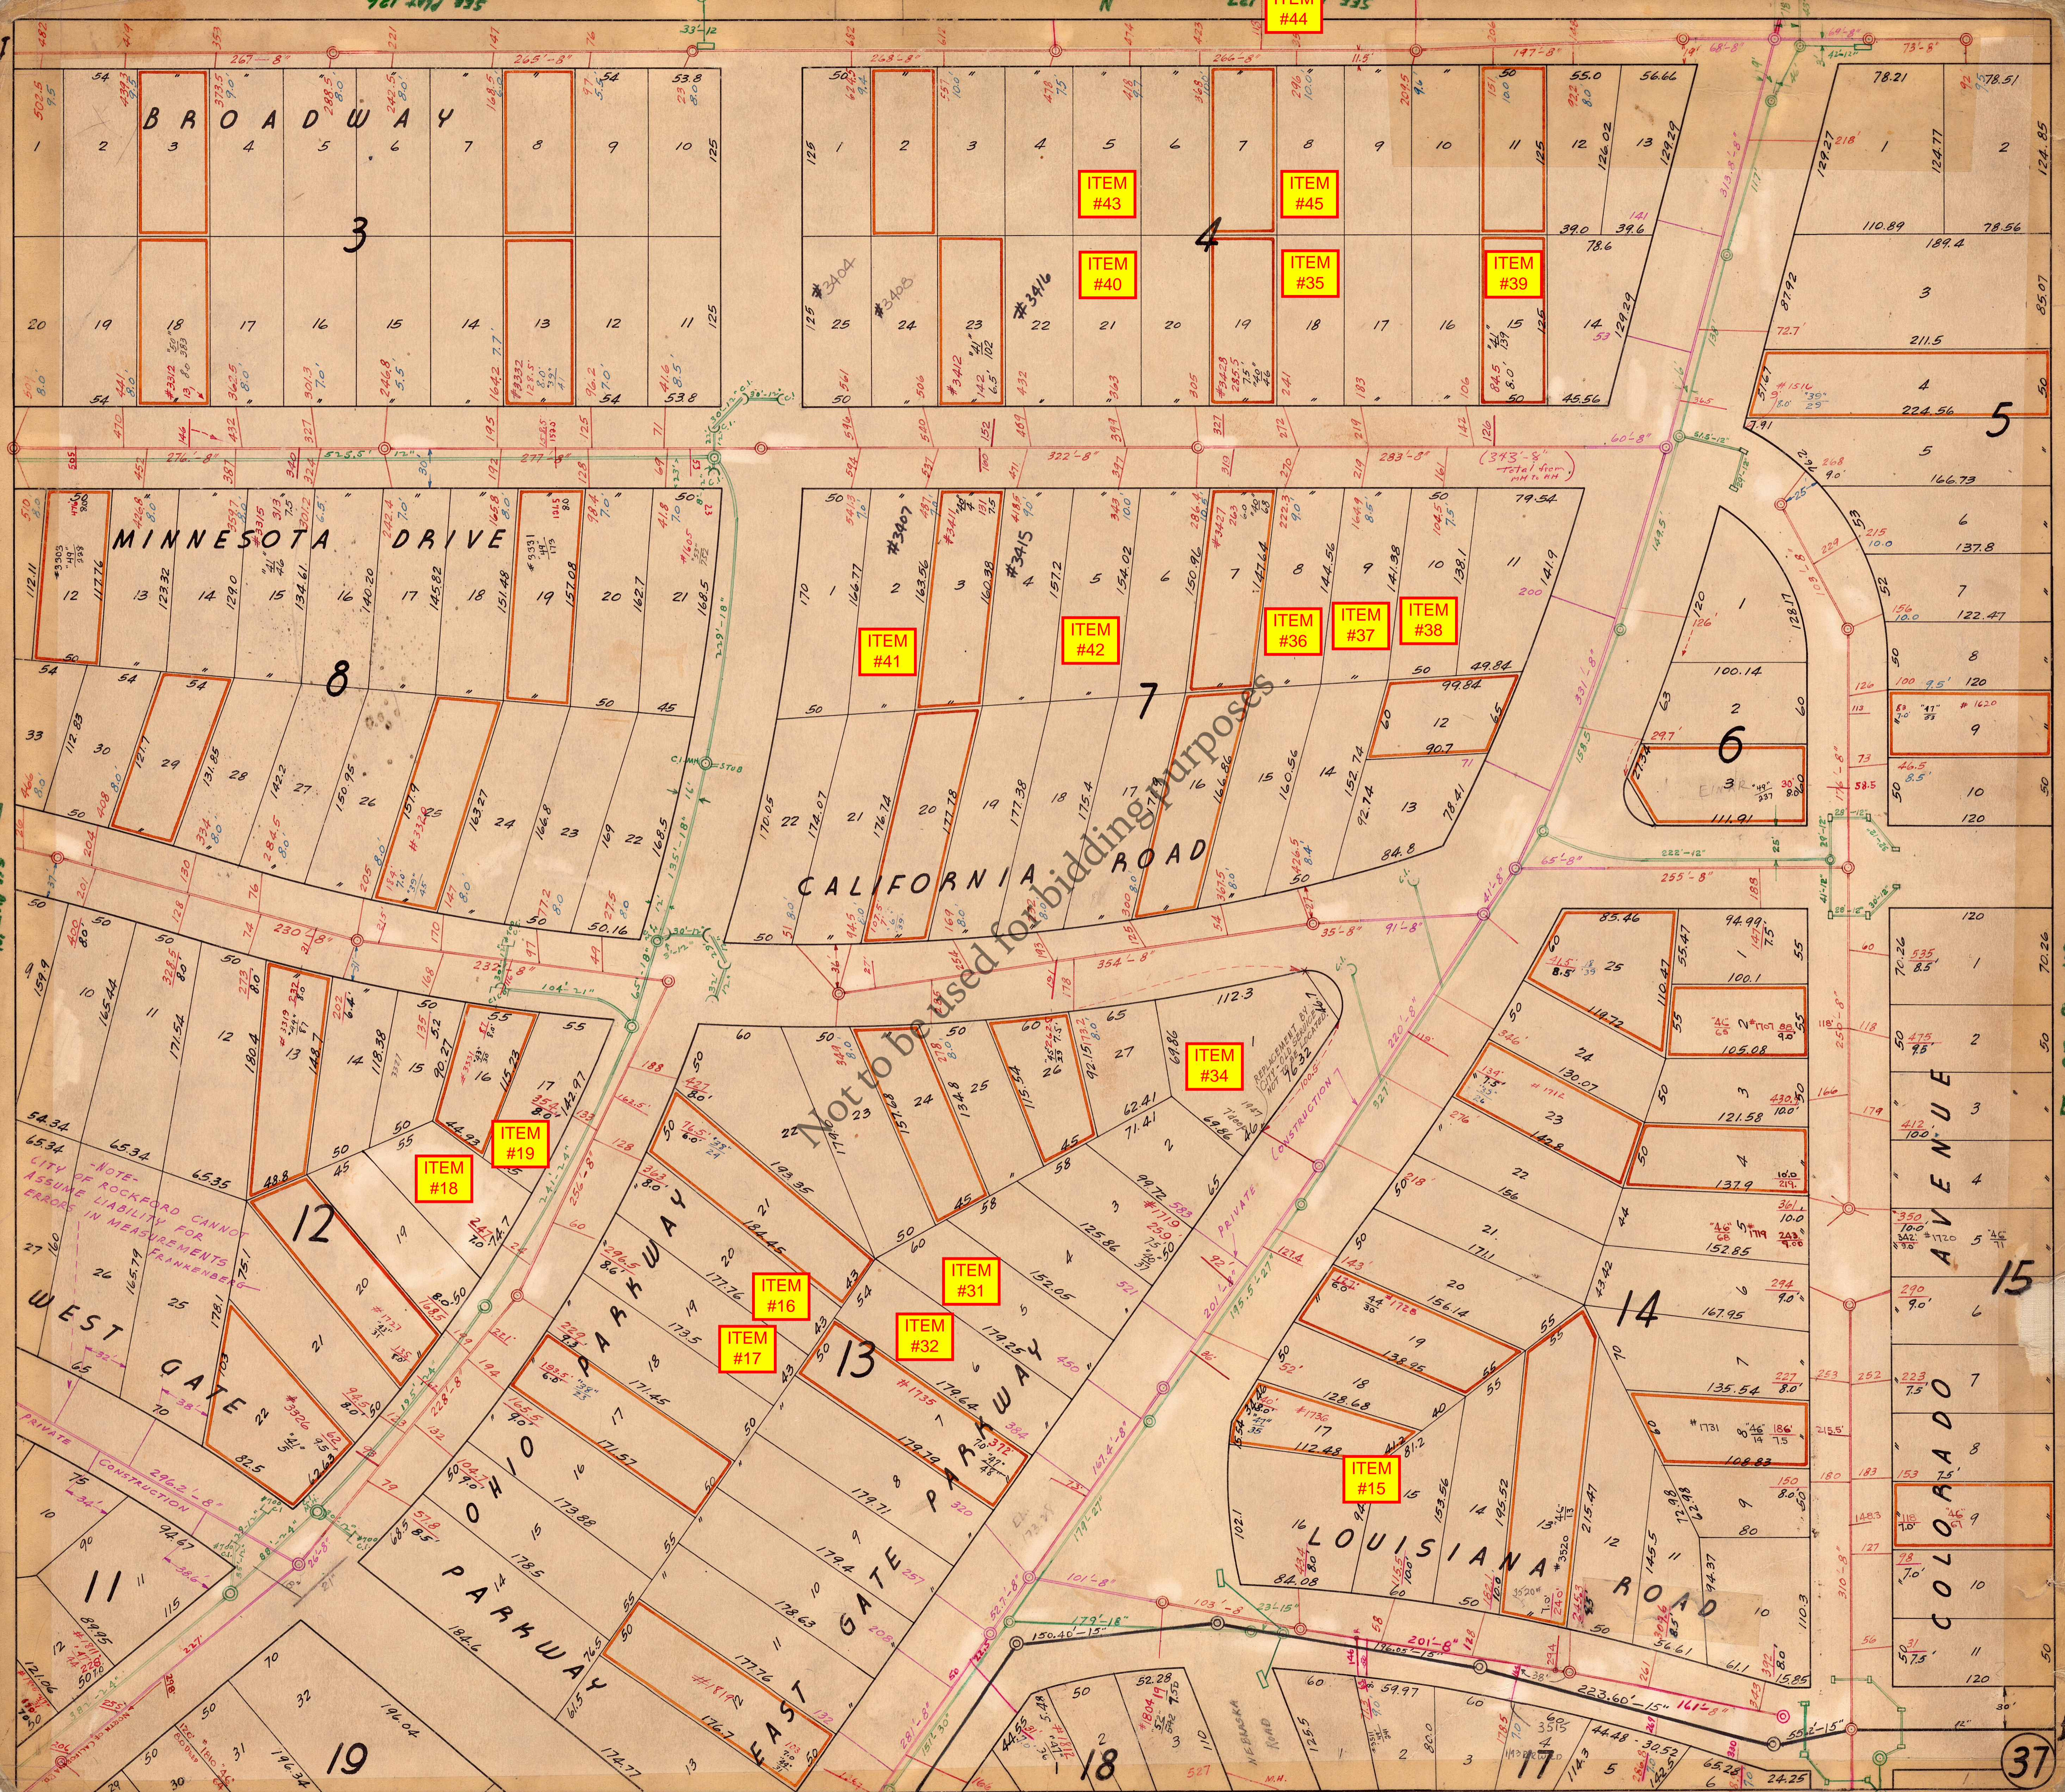

Not to be used for bidding purposes

-NOTE- CITY OF ROCKFORD CANNOT ASSUME LIABILITY FOR ERRORS IN MEASUREMENTS FRANKENBERG

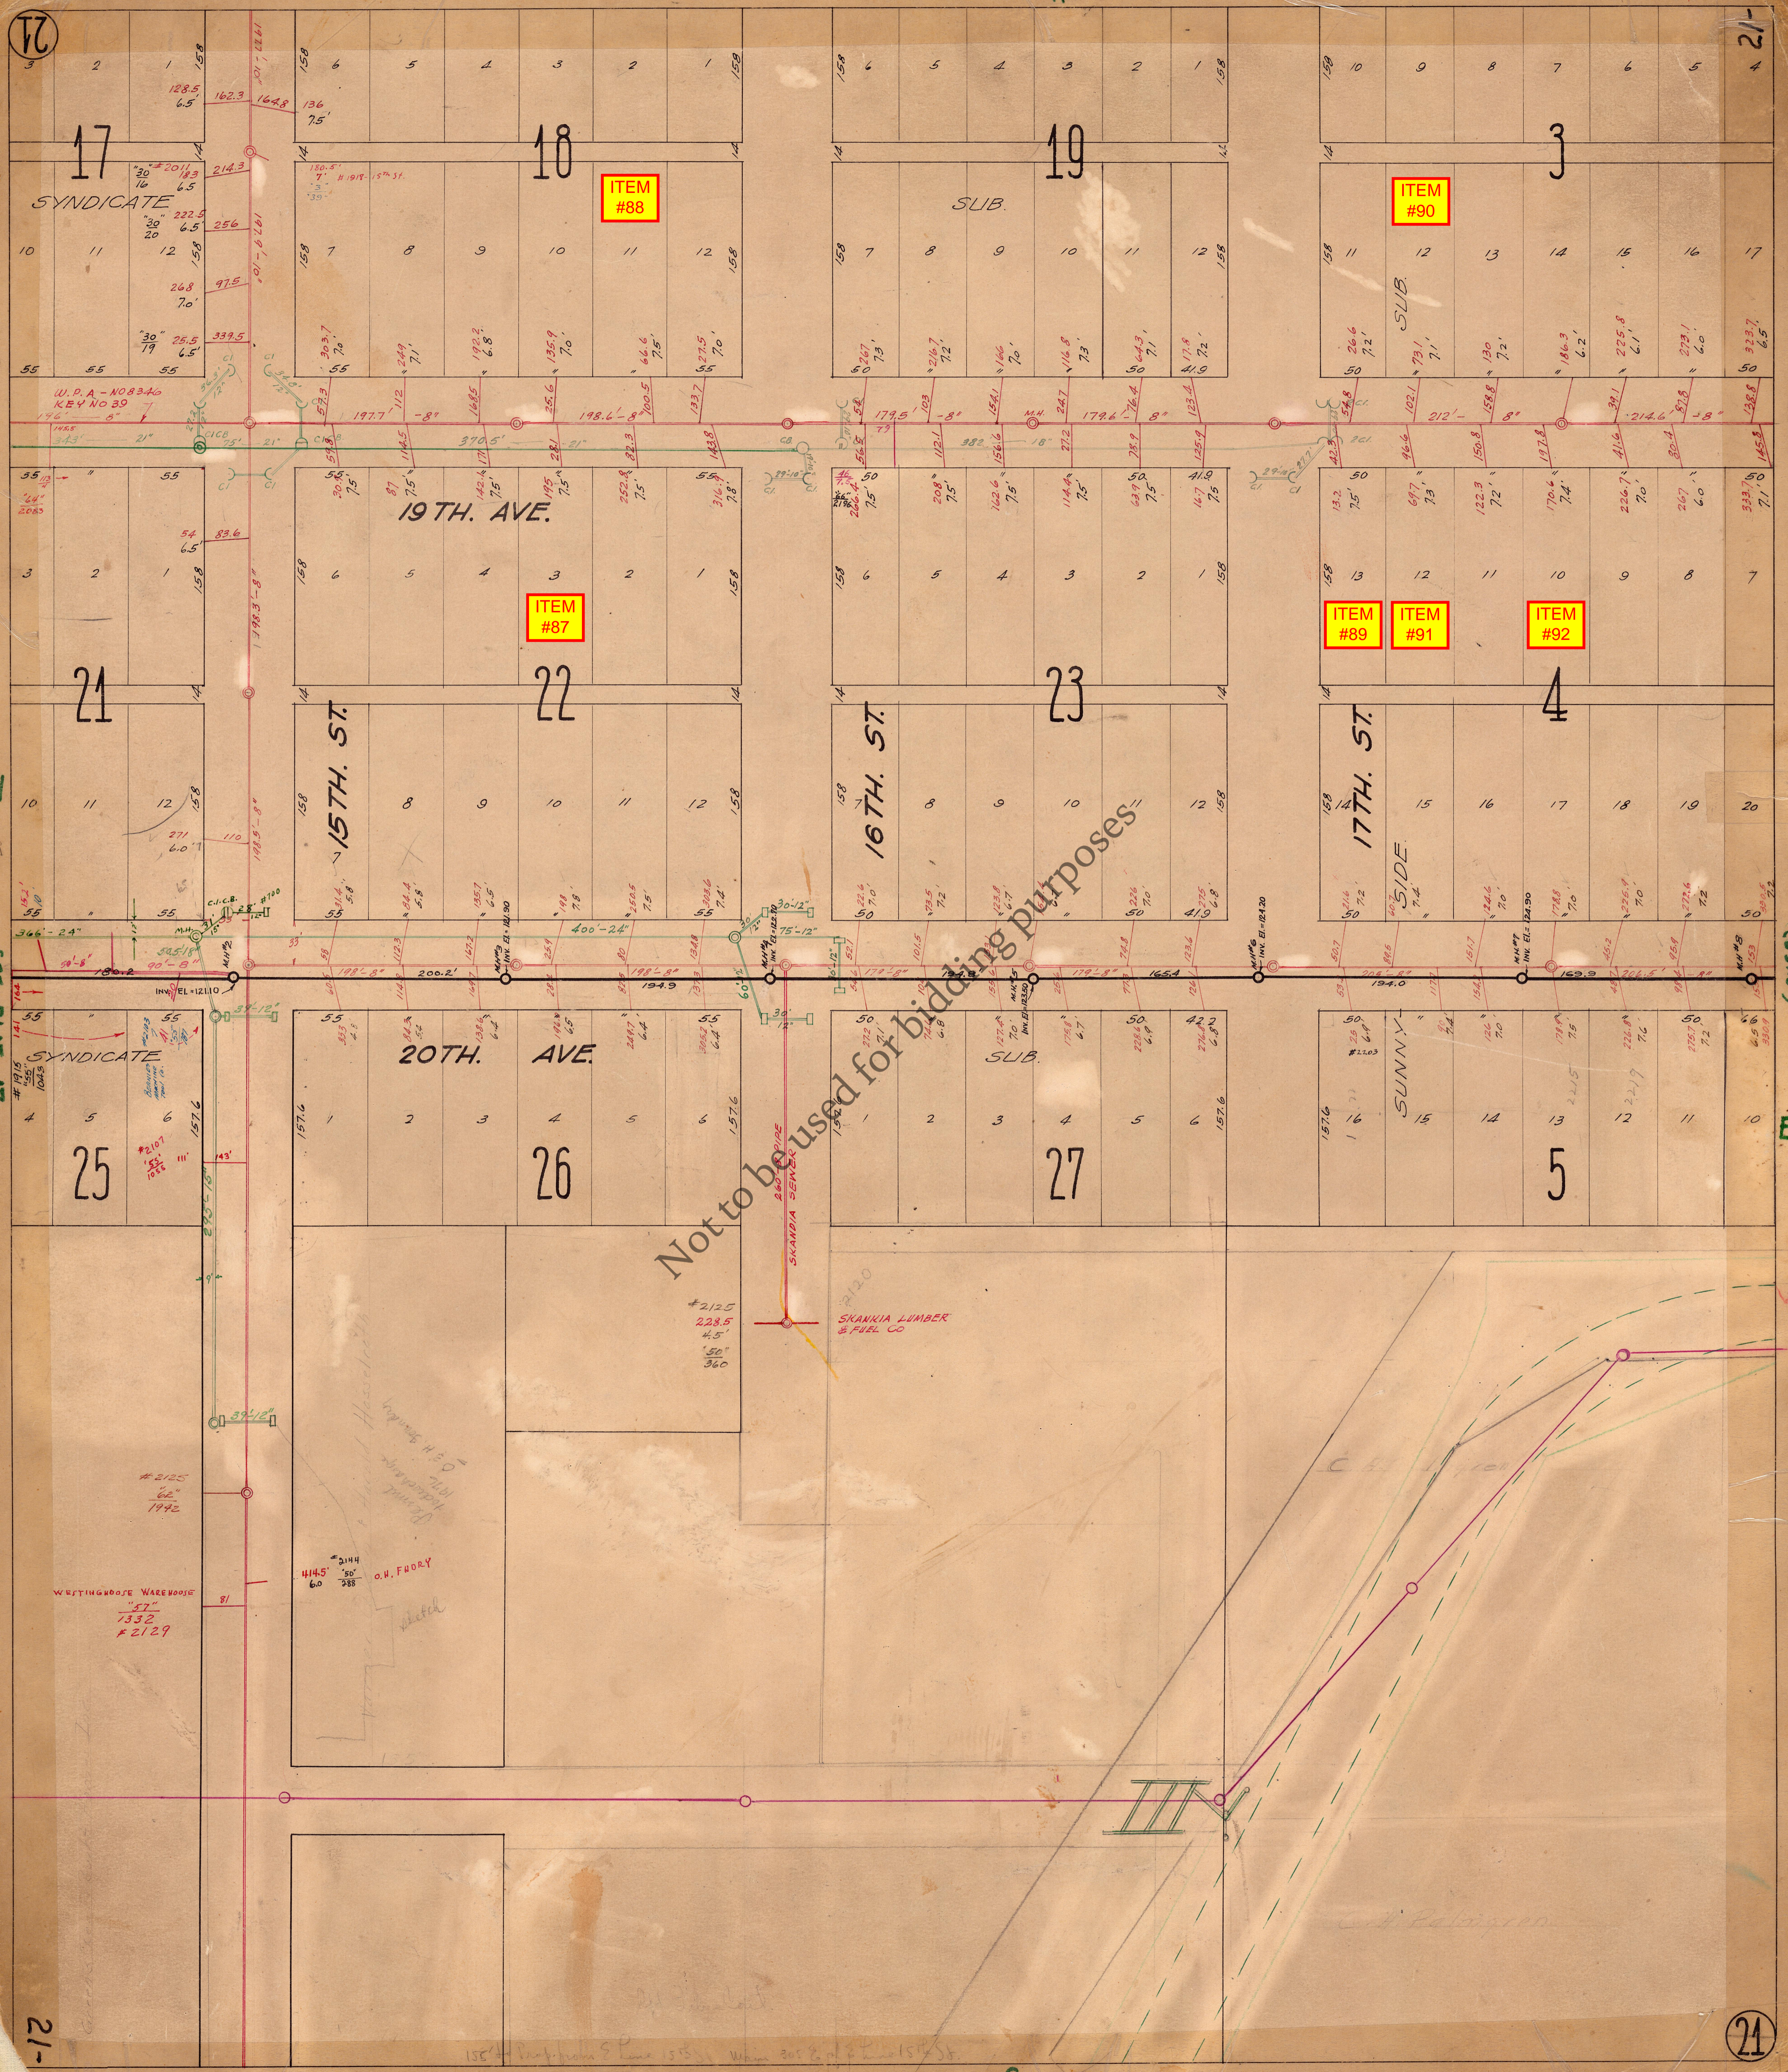

21

21-2

SEE PLAT 17

(COVER)

Not to be used for bidding purposes

17

18

19

3

21

22

23

4

25

26

27

5






21-2

21

26TH. ST. & 18TH. AVE. - 1930

SANITARY SEWER

PLAN - PROFILE

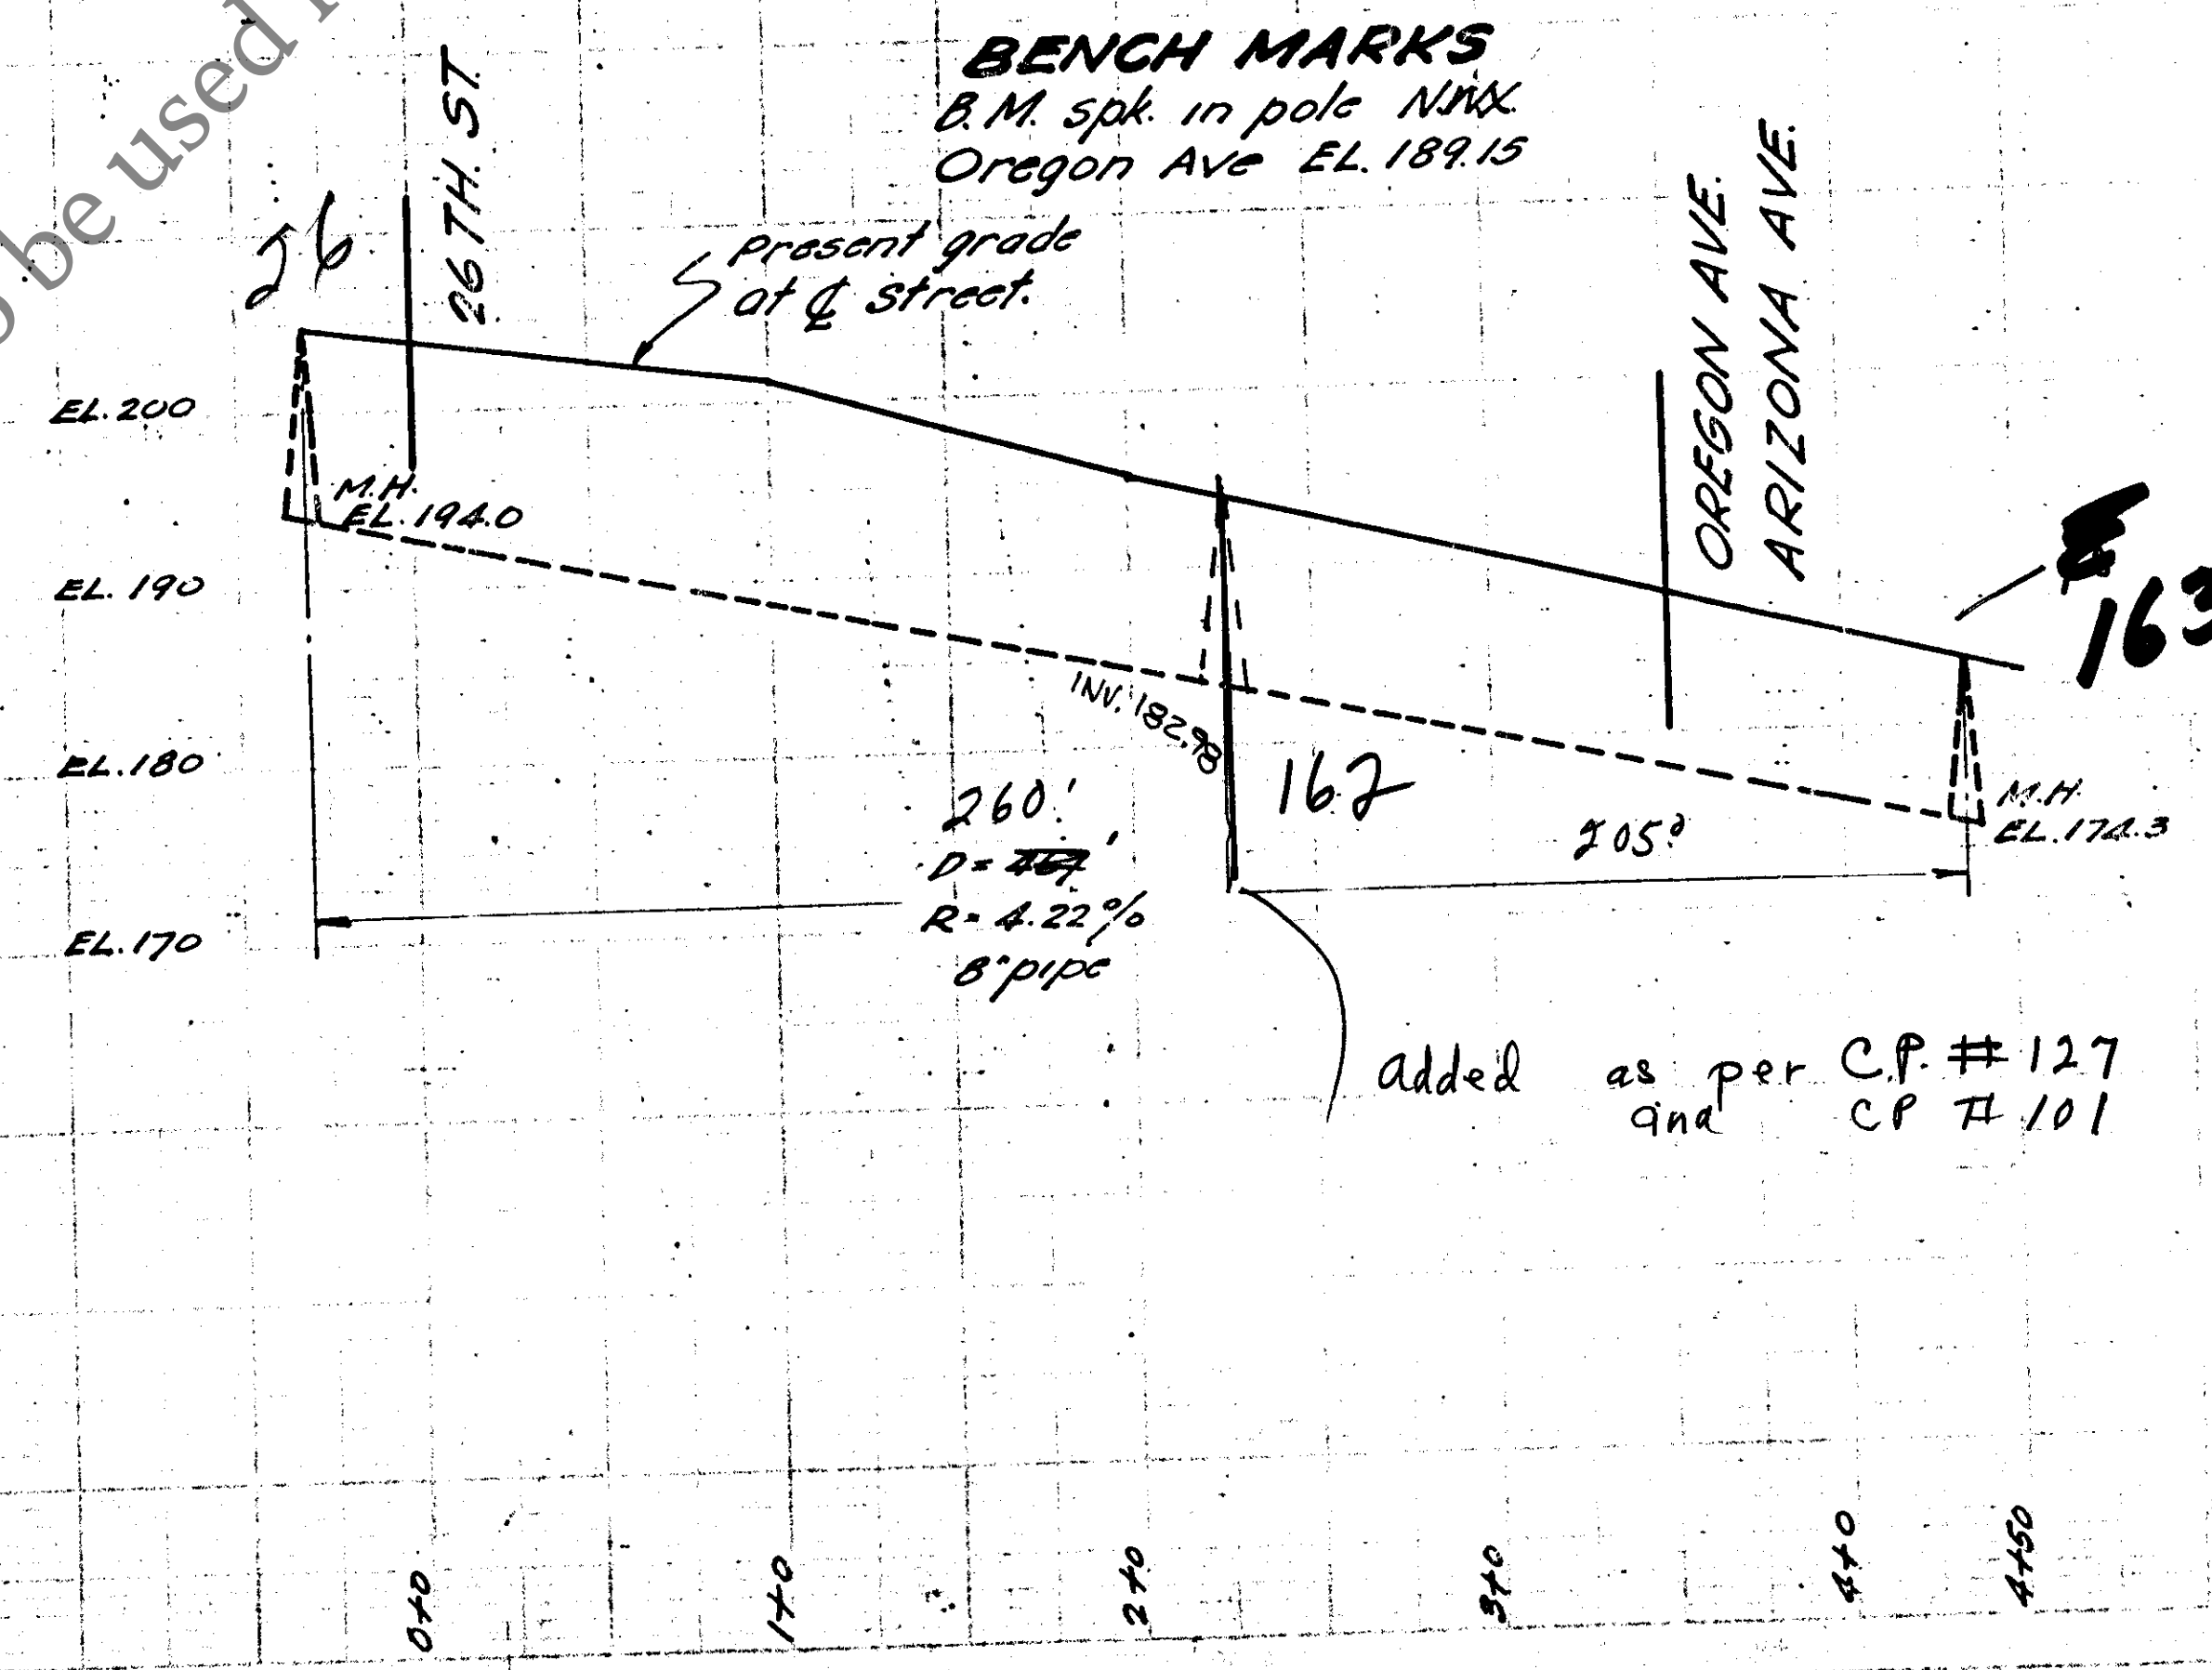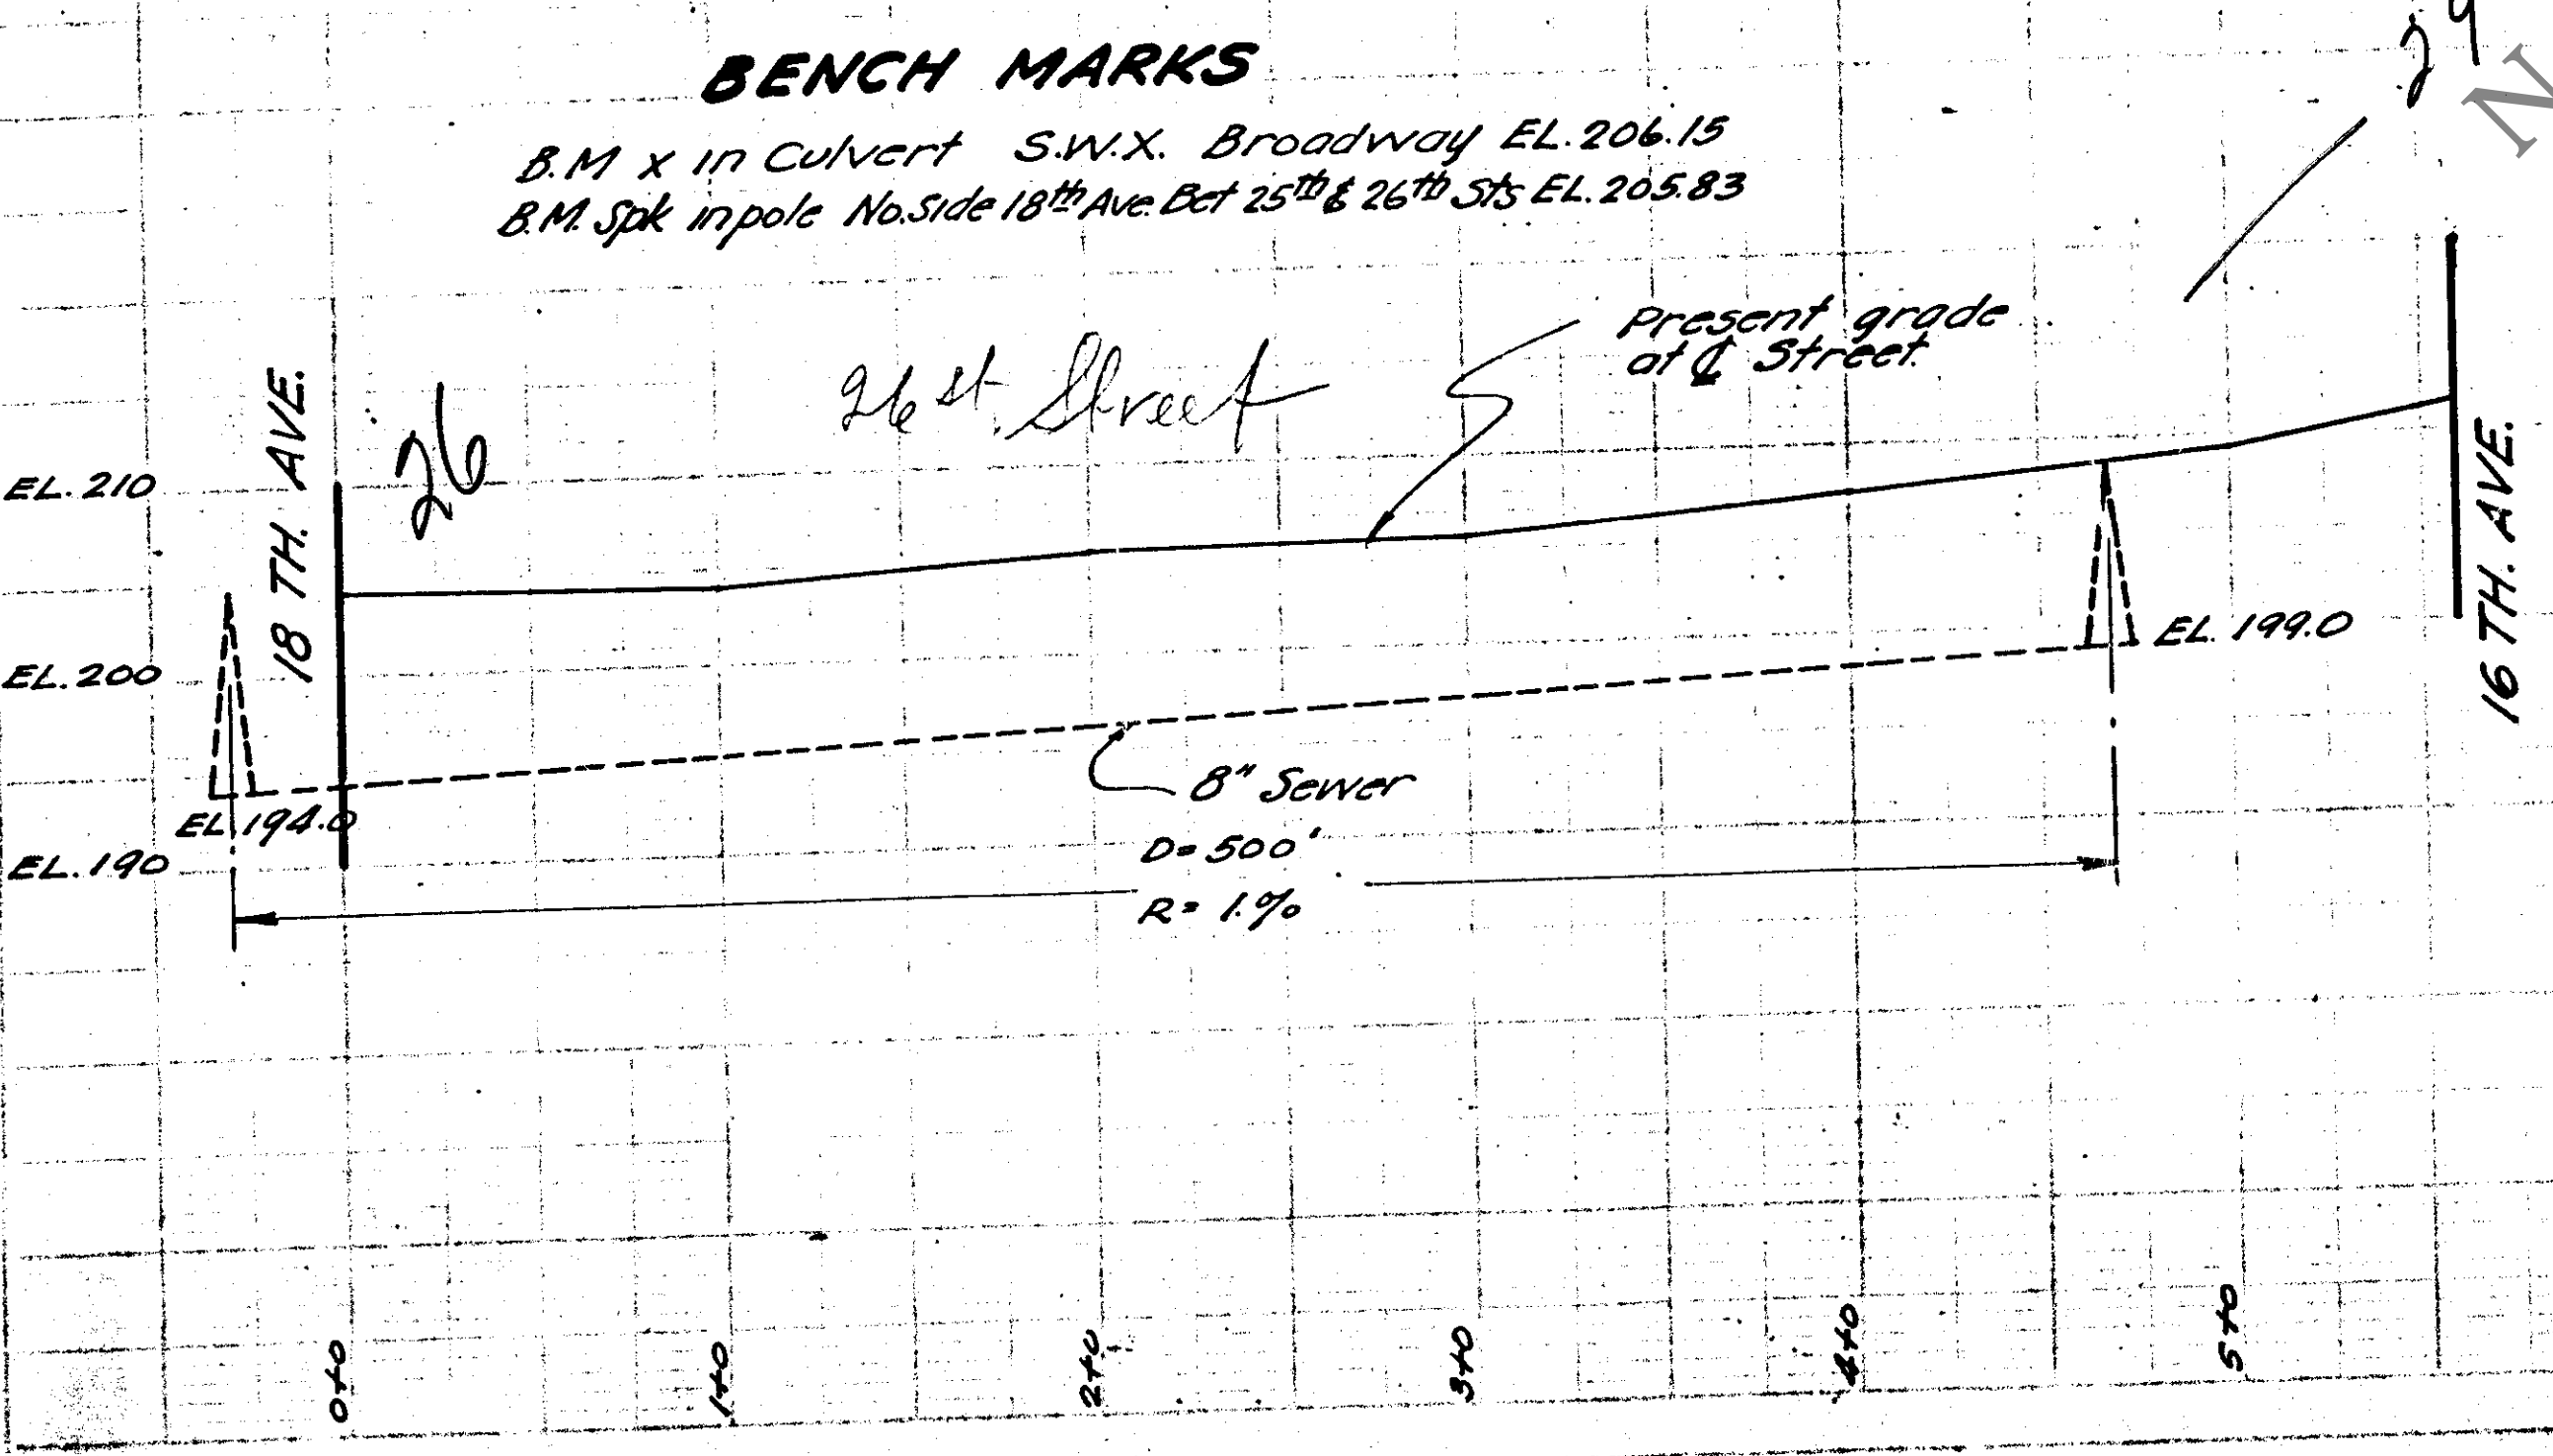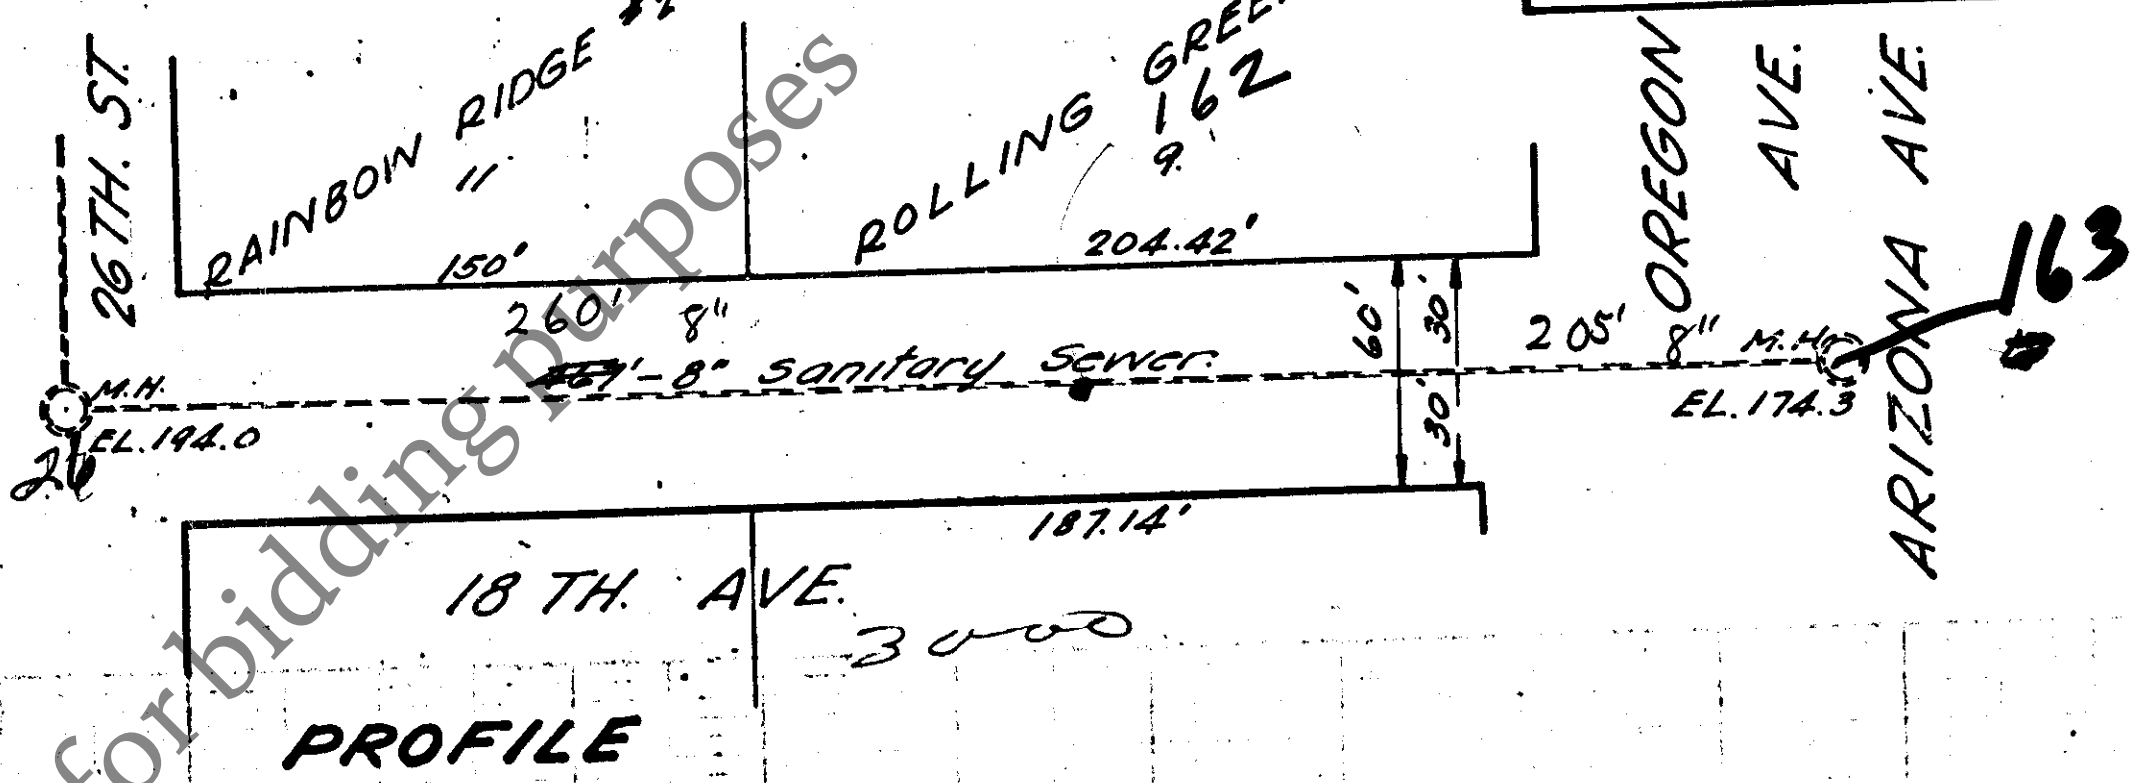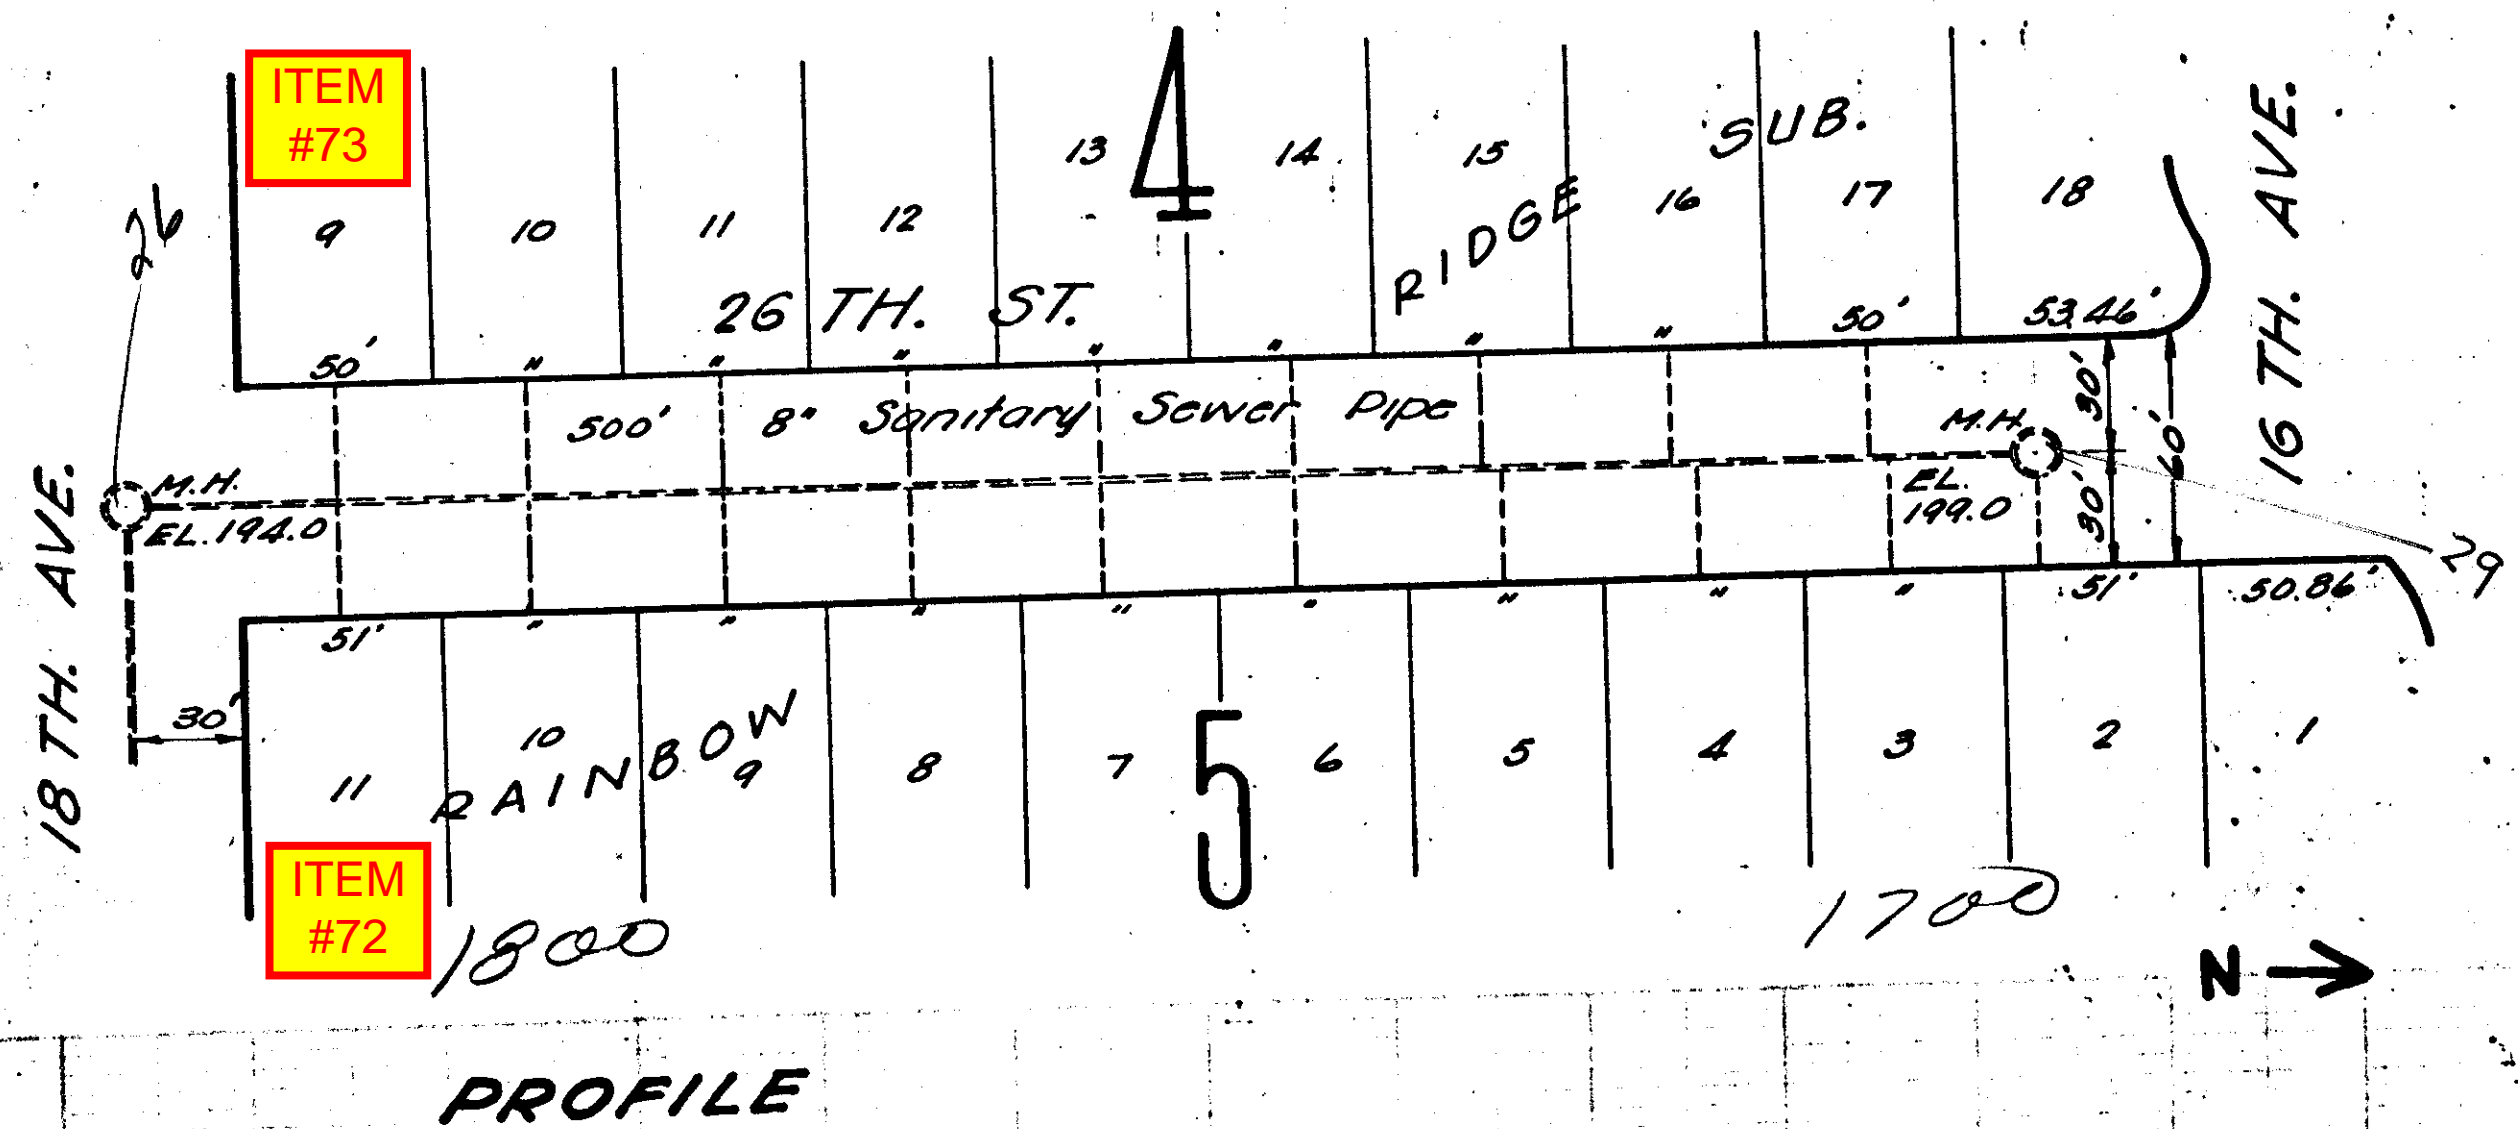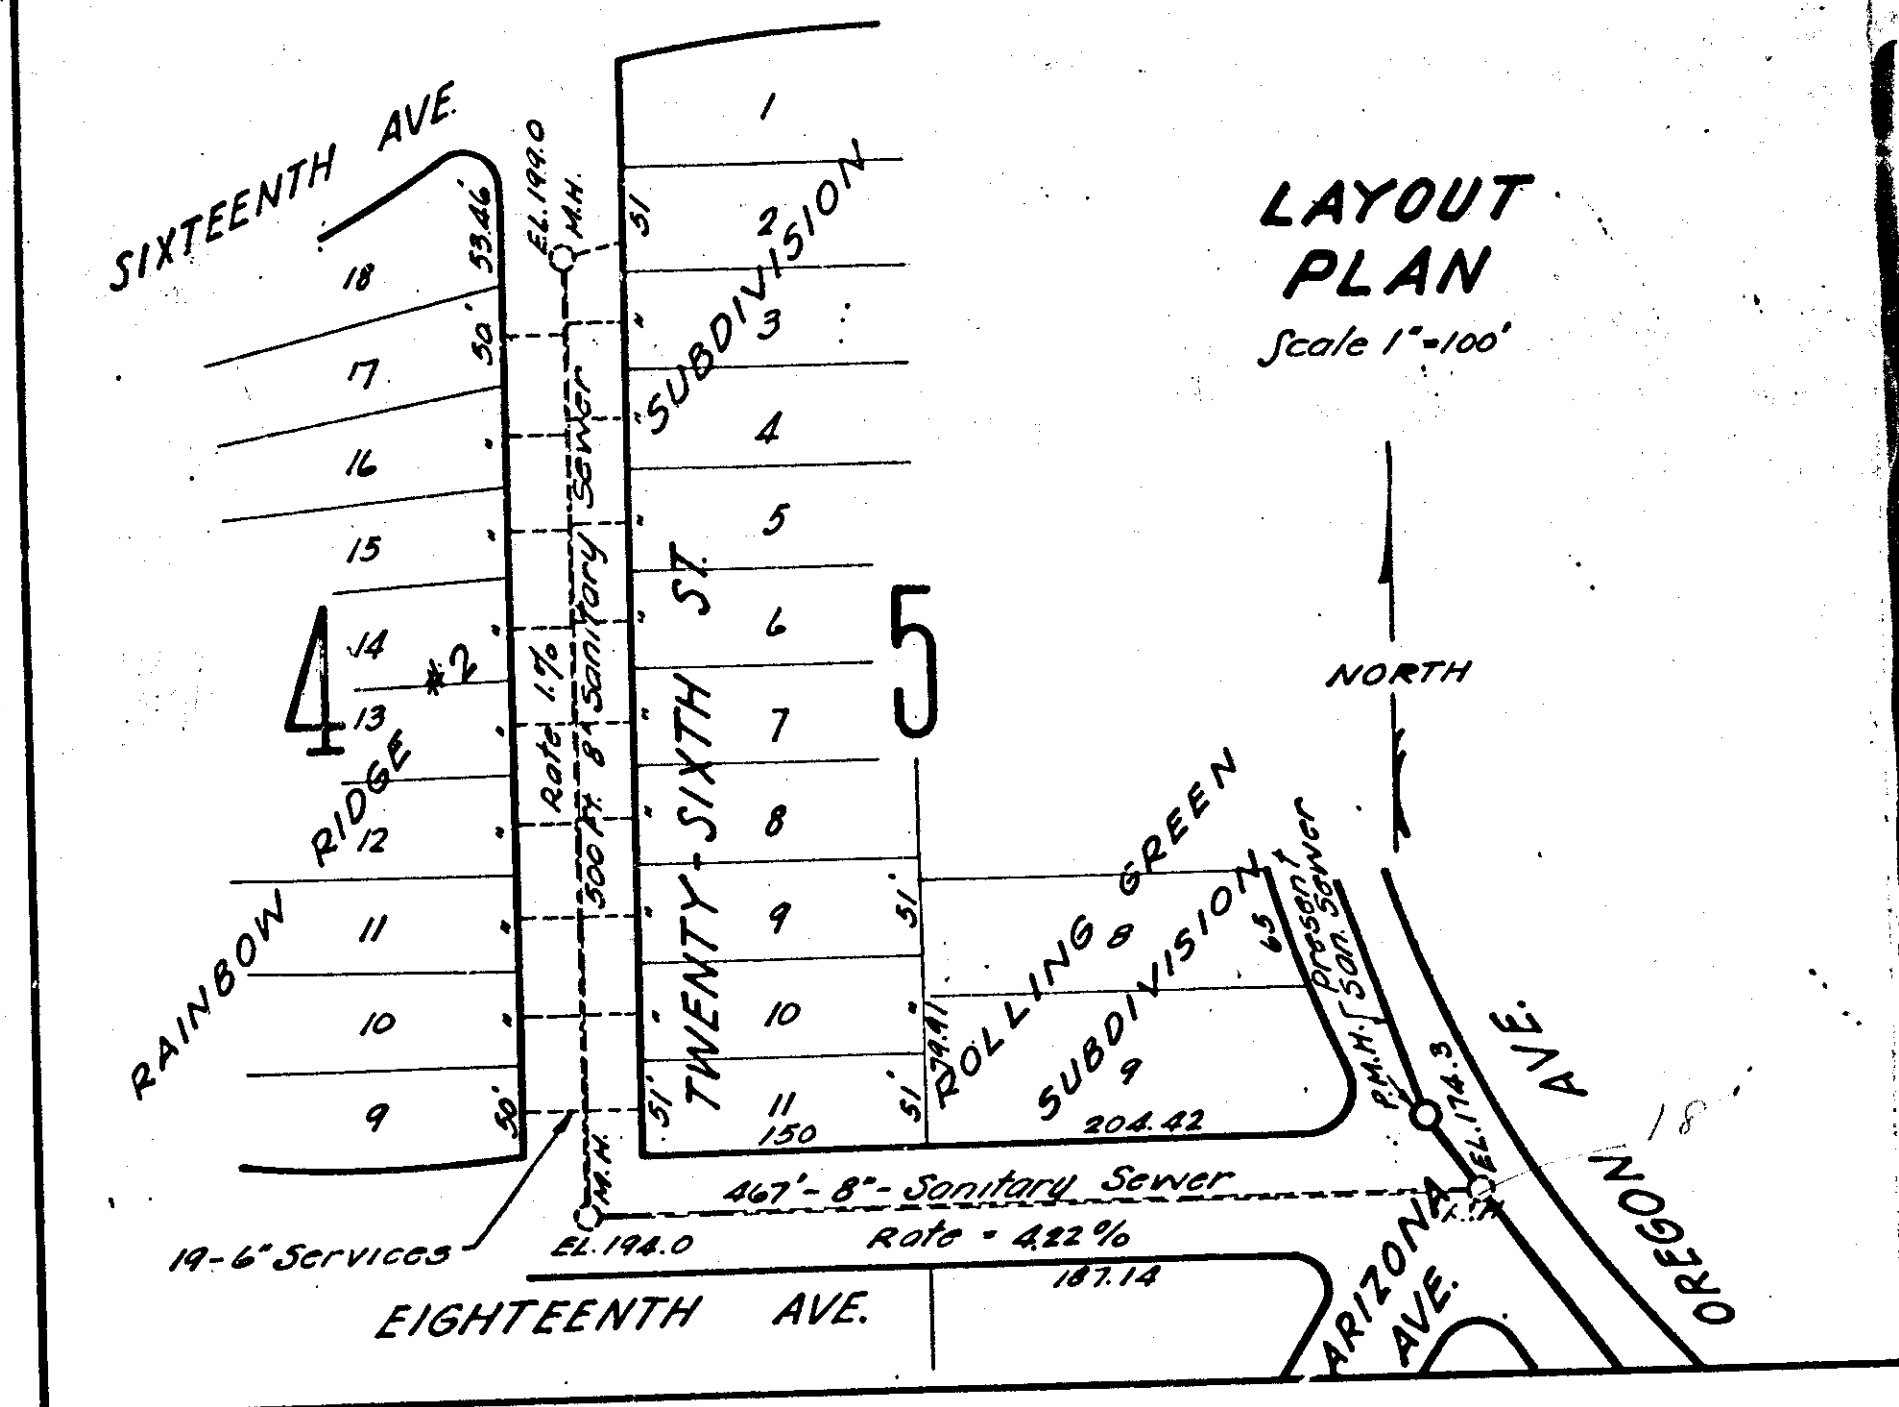

BILL OF MATERIALS

- 970 Lin. ft. 8" Vitriified Sewer pipe
- 600 Lin. ft. 6" Vitriified Sewer pipe
- 3 Standard Manholes.

Note
6"x8" Ts to be included in price of 6" pipe - services.


**PLAN PROFILE
26TH ST. AND
18TH. AVENUE.
SANITARY SEWER
1930**

Drawn J.C. Frankenberg
Checked T.F. Johnson
Approved P.A. Wilson
5-25-30
City of Rockford


12-31-120-TWENTY-SIXTH ST.

6720 B17 8

DATE: 6-5-69
 BY: S. Almgren
 IN: M. Carlson
 SURVEYED: []
 ALIGNED: []
 CHECKED: []
 RT. OF WAY: []
 PLAN NO. 85

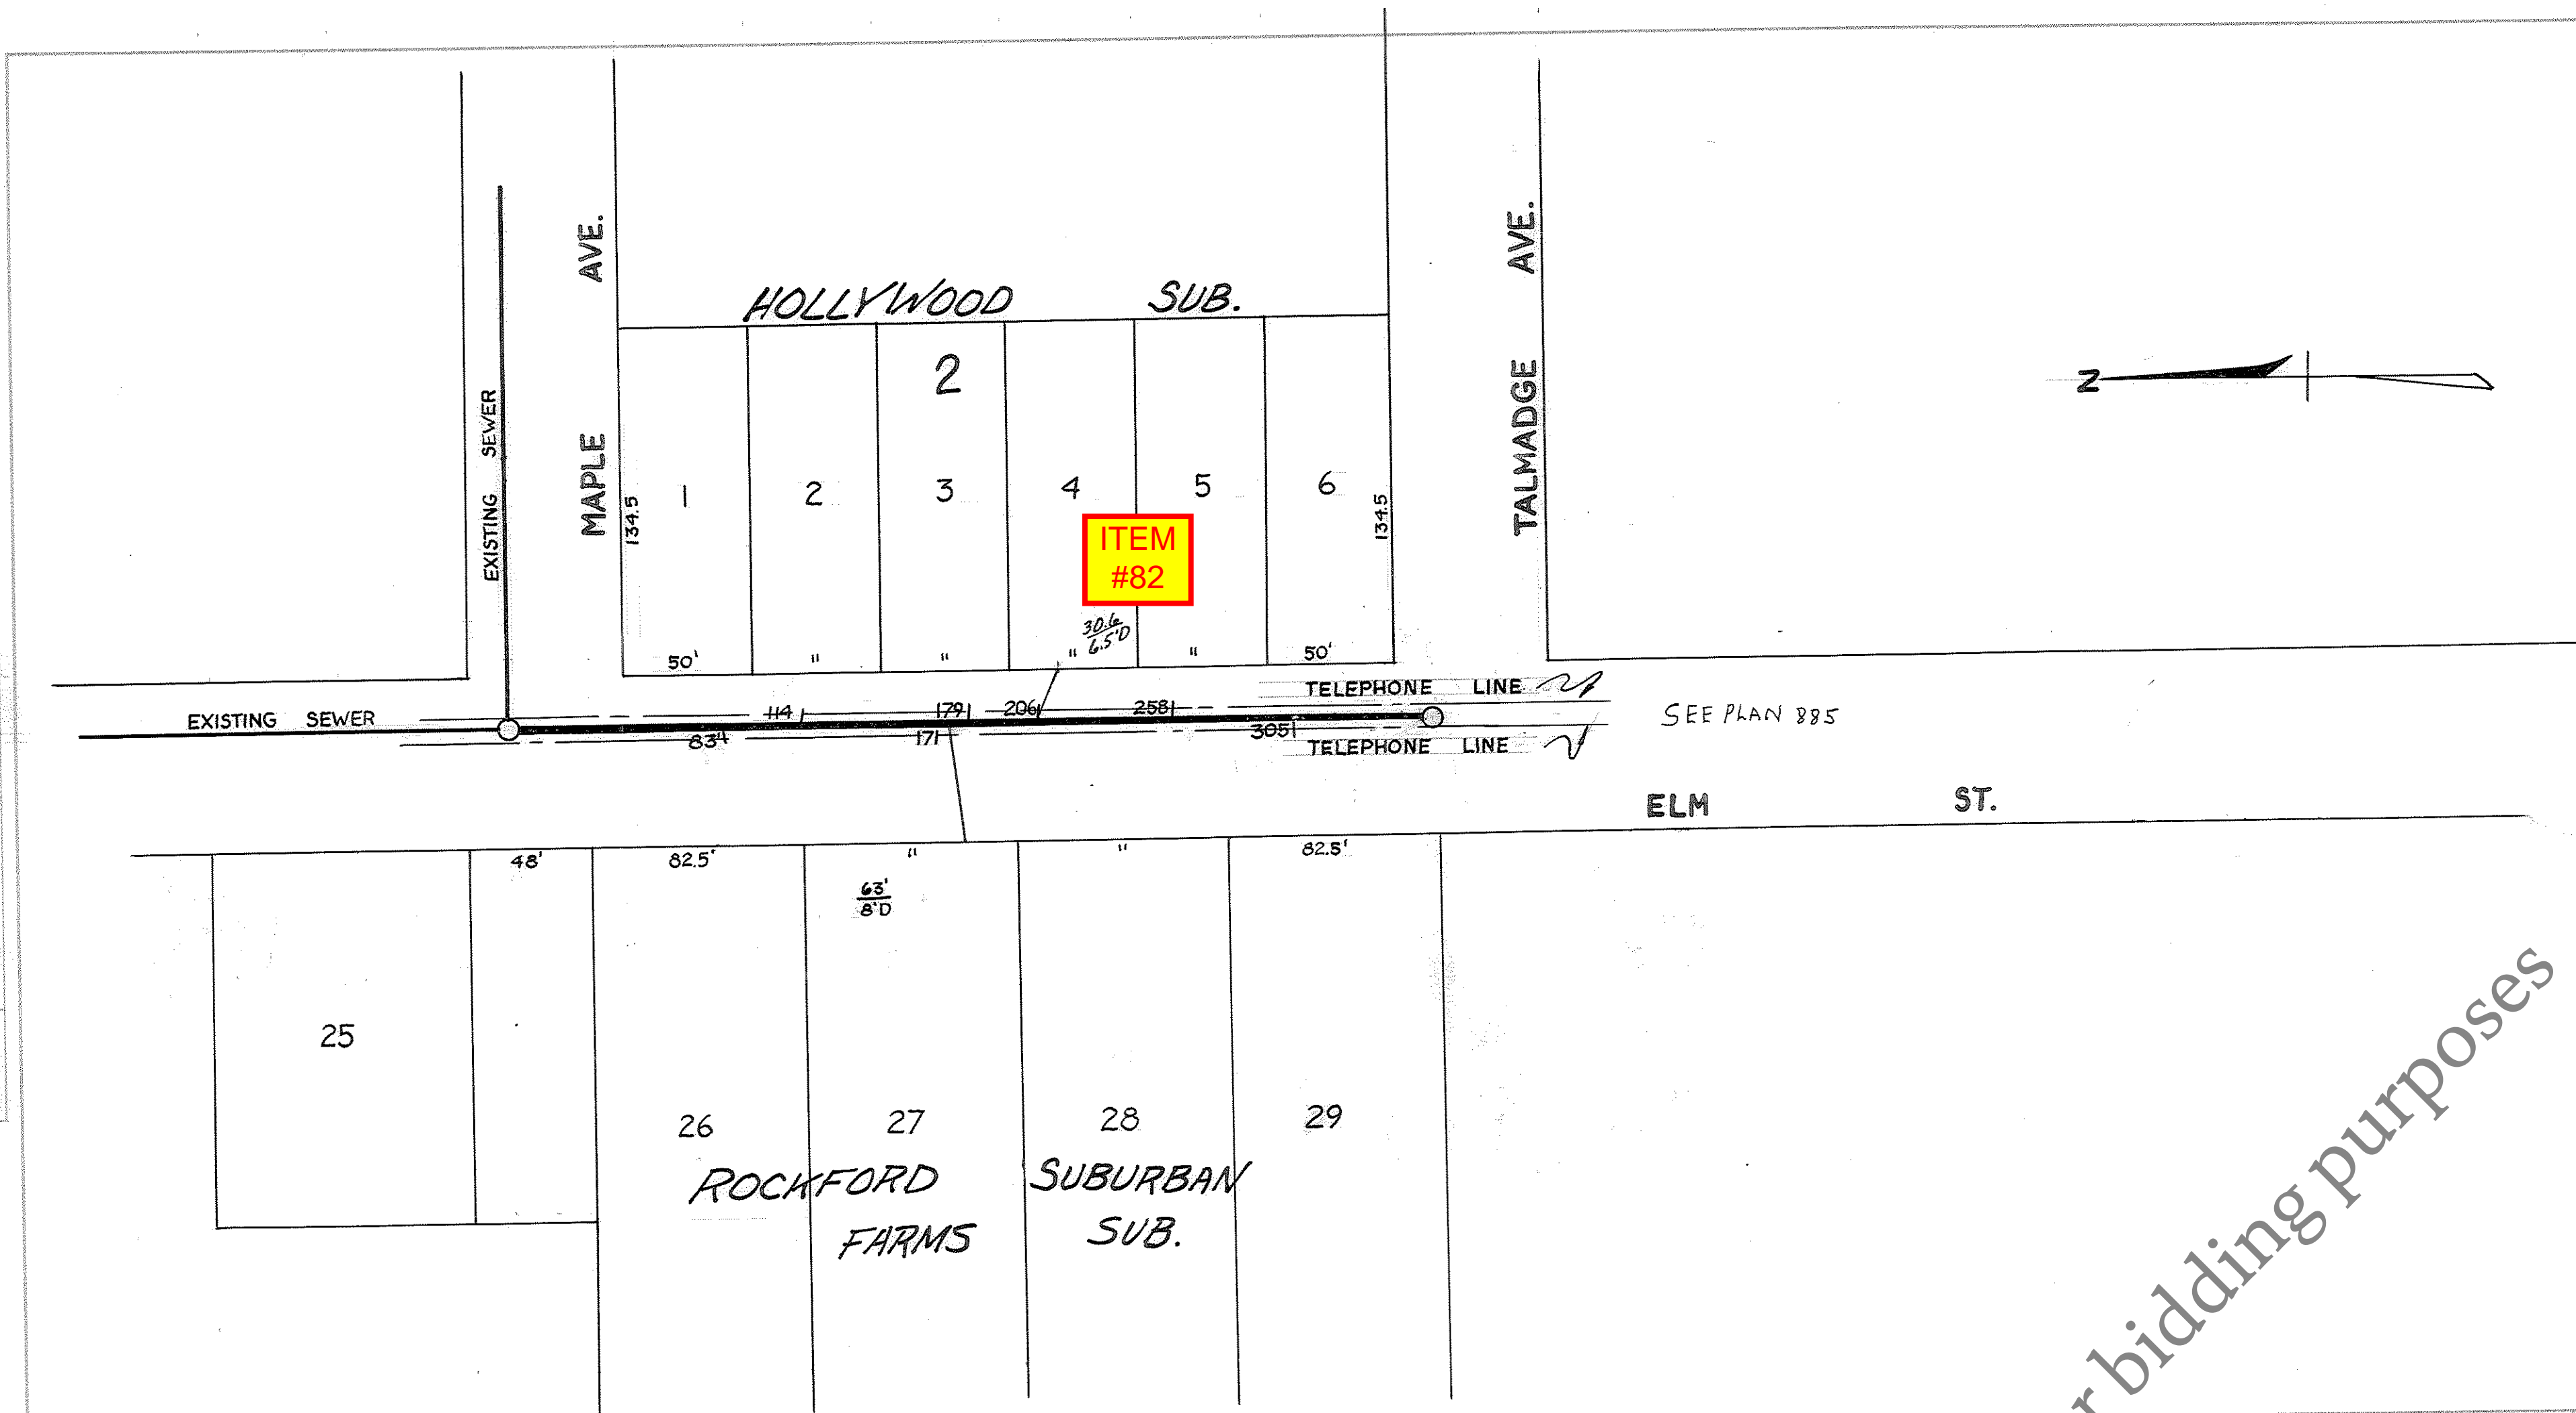

DATE: 6-5-69
 BY: S. Almgren
 IN: M. Carlson
 PROFILE: []
 GRADES: []
 CHECKED: []
 STATIONING: []
 PROFILE NO. 85

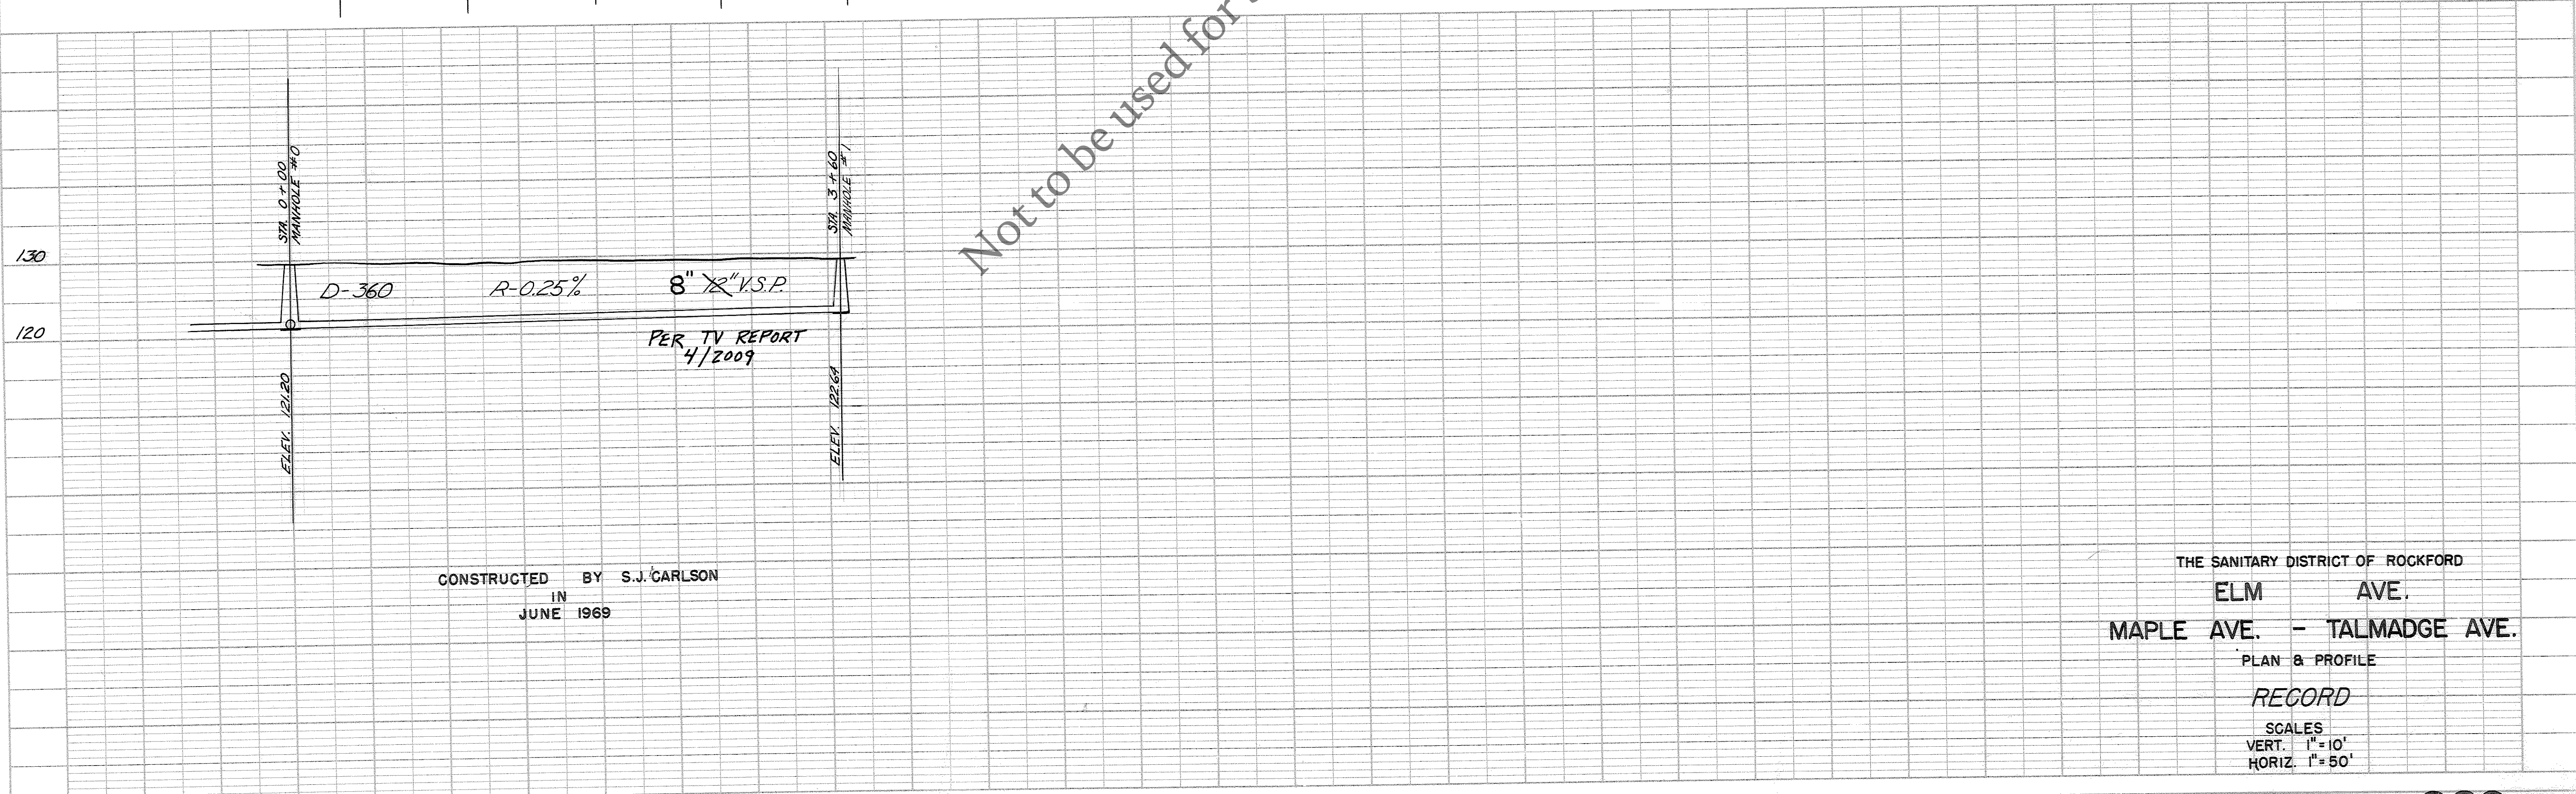

CONSTRUCTED BY S.J. CARLSON
 IN JUNE 1969

THE SANITARY DISTRICT OF ROCKFORD
 ELM AVE.
 MAPLE AVE. - TALMADGE AVE.


PLAN & PROFILE

RECORD

SCALES
 VERT. 1" = 10'
 HORIZ. 1" = 50'

Not to be used for bidding purposes

SANITARY DISTRICT
BOOK 144
PAGE 16-21

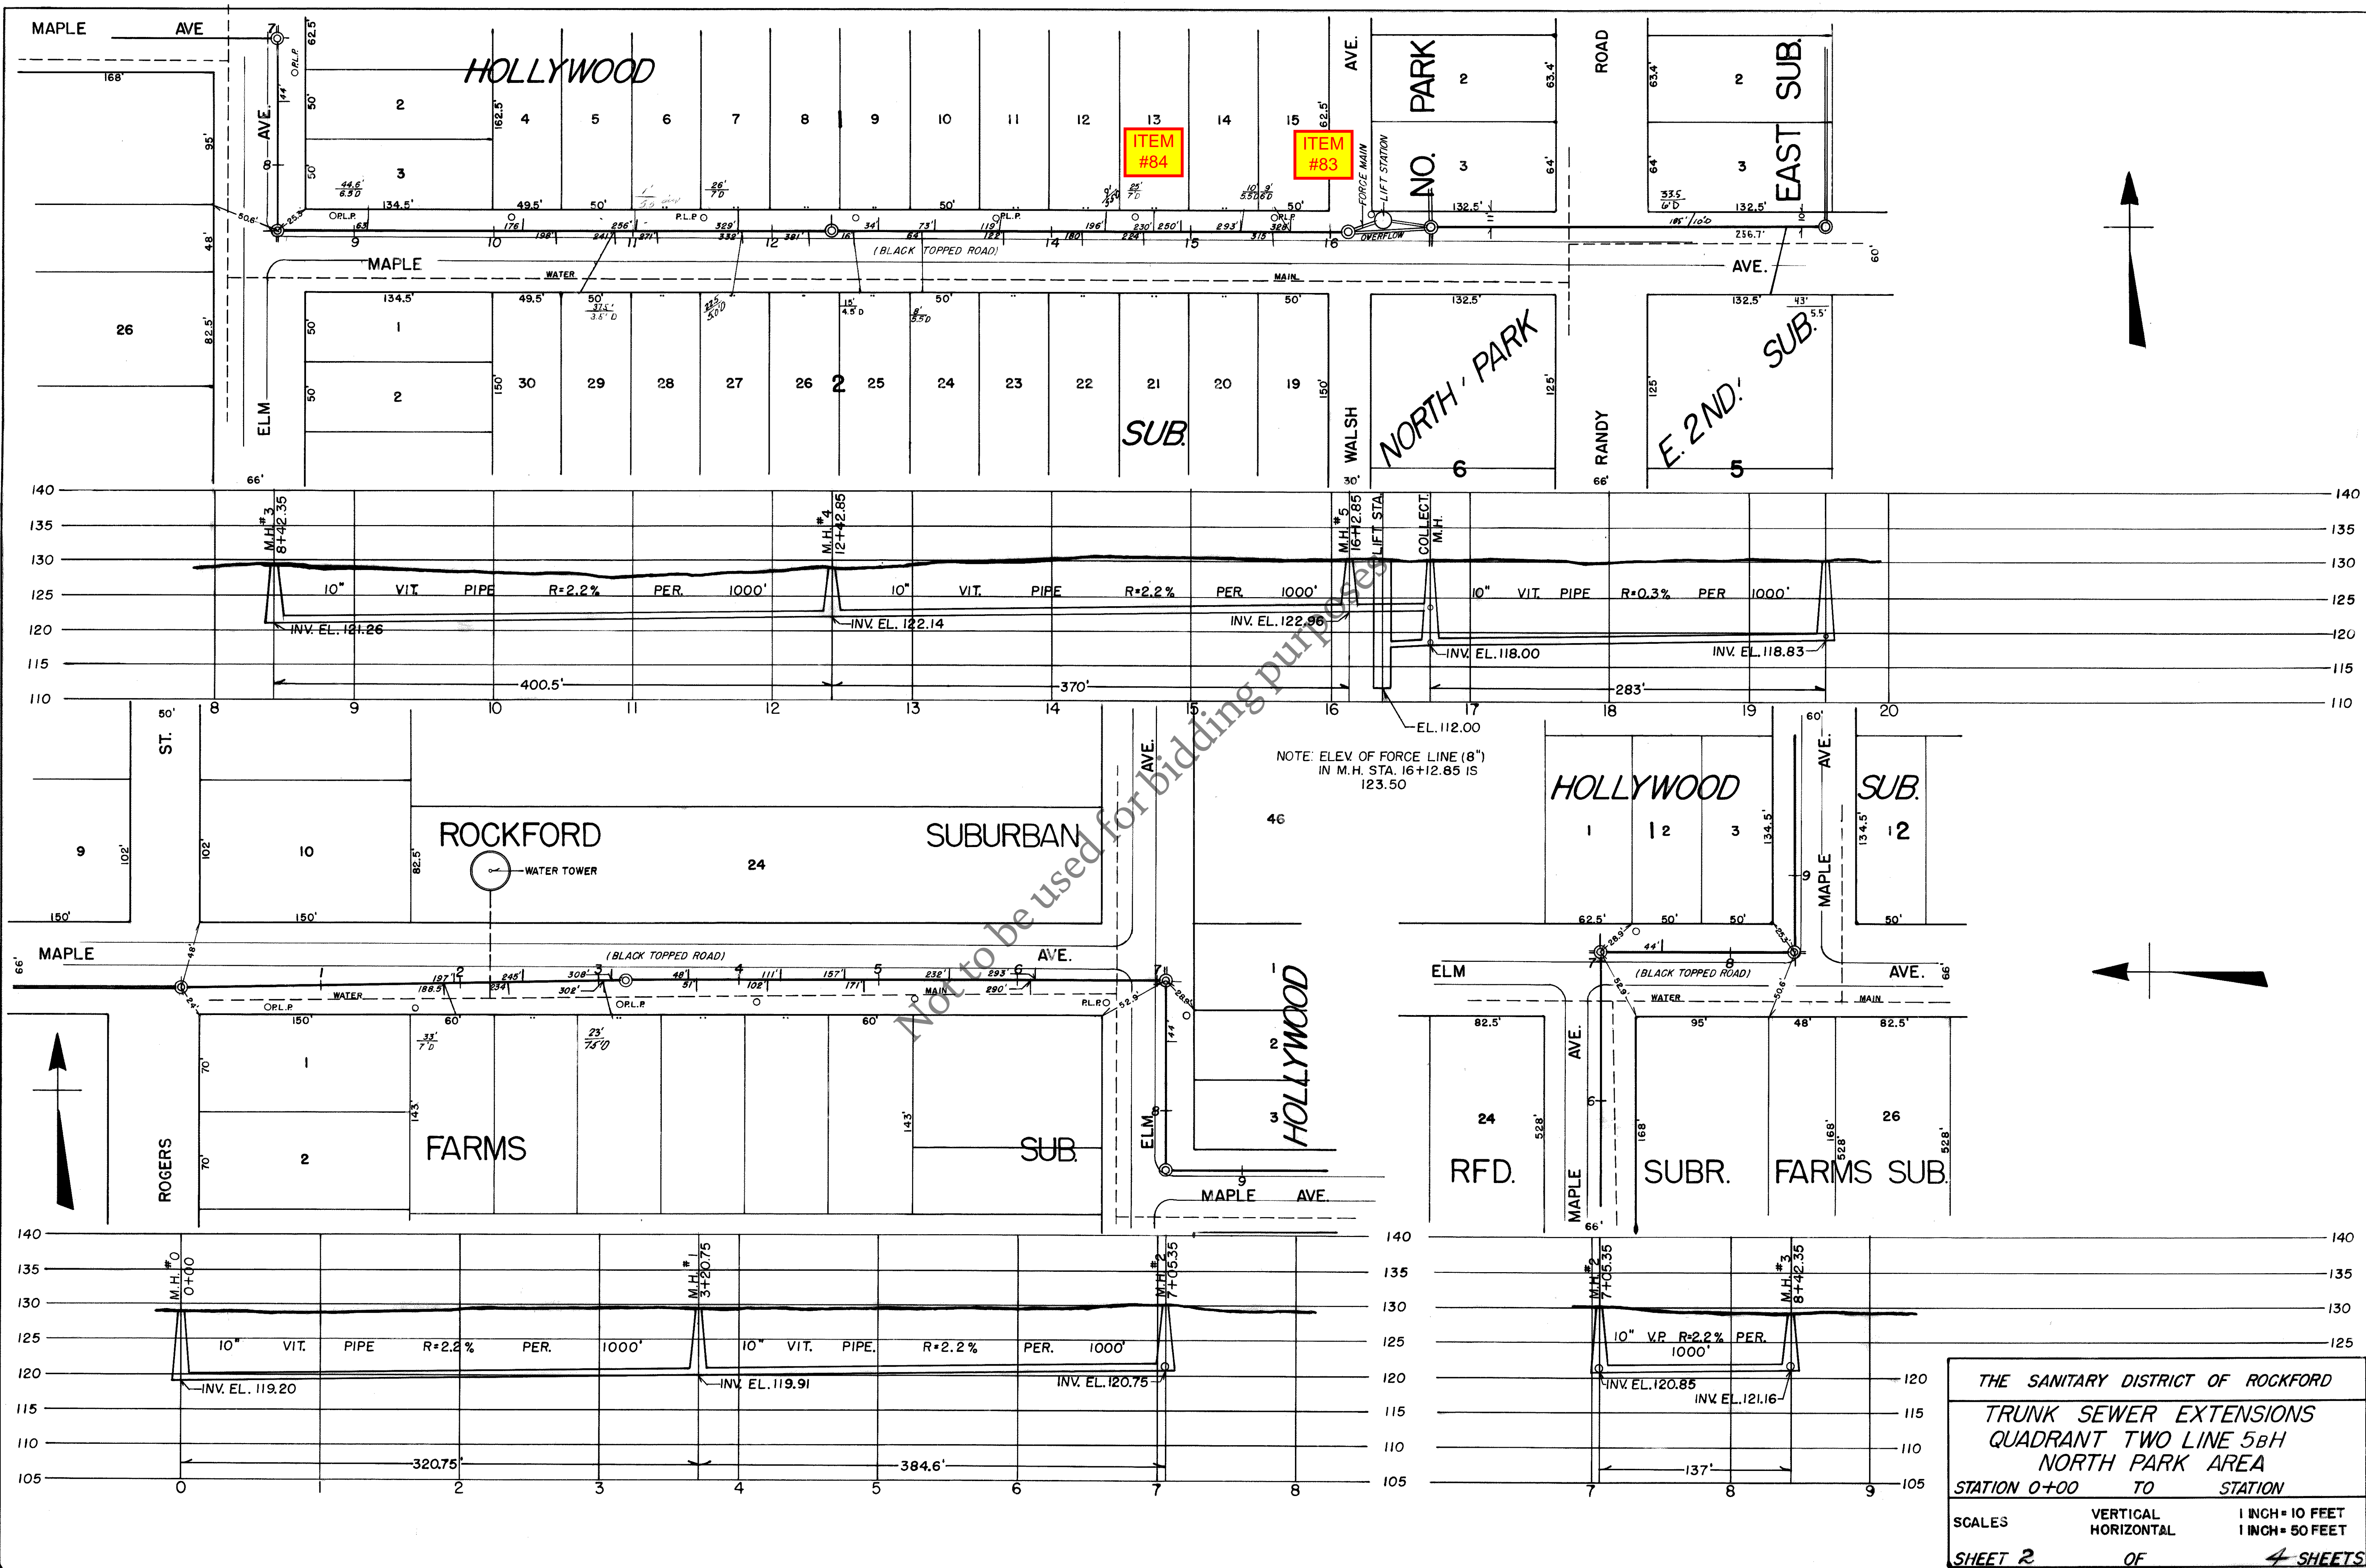


THE SANITARY DISTRICT OF ROCKFORD
TRUNK SEWER EXTENSIONS
QUADRANT TWO LINE 5BH
NORTH PARK AREA
STATION 0+00 TO STATION


SCALES	VERTICAL	1 INCH = 10 FEET
	HORIZONTAL	1 INCH = 50 FEET

SHEET 2 OF 4 SHEETS

PLAN SURVEYED BY C. H. WILSON
 PLOTTED AND CHECKED BY R. C. GLANS
 NOTE BOOK NO. 60
 DATE 9-21-54
 STRUCTURE NOTATIONS CHECKED BY R. C. GLANS

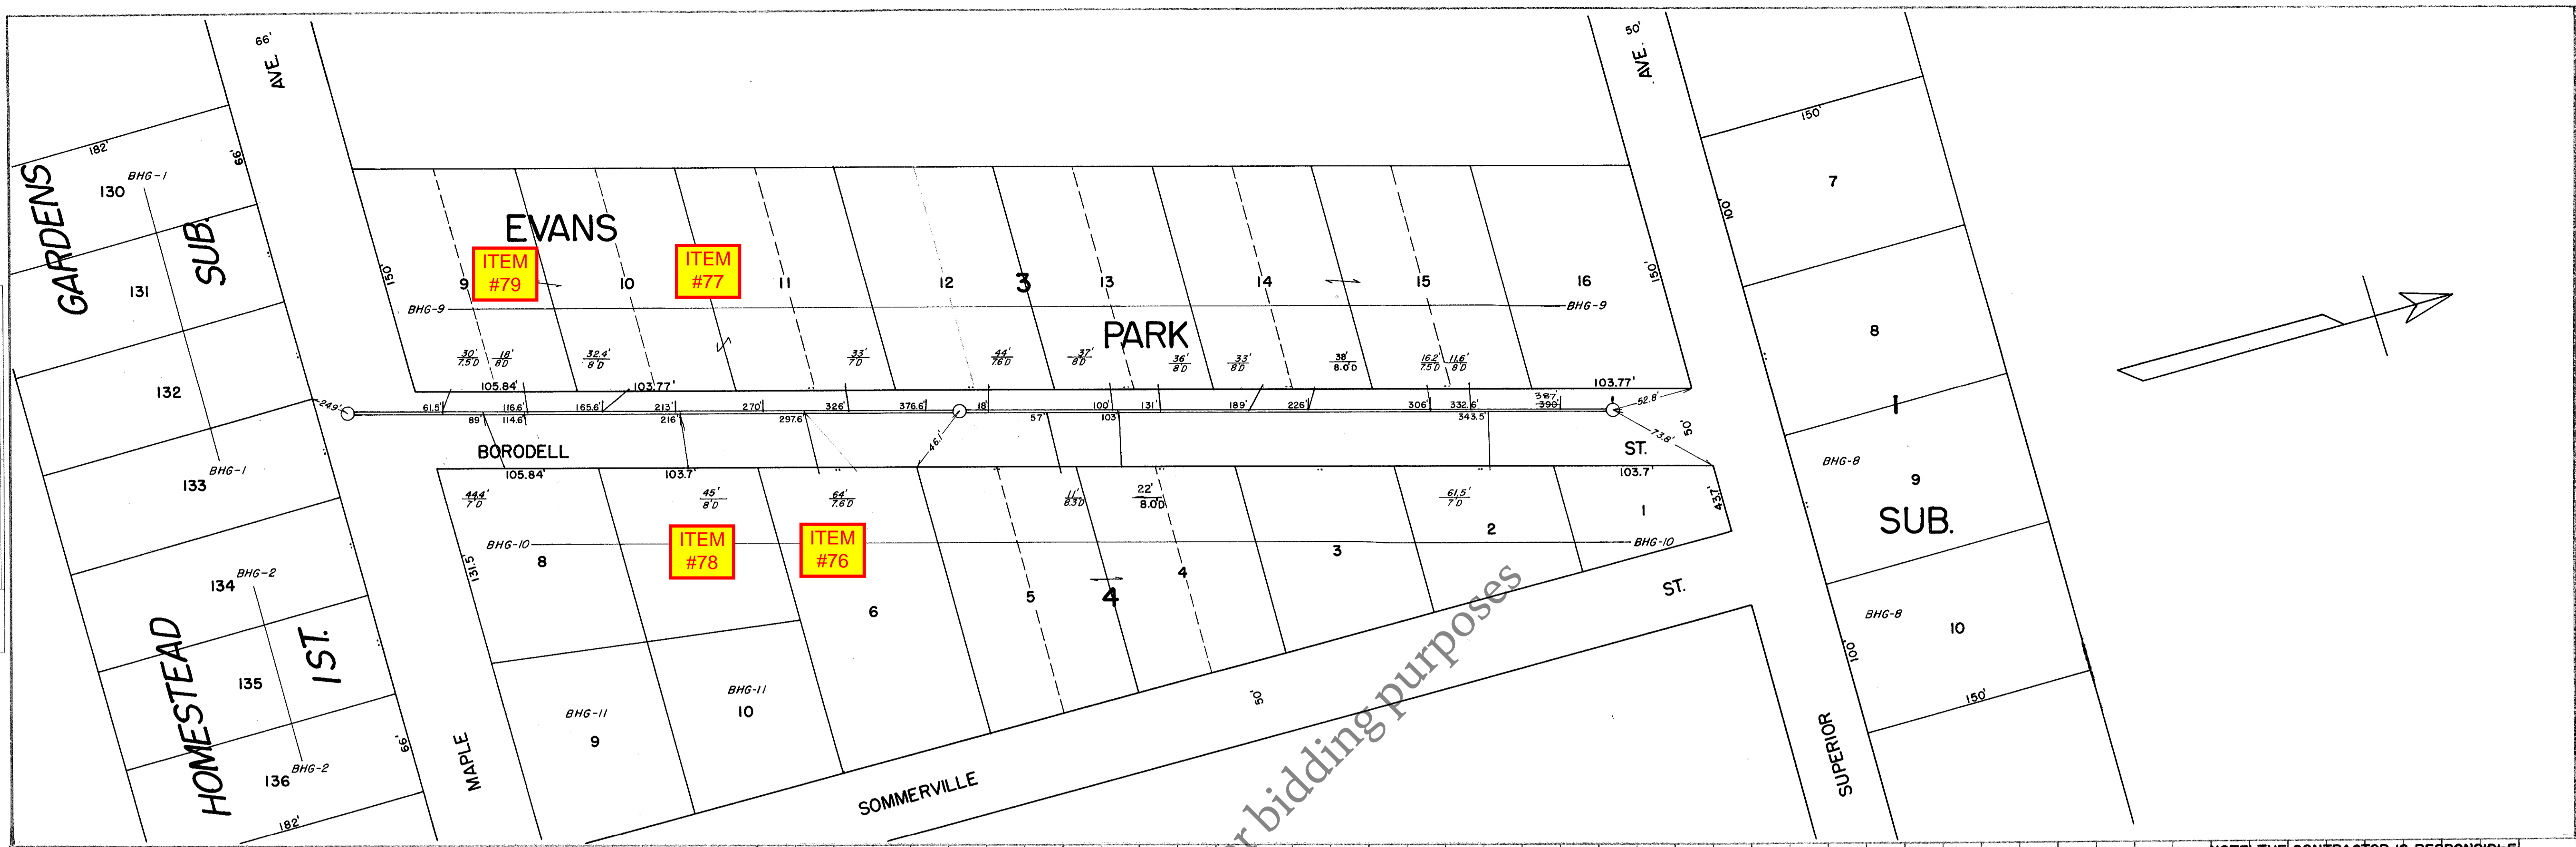

PROFILE SURVEYED BY C. H. WILSON
 PLOTTED AND CHECKED BY R. C. GLANS
 NOTE BOOK NO. 60
 DATE 9-21-54
 STRUCTURE NOTATIONS CHECKED BY R. C. GLANS

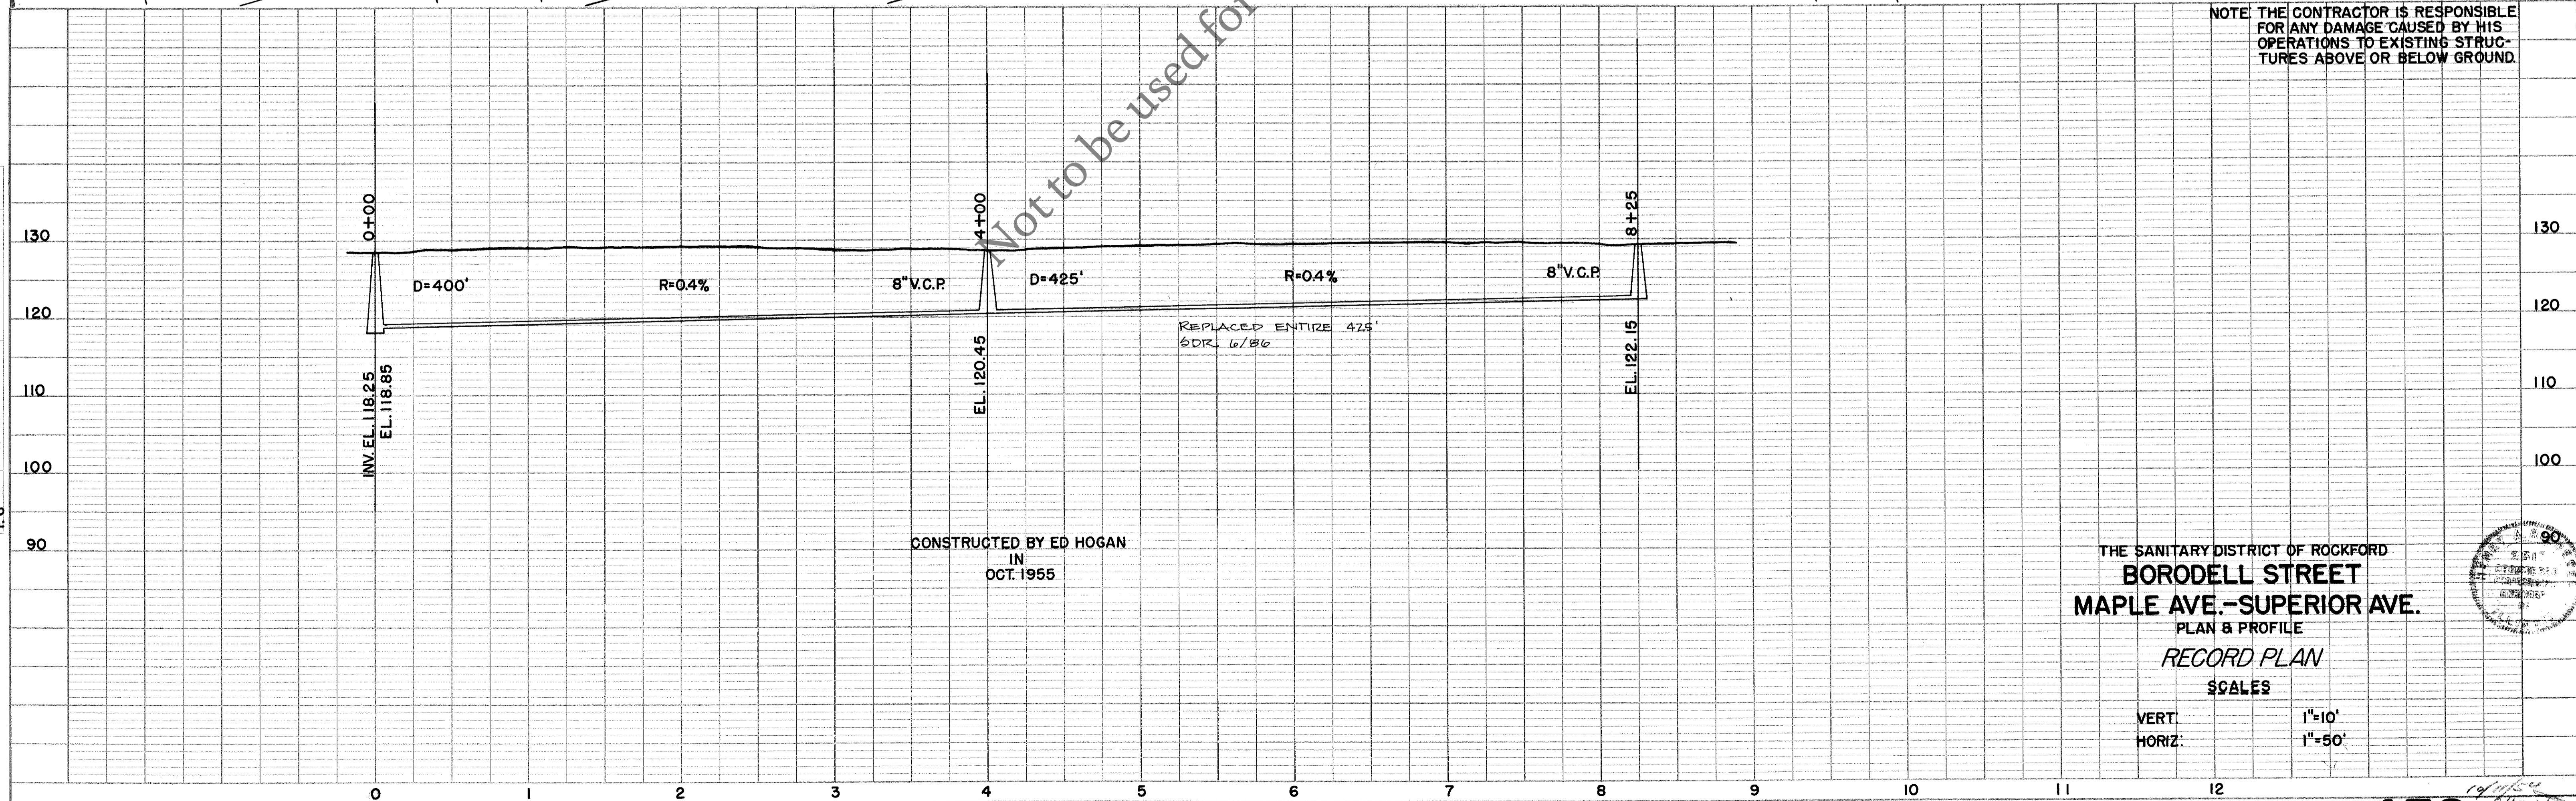


CONSTRUCTED BY ED HOGAN
 IN
 OCT. 1955

THE SANITARY DISTRICT OF ROCKFORD
BORODELL STREET
 MAPLE AVE.-SUPERIOR AVE.
 PLAN & PROFILE




RECORD PLAN
 SCALES

VERT: 1"=10'
 HORIZ: 1"=50'

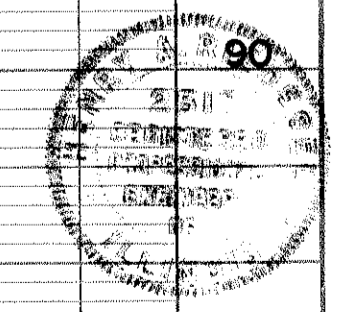

PLAN
 SURVEYED BY C.H. WILSON
 PLOTTED BY R.C. GLANS
 DATE 9-20-54
 NOTE BOOK ALIGNMENT CHECKED
 RT. OF WAY CHECKED

PROFILE
 SURVEYED BY C.H. WILSON
 PLOTTED BY R.C. GLANS
 DATE 9-20-54
 NOTE BOOK GRADES CHECKED
 STRUCTURE NOTATIONS CHECKED

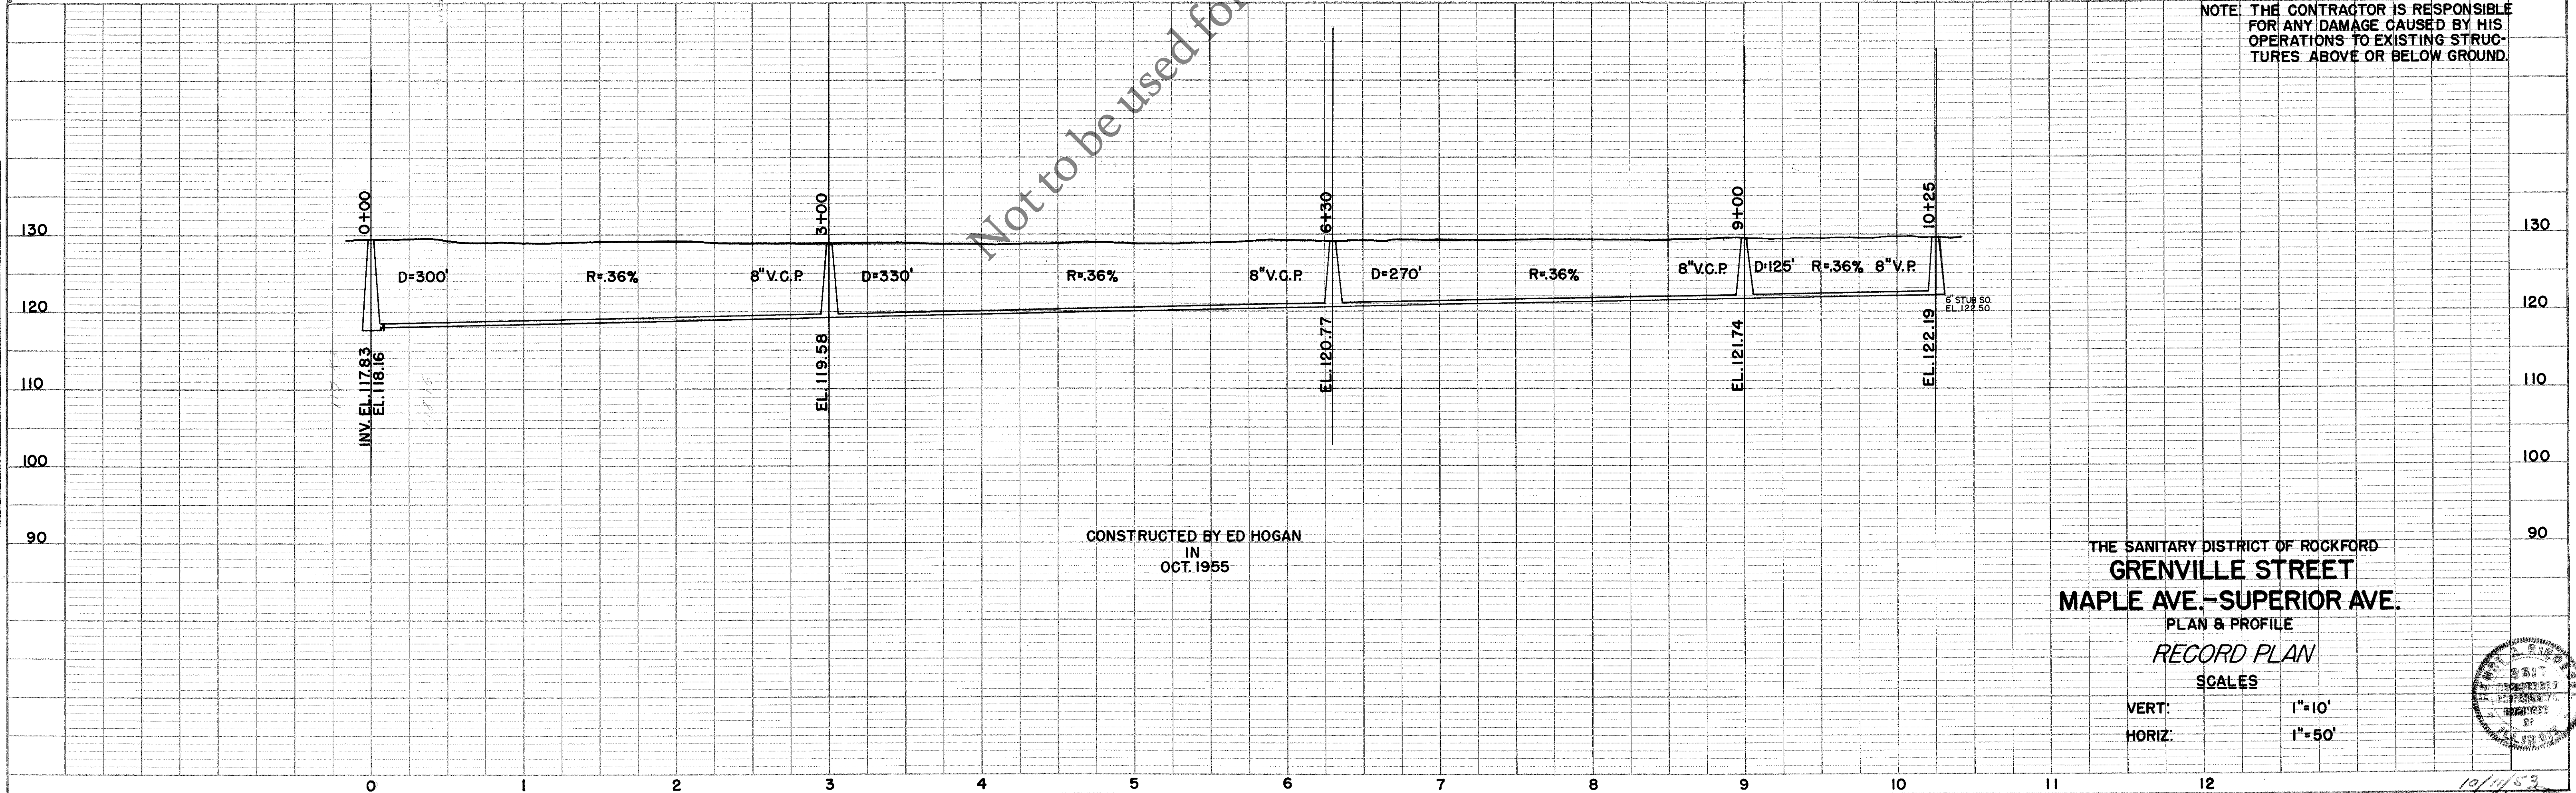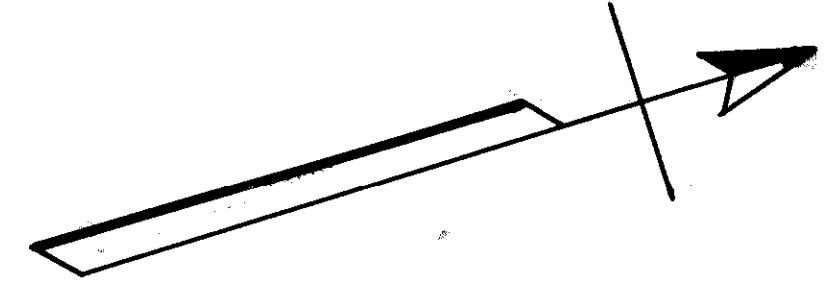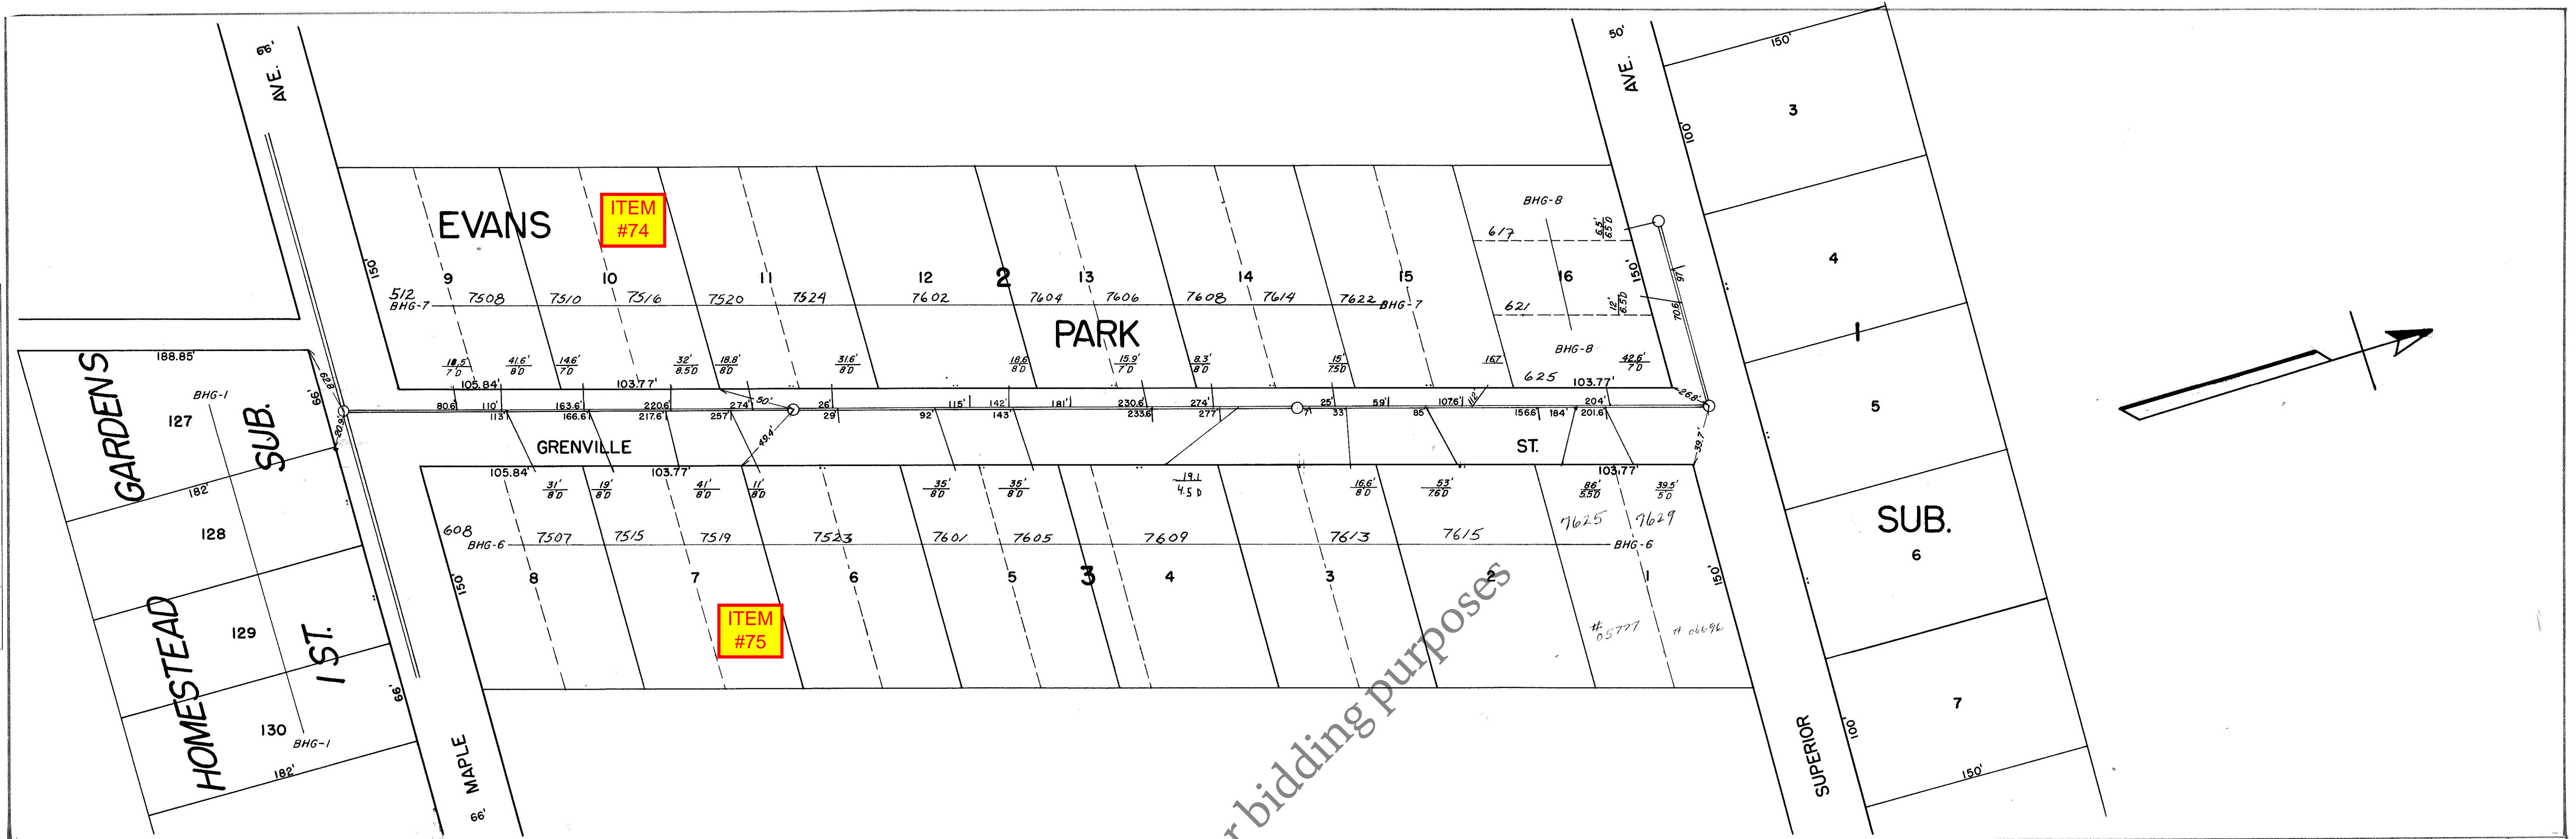


CONSTRUCTED BY ED HOGAN
 IN
 OCT. 1955

THE SANITARY DISTRICT OF ROCKFORD
GRENVILLE STREET
MAPLE AVE. - SUPERIOR AVE.
 PLAN & PROFILE



RECORD PLAN
 SCALES

VERT. 1"=10'
 HORIZ. 1"=50'

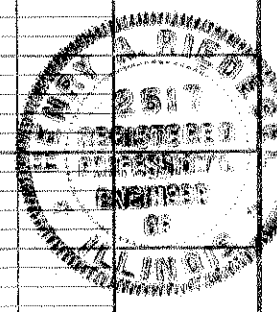

PLAN
 SURVEYED BY C.H. WILSON
 NOTE BOOK NO. 1000
 DATE 2-20-58
 CHECKED BY R.C. GLANS
 DATE 2-20-58
 NO. 1000

PROFILE
 SURVEYED BY C.H. WILSON
 NOTE BOOK NO. 1000
 DATE 2-20-58
 CHECKED BY R.C. GLANS
 DATE 2-20-58
 NO. 1000

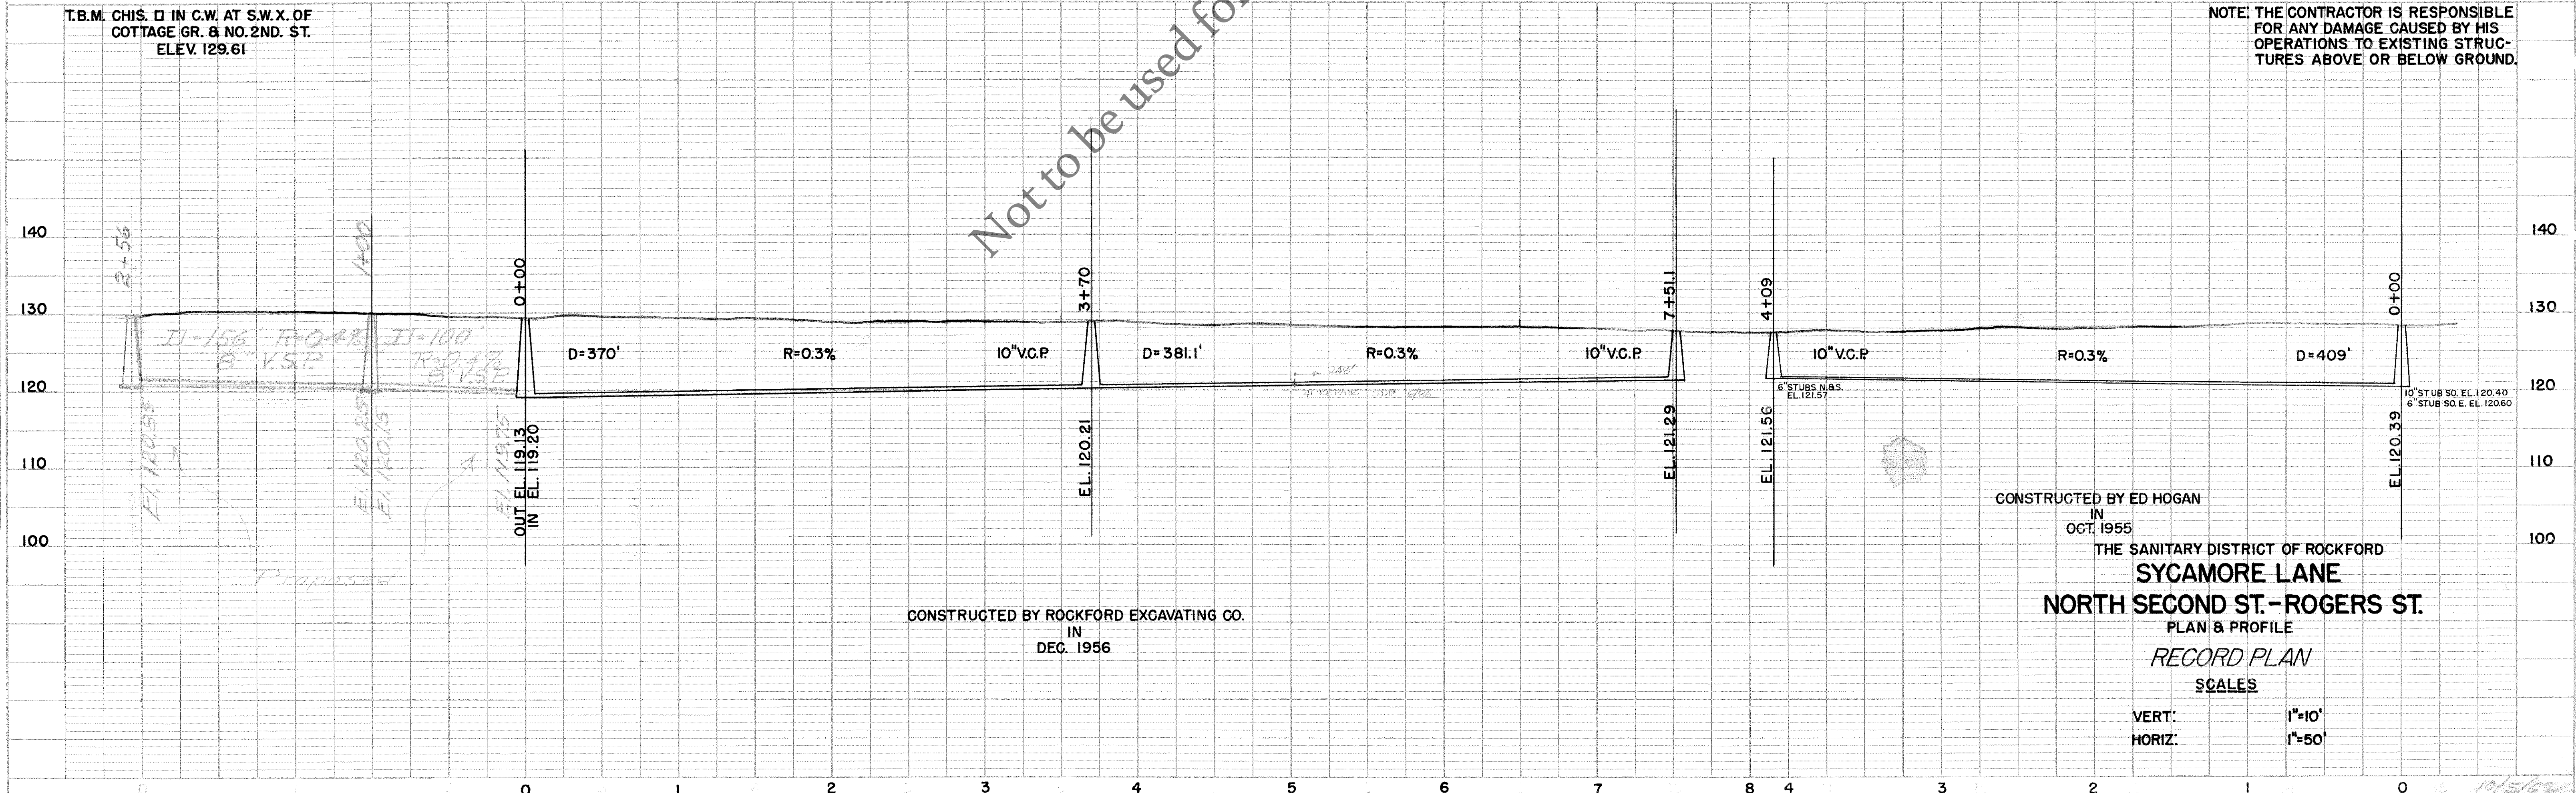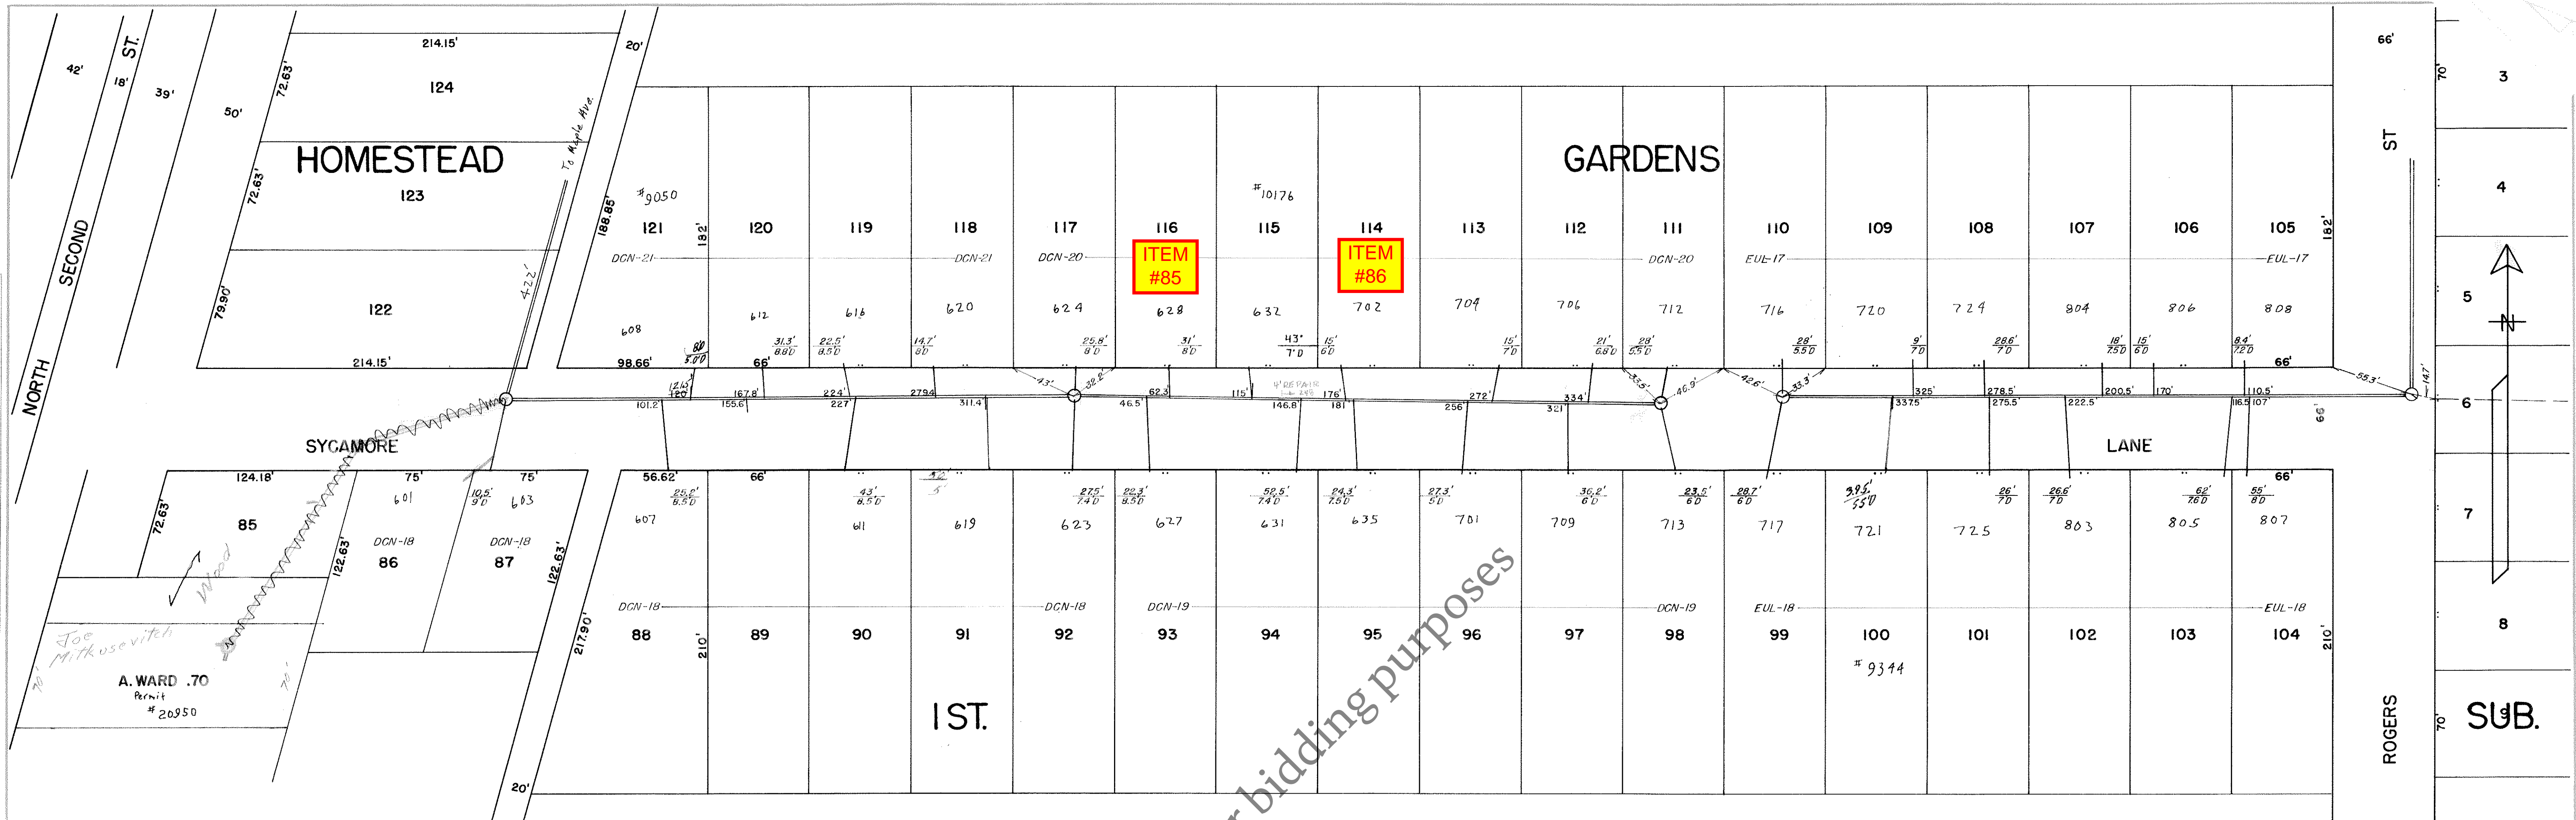


NOTE: THE CONTRACTOR IS RESPONSIBLE FOR ANY DAMAGE CAUSED BY HIS OPERATIONS TO EXISTING STRUCTURES ABOVE OR BELOW GROUND.

CONSTRUCTED BY ROCKFORD EXCAVATING CO.
 IN
 DEC. 1956

CONSTRUCTED BY ED HOGAN
 IN
 OCT. 1955
 THE SANITARY DISTRICT OF ROCKFORD
SYCAMORE LANE
NORTH SECOND ST.-ROGERS ST.
 PLAN & PROFILE
 RECORD PLAN
 SCALES
 VERT: 1"=10'
 HORIZ: 1"=50'


SURVEYED BY: *Frank P. Kowalski*
 ALIGNED BY: *George A. Johnson*
 REVISIONS: *12-2-31*
 NO. 3
 DATE: *12-2-31*
 PROJECT: *SEWERAGE & WATERWORKS*
 SHEET: *60-63*

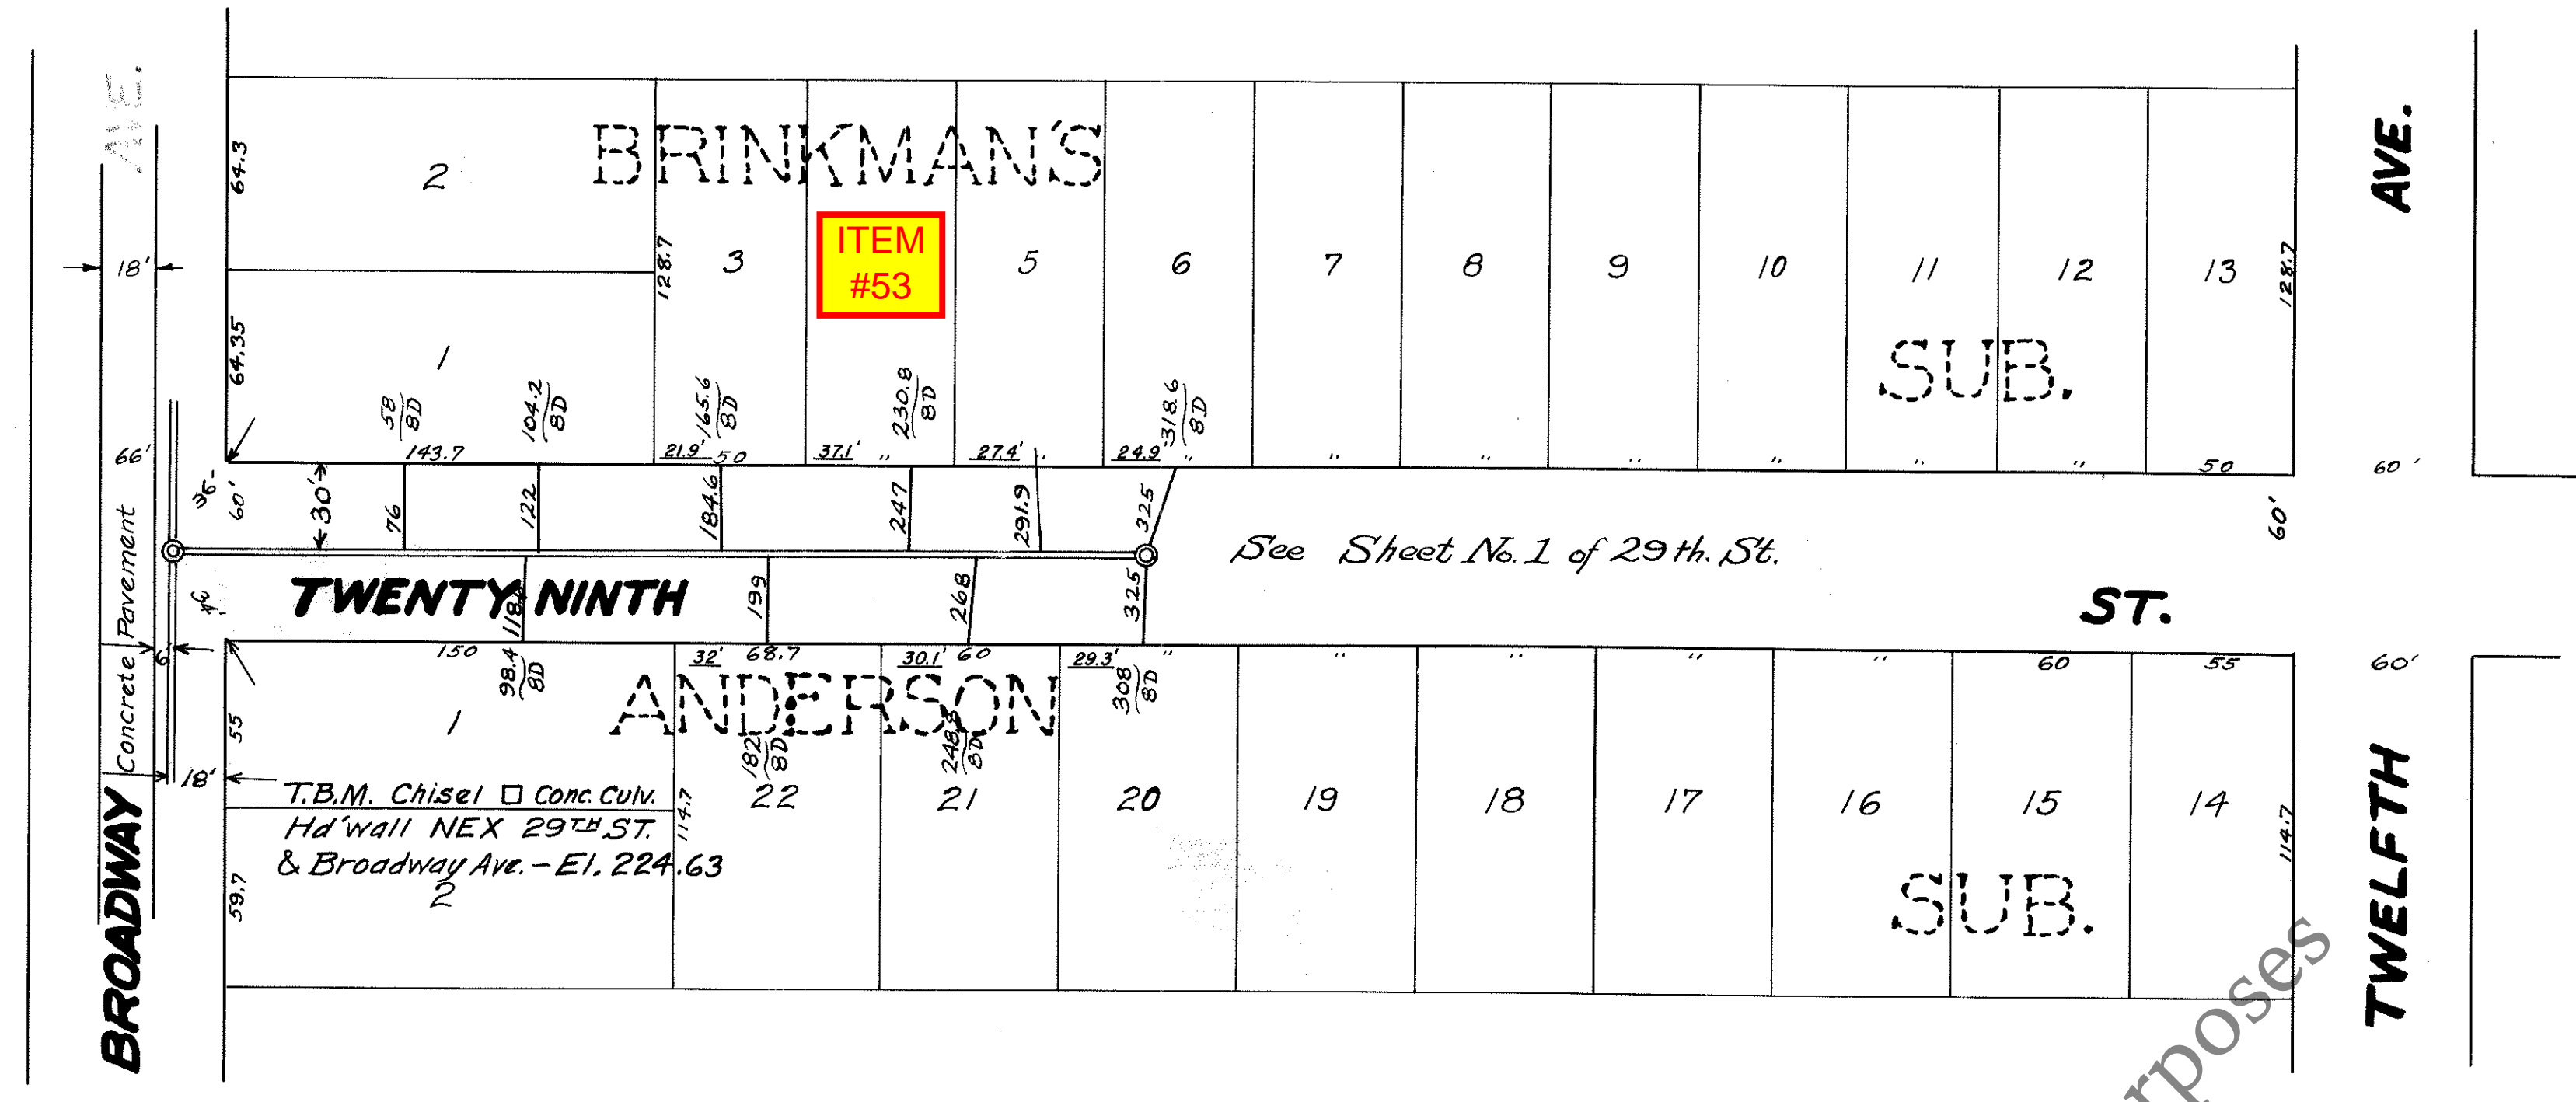

PLAN

Scale 1 inch = 50ft.

SURVEYED BY: *Frank P. Kowalski*
 ALIGNED BY: *George A. Johnson*
 REVISIONS: *12-2-31*
 NO. 3
 DATE: *12-2-31*
 PROJECT: *SEWERAGE & WATERWORKS*
 SHEET: *60-63*

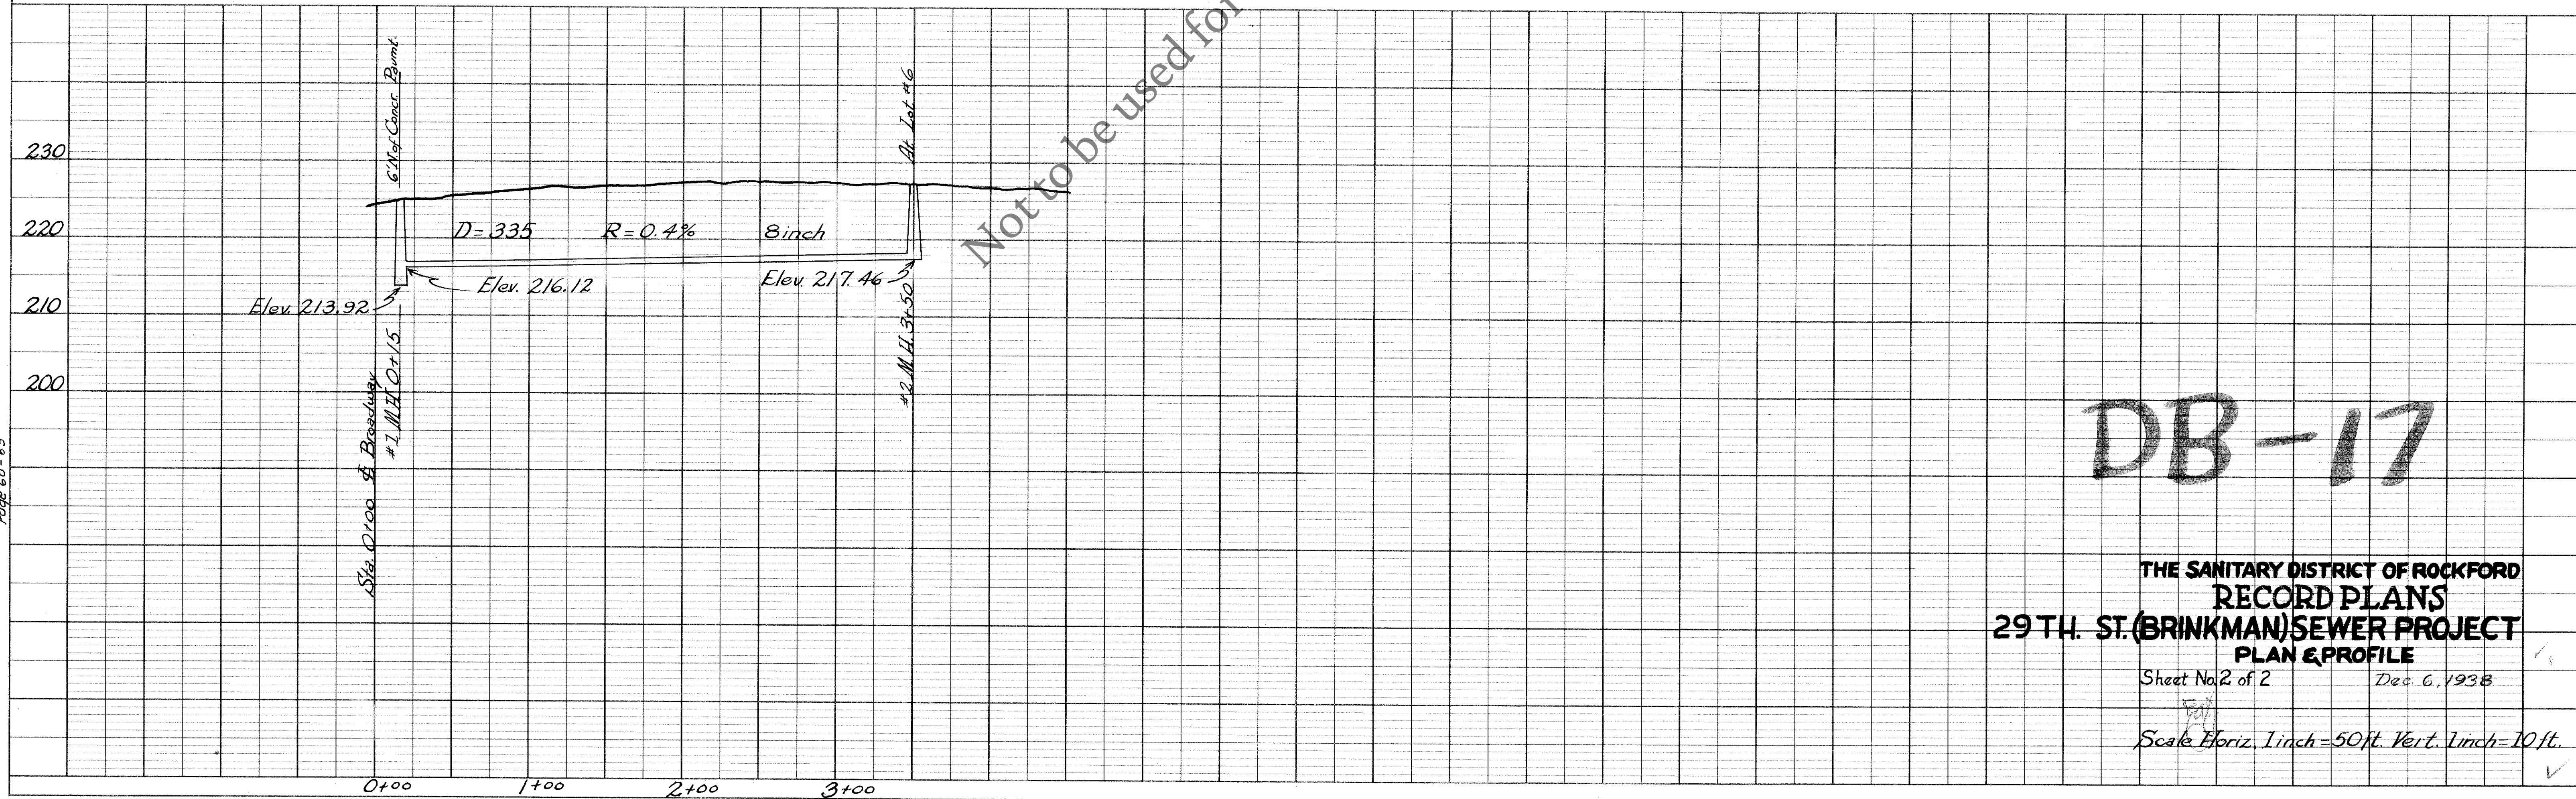

Not to be used for bidding purposes

DB-17

THE SANITARY DISTRICT OF ROCKFORD
 RECORD PLANS
 29 TH. ST. (BRINKMAN) SEWER PROJECT
 PLAN & PROFILE

Sheet No. 2 of 2 Dec. 6, 1938

Scale Horiz. 1 inch = 50ft. Vert. 1 inch = 10ft.

PROFILE

Section VI

**General Provisions & Technical
Specifications for Sanitary Sewer
Construction**

(Separate document incorporated by reference)