


FOUR RIVERS SANITATION AUTHORITY ROCKFORD, ILLINOIS

AEROBIC GRANULAR SLUDGE - PHASE I CAPITAL PROJECT NO. 2207 DECEMBER 20, 2022 BID SET

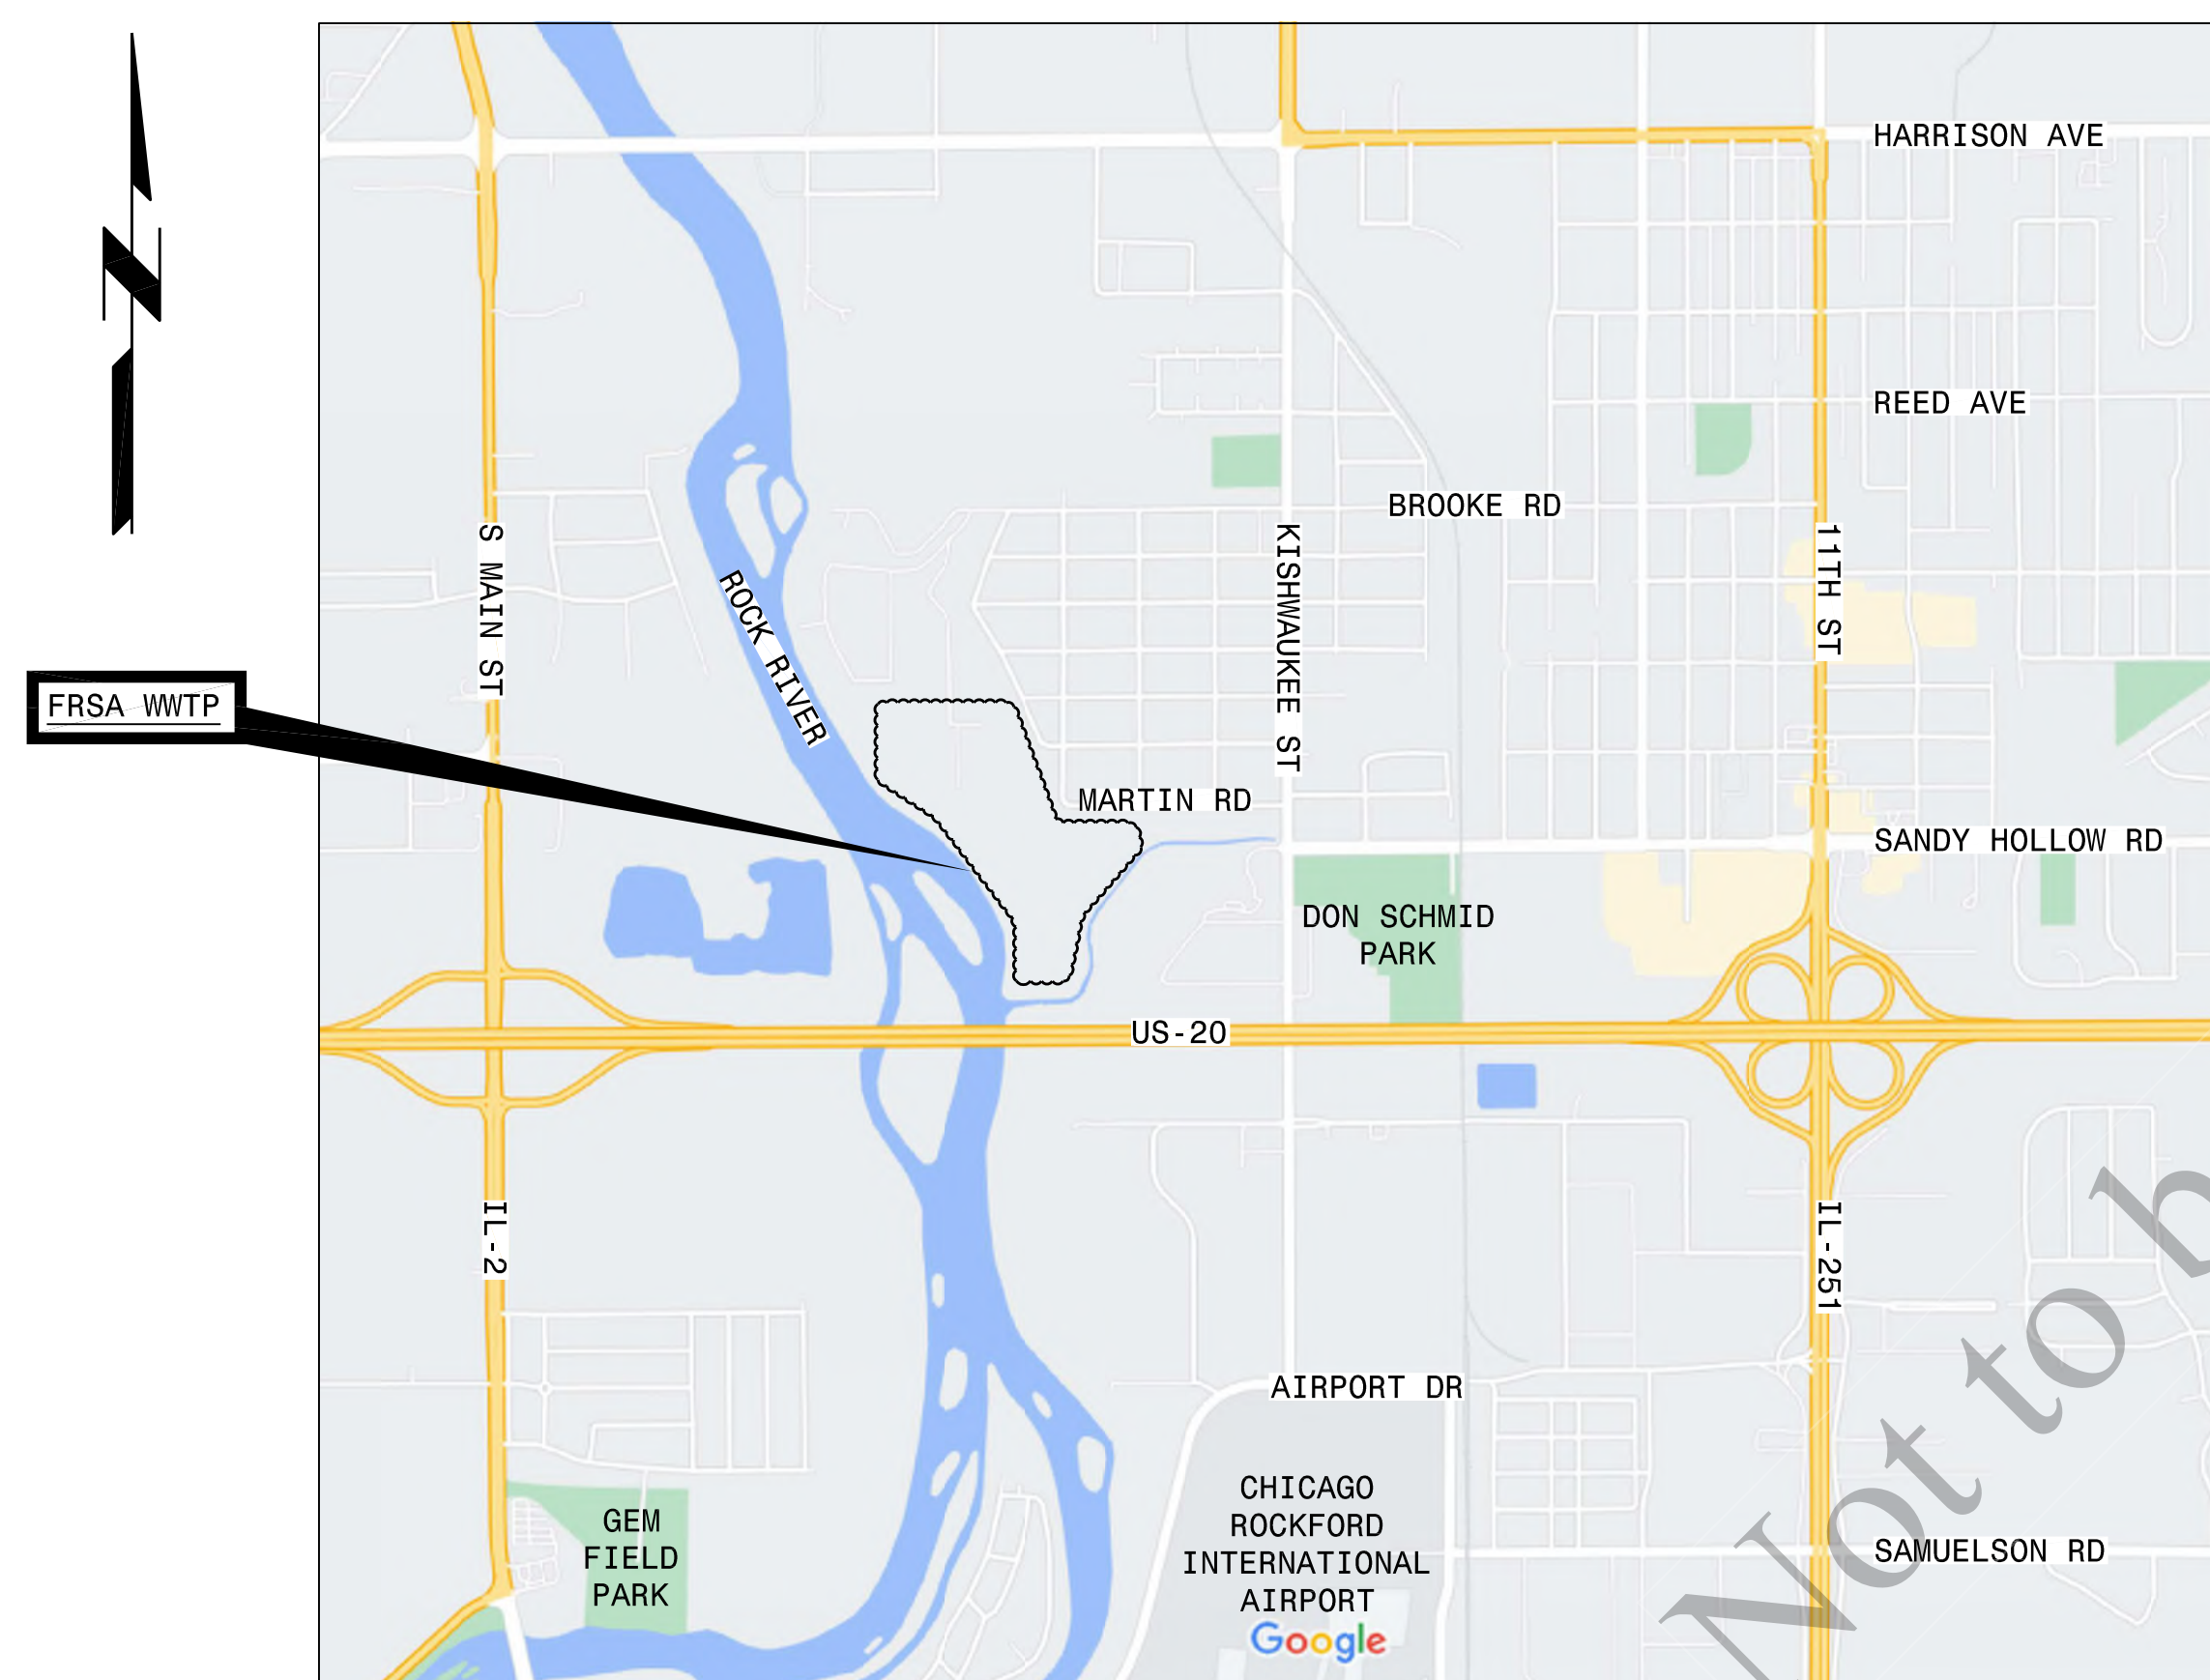

LOCATION MAP
NO SCALE

IEPA WPCLP SRF PROJECT NO. L17-6127

BOARD OF TRUSTEES
RICHARD POLLACK PRESIDENT
BEN BERNSTEN VICE PRESIDENT
GINGER HAAS CLERK/TREASURER
DONALD MASSIER TRUSTEE
ELMER JONES TRUSTEE

OFFICIALS
TIMOTHY S. HANSON EXECUTIVE DIRECTOR
CHRISTOPHER T. BAER, PE DIRECTOR OF ENGINEERING



SITE MAP
NO SCALE



Black & Veatch Corporation
Chicago, Illinois
ILLINOIS PROFESSIONAL
DESIGN FIRM - 184.002143 -0006

INDEX OF DRAWINGS

SHT #	DWG #	DRAWING TITLE
<u>GENERAL</u>		
0	00-G-001	COVER SHEET
1	00-G-002	INDEX OF DRAWINGS
2	00-G-003	ANNOTATION AND SYMBOLS LEGEND
3	00-G-004	GENERAL, CIVIL, AND PROCESS MECHANICAL ABBREVIATIONS
4	00-G-601	HYRAULIC PROFILE
5	00-G-602	PROCESS FLOW DIAGRAM
6	00-A-001	PERSPECTIVES
7	00-S-001	GENERAL NOTES
8	00-S-002	LEGENDS AND ABBREVIATIONS
9	00-S-003	LOADING CRITERIA
10	00-M-001	LEGENDS AND GENERAL NOTES
11	00-H-001	LEGENDS, ABBREVIATIONS, AND GENERAL NOTES
12	00-P-001	LEGENDS, ABBREVIATIONS, AND GENERAL NOTES
13	00-E-001	LEGENDS
14	00-E-002	ABBREVIATIONS AND NOTES
15	00-I-001	P&ID - LEGEND AND ABBREVIATIONS - SHEET 1 OF 3
16	00-I-002	P&ID - LEGEND AND ABBREVIATIONS - SHEET 2 OF 3
17	00-I-003	P&ID - LEGEND AND ABBREVIATIONS - SHEET 3 OF 3
18	01-I-601	P&ID - AGS REACTORS AND GALLERY
19	01-I-602	P&ID - WAGS/WLC PUMPS
20	02-I-601	P&ID - BLOWERS
21	00-D-101	DEMOLITION SITE PLAN
22	00-D-102	TRICKLING FILTER NO. 2 AND NO. 4 PLANS
23	00-D-103	TRICKLING FILTER PUMPING STATION PLAN
24	00-D-104	DRAINAGE PUMP STATION PLAN
25	00-D-105	METER VAULT PLAN AND SECTIONS
26	00-D-106	BYPASS CHAMBER PLAN AND SECTIONS
27	00-D-301	TRICKLING FILTER NO. 2 AND NO.4 SECTIONS
28	00-D-302	TRICKLING FILTER PUMP STATION SECTIONS
29	00-D-303	DRAINAGE PUMP STATION SECTIONS
30	00-C-001	LEGENDS AND GENERAL NOTES
31	00-C-101	KEY AND FACILITY ARRANGEMENT PLAN
32	00-C-102	EROSION AND SEDIMENT CONTROL PLAN
33	00-C-103	EXISTING CONDITIONS AND REMOVALS PLAN 1 OF 4
34	00-C-104	EXISTING CONDITIONS AND REMOVALS PLAN 2 OF 4
35	00-C-105	EXISTING CONDITIONS AND REMOVALS PLAN 3 OF 4
36	00-C-106	EXISTING CONDITIONS AND REMOVALS PLAN 4 OF 4
37	00-C-107	OVERALL PIPING PLAN
38	00-C-108	PIPING PLAN 1 OF 4
39	00-C-109	PIPING PLAN 2 OF 4
40	00-C-110	PIPING PLAN 3 OF 4
41	00-C-111	PIPING PLAN 4 OF 4
42	00-C-112	OVERALL GRADING AND PAVING PLAN
43	00-C-113	GRADING AND PAVING PLAN 1 OF 4
44	00-C-114	GRADING AND PAVING PLAN 2 OF 4
45	00-C-115	GRADING AND PAVING PLAN 3 OF 4
46	00-C-116	GRADING AND PAVING PLAN 4 OF 4
47	00-C-301	PIPING PROFILES 1 OF 2
48	00-C-302	PIPING PROFILES 2 OF 2
49	00-E-101	SITE PLAN
50	00-E-102	EXISTING ELECTRICAL PARTIAL PLANS


SHT #	DWG #	DRAWING TITLE
<u>AGS REACTORS AND PIPE GALLERY</u>		
51	01-A-001	REACTORS AND GALLERY LIFE SAFETY PLAN AND CODE ANALYSIS
52	01-A-101	AGS REACTORS AND GALLERY OVERALL PLANS
53	01-A-102	GALLERY STAIR NO. 1 PLANS AND ELEVATIONS
54	01-A-201	REACTOR PARTIAL ELEVATIONS
55	01-A-301	WALL SECTIONS
56	01-S-101	AGS REACTORS AND GALLERY FOUNDATION PLAN
57	01-S-102	AGS REACTORS AND GALLERY MID LEVEL PLAN
58	01-S-103	AGS REACTORS AND GALLERY TOP PLAN
59	01-S-104	PIPE GALLERY STAIR TOWER PLANS
60	01-S-301	SECTIONS AND DETAILS 1 OF 4
61	01-S-302	SECTIONS AND DETAILS 2 OF 4
62	01-S-303	SECTIONS AND DETAILS 3 OF 4
63	01-S-304	SECTIONS AND DETAILS 4 OF 4
64	01-S-501	DETAILS
65	01-S-502	DETAILS
66	01-M-101	OVERALL SECTIONAL PLAN
67	01-M-102	OVERALL TOP PLAN
68	01-M-301	REACTOR SECTIONS 1 OF 3
69	01-M-302	REACTOR SECTIONS 2 OF 3
70	01-M-303	REACTOR SECTIONS 3 OF 3
71	01-M-401	WEST SECTIONAL PLAN
72	01-M-402	WEST TOP PLAN
73	01-M-403	EAST SECTIONAL PLAN
74	01-M-404	EAST TOP PLAN
75	01-M-405	WETWELL ENLARGED PLAN AND SECTION
76	01-M-901	PERSPECTIVE VIEWS
77	01-H-101	REACTORS AND GALLERY OVERALL FLOOR PLAN
78	01-H-102	REACTORS AND GALLERY OVERALL TOP PLAN
79	01-H-401	REACTORS AND GALLERY ENLARGED FLOOR PLAN - WEST
80	01-H-402	REACTORS AND GALLERY ENLARGED FLOOR PLAN - EAST
81	01-H-403	REACTORS AND GALLERY ENLARGED TOP PLAN - WEST
82	01-H-404	REACTORS AND GALLERY ENLARGED TOP PLAN - EAST
83	01-P-101	REACTORS AND GALLERY OVERALL FLOOR PLAN
84	01-P-401	REACTORS AND GALLERY ENLARGED FLOOR PLAN - WEST
85	01-P-402	REACTORS AND GALLERY ENLARGED FLOOR PLAN - EAST
86	01-E-101	REACTOR 1 AND REACTOR 2 ELECTRICAL PLAN
87	01-E-102	REACTOR 3 AND REACTOR 4 ELECTRICAL PLAN
88	01-E-103	GALLERY ELECTRICAL PLANS
 <u>AGS SUPPORT FACILITIES</u>		
89	02-A-001	LIFE SAFETY PLAN AND CODE ANALYSIS
90	02-A-101	FLOOR AND ROOF PLANS
91	02-A-201	NORTH AND EAST ELEVATIONS
92	02-A-202	SOUTH AND WEST ELEVATIONS
93	02-A-301	WALL SECTIONS
94	02-S-101	FOUNDATION AND OPERATING FLOOR PLAN
95	02-S-102	ROOF PLAN
96	02-S-301	SECTIONS AND DETAILS 1 OF 2
97	02-S-302	SECTIONS AND DETAILS 2 OF 2
98	02-M-101	BLOWERS FLOOR PLAN
99	02-M-102	BLOWERS ROOF PLAN
100	02-M-301	BLOWERS SECTIONS
101	02-H-101	BLOWERS FLOOR PLAN
102	02-H-102	BLOWERS ROOF PLAN
103	02-P-101	BLOWERS FLOOR PLAN AND DETAIL
104	02-P-102	BLOWERS ROOF PLAN
105	02-E-101	FACILITIES POWER AND GROUNDING PLAN
106	02-E-102	FACILITIES LIGHTING PLAN
107	02-E-601	LIGHTING PANEL AND FIXTURE SCHEDULE
108	02-E-701	POWER DISTRIBUTION FUNCTIONAL DIAGRAM
109	02-E-702	SWITCHGEAR PARTIAL ONE-LINE DIAGRAMS
110	02-E-703	AGS MCC ONE-LINE DIAGRAM
111	02-E-704	AGS MCC ONE-LINE DIAGRAM
112	02-E-705	AGS PLC ONE-LINE DIAGRAM
113	02-E-706	AGS PLC ONE-LINE DIAGRAM
114	02-E-707	AGS POWER PANEL ONE-LINE DIAGRAM
115	02-E-708	SCHEMATICS

SHT #	DWG #	DRAWING TITLE
<u>YARD</u>		
116	98-M-101	DISTRIBUTION CHAMBER PLANS AND SECTIONS
117	98-M-102	FILTER EFFLUENT PUMPING STATION PLANS AND SECTION
118	98-M-103	OVERFLOW STRUCTURE PLANS AND SECTIONS
119	98-M-104	INLET SEWER MANHOLE PLAN AND SECTIONS
120	98-E-101	DISTRIBUTION CHAMBER PLANS AND SECTIONS
<u>DETAILS</u>		
121	99-C-501	EROSION CONTROL DETAILS
122	99-C-502	CIVIL DETAILS 1 OF 6
123	99-C-503	CIVIL DETAILS 2 OF 6
124	99-C-504	CIVIL DETAILS 3 OF 6
125	99-C-505	CIVIL DETAILS 4 OF 6
126	99-C-506	CIVIL DETAILS 5 OF 6
127	99-C-507	CIVIL DETAILS 6 OF 6
128	99-A-501	DETAILS
129	99-A-601	SCHEDULES AND DETAILS
130	99-A-602	DOOR, WINDOW AND LOUVER DETAILS
131	99-S-501	STANDARD CONCRETE REINFORCING DETAILS
132	99-S-502	STANDARD CONCRETE JOINT DETAILS
133	99-S-503	TYPICAL CONCRETE MASONRY REINFORCING DETAILS
134	99-S-504	TYPICAL CONCRETE MASONRY LINTEL AND JAMB DETAILS
135	99-S-505	STANDARD 3-RAIL GUARDRAIL AND HANDRAIL DETAILS
136	99-S-506	STANDARD STEEL PAN STAIR DETAILS
137	99-S-507	STANDARD LADDER DETAILS
138	99-S-508	TYPICAL METAL DECK DETAILS
139	99-S-509	STEEL ROOF TO CMU WALL CONNECTION DETAILS
140	99-S-510	HOLLOWCORE ROOF SLAB CONNECTION DETAILS
141	99-S-511	STANDARD CONCRETE BEAM AND SLAB SCHEDULE AND DETAILS
142	99-S-512	MISCELLANEOUS DETAILS
143	99-S-513	PIPE SUPPORT DETAILS 1 OF 4
144	99-S-514	PIPE SUPPORT DETAILS 2 OF 4
145	99-S-515	PIPE SUPPORT DETAILS 3 OF 4
146	99-S-516	PIPE SUPPORT DETAILS 4 OF 4
147	99-M-501	MECHANICAL DETAILS 1 OF 4
148	99-M-502	MECHANICAL DETAILS 2 OF 4
149	99-M-503	MECHANICAL DETAILS 3 OF 4
150	99-M-504	MECHANICAL DETAILS 4 OF 4
151	99-H-501	DETAILS
152	99-H-601	SEQUENCE OF OPERATIONS AND SCHEDULES
153	99-P-501	DETAILS
154	99-P-601	SCHEDULES
155	99-P-901	WATER AND DRAINAGE ISOMETRICS
156	99-E-501	DETAILS
157	99-E-502	DETAILS
158	99-E-503	DETAILS
159	99-I-501	INSTRUMENT INSTALLATION DETAILS 1 OF 4
160	99-I-502	INSTRUMENT INSTALLATION DETAILS 2 OF 4
161	99-I-503	INSTRUMENT INSTALLATION DETAILS 3 OF 4
162	99-I-504	INSTRUMENT INSTALLATION DETAILS 4 OF 4
163	99-I-601	CONTROL SYSTEM BLOCK DIAGRAM




12/19/2022
License Expires: 11/30/2023
ALL DRAWINGS UNLESS
OTHERWISE NOTED

ALL STRUCTURAL DRAWINGS

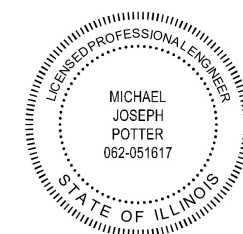

ALL I&C DRAWINGS

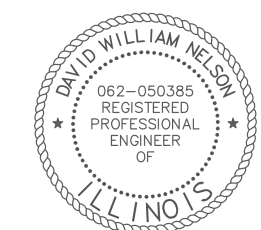

12/19/2022
License Expires: 11/30/2023
ALL HVAC AND
PLUMBING DRAWINGS



12/19/2022
License Expires: 11/30/2023
**ALL ELECTRICAL
DRAWINGS**

 **BLACK & VEATCH**

Black & Veatch Corporation
Chicago, Illinois
ILLINOIS PROFESSIONAL
DESIGN FIRM - 184.002143 -0006



AEROBIC GRANULAR SLUDGE - PHASE 1

[illegible]

REVISIONS AND RECORD OF ISSUE

DESIGNED:	JL
DETAILED:	VP
CHECKED:	AM/JH
APPROVED:	MR
DATE:	12/20/2022
PROJECT NO :	411752

GENERAL

GENERAL

INDEX OF DRAWINGS

00-G-002

1
OF
163



AEROBIC GRANULAR SLUDGE - PHASE 1



REVISIONS AND RECORD OF ISSUE	
DESIGNED:	JL
DETAILED:	VP
CHECKED:	AM/JH
APPROVED:	MR
DATE:	12/20/2022
PROJECT NO.:	411752

GENERAL

GENERAL

ANNOTATION AND SYMBOLS LEGEND

00-G-003

2
OF
163

FILL PATTERNS	ELEVATION & GRID CALLOUTS	VIEW CALLOUTS	DRAWING NUMBERING SYSTEM
<div><div></div><div>EARTH OR GRADE</div></div> <div><div></div><div>BEDROCK</div></div> <div><div></div><div>GRANULAR FILL (CRUSHED ROCK OR GRAVEL)</div></div> <div><div></div><div>SAND</div></div> <div><div></div><div>CONCRETE</div></div> <div><div></div><div>ENGINEERED FILL</div></div> <div><div></div><div>RIPRAP</div></div> <div><div></div><div>STONE</div></div> <div><div></div><div>BRICK</div></div> <div><div></div><div>CMU</div></div> <div><div></div><div>FACE BLOCK</div></div> <div><div></div><div>CHECKERED PLATE</div></div> <div><div></div><div>GRATE</div></div> <div><div></div><div>STEEL</div></div> <div><div></div><div>ALUMINUM</div></div> <div><div></div><div>DEMOLITION</div></div> <div><div></div><div>ASPHALT PAVEMENT</div></div>	<div><div>ELEVATION CALLOUTS</div><div><div><div>LEVEL NAME X.XX</div><div>PLAN ELEVATION</div><div>(SECTIONS & ELEVATIONS)</div></div><div><div><div>EL X.XX</div><div>FLOOR ELEVATION</div><div>(PLAN VIEWS)</div></div><div><div><div>EL X.XX</div><div>SPOT ELEVATION</div><div>(SECTIONS & ELEVATIONS)</div></div><div><div><div>N XXX E XXX EL XXX</div><div>SPOT COORDINATE</div><div>(PLAN VIEWS)</div></div><div><div><div>EL X.XX</div><div>WATER SURFACE ELEVATION</div></div></div></div><div><div>GRID/COLUMN CALLOUTS</div><div><div>TYPICAL GRID/COLUMN LAYOUT</div><div><div><div>ASCENDING ALPHANUMERIC SEQUENCE</div><div><div>1</div><div>1.5</div><div>2</div><div>3</div></div><div><div>A</div><div>A.5</div><div>B</div></div><div>ASCENDING NUMERIC SEQUENCE</div></div></div></div></div></div></div></div></div>	<div><div>SECTION CALLOUTS</div><div><div><div>CALLOUT DESIGNATION LETTER OR NUMBER</div><div>SHEET REFERENCE WHERE SECTION IS SHOWN</div></div><div><div><div>DETAIL/ENLARGED PLAN AREA CALLOUTS</div><div><div>CALLOUT DESIGNATION LETTER OR NUMBER</div><div>SHEET REFERENCE WHERE SECTION IS CUT</div></div><div><div>CALLOUT DESIGNATION LETTER OR NUMBER</div><div>SHEET REFERENCE WHERE DETAIL OR ENLARGED PLAN IS SHOWN</div><div>CALLOUT BOUNDARY</div></div></div></div></div></div>	<div><div><div>B - X - 1 01</div><div>SHEET SEQUENTIAL NUMBER</div><div>SHEET TYPE DESIGNATOR</div><div>DISCIPLINE DESIGNATOR</div><div>FACILITY/AREA DESIGNATION CODE</div></div><div><div>DISCIPLINE DESIGNATORS</div><div>A ARCHITECTURAL C CIVIL D DEMOLITION E ELECTRICAL F FIRE PROTECTION G GENERAL H HVAC/BUILDING MECHANICAL I INSTRUMENTATION AND CONTROLS L LANDSCAPE M PROCESS MECHANICAL P PLUMBING S STRUCTURAL</div></div><div><div>AREA/FACILITY DESIGNATION CODES</div><div>00 GENERAL 01 AGS REACTORS AND PIPE GALLERY 02 AGS SUPPORT FACILITIES 98 YARD 99 DETAILS</div></div><div><div>SHEET TYPE DESIGNATORS</div><div>0 GENERAL (SYMBOLS, LEGENDS, NOTES, ETC.) 1 PLANS (ARRANGEMENT PLANS, PARTIAL PLANS) 2 ELEVATIONS 3 SECTIONS 4 LARGE SCALE VIEWS (ENLARGED PLANS, STAIR SECTIONS OR SECTIONS THAT ARE NOT DETAILS) 5 DETAILS 6 SCHEDULES & DIAGRAMS 7 SCHEMATICS (ONE-LINES, BLOCK DIAGRAMS) 8 USER DEFINED 9 3D MODEL (PERSPECTIVES, ISOMETRICS, PHOTOGRAPHS)</div></div></div>
	<div><div>NORTH ARROW</div><div><div>NORTH ARROW (TRUE NORTH)</div></div></div>	<div><div>SECTION & DETAIL VIEW TITLES</div><div><div><div>SECTION</div><div>X-XX-XXX 1/8" = 1'-0"</div><div>SHEET REFERENCE WHERE SECTION IS USED</div></div><div><div>DETAIL</div><div>X-XX-XXX 1/8" = 1'-0"</div><div>SHEET REFERENCE WHERE DETAIL IS USED</div></div></div></div>	
	<div><div>BREAKS</div><div><div>PLAN, ELEVATION, AND SECTION BREAKS</div><div>PIPE BREAK</div></div></div>	<div><div>ANNOTATION</div><div><div>SHEET NOTES</div><div><div>SHEET KEYNOTE</div><div>REFERENCE KEYNOTE (KEYNOTE LIST)</div></div><div><div>REVISIONS</div><div><div>REVISION TAG</div><div>REVISION CLOUD</div></div></div></div></div>	
	<div><div>LINE STYLES</div><div><div>EXISTING FACILITY</div><div>NEW FACILITY</div><div>OTHER DISCIPLINE NEW FACILITY BACKGROUND</div><div>GRID LINE OR CENTERLINE</div><div>MATCH LINE</div><div>EXAMPLE BOUNDARY LINE (SEE CIVIL LEGEND)</div></div><div><div><div><div></div><div></div><div></div><div></div><div></div></div><div>PL</div></div></div></div>		

A	
AB	AGGREGATE BASE
ABV	ABOVE
AC	ASPHALT CONCRETE
ACP	ASBESTOS CEMENT PIPE
AD	AREA DRAIN, ANODE
ADD	ADDITIONAL
ADJ	ADJUSTABLE, ADJACENT
ADMIN	ADMINISTRATION
ADWF	AVERAGE DRY-WEATHER FLOW
AFF	ABOVE FINISHED FLOOR
AFG	ABOVE FINISHED GRADE
AH	AHEAD
ALT	ALTERNATE, ALTERNATIVE
ANC	ANCHOR
AP	ACCESS PANEL, ANGLE POINT
APPR	APPROACH
APPROX	APPROXIMATE, APPROXIMATELY
AR	ANCHOR ROD
ARCH	ARCHITECTURAL
ASSY	ASSEMBLY
ATM	ATMOSPHERE, ATMOSPHERIC
AUTO	AUTOMATIC
AUX	AUXILIARY
AVG	AVERAGE
AWG	AMERICAN WIRE GAUGE
AWWA	AMERICAN WATER WORKS ASSOCIATION
AWWF	AVERAGE WET-WEATHER FLOW
B	
B	BORE HOLE
B TO B	BACK TO BACK
BAL	BALANCE
BC	BACK OF CURB
BET	BETWEEN
BF	BLIND FLANGE
BHP	BRAKE HORSEPOWER
BITUM	BITUMINOUS
BLDG	BUILDING
BLK	BLOCK
BM	BENCHMARK
BNR	BIOLOGICAL NUTRIENT REMOVAL
BOD	BIOLOGICAL/BIOCHEMICAL OXYGEN DEMAND
BOF	BOTTOM OF FOOTING
BOP	BOTTOM OF PIPE
BOT	BOTTOM
BP	BACK PRESSURE
BRG	BEARING
BS	BOTH SIDES
BU	BELL-UP
BVC	BEGINNING OF VERTICAL CURVE
C	
C	CURVE
C TO C	CENTER TO CENTER
CB	CATCH BASIN
CF	CUBIC FEET
CFM	CUBIC FEET PER MINUTE
CFS	CUBIC FEET PER SECOND
C&G	CURB AND GUTTER
CIP	CAST IRON PIPE
CISP	CAST IRON SOIL PIPE
CL	CLASS
C/L	CENTERLINE
CLG	CEILING
CLR	CLEAR, CLEARANCE
CLSM	CONTROLLED LOW STRENGTH MATERIAL
CMC	CEMENT MORTAR COATED
CML	CEMENT MORTAR LINED
CMP	CORRUGATED METAL PIPE
CO	CLEAN OUT, COMPANY
COD	CHEMICAL OXYGEN DEMAND
COL	COLUMN
COMB	COMBINATION
COMB SWR	COMBINED SEWER
CONC	CONCRETE
CONN	CONNECTION
CONST	CONSTRUCTION
CONT	CONTINUED, CONTINUOUS, CONTINUATION, CONTROL
CONTR	CONTRACTOR
COR	CORNER
CORR	CORRIDOR, CORRUGATED
CP	CONTROL POINT, CATHODIC PROTECTION, CATCH POINT
CPLG	COUPLING
CPVC	CHLORINATED POLYVINYL CHLORIDE
CSP	CORRUGATED STEEL PIPE
CTR(S)	CENTER(S)
CTS	CORROSION/CATHODIC TEST STATION
CU	CUBIC, COPPER
CY	CUBIC YARD
D	
D	DOOR
DB	DUCT BANK
DBL	DOUBLE
DEG	DEGREE
DEPT	DEPARTMENT
DET	DETAIL
DI	DROP INLET, DUCTILE IRON
DIA	DIAMETER
DIFF	DIFFUSER
DIM	DIMENSION
DIP	DUCTILE IRON PIPE
DISCH	DISCHARGE
DIST	DISTRIBUTION
DIV	DIVISION
DMJ	DISMANTLING JOINT
DN	DOWN
DRN	DRAIN
DW	DRY WELL
DWG(S)	DRAWING(S)

E	
E	EAST, EASTING
EA	EACH
ECC	ECCENTRIC
ECC RED	ECCENTRIC REDUCER
EFF	EFFLUENT, EFFICIENCY
EG	EXISTING GRADE
EJ	EXPANSION JOINT
EL	ELEVATION
ELB	ELBOW
ELL	ELBOW
ELEC	ELECTRIC, ELECTRICAL
EMER	EMERGENCY
ENC	ENCASEMENT
ENCL	ENCLOSURE
EOL	END OF LINE
EOP	EDGE OF PAVEMENT
EOS	EDGE OF SLAB
EQ	EQUAL
EQUIP	EQUIPMENT
EVC	END OF VERTICAL CURVE
EW	EACH WAY
EXH	EXHAUST
EXIST	EXISTING
EXP	EXPANSION, EXPOSED
EXT	EXTENSION, EXTERIOR, EXTERNAL

F	
F	FAHRENHEIT, FACE
F TO F	FACE TO FACE
FAB	FABRICATE(D)TION
FC	FACE OF CONCRETE, FAIL CLOSED
FCA	FLANGED COUPLING ADAPTER
FD	FLOOR DRAIN
FF	FINISHED FLOOR
FG	FINISHED GRADE
FH	FIRE HYDRANT
FIG	FIGURE
FL	FLOOR, FLOW LINE
FLEX	FLEXIBLE
FLG	FLANGE(D)
FM	FORCE MAIN
FMH	FLEXIBLE METAL HOSE
FO	FAIL OPEN
FOB	FLAT ON BOTTOM
FOM	FACE OF MASONRY
FOT	FLAT ON TOP
FPS	FEET PER SECOND
FRP	FIBERGLASS REINFORCED PLASTIC
FS	FAR SIDE, FLOOR SLEEVE
FT	FOOT, FEET
FTG	FOOTING
FURN	FURNISH, FURNISHED
FWD	FORWARD

G	
G	GAS
GA	GAUGE
GAL	GALLON
GALV	GALVANIZED
GB	GRADE BREAK
GC	GROOVED COUPLING
GEN	GENERAL, GENERATOR
GL	GLASS
GM	GAS METER
GPD	GALLONS PER DAY
GPM	GALLONS PER MINUTE
GR	GRADE

H	
H	HIGH, HOUR
HDG	HOT-DIPPED GALVANIZED
HDPE	HIGH DENSITY POLYETHYLENE
HEX	HEAT EXCHANGER
HGT	HEIGHT
HH	HANDHOLE
HMC	HARNESSED MECHANICAL COUPLING
HMJ	HARNESSED MECHANICAL JOINT
HORIZ	HORIZONTAL
HP	HIGH POINT, HIGH PRESSURE, HORSEPOWER
HR	HOUR, HANDRAIL
HS	HIGH STRENGTH
HVAC	HEATING, VENTILATING AND AIR CONDITIONING
HWY	HIGHWAY
HYDRO	HYDROPNEUMATIC, HYDROGENERATION

I	
ID	INSIDE DIAMETER
IE	INVERT ELEVATION
IF	INSIDE FACE
IN	INCH(ES)
INCL	INCLUDING
INCR	INCREASE
INST	INSTRUMENT, INSTRUMENTATION
INSUL	INSULATE, INSULATED, INSULATING
INT	INTERIOR, INTERNAL
INV	INVERT
IPS	IRON PIPE SIZE

J	
JB	JUNCTION BOX
JT	JOINT

K	
KVA	KILOVOLT AMPERE

L	
L	LENGTH, LONG, LOW
LAT	LATERAL, LATITUDE
LB(S)	POUND(S)
LC	LENGTH OF CURVE
LF	LINEAR FEET
LH	LEFT HAND
LIN	LINEAL, LINEAR
LONG	LONGITUDE
LP LOW	POINT, LOW PRESSURE
LT	LEFT

M	
MAINT	MAINTENANCE
MAN	MANUAL(LY)
MAX	MAXIMUM
MBR	MEMBRANE BIOREACTOR
MC	MECHANICAL COUPLING
MECH	MECHANICAL
MED	MEDIUM
MF	MICROFILTRATION
MFR	MANUFACTURER
MG	MILLION GALLONS
MG/L	MILLIGRAMS PER LITER
MGD	MILLION GALLONS PER DAY
MH	MAINTENANCE HOLE, MANHOLE
MIN	MINIMUM, MINUTE
MISC	MISCELLANEOUS
MJ	MECHANICAL JOINT
MJRG	MECHANICAL JOINT RETAINER GLAND
MJTR	MECHANICAL JOINT WITH TIE ROD
MO	MOTOR OPERATED
MSL	MEAN SEA LEVEL
MTD	MOUNTED
MTL	MATERIAL
MTR	MOTOR
MW	MONITORING WELL

N	
N	NORTH, NORTHING, NITROGEN (TOTAL AS N)
N/A	NOT APPLICABLE
NAD	NORTH AMERICAN DATUM (HORIZONTAL)
NAV D	NORTH AMERICAN VERTICAL DATUM
NC	NORMALLY CLOSED
NF	NEAR FACE
NG	NATURAL GAS
NIC	NOT IN CONTRACT
NO	NORMALLY OPEN
NO	NUMBER(S)
NOM	NOMINAL
NPSH	NET POSITIVE SUCTION HEAD
NPSHR	NET POSITIVE SUCTION HEAD REQUIRED
NPT	NATIONAL PIPE THREAD
NRS	NON-RISING STEM
NS	NEAR SIDE
NTS	NOT TO SCALE

O	
OC	ON CENTER, ODOR CONTROL
OD	OUTSIDE DIAMETER
OF	OUTSIDE FACE, OVERFLOW
OH	OVERHEAD
OPER	OPERATING
OPNG	OPENING
OPP	OPPOSITE
OZ	OUNCE

P	
P&ID	PIPING/PROCESS AND INSTRUMENTATION DIAGRAM
P	PHOSPHORUS (TOTAL AS P)
PPM	PARTS PER MILLION
PC	POINT OF CURVATURE
PCC	POINT OF COMPOUND CURVATURE
PCCP	PRESTRESSED CONCRETE CYLINDER PIPE
PE	PLAIN END
PG	PRESSURE GAUGE
PH	PIPE HANGER
PI	POINT OF INTERSECTION
PNL(S)	PANEL(S), PANELBOARD(S)
PCC	POINT ON CIRCULAR CURVE, POINT OF CONNECTION
POT	POINT ON TANGENT
PP	POWER POLE
PROJ	PROJECTION
PRS	PRESSURE REDUCING STATION
PS	PIPE SUPPORT
PSF	POUNDS PER SQUARE FOOT
PSI	POUNDS PER SQUARE INCH
PSIA	POUNDS PER SQUARE INCH ABSOLUTE
PSIG	POUNDS PER SQUARE INCH GAUGE
PT	POINT OF TANGENCY, POINT
PVC	POLYVINYL CHLORIDE, POINT OF VERTICAL CURVATURE
PVT	POINT OF VERTICAL TANGENCY
PVCP	POLYVINYL CHLORIDE PIPE
PVI	POINT OF VERTICAL INTERSECTION
PVMT	PAVEMENT

Q	
Q	RATE OF FLOW
QCPLG	QUICK COUPLING

R	
R	RADIUS, RISER
R/W	RIGHT OF WAY
RCP	REINFORCED CONCRETE PIPE
RCCP	REINFORCED CONCRETE CYLINDER PIPE
RECIRC	RECIRCULATING
RED	REDUCER, REDUCING
REF	REFERENCE
REINF	REINFORCED, REINFORCING
REM	REMOVABLE, REMOVE

REQD	REQUIRED
RET	RETURN
REV	REVISION, REVISED, REVERSED
RH	RIGHT HAND
RO	REVERSE OSMOSIS
RPM	REVOLUTIONS PER MINUTE
RR	RAILROAD
RS	RISING STEM
RT	RIGHT
ROW	RIGHT OF WAY

S	
S	SECOND, SLOPE, SOUTH
SCHED	SCHEDULE
SCFM	STANDARD CUBIC FEET PER MINUTE
SD	STORM DRAIN
SEC	SECOND
SECT	SECTION
SF	SQUARE FEET
SH	SHEET
SIM	SIMILAR
SP	STEEL PIPE
SPA	SPACING, SPACES
SPEC(S)	SPECIFICATION(S)
SPL	SPECIAL
SPLY	SUPPLY
SQ	SQUARE
SS	STAINLESS STEEL
SS	SANITARY SEWER
ST SWR	STORM SEWER
STA	STATION
STD	STANDARD
STL	STEEL
STOR	STORAGE
STR	STRUCTURAL
SUSP	SUSPENDED
SYM	SYMMETRICAL
SYS	SYSTEM

T	
T	TELEPHONE, TOP
TAN	TANGENT
TBC	TOP BACK OF CURB
TBD	TO BE DETERMINED
TBM	TEMPORARY BENCHMARK
TC	TOP OF CURB
TDS	TOTAL DISSOLVED SOLIDS
TEMP	TEMPERATURE, TEMPORARY
TH	TEST HOLE
THD	THREADED
THK	THICK, THICKNESS
TOC	TOP OF CONCRETE, TABLE OF CONTENTS, TOTAL ORGANIC CARBON
TOF	TOP OF FOOTING
TOM	TOP OF MASONRY
TOP	TOP OF PIPE
TOW	TOP OF WALL
TP	TEST PIT
TRANS	TRANSFORMER
TS	TOTAL SOLIDS
TSS	TOTAL SUSPENDED SOLIDS
TYP	TYPICAL

U	
UB	UTILITY BOX
UF	ULTRAFILTRATION
UG	UNDERGROUND
UNO	UNLESS NOTED OTHERWISE
UP	UTILITY POLE
USGS	UNITED STATES GEOLOGICAL SURVEY
UV	ULTRAVIOLET
V	
V	VALVE (SEE P&ID ABBREVIATIONS), VERTICAL, VOLT, VENT
VAC	VACUUM
VB	VALVE BOX
VC	VERTICAL CURVE
VCP	VITRIFIED CLAY PIPE
VERT	VERTICAL
VIF	VERIFY IN FIELD
VOCs	VOLATILE ORGANIC COMPOUNDS
VP	VAPOR PRESSURE

W	
W	WEST, WIDE, WATER
W/	WITH
WC	WATER COLUMN
WEF	WATER ENVIRONMENT FEDERATION
W	WATER LEVEL
WM	WATER METER
W/O	WITHOUT
WP	WATERPROOF
WS	WATERSTOP
WS	WATER SURFACE
WSL	WATER SURFACE LEVEL
WT	WEIGHT
WW	WETWELL

X	
x	BY, TIMES

Y	
YH	YARD HYDRANT

- NOTES:**
- FOR EQUIPMENT ABBREVIATIONS, INCLUDING FOR VALVES, REFER TO P&ID LEGEND AND ABBREVIATIONS DRAWINGS FUNCTION CODE ABBREVIATIONS.
 - FOR SYSTEM AND PROCESS STREAM ABBREVIATIONS, REFER TO P&ID LEGEND AND ABBREVIATIONS DRAWINGS SYSTEM CODE AND PROCESS CODE ABBREVIATIONS.
 - FOR PIPE MATERIAL AND INSULATION MATERIAL ABBREVIATIONS REFER TO P&ID LEGEND AND ABBREVIATIONS DRAWINGS PIPELINE MATERIAL CODE AND INSULATION MATERIAL CODE ABBREVIATIONS.



Black & Veatch Corporation
 Chicago, Illinois
 ILLINOIS PROFESSIONAL
 DESIGN FIRM - 184.002143-0006



AEROBIC GRANULAR
 SLUDGE - PHASE 1

REVISIONS AND RECORD OF ISSUE

DESIGNED:	JL
DETAILED:	VP
CHECKED:	AM/JH
APPROVED:	MR
DATE:	12/20/2022

PROJECT NO.: 411752

GENERAL


GENERAL

GENERAL, CIVIL, AND
 PROCESS MECHANICAL
 ABBREVIATIONS

00-G-004

3
 OF
 163

PLOTTED: 12/19/2022 11:26:03 AM
FILE: C:\PW\WORKING\BWV_AMERICAS\0149533\00-G-601.DWG
FDI1000
D11000

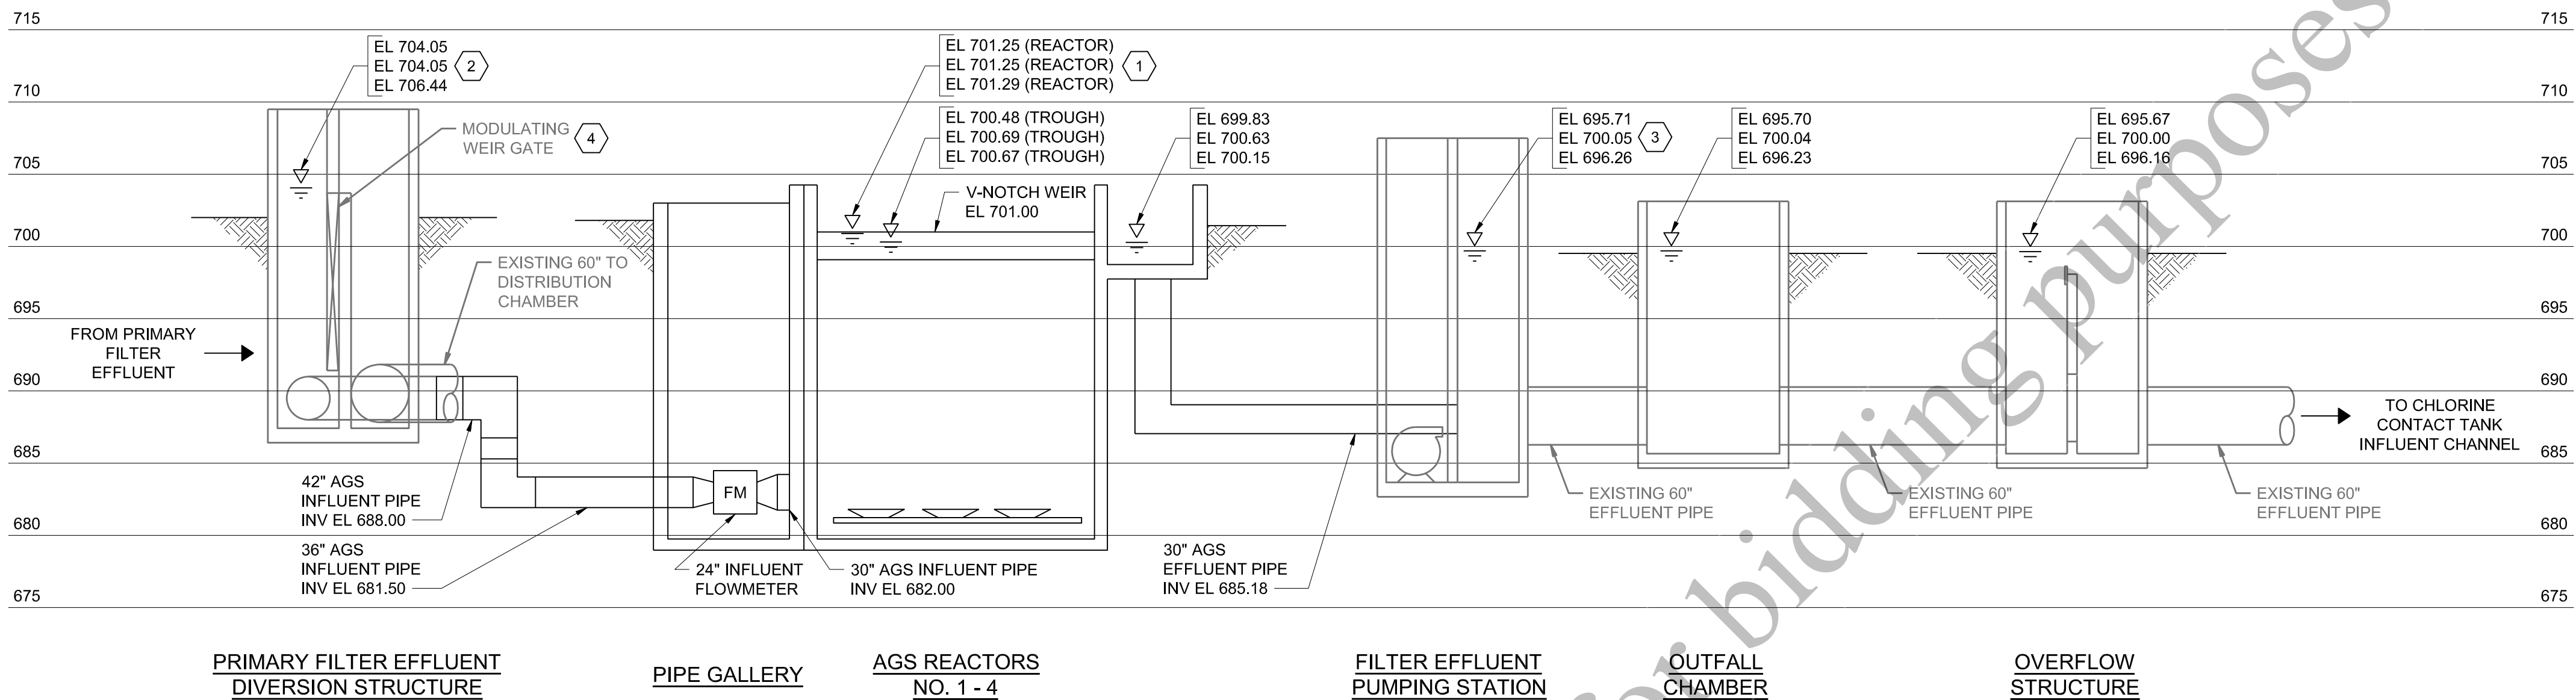

HYDRAULIC PROFILE
VERTICAL SCALE 1/8" = 1'-0"

SHEET KEYNOTES

1. REACTOR WATER ELEVATION CORRESPONDS TO MAXIMUM PROCESS WATER LEVEL OF 21.5 FEET.
2. MAXIMUM WATER ELEVATION AT THE PRIMARY FILTER EFFLUENT DIVERSION STRUCTURE IS 706.50. BASED ON PRELIMINARY DIRECTION FROM THE AGS SYSTEM SUPPLIER AND ESTIMATED AGS EQUIPMENT HEADLOSS, THE MAXIMUM FLOW THROUGH THE AGS FACILITIES IS 15 MGD.
3. 30" AGS EFFLUENT PIPE CONNECTS TO NORTH CHAMBER OF FILTER EFFLUENT PUMP STATION.
4. PRIMARY FILTRATION EFFLUENT CONTROL GATE 2 HAS A MINIMUM WEIR ELEVATION OF 702.00 AND A MAXIMUM WEIR ELEVATION OF 707.50. WEIR GATE WILL MODULATE TO MAINTAIN A DESIRED FLOW RATE TO THE AGS FACILITIES.



Black & Veatch Corporation
Chicago, Illinois
ILLINOIS PROFESSIONAL
DESIGN FIRM - 184.002143 -0006

KEY

DESIGN AVERAGE FLOW: 40 MGD PLANT INFLUENT FLOW, 10 MGD AGS FLOW
SHORT DURATION PEAK FLOW: 115 MGD PLANT INFLUENT FLOW, 10 MGD AGS FLOW
DESIGN MAX FLOW: 80 MGD PLANT INFLUENT FLOW, 15 MGD AGS FLOW



AEROBIC GRANULAR
SLUDGE - PHASE 1

REVISIONS AND RECORD OF ISSUE	
DESIGNED:	JL
DETAILED:	VP
CHECKED:	AM/JH
APPROVED:	MR
DATE:	12/20/2022

PROJECT NO.: 411752

GENERAL

GENERAL

HYDRAULIC PROFILE

00-G-601

4
OF
163



(SCALE BAR IS 4" AT FULL SCALE) 0 1/2 1 2 3 4

GENERAL SHEET NOTES

1. PERSPECTIVE VIEWS ARE FOR GENERAL REFERENCE ONLY AND MAY NOT INCLUDE ALL NECESSARY BUILDING COMPONENTS OR EQUIPMENT REQUIRED. REFER TO OTHER DRAWINGS FOR COMPLETE DETAILED DESIGN.

B&V Design, LLC
Kansas City, Missouri
ILLINOIS PROFESSIONAL
DESIGN FIRM - 184007283



AEROBIC GRANULAR
SLUDGE - PHASE 1

REVISIONS AND RECORD OF ISSUE	
DESIGNED:	RAB
DETAILED:	TMB
CHECKED:	PDR
APPROVED:	PDR
DATE:	12/20/2022
PROJECT NO.:	411752


GENERAL

ARCHITECTURAL


NORTHEAST AND
SOUTHEAST
PERSPECTIVES

00-A-001

6
OF
163

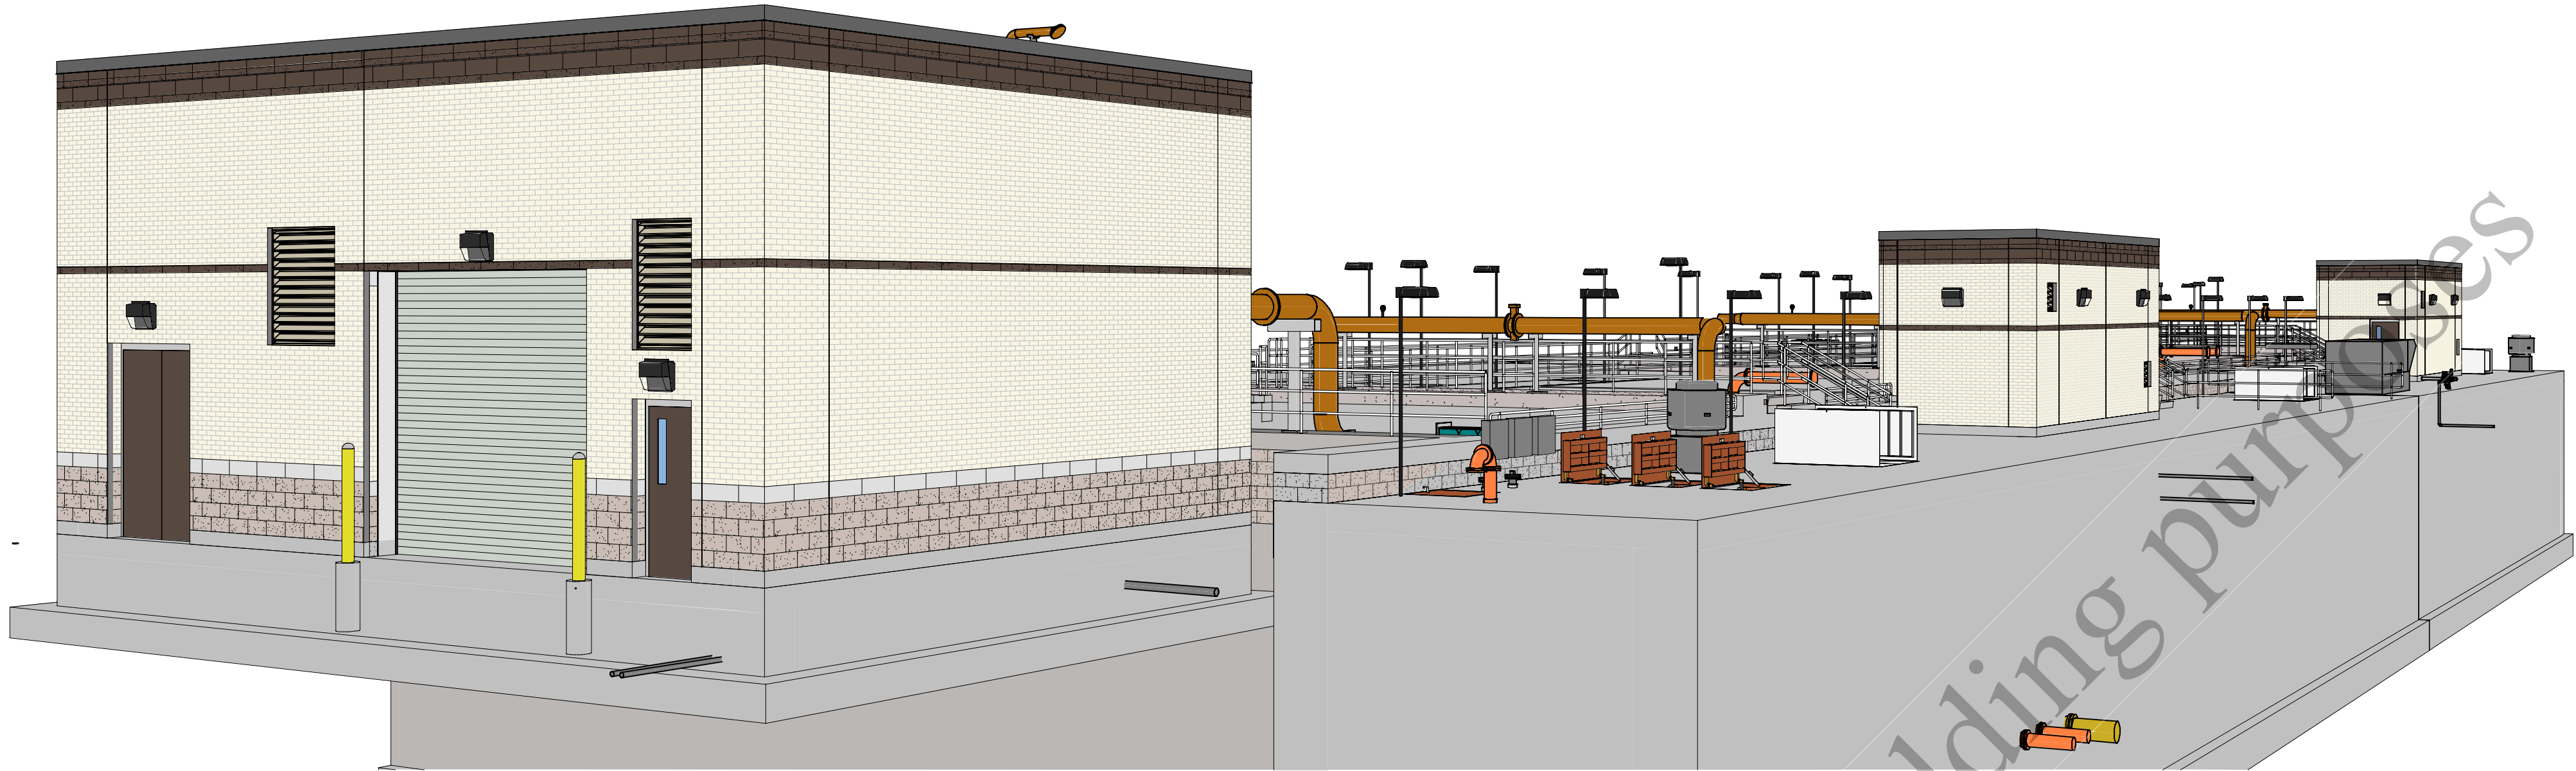

NORTHEAST PERSPECTIVE

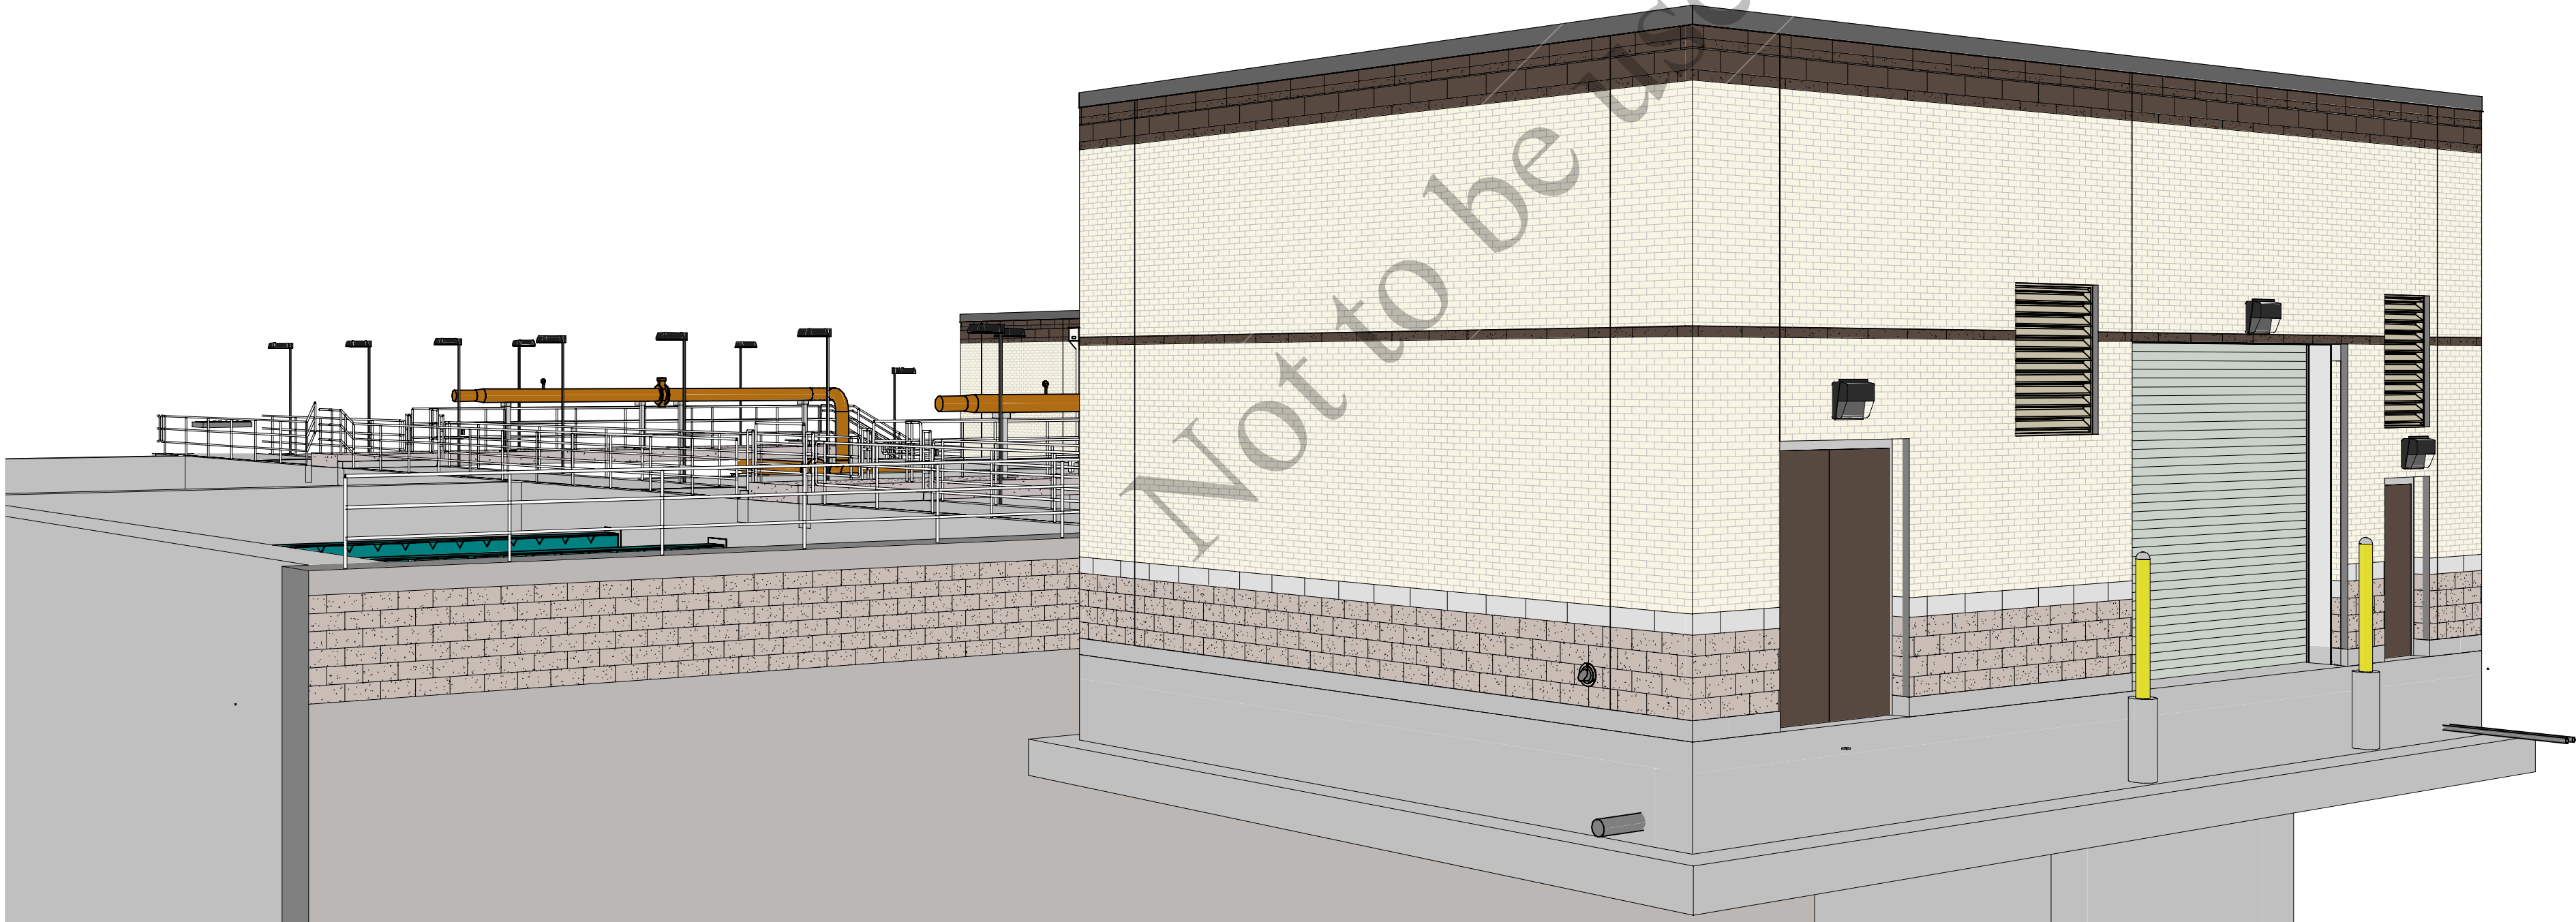

SOUTHEAST PERSPECTIVE

PLOTTED: 12/19/2022 4:25:42 PM
FILE: BIM 360/1409469- Aerobic Granular Sludge Phase 1409469 - AGS.rvt
D11000

STRUCTURAL NOTES

GENERAL

1. THE APPLICABLE BUILDING CODE IS INDICATED ON THE LOADING CRITERIA DRAWING.
2. THE REQUIREMENTS INDICATED ON THIS SHEET ARE INTENDED AS A BASIC SUMMARY OF THE MATERIAL AND CONSTRUCTION REQUIREMENTS FOR THE PROJECT. ADDITIONAL, MORE STRINGENT REQUIREMENTS ARE GIVEN IN THE PROJECT DETAIL DRAWINGS AND SPECIFICATIONS.
3. ALL STRUCTURAL RELATED SHOP DRAWINGS SHALL BE REVIEWED BY THE ENGINEER PRIOR TO CONSTRUCTION.
4. STRUCTURES MAY BE BUOYANT WHEN EMPTY DURING CONSTRUCTION. CONTRACTOR SHALL PROTECT STRUCTURES AGAINST FLOTATION UNTIL CONSTRUCTION IS COMPLETE.
5. STRUCTURES MAY BE UNSTABLE UNTIL THEY ARE CONSTRUCTED IN THEIR ENTIRETY. CONTRACTOR IS RESPONSIBLE FOR DESIGNING TEMPORARY STRUCTURAL SUPPORTS TO RESIST WIND LOADS, CONSTRUCTION LOADS, AND ANY OTHER TEMPORARY CONDITIONS THAT MAY OCCUR DURING CONSTRUCTION, IN ORDER TO MAINTAIN STABILITY OF THE CONSTRUCTION WORK. ANCHORS FOR CONTRACTOR'S TEMPORARY SUPPORT SYSTEMS THAT ATTACH TO CONCRETE OR MASONRY SHALL BE LOCATED TO AVOID DAMAGING EMBEDDED REINFORCEMENT OR UTILITIES.
6. PIPE/ CABLES AND DUCT PENETRATIONS NOT SHOWN ON STRUCTURAL DRAWINGS. CONTRACTOR SHALL COORDINATE WALL AND SLAB PENETRATIONS WITH MECHANICAL, ELECTRICAL, HVAC, PLUMBING AND INSTRUMENTATION DRAWINGS.

CAST-IN-PLACE CONCRETE

1. A MINIMUM 28 DAY COMPRESSIVE STRENGTH (f_c) OF 4,000 PSI WAS UTILIZED IN THE DESIGN OF STRUCTURAL REINFORCED CONCRETE. SEE SPECIFICATIONS FOR CONSTRUCTION STRENGTH REQUIREMENTS.
2. THE LOCATION OF ALL CONSTRUCTION JOINTS AND OTHER TYPES OF JOINTS, OTHER THAN THOSE SPECIFIED OR SHOWN ON THE PLANS, SHALL BE ACCEPTABLE TO THE ENGINEER PRIOR TO PLACING CONCRETE.

REINFORCING STEEL

1. ALL REINFORCING BAR SHALL BE GRADE 60, DEFORMED, ASTM A615, UNLESS NOTED OTHERWISE.
2. DIMENSIONS TO REINFORCING BARS ARE TO BAR CENTERLINES, UNLESS NOTED OTHERWISE. BAR COVER IS THE CLEAR DISTANCE BETWEEN THE BAR AND THE CONCRETE SURFACE.
3. NO WELDING OF REINFORCING BARS SHALL BE PERMITTED UNLESS APPROVAL IS OBTAINED FROM THE ENGINEER PRIOR TO CONSTRUCTION.
4. FOR CONCRETE SLABS THAT HAVE A SLOPING TOP FACE, THE TOP LAYERS OF REINFORCEMENT SHALL BE PLACED ON A SIMILAR SLOPE SO THAT SPECIFIED COVER IS MAINTAINED.

POST-INSTALLED ANCHORS

1. POST-INSTALLED ANCHORS SHALL INCLUDE ADHESIVE ANCHORS (THREADED RODS, BOLTS OR REINFORCING BARS), EXPANSION ANCHORS, AND UNDERCUT ANCHORS INSTALLED INTO HARDENED CONCRETE OR MASONRY. SEE THE ANCHORAGE IN CONCRETE AND MASONRY SPECIFICATION SECTION FOR ADDITIONAL REQUIREMENTS.
2. POST-INSTALLED ANCHORS SHALL ONLY BE USED WHERE INDICATED ON THE DRAWINGS. CONTRACTOR SHALL OBTAIN APPROVAL FROM ENGINEER PRIOR TO USING POST-INSTALLED ANCHORS FOR MISSING OR MISPLACED CAST-IN-PLACE ANCHORS.
3. CARE SHALL BE TAKEN TO AVOID CONFLICTS WITH EXISTING REINFORCING STEEL AND OTHER EMBEDDED ITEMS WHEN DRILLING HOLES. REINFORCING BARS SHALL NOT BE DAMAGED DURING DRILLING OR ANCHOR INSTALLATION. HOLES SHALL BE DRILLED AND CLEANED PER THE PRODUCT MANUFACTURER'S INSTRUCTIONS. ANCHORS SHALL BE INSTALLED PER THE PRODUCT MANUFACTURER'S INSTRUCTIONS AT NOT LESS THAN MINIMUM EDGE DISTANCES AND/OR SPACING INDICATED IN THE MANUFACTURER'S LITERATURE.
4. SUBSTITUTION REQUESTS FOR PRODUCTS OTHER THAN THOSE LISTED IN THE SPECIFICATION OR INDICATED ON THE DRAWINGS SHALL BE SUBMITTED TO ENGINEER FOR REVIEW AND APPROVAL. PRODUCT ICC-ESR EVALUATION REPORTS SHALL BE INCLUDED WITH THE SUBMITTAL PACKAGE. IF REQUESTED, CALCULATIONS PREPARED BY A REGISTERED PROFESSIONAL ENGINEER USING METHODS AND PROCEDURES REQUIRED BY THE BUILDING CODE MAY BE REQUIRED AS PART OF THE SUBMITTAL PACKAGE.
5. UNLESS NOTED OTHERWISE, THE MINIMUM EMBEDMENT PROVIDED FOR ADHESIVE ANCHORED REINFORCING BARS SHALL DEVELOP THE FULL TENSILE STRENGTH OF THE BAR.
6. SPECIAL INSPECTION WILL BE PROVIDED FOR ALL POST-INSTALLED ANCHORS.

STAINLESS STEEL

1. STAINLESS STEEL BOLTS SHALL CONFORM TO ASTM F593, ALLOY GROUP 1 OR 2, UNLESS NOTED OTHERWISE. MINIMUM YIELD STRENGTH SHALL BE 45 KSI.
2. STAINLESS STEEL PLATES SHALL CONFORM TO ASTM A240, TYPE 316L.
3. STAINLESS STEEL STRUCTURAL SHAPES SHALL CONFORM TO ASTM A1069 OR ASTM A276, TYPE 316L.

ALUMINUM

1. UNLESS NOTED OTHERWISE, ALUMINUM ALLOY IN ALL ALUMINUM STRUCTURAL MATERIALS SHALL BE 6061-T6. PIPE AND TUBING FOR GUARDRAIL AND HANDRAIL SHALL BE ALLOY 6061-T6 OR 6005A-T61.
2. ALL ALUMINUM SURFACES IN CONTACT WITH CONCRETE OR DISSIMILAR METALS SHALL BE COATED OR COVERED WITH A HEAVY COAT OF BITUMINOUS PAINT TO PREVENT ALUMINUM-CONCRETE REACTION OR ELECTROLYTIC ACTION.

MASONRY


1. CONCRETE MASONRY UNITS SHALL CONFORM TO ASTM C90. THE TOTAL MASONRY ASSEMBLAGE SHALL HAVE A COMPRESSIVE STRENGTH EQUAL TO 2500 PSI AT 28 DAYS.
2. MASONRY MORTAR SHALL CONFORM TO ASTM C270, TYPE S.
3. ALL BOND BEAMS AND ANY BLOCK CELLS CONTAINING REINFORCING STEEL, ANCHORS OR OTHER EMBEDMENTS SHALL BE FILLED WITH GROUT MEETING THE REQUIREMENTS OF ASTM C476. WALLS SHALL BE FULLY GROUTED WHEN INDICATED ON THE DRAWINGS.
4. BOND BEAM REINF SHALL BE CONTINUOUS AT CORNERS, INTERSECTIONS AND CONTROL JOINTS.

STRUCTURAL STEEL

1. ROLLED WIDE FLANGE SHAPES SHALL HAVE A MINIMUM YIELD STRENGTH OF 50 KSI; CHANNELS, PLATES, AND ANGLES A MINIMUM OF 36 KSI; STRUCTURAL PIPES A MINIMUM OF 35 KSI; ROUND STRUCTURAL TUBES A MINIMUM OF 48 KSI; RECTANGULAR STRUCTURAL TUBES A MINIMUM OF 50 KSI.
2. WELDING SHALL BE DONE WITH A FILLER MATERIAL HAVING A MINIMUM TENSILE STRENGTH OF 70 KSI.
3. BOLTED CONNECTIONS SHALL USE 3/4" DIA ASTM F3125, GRADE A325 BOLTS OR GRADE F1852 TWIST-OFF BOLTS, WITH THE THREADS EXCLUDED FROM THE SHEAR PLANE, UNLESS NOTED OTHERWISE.
4. CARBON STEEL OR GALVANIZED STEEL ANCHOR RODS AND ANCHOR BOLTS SHALL CONFORM TO ASTM F1554 GRADE 36.
5. HOLES FOR ANCHOR RODS AND ANCHOR BOLTS IN COLUMN BASE PLATES USING ASTM F844 OR F436 FLAT CIRCULAR WASHERS SHALL BE AS FOLLOWS:

BOLTS/RODS 3/4" TO 1" - 5/16" OVERSIZE
BOLTS/RODS 1" TO 2" - 1/2" OVERSIZE
BOLTS/RODS OVER 2" - 1" OVERSIZE

AT THE CONTRACTORS OPTION, OVERSIZE HOLES LARGER THAN THOSE LISTED ABOVE MAY BE USED, PROVIDED THAT 3/8" PLATE WASHERS ARE USED WITH STANDARD HOLES AND FIELD WELDED WITH A 5/16" FILLET WELD TO THE BASE PLATE ALONG A MIN OF 3 SIDES.

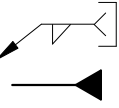6. STEEL LEGEND
 INDICATES ANGLE OR PLATE TO BE WELDED ON THREE SIDES
INDICATES MOMENT CONNECTION

EXCAVATION, BACKFILL, AND FOUNDATIONS

1. FOUNDATION CONSTRUCTION SHALL NOT BEGIN UNTIL ANY REQUIRED SPECIAL INSPECTION HAS BEEN COMPLETED AND THE CONTRACTOR NOTIFIED TO PROCEED.
2. TO FACILITATE SCHEDULING, AT LEAST 48 HOURS ADVANCE NOTICE SHALL BE GIVEN TO THE ENGINEER PRIOR TO THE REQUIRED INSPECTIONS.
3. UNLESS NOTED OTHERWISE, BACKFILL SHALL NOT BE PLACED AGAINST WALLS WHICH SUPPORT A CONCRETE SLAB OR WALKWAY UNTIL THE TOP SLAB OR WALKWAY HAS BEEN PLACED IN ITS ENTIRETY AND ALL CONCRETE HAS REACHED THE SPECIFIED DESIGN STRENGTH.
4. OVER-EXCAVATION OF SOIL, OR OVER-BREAKING OF ROCK, THAT WOULD RESULT IN A STRUCTURAL CONCRETE THICKNESS GREATER THAN INDICATED ON THE DRAWINGS SHALL BE CLASSIFIED AS UNAUTHORIZED EXCAVATION. CONTRACTOR SHALL SELECT ONE OF TWO METHODS TO ADDRESS UNAUTHORIZED EXCAVATION.
 - REPLACE UNAUTHORIZED EXCAVATION MATERIAL WITH LEAN CONCRETE THAT IS PLACED SEPARATELY FROM THE STRUCTURAL CONCRETE INDICATED ON THE DRAWINGS. CONTRACTOR WILL RECEIVE NO ADDITIONAL PAYMENT FOR THE LEAN CONCRETE.
 - REPLACE UNAUTHORIZED EXCAVATION MATERIAL WITH STRUCTURAL CONCRETE THAT IS PLACED MONOLITHICALLY WITH THE STRUCTURAL CONCRETE INDICATED ON THE DRAWINGS. CREATING AN ENLARGED SECTION. CONTRACTOR SHALL NOTIFY ENGINEER FOR DIRECTION PRIOR TO PERFORMING THIS WORK. THE INCREASED CONCRETE THICKNESS MAY REQUIRE ADDITIONAL REINFORCEMENT AND/OR OTHER DESIGN MODIFICATIONS. IF THE INCREASED CONCRETE THICKNESS EXCEEDS 36 INCHES, ENGINEER MAY REQUIRE CONTRACTOR TO IMPLEMENT MASS CONCRETE HEAT MITIGATION PROCEDURES. CONTRACTOR WILL RECEIVE NO ADDITIONAL PAYMENT FOR EXTRA STRUCTURAL CONCRETE, ADDITIONAL REINFORCEMENT, OTHER DESIGN MODIFICATIONS, OR MASS CONCRETING PROCEDURES.
5. THE FOLLOWING NET ALLOWABLE BEARING PRESSURES WERE UTILIZED IN THE DESIGN OF THE FOUNDATIONS.

SPREAD FOOTINGS.....3000 PSF
FROST DEPTH.....4'-0"
COEFFICIENT AGAINST SLIDING (ULTIMATE).....0.40
6. FOUNDATION DESIGN IS BASED UPON THE INFORMATION AND RECOMMENDATION INCLUDED IN THE FINAL GEOTECHNICAL ENGINEERING REPORT - DATED OCTOBER 27, 2022 BY GEOCON PROFESSIONAL SERVICES, 9370 W LARAWAY Rd, FRANKFORT, IL 60423, GEOCON PROJECT NO. 21-G801.

EXISTING STRUCTURES

1. THE DRAWINGS DEPICT WORK AT EXISTING STRUCTURES. ALL DIMENSIONS AND ALL DEPICTIONS SHALL BE FIELD VERIFIED BY THE CONTRACTOR PRIOR TO ORDERING MATERIALS, STARTING FABRICATION, OR STARTING CONSTRUCTION.
2. THE CONTRACTOR SHALL BE RESPONSIBLE FOR ANY DAMAGE, REPAIRS OR STRUCTURAL MODIFICATIONS THAT ARE REQUIRED DUE TO DEMOLITION BEYOND THE LIMITS IDENTIFIED IN THE DRAWINGS.
3. REINFORCEMENT FOR ANY EXISTING CONCRETE OR MASONRY ELEMENT SHALL NOT BE DAMAGED UNLESS THE ELEMENT IS TO BE DEMOLISHED. WHEN LOCATING EXISTING REINFORCEMENT IS REQUIRED, IT SHALL BE LOCATED USING NON-DESTRUCTIVE METHODS. REINFORCING STRANDS IN EXISTING PRESTRESSED CONCRETE SHALL NOT BE CUT UNLESS INDICATED ON THE DRAWINGS OR OTHERWISE AUTHORIZED BY THE ENGINEER. THE CONTRACTOR SHALL BE RESPONSIBLE FOR ANY DAMAGE, REPAIRS OR STRUCTURAL MODIFICATIONS THAT ARE REQUIRED DUE TO DAMAGE OF CONCRETE, MASONRY OR REINFORCEMENT THAT HAS BEEN IDENTIFIED ON THE DRAWINGS TO REQUIRE FIELD VERIFICATION.
4. CORE DRILLING AND SAW CUTTING SHALL NOT BE PERFORMED UNLESS INDICATED ON THE DRAWINGS OR APPROVED BY ENGINEER.
5. EXPOSED CONCRETE SURFACES THAT REMAIN AFTER DEMOLITION SHALL BE REPAIRED TO MATCH ADJACENT CONCRETE SURFACES.
6. UNLESS OTHERWISE INDICATED ON THE DRAWINGS, EXPOSED CONCRETE SURFACES WITH REINFORCEMENT, ANCHOR BOLTS, HANGER RODS, OR OTHER EXPOSED METAL EMBEDMENTS SHALL BE REPAIRED BY CUTTING OFF THE METAL AT THE FACE OF THE CONCRETE, GRINDING SMOOTH, AND COATING. COATING SHALL EXTEND A MINIMUM OF 1" BEYOND THE EDGE OF ANY EXPOSED METAL.

SPECIAL INSPECTIONS

1. CODE REQUIRED SPECIAL INSPECTIONS AND TESTS WILL BE CONDUCTED BY APPROVED AGENCIES EMPLOYED BY THE OWNER IN ACCORDANCE WITH THE APPLICABLE BUILDING CODE.
2. THE STATEMENT OF SPECIAL INSPECTIONS WILL BE PREPARED BY THE REGISTERED DESIGN PROFESSIONAL IN RESPONSIBLE CHARGE DURING CONSTRUCTION.
3. SEE THE QUALITY CONTROL SECTION AND THE CODE REQUIRED SPECIAL INSPECTIONS AND PROCEDURES SECTION OF THE SPECIFICATIONS FOR FURTHER CLARIFICATION OF RESPONSIBILITIES.

DELEGATED DESIGN

1. THE FOLLOWING ITEMS ARE IDENTIFIED IN THE DRAWINGS AND SPECIFICATIONS AS BEING DESIGNED AND SEALED BY OTHERS IN ACCORDANCE WITH SPECIFICATIONS. SUBMITTALS FOR THESE ITEMS SHALL BE PREPARED BY THE SUPPLIERS AND SUBMITTED TO ENGINEER AND CODE OFFICIAL FOR REVIEW.

SPECIFICATION SECTION 01 61 00	- EQUIPMENT AND NON-STRUCTURAL COMPONENTS.
SPECIFICATION SECTION 05 52 13	- METAL RAILINGS.
SPECIFICATION SECTION 05 81 00	- EQUIPMENT ANCHORAGE.
SHEET 99-S-506	- STEEL PAN STAIRS.
SPECIFICATION SECTION 40 05 07	- PIPE SUPPORTS FOR 12" AND SMALLER DIAMETER PIPES
SPECIFICATION SECTION 05 50 00	- METAL LADDERS.
SPECIFICATION SECTION 05 31 00	- STEEL DECKING.
SPECIFICATION SECTION 05 53 13	- METAL GRATINGS.
SPECIFICATION SECTION 03 41 00	- PRECAST STRUCTURAL CONCRETE.
SPECIFICATION SECTION 28 05 11	- CABLE TRAY & SUPPORTS.
SPECIFICATION SECTION 05 50 00	- STEEL CROSS OVER STAIRS.
& 05 50 13	



Black & Veatch Corporation
Chicago, Illinois
ILLINOIS PROFESSIONAL
DESIGN FIRM - 184.002143-0006



AEROBIC GRANULAR
SLUDGE - PHASE 1

REVISIONS AND RECORD OF ISSUE

DESIGNED:	SKA
DETAILED:	UBS
CHECKED:	CG
APPROVED:	TNG
DATE:	12/20/2022

PROJECT NO.: 411752

GENERAL

STRUCTURAL

GENERAL NOTES

00-S-001

7
OF
163

(SCALE BAR IS 4" AT FULL SCALE) 0 1/2 1 2 3 4

STRUCTURAL ABBREVIATIONS

--	--	

BASIC LOADING CRITERIA

THE APPLICABLE BUILDING CODE IS THE 2015 INTERNATIONAL BUILDING CODE (IBC), WITH CITY OF ROCKFORD AMENDMENTS

1. DEAD LOAD CALCULATED
2. LIVE LOADS:

OPERATING AND PROCESS FLOORS..... 150 PSF

STAIRS, SERVICE PLATFORMS & LANDINGS..... 100 PSF

ELECTRICAL AND CONTROL ROOM FLOORS..... 250 PSF

CHEMICAL STORAGE ROOMS..... 250 PSF

STORAGE..... 250 PSF

ALL FLOORS NOT INDICATED..... 100 PSF

ROOF..... 20 PSF(UNREDUCED)
3. LATERAL EARTH PRESSURE (EQUIVALENT FLUID PRESSURE)

NON-SATURATED..... 60 PSF/FT

SATURATED..... 94 PSF/FT

EARTH PRESSURE COEFFICIENTS

EARTH PRESSURE COEFFICIENTS EARTH PRESSURE CONDITIONS	COEFFICIENT FOR BACKFILL TYPE	EQUIVALENT FLUID DENSITY (pcf)		SURCHARGE PRESSURE, p1 (psf)	EARTH PRESSURE, p2 (psf)
		DRAINED	UNDRAINED		
AT-REST (K ₀)	GRANULAR - 0.50	60	94	(0.50) S	(60)H
ACTIVE (K _a)	GRANULAR - 0.33	40	94	(0.33) S	(40)H
PASSIVE (K _p)	GRANULAR - 3.0	360	--	--	(360)H
	COHESIVE - 2.4	290	--	--	(290)H

4. LATERAL SURCHARGE..... EQUIVALENT TO 2 FEET OF SOIL WHERE ADJACENT TO A ROADWAY
5. COMPACTIVE SURCHARGE LOAD..... 400 PSF AT FINISH GRADE ELEVATION DECREASING LINEARLY AT SAME RATE AS BACKFILL LOAD INCREASES. FOR WALLS 8 FEET OR LESS IN HEIGHT, USE CRITERIA 4 ABOVE AS COMPACTIVE SURCHARGE.
6. HYDROSTATIC FLUID PRESSURE..... 63 PSF/FT
7. SNOW LOAD:

GROUND SNOW LOAD (P_s)..... 30 PSF

SNOW EXPOSURE FACTOR (C_e)..... 1.2
8. SEISMIC LOAD:

MAPPED MCE SHORT PERIOD SPECTRAL RESPONSE ACCELERATION (S_s)..... 0.124g

MAPPED MCE ONE SECOND PERIOD SPECTRAL RESPONSE ACCELERATION (S₁)..... 0.058g

DESIGN SPECTRAL RESPONSE ACCELERATION AT SHORT PERIODS (S_{ps})..... 0.132g

DESIGN SPECTRAL RESPONSE ACCELERATION AT ONE SECOND PERIOD (S_{pl})..... 0.092g


SITE CLASS..... D
9. WIND LOAD:

BASIC (ULTIMATE) DESIGN WIND SPEED..... 120 MPH

ALLOWABLE STRESS (NOMINAL) DESIGN WIND SPEED..... 93 MPH

GROUND ELEVATION FACTOR (K_d)..... 1.0


EXPOSURE..... B
10. DESIGN FLOOD ELEVATION..... EL 697.30 (NAVD 88) (FROM FLOOD INSURANCE RATE MAP 17201C0376E AND 17201C0377E, ZONE X, OUTSIDE OF THE 0.2% AND 1% ANNUAL CHANCE FLOOD HAZARD)
11. DESIGN NORMAL GROUND WATER ELEVATION..... EL 688.00

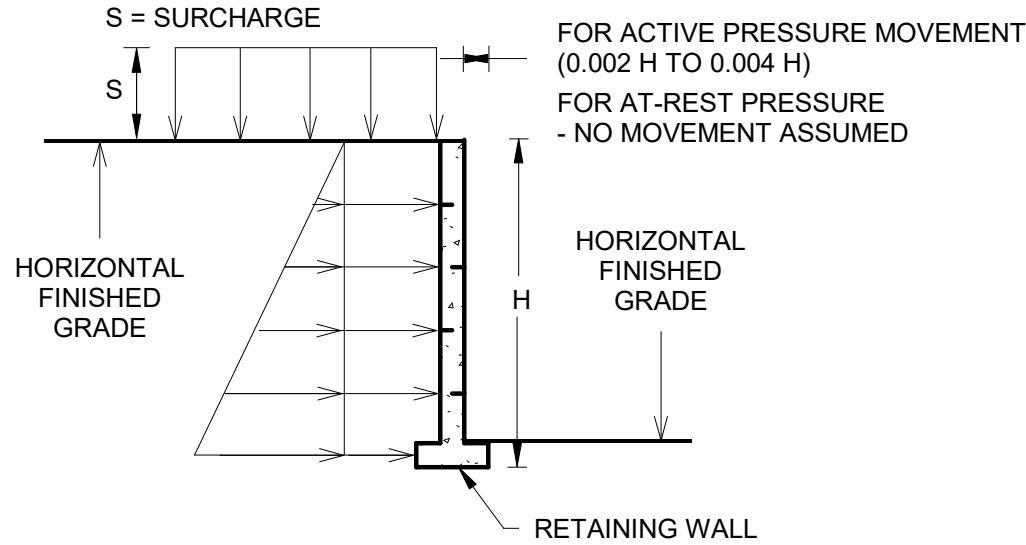

AGS REACTORS STAIR TOWER						
INTERNAL PRESSURE COEFFICIENT.....					±0.55	
DIMENSION "a" FOR WALLS.....					3.00 FT	
DIMENSION "h" FOR ROOF.....					11.17 FT	
ROOF TYPE.....					1	
EFFECTIVE WIND AREA (SQUARE FEET)						
ROOF			<=10	20	50	>=100
INTERIOR ZONE 1 (PSF)	(+)		19	18	17	16
	(-)		-34	-33	-32	-32
EDGE ZONE 2 (PSF)	(+)		19	18	17	16
	(-)		-52	-47	-41	-36
CORNER ZONE 3 (PSF)	(+)		19	18	17	16
	(-)		-73	-62	-47	-36
EFFECTIVE WIND AREA (SQUARE FEET)						
WALL			<=10	20	50	100
INTERIOR ZONE 4 (PSF)	(+)		32	31	29	28
	(-)		-34	-33	-31	-30
EXTERIOR ZONE 5 (PSF)	(+)		32	31	29	28
	(-)		-40	-38	-35	-33

NOTES:

1. a = 0.1 x LEAST HORIZ DIM, OR 0.4xh, WHICHEVER IS SMALLER BUT NOT LESS THAN 0.04 x LEAST HORIZ OR 3'-0".
2. h = EAVE HT.
3. POSITIVE PRESSURES ACT TOWARDS THE SURFACE. NEGATIVE PRESSURES ACT AWAY FROM THE SURFACE.
4. LINEARLY INTERPOLATE PRESSURES FOR EFFECTIVE WIND AREAS BETWEEN THOSE SCHEDULED OR USE PRESSURES FOR THE SMALLER EFFECTIVE WIND AREA.
5. ALL ROOF OVERHANG PRESSURES ACT UPWARD.
6. SOFFITS BELOW ROOF OVERHANGS ARE DESIGNED FOR THE PRESSURE ON THE WALL BELOW THE SOFFIT.
7. PARAPET PRESSURES ARE THE TOTAL OF THE WINDWARD AND LEEWARD PARAPET FACE VALUES.
8. PRESSURES MENTIONED IN THE ABOVE TABLE ARE AT STRENGTH LEVEL.
9. PRESSURES MENTIONED IN THE ABOVE TABLE INCLUDE INTERNAL PRESSURE COEFFICIENT.
10. NET WIND PRESSURE OF 54 PSF IS APPLICABLE ON HVAC/EQUIPMENTS ON ROOF TOP.
11. NET WIND PRESSURE OF 106 PSF IS APPLICABLE FOR PARAPET WALL DESIGN.

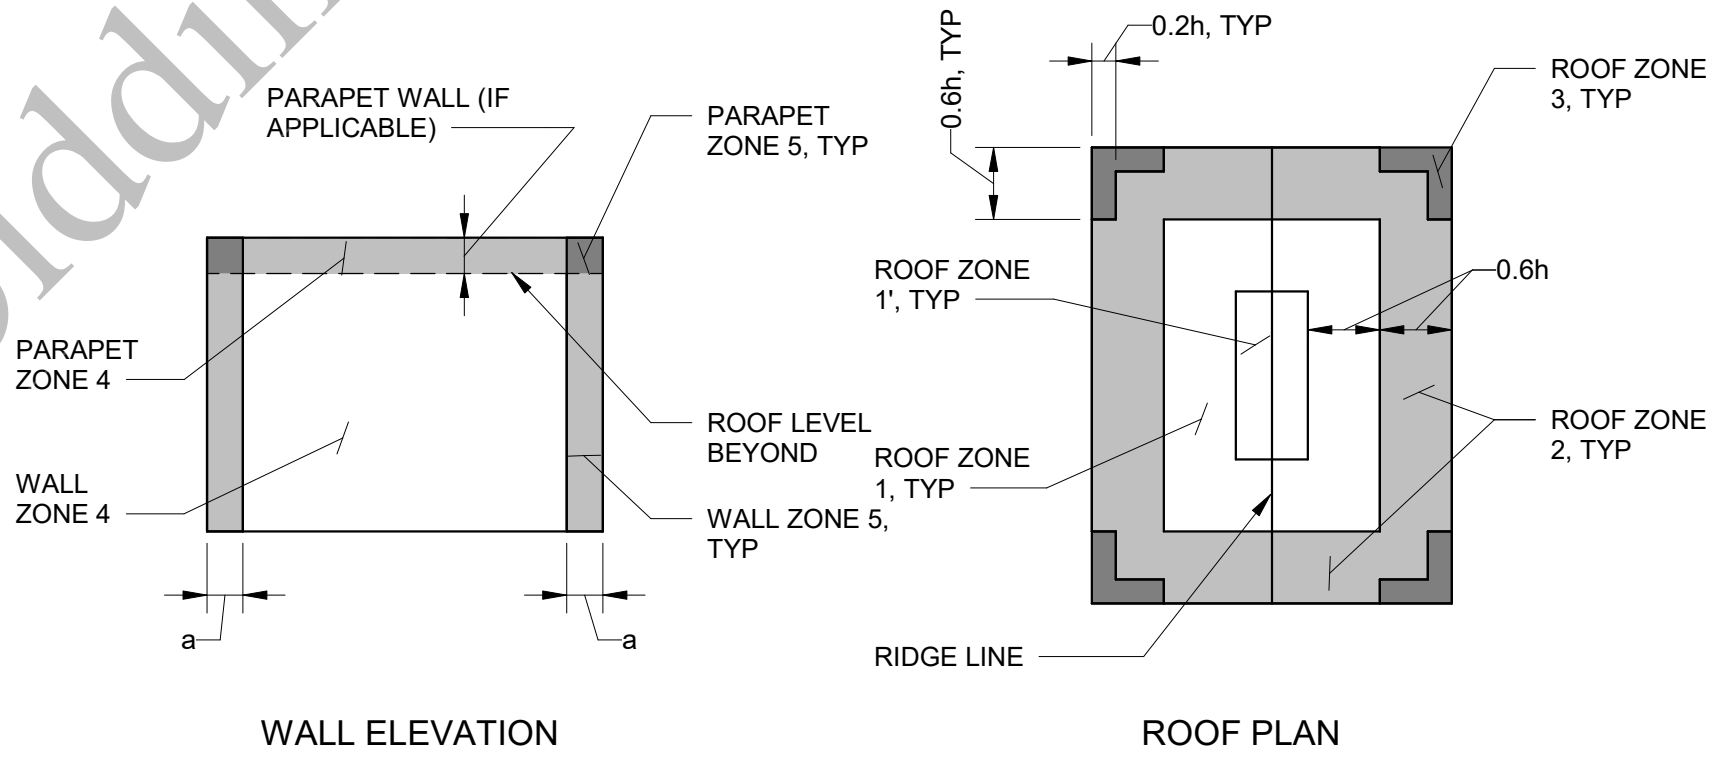

WIND ZONE DIAGRAMS

SNOW AND SEISMIC LOADING CRITERIA FOR BUILDINGS	AGS REACTORS PIPE GALLERY SLAB	AGS REACTORS STAIR TOWER	AGS SUPPORT FACILITY
RISK CATEGORY	III	III	III
FLAT-ROOF SNOW LOAD (P _f), PSF	34	34	34
SNOW DRIFT SURCHARGE LOAD (P _d), PSF	57	27.4	33.3
SNOW DRIFT WIDTH (W), FEET	12.75	33.3	7.45
SNOW IMPORTANCE FACTOR (I _s)	1.1	1.1	1.1
THERMAL FACTOR (C _t)	1.2	1.2	1.2
SEISMIC IMPORTANCE FACTOR	1.25	1.25	1.25
SEISMIC DESIGN CATEGORY	B	B	B
BASIC LATERAL FORCE RESISTING SYSTEM	CONCRETE SHEAR WALL	ORDINARY REINFORCED CMU WALL	ORDINARY REINFORCED CMU WALL
STRENGTH DESIGN BASE SHEAR, KIPS	-	13	65
SEISMIC RESPONSE COEFFICIENT (C _s)	-	0.083	0.083
RESPONSE MODIFICATION FACTOR (R)	-	2	2
SEISMIC ANALYSIS PROCEDURE	EQUIVALENT STATIC ANALYSIS	EQUIVALENT STATIC ANALYSIS	EQUIVALENT STATIC ANALYSIS

AGS SUPPORT FACILITY

INTERNAL PRESSURE COEFFICIENT.....					±0.55		
DIMENSION "a" FOR WALLS.....					3.00 FT		
DIMENSION "h" FOR ROOF.....					17.83 FT		
ROOF TYPE.....					1		
EFFECTIVE WIND AREA (SQUARE FEET)							
ROOF			<=10	20	50	>=100	
INTERIOR ZONE 1 (PSF)	(+)		24	23	22	21	
	(-)		-43	-42	-41	-40	
EDGE ZONE 2 (PSF)	(+)		40	39	37	36	
	(-)		-66	-60	-52	-46	
CORNER ZONE 3 (PSF)	(+)		40	39	37	36	
	(-)		-66	-60	-52	-46	
EFFECTIVE WIND AREA (SQUARE FEET)							
WALL			<=10	20	50	100	>=500
INTERIOR ZONE 4 (PSF)	(+)		40	39	37	36	33
	(-)		-43	-42	-40	-39	-35
EXTERIOR ZONE 5 (PSF)	(+)		40	39	37	36	33
	(-)		-51	-48	-44	-42	-35



Black & Veatch Corporation
Chicago, Illinois
ILLINOIS PROFESSIONAL
DESIGN FIRM - 184.002143-0006



AEROBIC GRANULAR
SLUDGE - PHASE 1

REVISIONS AND RECORD OF ISSUE	
DESIGNED:	SKA
DETAILED:	UBS
CHECKED:	CG
APPROVED:	TNG
DATE:	12/20/2022
PROJECT NO.:	411752

GENERAL

STRUCTURAL

LOADING CRITERIA

00-S-003

9
OF
163

(SCALE BAR IS 4" AT FULL SCALE) 0 1/2 1 2 3 4

(SCALE BAR IS 4" AT FULL SCALE) 0 1/2 1 2 3 4

ONE-LINE DIAGRAM LEGEND	SCHEMATIC SYMBOLS		BREAKER DETAILS	COMMUNICATION SYMBOLS
<div><div></div><div>TRANSFORMER WITH PRIMARY AND SECONDARY VOLTAGE, AND KVA RATING AS NOTED</div></div> <div><div></div><div>CIRCUIT NO.22 WITH 3#8 INSULATED CONDUCTORS AND 1#10 GROUND WIRE FOR A 20HP MOTOR WITH 3 POLE, 60A, MOTOR DISCONNECT SWITCH AND 4#14 INSULATED CONDUCTORS FOR AUXILIARY ITEM, AS FOR EXAMPLE A CONTROL STATION, ALL IN 2" CONDUIT.</div></div> <div><div></div><div>AUXILIARY ITEMS MAY NOT BE COMPLETELY SHOWN</div><div></div><div>CONDUCTORS FOR AUXILIARY ITEM SHALL NOT PASS THROUGH MOTOR DISCONNECT SWITCH.</div></div> <div><div></div><div>ONE-LINE SHOWING POWER AND CONTROL TO A PACKAGE UNIT, AS FOR EXAMPLE A STEAM GENERATOR OR AN AIR HANDLING UNIT, SHALL IMPLY THAT ANY AND ALL ASSOCIATED EQUIPMENT SHALL ALSO BE INSTALLED AND WIRED AS REQUIRED BY THE EQUIPMENT FURNISHED.</div></div> <div><div></div><div>INDICATES THAT ALL OR PART OF CIRCUIT MAY BE ROUTED IN DUCT BANK OR UNDERGROUND. CONDUIT SIZE SHOWN ON ONE-LINE IS ABOVE GROUND AND/OR INSIDE OF STRUCTURE. SEE DUCT BANK SCHEDULE AND SECTIONS FOR CONDUIT SIZE OF UNDERGROUND PORTION OF CIRCUIT.</div></div> <div><div></div><div>HIGH VOLTAGE DRAWOUT AIR OR VACUUM CIRCUIT BREAKER</div></div> <div><div></div><div>LOW VOLTAGE AIR CIRCUIT BREAKER, 3 POLE, 20 AMPERE</div></div> <div><div></div><div>SIZE 4 COMBINATION MAGNETIC MOTOR STARTER</div></div> <div><div></div><div>LOW VOLTAGE DRAWOUT AIR CIRCUIT BREAKER</div></div> <div><div></div><div>HIGH VOLTAGE DRAWOUT CONTACTOR</div></div> <div><div></div><div>FUSE AND DISCONNECT SWITCH</div></div> <div><div></div><div>SIZE 2 COMBINATION MAGNETIC MOTOR STARTER, REVERSING OR 2 SPEED</div></div> <div><div></div><div>SIZE 1 COMBINATION REDUCED VOLTAGE AUTOTRANSFORMER</div></div> <div><div></div><div>POTENTIAL TRANSFORMER</div></div> <div><div></div><div>CURRENT TRANSFORMER</div></div> <div><div></div><div>CURRENT OR POTENTIAL TEST SWITCH</div></div> <div><div></div><div>GENERATOR</div></div> <div><div></div><div>KIRK KEY INTERLOCK</div></div> <div><div></div><div>ELECTRICAL INTERLOCK</div></div> <div><div></div><div>RESISTOR</div></div> <div><div></div><div>PROTECTION RELAY WITH IEEE DEVICE FUNCTION AS SHOWN</div></div> <div><div></div><div>SINGLE-FUNCTION METER</div></div> <div><div></div><div>SURGE OR LIGHTNING ARRESTER</div></div> <div><div></div><div>SURGE ARRESTER WITH SURGE CAPACITOR</div></div> <div><div></div><div>GROUND CONNECTION</div></div>	<div><div><ul style="list-style-type: none">WIRE CONNECTION POINTEXTERNAL CONNECTION POINTNORMALLY OPEN CONTACTNORMALLY CLOSED CONTACTSTARTER, CONTACTOR OR RELAY COILNORMALLY OPEN PUSH BUTTONNORMALLY CLOSED PUSH BUTTONMAINTAINED PUSH BUTTONNORMALLY CLOSED GEARED LIMIT SWITCHNORMALLY OPEN GEARED LIMIT SWITCHINDICATING LIGHTFUSEPOTENTIOMETERCAPACITORDIODERESISTORCONTROL POWER TRANSFORMERSWITCHMANUAL STARTEROVERLOADOVERLOADELECTRODEFLOAT SWITCH (CLOSING ON RISING LEVEL)FLOAT SWITCH (OPENING ON RISING LEVEL)PRESSURE SWITCH (CLOSING ON RISING PRESSURE)PRESSURE SWITCH (OPENING ON RISING PRESSURE)</div><div><div></div><div>VACUUM SWITCH (CLOSING ON INCREASING VACUUM)</div></div><div><div></div><div>VACUUM SWITCH (OPENING ON INCREASING VACUUM)</div></div><div><div></div><div>TEMPERATURE SWITCH (CLOSING ON RISING TEMPERATURE)</div></div><div><div></div><div>TEMPERATURE SWITCH (OPENING ON RISING TEMPERATURE)</div></div><div><div></div><div>FLOW ACTUATED SWITCH (CLOSING ON INCREASE IN FLOW)</div></div><div><div></div><div>FLOW ACTUATED SWITCH (OPENING ON INCREASE IN FLOW)</div></div><div><div></div><div>ON TIME DELAY CONTACT (NORMALLY OPEN, WHEN THE COIL IS ENERGIZED THE CONTACT WILL CLOSE AFTER A TIME DELAY)</div></div><div><div></div><div>ON TIME DELAY CONTACT (NORMALLY CLOSED, WHEN THE COIL IS ENERGIZED THE CONTACT WILL OPEN AFTER A TIME DELAY)</div></div><div><div></div><div>OFF TIME DELAY CONTACT (NORMALLY OPEN, WHEN THE COIL IS DE-ENERGIZED THE CONTACT WILL OPEN AFTER A TIME DELAY)</div></div><div><div></div><div>OFF TIME DELAY CONTACT (NORMALLY CLOSED, WHEN THE COIL IS DE-ENERGIZED THE CONTACT WILL CLOSE AFTER A TIME DELAY)</div></div><div><div></div><div>TORQUE SWITCH (NORMALLY OPEN)</div></div><div><div></div><div>TORQUE SWITCH (NORMALLY CLOSED)</div></div><div><div></div><div>LIMIT SWITCH (NORMALLY OPEN)</div></div><div><div></div><div>LIMIT SWITCH (NORMALLY OPEN, HELD CLOSED)</div></div><div><div></div><div>LIMIT SWITCH (NORMALLY CLOSED)</div></div><div><div></div><div>LIMIT SWITCH (NORMALLY CLOSED, HELD OPEN)</div></div><div><div></div><div>DIFFERENTIAL PRESSURE SWITCH (NORMALLY OPEN, CLOSING ON INCREASING DIFF.)</div></div><div><div></div><div>DIFFERENTIAL PRESSURE SWITCH (NORMALLY CLOSED, OPENING ON INCREASING DIFF.)</div></div></div>	<div><div><div>DETAIL A</div><div><div></div><div>5KV 1200A 49KA</div><div>A 5KV CLASS MEDIUM-VOLTAGE, DRAWOUT, VACUUM OR AIR INSULATED CIRCUIT BREAKER WITH A 1,200 AMPERE FRAME. BREAKER HAS A 49,000 AMPERE MAXIMUM FAULT CURRENT INTERRUPTING RATING.</div></div></div><div><div><div>DETAIL B</div><div><div></div><div>A LOW VOLTAGE FIXED MOUNTED MOLDED CASE CIRCUIT BREAKER WITH A 50 AMPERE TRIP RATING. TRIP UNIT IS NON-ADJUSTABLE THERMAL-MAGNETIC TYPE.</div></div></div><div><div><div>DETAIL C</div><div><div></div><div>800AT 1000AS 1200AF AFRD</div><div>A LOW VOLTAGE, DRAWOUT, POWER OR INSULATED CASE CIRCUIT BREAKER WITH A 1600A FRAME AND SOLID-STATE TRIP UNIT. TRIP UNIT HAS A SENSOR MODULE RATED FOR 1000 AMPERES AND WITH A TRIP RATING OF 800 AMPERES AND ARC-FLASH REDUCTION PROTECTION FEATURES.</div></div></div></div></div></div>	<div><div></div><div>HORN SPEAKER</div><div></div><div>DUAL HORN SPEAKER</div><div></div><div>WALL MOUNTED CONE SPEAKER</div><div></div><div>CEILING MOUNTED CONE SPEAKER</div></div>	
	<div><div><div>SWITCH & OUTLET SYMBOLS</div><div><div><div>S</div><div>SINGLE POLE SWITCH</div></div><div><div>S₂</div><div>TWO POLE SWITCH</div></div><div><div>S_{3A}</div><div>THREE-WAY SWITCH CONTROLLING LIGHTS WITH "A" DESIGNATION</div></div><div><div>S₄</div><div>FOUR-WAY SWITCH</div></div><div><div>S_{C1M}</div><div>MOMENTARY SWITCH CONTROLLING CONTACTOR C1</div></div><div><div>S_{DM A}</div><div>DIMMING WALL SWITCH CONTROLLING LIGHTS WITH "A" DESIGNATION</div></div><div><div>S_{OS A}</div><div>WALL SWITCH WITH OCCUPANCY SENSOR CONTROLLING LIGHTS WITH "A" DESIGNATION</div></div><div><div></div><div>DUPLEX RECEPTACLE 120 VOLT</div></div><div><div></div><div>SIMPLEX RECEPTACLE</div></div><div><div></div><div>RANGE RECEPTACLE</div></div><div><div></div><div>TWISTLOCK RECEPTACLE</div></div><div><div></div><div>240V, 1Ø RECEPTACLE, TYPICAL AMPERE RATING NOTED</div></div><div><div></div><div>480V, 3Ø WELDING RECEPTACLE, TYPICAL AMPERE RATING NOTED</div></div><div><div></div><div>120 VOLT DUPLEX RECEPTACLE (UPS)</div></div><div><div></div><div>DUPLEX FLOOR OUTLET</div></div><div><div></div><div>TELEPHONE OUTLET</div></div><div><div></div><div>TELEPHONE FLOOR OUTLET</div></div><div><div></div><div>COAXIAL CABLE OUTLET</div></div><div><div></div><div>DATA NETWORK OUTLET</div></div></div></div><div><div><div>MISCELLANEOUS SYMBOLS</div><div><div></div><div>STROBE</div></div><div><div></div><div>HORN & STROBE</div></div><div><div></div><div>HORN</div></div><div><div></div><div>THERMOSTAT</div></div><div><div></div><div>JUNCTION BOX</div></div><div><div></div><div>GROUND ROD</div></div><div><div></div><div>GROUND ROD WITH TEST WELL</div></div><div><div></div><div>GROUND CONNECTION</div></div><div><div></div><div>DISCONNECT SWITCH</div></div><div><div></div><div>COMBINATION STARTER</div></div><div><div></div><div>POWER PANEL</div></div><div><div></div><div>LIGHTING PANEL</div></div><div><div></div><div>MISCELLANEOUS PANEL</div></div><div><div></div><div>LIGHTING CONTACTOR</div></div><div><div></div><div>CAMERA</div></div><div><div></div><div>PHOTOELECTRIC SENSOR, PHOTOCELL</div></div><div><div></div><div>CEILING MOUNTED OCCUPANCY SENSOR</div></div><div><div></div><div>WALL MOUNTED OCCUPANCY SENSOR</div></div><div><div></div><div>LIGHTNING PROTECTION AIR TERMINAL</div></div></div></div></div>	<div>CONDUIT & WIRING INSTALLATION LEGEND<div><div></div><div>CONDUIT EXPOSED</div></div><div><div></div><div>CONDUIT CONCEALED</div></div><div><div></div><div>CONDUIT TURNING UP, CONDUIT TURNING DOWN.</div></div><div><div></div><div>CONDUIT PLUGGED FLUSH, CONDUIT CAPPED.</div></div><div><div></div><div>TYPICAL FOR HOME RUN TO BE ROUTED TO LIGHTING PANEL L2 & CONNECTED TO CIRCUIT #5 (MINIMUM NO. 12 AWG CONDUCTORS AND 3/4" CONDUIT)</div></div><div><div></div><div>LP1-1 A</div></div><div><div></div><div>LP1-1 A</div></div><div><div></div><div>LP1-1 A</div></div><div><div></div><div>LP1-3</div></div><div><div></div><div>LP1-1 11</div></div><div><div></div><div>LP1-1 EX</div></div><div><div></div><div>LP1-1 EM</div></div><div><div></div><div>UNDERGROUND CONCRETE ENCASED ELECTRICAL DUCT BANK</div></div><div><div></div><div>UNDERGROUND CONCRETE ENCASED ELECTRICAL BANK ROUTED BENEATH SLAB-ON-GRADE</div></div><div><div></div><div>DIRECT BURIED CONDUIT</div></div><div><div></div><div>GROUND CONDUCTOR</div></div><div><div></div><div>UNDERGROUND ELECTRIC</div></div><div><div></div><div>OVERHEAD CIRCUIT</div></div></div> <div><div><div>PROTECTION/RELAY DEVICE NUMBERS</div><div>25 - SYNCHRONIZING OR SYNCHRONISM-CHECK DEVICE 27 - UNDERVOLTAGE RELAY 32 - DIRECTIONAL POWER RELAY 37 - UNDERCURRENT OR UNDERPOWER RELAY 46 - REV. PHASE OR PHASE-BAL. CURRENT RELAY 47 - PHASE SEQ. OR PHASE BAL. VOLTAGE RELAY 49 - MACHINE OR TRANSFORMER THERMAL RELAY 50 - INSTANTANEOUS OVERCURRENT 51 - AC TIME OVERCURRENT RELAY 52 - AC CIRCUIT BREAKER 59 - OVERVOLTAGE RELAY 63 - PRESSURE SWITCH 64 - GROUND DETECTOR RELAY 67 - AC DIRECTIONAL OVERCURRENT RELAY 71 - LIQUID OR GAS LEVEL RELAY 81 - FREQUENCY RELAY 83 - AUTOMATIC SELECTIVE CONTROL OR TRANSFER RELAY 86 - LOCKOUT RELAY 87 - DIFFERENTIAL PROTECTIVE RELAY</div></div></div>		
				<div><div><div>REVISIONS AND RECORD OF ISSUE</div><div><div>DESIGNED: EJB</div><div>DETAILED: SFR</div><div>CHECKED: SDS</div><div>APPROVED: EJB</div><div>DATE: 12/20/2022</div><div>PROJECT NO.: 411752</div></div></div><div><div>GENERAL</div><div>ELECTRICAL</div><div>LEGENDS</div></div><div><div>00-E-001</div><div>13 OF 163</div></div></div>

ELECTRICAL GENERAL NOTES

1. SOLID LINES (—————) INDICATE NEW WORK OR EQUIPMENT.
2. SCREENED LINES (—————) INDICATE EXISTING WORK OR EQUIPMENT.
3. DASHED LINES (- - - - -) INDICATE FUTURE WORK OR EQUIPMENT.
4. REFER TO INDIVIDUAL DISCIPLINE CONTRACT DRAWINGS FOR ADDITIONAL ABBREVIATIONS, DETAILS, AND GENERAL DESIGN NOTES.
5. LEGEND SHEETS ARE GENERAL. SOME SYMBOLS AND ABBREVIATIONS MAY NOT BE UTILIZED ON THIS SPECIFIC PROJECT.
6. INFORMATION RELATED TO CIRCUIT IDENTIFICATION, WIRE & CONDUIT SIZES, AND ROUTING, IS ON THE FOLLOWING DRAWING TYPES.

A. ONE-LINE DIAGRAMS SHOW CIRCUIT IDENTIFICATION, WIRE QUANTITY AND SIZES, AND CONDUIT SIZE WITHIN STRUCTURES. ONE-LINE DIAGRAMS ALSO INDICATE ORIGIN AND DESTINATION OF CIRCUITS, AND IDENTIFY CIRCUITS ROUTED UNDERGROUND.

B. FOR CIRCUITS WITHOUT UNDERGROUND PORTIONS, FACILITY FLOOR PLANS SHOW LOCATION OF EQUIPMENT FOR DETERMINING CIRCUIT LENGTH WITHIN THE STRUCTURE. FOR CIRCUITS WITH UNDERGROUND PORTIONS, ANTICIPATED PENETRATION OF UNDERGROUND CONDUITS ARE SHOWN ON STRUCTURE PLANS FOR DETERMINING THE LENGTH OF THE IN-STRUCTURE PORTIONS OF CIRCUITS. FACILITY FLOOR PLANS MAY ALSO SHOW HOME RUNS FOR LIGHTING, RECEPTACLE, AND OTHER MISCELLANEOUS EQUIPMENT CIRCUITS.

C. SITE PLANS INDICATE THE GENERAL ROUTING OF UNDERGROUND CONDUITS AND DUCT BANKS. CIRCUITS ROUTED IN UNDERGROUND CONDUITS OR DUCT BANKS ARE INDICATED IN DUCT BANK SECTIONS REFERENCED ON THE SITE PLAN.

D. DUCT BANK SECTIONS AND SCHEDULES IDENTIFY CONDUIT SIZE, CONDUIT MATERIAL, ARRANGEMENT OF THE UNDERGROUND CONDUITS, AND CIRCUITS ROUTED IN EACH UNDERGROUND CONDUIT.

AREA DESIGNATIONS

THE SPECIAL AREA DESIGNATION BOXES, AS DEFINED BELOW, ARE LOCATED ON THE PLAN DRAWINGS TO DEFINE ELECTRICAL INSTALLATION REQUIREMENTS. DESIGNATION BOXES ARE LOCATED WITHIN ROOM OR BELOW ROOM NUMBER. ALL INDOOR AREAS NOT INDICATED OTHERWISE ARE AREA TYPE 1 AND MINIMUM NEMA TYPE 1 ENCLOSURES.

AREA TYPE 1A	CORROSIVE CHEMICAL FEED AND STORAGE ROOMS. CONDUIT SYSTEM SHALL BE EXPOSED SCHEDULE 80 PVC RIGID NON-METALLIC CONDUIT WITH PVC FITTINGS, BOXES AND ACCESSORIES.
AREA TYPE 4	INDOOR WET LOCATIONS SUCH AS VAULTS, HOSEDOWN AREAS, BASEMENTS, ETC. MINIMUM NEMA TYPE 4 ENCLOSURE FOR EQUIPMENT AND GASKETED FITTINGS IN A CONDUIT SYSTEM.
AREA TYPE 7A	CLASS I, DIVISION 1 AREA AS DEFINED BY NEC. ALL EQUIPMENT AND CONDUIT SYSTEMS SHALL BE RATED FOR USE IN THIS AREA.
AREA TYPE 7B	CLASS I, DIVISION 2, GROUP C AND D (METHANE, GASOLINE) AS DEFINED BY NEC. EQUIPMENT AND CONDUITS SYSTEMS SHALL BE RATED FOR USE IN THIS AREA.
AREA TYPE 12	INDOOR, DRY, DIRTY AREA. REQUIRES MINIMUM NEMA TYPE 12 GASKETED ENCLOSURES FOR ALL EQUIPMENT AND GASKETED FITTINGS IN CONDUIT SYSTEMS.
AREA TYPE 4X	OUTDOOR, WET, HARSH ENVIRONMENT SUCH AS AREAS IN AND AROUND THE REACTORS, MINIMUM NEMA TYPE 4X ENCLOSURES FOR EQUIPMENT AND GASKETED FITTINGS IN A CONDUIT SYSTEM

GENERAL REQUIREMENTS

1. THE CONTRACTOR SHALL BE RESPONSIBLE FOR ROUTING ALL CONDUITS NOT SHOWN ON THE PLANS. THIS SHALL INCLUDE ALL CONDUITS SHOWN ON THE ONE-LINES AND HOME-RUNS SHOWN ON THE PLAN DRAWINGS. CONDUITS SHALL BE ROUTED AS DEFINED IN THE SPECIFICATIONS.
2. SPARE WIRES SHALL BE TAPED AND COILED AND LABELED TO INDICATE WHERE OTHER END OF SPARE WIRE IS LOCATED.
3. IF EQUIPMENT SUPPLIED BY MANUFACTURER HAS A LARGER LOAD THAN VALUE SHOWN, THE CABLE CONDUIT AND ELECTRICAL EQUIPMENT SHALL BE ENLARGED, AS REQUIRED, TO ACCOMMODATE THE HIGHER VALUE.
4. THE CONTRACTOR SHALL BE RESPONSIBLE FOR FURNISHING PROPERLY SIZED STARTER OVERLOADS FOR EQUIPMENT FURNISHED.
5. LIGHTING AND RECEPTACLE CIRCUITS DESIGNATED ON THE FLOOR PLANS ARE NOT SHOWN ON THE ONE-LINES. CONDUCTORS FOR LIGHTING, RECEPTACLES, AND MISCELLANEOUS 120VAC CIRCUITS SHALL BE MINIMUM NO. 12 AWG. CONDUIT FOR LIGHTING, RECEPTACLES, AND MISCELLANEOUS 120VAC CIRCUITS SHALL BE MINIMUM 3/4".
6. IN AREAS WHERE THERE ARE OVERHEAD BRIDGE CRANES, HOISTS, ETC. NO CONDUITS SHALL BE RUN OVERHEAD THAT WILL INTERFERE WITH THE OPERATION OF THE EQUIPMENT.

ELECTRICAL ABBREVIATIONS

A		I		S	
A	AMBER, AMPERE, ALARM	I/O	INPUT/OUTPUT	S	SHORT-TIME, SHIELDED, STARTER
AC	ALTERNATING CURRENT	I	INSTANTANEOUS	SA	SURGE ARRESTER, SPEAKER AMPLIFIER
ACB	AIR CIRCUIT BREAKER	IJB	INTERCOM JUNCTION BOX	SCADA	SUPERVISORY CONTROL AND DATA ACQUISITION
ACR	ACCESS CARD READER			SF6	SULFUR HEXAFLORIDE
AF	AMPERE FRAME	J		SH	SPACE HEATER
AFD	ADJUSTABLE FREQUENCY DRIVE	J, JB	JUNCTION BOX	SN	SOLID NEUTRAL
AFRD	ARC-FLASH REDUCTION DEVICE			SO	SOLENOID OILER
AM	AMMETER			SP	SINGLE POLE
ANN	ANNUNCIATOR			SPD	SURGE PROTECTION DEVICE
AR	ALARM RELAY			SPDT	SINGLE POLE DOUBLE THROW
AS	AMMETER SWITCH, AMPERE SENSOR	K		SPST	SINGLE POLE SINGLE THROW
AT	AMPERE TRIP	K	KEY INTERLOCK	SS	SELECTOR SWITCH, START/STOP, STAINLESS STEEL
ATS	AUTOMATIC TRANSFER SWITCH	KAIC	THOUSAND AMPERES INTERRUPTING CURRENT	SSM	SOLID-STATE METERING
AUX	AUXILIARY	KCMIL	THOUSAND CIRCULAR MIL	SSS	SOLID STATE STARTER
AWG	AMERICAN WIRE GAUGE	KO	KEY OPERATED	SST	SOLID-STATE TRIP
		KV	KILOVOLT	SUPV	SUPERVISORY CONTROL
B		KVA	KILOVOLT AMPERE	SV	SOLENOID VALVE
B	BUS	KVAR	KILOVAR	SWB,SWBD	SWITCHBOARD
BC	BATTERY CHARGER	KW	KILOWATT	SWG,SWGR	SWITCHGEAR
BKR	BREAKER	KWH	KILOWATT HOUR		
BR	BRAKE			I	
BT	BEARING TEMPERATURE	L		T	THERMOSTAT, TIMER, TOTALIZER, TRANSFORMER
		L	LOW, LEVEL, LONG-TIME	TACH	TACHOMETER
C		LA	LIGHTNING ARRESTER	IB	TERMINAL BLOCK
C	CLOSE, COUNTER, CONTACTOR, CONTROL, CCTV CAMERA	LAN	LOCAL AREA NETWORK	TC	TIMER CLUTCH
CAP	CAPACITOR	LC	LIGHTING CONTRACTOR	TD	TIME DELAY RELAY
CB	CIRCUIT BREAKER	LCE	LIGHTING CONTRACTOR ENCLOSURE	TEMP	TEMPERATURE
CB"A"	CIRCUIT BREAKER AUXILIARY CONTACT (OPEN WHEN BREAKER IS OPEN)	LCP	LIGHTING CONTROL ENCLOSURE	TM	TIMER MOTOR
CB"B"	CIRCUIT BREAKER AUXILIARY CONTACT (CLOSED WHEN BREAKER IS OPEN)	LCS	LOCAL CONTROL PANEL	TQ	TORQUE
CD	CONTROL DAMPER	LOA	LOCAL CONTROL STATION	TR	TIMER RELAY, TRIAD
CI	CELL INTERLOCK	LOR	LOCAL-OFF-AUTO	TS	TEMPERATURE SWITCH
CKT	CIRCUIT	LQS	LOCAL-OFF-REMOTE	TTB	TELEPHONE TERMINAL BOARD
CL2	CHLORINE	LOS	LOCK OUT STOP		
COS	CABLE OPERATED SWITCH	LP	LIGHTING PANEL	U	
CP	CONTROL PANEL	LS	LIMIT OR LEVEL SWITCH	UG	UNDERGROUND
CPT	CONTROL POWER TRANSFORMER	LTG	LIGHTING	UPS	UNINTERRUPTIBLE POWER SUPPLY
CR	CURRENT OF CONTROL RELAY, CARD READER	LWCO	LOW WATER CUTOFF		
CS	CONTROL STATION	M		V	
CT	CYCLE TIMER OR CURRENT TRANSFORMER	M	MAGNETIC MOTOR, STARTER	V	VOLTS, VOLTAGE RESTRAINED
CTC	CYCLE TIMER CLUTCH	MA	MILLIAMPERE	VA	VOLT AMPERE
CTM	CYCLE TIMER MONITOR	MCB	MAIN CIRCUIT BREAKER	VAR	VARMETER
2/C	2 CONDUCTOR	MCC	MOTOR CONTROL CENTER	VFD	VARIABLE FREQUENCY DRIVE
4"C	4" CONDUIT	MCCU	MOTOR CONTROL LINEUP	VI	VACUUM INTERRUPTER
		MD	MOISTURE DETECTOR, MOTION DETECTOR	VLS	VALVE LIMIT SWITCH
D		MDL	MAGNETIC DOOR LOCK	VM	VOLTMETER
DC	DIRECT CURRENT, DOOR CONTACT	MFR	MANUFACTURER	VPI	VALVE POSITION INDICATOR
DI	DOOR INTERLOCK	MH	MANHOLE, MOUNTING HEIGHT	VS	VOLTMETER SWITCH
DM	DAMPER MOTOR, DEMAND METER, DIMMER SWITCH	MOV	MOTOR OPERATED VALVE		
		MPR	MOTOR PROTECTION RELAY	W	
DPDT	DOUBLE POLE DOUBLE THROW	MS	MANUAL MOTOR STARTER	W	WHITE, WATTS
DPST	DOUBLE POLE SINGLE THROW	MSH	MOTOR SPACE HEATER	WH	WATTHOUR METER
DPR	DIFFERENTIAL PRESSURE REGULATOR	MTS	MANUAL TRANSFER SWITCH	WM	WATT METER
DPS	DIFFERENTIAL PRESSURE SWITCH	MV	MILLIVOLT, MEDIUM VOLTAGE	WP	WEATHERPROOF
DS	DISCONNECT SWITCH, DOOR SWITCH, DESKTOP STATION	MVA	MEGAVOLT AMPERE	WPI	WEATHERPROOF IN-USE
		N		WS	WALL STATION
DVLS	DISCHARGE VALVE LIMIT SWITCH	N	NEUTRAL	X	
		NGR	NEUTRAL GROUNDING RESISTOR	X	AUXILIARY RELAY
E		NGT	NEUTRAL GROUNDING TRANSFORMER	XFMR	TRANSFORMER
E	ELECTRIC OPERATOR FOR CONTROL	NC	NORMALLY CLOSED	XP	EXPLOSION PROOF
EC	EMPTY CONDUIT	NO	NORMALLY OPEN, NUMBER		
EDS	ELECTRICAL DOOR STRIKE	O		Y	
EL	ELEVATION, EMERGENCY LIGHT	OL	OPEN	Y	YELLOW
EMH	ELECTRICAL MANHOLE	OOA	ON-OFF-AUTO		
ER	ELECTRODE RELAY	OOR	ON-OFF-REMOTE	Z	
ES	END SWITCH, REQUEST TO EXIT SENSOR	OS	OCCUPANCY SENSOR	Z	AUXILIARY RELAY, IMPEDANCE
E-STOP	EMERGENCY STOP	O/U	OVER/UNDER	ZS	POSITION SWITCH
ETM	ELAPSED TIME METER			ZSS	ZERO SPEED SWITCH
EX	EXISTING	P			
EXP	EXPLOSION PROOF	P	PRIMARY, POWER, POLE		
		PCS	PLANT CONTROL SYSTEM	1-1PR#16S	ONE, SINGLE PAIR, TWISTED SHIELDED #16 CABLE
F		PB	PUSH BUTTON, PULL BOX		
F	FORWARD, FIELD	PE	PHOTOELECTRIC SENSOR, PHOTOCCELL		
FO	FIBER OPTIC	PF	POWER FACTOR		
FPR	FEEDER PROTECTION RELAY	PFCC	POWER FACTOR CORRECTION CAPACITOR	3-7/C#14	THREE, SINGLE, SEVEN CONDUCTOR #14 MULTICONDUCTOR CONTROL CABLES
FS	FLOW SWITCH	PH	PHASE		
		PL	PILOT LIGHT		
G		PLC	PROGRAMMABLE LOGIC CONTROLLER		
G	GREEN, GROUND, GENERATOR, GROUND FAULT	PP	POWER PANEL		
GD	GROUND DETECTOR	PR	PAIR		
GEN	GENERATOR	PRS	PROXIMITY SWITCH		
GFCI,GFI	GROUND FAULT CURRENT INTERRUPTOR, GROUND FAULT INTERRUPTOR	PS	PRESSURE SWITCH		
		PT	POTENTIAL TRANSFORMER, PROGRAM TIMER		
GLS	GEARED LIMIT SWITCH	Q			
GPR	GENERATOR PROTECTION RELAY	Q	NOT USED		
GND	GROUND	R			
#8G	#8 GROUND WIRE	R	RED, RAISE, RELAY, REVERSE		
		RECP	RECEPTACLE		
H		RES	RESISTOR		
H	HIGH, HUMIDISTAT	RH	REMOTE HANDSET		
HH	HANDHOLE	RT	REPEATING TIMER		
HMT	HIGH MOTOR TEMPERATURE	RTD	RESISTANCE TEMPERATURE DETECTOR		
HOA	HAND-OFF-AUTO	RTU	REMOTE TERMINAL UNIT		
HOR	HAND-OFF-REMOTE	RVSS	REDUCED VOLTAGE SOLID STATE STARTER		
HP	HORSEPOWER				
HS	HAND STATION				
HWCO	HIGH WATER CUTOFF				
HZ	HERTZ (CYCLE)				



Black & Veatch Corporation
Chicago, Illinois
ILLINOIS PROFESSIONAL
DESIGN FIRM - 184.002143-0006



AEROBIC GRANULAR
SLUDGE - PHASE 1

REVISIONS AND RECORD OF ISSUE

DESIGNED:	EJB
DETAILED:	SFR
CHECKED:	SDS
APPROVED:	EJB
DATE:	12/20/2022

PROJECT NO.: 411752

GENERAL



ELECTRICAL

ABBREVIATIONS AND
NOTES


00-E-002

14
OF
163


PLOTTED: 12/19/2022 1:46:33 PM
 FILE: C:\USERS\HOT06334\APPDATA\LOCAL\AUTODESK\AUTOCAD PLANT 3D\COLOR\LABORATORY\IONCACH\411752PID.DWG\00-I-001.DWG
 FDI1000
 011000

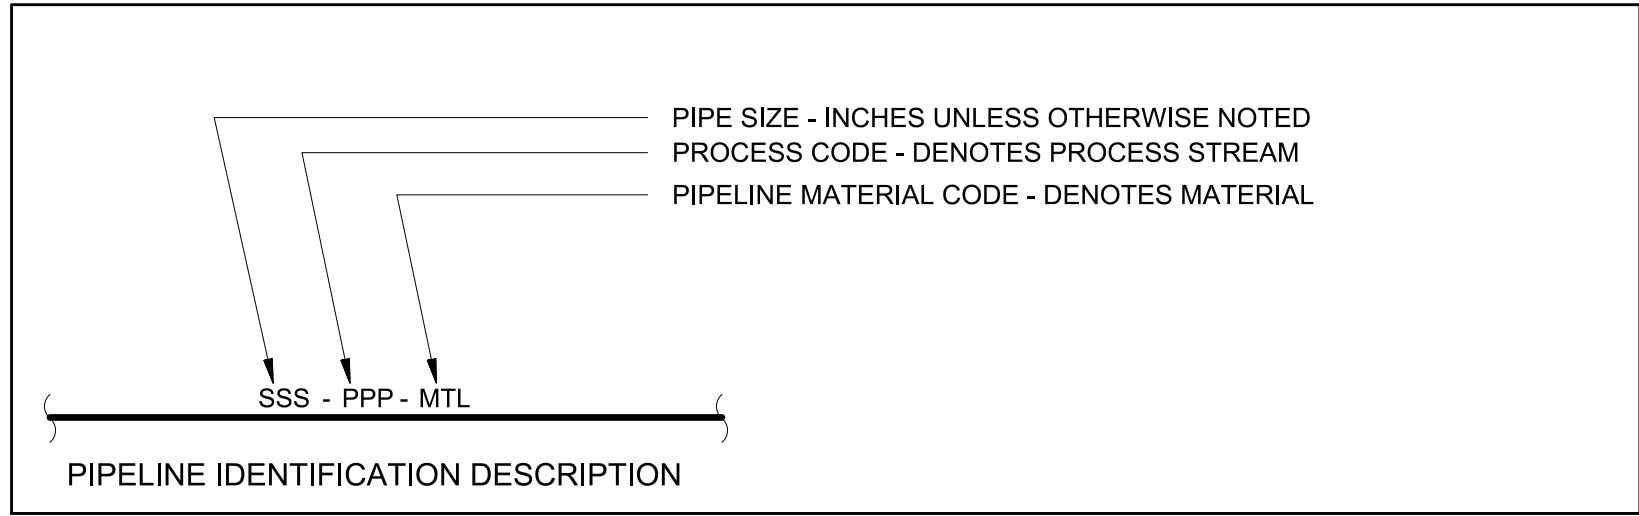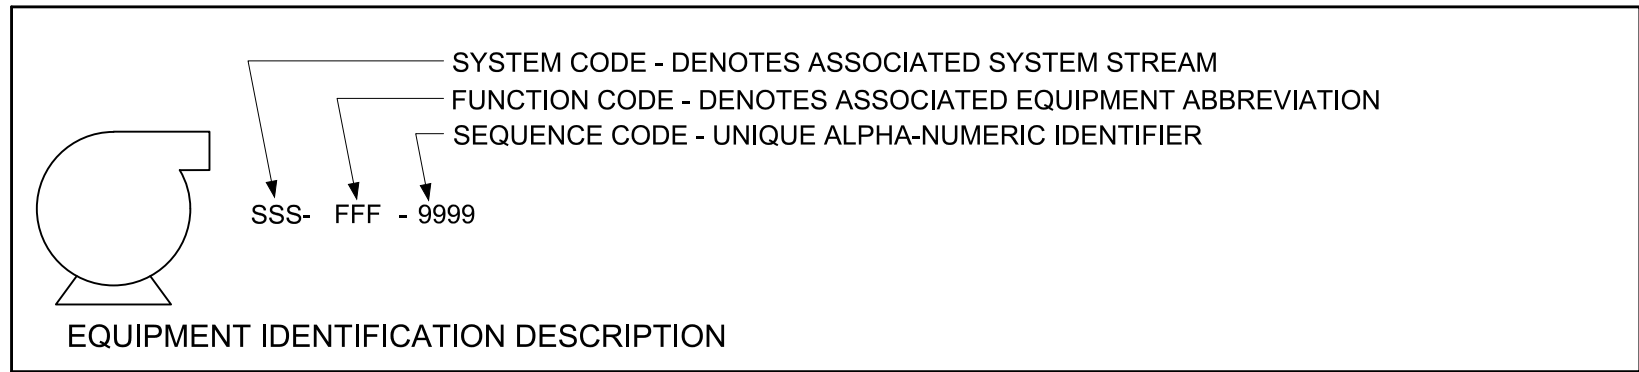


LINE SYMBOLS

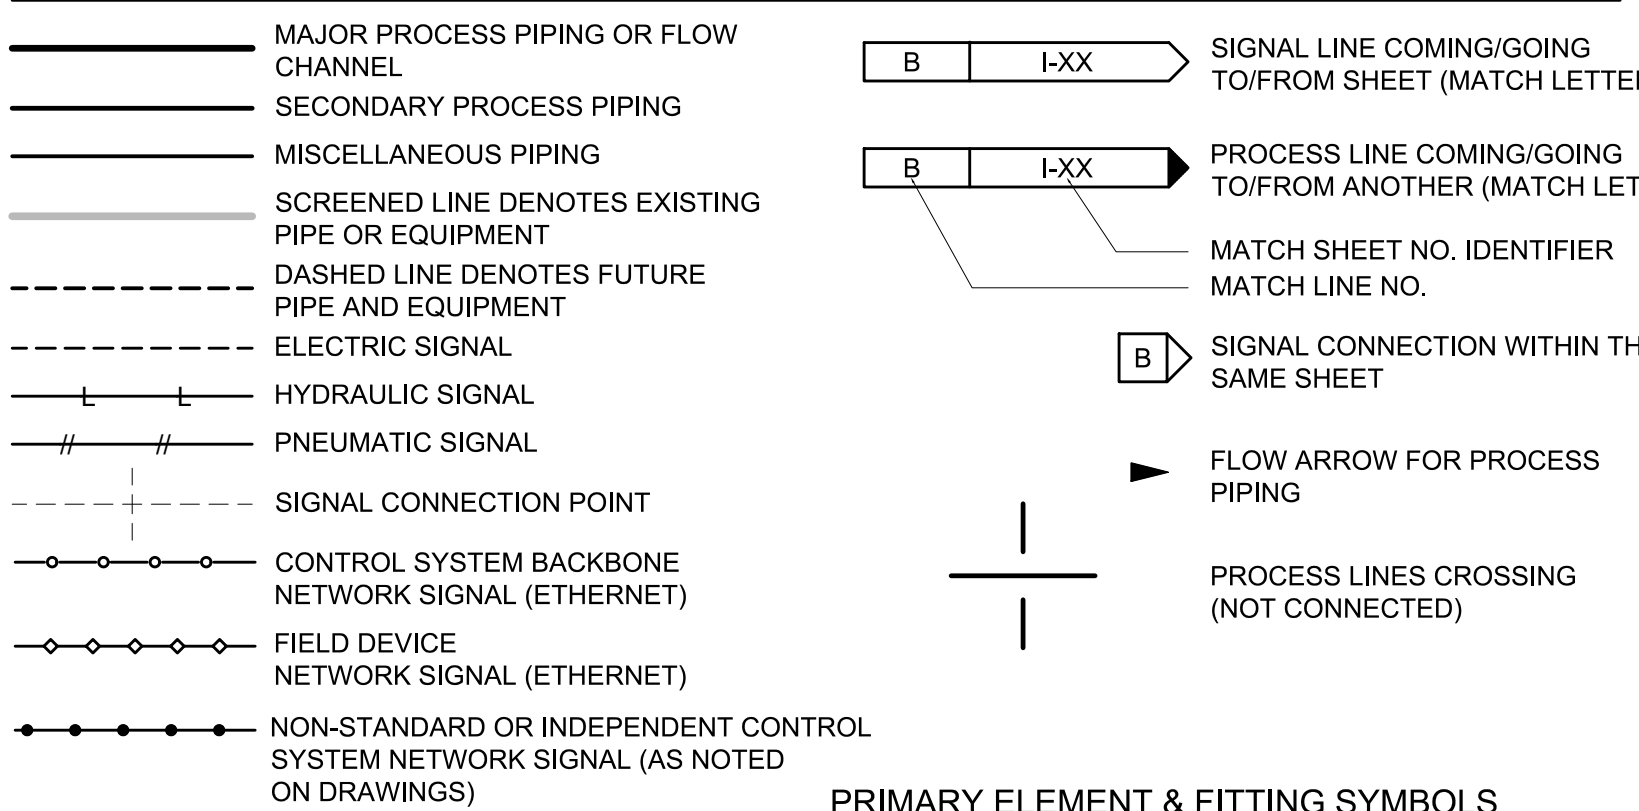


PRIMARY ELEMENT & FITTING SYMBOLS

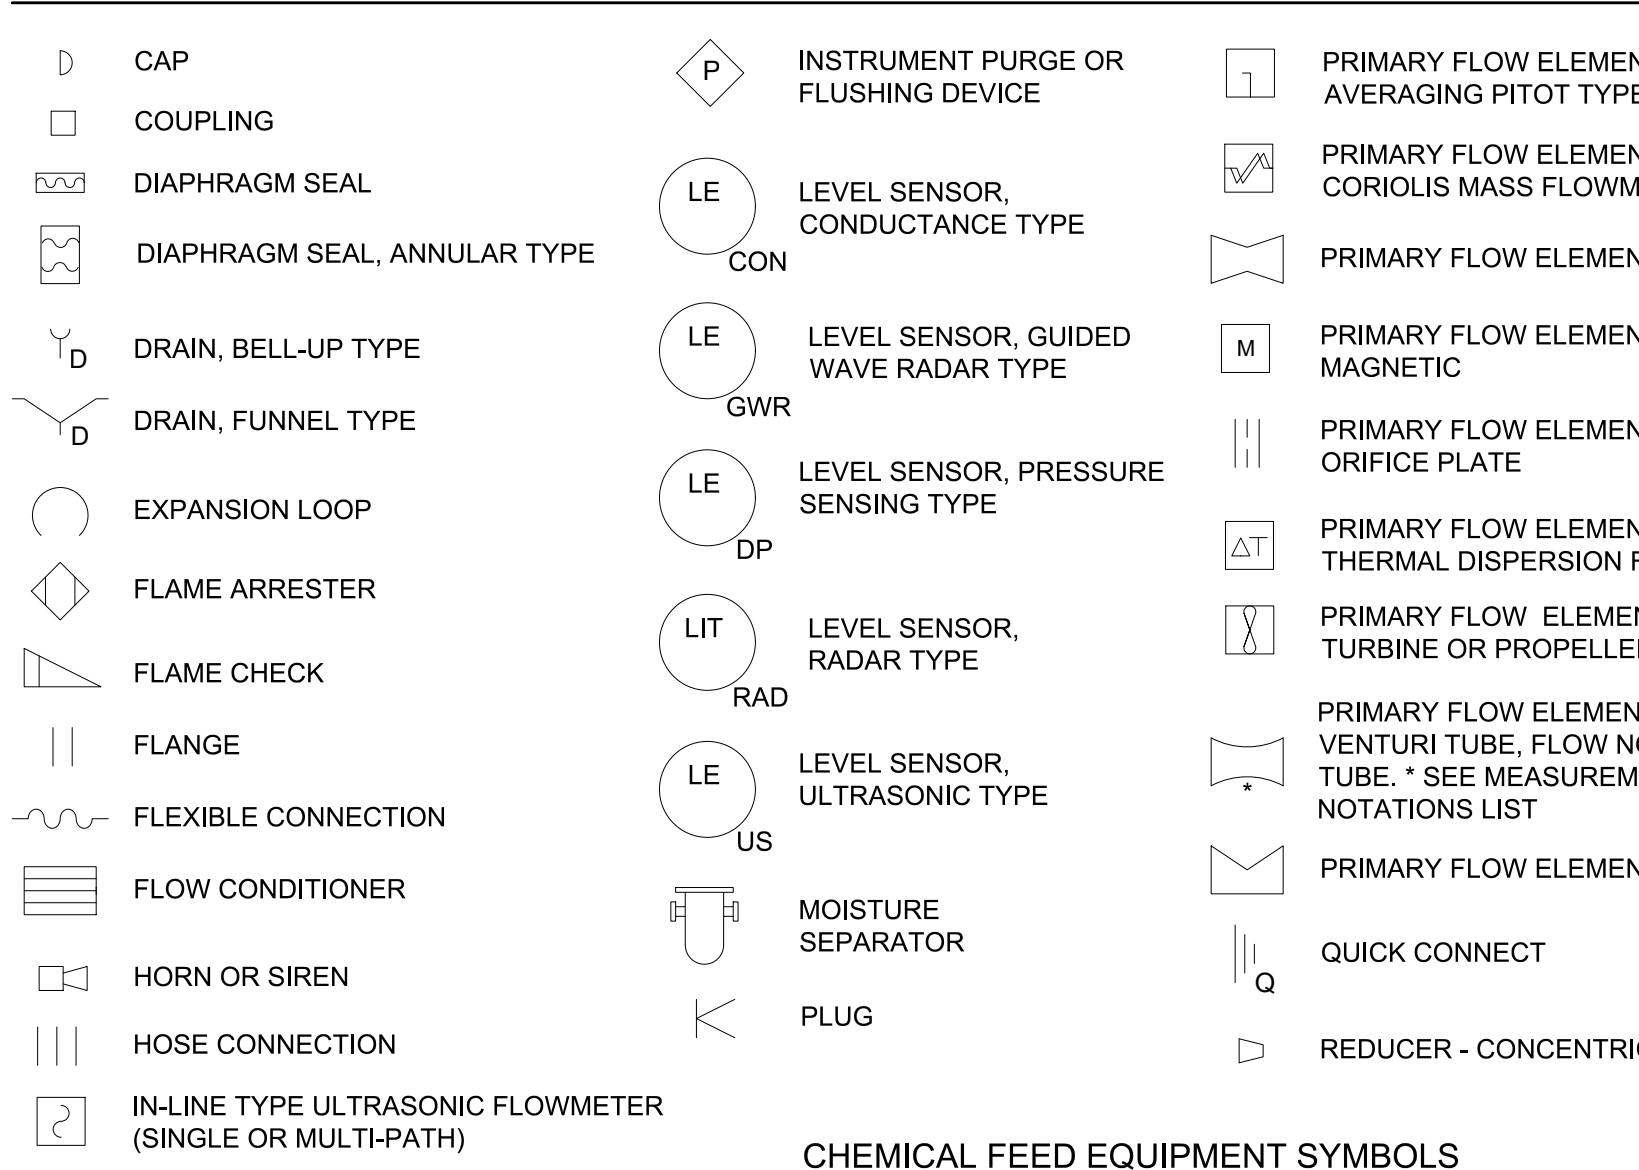


CHEMICAL FEED EQUIPMENT SYMBOLS

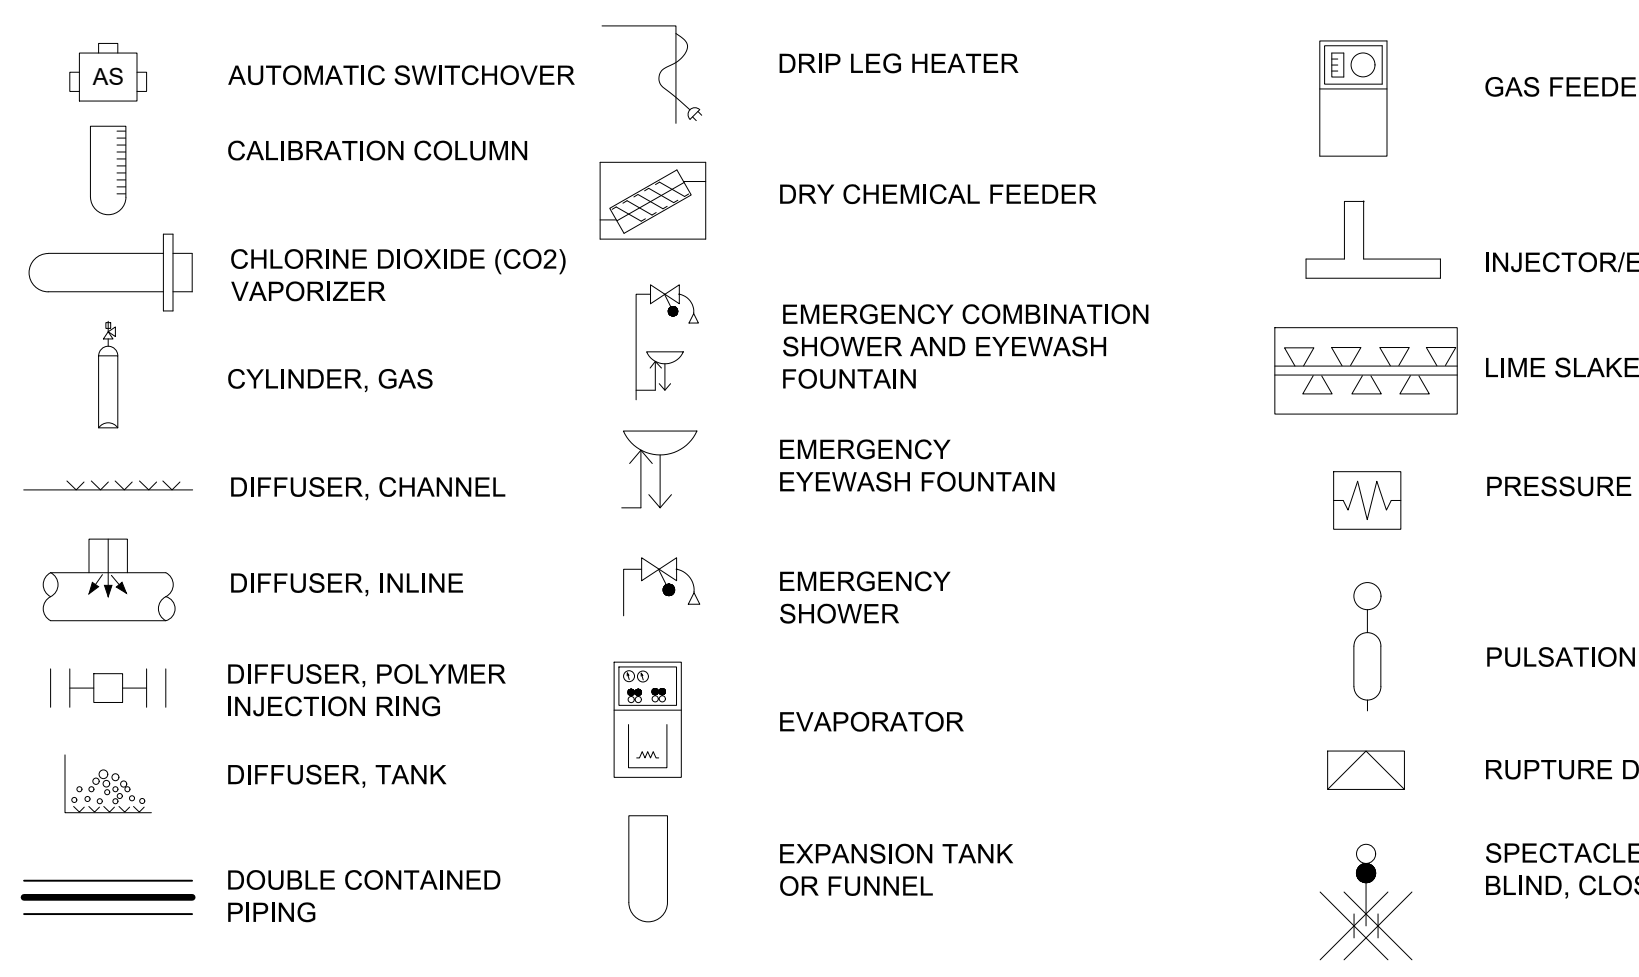


MISCELLANEOUS MECHANICAL EQUIPMENT SYMBOLS

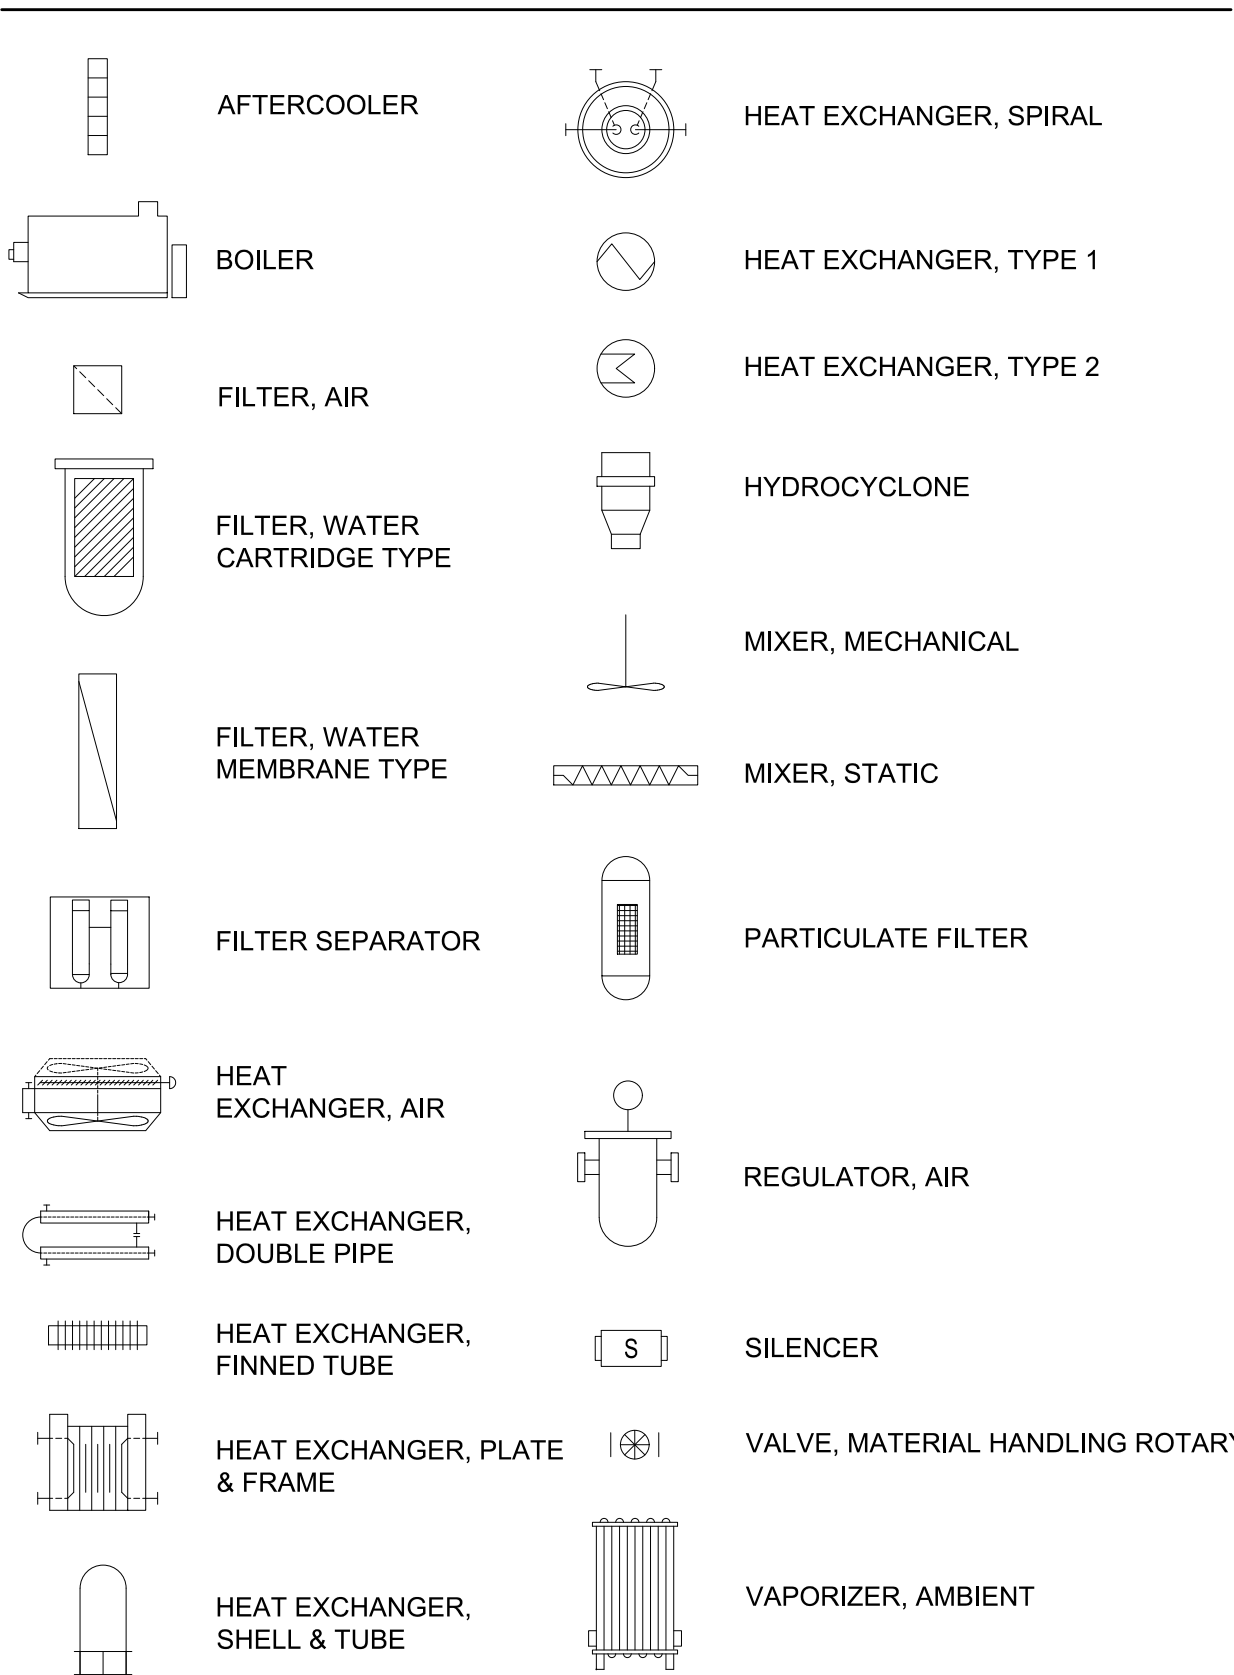


PUMP & BLOWER SYMBOLS

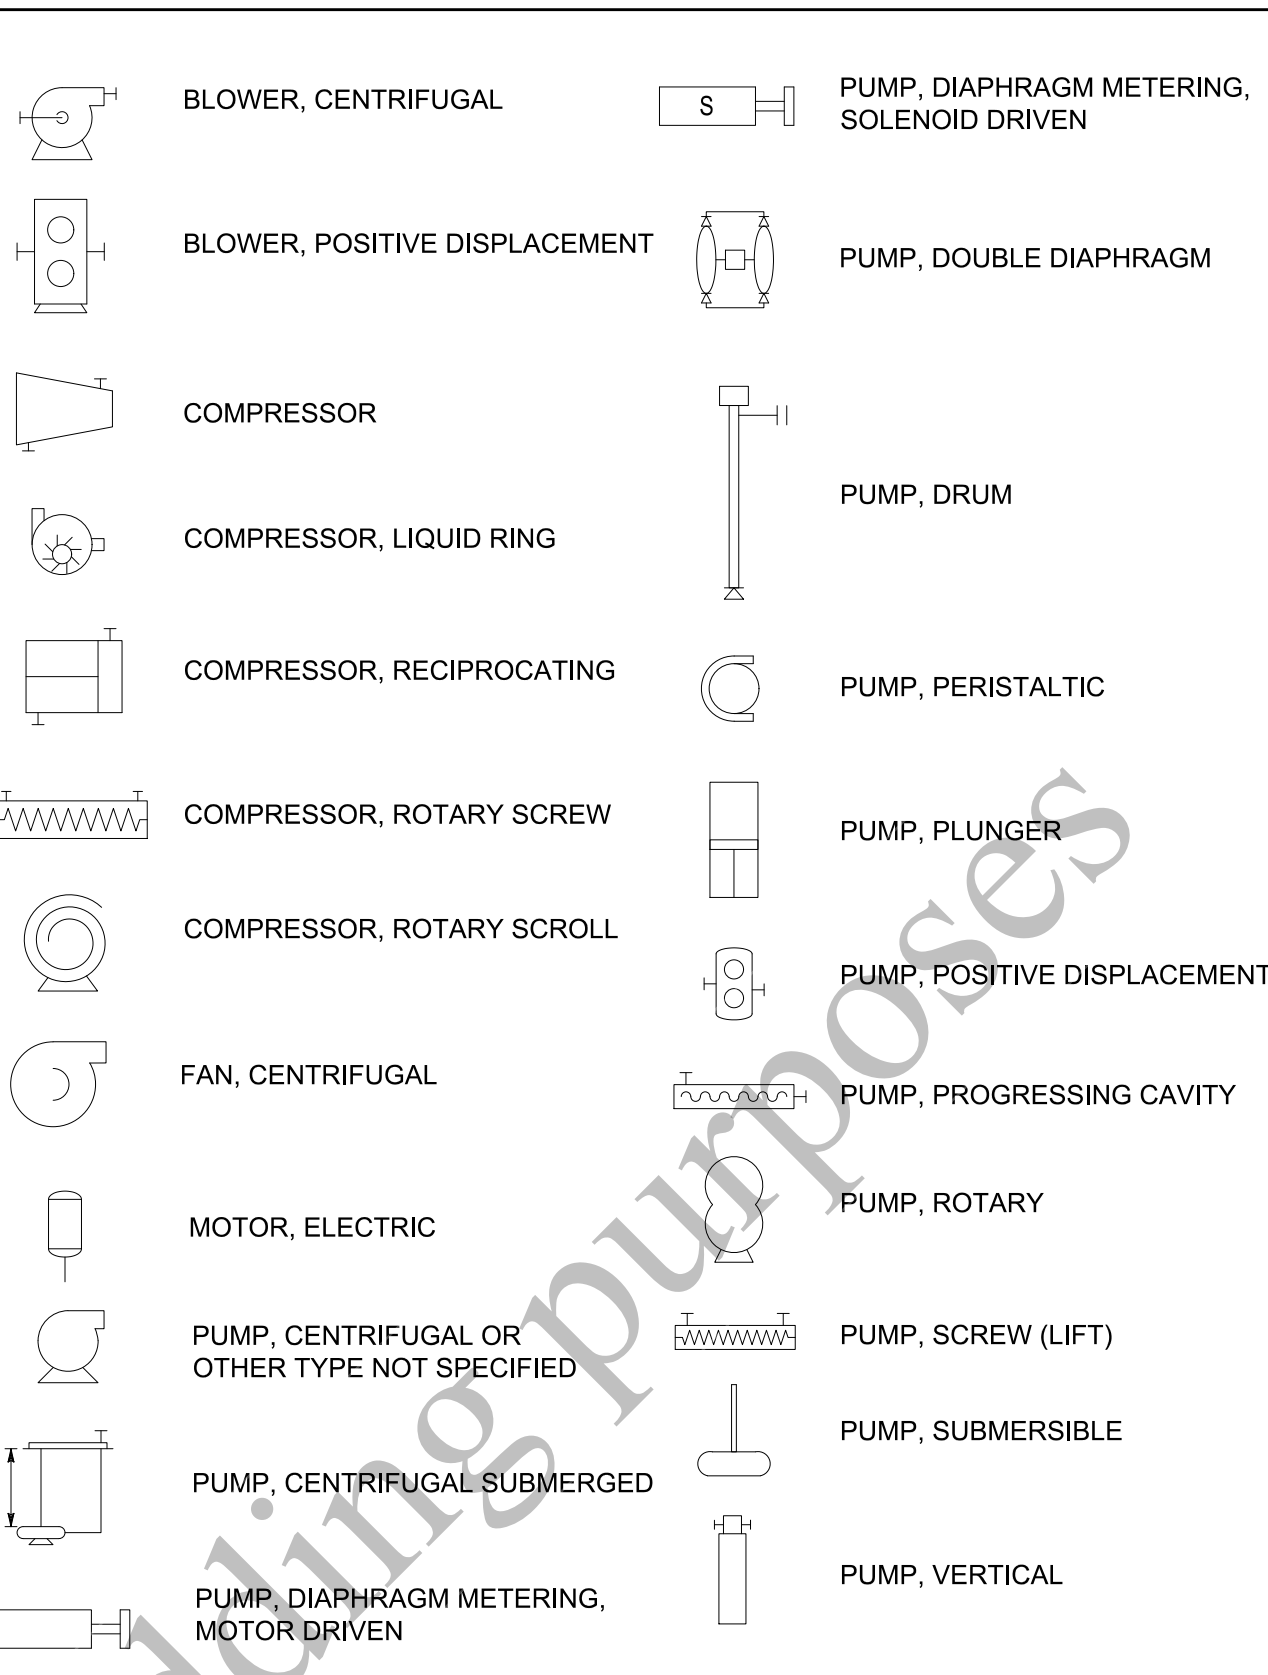


VALVE & GATE SYMBOLS

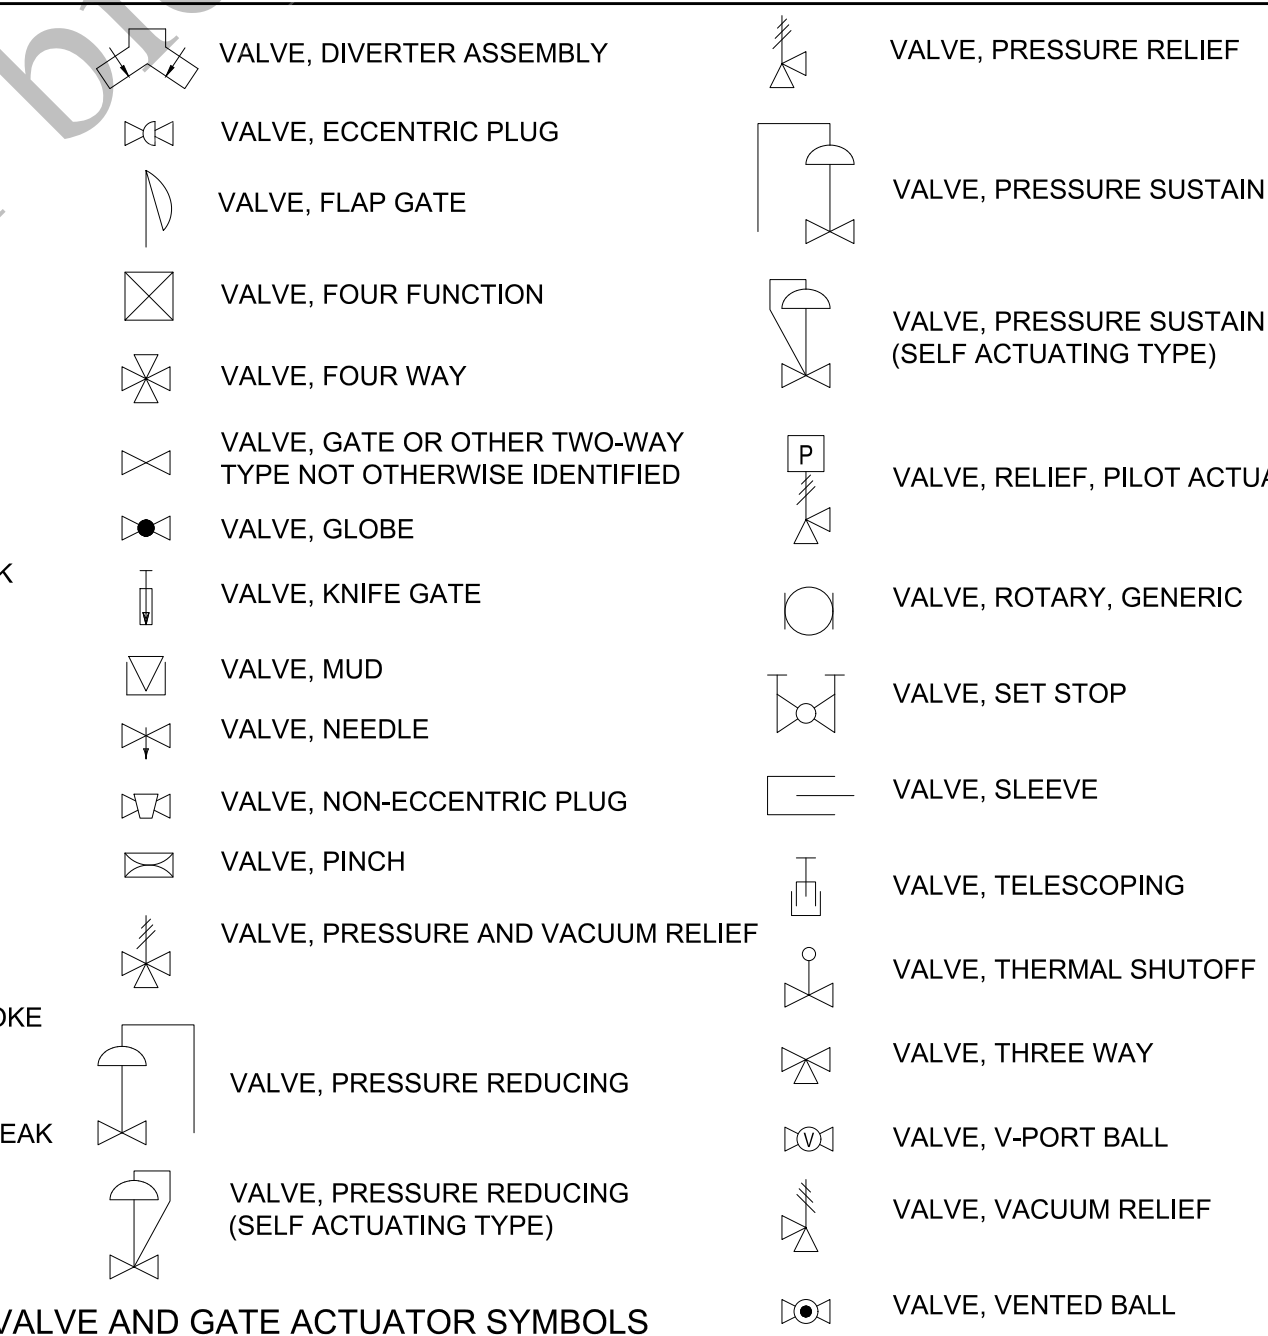


VALVE AND GATE ACTUATOR SYMBOLS

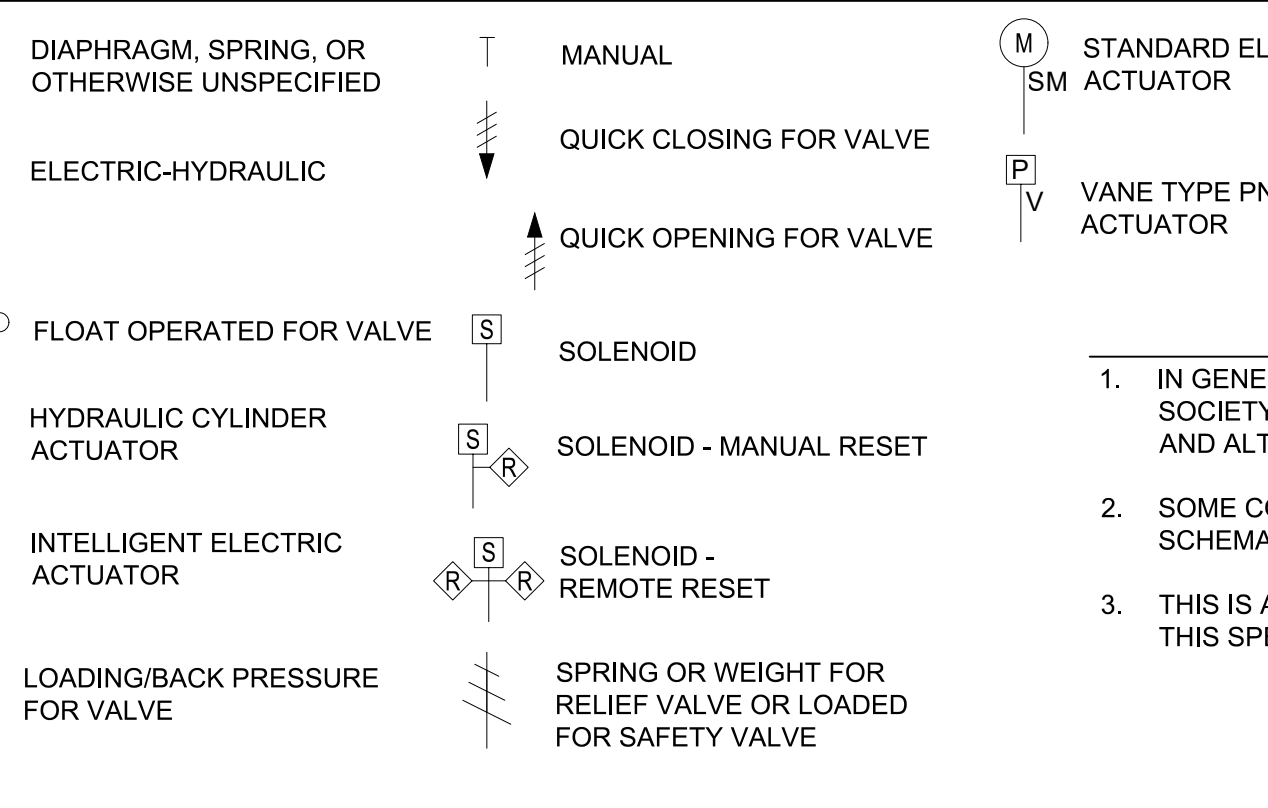

WATER & WASTEWATER MECHANICAL EQUIPMENT SYMBOLS

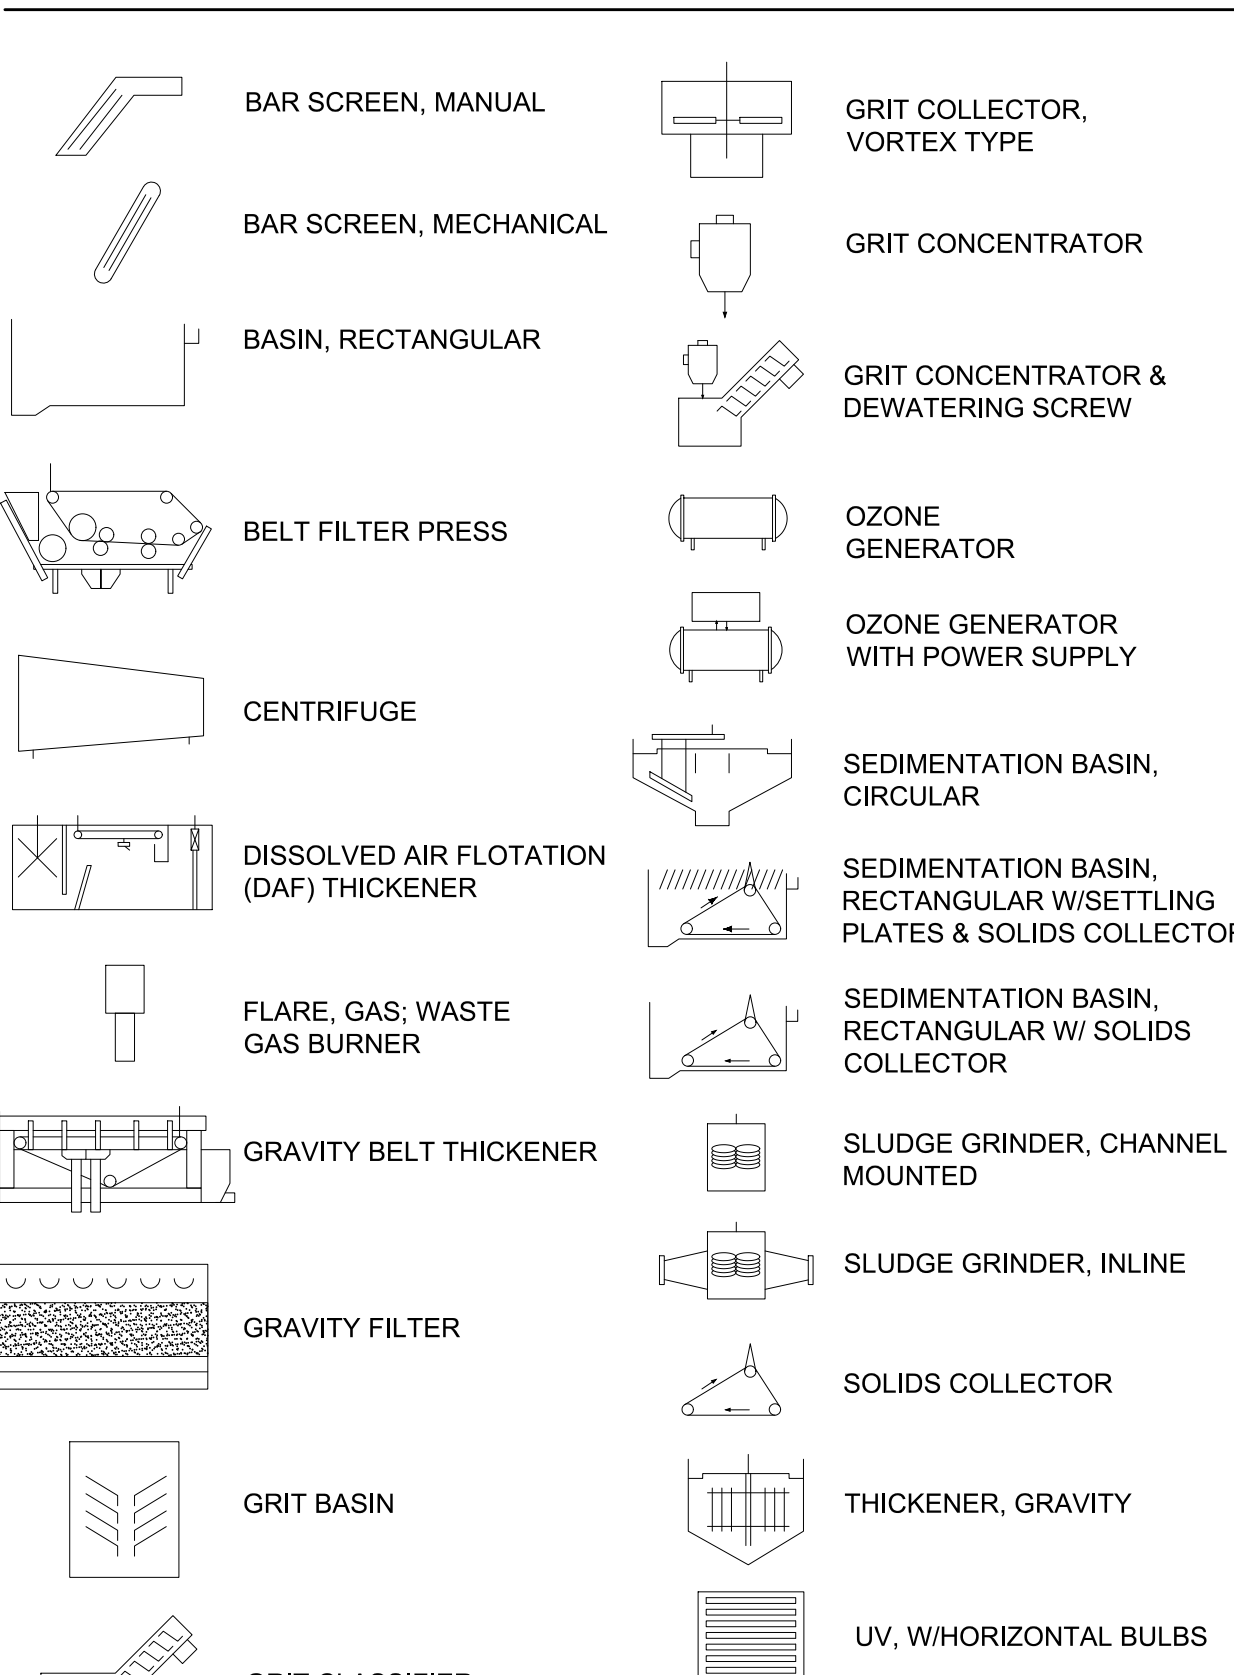

MATERIAL HANDLING EQUIPMENT SYMBOLS

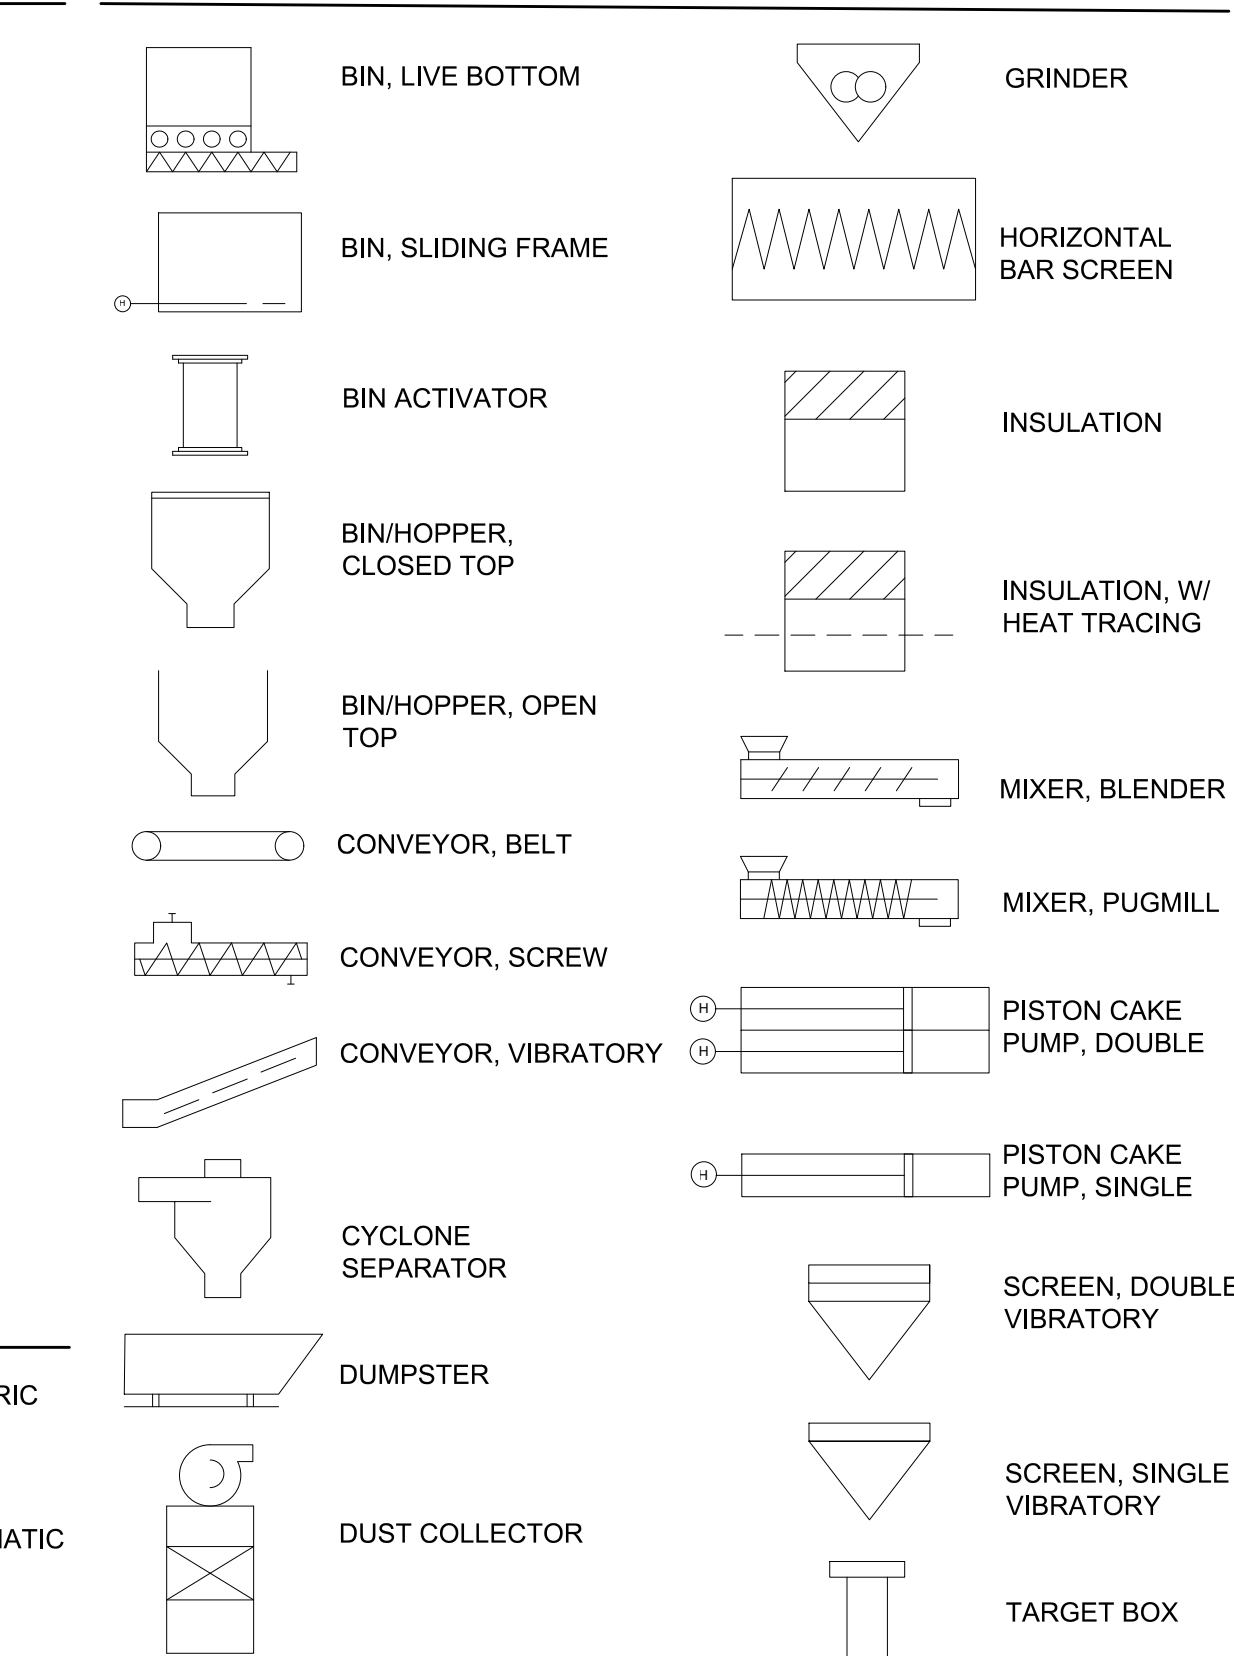

GENERAL NOTES

- IN GENERAL, THE P&ID SYMBOLS AND DEVICE IDENTIFICATIONS ARE BASED ON INTERNATIONAL SOCIETY OF AUTOMATION, STANDARD PRACTICE ANSI/ISA-5.1 (2022). SOME MODIFICATIONS, ADDITIONS, AND ALTERATIONS HAVE BEEN MADE AS NEEDED TO ACCOMMODATE THE PROJECT REQUIREMENTS.
- SOME CONTROL AND INTERLOCK REQUIREMENTS WHICH CAN BE MORE CLEARLY ILLUSTRATED ON SCHEMATIC DRAWINGS HAVE BEEN OMITTED FROM THE P&ID DRAWINGS.
- THIS IS A GENERAL LEGEND SHEET. SOME SYMBOLS AND ABBREVIATIONS MAY NOT BE UTILIZED ON THIS SPECIFIC PROJECT.

AEROBIC GRANULAR SLUDGE - PHASE 1

REVISIONS AND RECORD OF ISSUE	
DESIGNED:	MJP
DETAILED:	DHH
CHECKED:	SAY
APPROVED:	MJP
DATE:	12/20/2022
PROJECT NO.:	411752

GENERAL

INSTRUMENTATION

P&ID - LEGEND AND ABBREVIATIONS SHEET 1 OF 3

PLOTTED: 12/19/2022 1:46:52 PM
 FILE: C:\USERS\HOT06334\APPDATA\LOCAL\AUTODESK\AUTOCAD PLANT 3D\COLOR\LABORATORY\NCA\HEX411752PID.DWG004-002.DWG
 FDI1000
 011000

INSTRUMENT AND I/O ABBREVIATIONS MEANINGS OF IDENTIFICATION LETTERS				
LETTER	FIRST LETTER		SUCCEEDING LETTERS	
	MEASURED OR INITIATING VARIABLE	VARIABLE MODIFIER	READOUT OR PASSIVE FUNCTION	OUTPUT OR ACTIVE FUNCTION
A	ANALYSIS		ALARM	
B	BURNER, COMBUSTION		USER'S CHOICE	USER'S CHOICE
C	USER'S CHOICE			CONTROL
D	USER'S CHOICE	DIFFERENTIAL		DEVIATION
E	VOLTAGE (EMF)		SENSOR, PRIMARY ELEMENT	
F	FLOW, FLOW RATE	RATIO (FRACTION)		
G	USER'S CHOICE		GLASS, GAUGE, VIEWING DEVICE	
H	HAND (MANUALLY INITIATED)			HIGH
I	CURRENT (ELECTRICAL)		INDICATE	
J	POWER		SCAN	
K	TIME OR TIME-SCHEDULE	TIME RATE OF CHANGE		CONTROL STATION
L	LEVEL		LIGHT	LOW
M	MOISTURE	MOMENTARY		MIDDLE OR INTERMEDIATE
N	USER'S CHOICE		USER'S CHOICE	USER'S CHOICE
O	USER'S CHOICE		ORIFICE (RESTRICTION)	OPEN
P	PRESSURE OR VACUUM		POINT (TEST CONNECTION)	
Q	QUANTITY	INTEGRATE OR TOTALIZE	INTEGRATE OR TOTALIZE	
R	RADIATION		RECORD	RUN
S	SPEED OR FREQUENCY	SAFETY		SWITCH
T	TEMPERATURE			TRANSMIT
U	MULTIVARIABLE		MULTIFUNCTION	MULTIFUNCTION
V	VIBRATION OR MECHANICAL ANALYSIS			VALVE, DAMPER OR LOUVER
W	WEIGHT OR FORCE		WELL, PROBE	
X	UNCLASSIFIED	X-AXIS	ACCESSORY DEVICES OR UNCLASSIFIED	UNCLASSIFIED
Y	EVENT, STATE, OR PRESENCE	Y-AXIS		AUXILIARY DEVICES
Z	POSITION, DIMENSION	Z-AXIS		DRIVE, ACTUATOR OR FINAL CTRL ELEMENT

GENERAL NOTES

1. IN GENERAL, THE P&ID SYMBOLS AND DEVICE IDENTIFICATIONS ARE BASED ON INTERNATIONAL SOCIETY OF AUTOMATION, STANDARD PRACTICE ANSI/ISA-5.1 (2022). SOME MODIFICATIONS, ADDITIONS, AND ALTERATIONS HAVE BEEN MADE AS NEEDED TO ACCOMMODATE THE PROJECT REQUIREMENTS.
2. SOME CONTROL AND INTERLOCK REQUIREMENTS WHICH CAN BE MORE CLEARLY ILLUSTRATED ON SCHEMATIC DRAWINGS HAVE BEEN OMITTED FROM P&ID DRAWINGS.
3. THIS IS A GENERAL LEGEND SHEET. SOME SYMBOLS AND ABBREVIATIONS MAY NOT BE UTILIZED ON THIS SPECIFIC PROJECT. PIPING AND EQUIPMENT LEGEND APPLIES TO P&ID SHEETS.

PIPELINE MATERIAL CODE ABBREVIATIONS ¹


PIPE MATERIAL	SPECIFICATION NO.
BR	BRASS
CBCP	CONCRETE BAR-WRAPPED STEEL CYLINDER PIPE
CCFP	CENTRIFUGALLY CAST FIBERGLASS PIPE
CCP	CONCRETE CULVERT PIPE
CI	CAST IRON SOIL PIPE
CMP	CORRUGATED METAL PIPE
CPVC	CPVC
CS	MISCELLANEOUS STEEL PIPE
CSG	GALVANIZED STEEL PIPE
CSP	COMPOSITE SEWER PIPE
CU	COPPER TUBING
DIP	DUCTILE IRON PIPE
FRP	FRP
FRPA	FRP EXHAUST AIR PIPE
HDPE	HDPE PRESSURE PIPE
HS	HOSE
LHCP	LOW-HEAD CONCRETE PRESSURE
LWSP	LIGHT WALL STEEL PIPE
PCCP	PRESTRESSED CONCRETE CYLINDER PIPE
PE	POLYETHYLENE
PP	POLYPROPYLENE
PVC	PVC
PVCFJ	PVC FUSED JOINT PIPE
PVCP	PVC PRESSURE PIPE
PVCSP	PVC SEWER PIPE
PVDF	PVDF
RCP	CONCRETE SEWER PIPE
RPT	REINFORCED PLASTIC TUBING
SP	STEEL PIPE
SS	STAINLESS STEEL PIPE
TG	TEMPERED GLASS
VCP	VITRIFIED CLAY PIPE

1. ABBREVIATION EXTENSIONS ARE ADDED AS NEEDED TO IDENTIFY THE MATERIAL SUB-CLASSIFICATION IN THE SPECIFICATION, SUCH AS "SS-1" FOR DIGESTER GAS PIPING.


INSTRUMENT AND I/O ABBREVIATION DEFINITIONS

AAH	ANALYZER ALARM HIGH	PDI	DIFFERENTIAL PRESSURE INDICATOR (LED OR SCREEN)
AAHH	ANALYZER ALARM HIGH-HIGH	PDIT	DIFFERENTIAL PRESSURE INDICATING TRANSMITTER
AAL	ANALYZER ALARM LOW OR STROBE ALARM LIGHT	PDSH	DIFFERENTIAL PRESSURE SWITCH HIGH
AALL	ANALYZER ALARM LOW-LOW	PDSHH	DIFFERENTIAL PRESSURE SWITCH HIGH-HIGH
AAX	ALARM HORN	PDSL	DIFFERENTIAL PRESSURE SWITCH LOW
AE	ANALYZER SENSOR	PDSLL	DIFFERENTIAL PRESSURE SWITCH LOW-LOW
AI	ANALYZER INDICATION	PE	PRESSURE SENSOR
AIT	ANALYZER INDICATING TRANSMITTER	PG	PRESSURE GAUGE
ASH	ANALYZER SWITCH HIGH	PI	PRESSURE INDICATOR (LED OR SCREEN)
ASHH	ANALYZER SWITCH HIGH-HIGH	PIT	PRESSURE INDICATING TRANSMITTER
CB	CONTROL BLOCK REFERENCE (SCADA LEVEL)	PSH	PRESSURE SWITCH HIGH
FAH	FLOW ALARM HIGH	PSL	PRESSURE SWITCH LOW
FAL	FLOW ALARM LOW	SC	SPEED CONTROL
FC	FLOW CONTROLLER	SI	SPEED INDICATION (LED OR SCREEN)
FE	PRIMARY FLOW ELEMENT/SENSOR	SIK	SPEED INDICATING CONTROL STATION
FG	FLOW SIGHT GAUGE	SIT	SPEED INDICATING TRANSMITTER
FI	FLOW DIGITAL INDICATOR (LED OR SCREEN)	SSL	SPEED SWITCH LOW
FIC	FLOW INDICATING CONTROLLER	TAH	TEMPERATURE ALARM HIGH
FIT	FLOW INDICATING TRANSMITTER	TAHH	TEMPERATURE ALARM HIGH-HIGH
FOG	FLOW TOTALIZING GAUGE	TAL	TEMPERATURE ALARM LOW
FOIT	FLOW TOTALIZING INDICATING TRANSMITTER	TDI	DIFFERENTIAL TEMPERATURE INDICATOR (LED OR SCREEN)
FSH	FLOW SWITCH HIGH	TDIT	DIFFERENTIAL TEMPERATURE TRANSMITTER
FSL	FLOW SWITCH LOW	TE	TEMPERATURE SENSOR/RESISTANCE
FY	FLOW SIGNAL CONVERTER, REPEATER, OR ISOLATOR	TE	TEMPERATURE DETECTOR
HIC	HAND INDICATING CONTROLLER	TG	TEMPERATURE GAUGE
HMS	MOMENTARY PUSHBUTTON OR SELECTOR SWITCH	TI	TEMPERATURE INDICATOR (LED OR SCREEN)
HS	HAND SWITCH	TIT	TEMPERATURE INDICATING TRANSMITTER
IAH	CURRENT ALARM HIGH (MOTOR OVERLOAD)	TSH	TEMPERATURE SWITCH HIGH
IE	CURRENT ELEMENT/SENSOR	TSHH	TEMPERATURE SWITCH HIGH HIGH
ISH	CURRENT SWITCH HIGH USED TO DETECT HIGH TORQUE	TSL	TEMPERATURE SWITCH LOW
JA	POWER FAILURE ALARM	UA	MULTIVARIABLE/Common Alarm/Common Fault
JI	POWER INDICATOR	UCR	RUN COMMAND
JIT	POWER INDICATING TRANSMITTER	UCS	STOP COMMAND
JL	POWER INDICATING LIGHT	VAH	VIBRATION ALARM HIGH
KQI	TIME TOTALIZING INDICATOR	WE	PRIMARY WEIGHT SENSOR/LOAD CELL
LAH	LEVEL ALARM HIGH	WG	WEIGHT GAUGE
LAHH	LEVEL ALARM HIGH-HIGH	WIT	WEIGHT INDICATING TRANSMITTER
LAL	LEVEL ALARM LOW	YA	GENERAL ALARM EVENT
LALL	LEVEL ALARM LOW-LOW	YI	EVENT INDICATION (LED OR SCREEN)
LE	PRIMARY LEVEL ELEMENT/SENSOR	YIR	RUNNING INDICATION
LG	LEVEL SIGHT GAUGE	YIS	STOPPED INDICATION
LI	LEVEL INDICATOR (LED OR SCREEN)	YL	EVENT INDICATING LIGHT
LSH	LEVEL SWITCH HIGH	YLR	RUNNING INDICATING LIGHT
LSHH	LEVEL SWITCH HIGH-HIGH	YLS	STOPPED INDICATING LIGHT
LSL	LEVEL SWITCH LOW	ZI	POSITION INDICATOR
LSLL	LEVEL SWITCH LOW LOW	ZIC	CLOSED INDICATION
LY	LEVEL SIGNAL CONVERTER, ISOLATOR, OR REPEATER	ZIO	OPEN INDICATION
OAH	TORQUE ALARM HIGH	ZIT	POSITION INDICATING TRANSMITTER
OAAH	TORQUE ALARM HIGH HIGH	ZLC	CLOSED INDICATING LIGHT
OSH	TORQUE SWITCH HIGH	ZLO	OPEN INDICATING LIGHT
OSHH	TORQUE SWITCH HIGH-HIGH	ZSC	CLOSED POSITION SWITCH
PAH	PRESSURE ALARM HIGH	ZSO	OPEN POSITION SWITCH
PAHH	PRESSURE ALARM HIGH-HIGH	ZT	POSITION TRANSMITTER
PAL	PRESSURE ALARM LOW		
PALL	PRESSURE ALARM LOW-LOW		
PDAH	DIFFERENTIAL PRESSURE ALARM HIGH		
PDAH-H	DIFFERENTIAL PRESSURE ALARM HIGH-HIGH		
PDG	DIFFERENTIAL PRESSURE GAUGE		

GENERAL INSTRUMENT SYMBOLS

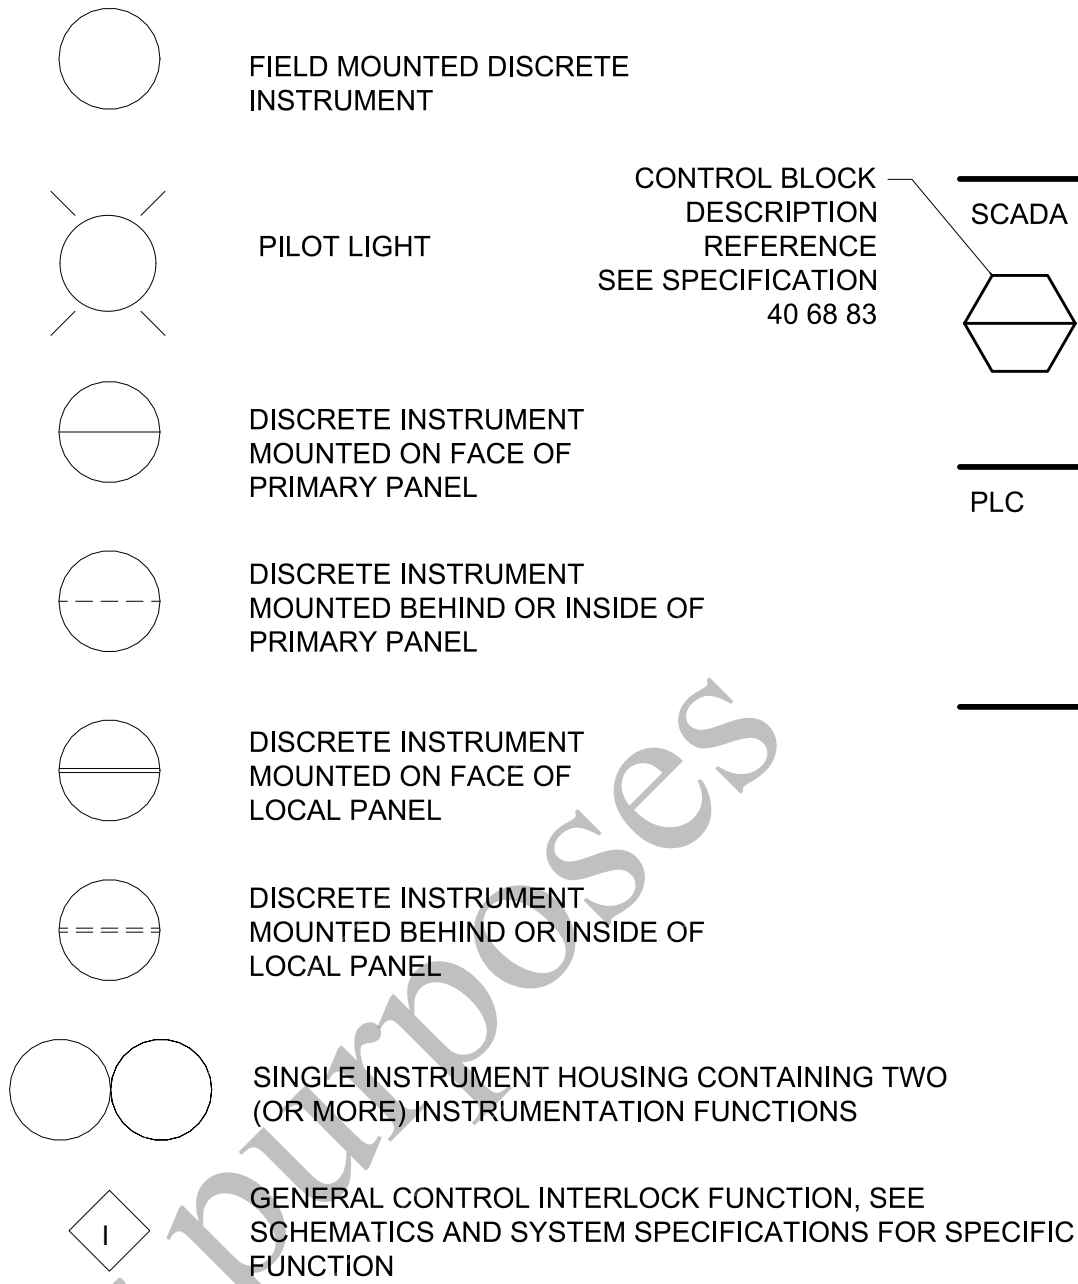


DIGITAL SYSTEMS INTERFACE SYMBOLS

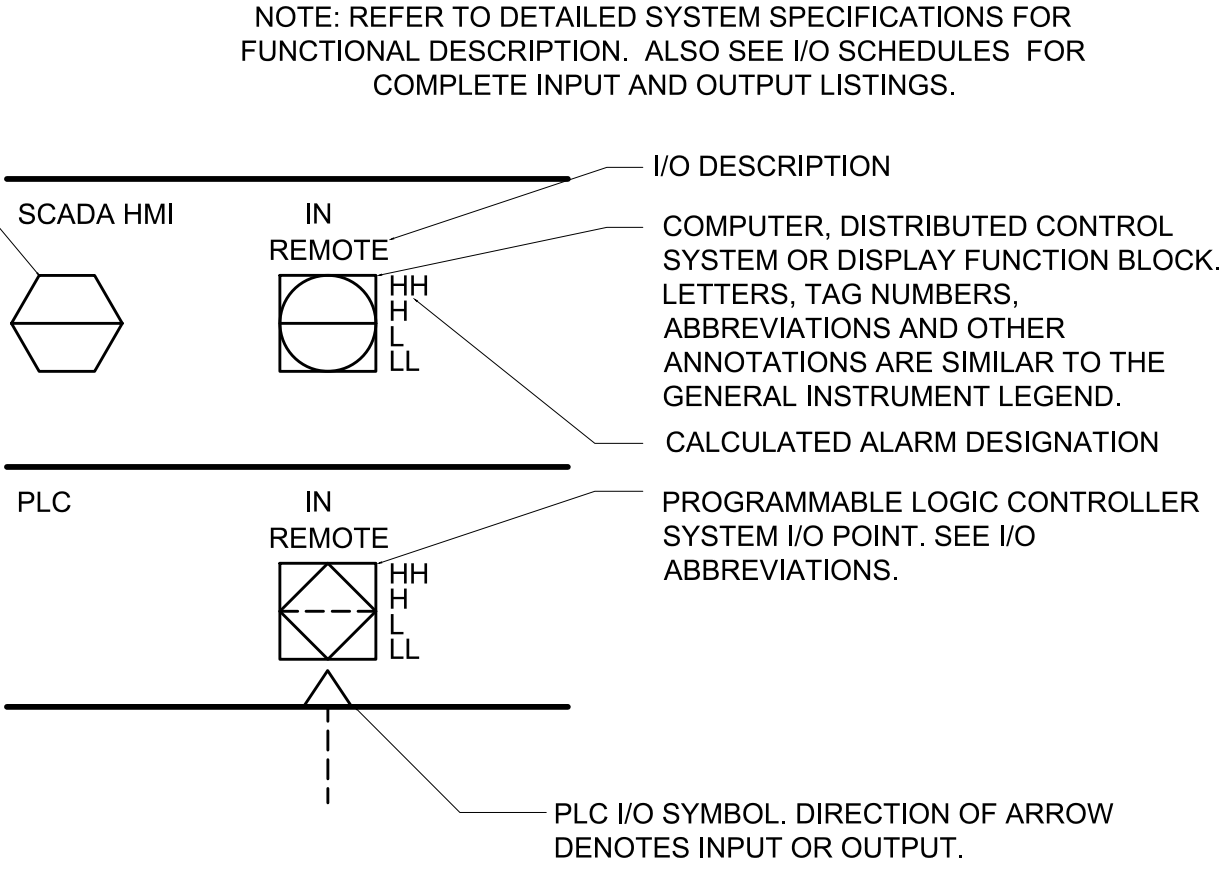

- △ DISCRETE INPUT
- ▽ DISCRETE OUTPUT
- ▲ ANALOG INPUT
- ▼ ANALOG OUTPUT
- △ PULSE INPUT

INSTRUMENTATION SYMBOLOGY AND DESIGNATIONS

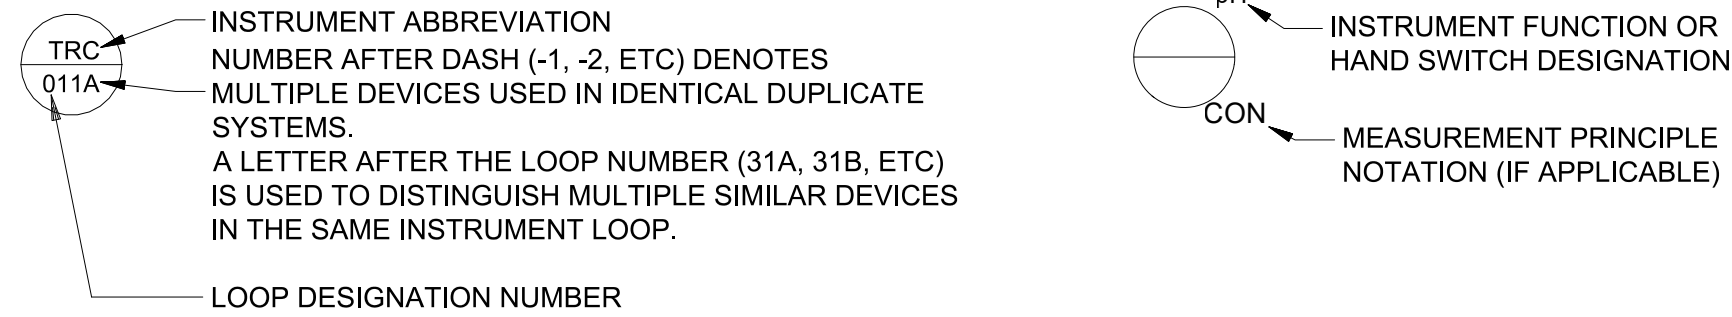

FUNCTION DESIGNATIONS AND ABBREVIATIONS

MEASUREMENT PRINCIPLE NOTATIONS		INSTRUMENT FUNCTIONS		HAND SWITCH DESIGNATIONS	
CON	CONDUCTANCE	Δ	SUBTRACT (DIFFERENCE)	ES	EMERGENCY STOP
DP	DIFFERENTIAL	Σ	ADD OR SUM (ADD AND SUBTRACT)	FLT	FAULT
FLN	PRESSURE SENSING	✓	EXTRACT SQUARE ROOT	FR	FORWARD-REVERSE
FLT	FLOW NOZZLE	÷	DIVIDE	HOA	HAND-OFF-AUTO
GWR	FLOW TUBE	>	HIGH-SELECT	HOR	HAND-OFF-REMOTE
RAD	GUIDED WAVE RADAR	<	LOW-SELECT	LOA	LOCAL-OFF-AUTO
US	RADAR	×	MULTIPLY	LOR	LOCAL-OFF-REMOTE
VENT	ULTRASONIC	∫	INTEGRATE (TIME INTEGRAL)	LR	LOCAL REMOTE
	VENTURI TUBE	CH4	METHANE	OC	OPEN-CLOSE
		CL2	CHLORINE RESIDUAL	OCA	OPEN-CLOSE-AUTO
		CO2	CARBON DIOXIDE	OO	ON-OFF
		COND	CONDUCTIVITY	OOA	ON-OFF-AUTO
		DO	DISSOLVED OXYGEN	OOR	ON-OFF-REMOTE
		DWPT	DEWPOINT	OSC	OPEN-STOP-CLOSE
		F(X)	CHARACTERIZE SIGNAL	RS	RESET
		H2S	HYDROGEN SULFIDE	STP	STOP
		K	GAIN OR ATTENUATE (INPUT:OUTPUT)	STRT	START
		-K	GAIN AND REVERSE		
		LEL	LOWER EXPLOSIVE LIMIT		
		MCC	MOTOR CONTROL CENTER		
		MLSS	MIXED LIQUOR SUSPENDED SOLIDS		
		NH3/NH4	AMMONIUM		
		NO3	NITRATE		
		02	OXYGEN (PURITY)		
		03	OZONE		
		ORP	OXYGEN REDUCTION POTENTIAL		
		pH	pH		
		PO4	PHOSPHATE		
		TSS	TOTAL SUSPENDED SOLIDS		

CALCULATED ALARM DESIGNATIONS	
H	HIGH
HH	HIGH-HIGH
L	LOW
LL	LOW-LOW

INDICATING LIGHT/ALARM DESIGNATIONS	
OVRLD	OVERLOAD
TRQ HI	TORQUE HIGH
TRQ HI-HI	TORQUE HIGH HIGH

TRANSDUCER & CONVERTER DESIGNATION	
E	VOLTAGE
FSK	FREQUENCY SHIF KEYING
H	HYDRAULIC
I	CURRENT
P	PNEUMATIC PULSE
PD	PULSE DURATION
PF	PULSE FREQUENCY
R	RESISTANCE (ELECTRICAL)
EXAMPLE: I/P = CURRENT TO PNEUMATIC TRANSDUCER	

POWER SUPPLY ABBREVIATIONS	
— 120V	POWER SUPPLY SOURCE LABEL. US ONLY WHERE NECESSARY TO HELP CLARIFY AN INSTRUMENT OR SYSTEM FUNCTION.
120V	120VAC
AS	AIR SUPPLY
ES	ELECTRIC SUPPLY
GS	GAS SUPPLY
HS	HYDRAULIC SUPPLY
NS	NITROGEN SUPPLY
SS	STEAM SUPPLY
WS	WATER SUPPLY

VALVE ACTUATOR DESIGNATIONS	
NO	NORMALLY OPEN
NC	NORMALLY CLOSED

POWER SUPPLY ABBREVIATIONS

120V POWER SUPPLY SOURCE LABEL. USED ONLY WHERE NECESSARY TO HELP CLARIFY AN INSTRUMENT OR SYSTEM FUNCTION.

VALVE ACTUATOR DESIGNATIONS

- NO NORMALLY OPEN
- NC NORMALLY CLOSED



Black & Veatch Corporation
Chicago, Illinois
ILLINOIS PROFESSIONAL
DESIGN FIRM - 184.002143 -0006



AEROBIC GRANULAR
SLUDGE - PHASE 1

REVISIONS AND RECORD OF ISSUE

DESIGNED: MJP
DETAILED: DHH
CHECKED: SAY
APPROVED: MJP
DATE: 12/20/2022

PROJECT NO.: 411752

GENERAL

INSTRUMENTATION


P&ID - LEGEND AND
ABBREVIATIONS
SHEET 2 OF 3


00-I-002

16
OF
163

(SCALE BAR IS 4" AT FULL SCALE) 0 1/2 1 2 3 4

PLOTTED: 12/19/2022 1:38:43 PM
FILE: C:\USERS\HOT0633\APPDATA\LOCAL\AUTODESK\AUTOCAD PLANT 3D\COLOR\LABORATORY\IONCACH\411752PID.DWG 02-I-601.DWG
D11000

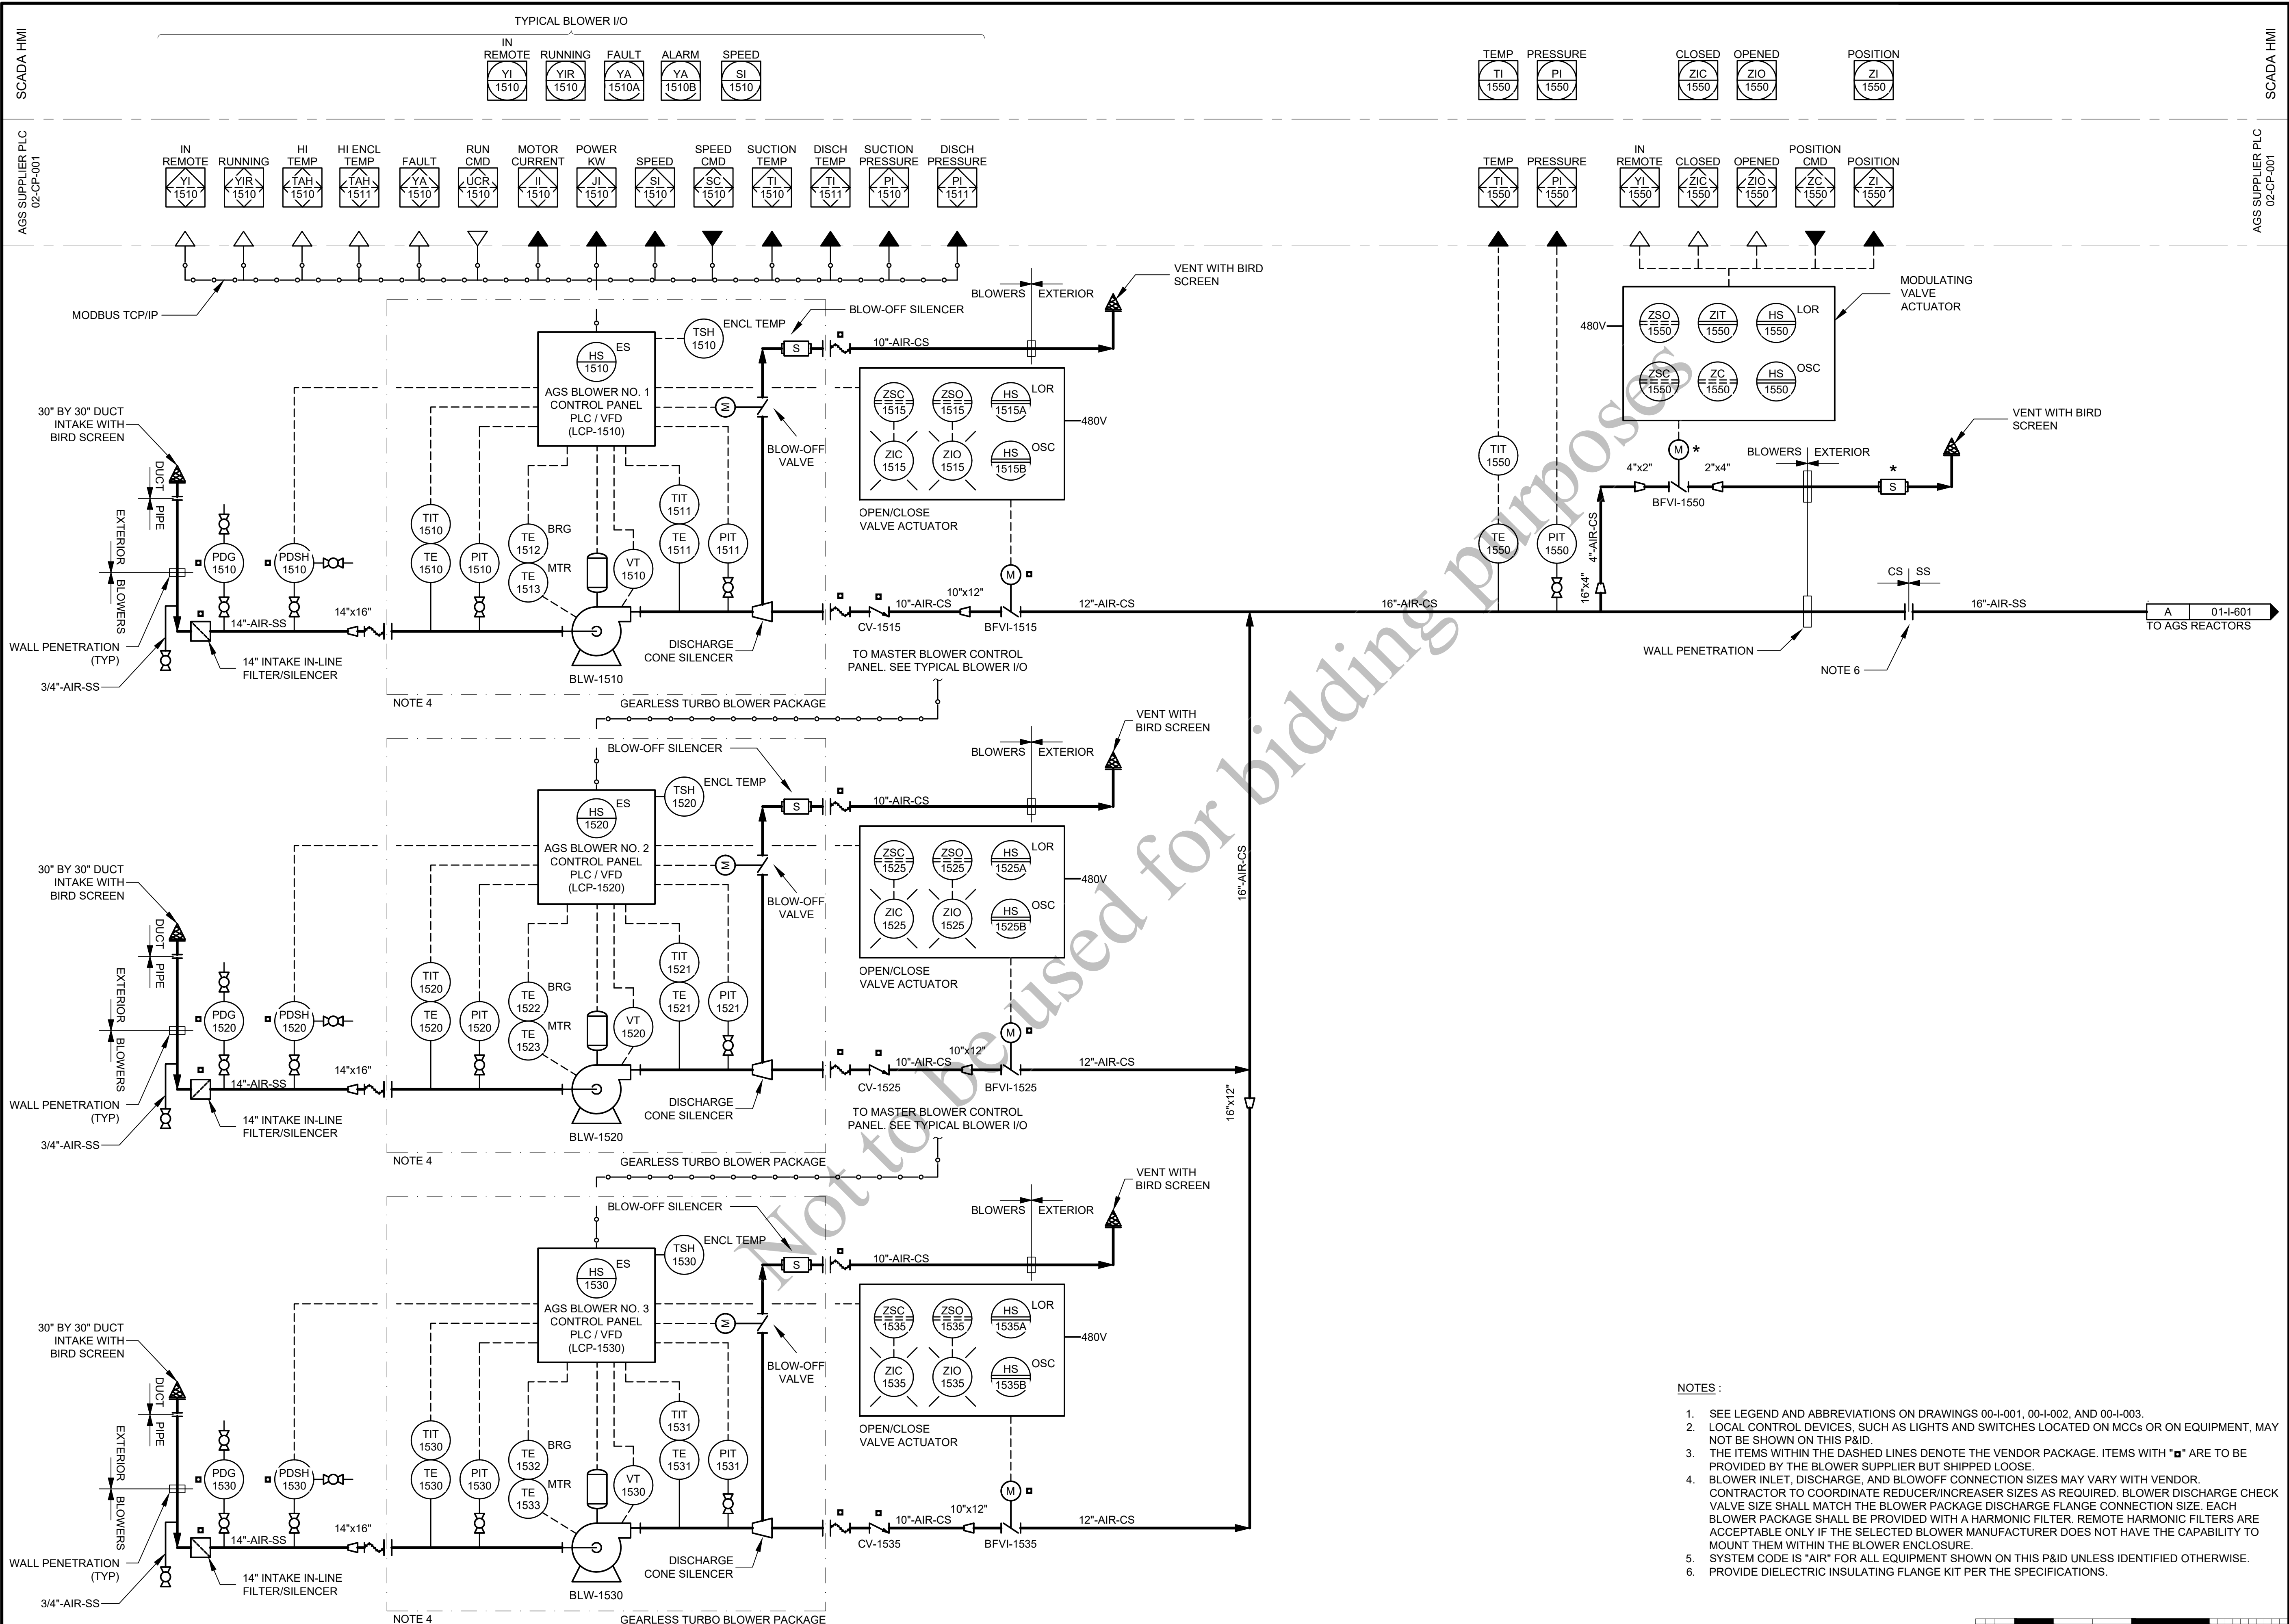

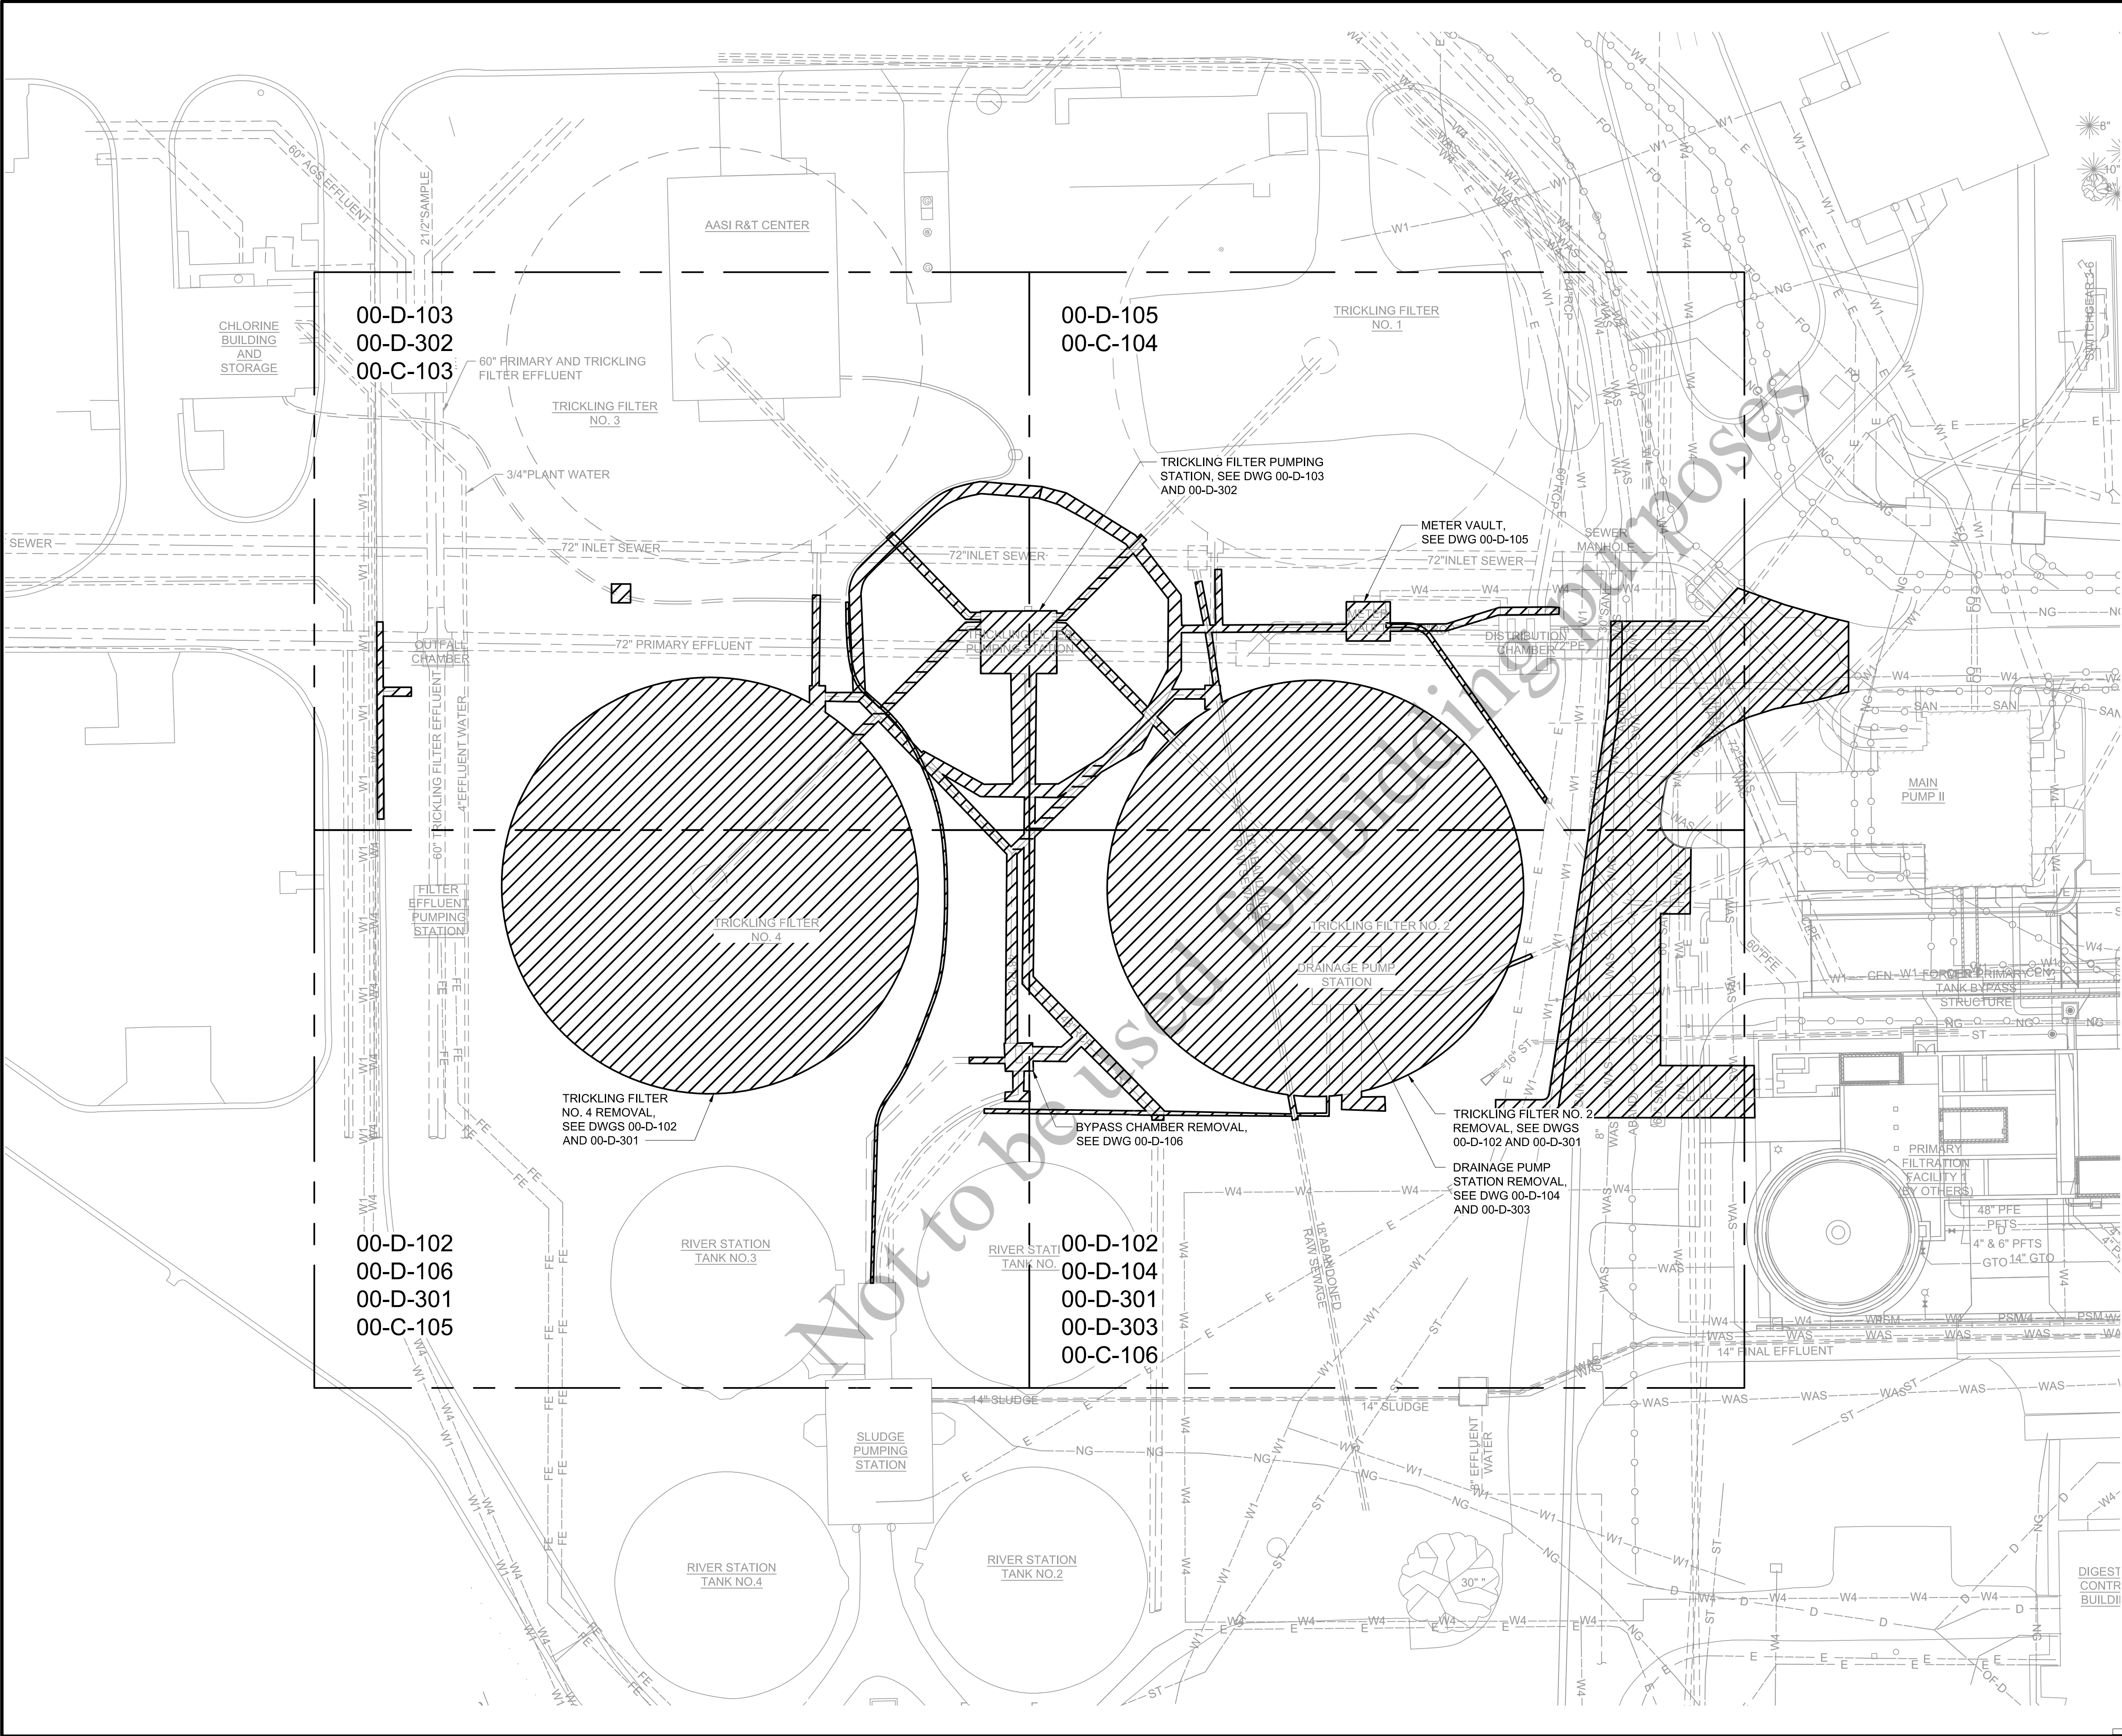

- NOTES:**
- CONTRACTOR SHALL NOTIFY FRSA AT LEAST 72 HOURS PRIOR TO ANY EXCAVATION.
 - SEE DWG 00-C-001 FOR LEGEND AND GENERAL NOTES AND DWGS 00-C-103 THROUGH 00-C-106 FOR EXISTING CONDITIONS AND REMOVAL PLANS.
 - EXISTING PCC PAVEMENT AND CURB AND GUTTER IS DOWELED. PRESERVE DOWELS IN EXISTING CONCRETE TO REMAIN.
 - PARTIAL REMOVAL OF PCC PAVEMENT PANELS IS NOT PERMITTED. WHERE REMOVAL OF PCC PAVEMENT IS REQUIRED, CONTRACTOR SHALL REMOVE ENTIRE PANEL.
 - CONTRACTOR SHALL NOT BEGIN ANY LAND DISTURBING ACTIVITIES UNTIL EROSION CONTROL MEASURES AND DEVICES HAVE BEEN PUT IN PLACE. SEE DWG 00-C-102 FOR ADDITIONAL DETAILS AND EROSION AND SEDIMENT CONTROL NOTES.
 - ITEMS SHOWN AS EXISTING ON DRAWINGS ARE TO BE PROTECTED DURING CONSTRUCTION.
 - PLANT PERIMETER SHALL REMAIN SECURED AT ALL TIMES. CONTRACTOR IS RESPONSIBLE FOR TEMPORARY FENCING AS REQUIRED.
 - TRENCH, PAVEMENT, AND SITE RESTORATION SHALL MATCH ADJACENT EXISTING GRADE UNLESS OTHERWISE NOTED.
 - ALL EXISTING MANHOLES, CATCH BASINS, AND INLETS WITHIN THE LIMITS OF CONSTRUCTION TO REMAIN SHALL BE PROTECTED DURING CONSTRUCTION, AND, IF REQUIRED DUE TO NEW CONSTRUCTION, ADJUSTED TO FINAL GRADE AND/OR TO ACCEPT DRAINAGE.
 - ALL EXISTING SHRUBS, PLANTS, AND STRUCTURES WITHIN THE SITE SHALL BE PROTECTED BY MEANS OF FENCING AND OTHER DEVICES. IT SHALL BE THE CONTRACTOR'S RESPONSIBILITY TO PROTECT AND CLEAN UP ALL DEBRIS NEAR, ON, OR AROUND THESE AREAS AT COMPLETION OF WORK.
 - ALL WASTE EXCAVATION, CONSTRUCTION MATERIALS, DEMOLISHED STRUCTURES AND DEBRIS SHALL BE REMOVED FROM THE SITE.
 - CONTRACTOR AT HIS DISCRETION MAY ELECT TO PROCESS DEMOLISHED CONCRETE ON SITE FOR REUSE WITHIN ONE OF THE POTENTIAL CONTRACTOR STAGING AREAS.
 - SAWCUT AND REMOVE CONCRETE TO THE LIMITS NOTED. IN EXPOSED AREAS NOT COVERED BY NEW CONSTRUCTION, REMOVE REINFORCEMENT AND EMBEDMENTS 1" BEYOND FINISHED SURFACE AND PATCH SURFACE WITH PATCHING MORTAR TO MATCH ADJACENT FINISHED SURFACE.
 - REMOVE CONCRETE ANCHORS, ANCHOR BOLTS, AND OTHER EMBEDMENTS FOR MATERIALS AND EQUIPMENT BEING REMOVED. IN EXPOSED AREAS NOT COVERED BY NEW CONSTRUCTION, REMOVE CONCRETE ANCHORS, ANCHOR BOLTS, OTHER EMBEDMENTS 1" BEYOND FINISHED SURFACE AND PATCH SURFACE WITH PATCHING MORTAR. FINISH SURFACE TO MATCH ADJACENT FINISHED SURFACE.
 - WHERE EQUIPMENT IS INDICATED TO BE REMOVED, REMOVE ALL ASSOCIATED POWER AND CONTROL WIRING AND CONDUIT BACK TO SOURCE. REMOVE JUNCTION BOXES AND PULL BOXES ASSOCIATED WITH THE REMOVED CONDUITS. WHERE CONDUIT SYSTEM CONTAINS CIRCUITS TO OTHER EQUIPMENT THAT REMAINS, RETAIN THESE CIRCUITS AND RELOCATE EXISTING CONDUIT AND EXTEND EXISTING CIRCUITS AS REQUIRED FOR THE INSTALLATION OF NEW EQUIPMENT.
 - REMOVE ALL SUPPORTS ASSOCIATED WITH REMOVED PIPING, DUCTWORK, CONDUIT, AND EQUIPMENT. REMOVE RODS AND FASTENERS FROM CEILINGS, FLOORS, AND WALLS WITH CARE. WHERE SURFACE HAS BEEN MARRED, CHIPPED, SPRAWLED, ETC. AS A RESULT OF REMOVAL, PATCH SURFACE WITH PATCHING MORTAR AND FINISH TO MATCH ADJACENT FINISHED SURFACE.
 - REMOVE EXISTING PADS OF ANY EQUIPMENT BEING REMOVED. REMOVE CONCRETE REINFORCEMENT A MINIMUM OF 1" BEYOND FINISHED SURFACE AT ANY LOCATION WHERE NEW CONCRETE PAD WILL NOT COVER ROUGH SURFACE OF REMOVED PAD. PATCH SURFACE WITH PATCHING MORTAR AND FINISH TO MATCH ADJACENT FINISHED SURFACE.
 - WHERE OPENINGS ARE LEFT IN WALLS, SLABS, OR CEILINGS DUE TO REMOVED PIPING, DUCTWORK, EQUIPMENT, OR OTHER WORK, PATCH OPENING TO MATCH ADJACENT SURFACES UNLESS NOTED OTHERWISE. THE PERIMETER OF OPENINGS IN CONCRETE WALLS AND SLABS EXPOSED TO EARTH, WEATHER, OR WATER SHALL BE LINED WITH A GASKET TYPE WATERSTOP PRIOR TO PATCHING OF THE WALL. OPENINGS IN PRECAST CONCRETE ROOF MEMBERS ARE TO BE PATCHED WITH CONCRETE AND DOWELED TO THE EXISTING ROOF MEMBERS UNLESS NOTED OTHERWISE. ROOFING SYSTEM SHALL BE PATCHED TO PREVENT ANY LEAKING AT THE OPENING.

LEGEND:

ITEMS OR AREAS TO BE DEMOLISHED



AEROBIC GRANULAR SLUDGE - PHASE 1

REVISIONS AND RECORD OF ISSUE	
DESIGNED:	SM
DETAILED:	AB
CHECKED:	AM/JH
APPROVED:	MR
DATE:	12/20/2022
PROJECT NO.:	411752

GENERAL

DEMOLITION

DEMOLITION SITE PLAN

REVISIONS AND RECORD OF ISSUE

DESIGNED:	SM
DETAILED:	AB
CHECKED:	AM/JH
APPROVED:	MR
DATE:	12/20/2022
PROJECT NO.:	411752

GENERAL

DEMOLITION

TRICKLING FILTER NO. 2
AND NO. 4 PLANS



00-D-102

22
OF
163

NOTES:


- DEMOLITION PLAN DEPICTS TRICKLING FILTER NO.2. DEMOLITION OF TRICKLING FILTER NO.4 IS SIMILAR TO TRICKLING FILTER NO.2. HOWEVER, THE ORIENTATION OF THE INLET AND OUTLET PIPE DIFFERS.
- REFER TO DWG 00-D-101 FOR GENERAL REMOVAL NOTES.
- BECAUSE AN IMAGE FROM A RECORD DRAWING IS USED TO SHOW THE EXTENT OF DEMOLITION, THIS DRAWING IS NOT TO SCALE. CONTRACTOR SHALL FOLLOW THE DIMENSIONS SPECIFIED IN THE IMAGE.
- CONVERT ELEVATIONS INDICATED ON RECORD DRAWING BACKGROUND IMAGES TO THE PROJECT DATUM BY ADDING 602.58. FOR EXAMPLE, RECORD DRAWING ELEVATION 90.6 EQUALS PROJECT DATUM ELEVATION 693.18.
- CONTRACTOR TO FIELD VERIFY ALL DIMENSIONS AND ELEVATIONS.

LEGEND:

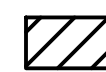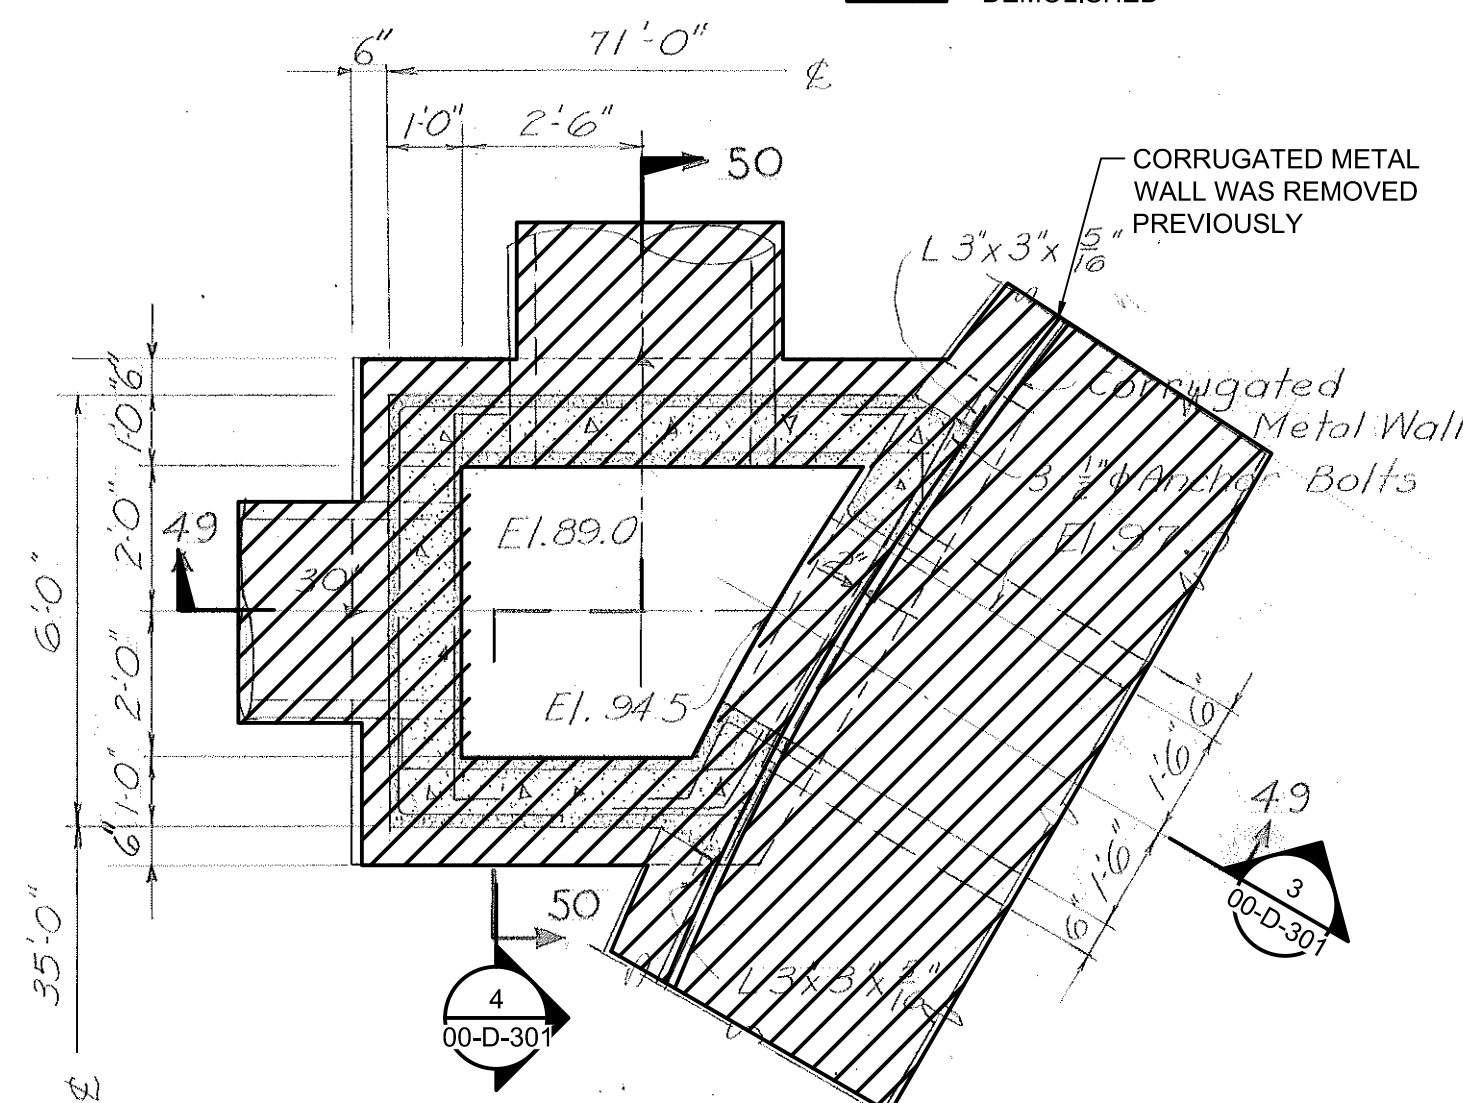 ITEMS OR AREAS TO BE DEMOLISHED

PLAN OF OUTLET BOX


3/8" = 1'-0"

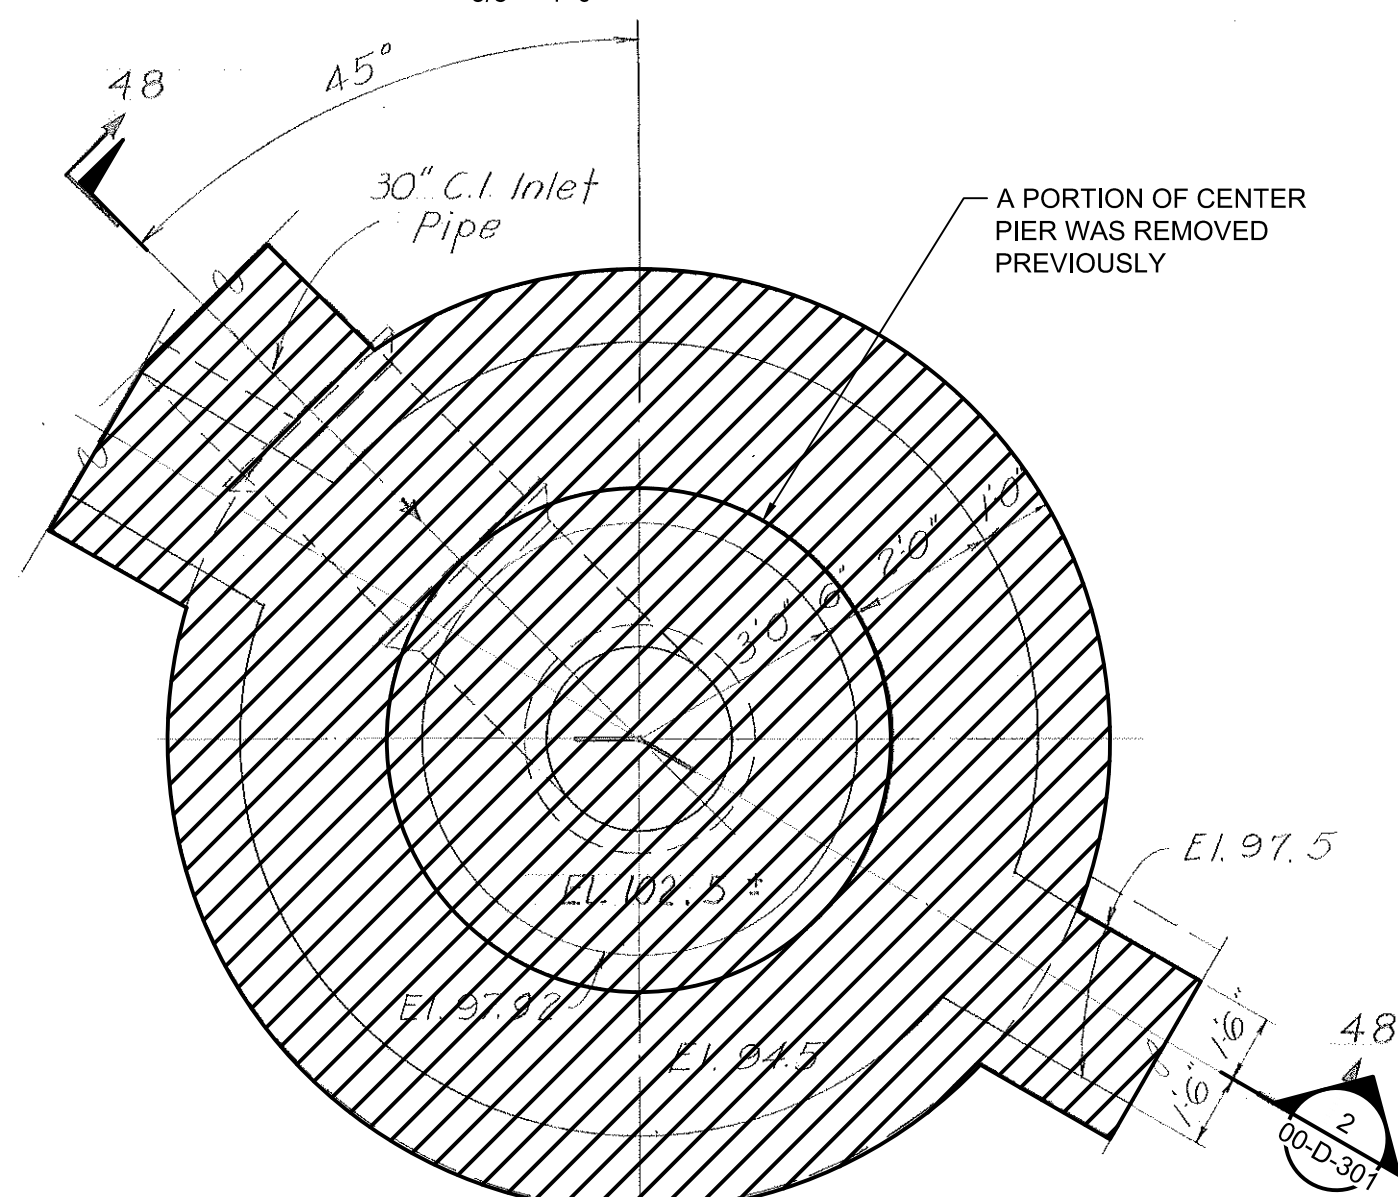

PLAN OF CENTER PIER

3/8" = 1'-0"

(SCALE BAR IS 4" AT FULL SCALE) 0 1/2 1 2 3 4

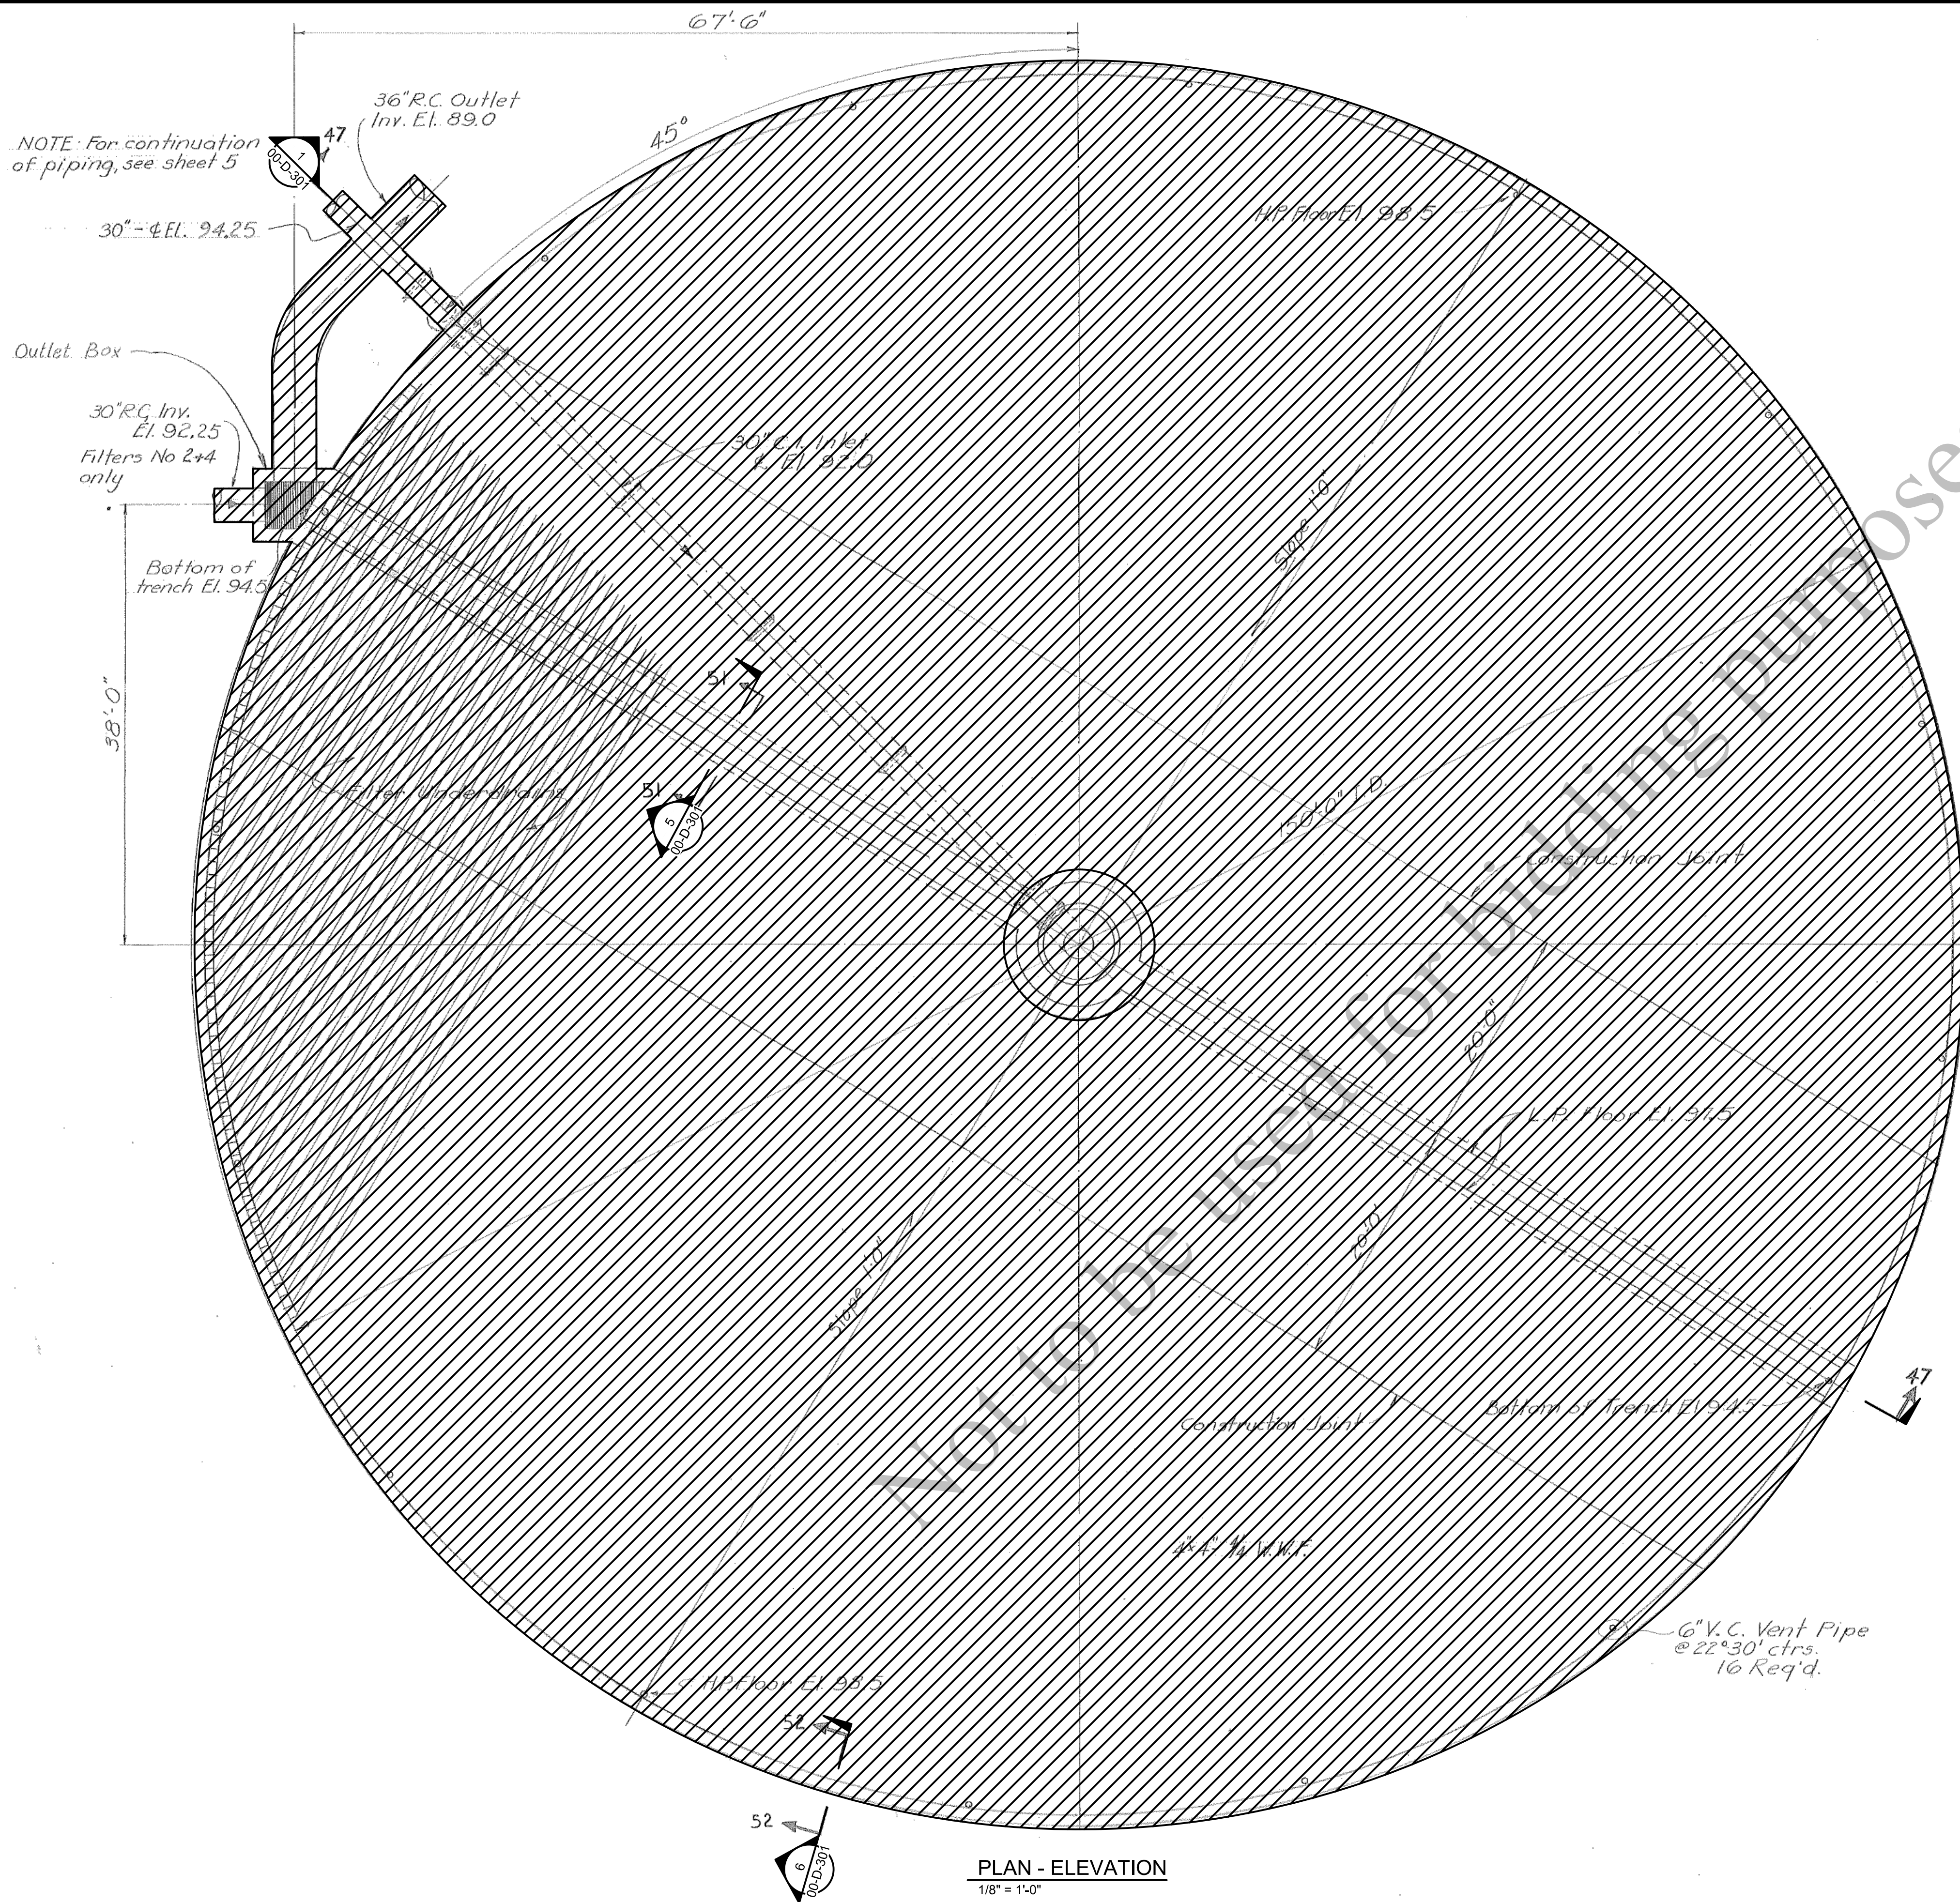

PLAN - ELEVATION

1/8" = 1'-0"

NOTE: For continuation
of piping, see sheet 5

30" C.I. El. 94.25

Outlet Box

30" R.C. Inv.
El. 92.25
Filters No 2+4
onlyBottom of
trench El. 94.5

AEROBIC GRANULAR
SLUDGE - PHASE 1

REVISIONS AND RECORD OF ISSUE


DESIGNED:	SM
DETAILED:	AB
CHECKED:	AM/JH
APPROVED:	MR
DATE:	12/20/2022
PROJECT NO.:	411752

GENERAL

DEMOLITION


TRICKLING FILTER
PUMPING STATION PLAN

00-D-103

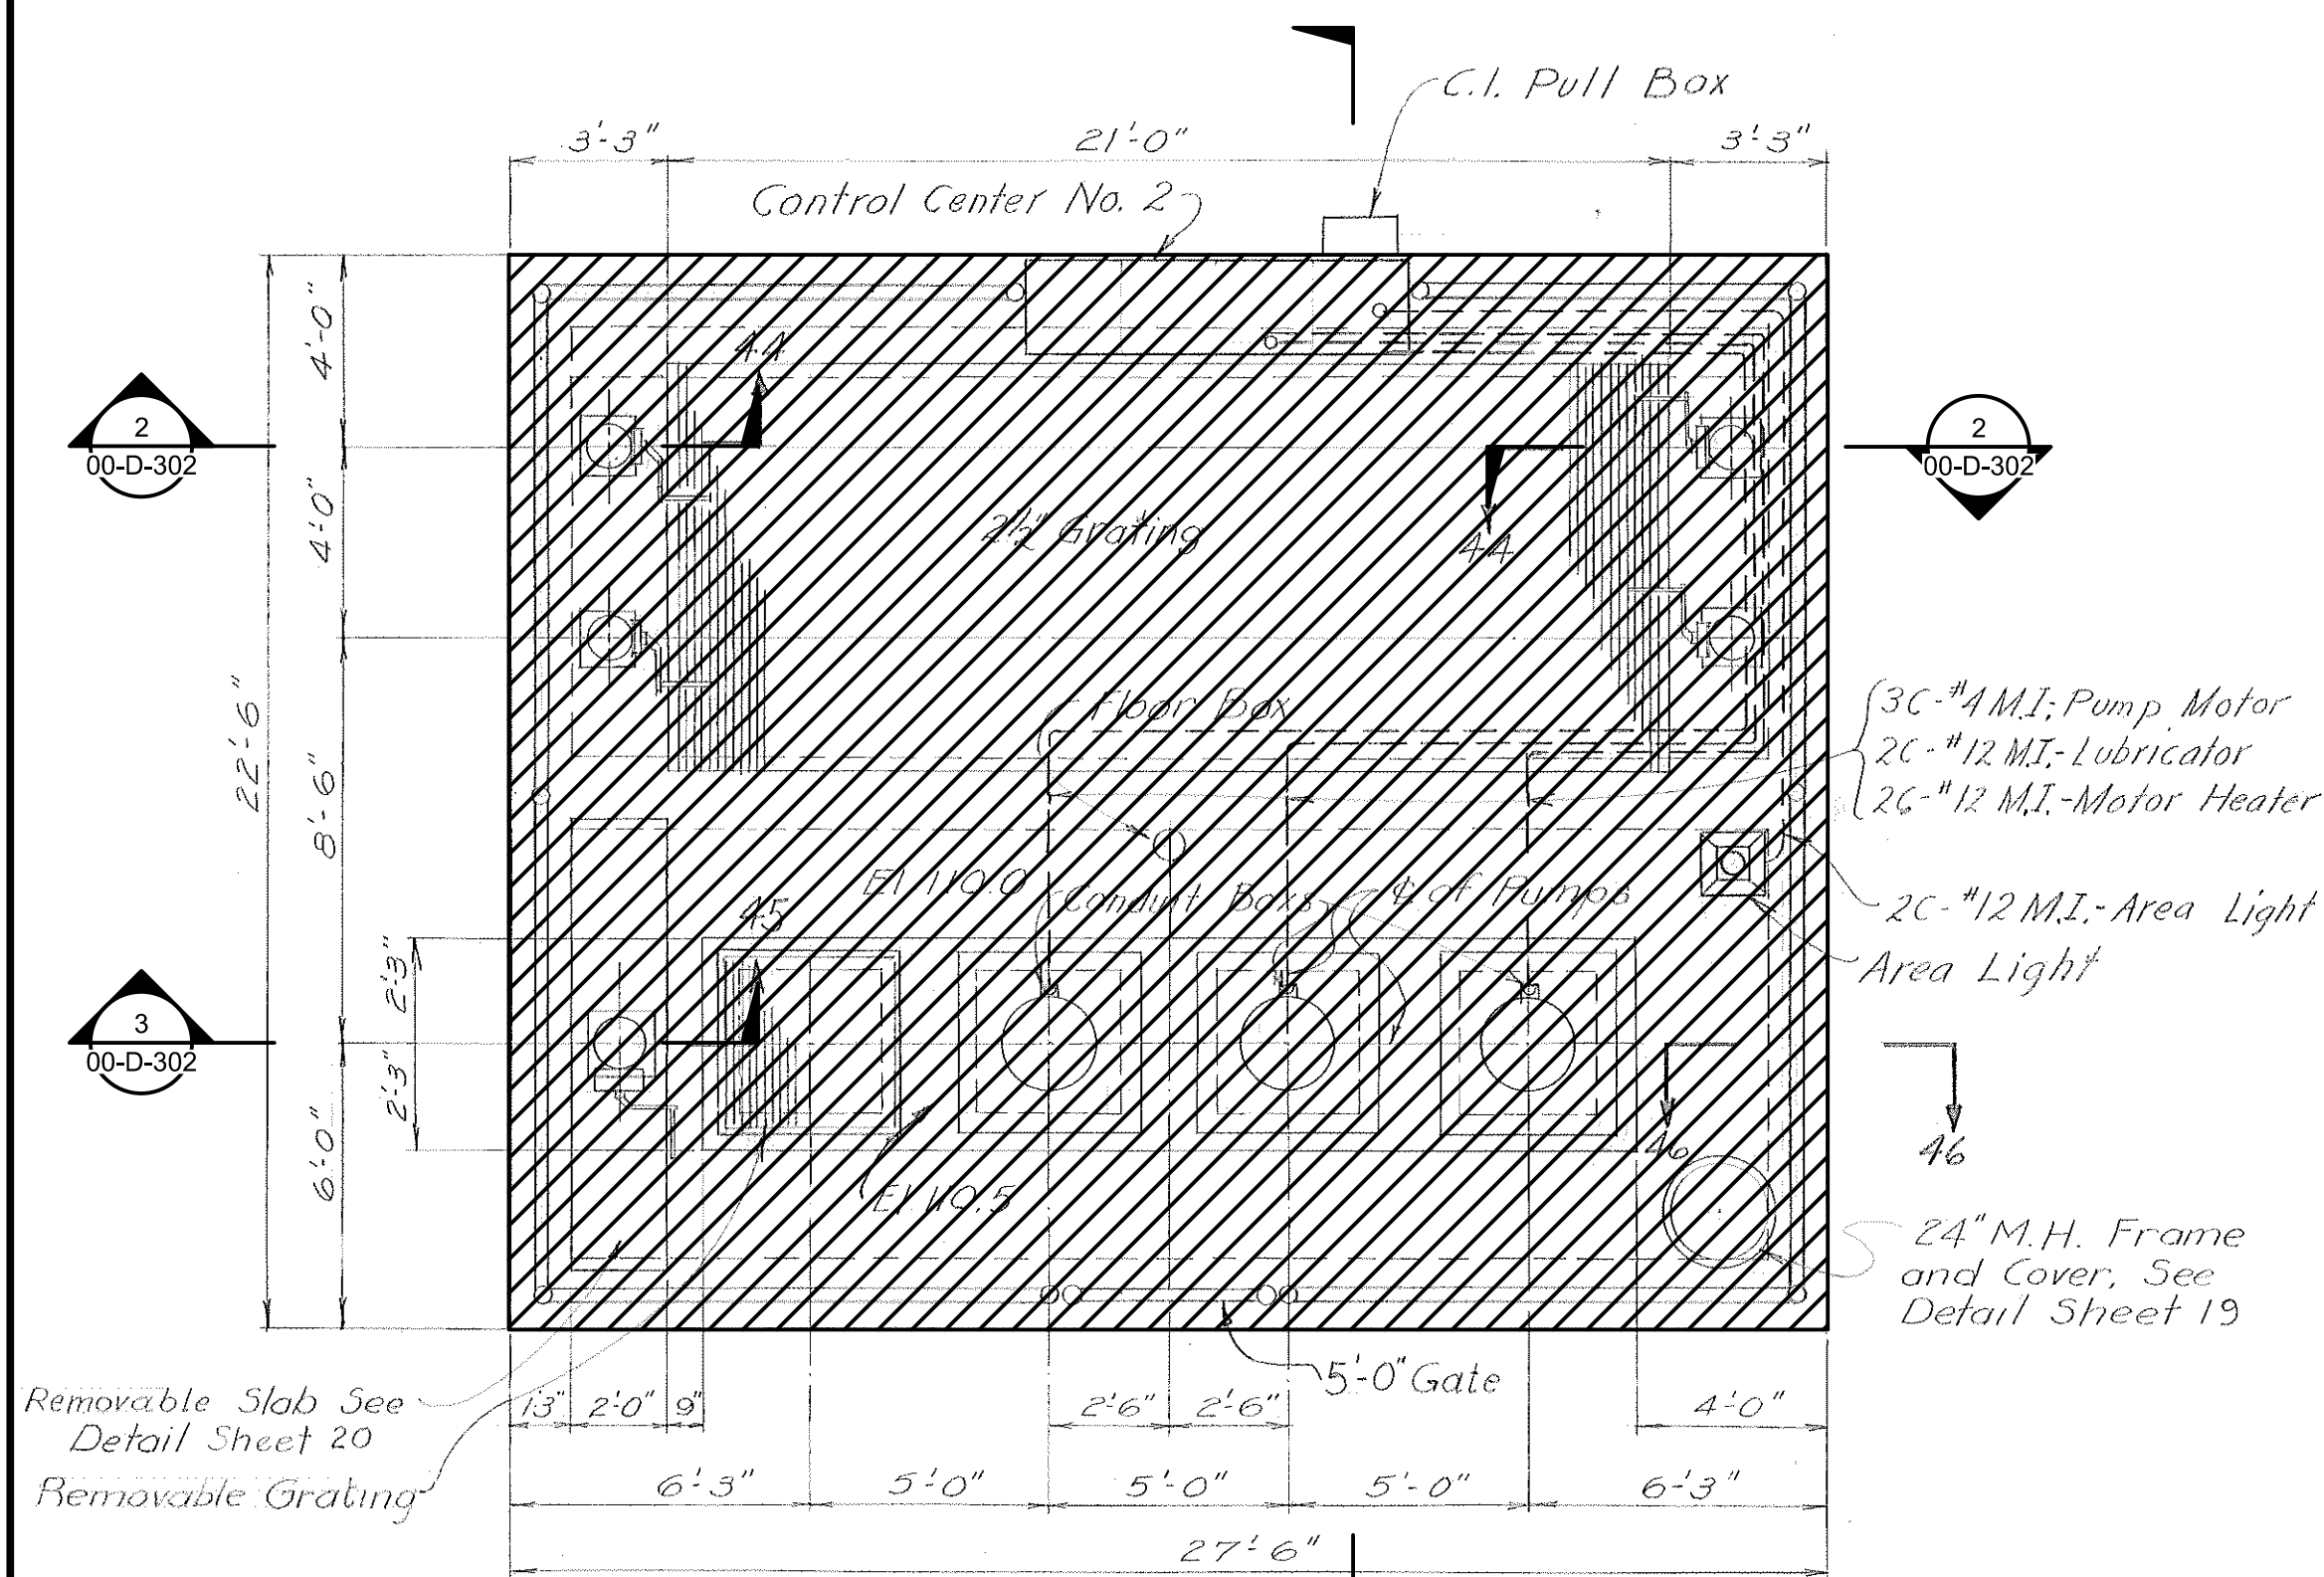23
OF
163


PLAN - ELEVATION 110.0

1/4" = 1'-0"

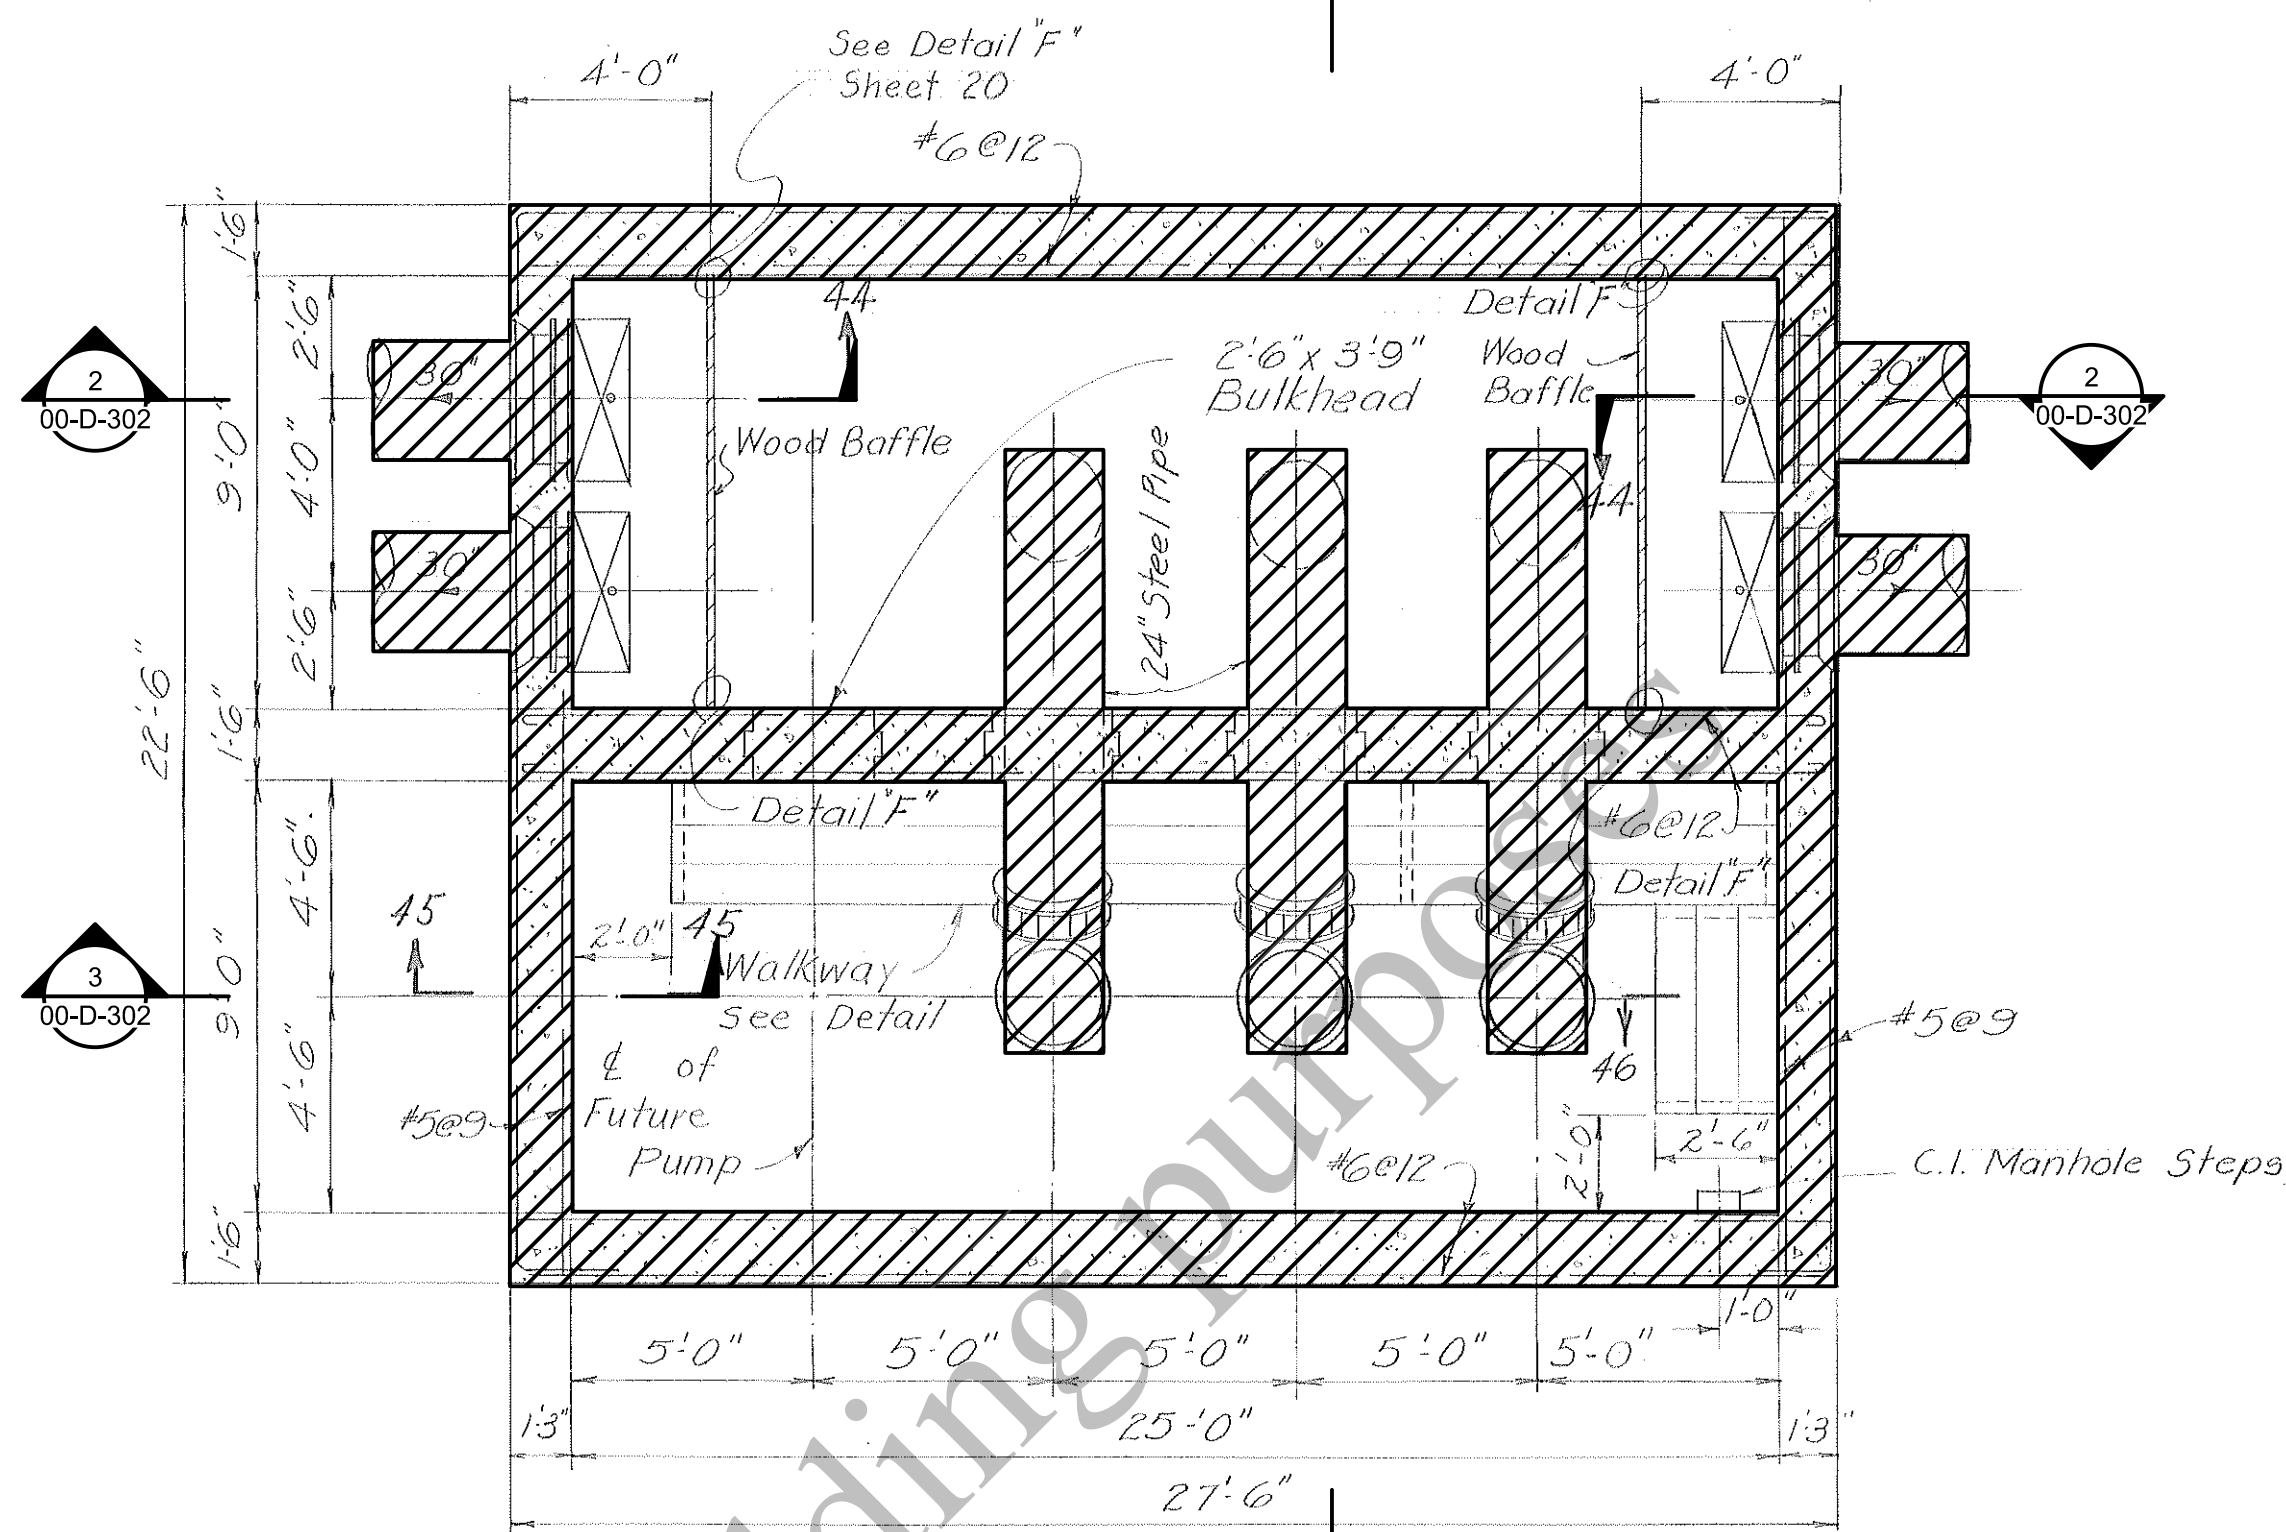


PLAN - ELEVATION 108.0

1/4" = 1'-0"

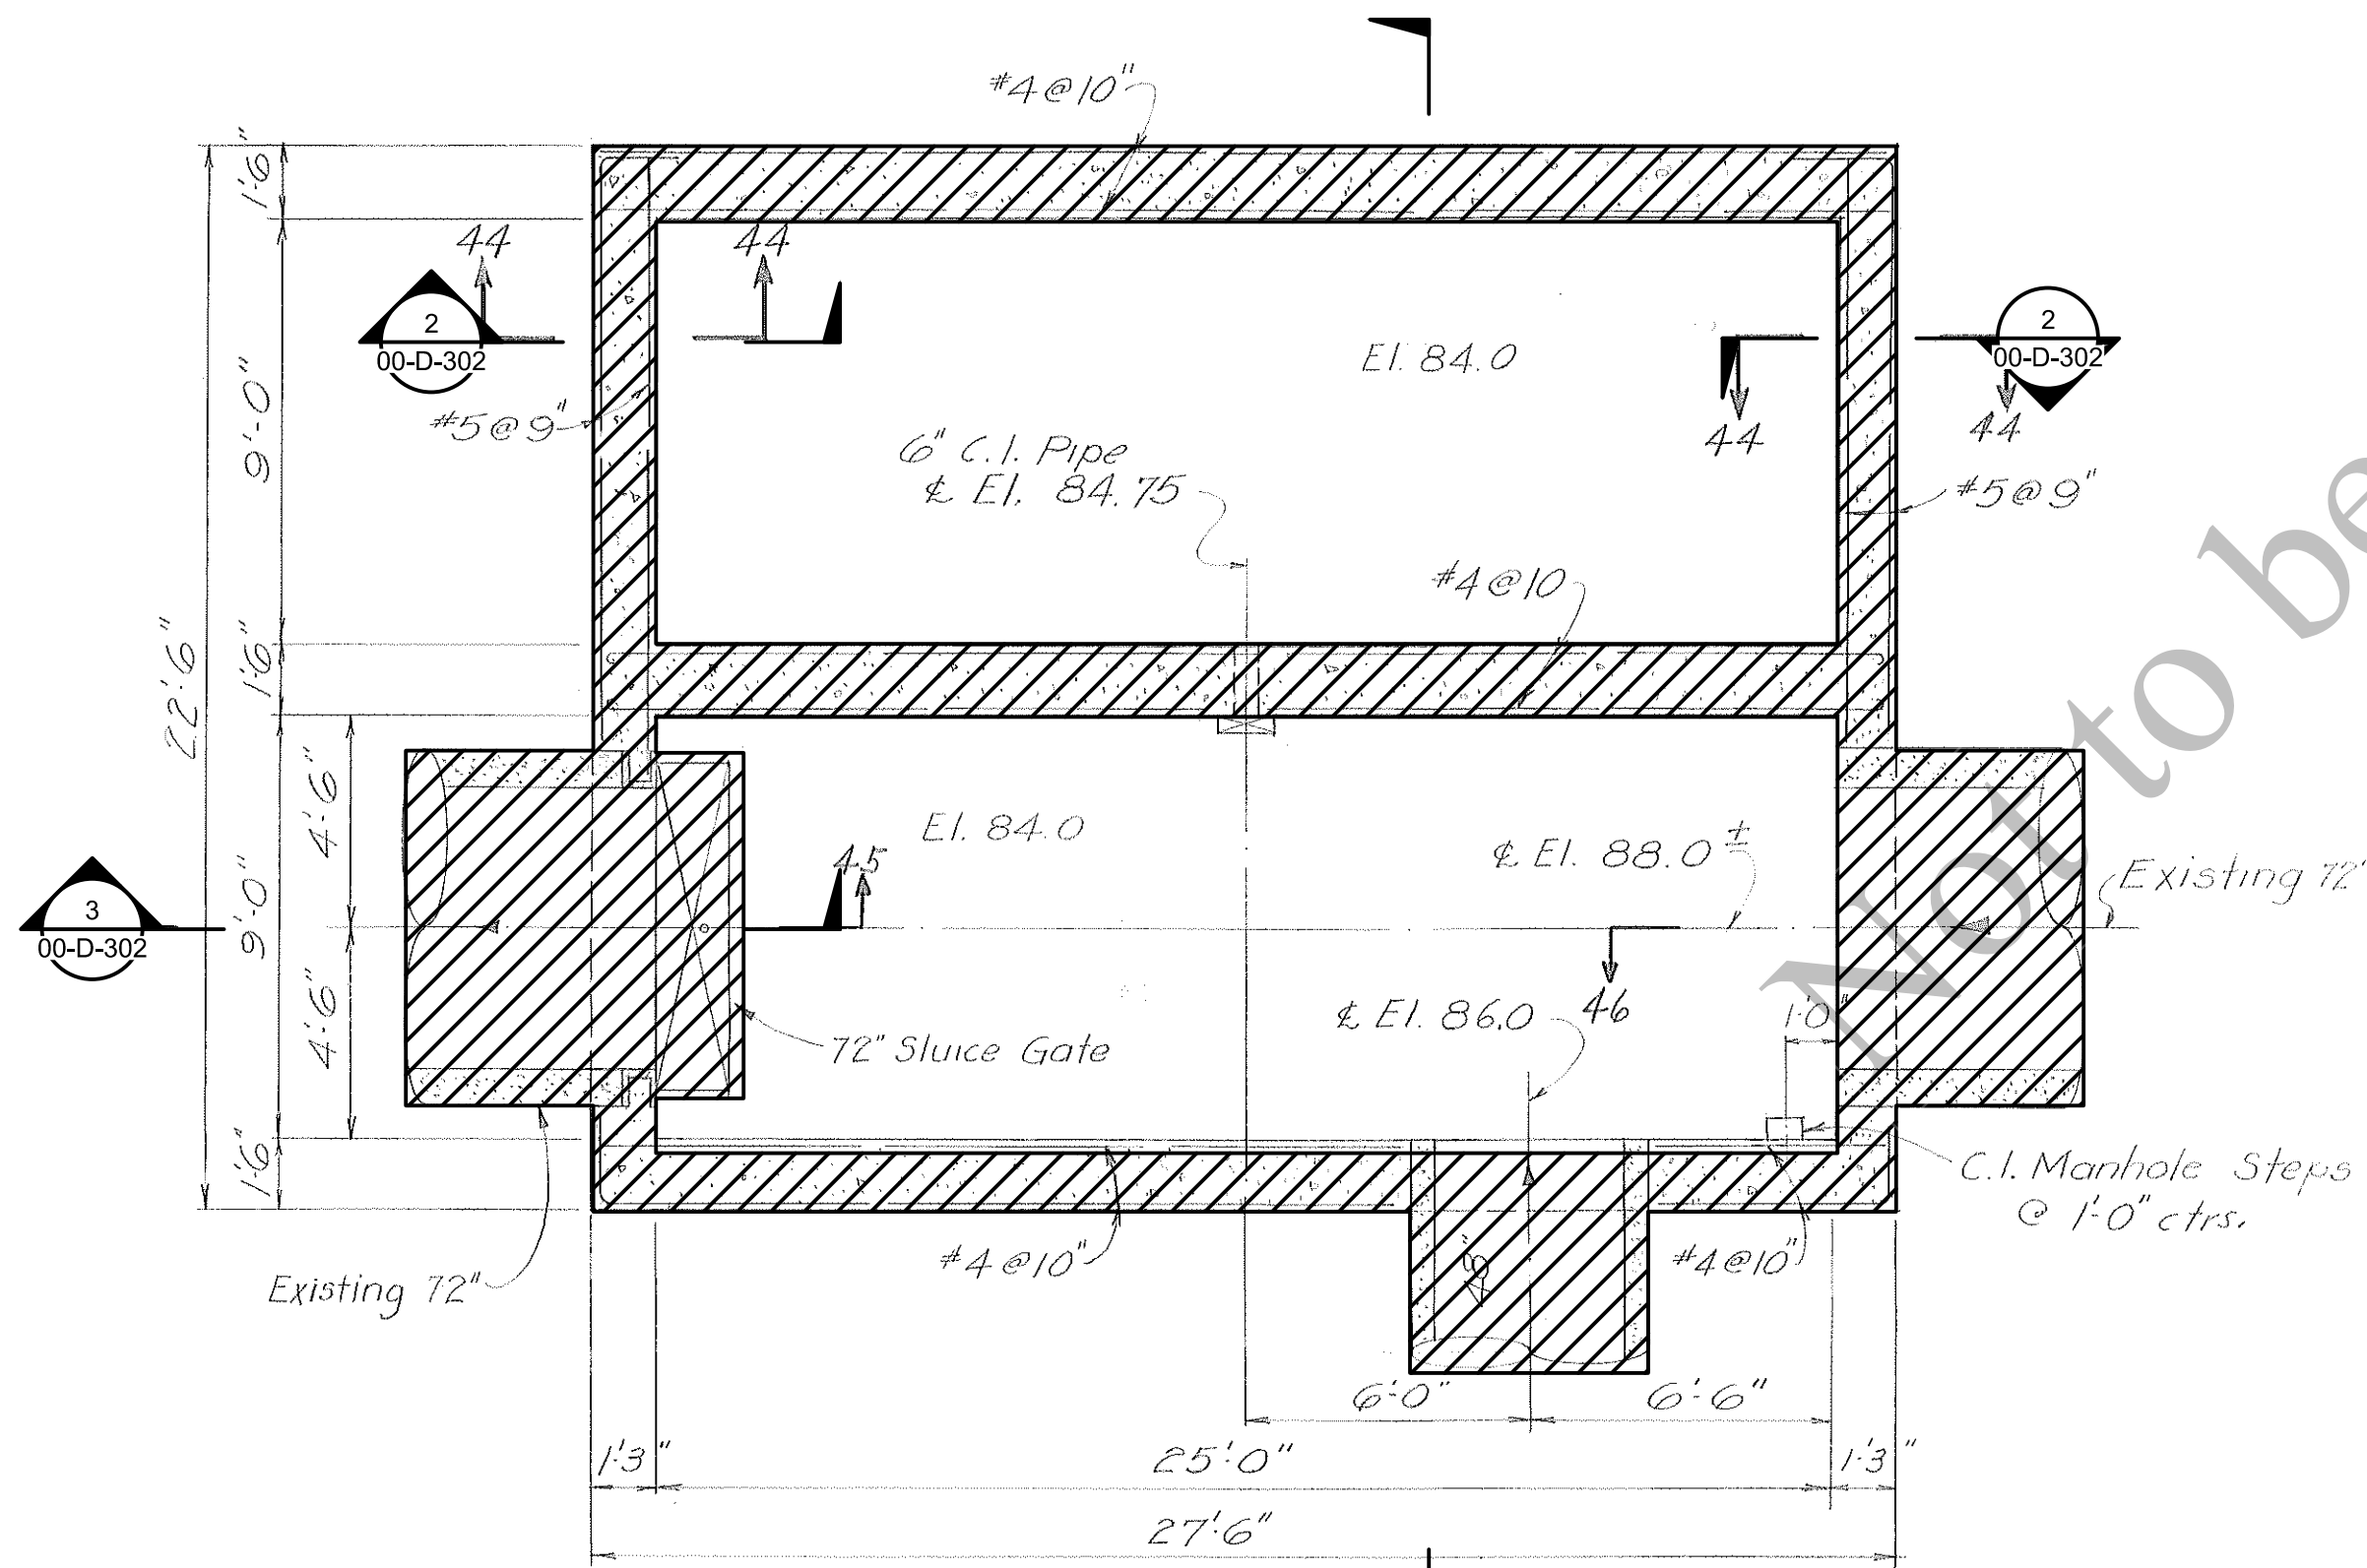

PLAN - ELEVATION 88.0

1/4" = 1'-0"

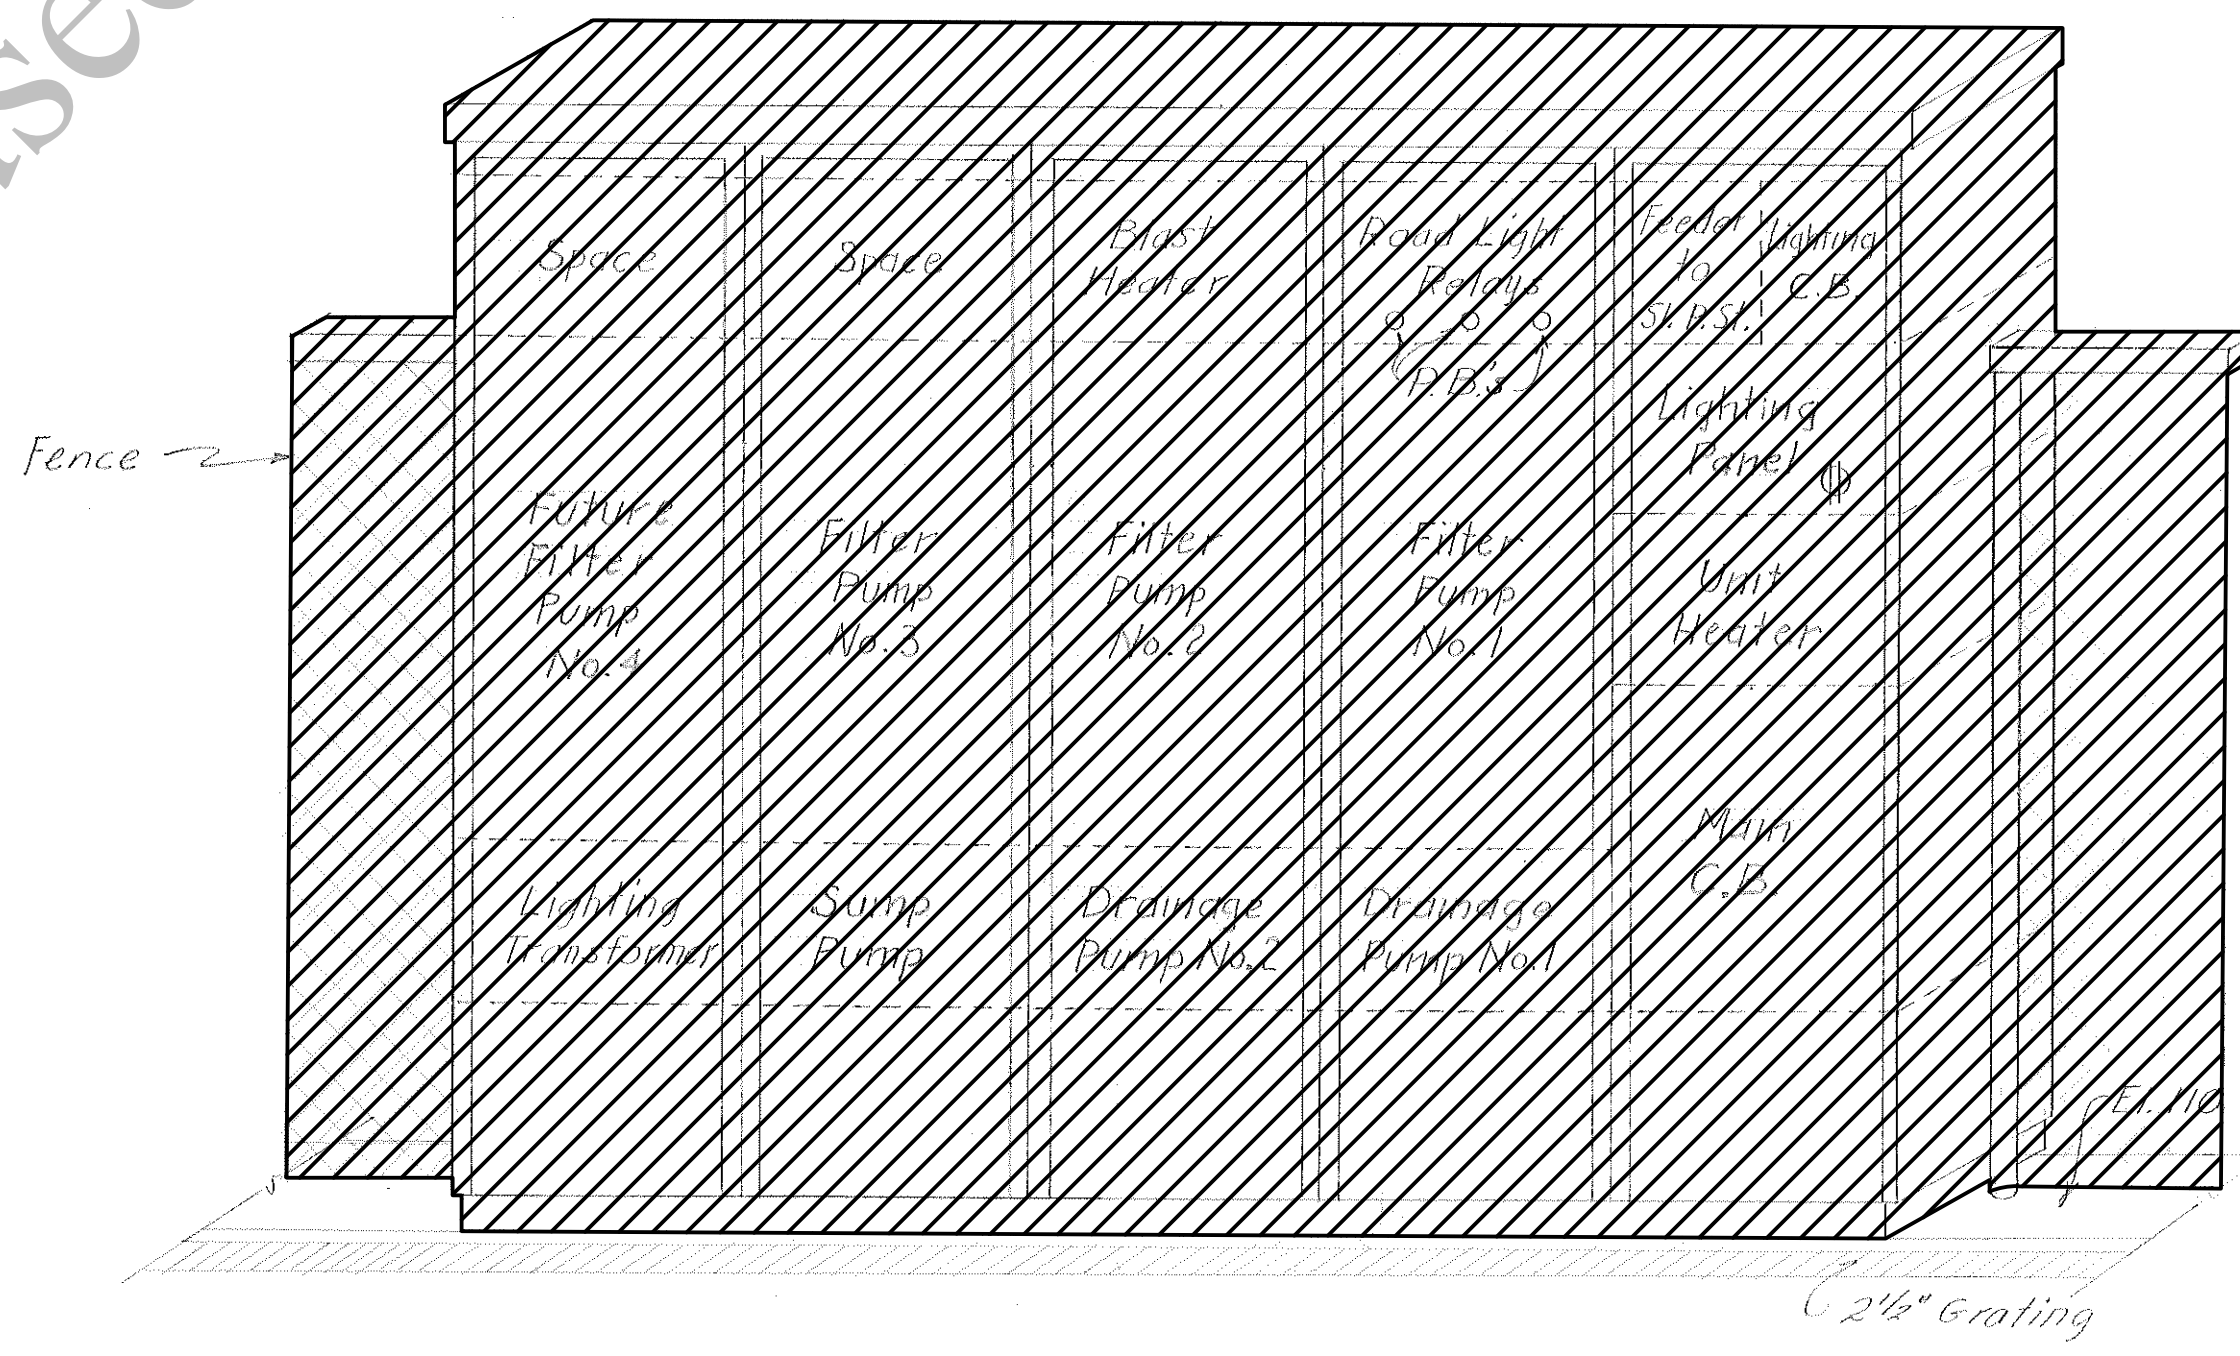

CONTROL CENTER NO. 2

NTS

NOTES:

1. REFER TO DWG 00-D-101 FOR GENERAL REMOVAL NOTES.
2. BECAUSE AN IMAGE FROM A RECORD DRAWING IS USED TO SHOW THE EXTENT OF DEMOLITION, THIS DRAWING IS NOT TO SCALE. CONTRACTOR SHALL FOLLOW THE DIMENSIONS SPECIFIED IN THE IMAGE.
3. CONVERT ELEVATIONS INDICATED ON RECORD DRAWING BACKGROUND IMAGES TO THE PROJECT DATUM BY ADDING 602.58. FOR EXAMPLE, RECORD DRAWING ELEVATION 90.6 EQUALS PROJECT DATUM ELEVATION 693.18.
4. CONTRACTOR TO FIELD VERIFY ALL DIMENSIONS AND ELEVATIONS.

LEGEND:


ITEMS OR AREAS TO BE DEMOLISHED



NOTES:

1. REFER TO DWG 00-D-101 FOR GENERAL REMOVAL NOTES.
2. BECAUSE AN IMAGE FROM A RECORD DRAWING IS USED TO SHOW THE EXTENT OF DEMOLITION, THIS DRAWING IS NOT TO SCALE. CONTRACTOR SHALL FOLLOW THE DIMENSIONS SPECIFIED IN THE IMAGE.
3. CONVERT ELEVATIONS INDICATED ON RECORD DRAWING BACKGROUND IMAGES TO THE PROJECT DATUM BY ADDING 602.58. FOR EXAMPLE, RECORD DRAWING ELEVATION 90.6 EQUALS PROJECT DATUM ELEVATION 93.18.
4. CONTRACTOR TO FIELD VERIFY ALL DIMENSIONS AND ELEVATIONS.

LEGEND:

 ITEMS OR AREAS TO BE DEMOLISHEDAEROBIC GRANULAR
SLUDGE - PHASE 1

REVISIONS AND RECORD OF ISSUE





DESIGNED:	SM
DETAILED:	AB
CHECKED:	AM/JH
APPROVED:	MR
DATE:	12/20/2022
PROJECT NO.:	411752

GENERAL

DEMOLITION

DRAINAGE PUMP STATION
PLAN

00-D-104

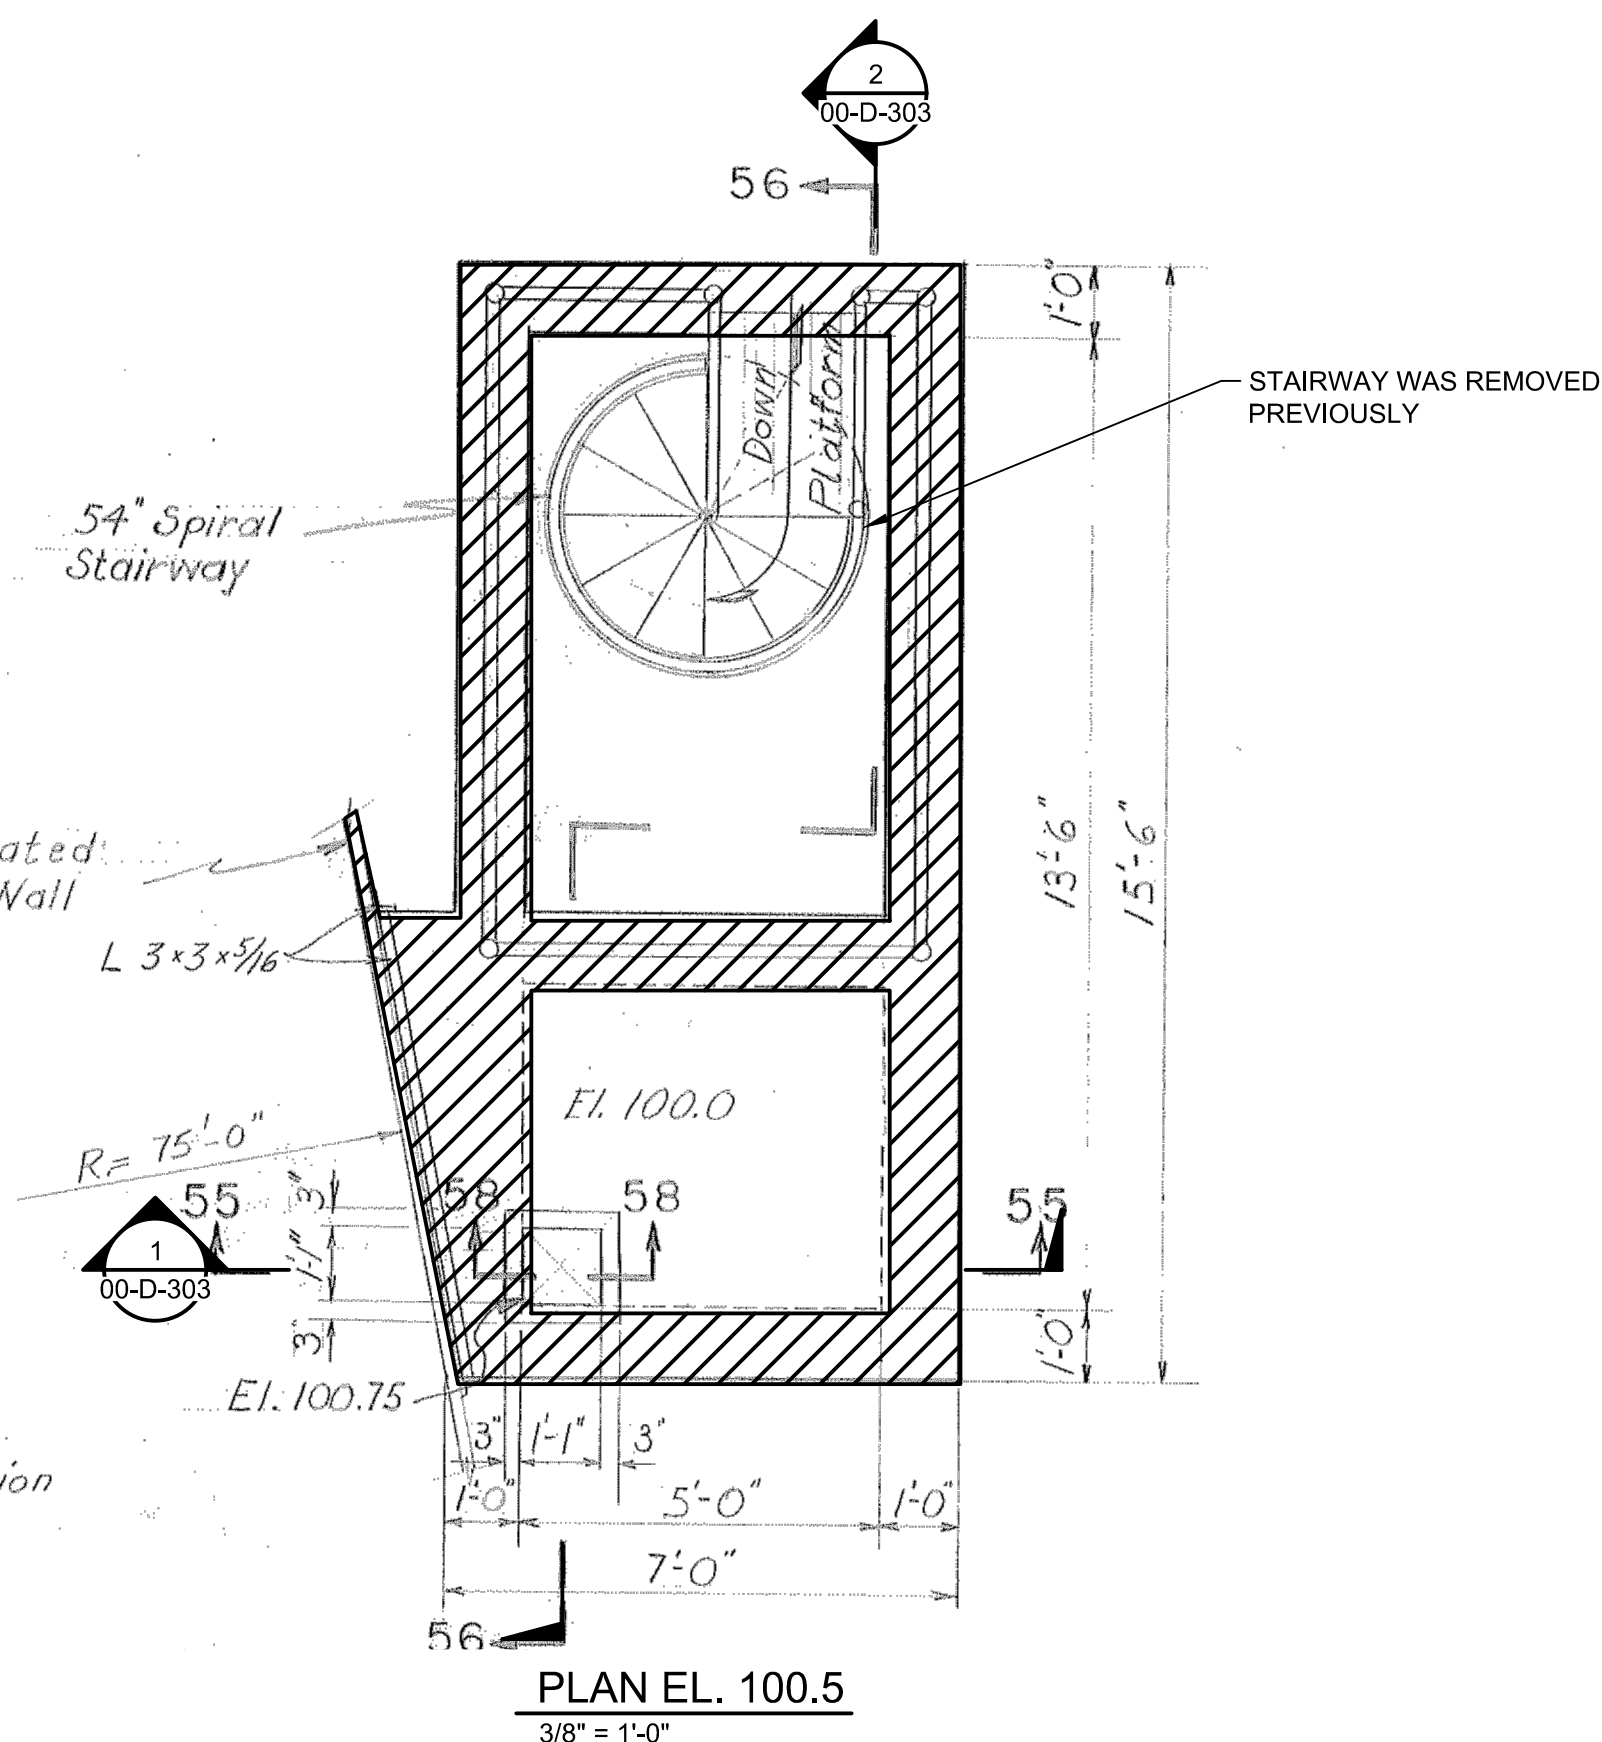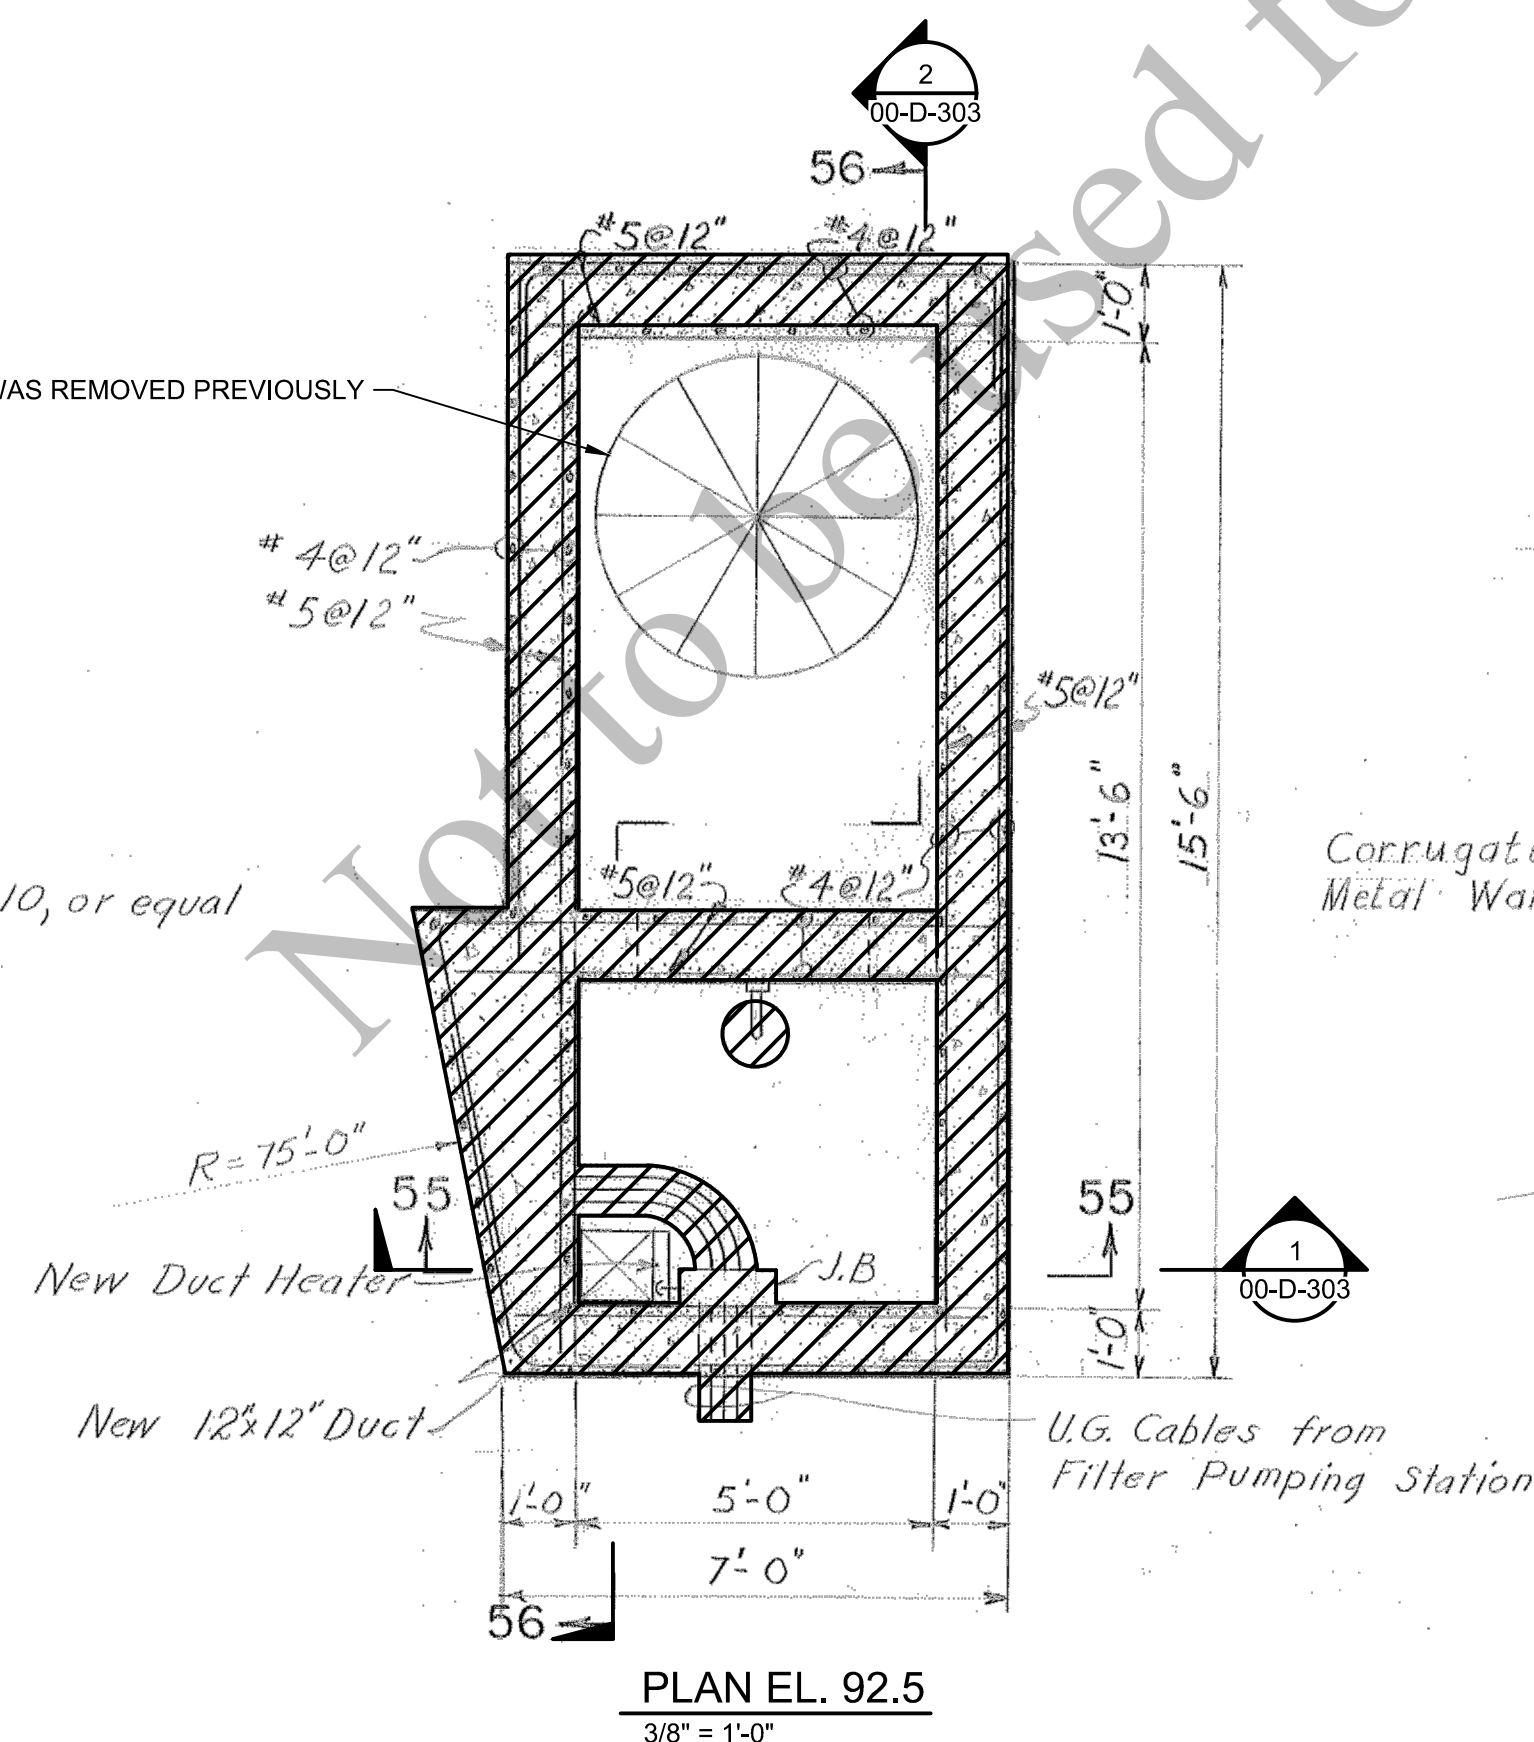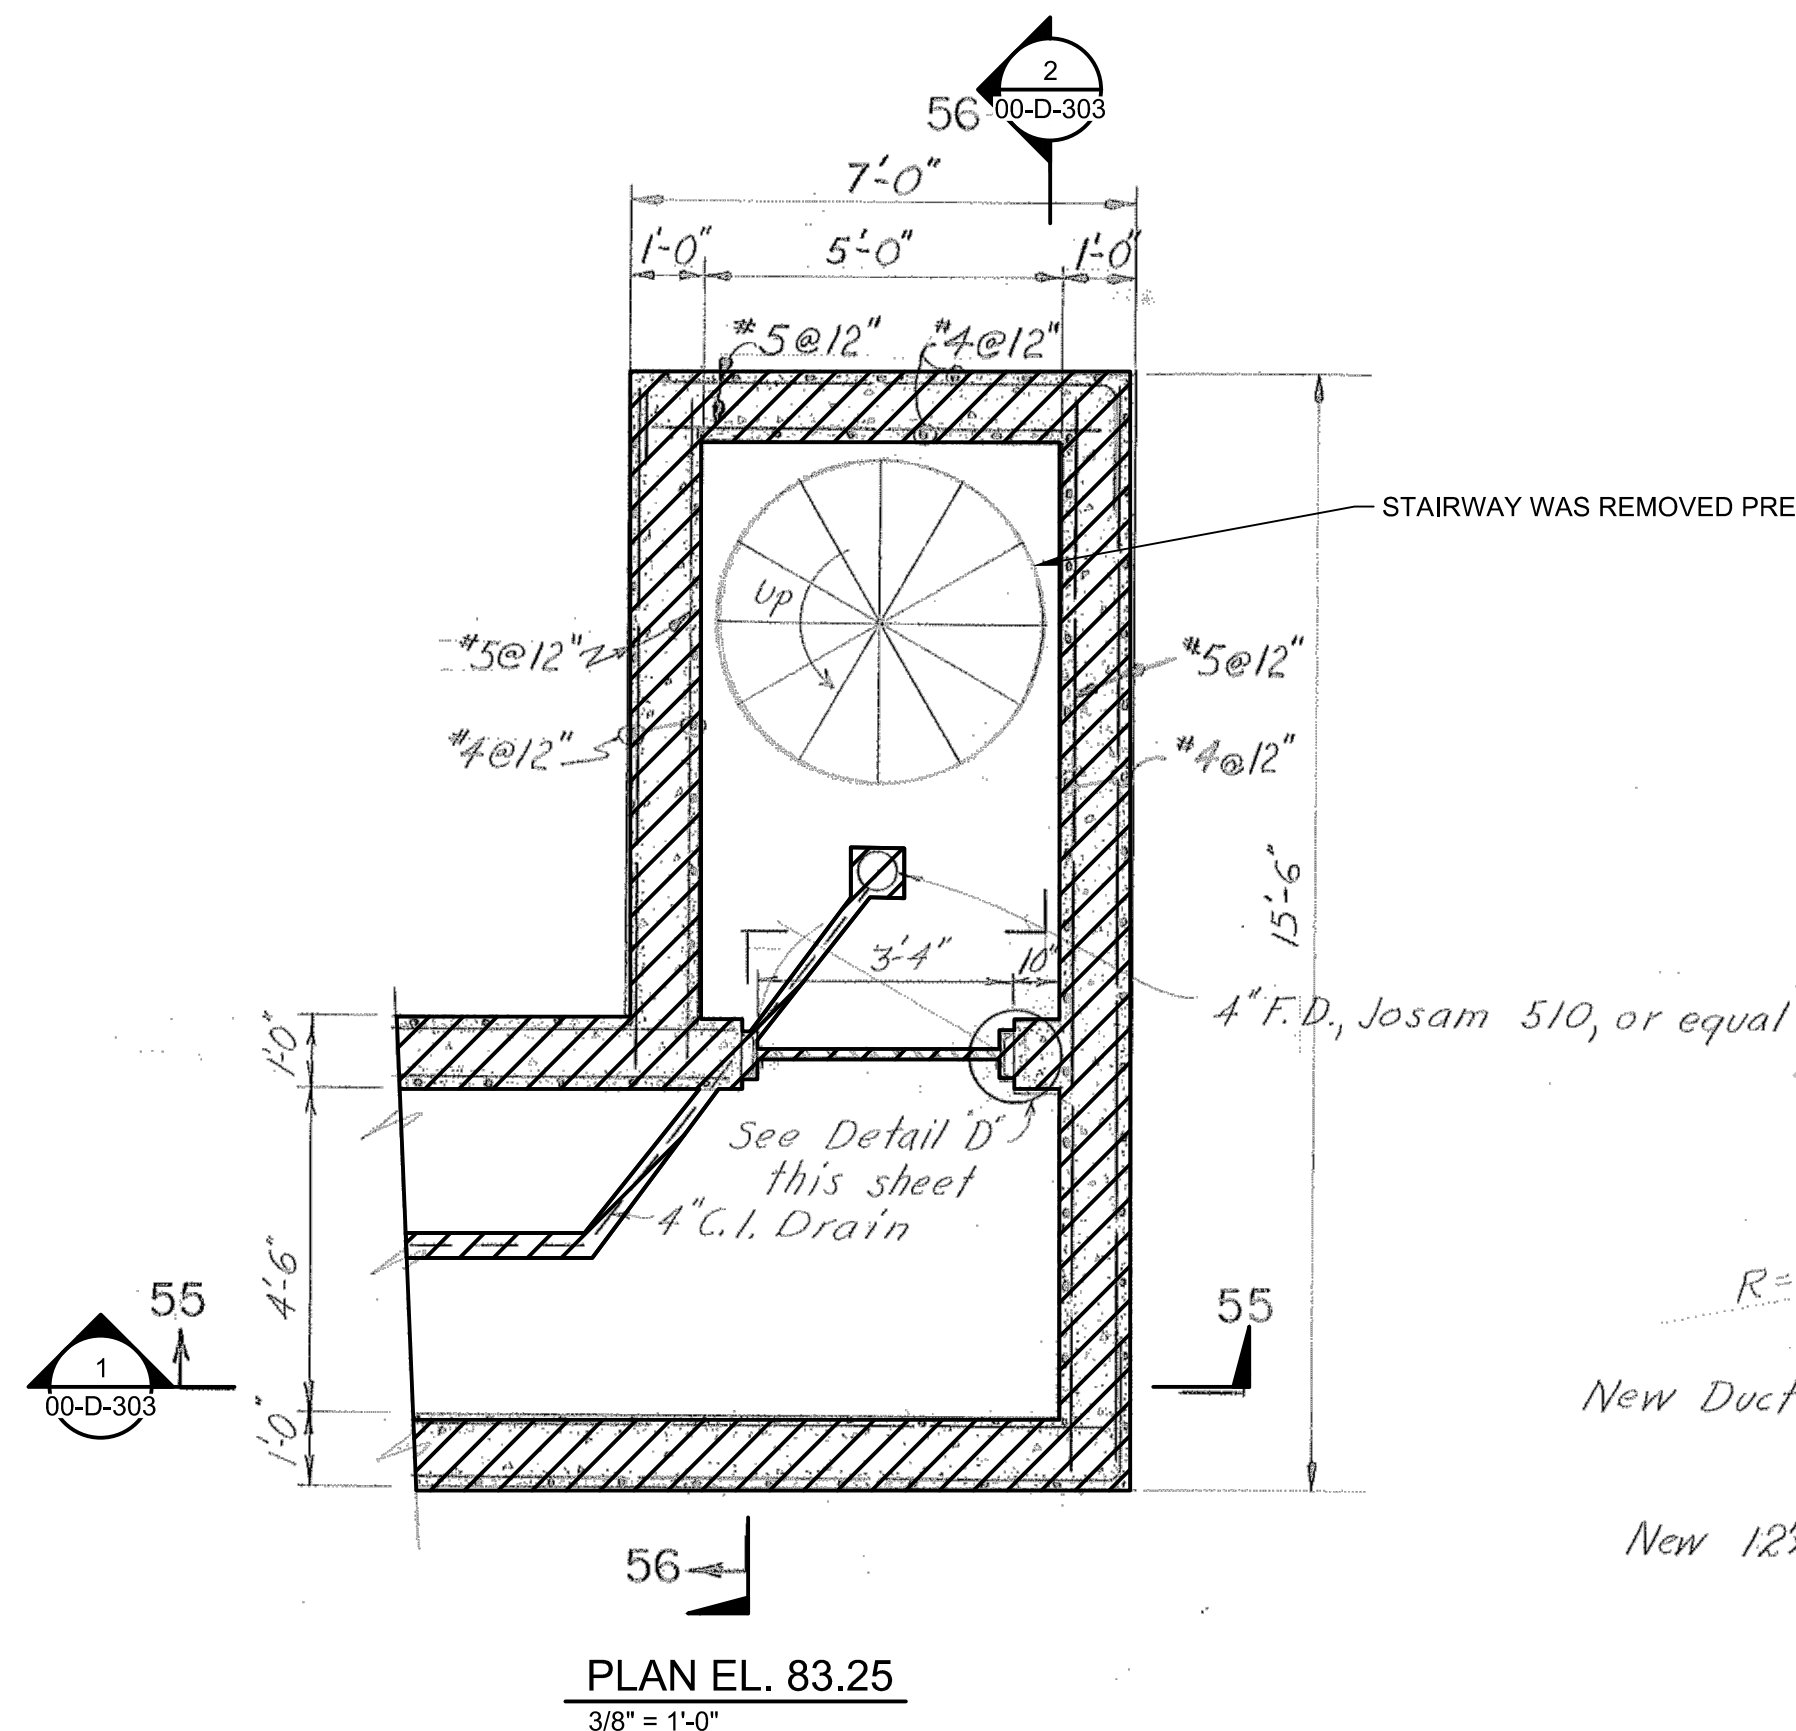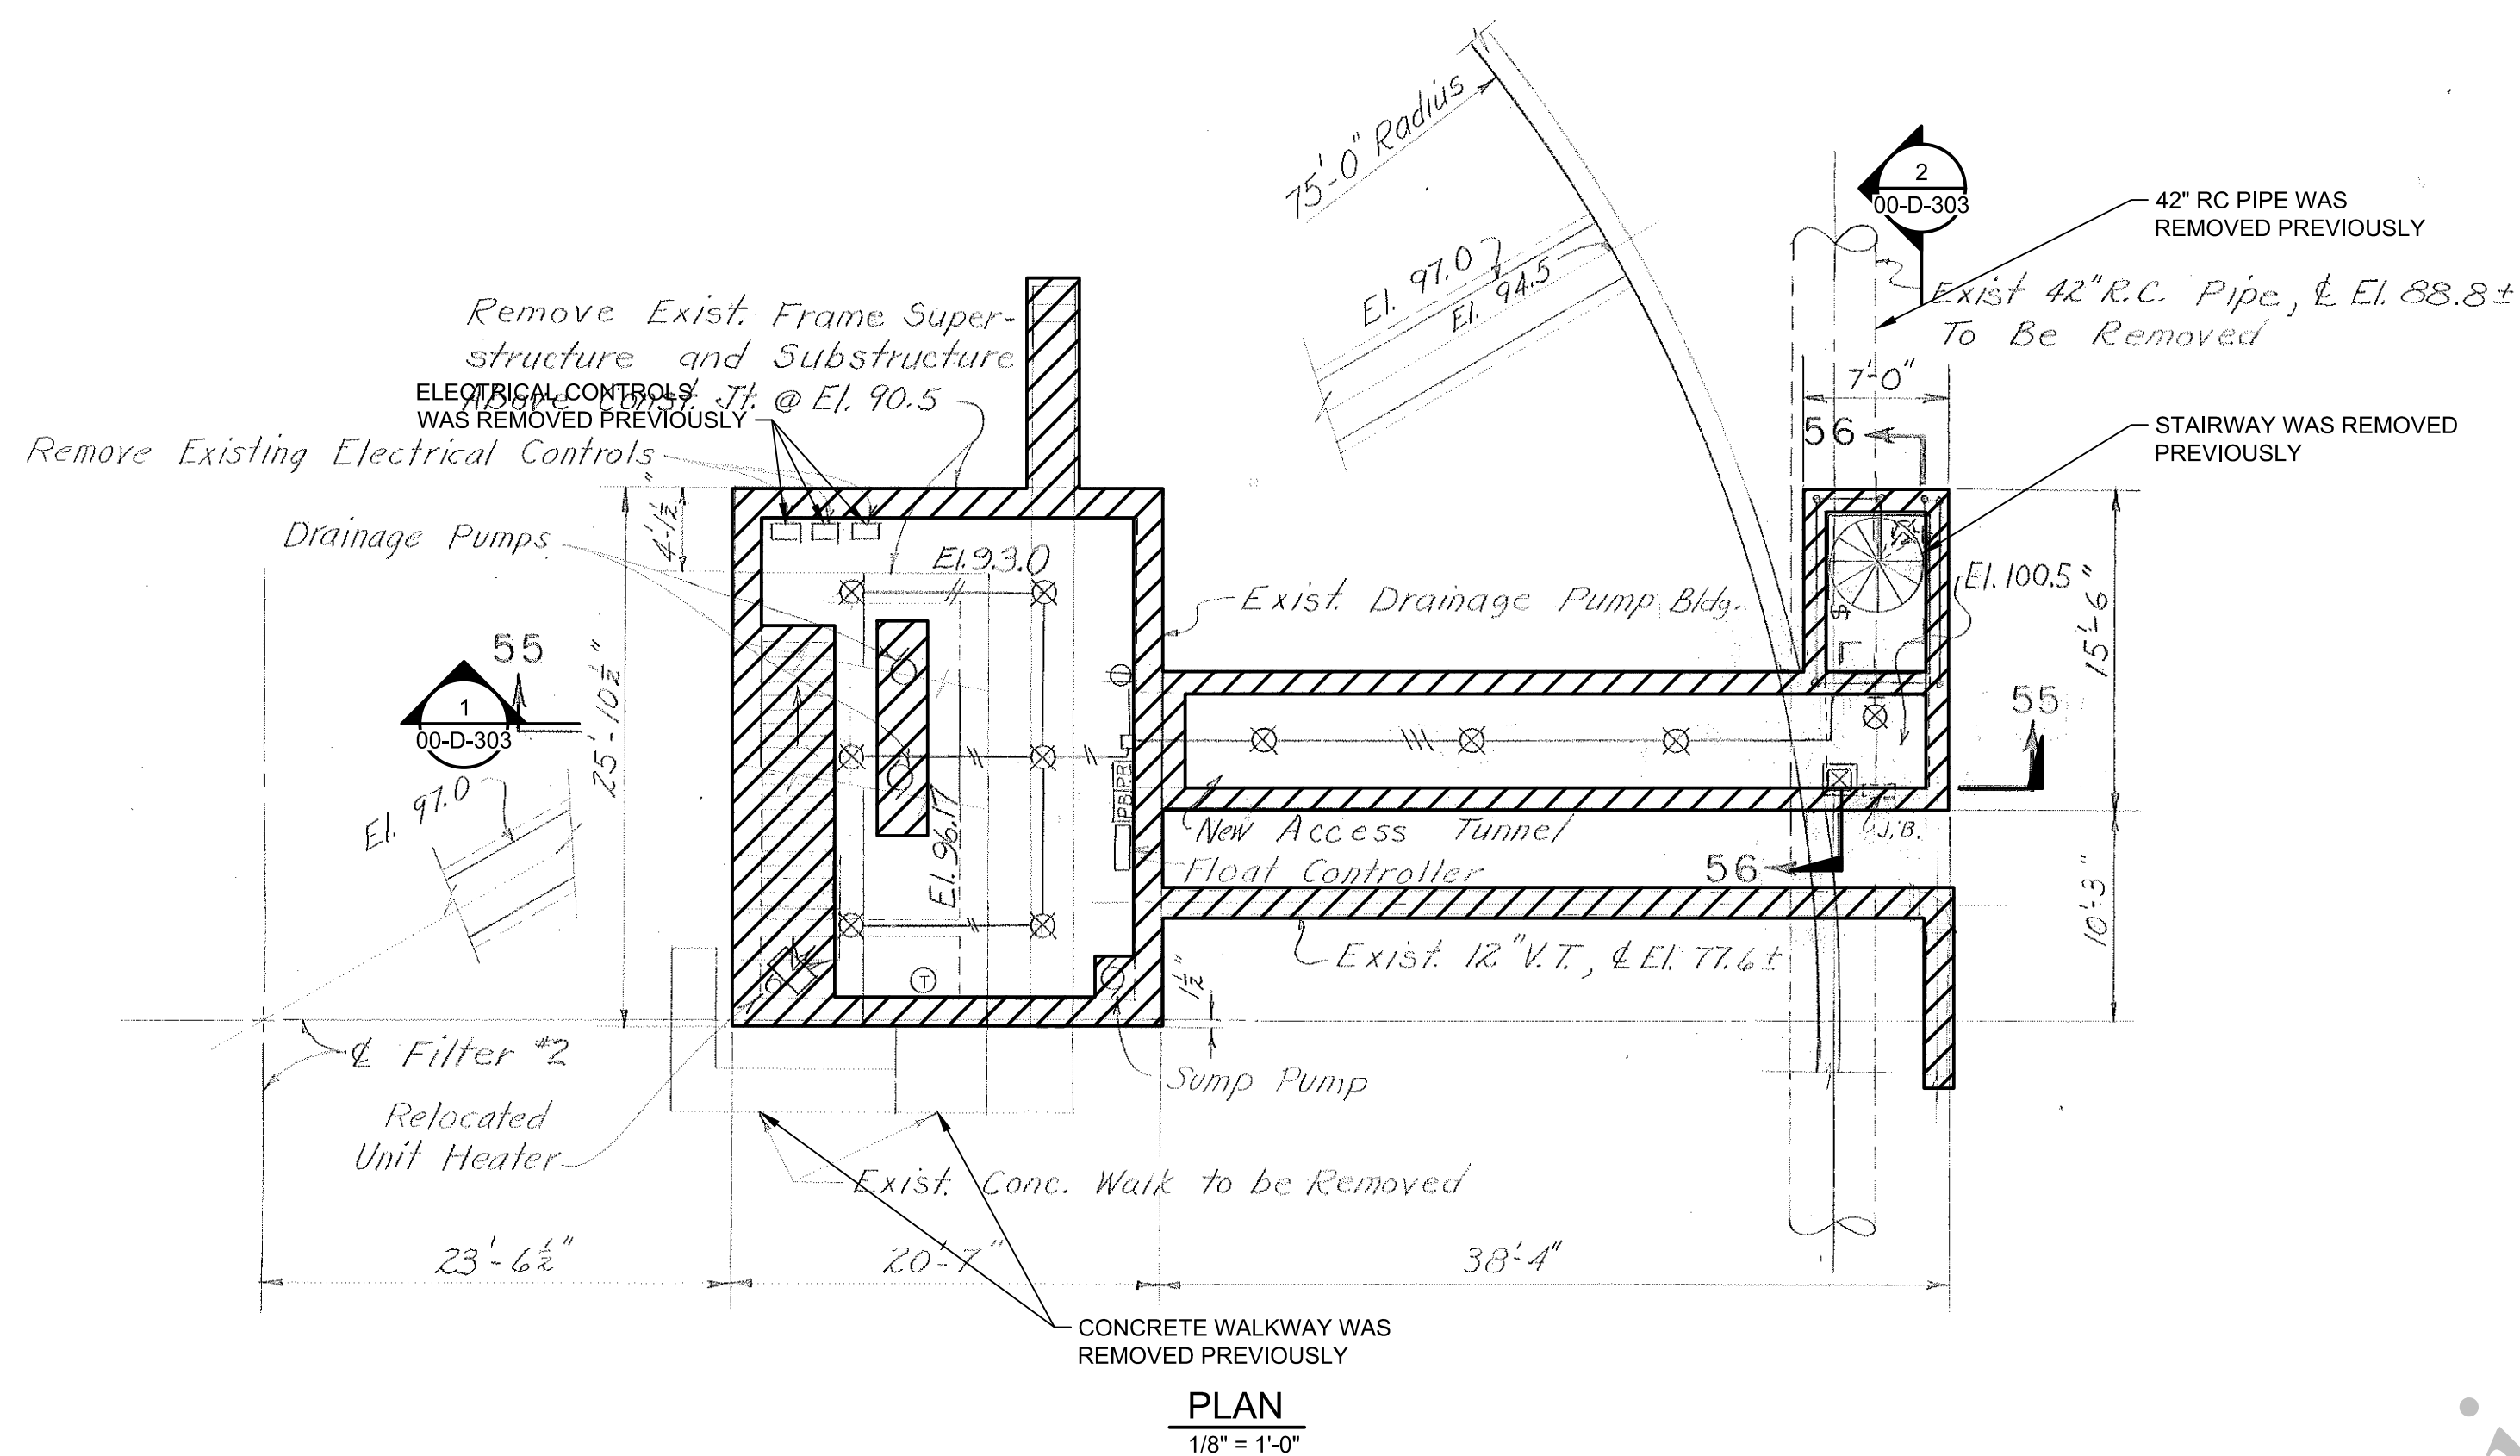24
OF
163

AEROBIC GRANULAR
SLUDGE - PHASE 1


REVISIONS AND RECORD OF ISSUE	
DESIGNED:	SM
DETAILED:	AB
CHECKED:	AM/JH
APPROVED:	MR
DATE:	12/20/2022
PROJECT NO.:	411752

GENERAL

EMOLITION

METER VAULT PLAN AND SECTIONS

00-D-105

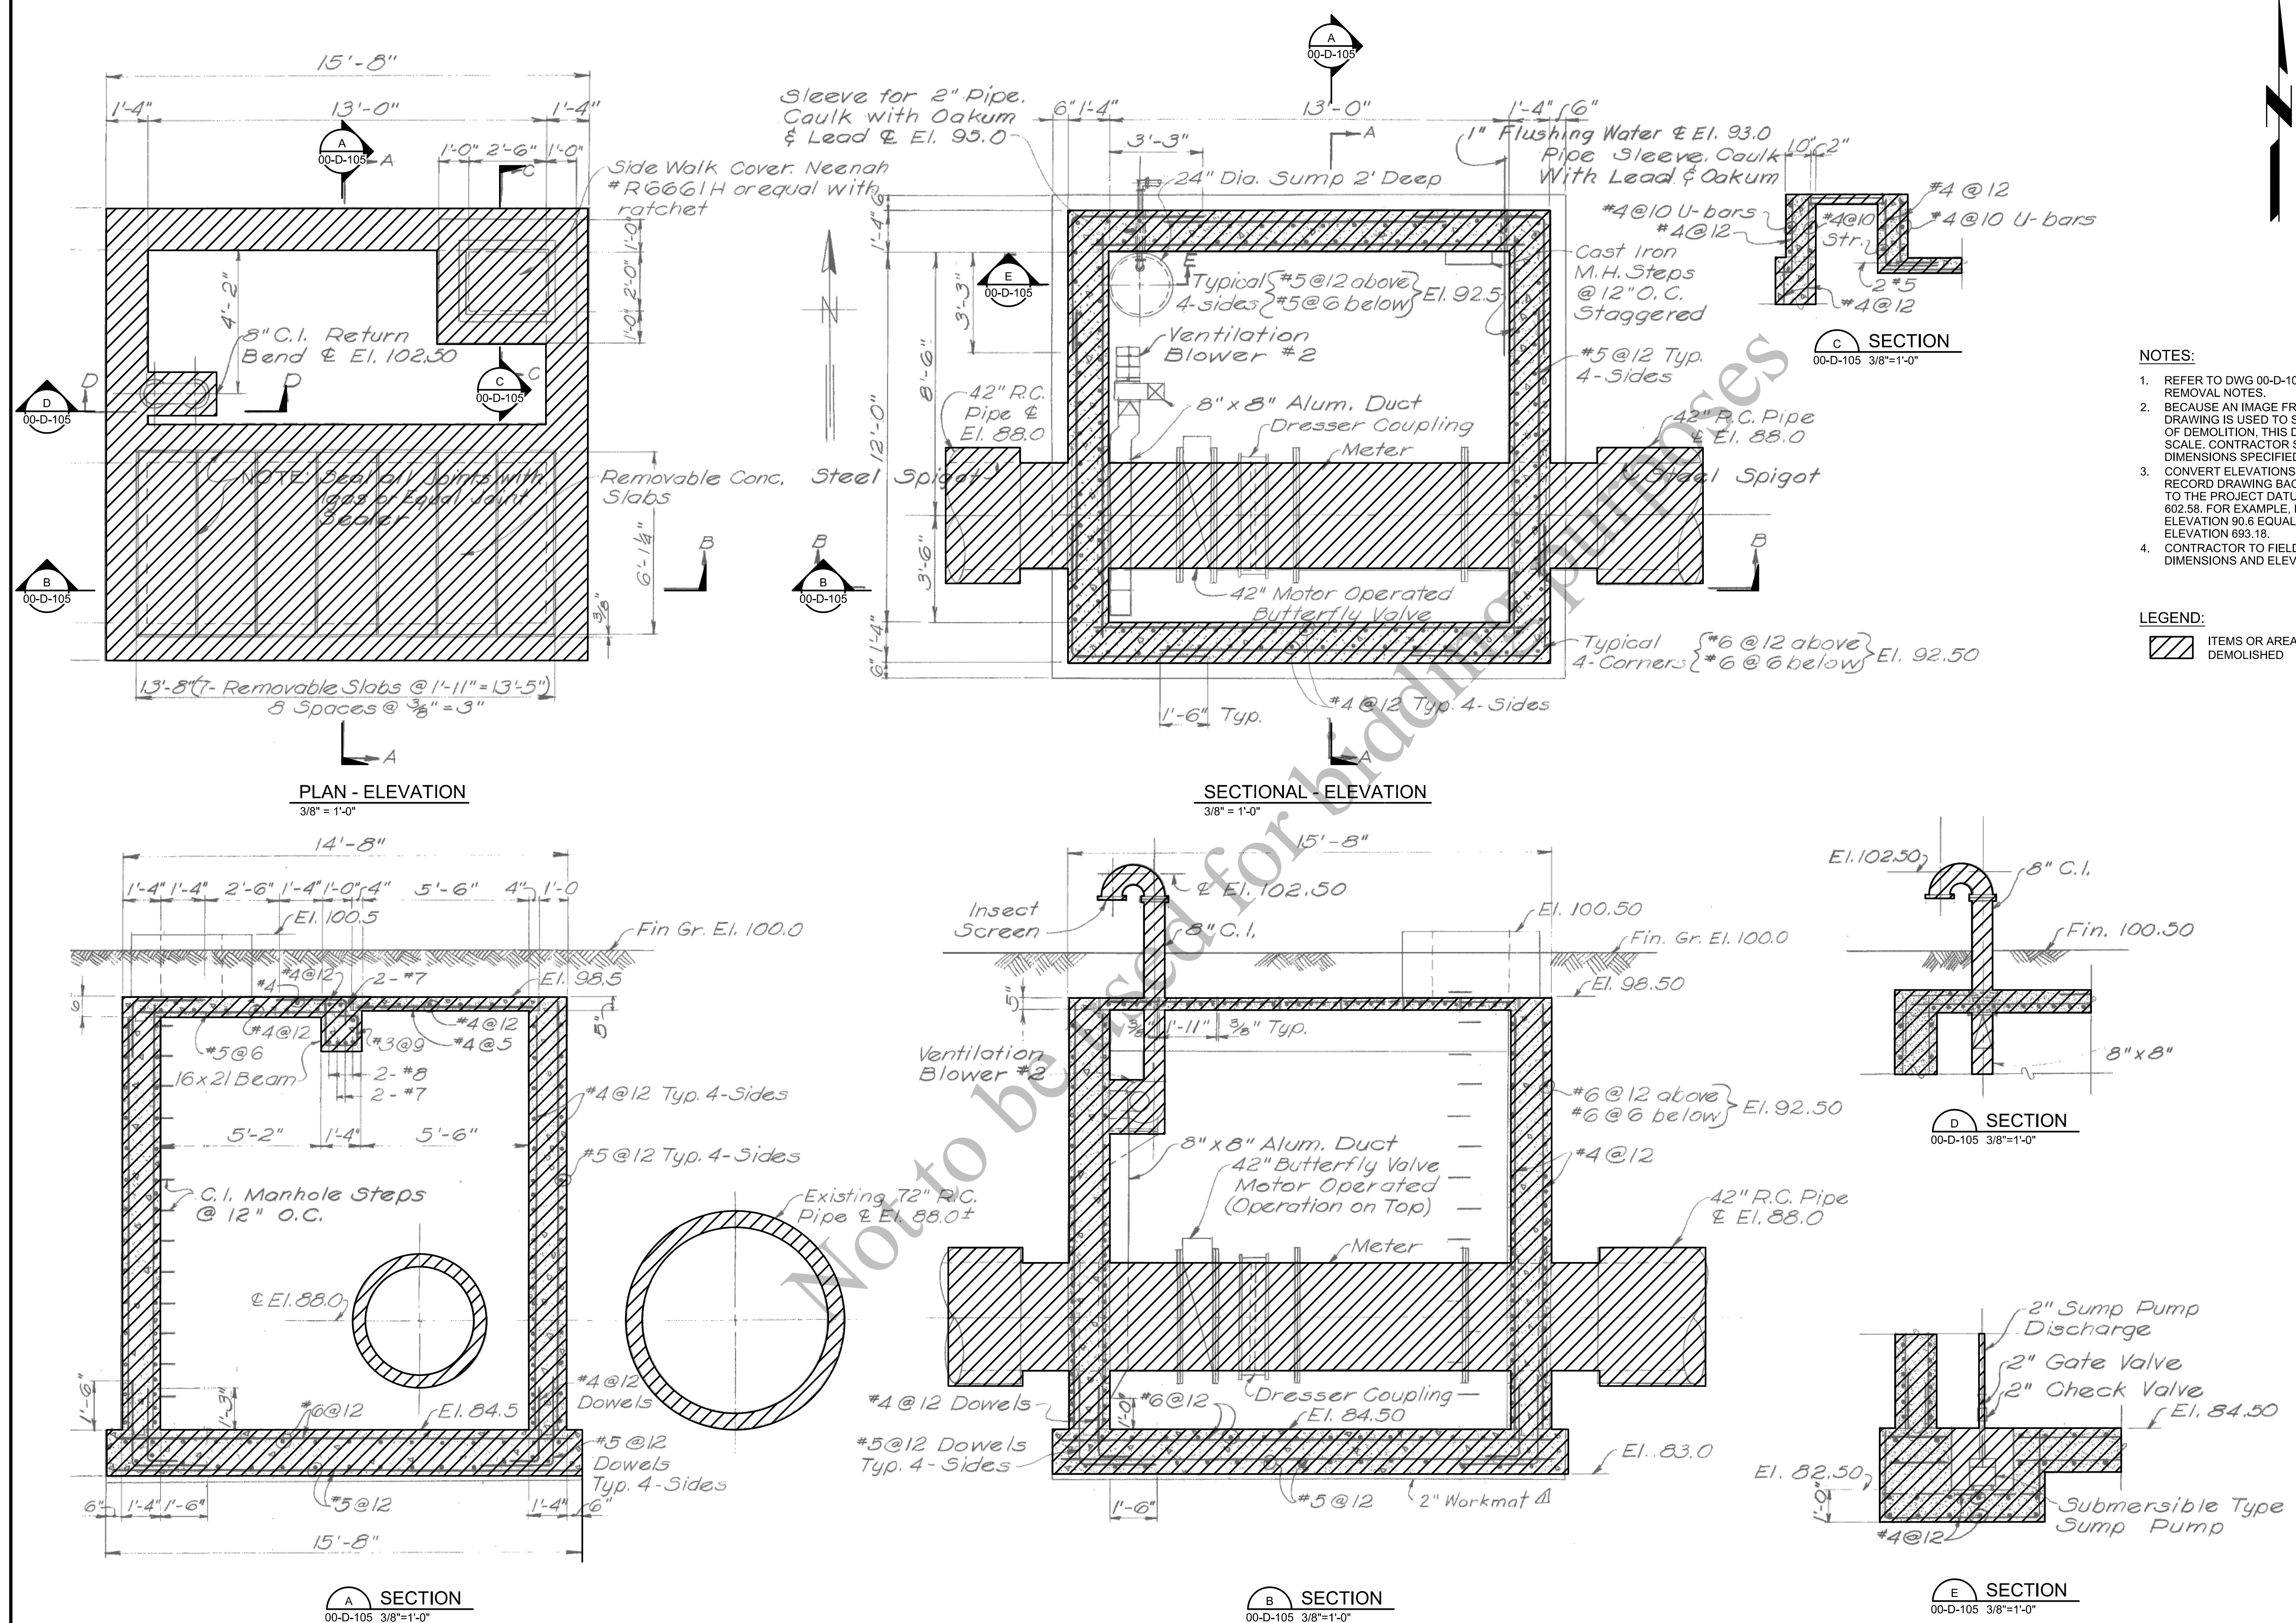
25
DF
63



NOTES:

1. REFER TO DWG 00-D-101 FOR GENERAL REMOVAL NOTES.
2. BECAUSE AN IMAGE FROM A RECORD DRAWING IS USED TO SHOW THE EXTENT OF DEMOLITION, THIS DRAWING IS NOT TO SCALE. CONTRACTOR SHALL FOLLOW THE DIMENSIONS SPECIFIED IN THE IMAGE.
3. CONVERT ELEVATIONS INDICATED ON RECORD DRAWING BACKGROUND IMAGES TO THE PROJECT DATUM BY ADDING 602.58. FOR EXAMPLE, RECORD DRAWING ELEVATION 90.6 EQUALS PROJECT DATUM ELEVATION 93.18.
4. CONTRACTOR TO FIELD VERIFY ALL DIMENSIONS AND ELEVATIONS.

LEGEND:

 ITEMS OR AREAS TO BE DEMOLISHED

AEROBIC GRANULAR
SLUDGE - PHASE 1

REVISIONS AND RECORD OF ISSUE

DESIGNED:	SM
DETAILED:	AB
CHECKED:	AM/JH
APPROVED:	MR
DATE:	12/20/2022



PROJECT NO.: 411752





GENERAL

DEMOLITION

BYPASS CHAMBER PLAN
AND SECTIONS

00-D-106

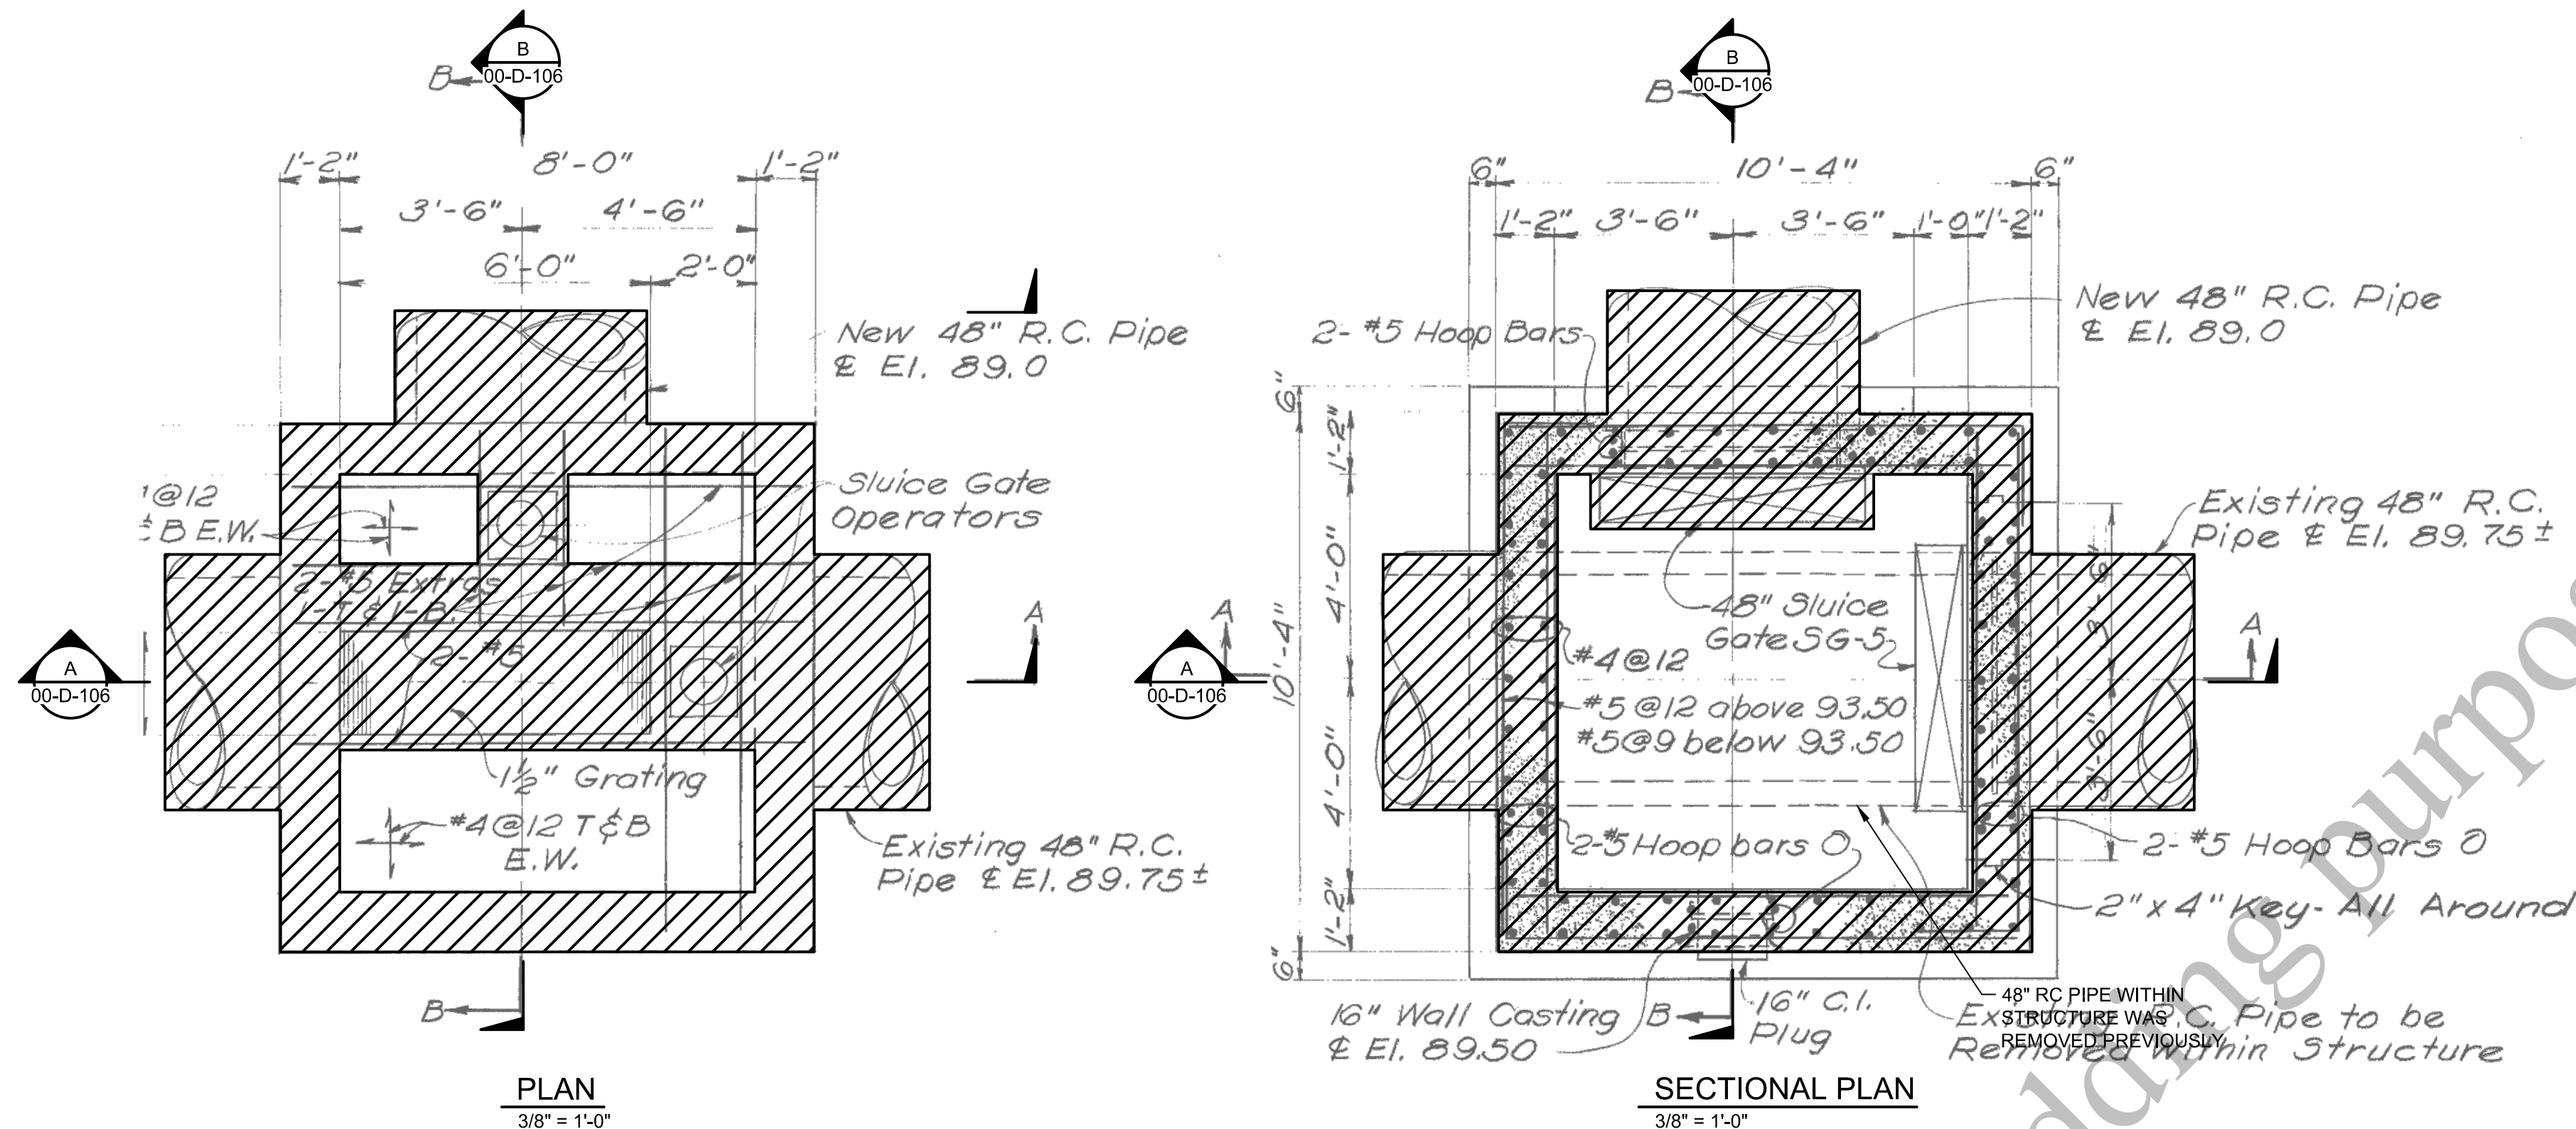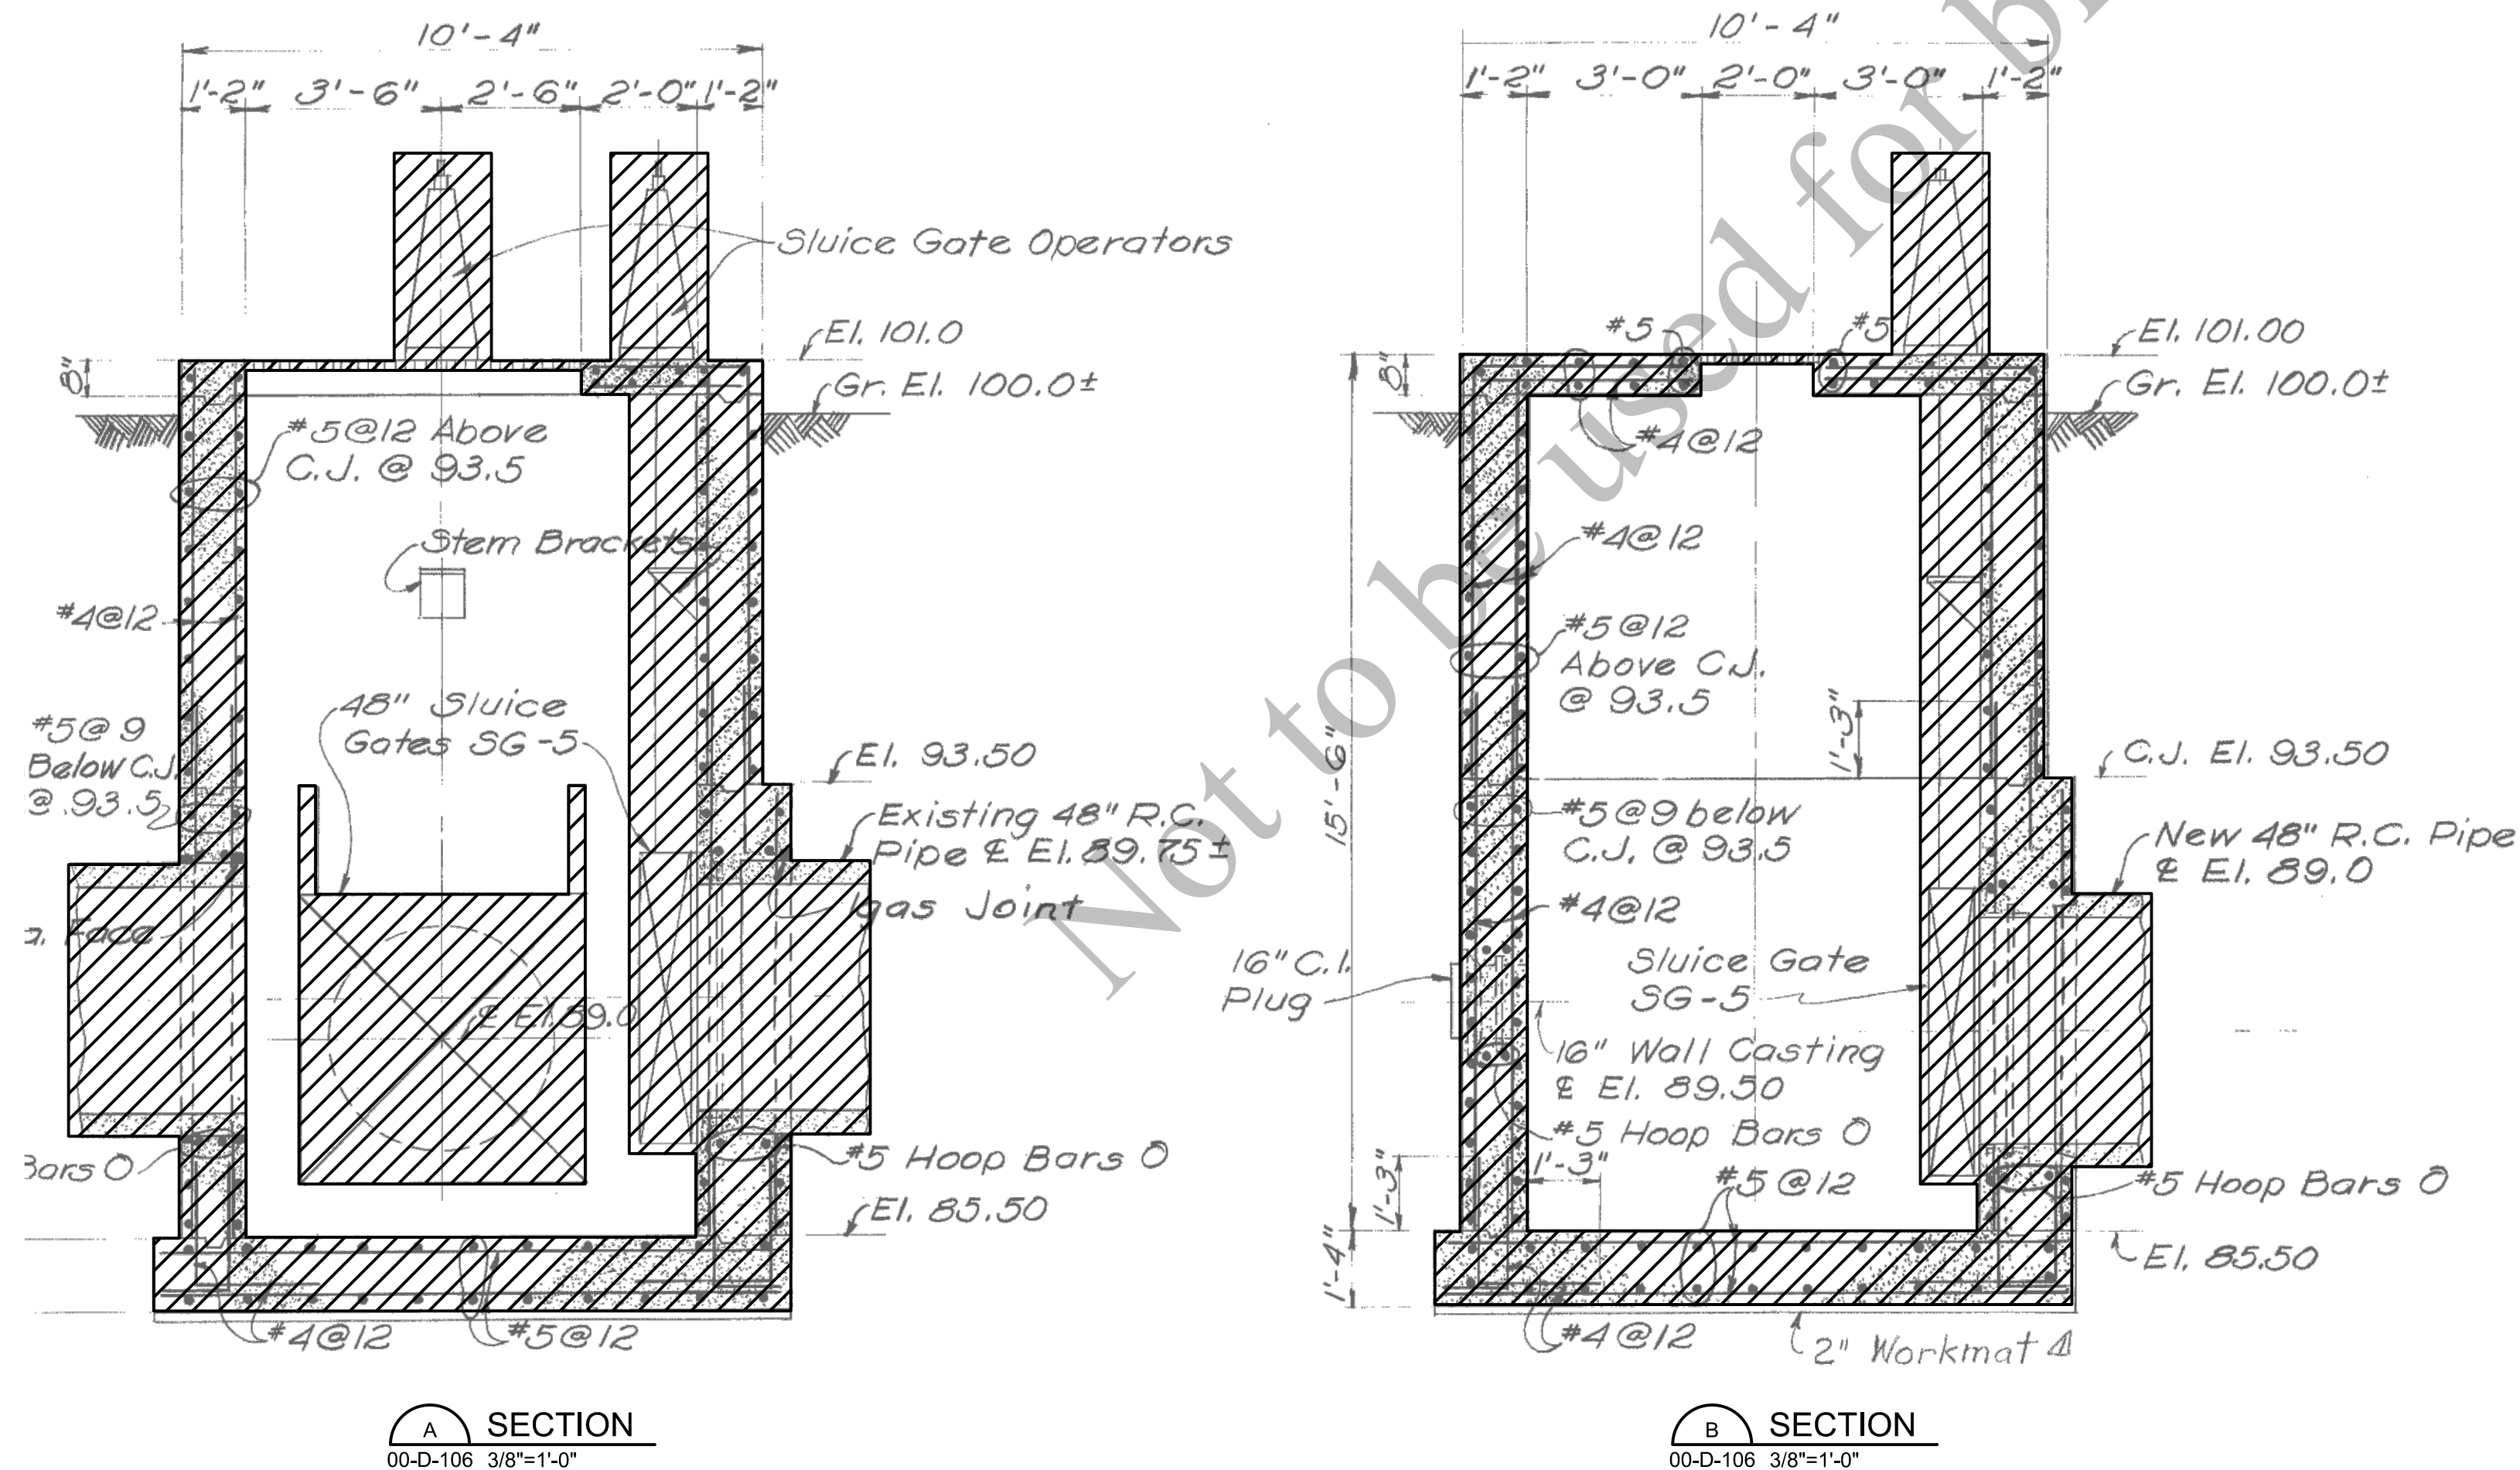26
OF
163PLAN
3/8" = 1'-0"SECTIONAL PLAN
3/8" = 1'-0"SECTION A
00-D-106 3/8" = 1'-0"SECTION B
00-D-106 3/8" = 1'-0"

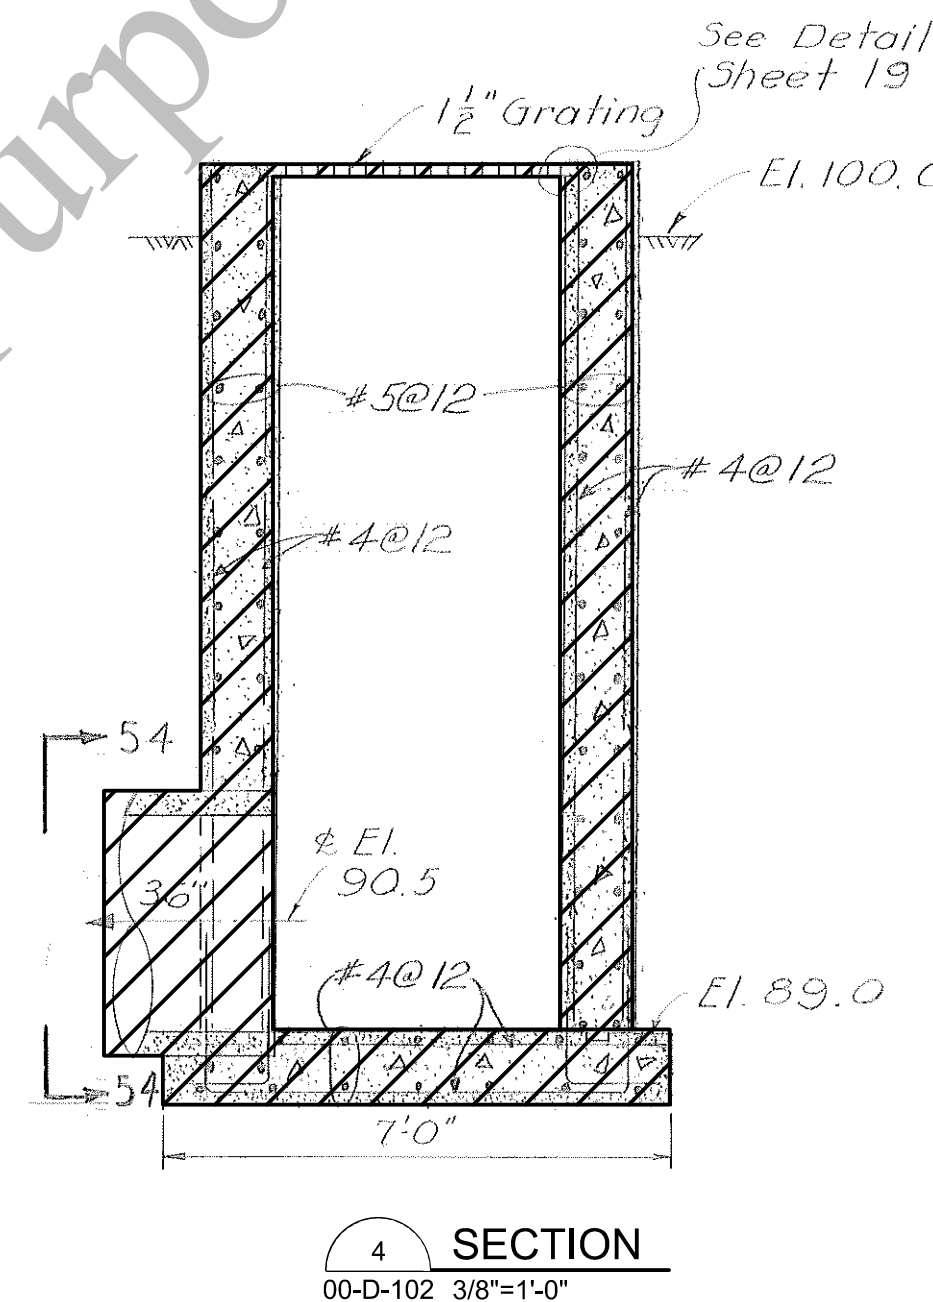
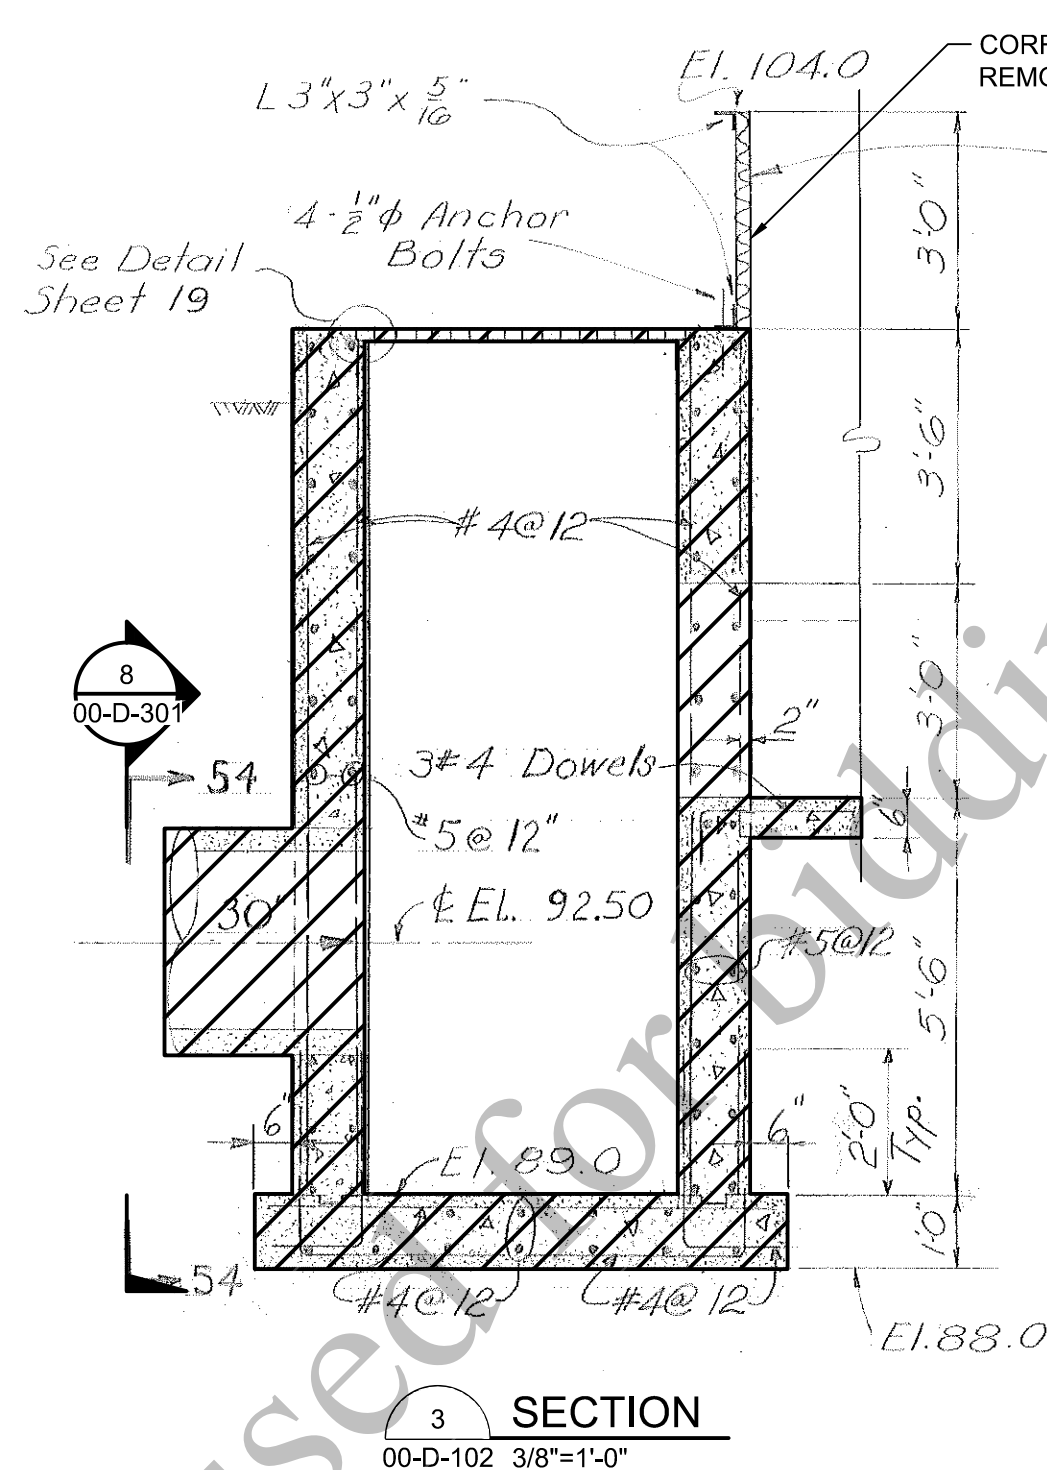
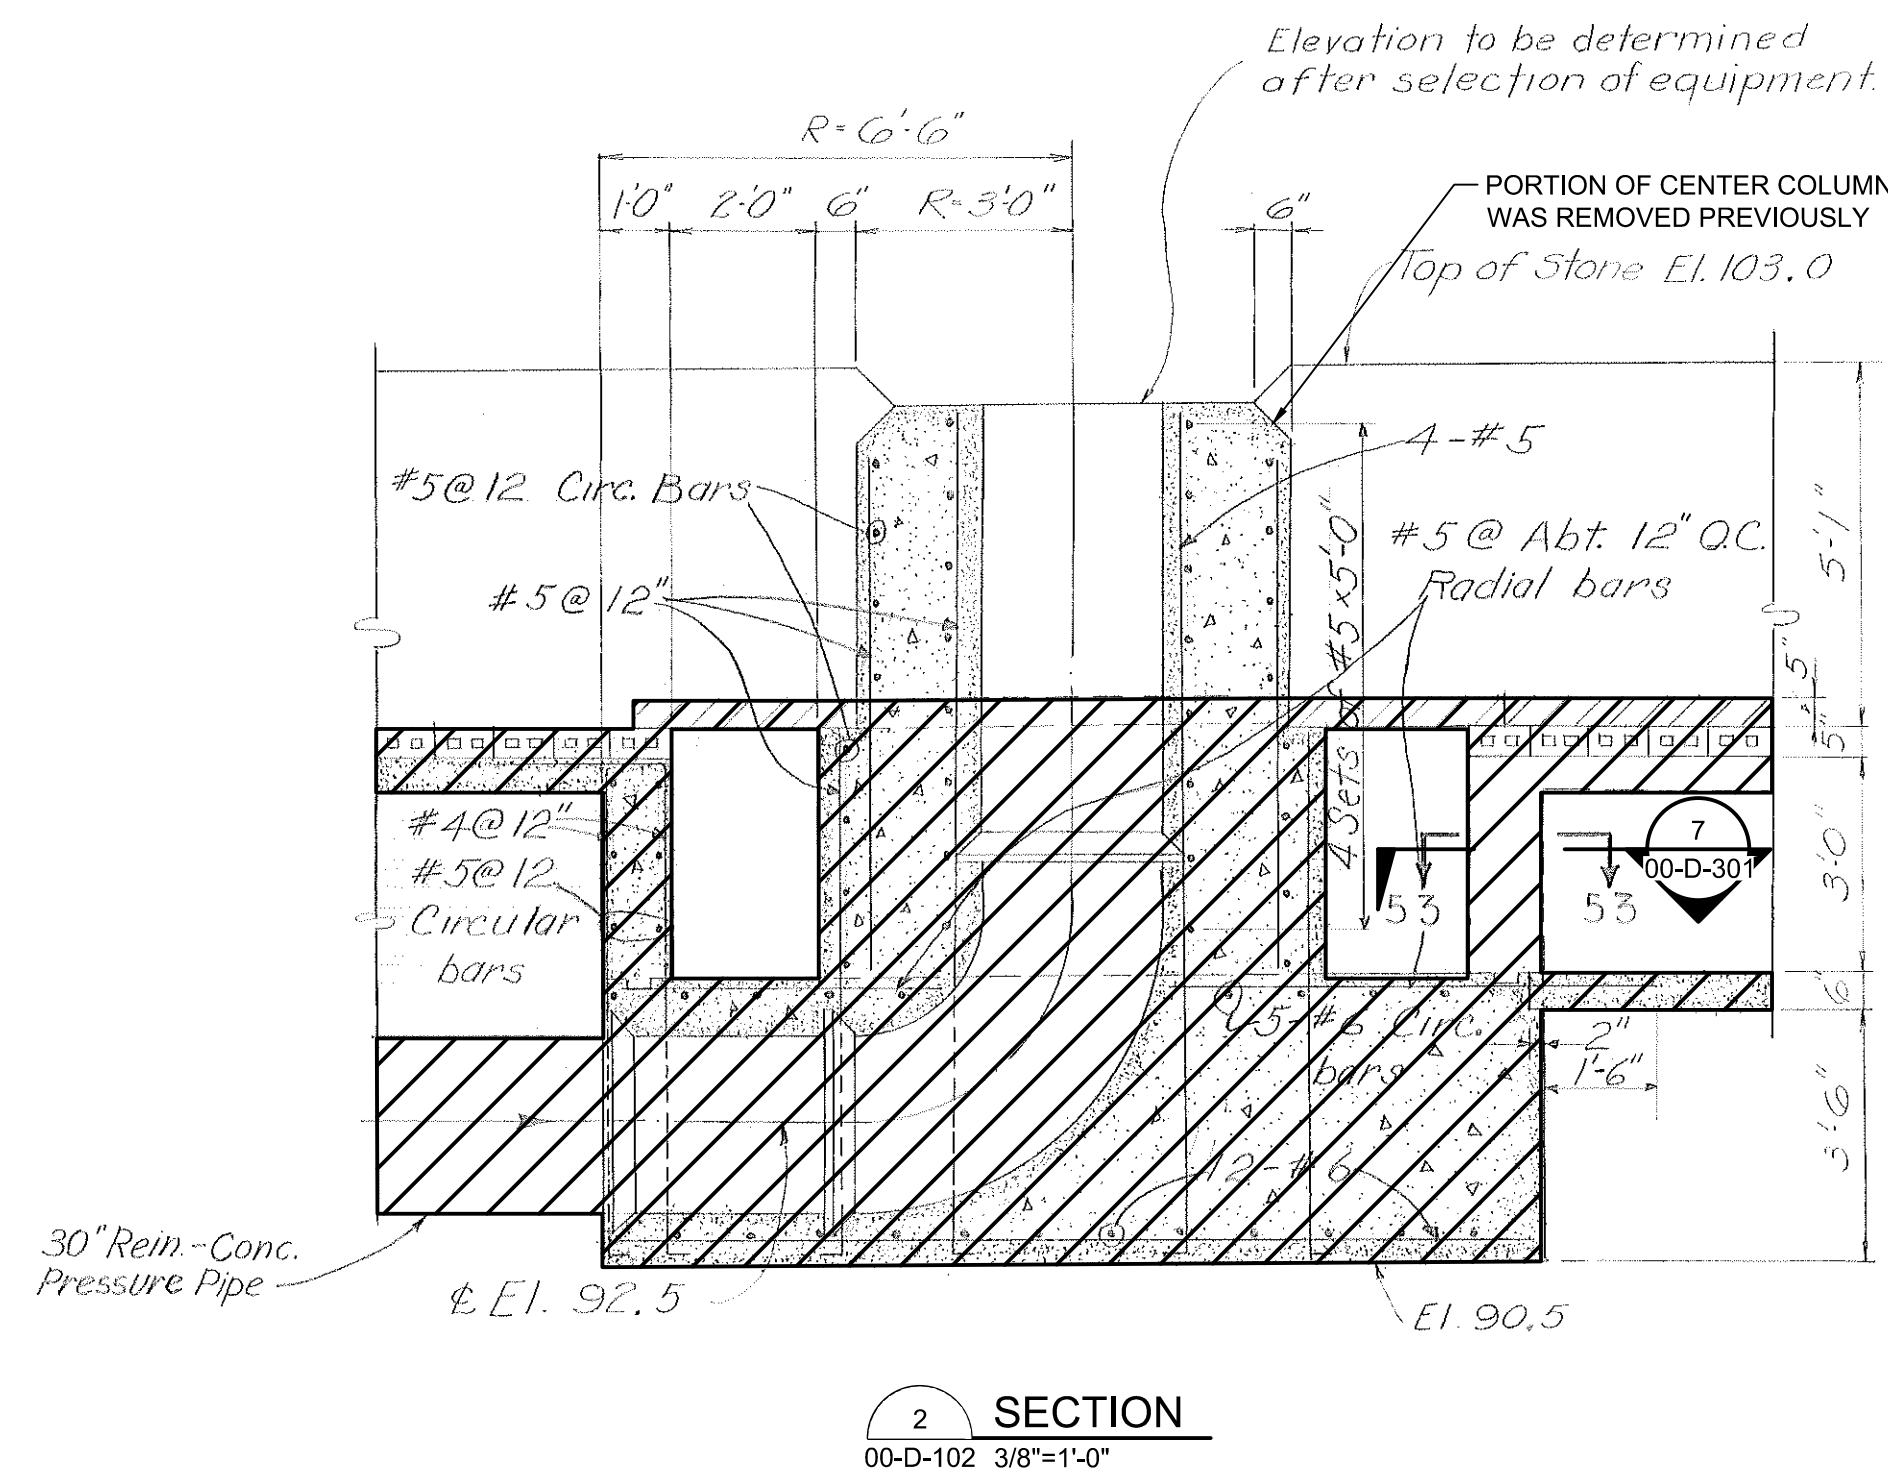
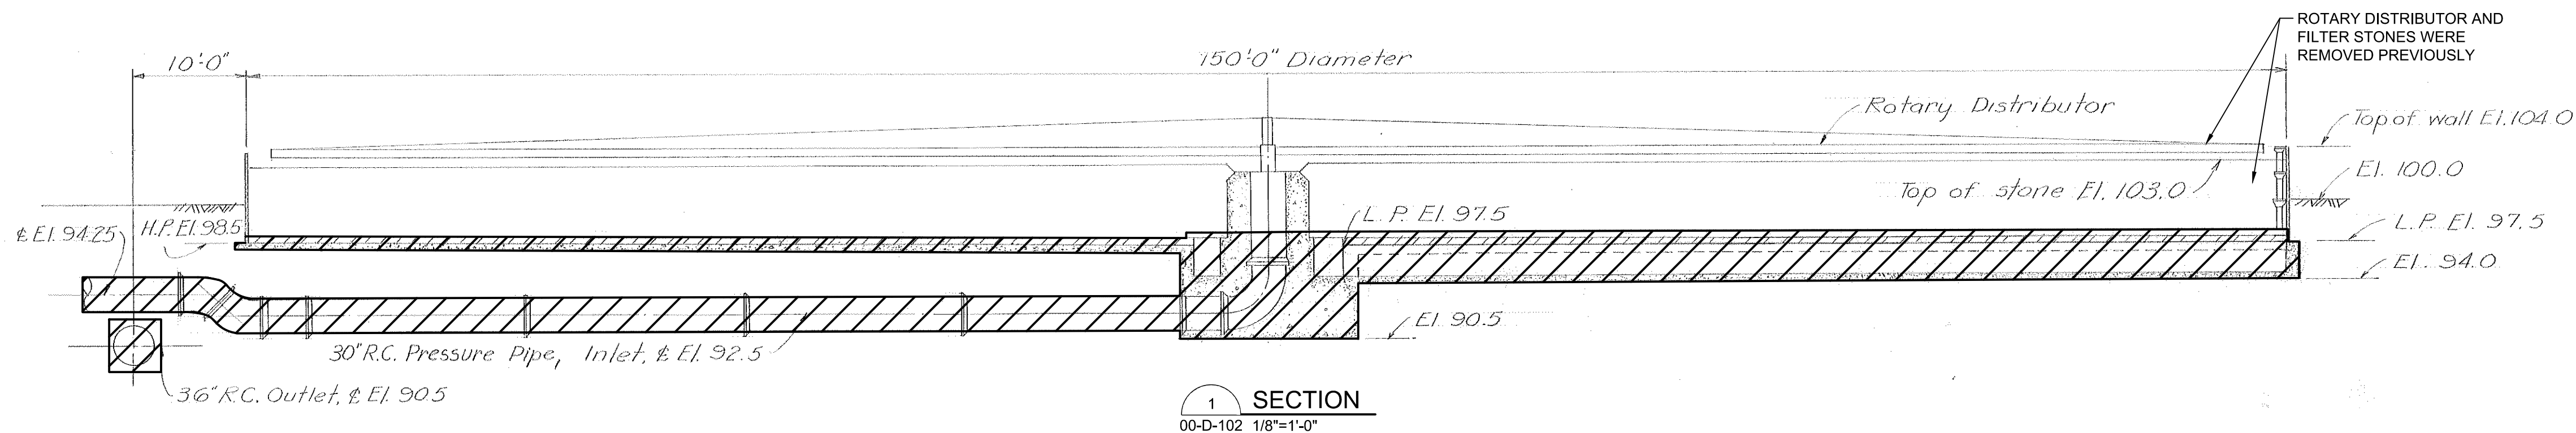


NOTES:


1. REFER TO DWG 00-D-101 FOR GENERAL REMOVAL NOTES.
2. BECAUSE AN IMAGE FROM A RECORD DRAWING IS USED TO SHOW THE EXTENT OF DEMOLITION, THIS DRAWING IS NOT TO SCALE. CONTRACTOR SHALL FOLLOW THE DIMENSIONS SPECIFIED IN THE IMAGE.
3. CONVERT ELEVATIONS INDICATED ON RECORD DRAWING BACKGROUND IMAGES TO THE PROJECT DATUM BY ADDING 602.58. FOR EXAMPLE, RECORD DRAWING ELEVATION 90.6 EQUALS PROJECT DATUM ELEVATION 93.18.
4. CONTRACTOR TO FIELD VERIFY ALL DIMENSIONS AND ELEVATIONS.

LEGEND:

ITEMS OR AREAS TO BE DEMOLISHED

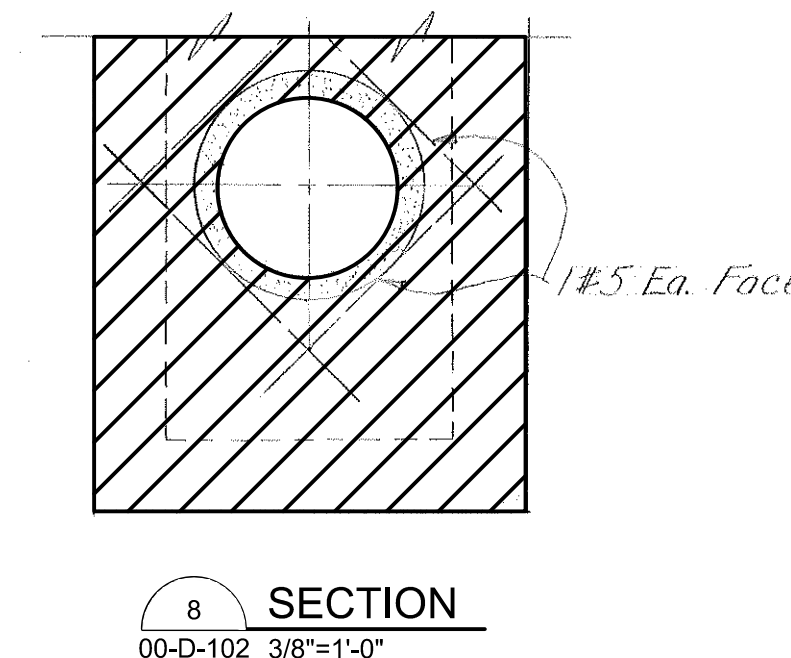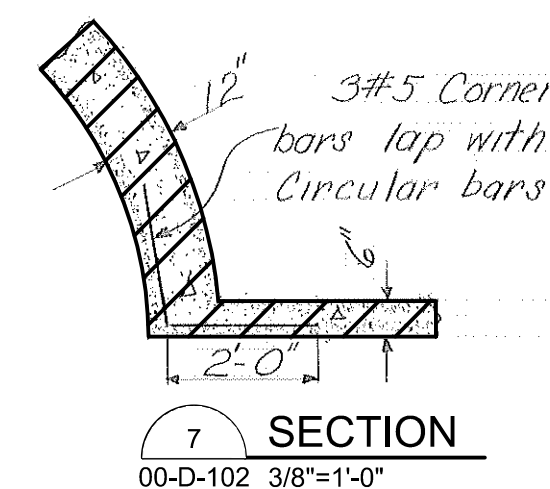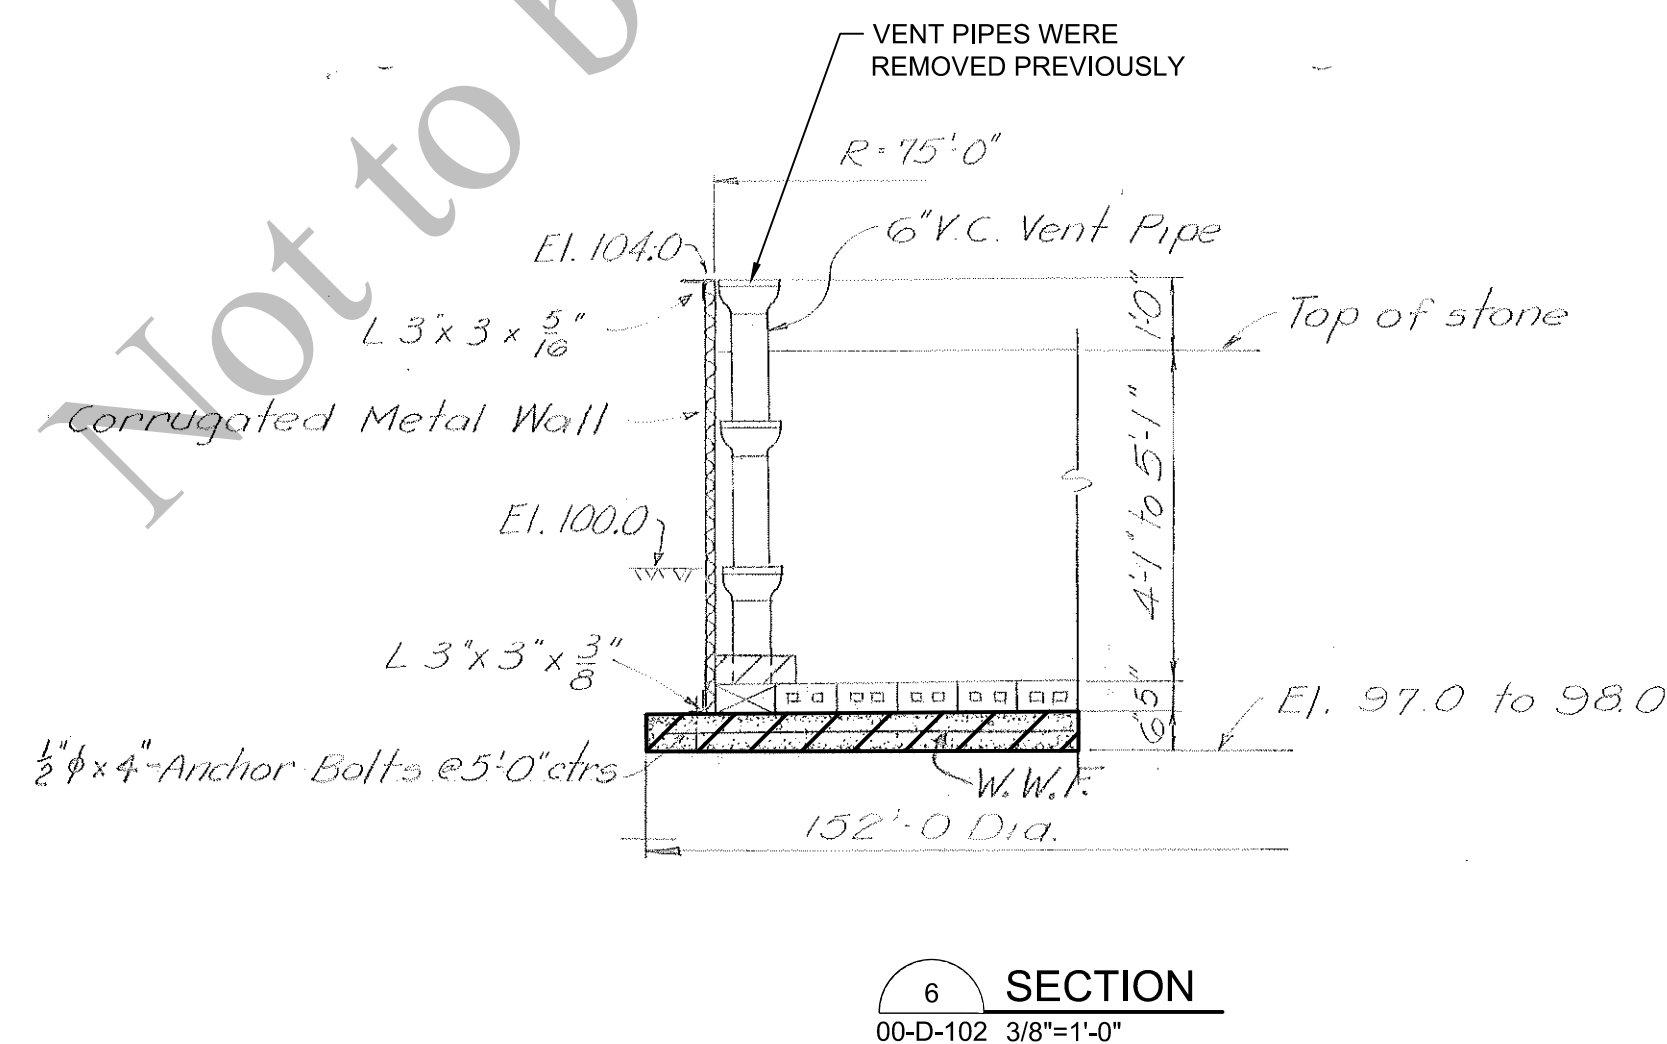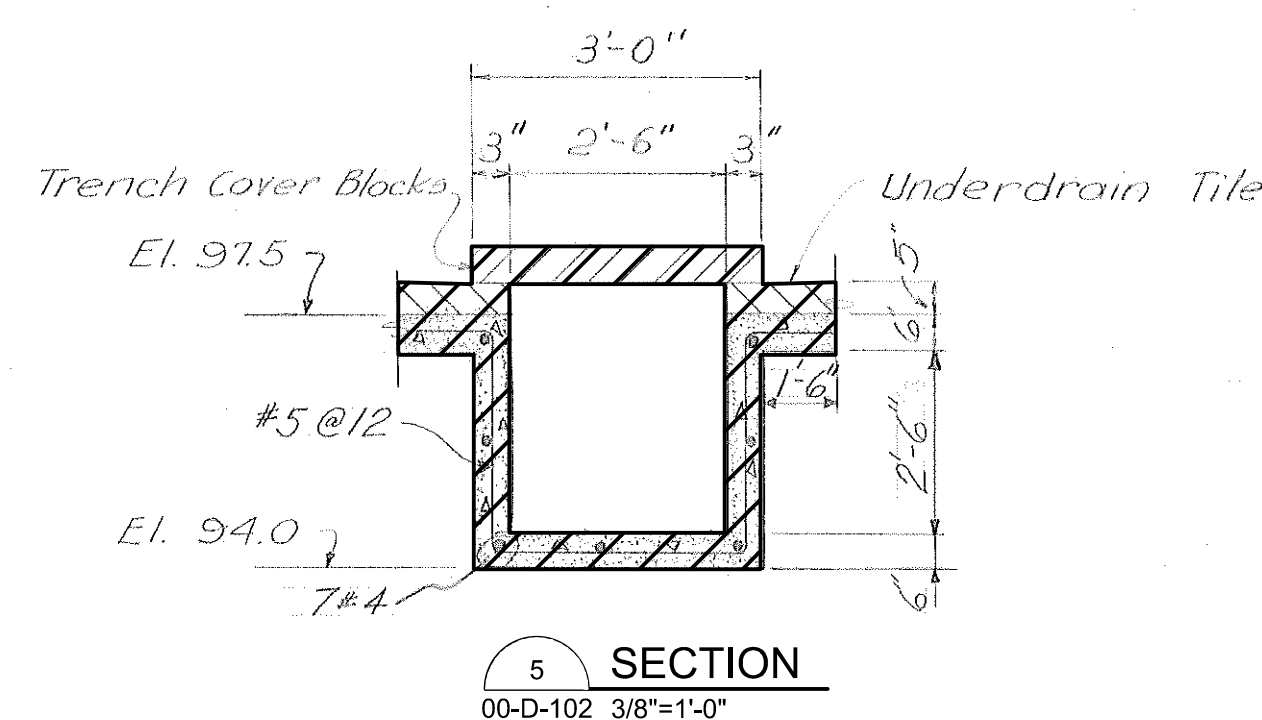

TYP. CONC. SLAB CONSTR. JOINT

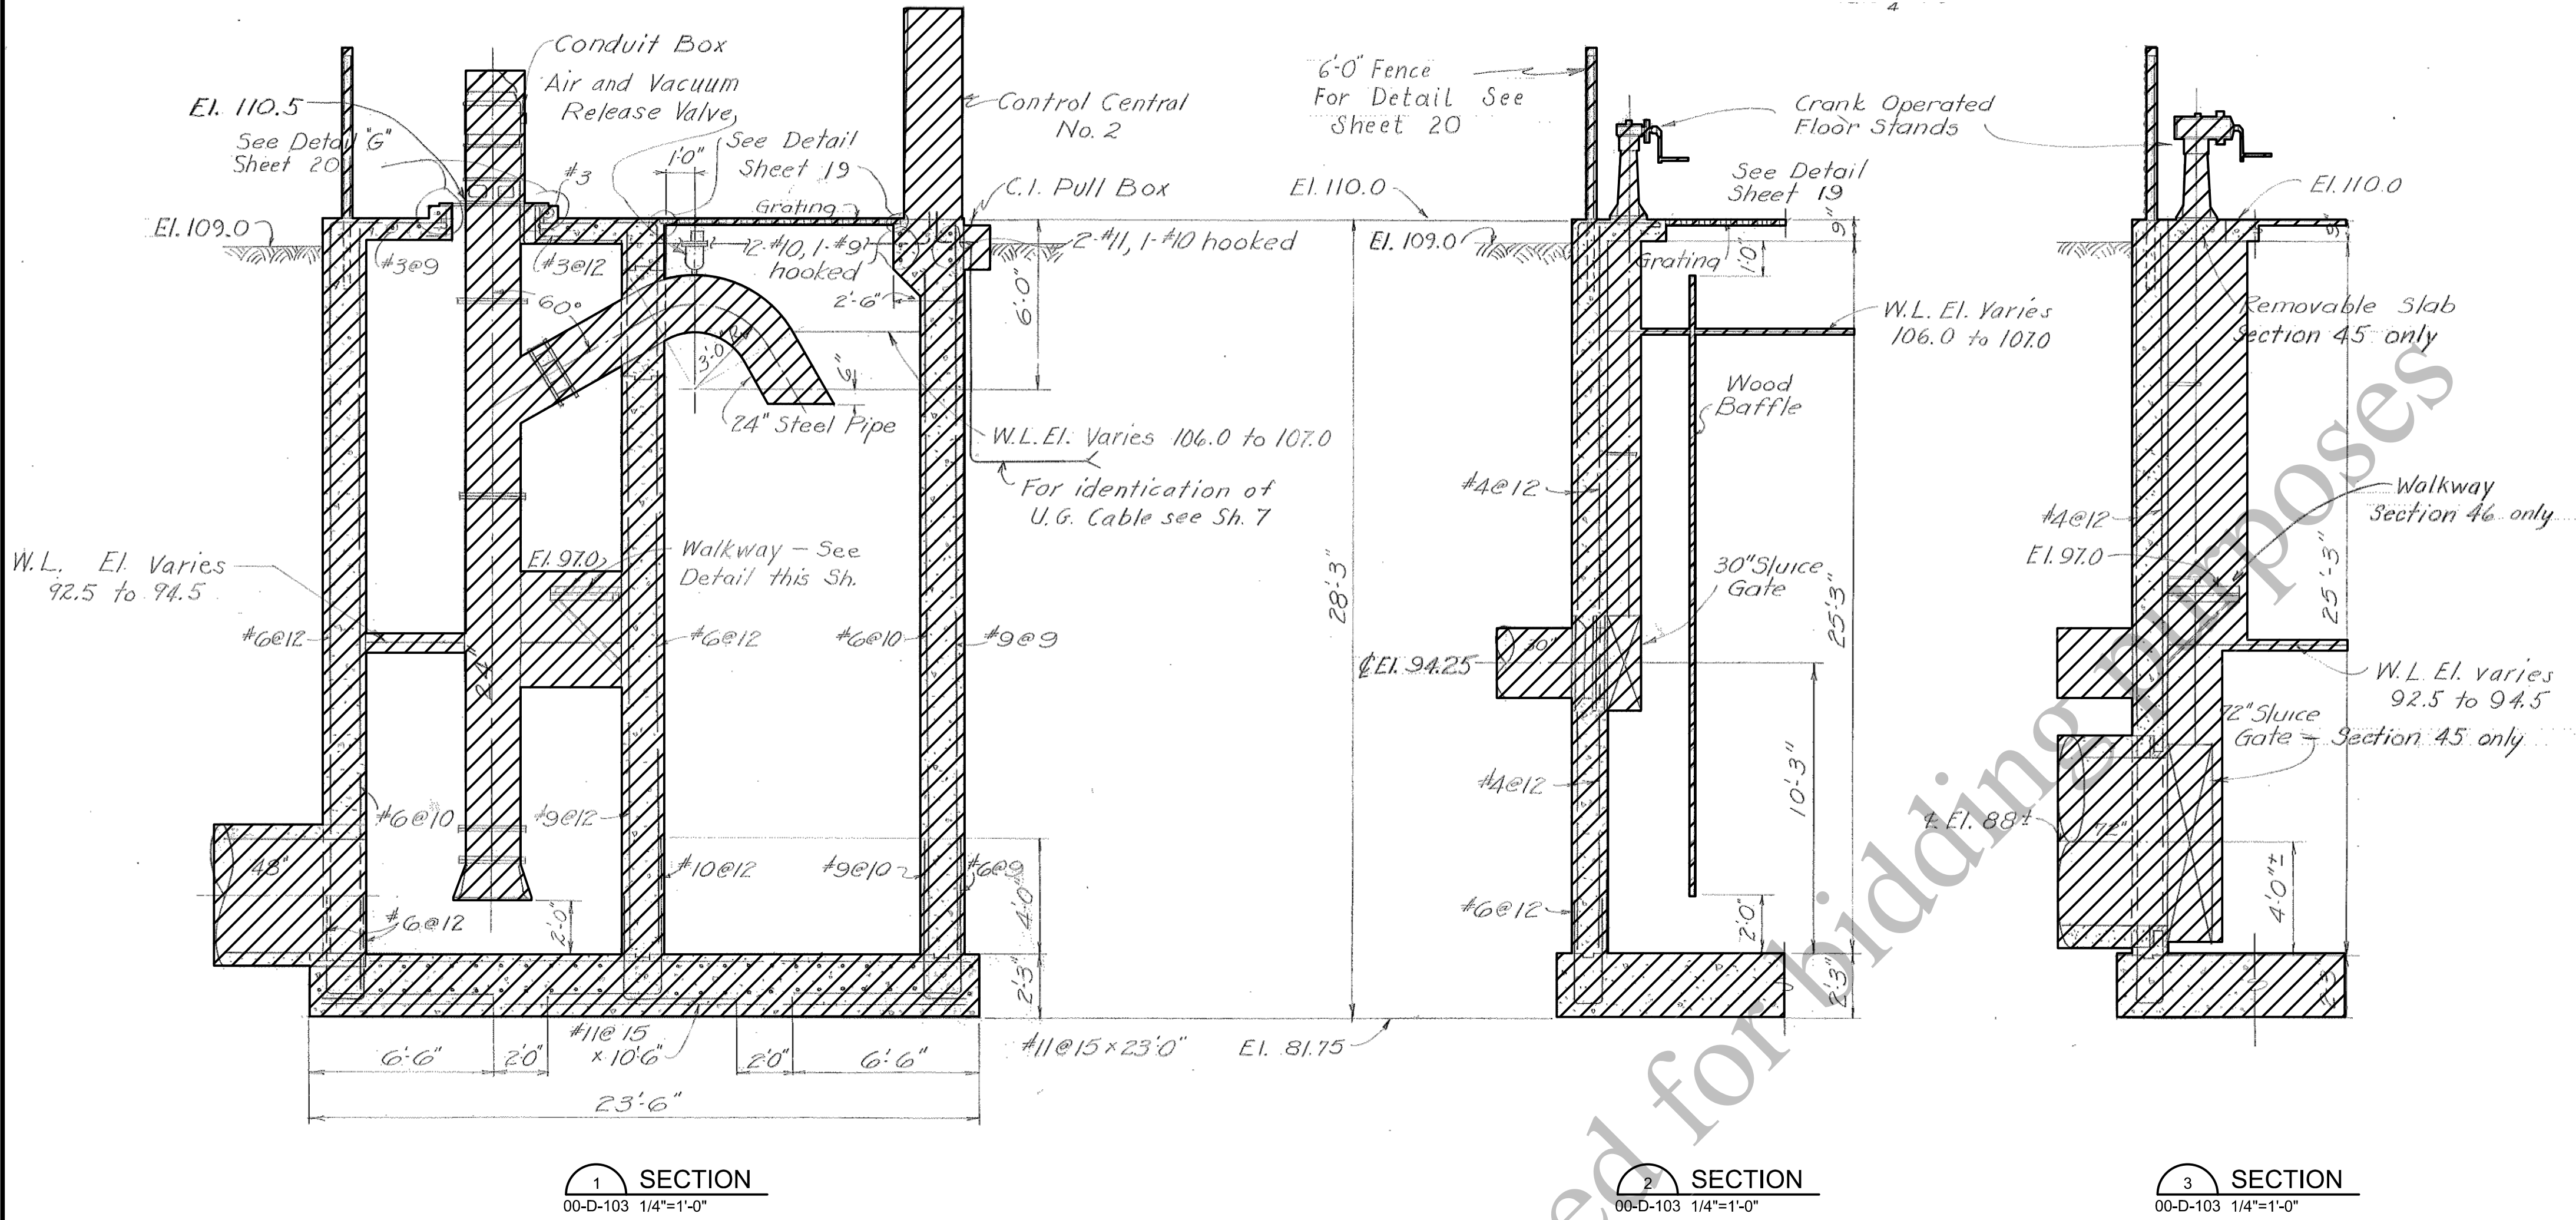

NOTES:

1. REFER TO DWG 00-D-101 FOR GENERAL REMOVAL NOTES.
2. BECAUSE AN IMAGE FROM A RECORD DRAWING IS USED TO SHOW THE EXTENT OF DEMOLITION, THIS DRAWING IS NOT TO SCALE. CONTRACTOR SHALL FOLLOW THE DIMENSIONS SPECIFIED IN THE IMAGE.
3. CONVERT ELEVATIONS INDICATED ON RECORD DRAWING BACKGROUND IMAGES TO THE PROJECT DATUM BY ADDING 602.58. FOR EXAMPLE, RECORD DRAWING ELEVATION 90.6 EQUALS PROJECT DATUM ELEVATION 93.18.
4. CONTRACTOR TO FIELD VERIFY ALL DIMENSIONS AND ELEVATIONS.

LEGEND:

ITEMS OR AREAS TO BE DEMOLISHED

AEROBIC GRANULAR
SLUDGE - PHASE 1


REVISIONS AND RECORD OF ISSUE

DESIGNED:	SM
DETAILED:	AB
CHECKED:	AM/JH
APPROVED:	MR
DATE:	12/20/2022
PROJECT NO.:	411752

GENERAL

DEMOLITION


TRICKLING FILTER PUMP
STATION SECTIONS

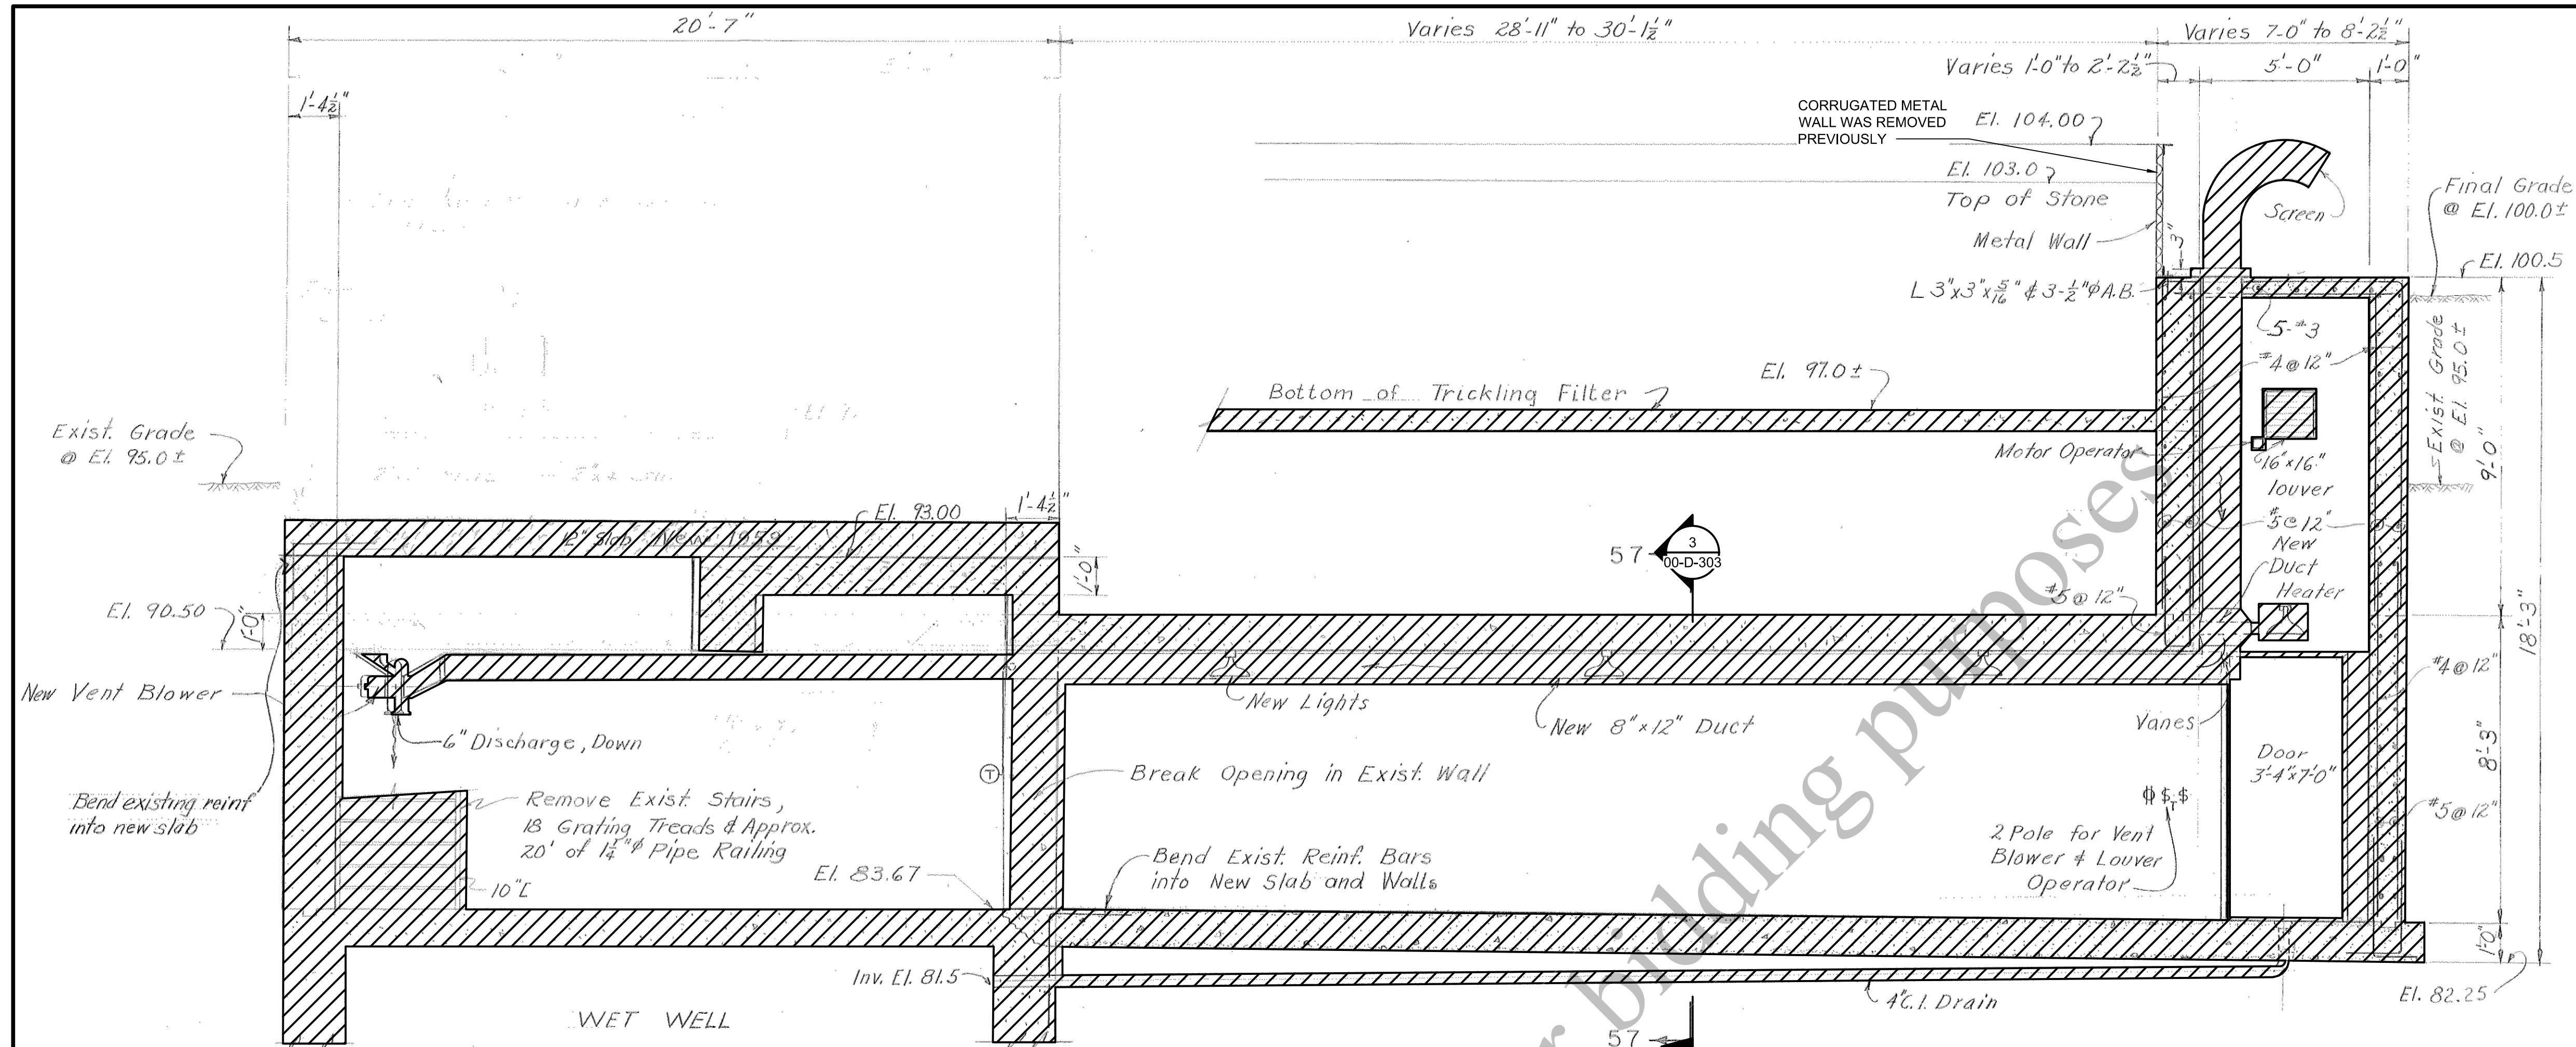


NOTES:



1. REFER TO DWG 00-D-101 FOR GENERAL REMOVAL NOTES.
2. BECAUSE AN IMAGE FROM A RECORD DRAWING IS USED TO SHOW THE EXTENT OF DEMOLITION, THIS DRAWING IS NOT TO SCALE. CONTRACTOR SHALL FOLLOW THE DIMENSIONS SPECIFIED IN THE IMAGE.
3. CONVERT ELEVATIONS INDICATED ON RECORD DRAWING BACKGROUND IMAGES TO THE PROJECT DATUM BY ADDING 602.58. FOR EXAMPLE, RECORD DRAWING ELEVATION 90.6 EQUALS PROJECT DATUM ELEVATION 693.18.
4. CONTRACTOR TO FIELD VERIFY ALL DIMENSIONS AND ELEVATIONS.

LEGEND:

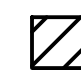 ITEMS OR AREAS TO BE DEMOLISHED

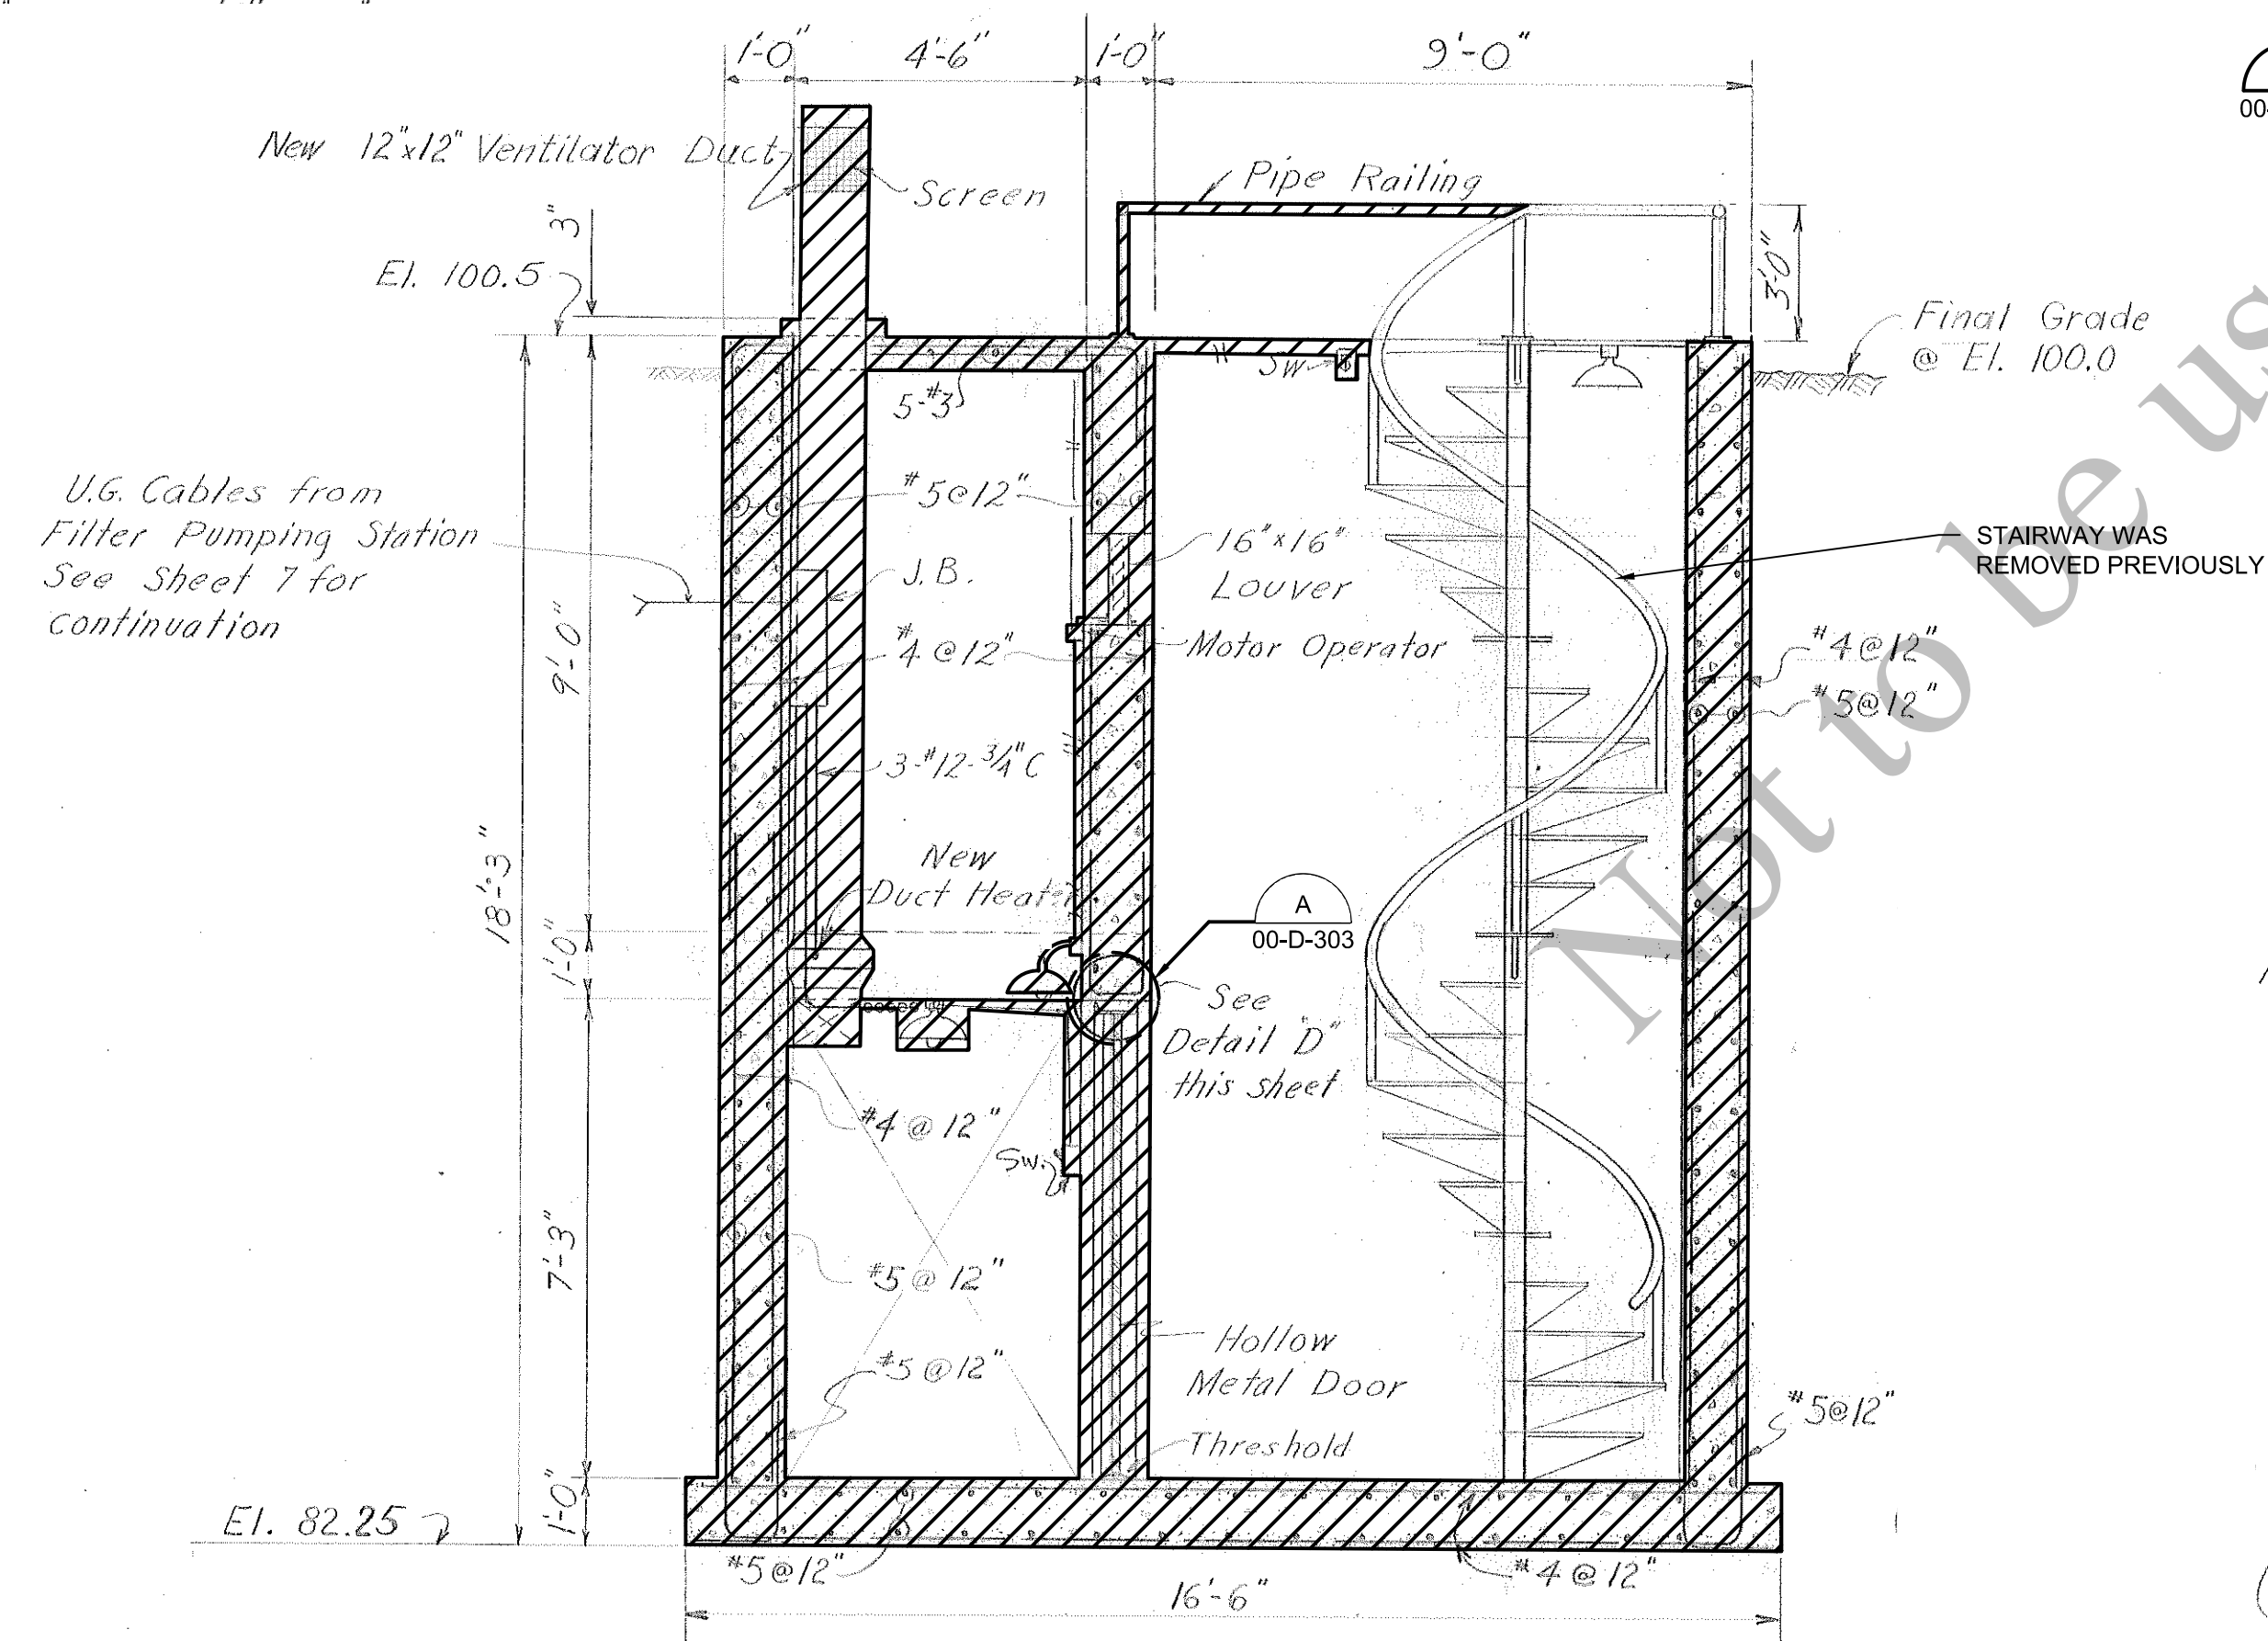AEROBIC GRANULAR
SLUDGE - PHASE 1SECTION
00-D-104 3/8"=1'-0"

Sump Pump - 3-#12+2-#14-1' C
Drainage Pump #1, 3-#10+2-#14-1' C
" " #2, 3-#12+2-#14-1' C
Unit Heater, 5-#12+2-#14-1' C
Blast Ht. Thermostat, 2-#14-3/4" C

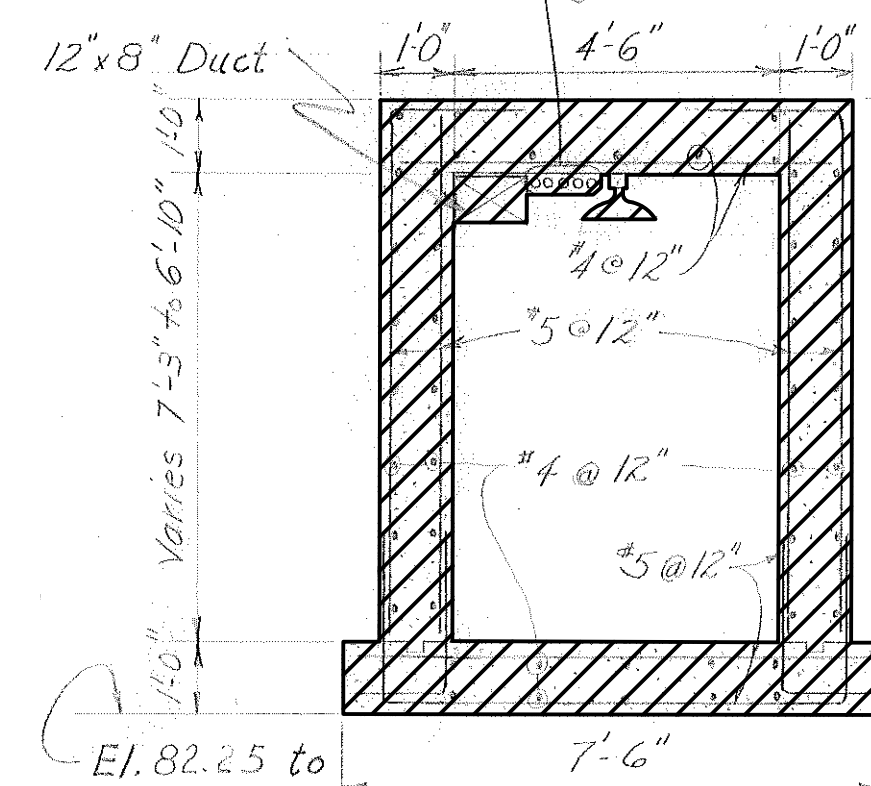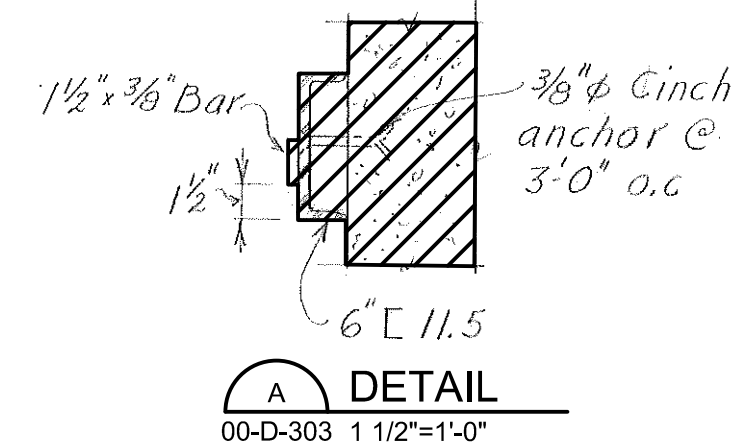SECTION
00-D-104 3/8"=1'-0"DETAIL
00-D-303 1 1/2"=1'-0"

REVISIONS AND RECORD OF ISSUE

DESIGNED:	SM
DETAILED:	AB
CHECKED:	AM/JH
APPROVED:	MR
DATE:	12/20/2022

PROJECT NO.: 411752

GENERAL

DEMOLITION

DRAINAGE PUMP STATION
SECTIONS

00-D-303

CIVIL LEGENDS AND NOTES

EXISTING FACILITY LEGEND

EXISTING GRADE CONTOUR

EXISTING PIPING

CENTERLINE

ELECTRICAL (UNDERGROUND)

FINAL EFFLUENT

FIBER OPTIC

NATURAL GAS

ELECTRICAL (OVERHEAD)

STORM SEWER

POTABLE WATER

WELL WATER

WASTE ACTIVATED SLUDGE

SANITARY SEWER

THICKENED SLUDGE

WATER LINE

WATER OR GAS VALVE

WATER OR GAS METER

SEWER OR STORMDRAIN MANHOLE

VALVE

UTILITY POLE WITH GUY ANCHOR

FIRE HYDRANT

YARD HYDRANT

STREET LIGHT POLE

HEDGE, BRUSH, SHRUBS, WOODS

DECIDUOUS TREE AND TRUNK DIAMETER

CONIFEROUS TREE AND TRUNK DIAMETER

SWAMP

SPOT ELEVATION

CONTROL POINT

BENCHMARK

LEGENDS NOTES:

1. REFER TO PROCESS MECHANICAL LEGENDS FOR VALVE, PIPE JOINT, AND PIPE FITTING SYMBOLS.

2. LEGEND SYMBOLS AND ABBREVIATIONS SHOWN IN THIS DRAWING ARE BASED ON A TEMPLATE THAT IS NOT PROJECT SPECIFIC. SOME LEGEND SYMBOLS AND ABBREVIATIONS ARE NOT USED ON THIS SPECIFIC PROJECT, BUT ARE SHOWN TO PROVIDE A DICTIONARY FOR SYMBOLS AND ABBREVIATIONS THAT MAY ALSO BE USED DURING THE PROJECT CONSTRUCTION PHASE.

NEW FACILITY LEGEND

DESIGN POINT

PERCENT SLOPE

STATION

SLOPE RUN : RISE

CURVE NUMBER

SPOT ELEVATION

SURFACED STREET, ROAD OR DRIVE

SURFACED STREET, ROAD OR DRIVE WITH CURBS

CATCH BASIN

SEWER OR STORMDRAIN MANHOLE

DRAINAGE COURSE OR FLOW LINE

FINISHED GRADE CONTOUR

BANK OR SLOPE LINES

BORE HOLE OR TEST HOLE AND NUMBER

SURVEY LINE WITH PI, PT, OR POT

CONCRETE ENCASEMENT - PLAN VIEW

CULVERT

NEW PIPING

NATURAL GAS

STORM SEWER

WELL WATER

SANITARY SEWER

NEW PIPING IN PROFILE

BUILDINGS, STRUCTURES

STRUCTURES UNDERGROUND

FUTURE BUILDINGS, STRUCTURES

FENCE

CENTERLINE

FIRE HYDRANT

YARD HYDRANT

STREET LIGHT POLE

TO BE DEMOLISHED

WHEELCHAIR ACCESSIBILITY MARKER

EARTH OR GRADE

GRANULAR FILL (CRUSHED ROCK OR GRAVEL)

SAND

CONCRETE

ENGINEERED FILL

RIPRAP

ASPHALT PAVEMENT

PIPING IDENTIFICATION LEGEND

NEW PIPING

PIPE SERVICE PROCESS CODE, SEE P&ID LEGEND & ABBREVIATIONS

PIPE SIZE

EXISTING PIPING

FUTURE PIPING

EQUIPMENT & VALVE TAG LEGEND

MECHANICAL EQUIPMENT/VALVE TAG, SEE P&ID LEGEND AND ABBREVIATIONS

PROJECT BENCHMARKS

CONTROL POINT TABLE				
CP#	NORTHING	EASTING	ELEVATION	DESCRIPTION
1	2025945.97	2587090.76	703.88	CP CUT X
9	2025705.88	2587300.21	704.21	CP CUT X
10	2025679.80	2587527.97	704.20	BRASS "CP" DISC
11*	2025806.30	2587839.41	704.22	CP CUT X
12*	2025666.07	2587616.15	704.22	CP CUT X
20	2025671.29	2587065.95	697.83	BRASS "CP" DISC
26	2025978.05	2587261.64	711.82	BRASS "CP" DISC

* ON DRAWING 00-C-101, CP POINTS 11 AND 12 ARE BEYOND THE PLAN LIMITS

BENCHMARK TABLE				
BM#	NORTHING	EASTING	ELEVATION	DESCRIPTION
336**	2025808.87	2587839.10	704.18	BM CHISELED SQUARE
337**	2025668.91	2587840.60	704.19	BM COPPER DISC
340	2025804.10	2587367.97	704.32	BM CHISELED SQUARE
341	2025802.98	2587300.60	704.24	BM CHISELED SQUARE
342	2025697.73	2587168.21	704.06	BM CHISELED SQUARE
343	2025919.52	2587474.32	708.98	BM CHISELED SQUARE

** ON DRAWING 00-C-101, BM POINTS 336 AND 337 ARE BEYOND THE PLAN LIMITS

SOIL BORE HOLE TABLE			
SOIL BORE HOLE NO.	NORTHING	EASTING	ELEVATION
1	2025767.03	2586752.74	700.20
2	2025951.86	2586758.64	703.60
3	2025917.01	2587083.86	702.80
4	2026040.10	2586886.09	703.30

GENERAL NOTES

- HORIZONTAL CONTROL: COORDINATES ARE BASED ON WinGIS (WINNEBAGO COUNTY GEOGRAPHIC INFORMATION SYSTEM) CONTROL NETWORK DATUM. COORDINATES ON STRUCTURES DEPICT THE EXTERIOR FACE OF THE CONCRETE SUBSTRUCTURE FOUNDATION WALL OR FOOTING WALL.
- VERTICAL CONTROL: ELEVATIONS ARE BASED ON WinGIS (WINNEBAGO COUNTY GEOGRAPHIC INFORMATION SYSTEM) CONTROL NETWORK DATUM. BENCHMARKS AND/OR STRUCTURE ELEVATIONS FROM EXISTING SURVEYS OR REFERENCE DRAWINGS MAY RESULT IN VARIANCES WITH ELEVATIONS INDICATED ON THE DRAWINGS FOR EXISTING FACILITIES.
- THE PROJECTED BASE FLOOD ELEVATION IS 697.3 FEET.
- EXISTING UTILITIES AND STRUCTURES (UNDERGROUND, SURFACE, OR OVERHEAD) ARE INDICATED ONLY TO THE EXTENT THAT SUCH INFORMATION WAS KNOWN, OR MADE AVAILABLE TO, OR DISCOVERED BY THE ENGINEER IN PREPARING THE DRAWINGS. THE LOCATIONS, CONFIGURATIONS, AND ELEVATIONS OF SUBSURFACE FACILITIES AND UTILITIES ARE APPROXIMATE, AND NOT ALL UTILITIES AND FACILITIES MAY BE INDICATED. OVERHEAD UTILITIES ARE NOT INDICATED IN ARCHITECTURAL ELEVATIONS, PROFILE OR SECTION DRAWINGS. THE ENGINEERING INVESTIGATIONS, LOCATION, AND DESIGNATION OF SUBSURFACE UTILITIES INDICATED IN THESE CONTRACT DOCUMENTS HAS BEEN PERFORMED TO QUALITY LEVEL C IN ACCORDANCE WITH GENERALLY ACCEPTED ENGINEERING PRINCIPLES AND PRACTICES AS OUTLINED IN ASCE STANDARD AND GUIDELINE BULLETIN C/ASCE 38-02 UNLESS OTHERWISE DESIGNATED. WHERE SUCH ACTIVITIES HAVE BEEN TO A HIGHER LEVEL OF QUALITY, THE HIGHER QUALITY LEVEL FOR THE AFFECTED AREAS IS INDICATED IN THE CONTRACT DOCUMENTS.
- "SCREENED" (LIGHT) DELINEATION INDICATED ON THE DRAWINGS DENOTES EXISTING FACILITIES. "SCREENED" INFORMATION WAS TAKEN FROM EXISTING CONSTRUCTION DRAWINGS AND DATA AND SURVEYS, IS FOR REFERENCE ONLY, AND SHALL BE FIELD VERIFIED BY THE CONTRACTOR PRIOR TO THE ORDERING OF MATERIALS AND BEGINNING OF CONSTRUCTION. "BOLD" DELINEATION IS NEW WORK TO BE CONSTRUCTED UNDER THIS CONTRACT.
- CONTRACTOR'S STAGING, PARKING AND MATERIAL STORAGE SHALL BE LIMITED TO THE SPACE(S) DESIGNATED ON THE DRAWINGS. PROVIDING ADDITIONAL STORAGE OR PARKING SHALL BE THE RESPONSIBILITY OF THE CONTRACTOR.
- CALL BEFORE YOU DIG. CONTRACTOR SHALL NOTIFY FRSA AT LEAST 72 HOURS PRIOR TO ANY EXCAVATION. ACCURATE LOCATIONS AND ELEVATIONS OF ALL UTILITIES AND STRUCTURES, WHETHER INDICATED ON THE DRAWINGS OR NOT, SHALL BE DETERMINED BY THE CONTRACTOR IN ADVANCE, BY CONTACTING ALL UTILITIES AND OTHER AGENCIES AND BY PROSPECTING. CONTRACTOR SHALL BE RESPONSIBLE FOR REMOVAL, DEMOLITION, RECONSTRUCTION, AND RECONNECTION OF EXISTING FACILITIES AS REQUIRED TO COMPLETE THE WORK. IF REQUIRED AFTER FIELD LOCATION AND VERIFICATION, CONTRACTOR SHALL COORDINATE WITH THE ENGINEER TO DETERMINE ANY NECESSARY MODIFICATIONS TO THE DESIGN OF NEW WORK.
- BEFORE CONSTRUCTION IS STARTED, CONTRACTOR SHALL COORDINATE WITH THE OWNER OF EACH UTILITY AND DEFINE THE REQUIREMENTS AND METHODS TO ACCOMMODATE THE PROTECTION, TEMPORARY SUPPORT, ADJUSTMENT, OR RELOCATION OF ANY UTILITIES AFFECTED BY THE PROPOSED NEW WORK.
- CONTRACTOR SHALL COMPLY WITH THE GOVERNING AGENCY NPDES CONSTRUCTION REQUIREMENTS, AND SHALL PROVIDE APPROPRIATE MITIGATION MEASURES OR PROTECTION AND RESTORATION AT ALL LOCATIONS AS REQUIRED BY THEIR OPERATIONS, AND AS DIRECTED BY ENGINEER. SPECIAL CONSTRUCTION REQUIREMENTS, TEMPORARY PROTECTIVE FENCING OR BARRICADES, SHEETING, SHORING, EROSION PROTECTION, AND SURFACE RESTORATION AT CERTAIN LOCATIONS ARE INDICATED ON THE DRAWINGS AND SPECIFIED TO BRING THE CONTRACTOR'S ATTENTION TO SENSITIVE AREAS.
- THE CONTRACTOR SHALL BE RESPONSIBLE FOR THE PROTECTION OF ALL PROPERTY CORNER AND SURVEYING CONTROL MARKERS AND MONUMENTS. MONUMENTS DAMAGED BY CONSTRUCTION ACTIVITIES SHALL BE REESTABLISHED BY A PROFESSIONAL LAND SURVEYOR LICENSED IN THE STATE OF ILLINOIS.
- THE LOCATION OF BORINGS, AND TEST HOLES INDICATED ON THE DRAWINGS ARE APPROXIMATE. CONTRACTOR SHALL REFER TO THE GEOTECHNICAL REPORT FOR ACTUAL BORINGS AND TEST HOLE LOCATIONS AND THE FINDINGS OF THE GEOTECHNICAL INVESTIGATIONS.
- CONTRACTOR SHALL PROTECT AND MAINTAIN ALL EXISTING TREES, SHRUBS, AND PLANTS, UNLESS OTHERWISE NOTED.
- CONTRACTOR SHALL INSTALL ALL PIPELINES, PAVING, WALKWAYS, AND CURB AND GUTTER AT A UNIFORM GRADE BETWEEN ELEVATIONS DEPICTED ON THE DRAWINGS.
- FOR ALL SITE GRADING, SMOOTH PARABOLIC TRANSITIONS SHALL BE MADE BETWEEN CHANGES IN SLOPE, UNLESS NOTED OTHERWISE IN THE DRAWINGS. PARABOLIC ROUNDING SHALL APPLY TO ALL CUT AND FILL SECTIONS.
- FINISHED GRADE ELEVATION AT THE FACILITIES FACE, WHERE NOT ADJACENT TO PAVEMENT, SHALL BE APPROXIMATELY 6 INCHES BELOW FINISHED FLOOR ELEVATION UNLESS OTHERWISE NOTED. FINISHED GRADE ELEVATION ADJACENT TO BASINS SHALL BE APPROXIMATE AS INDICATED BY CONTOURS, OR AS REQUIRED TO MEET STAIR LANDINGS.
- THE CONTRACTOR'S CONSTRUCTION OPERATIONS SHALL CONFORM TO FEDERAL, STATE, AND LOCAL AGENCY SAFETY AND HEALTH RULES AND REGULATIONS FOR EXCAVATION AND TRENCHING, CONFINED SPACE ENTRY, WORK IN HAZARDOUS LOCATIONS, WORK AT HEIGHTS, AIR QUALITY CONTROL, NOISE CONTROL, TRAFFIC CONTROL, AND ANY OTHER POTENTIALLY HAZARDOUS CONDITIONS.
- ALL PRESSURIZED OR SURCHARGED PIPELINES, PIPE FITTINGS, COUPLINGS, JOINTS, EXPANSION JOINTS, TANK CONNECTIONS, AND CHANNEL CONNECTIONS SHALL BE PROVIDED WITH THRUST RESTRAINT BASED ON SPECIFIED PRESSURES AND TEMPERATURES.
- THE DRAWINGS INDICATE TYPES OF PIPE SUPPORT SYSTEMS AT VARIOUS LOCATIONS. HOWEVER, ALL PIPE SUPPORTS, HANGERS, BRACKETS, INSERTS OR BRACES ARE NOT SHOWN. CONTRACTOR SHALL REFER TO THE SPECIFICATIONS AND PROVIDE A COMPLETE SUPPORT SYSTEM AS REQUIRED.
- THE TERM "PROPOSED" AS INDICATED ON THE DRAWINGS MEANS THE ITEM IS DESIGNED OR PLANNED TO BE PROVIDED BY OWNER OR OTHERS SEPARATE FROM THIS CONTRACT. THE TERM "FUTURE" AS INDICATED ON THE DRAWINGS REFERS TO THE ENGINEER'S INTERPRETATION OF THE ITEM FOR THE FUTURE, BASED ON AVAILABLE INFORMATION.
- THE EXISTING PROCESS FACILITIES SHALL REMAIN IN OPERATION CONTINUOUSLY THROUGHOUT THE DURATION OF CONSTRUCTION ACTIVITIES. INDIVIDUAL PROCESS FACILITIES CAN BE TAKEN OUT OF SERVICE FOR LIMITED PERIODS OF TIME TO FACILITATE CONSTRUCTION AS SPECIFIED IN THE CONTRACT DOCUMENTS.
- STRUCTURES SUCH AS CURBS AND GUTTERS, CONCRETE AND ASPHALT DRIVES AND WALKWAYS, PAVING BRICKS, FENCING, RETAINING WALLS, ETC., CROSSED BY PIPELINES ARE NOT ALL INDICATED IN PROFILE. CONTRACTOR SHALL RESTORE ANY EXISTING STRUCTURES THAT ARE DISTURBED, DAMAGED, OR REMOVED BY CONSTRUCTION.
- CONTRACTOR SHALL REPLACE EXISTING PIPE CULVERTS THAT ARE REMOVED TO INSTALL NEW PIPELINES WITH NEW PIPE CULVERTS OF THE SAME SIZE, MATERIAL AND CONSTRUCTION AT THE SAME LOCATION AND INVERT ELEVATION AS THOSE THAT WERE REMOVED, AND SHAPE THE DITCH TO DRAIN WITH THE REPLACED CULVERT. CONTRACTOR SHALL PROVIDE ANY TEMPORARY CULVERTS THAT MAY BE REQUIRED FOR CONTRACTOR'S OPERATIONS. CONTRACTOR SHALL COORDINATE REMOVAL AND REPLACEMENT OF ANY CULVERTS WITHIN PUBLIC RIGHT-OF-WAY WITH THE REGULATING AGENCY.
- HORIZONTAL STATIONING ALONG PIPELINE ALIGNMENTS IS A HORIZONTAL MEASUREMENT. FOR MEASUREMENT AND PAYMENT FOR PIPELINES, CONTRACTOR SHALL PROVIDE THE ACTUAL PIPE LENGTH DETERMINED ACCOUNTING FOR THE SLOPE OR VERTICAL CURVE ON WHICH PIPELINES ARE INSTALLED.
- UNLESS OTHERWISE SPECIFIED, INDICATED ON THE DRAWINGS, OR DIRECTED BY THE ENGINEER, INSTALL PIPELINES SLOPING DOWNWARD FROM AN AIR VALVE. HIGH POINTS IN PIPELINES WILL NOT BE PERMITTED EXCEPT AT LOCATIONS OF AIR VALVES AS INDICATED ON THE DRAWINGS. REVIEW PIPELINE PROFILE REQUIREMENTS WITH THE ENGINEER PRIOR TO PREPARING LAYING SCHEDULES AND PERFORMING FIELD CONSTRUCTION STAKING.
- PROVIDE A MINIMUM 5 FEET COVER FOR ALL PIPELINES, INCLUDING BLOW-OFFS, BASED ON FINISHED GRADE.
- AIR RELEASE VALVES AND ISOLATION VALVES SHALL BE INSTALLED BELOW THE LEVEL IDENTIFIED ABOVE FOR REQUIRED MINIMUM COVER.
- CONTRACTOR SHALL DETERMINE ACCURATE LOCATION, ELEVATION, AND ARRANGEMENT OF CONNECTIONS OF NEW PIPELINES WITH EXISTING PIPELINES BASED ON ACTUAL CONDITIONS IN THE FIELD, INCLUDING EXPOSING EXISTING PIPING, PRIOR TO FABRICATING NEW PIPING. CONTRACTOR SHALL PROVIDE FITTINGS, ADAPTERS, SOLID SLEEVE CLOSURES, AND HARNESSSED MECHANICAL COUPLING, ROTATE FITTINGS, DEFLECT JOINTS, AND MODIFY EXISTING PIPING AS APPLICABLE AND AS REQUIRED TO MAKE CONNECTIONS, INCLUDING ADJUSTMENTS FOR ANY OFFSETS IN CENTERLINE ELEVATIONS BETWEEN PIPELINES. CONTRACTOR SHALL PROVIDE TEMPORARY PLUG WITH FACTORY OUTLET SIZED AS REQUIRED FOR CONTRACTOR'S TESTING AND DISINFECTION WORK BEFORE MAKING CONNECTION, WHERE APPLICABLE. CONTRACTOR SHALL COORDINATE MAKING EACH CONNECTION WITH THE OWNER.
- ALL DUCTILE IRON PIPE (DIP) SHALL BE PROTECTED WITH POLYETHYLENE ENCASEMENT. LOCATIONS WHERE DIP IS TO BE WRAPPED (SINGLE OR DOUBLE) WITH POLYETHYLENE ENCASEMENT, AND WHERE PRESTRESSED CONCRETE CYLINDER (PCCP) AND CONCRETE BAR-WRAPPED, STEEL CYLINDER PIPE ARE TO BE WRAPPED (SINGLE OR DOUBLE) WITH POLYETHYLENE ENCASEMENT ARE AS SPECIFIED AND AS INDICATED ON THE DRAWINGS.
- PROVIDE BURIED POTABLE WATER PIPELINE HORIZONTAL AND VERTICAL SEPARATION FROM SANITARY SEWER AND OTHER PIPELINES AS REQUIRED BY STATE-SPECIFIC DEPARTMENT OF HEALTH AND ENVIRONMENTAL QUALITY RULES AND REGULATIONS.



Black & Veatch Corporation
Chicago, Illinois
ILLINOIS PROFESSIONAL
DESIGN FIRM - 184.002143 -0006



**AEROBIC GRANULAR
SLUDGE - PHASE 1**

REVISIONS AND RECORD OF ISSUE	
DESIGNED:	SM
DETAILED:	AB
CHECKED:	AM/JH
APPROVED:	MR
DATE:	12/20/2022
PROJECT NO.:	411752

GENERAL


CIVIL

LEGENDS AND GENERAL
NOTES

00-C-001

30
OF
163

PLOTTED: 12/12/2022 6:06:58 PM
 FILE: C:\PW\WORKING\BWV_AMERICAS\01495388\00-C-101.DWG
 FDI1000
 011000

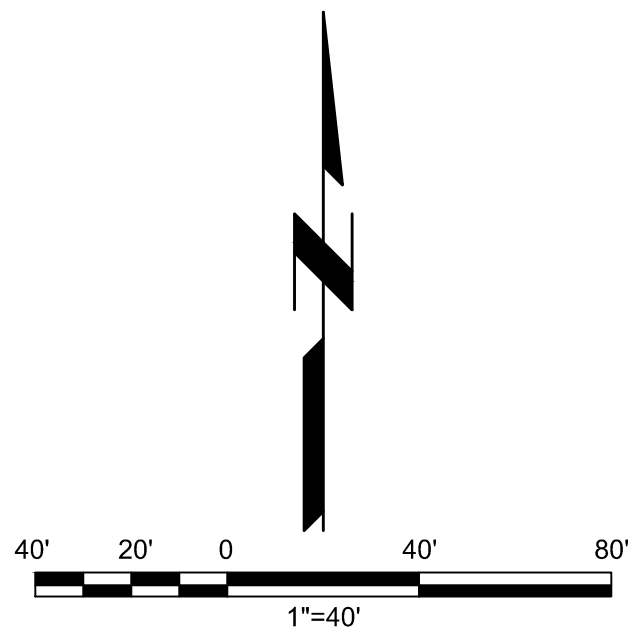

- NOTES:**
- SEE DWG 00-C-001 FOR LEGEND AND GENERAL NOTES AND PROJECT BENCHMARK INFORMATION.
 - CONTRACTOR SHALL ESTABLISH ADDITIONAL CONTROL POINTS AND BENCHMARKS AS REQUIRED TO MAINTAIN ADEQUATE CONTROL. SOME ESTABLISHED CONTROL POINTS AND BENCHMARKS MAY BE DISTURBED OR DESTROYED BY CONSTRUCTION.
 - CONTRACTOR SHALL MAINTAIN ACCESS TO EXISTING FACILITIES TO REMAIN DURING CONSTRUCTION FOR DELIVERIES.
 - FOR INTERFACE POINTS, CONTRACTOR SHALL UNDERTAKE CONSTRUCTION WORK IN COORDINATION WITH PRIMARY FILTRATION PROJECT PHASE 1.



Black & Veatch Corporation
Chicago, Illinois
ILLINOIS PROFESSIONAL
DESIGN FIRM - 184.002143 -0006



AEROBIC GRANULAR
SLUDGE - PHASE 1

REVISIONS AND RECORD OF ISSUE	
DESIGNED:	SM
DETAILED:	AB
CHECKED:	AM/JH
APPROVED:	MR
DATE:	12/20/2022
PROJECT NO.:	411752

GENERAL

CIVIL

KEY AND FACILITY
ARRANGEMENT PLAN

00-C-101



31
OF
163

(SCALE BAR IS 4" AT FULL SCALE) 0 1/2 1 2 3 4

PLOTTED: 12/19/2022 5:38:48 PM
FILE: C:\PW\WORKING\BWV_AMERICAS\01495388\00-C-102.DWG
FDI1000
D11000

LEGEND:


- STAGING \ LAYDOWN AREA
- INLET PROTECTION
- SILT FENCE

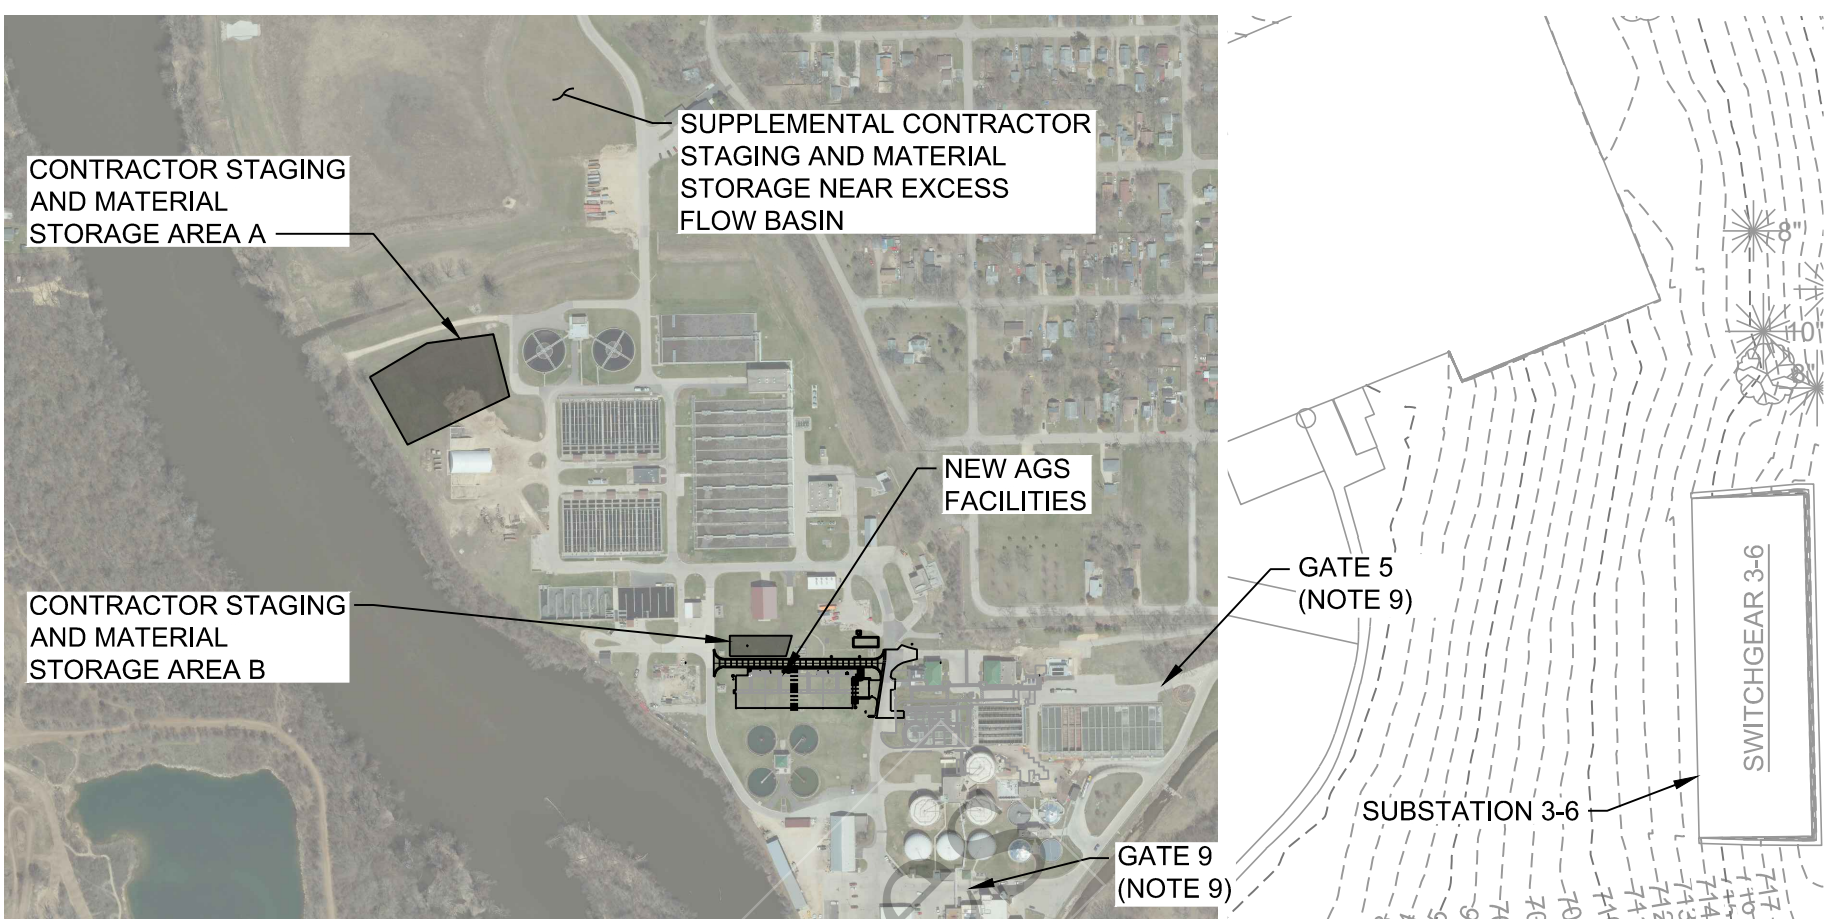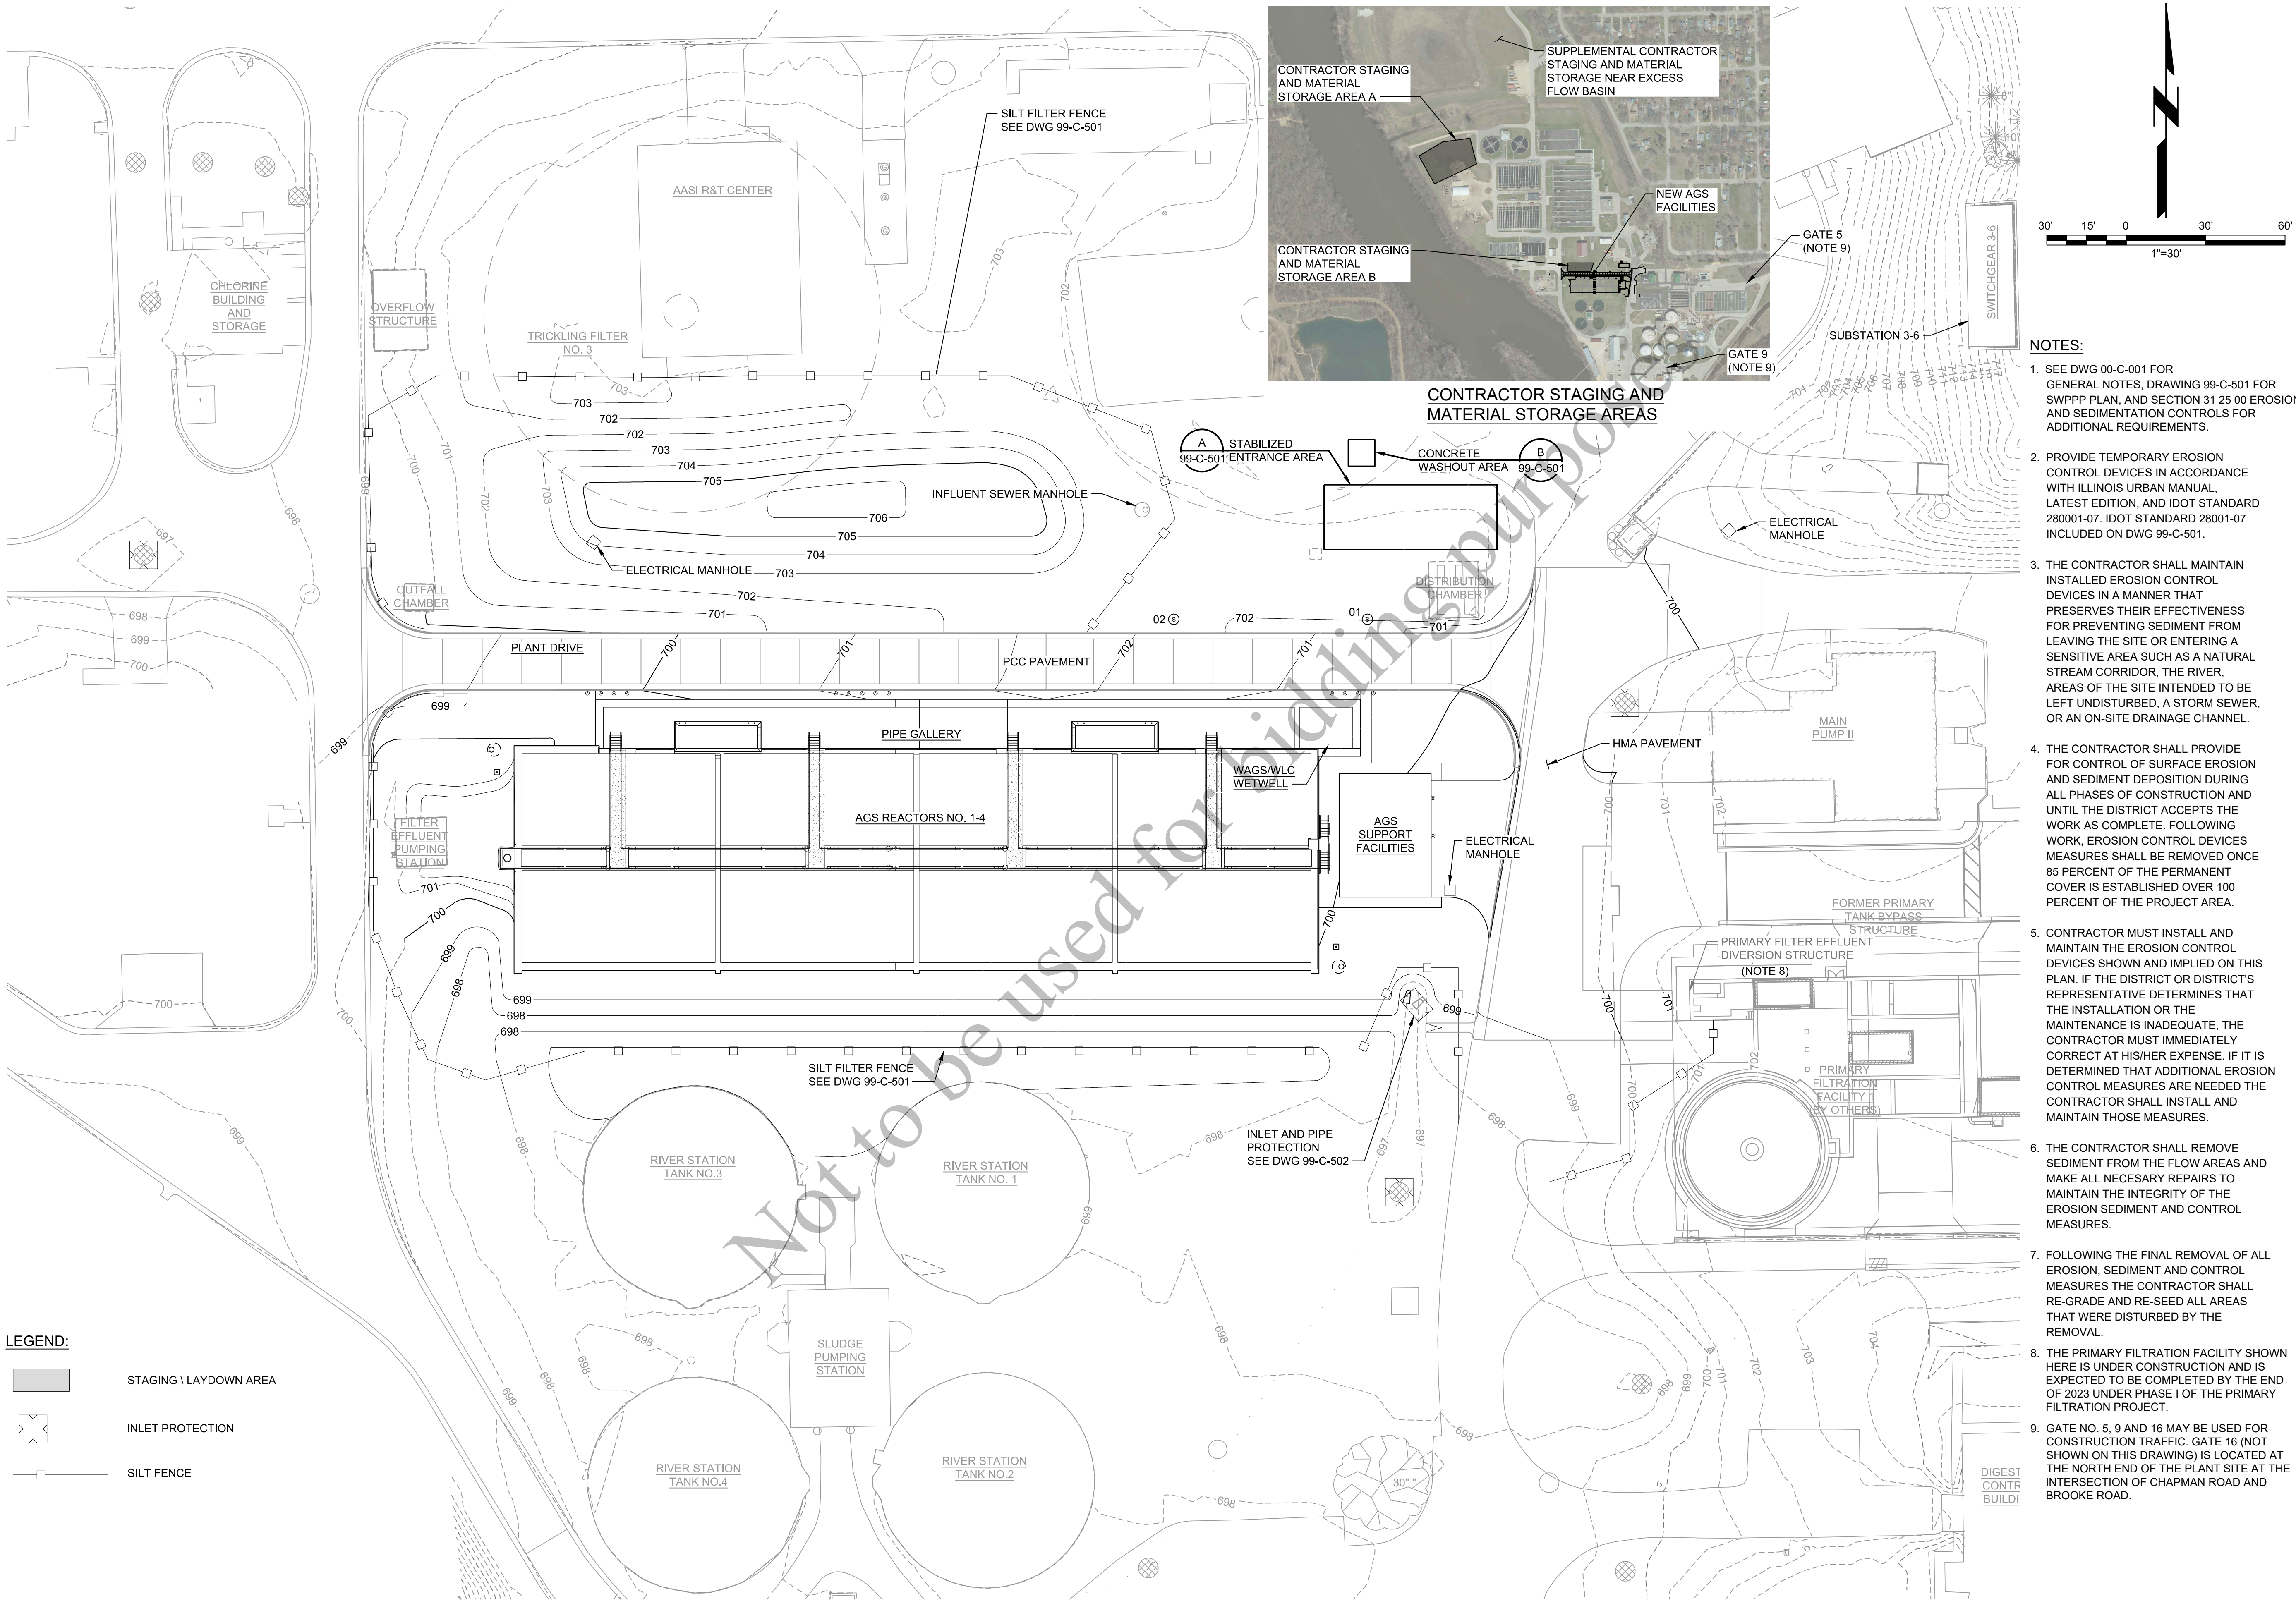

CONTRACTOR STAGING AND MATERIAL STORAGE AREAS

A STABILIZED 99-C-501 ENTRANCE AREA

B CONCRETE WASHOUT AREA 99-C-501

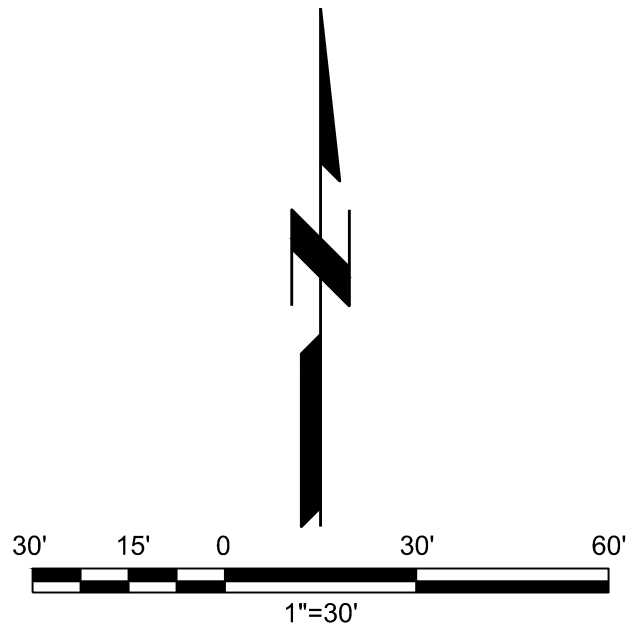

NOTES:

- SEE DWG 00-C-001 FOR GENERAL NOTES, DRAWING 99-C-501 FOR SWPPP PLAN, AND SECTION 31 25 00 EROSION AND SEDIMENTATION CONTROLS FOR ADDITIONAL REQUIREMENTS.
- PROVIDE TEMPORARY EROSION CONTROL DEVICES IN ACCORDANCE WITH ILLINOIS URBAN MANUAL, LATEST EDITION, AND IDOT STANDARD 280001-07. IDOT STANDARD 28001-07 INCLUDED ON DWG 99-C-501.
- THE CONTRACTOR SHALL MAINTAIN INSTALLED EROSION CONTROL DEVICES IN A MANNER THAT PRESERVES THEIR EFFECTIVENESS FOR PREVENTING SEDIMENT FROM LEAVING THE SITE OR ENTERING A SENSITIVE AREA SUCH AS A NATURAL STREAM CORRIDOR, THE RIVER, AREAS OF THE SITE INTENDED TO BE LEFT UNDISTURBED, A STORM SEWER, OR AN ON-SITE DRAINAGE CHANNEL.
- THE CONTRACTOR SHALL PROVIDE FOR CONTROL OF SURFACE EROSION AND SEDIMENT DEPOSITION DURING ALL PHASES OF CONSTRUCTION AND UNTIL THE DISTRICT ACCEPTS THE WORK AS COMPLETE. FOLLOWING WORK, EROSION CONTROL DEVICES MEASURES SHALL BE REMOVED ONCE 85 PERCENT OF THE PERMANENT COVER IS ESTABLISHED OVER 100 PERCENT OF THE PROJECT AREA.
- CONTRACTOR MUST INSTALL AND MAINTAIN THE EROSION CONTROL DEVICES SHOWN AND IMPLIED ON THIS PLAN. IF THE DISTRICT OR DISTRICT'S REPRESENTATIVE DETERMINES THAT THE INSTALLATION OR THE MAINTENANCE IS INADEQUATE, THE CONTRACTOR MUST IMMEDIATELY CORRECT AT HIS/HER EXPENSE. IF IT IS DETERMINED THAT ADDITIONAL EROSION CONTROL MEASURES ARE NEEDED THE CONTRACTOR SHALL INSTALL AND MAINTAIN THOSE MEASURES.
- THE CONTRACTOR SHALL REMOVE SEDIMENT FROM THE FLOW AREAS AND MAKE ALL NECESSARY REPAIRS TO MAINTAIN THE INTEGRITY OF THE EROSION SEDIMENT AND CONTROL MEASURES.
- FOLLOWING THE FINAL REMOVAL OF ALL EROSION, SEDIMENT AND CONTROL MEASURES THE CONTRACTOR SHALL RE-GRADE AND RE-SEED ALL AREAS THAT WERE DISTURBED BY THE REMOVAL.
- THE PRIMARY FILTRATION FACILITY SHOWN HERE IS UNDER CONSTRUCTION AND IS EXPECTED TO BE COMPLETED BY THE END OF 2023 UNDER PHASE I OF THE PRIMARY FILTRATION PROJECT.
- GATE NO. 5, 9 AND 16 MAY BE USED FOR CONSTRUCTION TRAFFIC. GATE 16 (NOT SHOWN ON THIS DRAWING) IS LOCATED AT THE NORTH END OF THE PLANT SITE AT THE INTERSECTION OF CHAPMAN ROAD AND BROOKE ROAD.

AEROBIC GRANULAR
SLUDGE - PHASE 1

REVISIONS AND RECORD OF ISSUE	
DESIGNED:	SM
DETAILED:	AB
CHECKED:	AM/JH
APPROVED:	MR
DATE:	12/20/2022
PROJECT NO.:	411752

GENERAL

CIVIL



EROSION AND SEDIMENT
CONTROL PLAN

00-C-102

32
OF
163

(SCALE BAR IS 4" AT FULL SCALE) 0 1/2 1 2 3 4

PLOTTED: 12/13/2022 11:09:07 AM
FILE: C:\PW\WORKING\BW\AMERICAS\01495388\00-C-103.DWG
FD1000
D11000

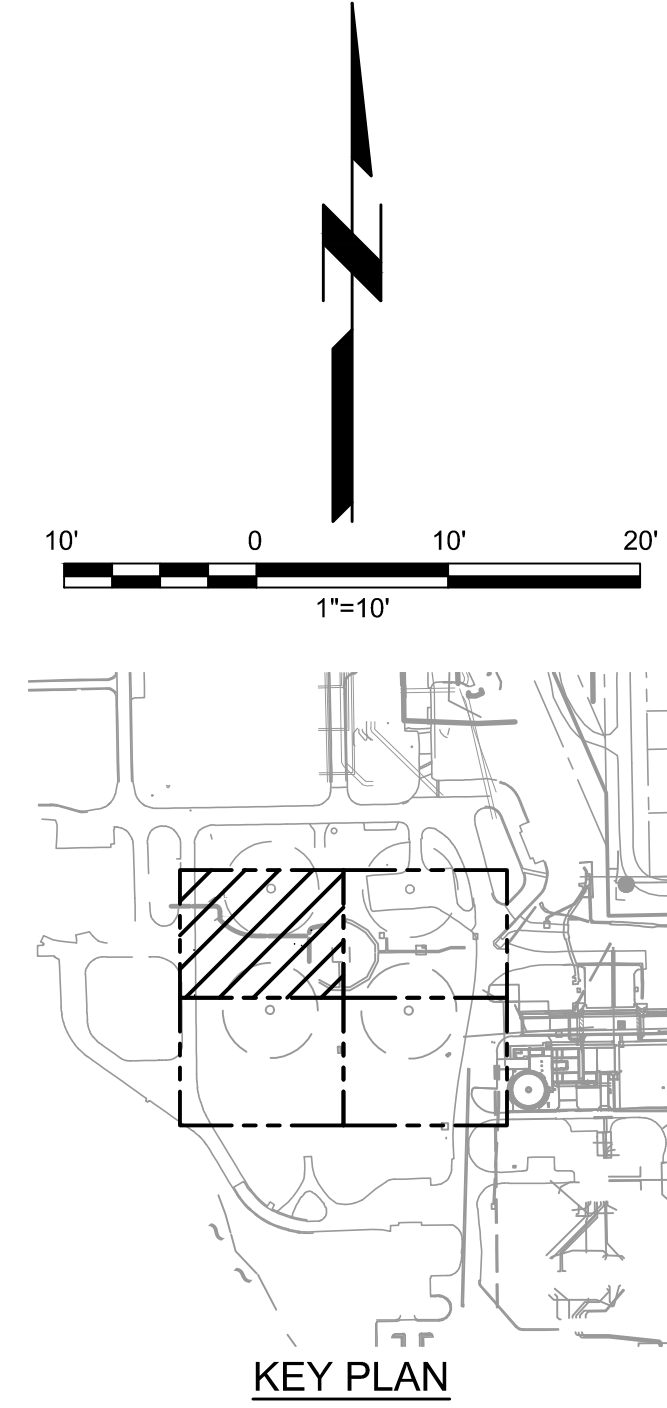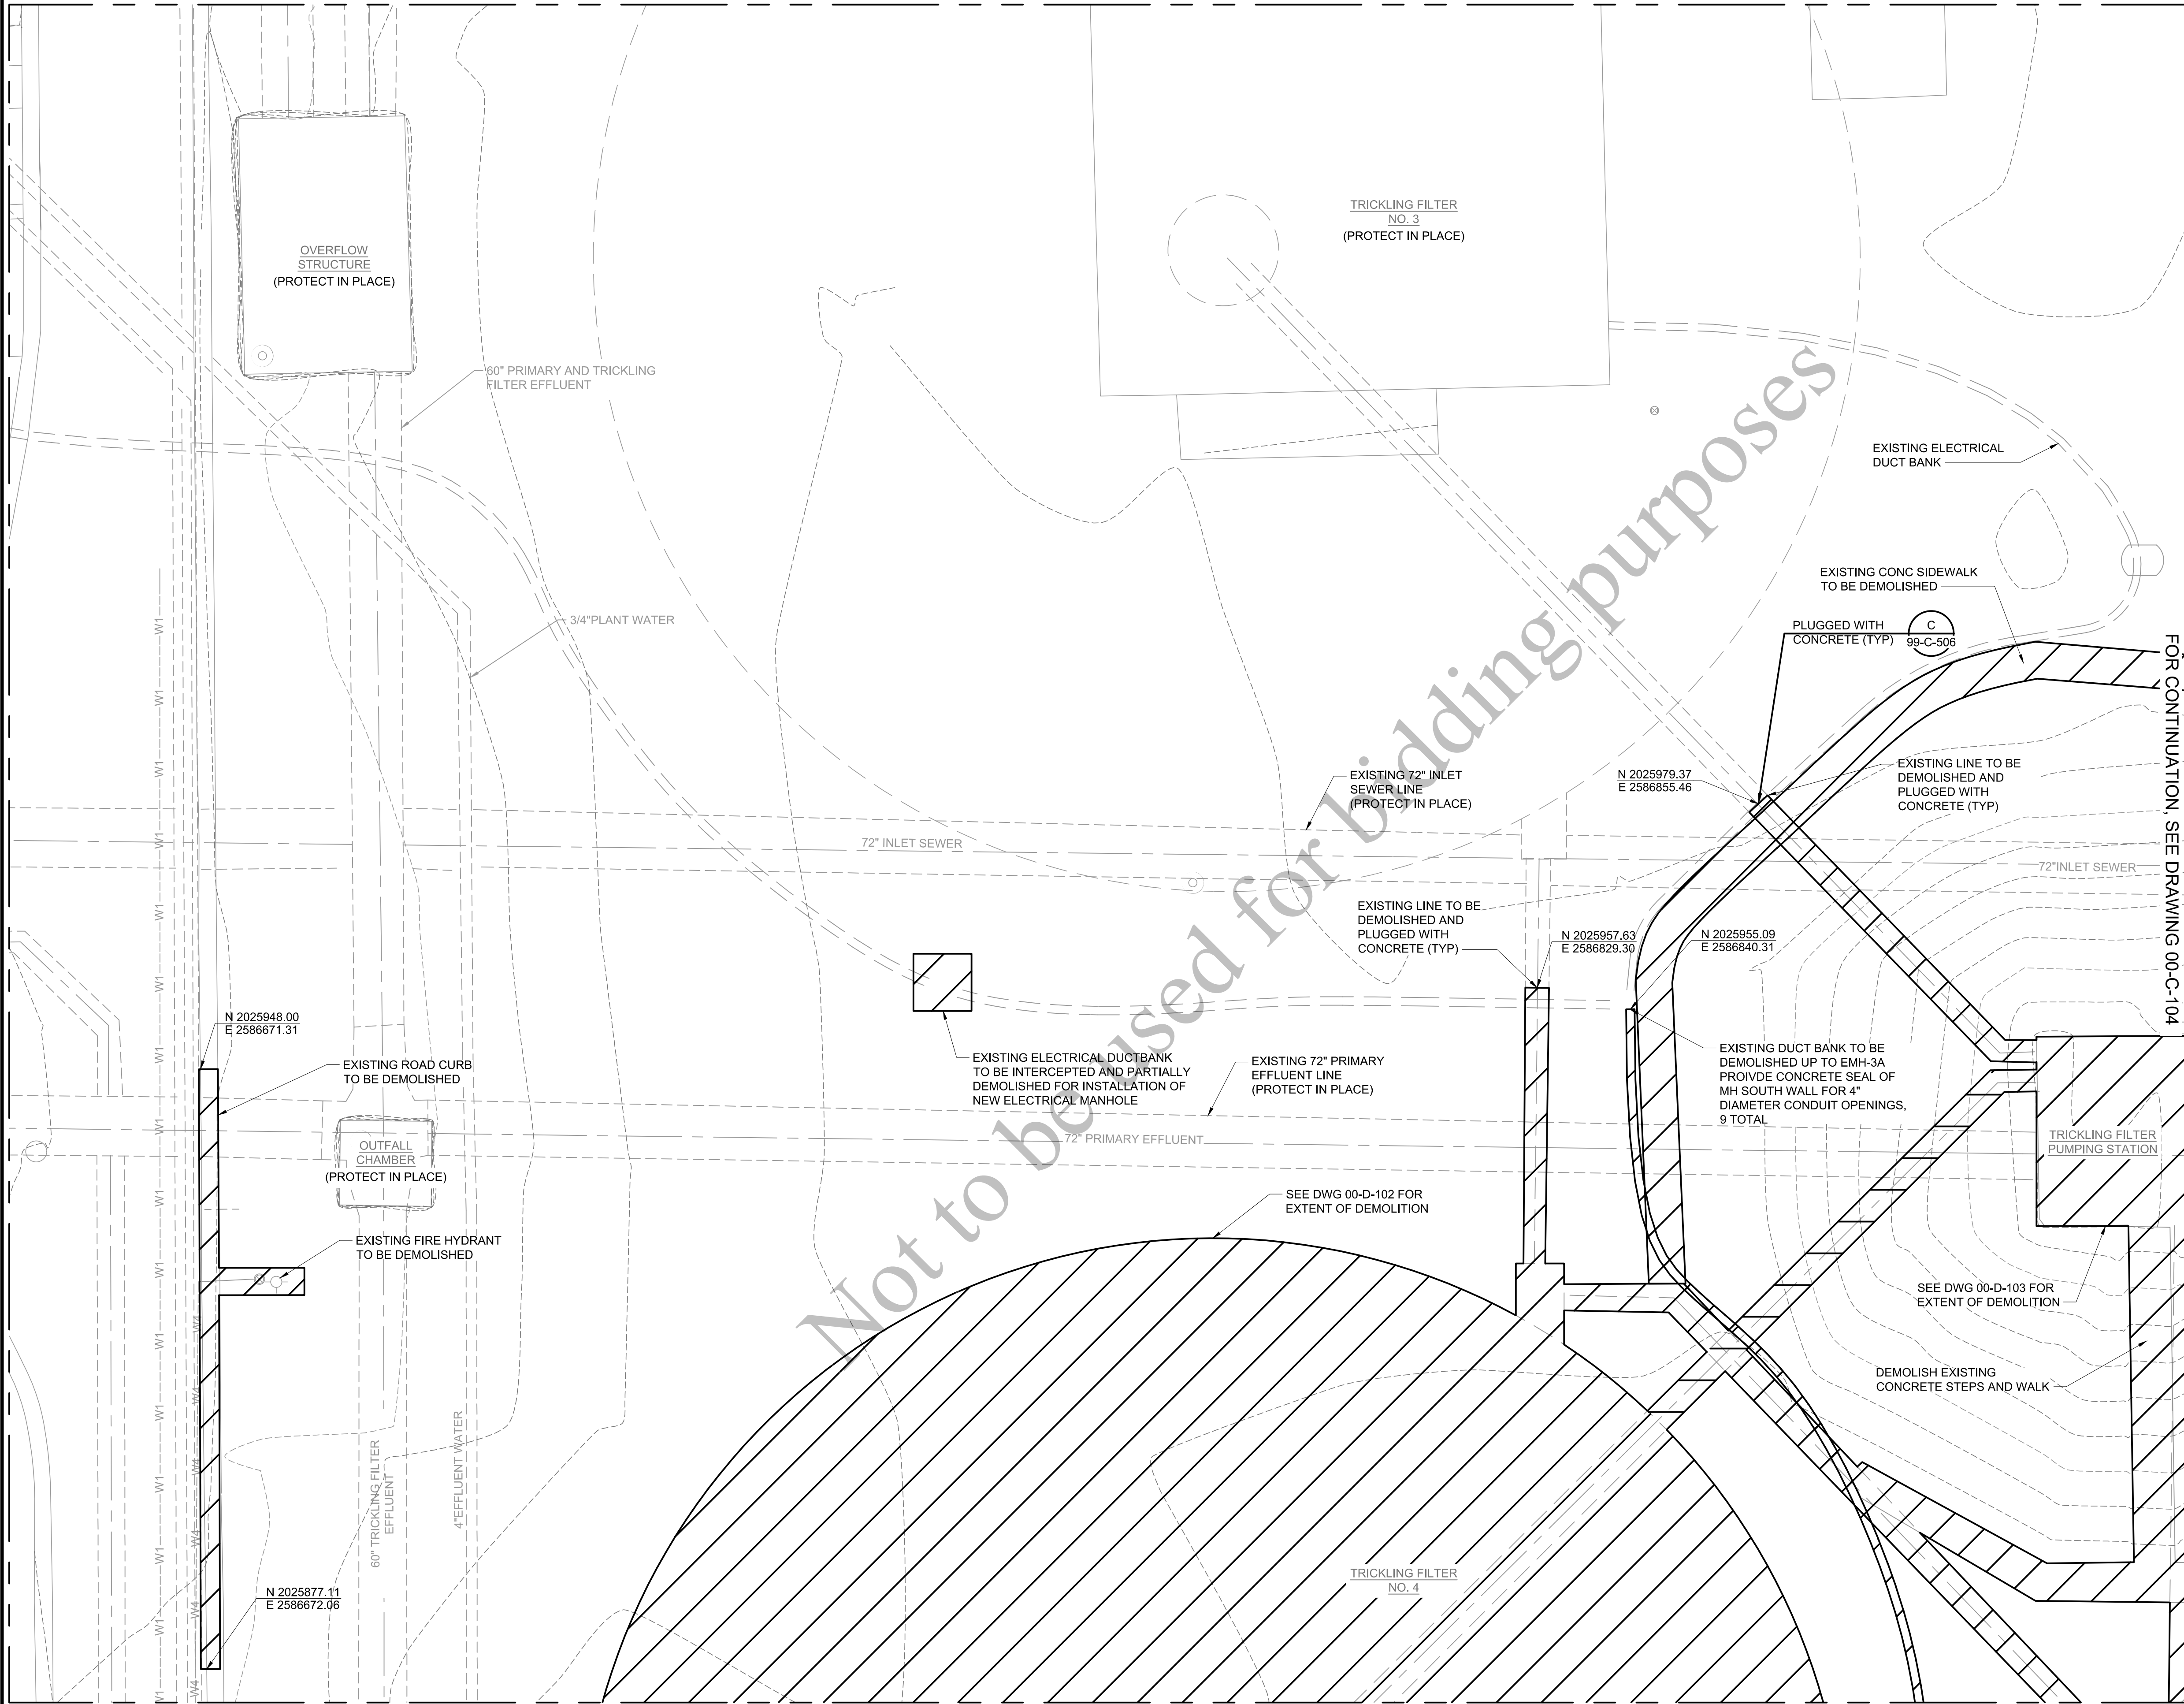

- NOTES:
1. REFER TO DWG 00-D-101 FOR GENERAL REMOVAL NOTES.

Black & Veatch Corporation
Chicago, Illinois
ILLINOIS PROFESSIONAL
DESIGN FIRM - 184.002143 -0006

Four Rivers
Sanitation Authority

**AEROBIC GRANULAR
SLUDGE - PHASE 1**

REVISIONS AND RECORD OF ISSUE	
DESIGNED:	SM
DETAILED:	AB
CHECKED:	AM/JH
APPROVED:	MR
DATE:	12/20/2022
PROJECT NO.:	411752

GENERAL

CIVIL


**EXISTING CONDITIONS
AND REMOVALS
PLAN 1 OF 4**

00-C-103


33
OF
163

(SCALE BAR IS 4" AT FULL SCALE) 0 1/2 1 2 3 4


PLOTTED: 12/13/2022 11:07:06 AM
 FILE: C:\PW\WORKING\BWV_AMERICAS\01495388\00-C-104.DWG
 FD1000
 D11000

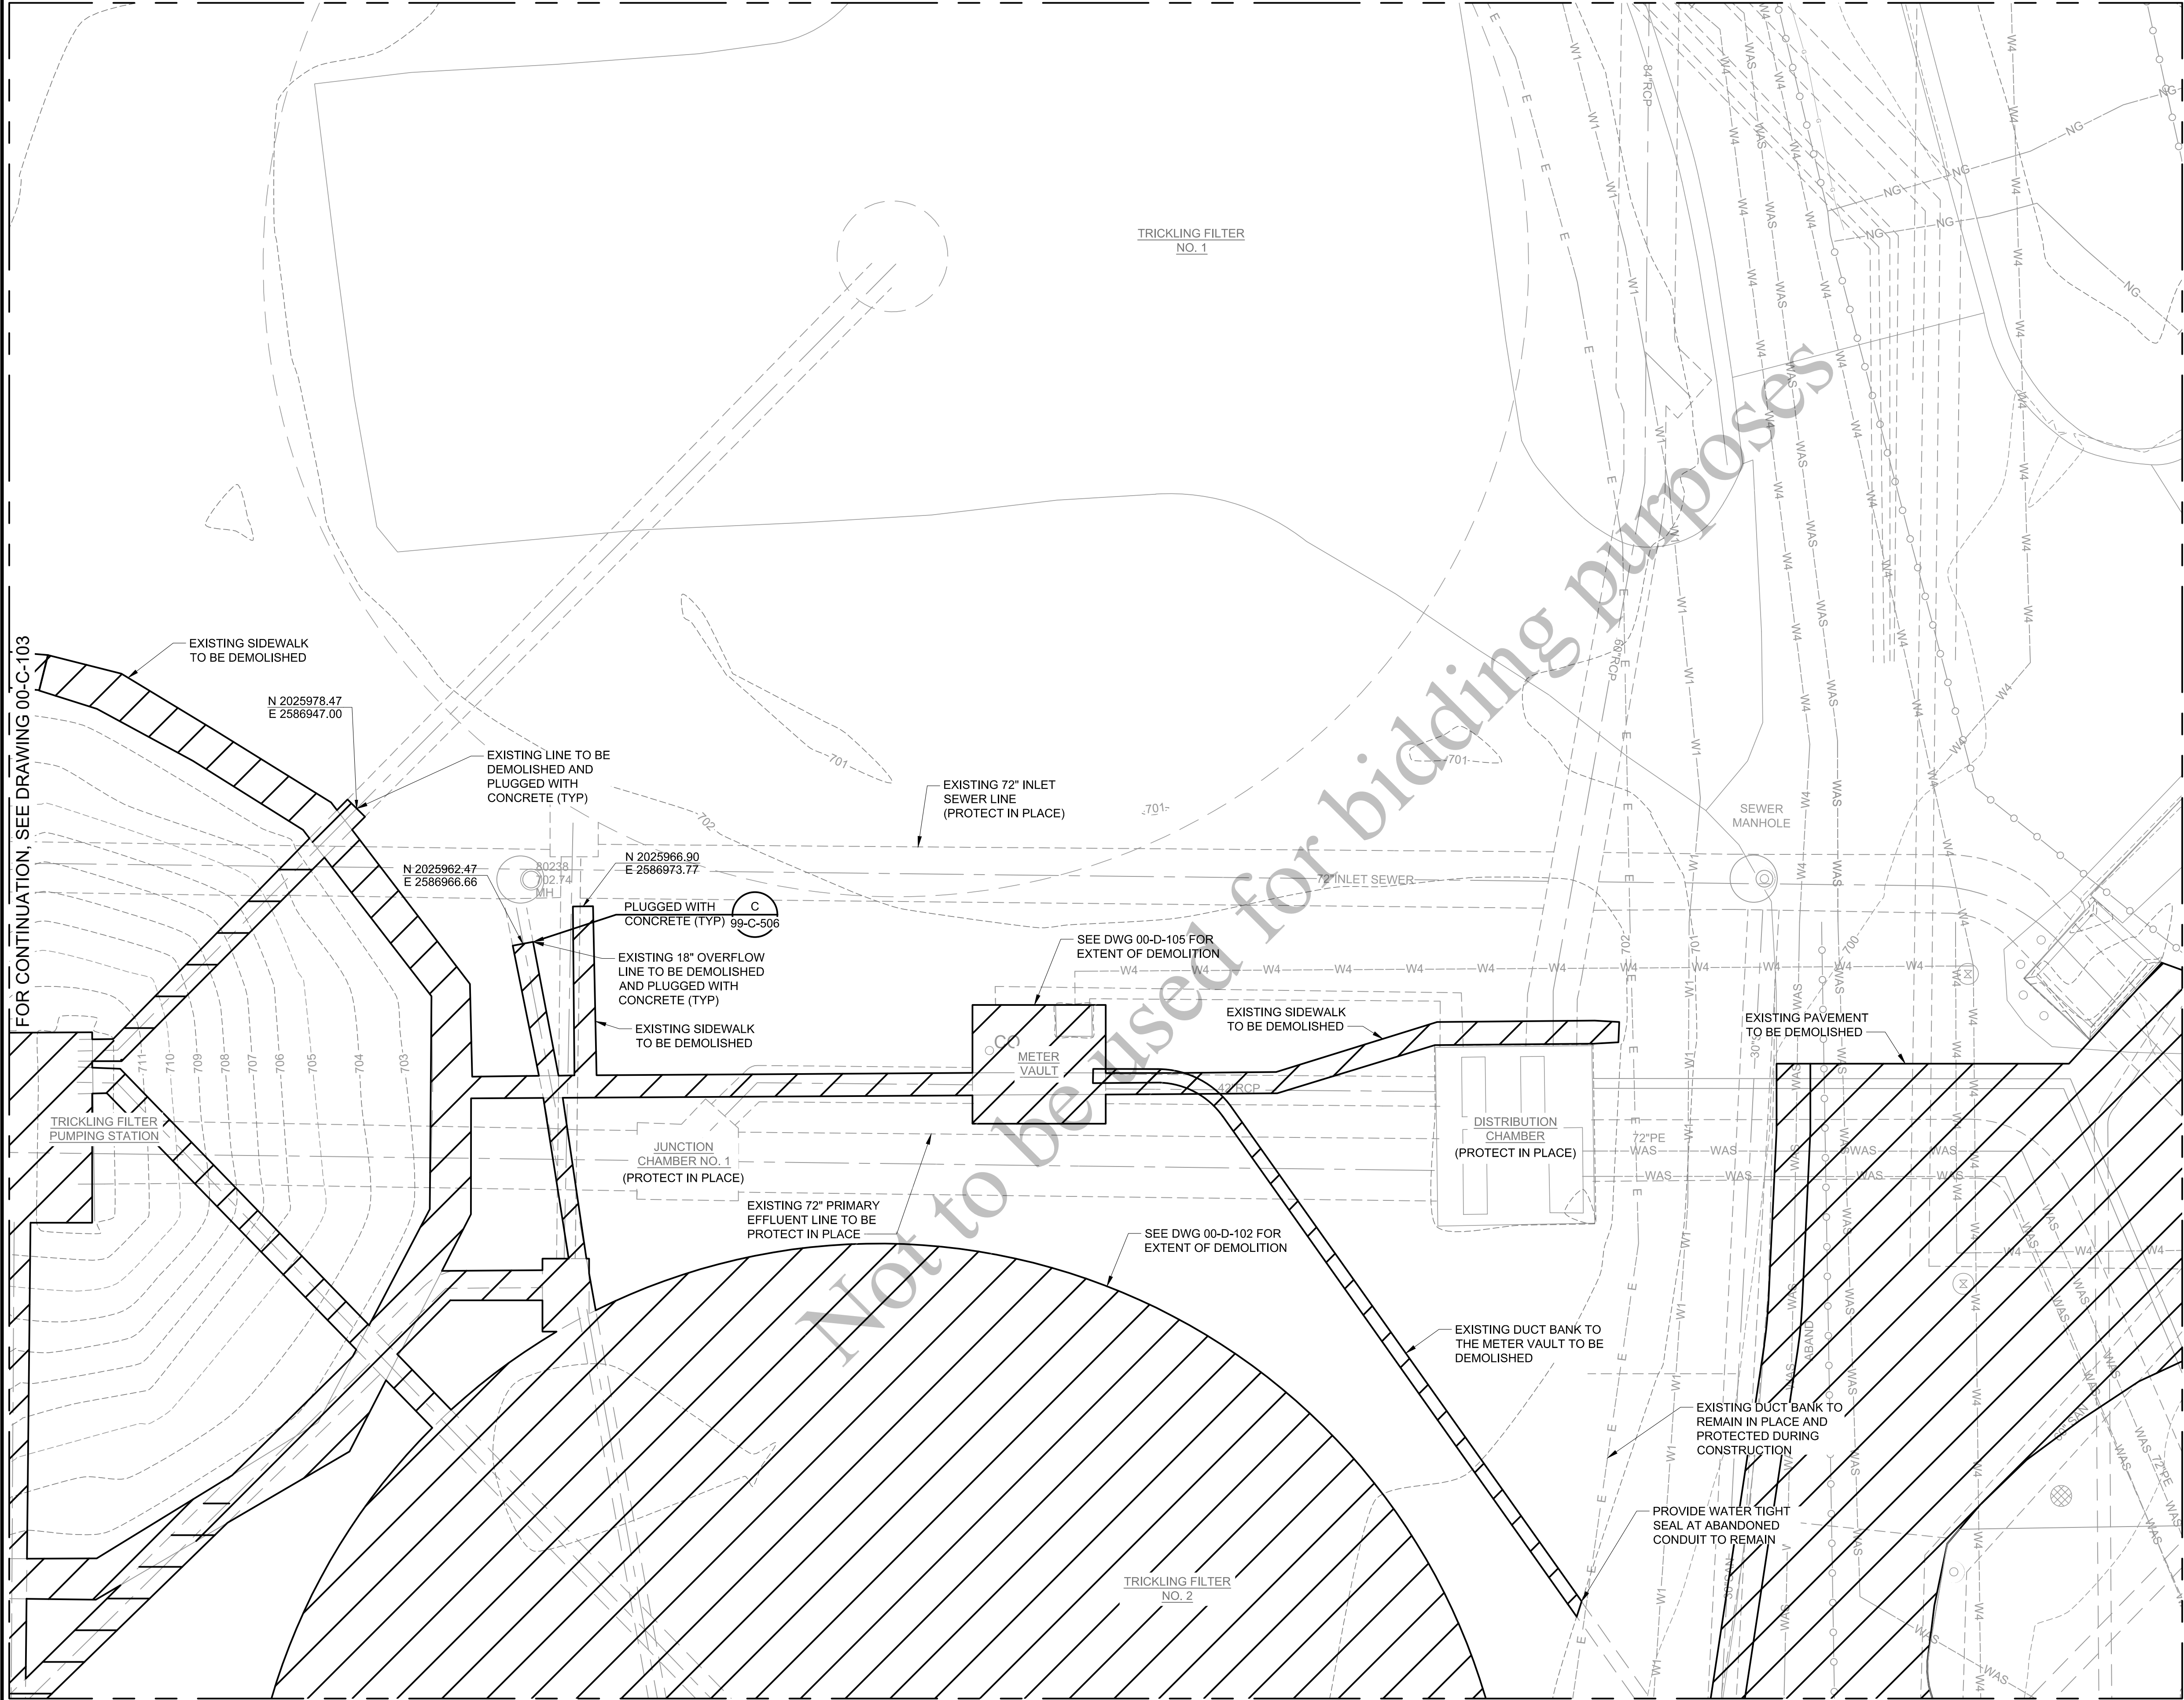


FOR CONTINUATION, SEE DRAWING 00-C-106

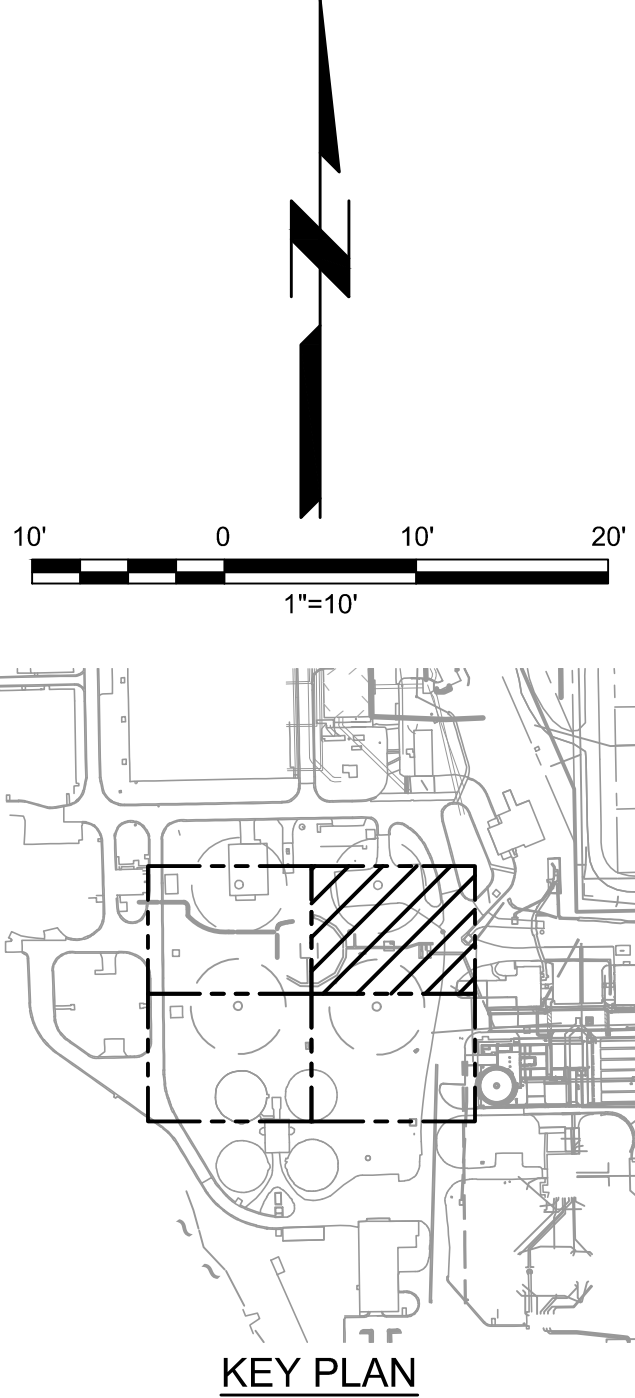

- NOTES:
1. REFER TO DWG 00-D-101 FOR GENERAL REMOVAL NOTES.



Black & Veatch Corporation
Chicago, Illinois
ILLINOIS PROFESSIONAL
DESIGN FIRM - 184.002143 -0006



AEROBIC GRANULAR
SLUDGE - PHASE 1

REVISIONS AND RECORD OF ISSUE	
DESIGNED:	SM
DETAILED:	AB
CHECKED:	AM/JH
APPROVED:	MR
DATE:	12/20/2022
PROJECT NO.:	411752

GENERAL

CIVIL

EXISTING CONDITIONS
AND REMOVALS
PLAN 2 OF 4




00-C-104

34
OF
163

(SCALE BAR IS 4" AT FULL SCALE) 0 1/2 1 2 3 4

PLOTTED: 12/13/2022 11:04:46 AM
FILE: C:\PWL\WORKING\BWV_AMERICAS\01495388\00-C-105.DWG
FD1000
D11000

FOR CONTINUATION, SEE DRAWING 00-C-103

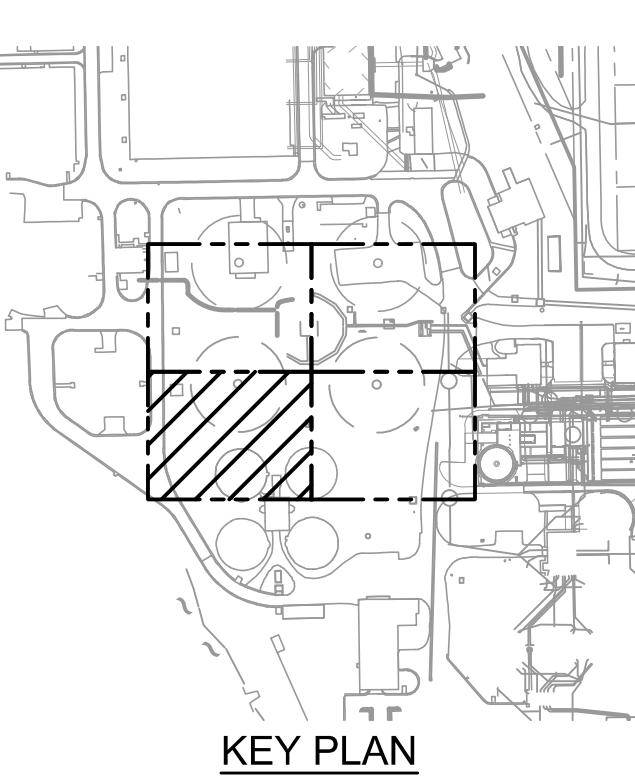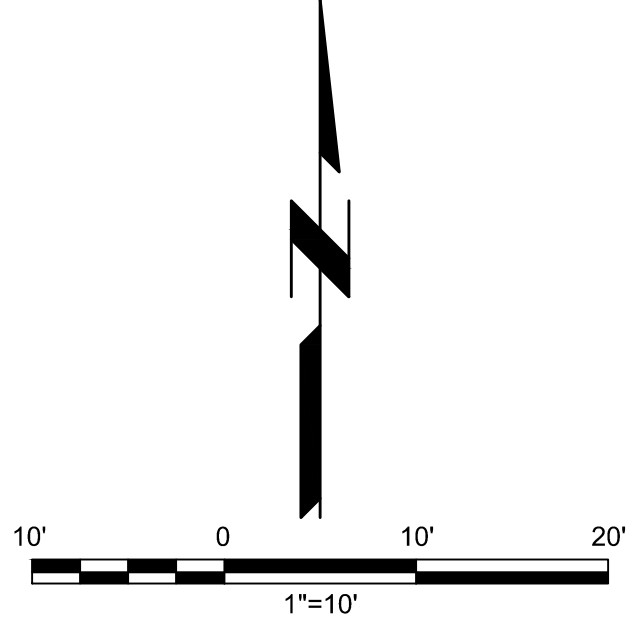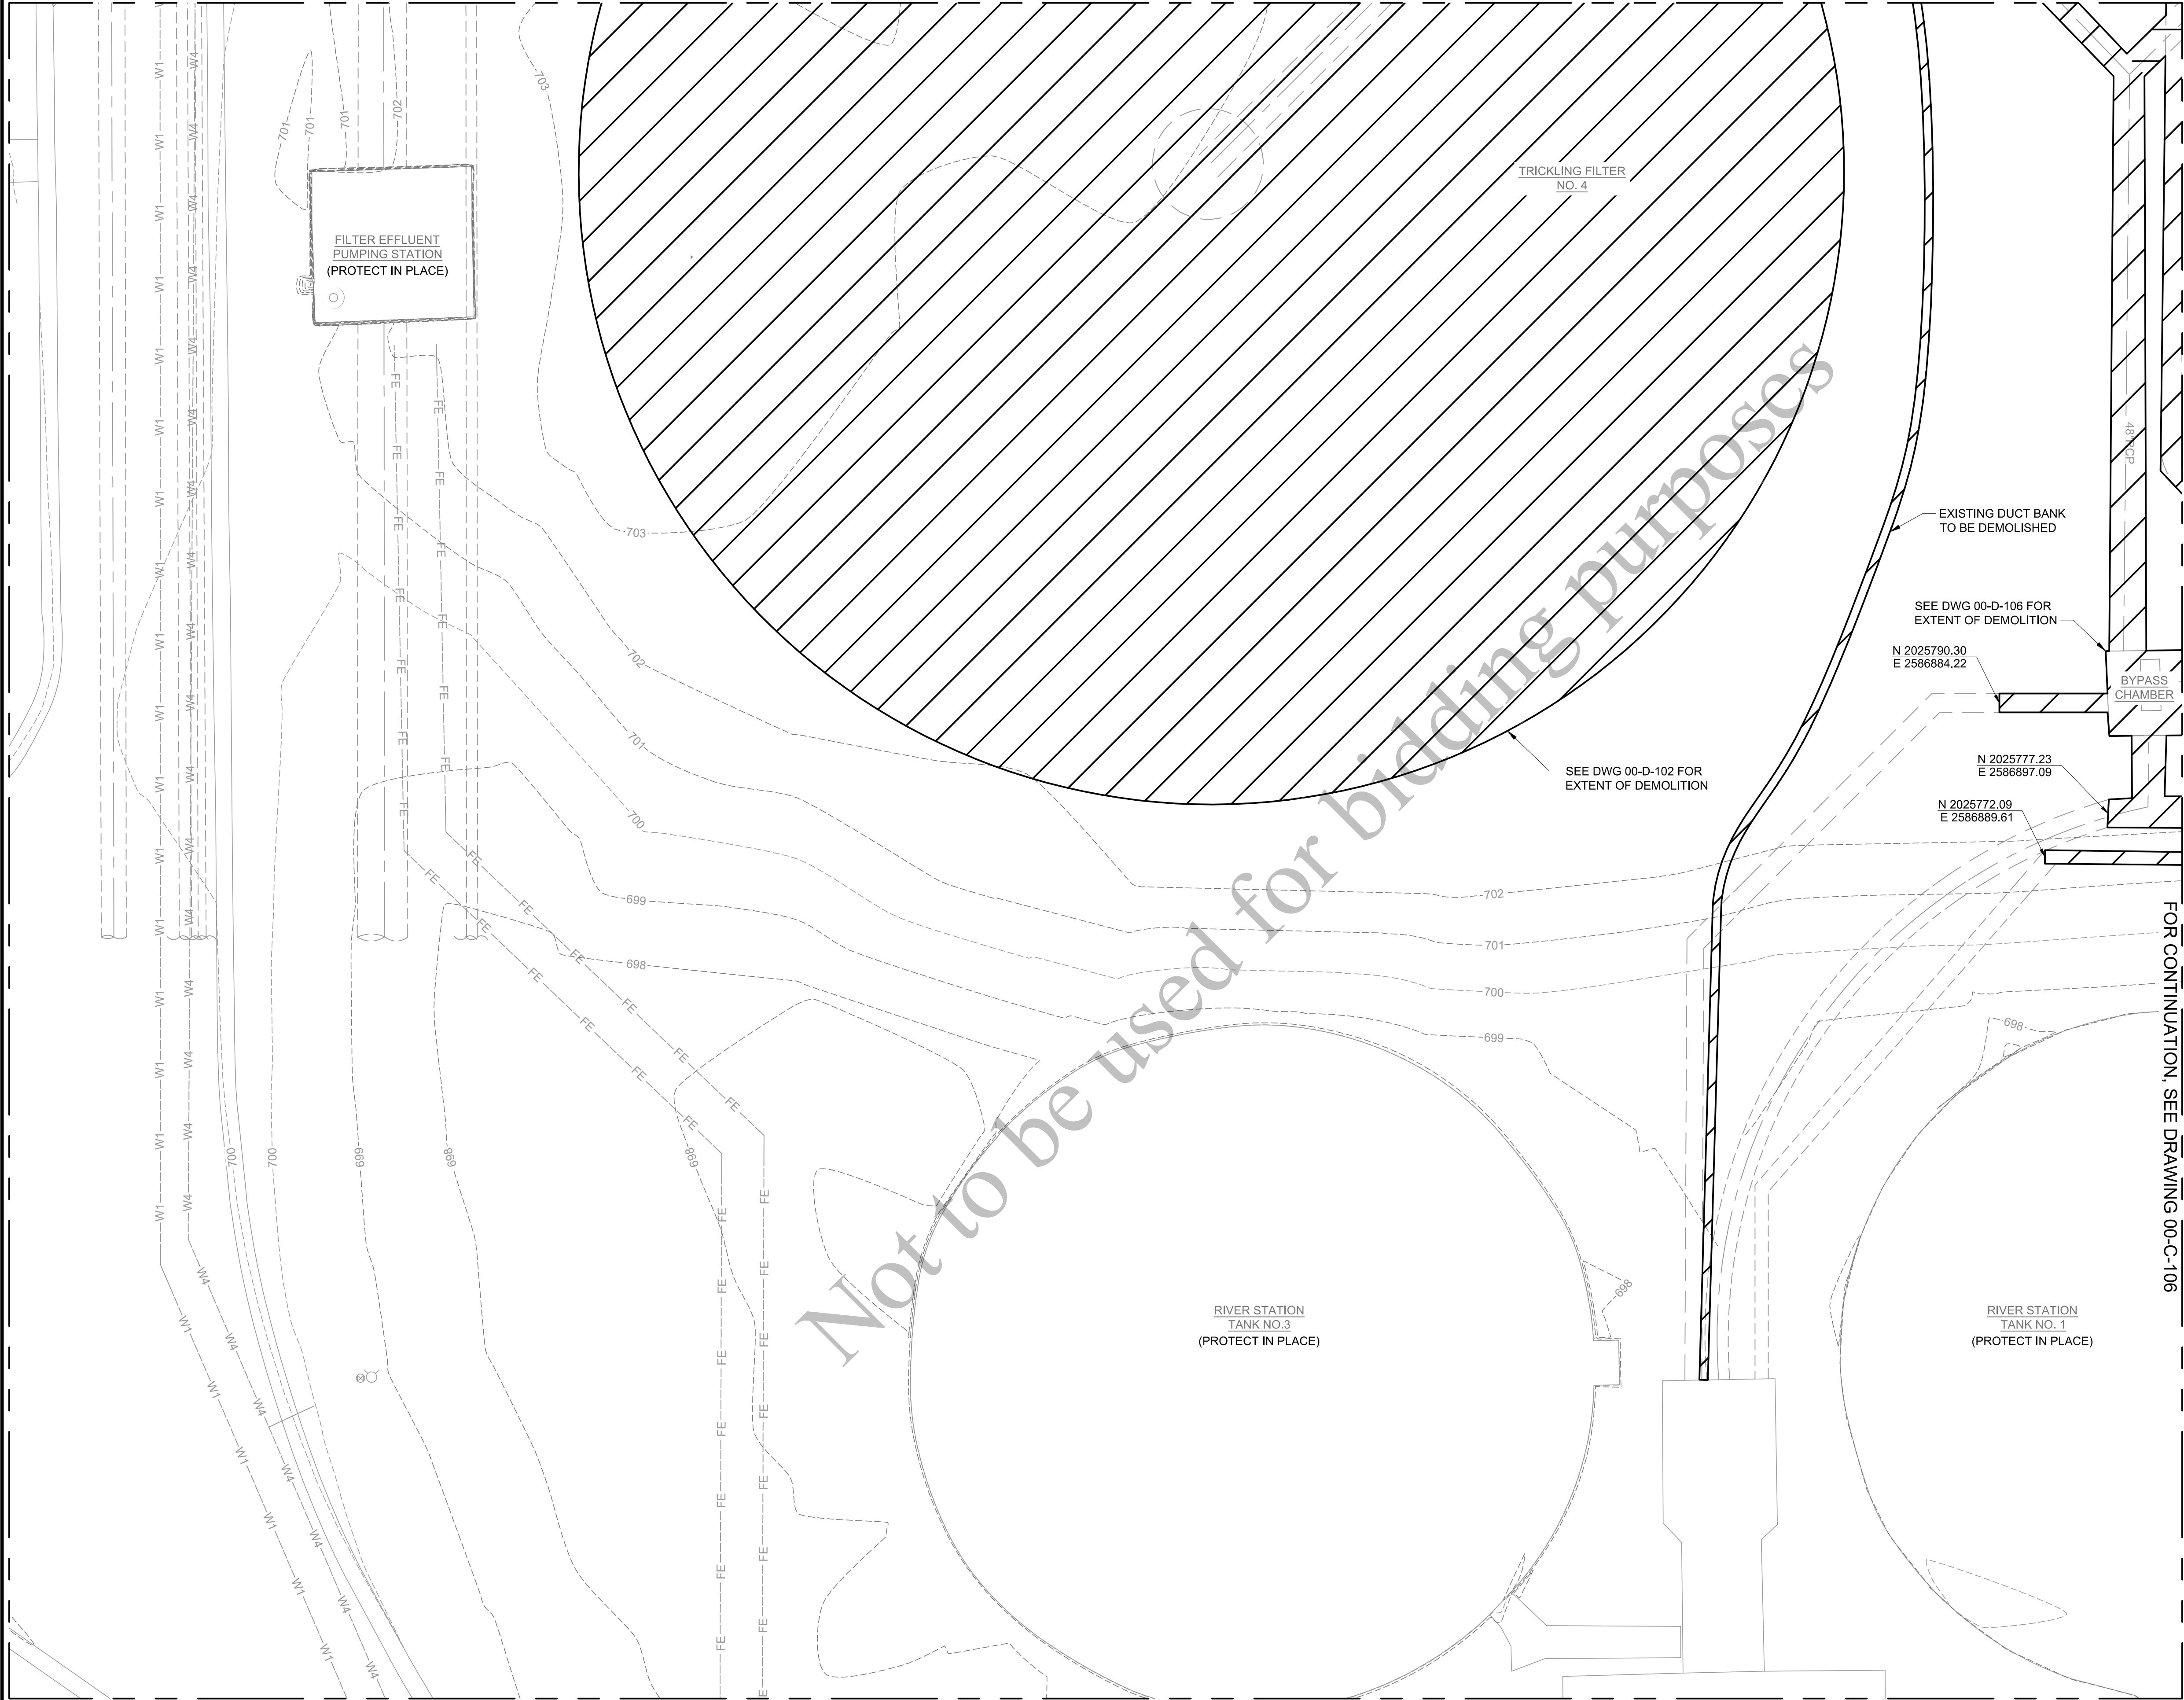

- NOTES:
1. REFER TO DWG 00-D-101 FOR GENERAL REMOVAL NOTES.

BLACK & VEATCH

Black & Veatch Corporation
Chicago, Illinois
ILLINOIS PROFESSIONAL
DESIGN FIRM - 184.002143 -0006

Four Rivers
Sanitation Authority

AEROBIC GRANULAR
SLUDGE - PHASE 1

REVISIONS AND RECORD OF ISSUE	
DESIGNED:	SM
DETAILED:	AB
CHECKED:	AM/JH
APPROVED:	MR
DATE:	12/20/2022
PROJECT NO.:	411752

GENERAL


CIVIL

EXISTING CONDITIONS
AND REMOVALS
PLAN 3 OF 4

00-C-105

35
OF
163

(SCALE BAR IS 4" AT FULL SCALE) 0 1/2 1 2 3 4

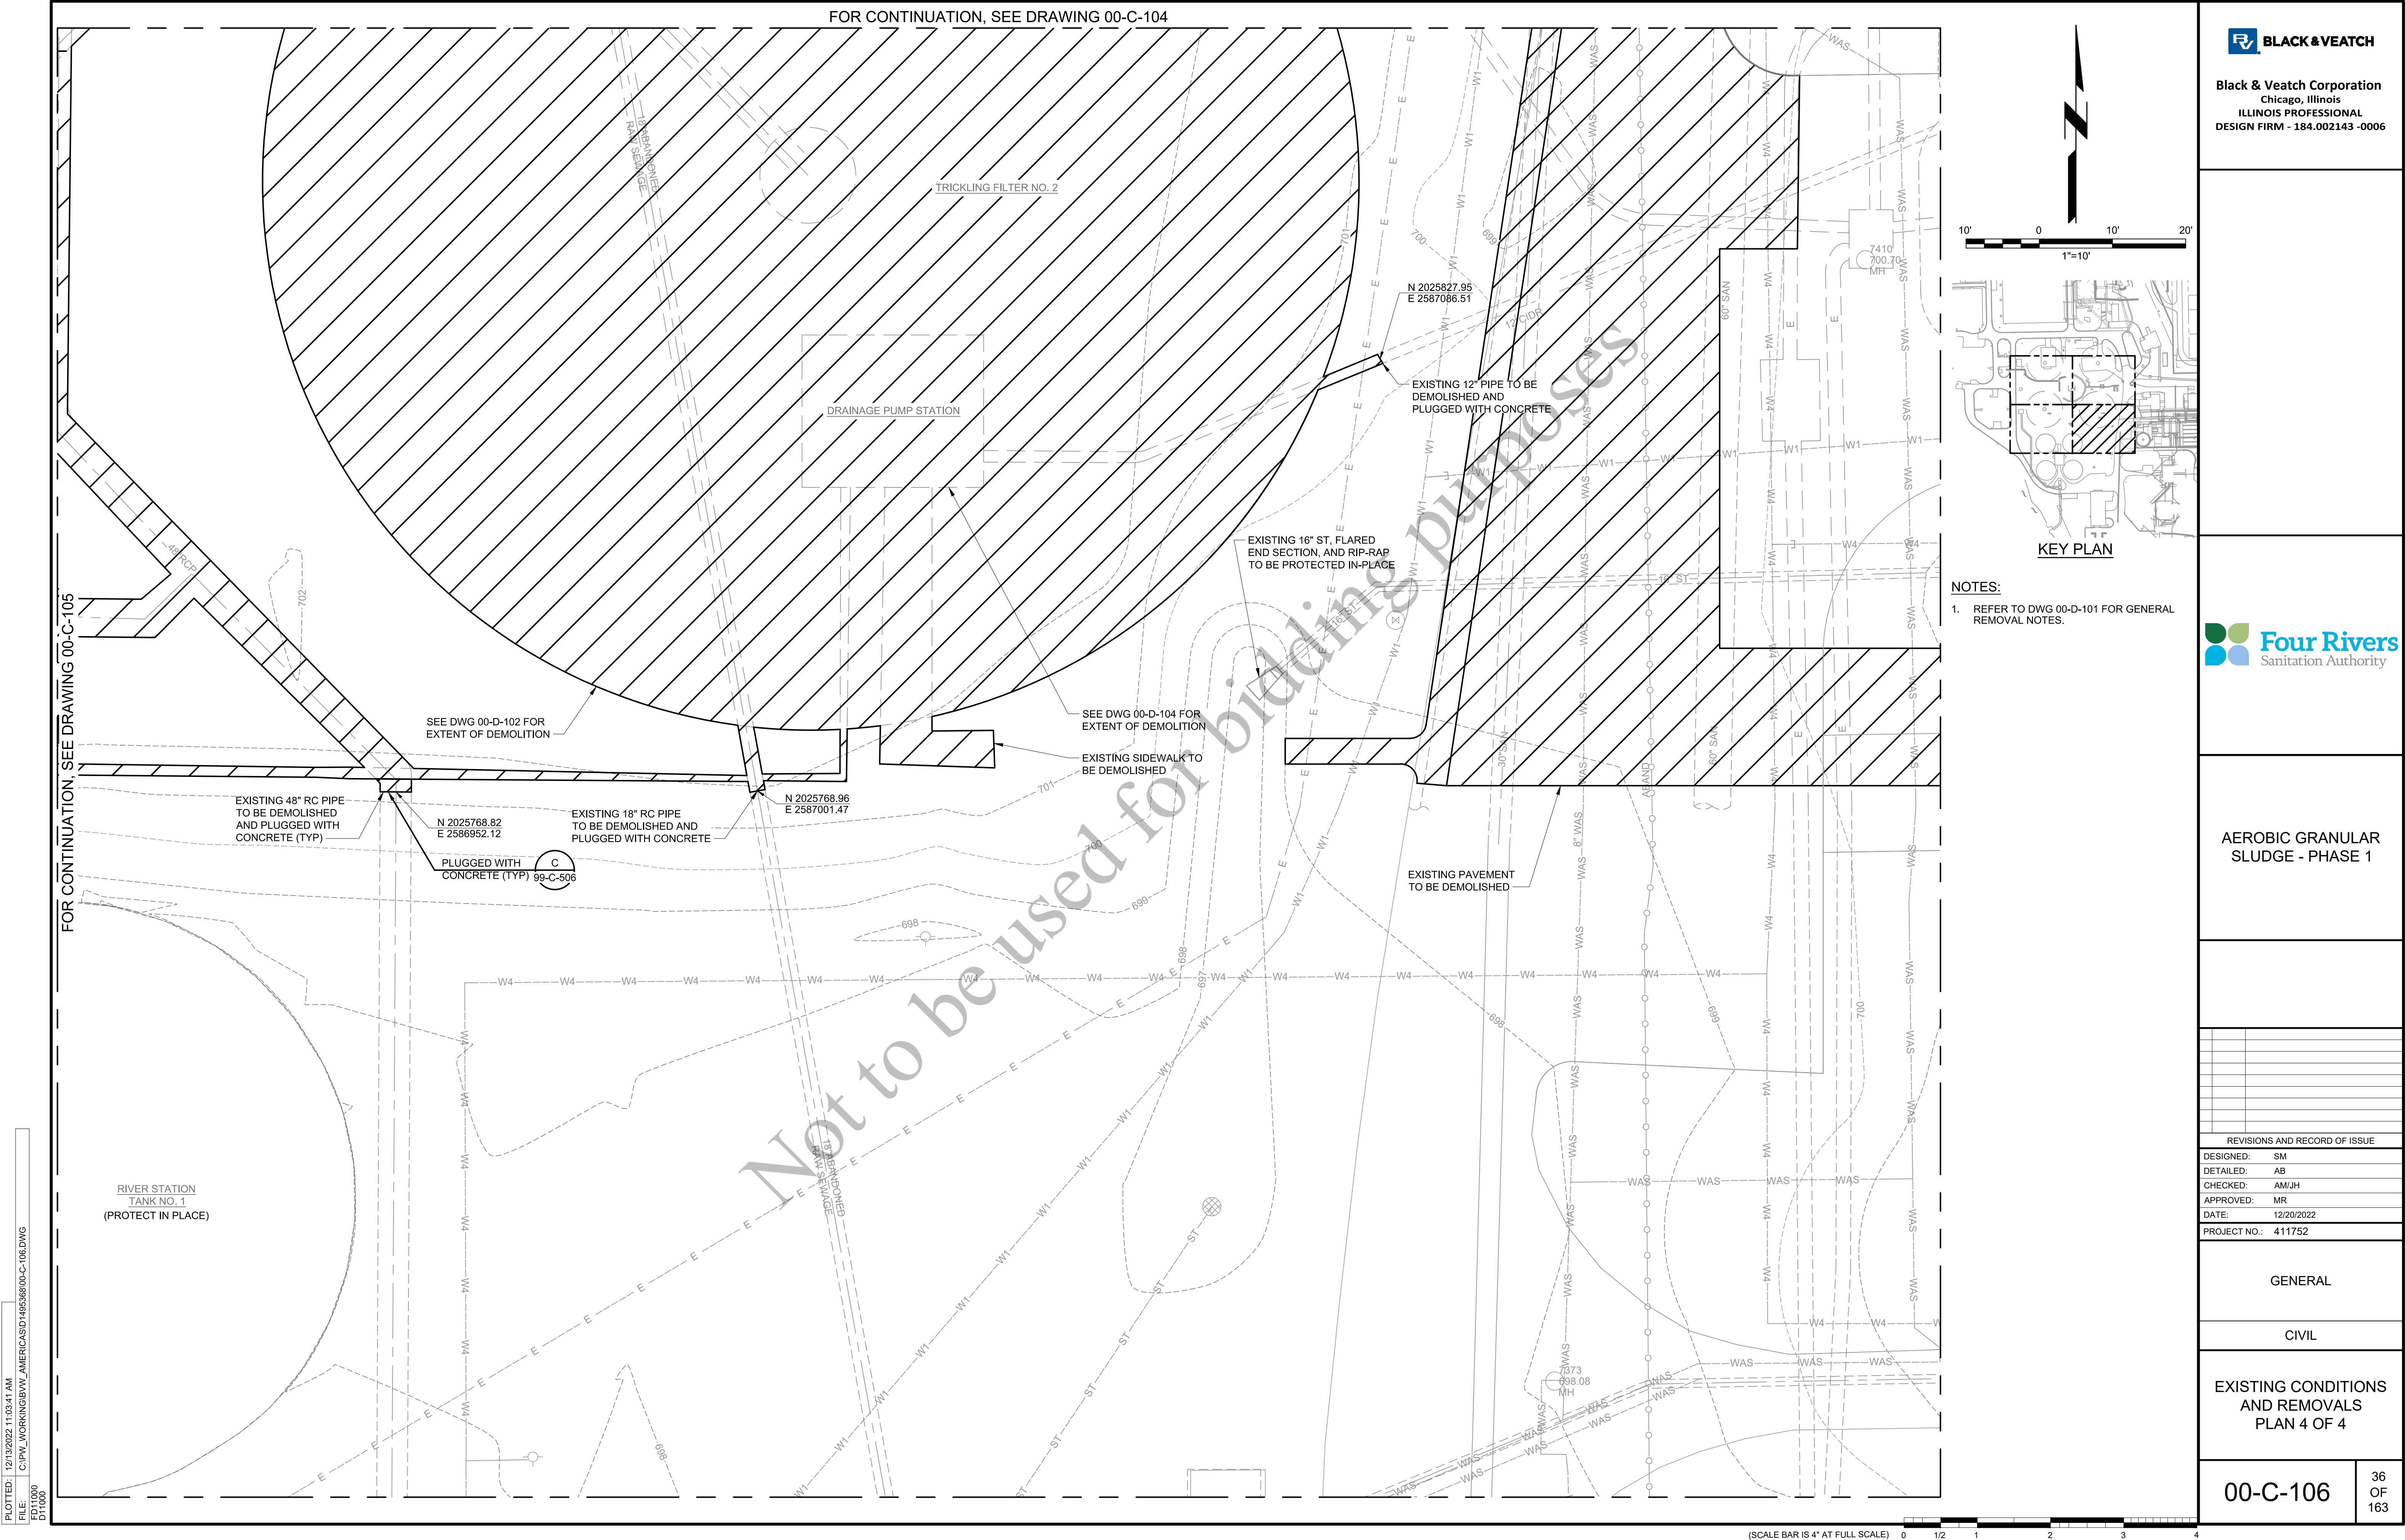


AEROBIC GRANULAR
SLUDGE - PHASE 1

GENERAL

CIVIL

OVERALL PIPING PLAN

00-C-107

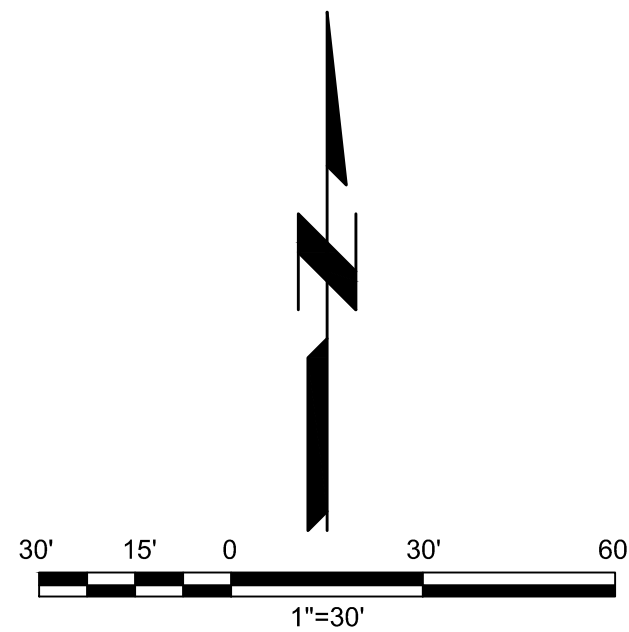37
OF
163

NOTES:

1. SEE DWG 00-C-001 FOR LEGENDS AND GENERAL NOTES.
2. PORTION OF EXISTING INFLUENT SEWER MANHOLE SHALL BE REHABILITATED AND REBUILT TO MAKE NEW 12" WLC BYPASS AND 4" SANITARY SEWER CONNECTION. REFER TO DWG 98-M-104 FOR THE EXTENT OF MANHOLE REHABILITATION.
3. ALL EXISTING PIPING AND BURIED UTILITIES SHALL BE FIELD VERIFIED FOR LOCATION AND ELEVATION AT CROSSINGS AND CONNECTION LOCATIONS.
4. UNLESS OTHERWISE INDICATED, ALL EXISTING YARD PIPING AND STRUCTURES, DUCT BANKS, UTILITIES, ETC. BENEATH NEW CONCRETE PAVEMENT SHALL BE PROTECTED WITH SHEETING, SHORING, OR OTHER MEANS NECESSARY TO PROTECT THEM FROM DAMAGE.
5. TRACER WIRE IS REQUIRED ON ALL NEW BURIED PIPING AND DUCT BANKS. PROVIDE TRACER WIRE AND ACCESS POINTS IN ACCORDANCE WITH FRSA TREATMENT PLANT TRACER WIRE AND ACCESS POINTS DETAIL ON DWG 99-C-504.
6. PIPING SHALL BE INSTALLED ON A CONTINUOUS GRADE WITHOUT SAGS OR HUMPS BETWEEN ELEVATIONS INDICATED. COORDINATE WITH THE ENGINEER FOR GUIDANCE WHERE THIS IS NOT POSSIBLE.
7. 2" PUMP DISCHARGE (PD) LINE ON DWG 01-P-402 CONTINUES AS 2" SANITARY LINE TO THE MANHOLE.

SHEET NOTES:

- 1 REFER TO "PRIMARY FILTRATION PROJECT PHASE I (CAPITAL PROJECT NO. 2022)" DRAWINGS PREPARED BY DONOHUE FOR PRIMARY FILTRATION FACILITIES. AT TIME OF BIDDING PRIMARY FILTRATION FACILITIES ARE UNDER CONSTRUCTION. LOCATIONS SHOWN ARE APPROXIMATE AND BASED ON PRIMARY FILTRATION BIDDING DOCUMENTS. CONTRACTOR SHALL VERIFY LOCATIONS, ELEVATIONS, AND SIZES OF FACILITIES AND PIPES PROVIDED BY OTHERS.

REVISIONS AND RECORD OF ISSUE


DESIGNED:	SM
DETAILED:	AB
CHECKED:	AM/JH
APPROVED:	MR
DATE:	12/20/2022
PROJECT NO.:	411752

GENERAL

CIVIL



OVERALL PIPING PLAN

00-C-107

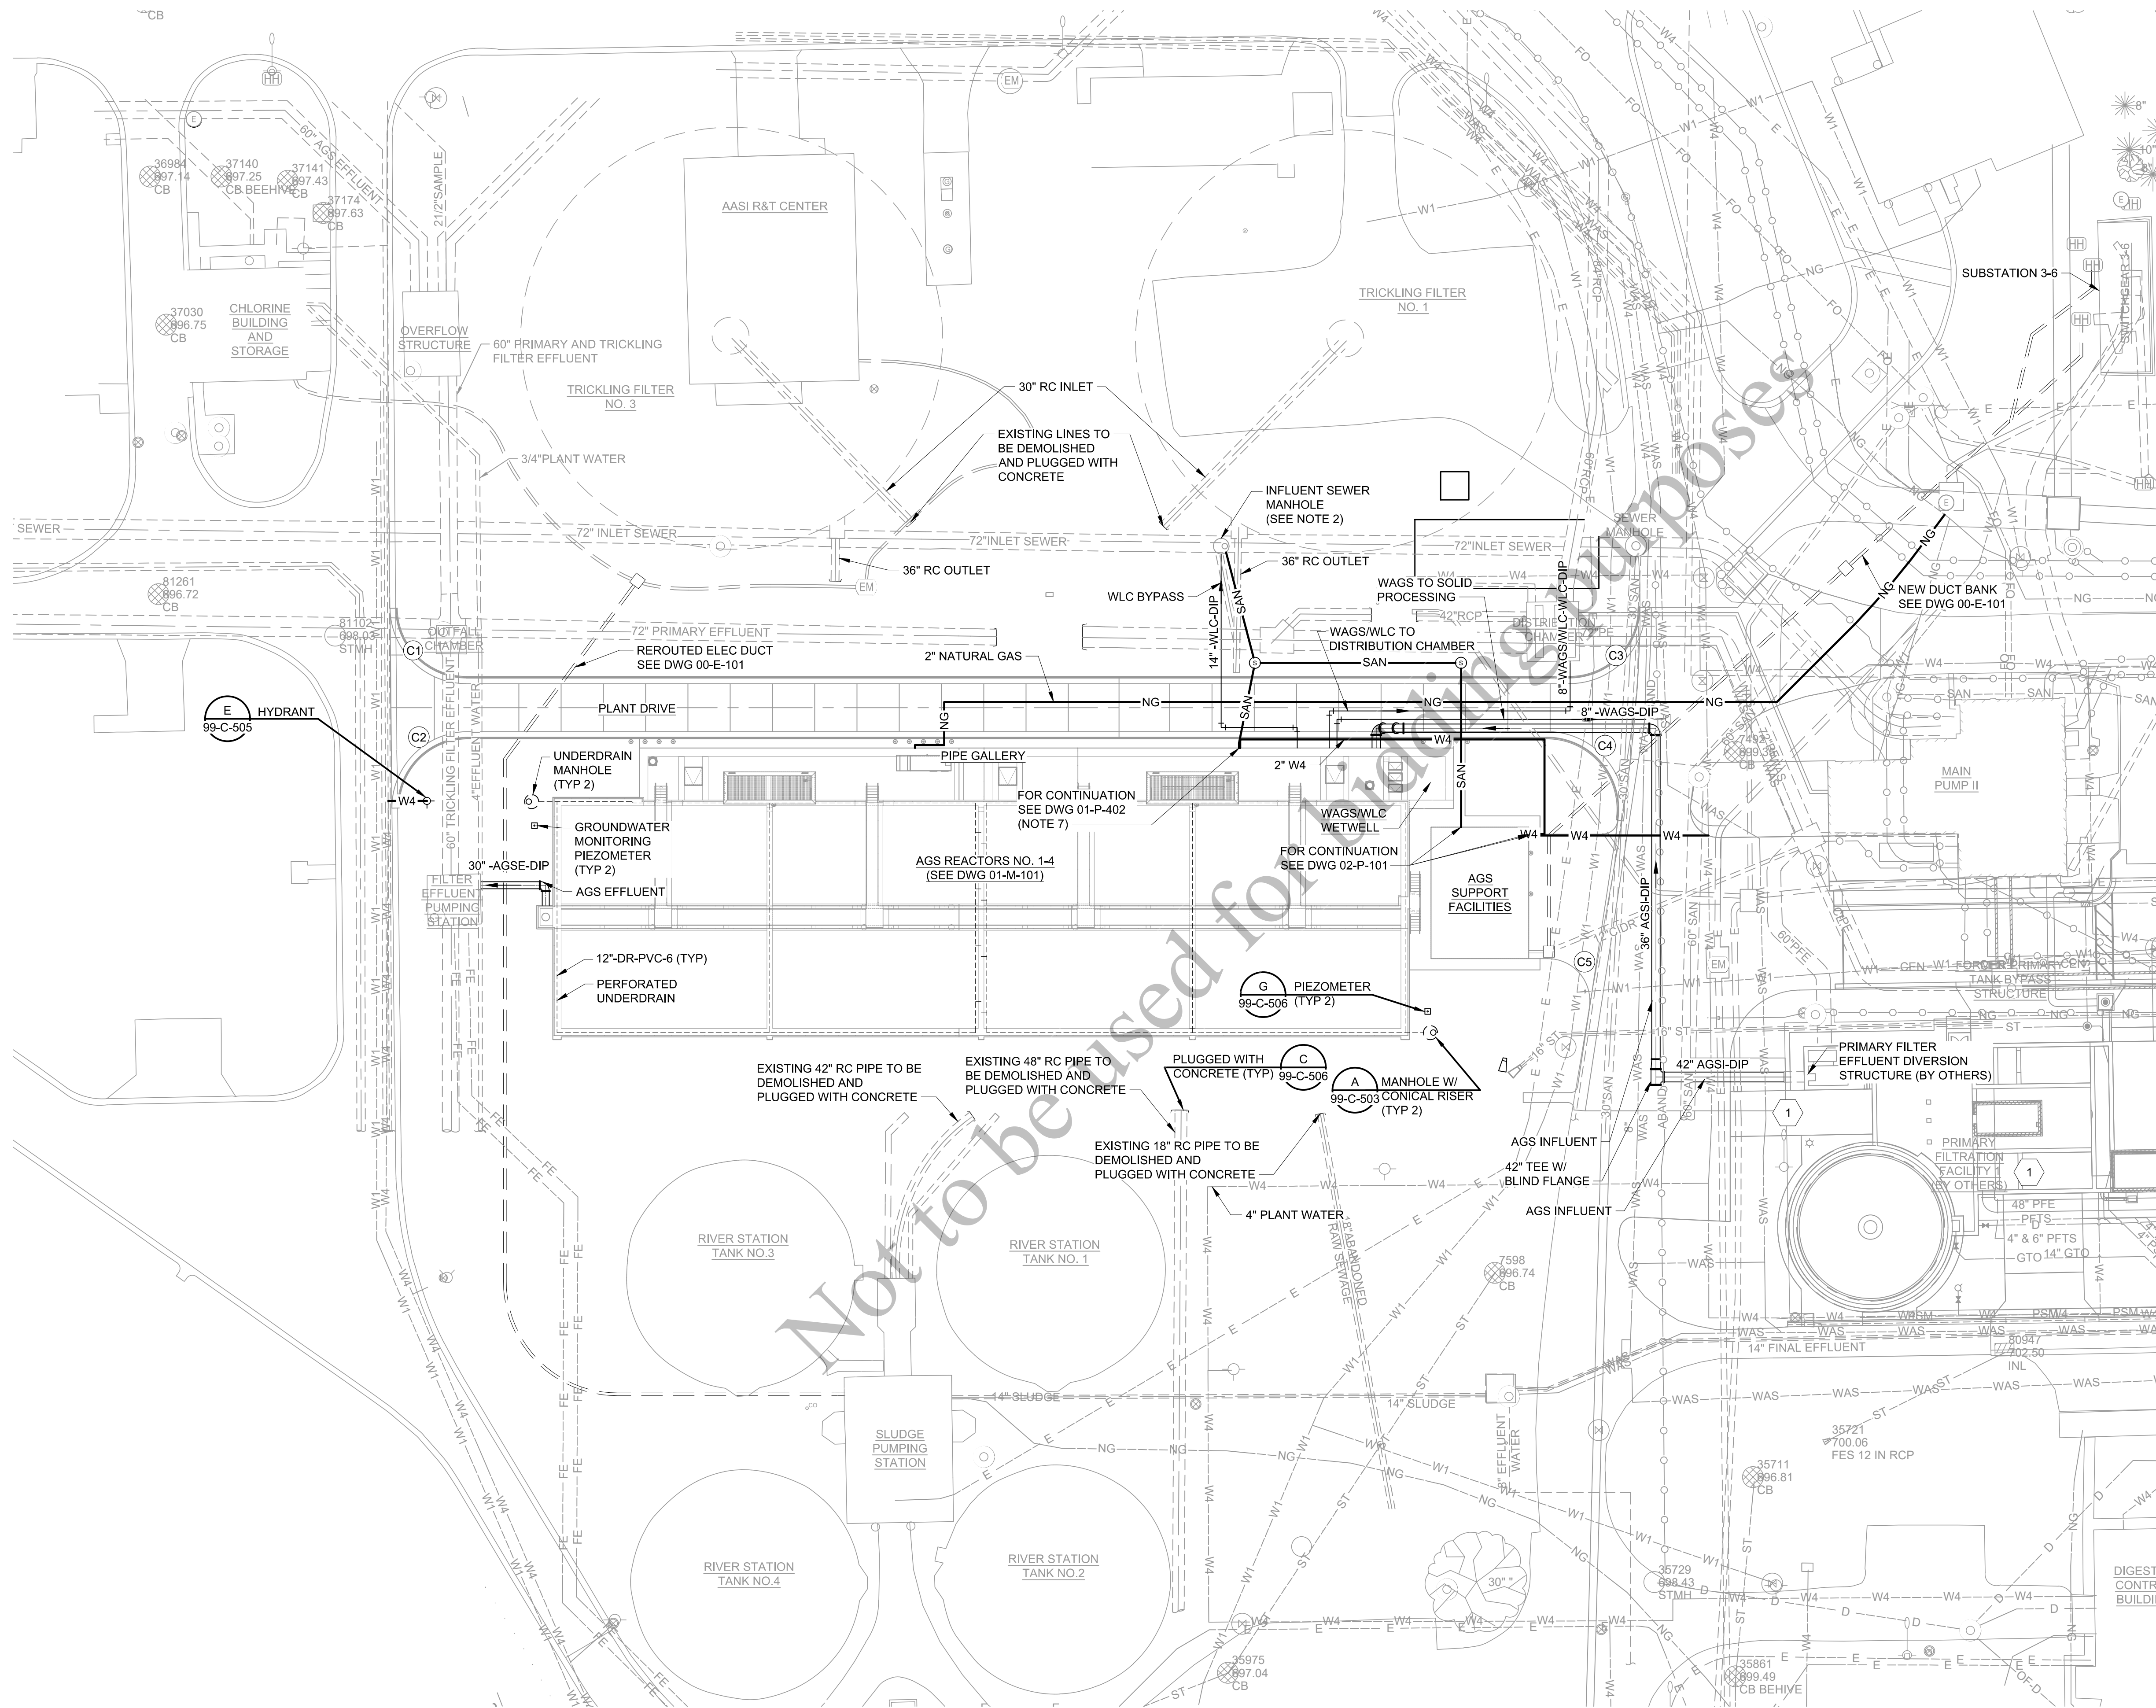37
OF
163

(SCALE BAR IS 4" AT FULL SCALE) 0 1/2 1 2 3 4

PLOTTED: 12/13/2022 11:02:30 AM
 FILE: C:\PWL\WORKING\BWV_AMERICAS\01495388\00-C-108.DWG
 FDI1000
 D11000

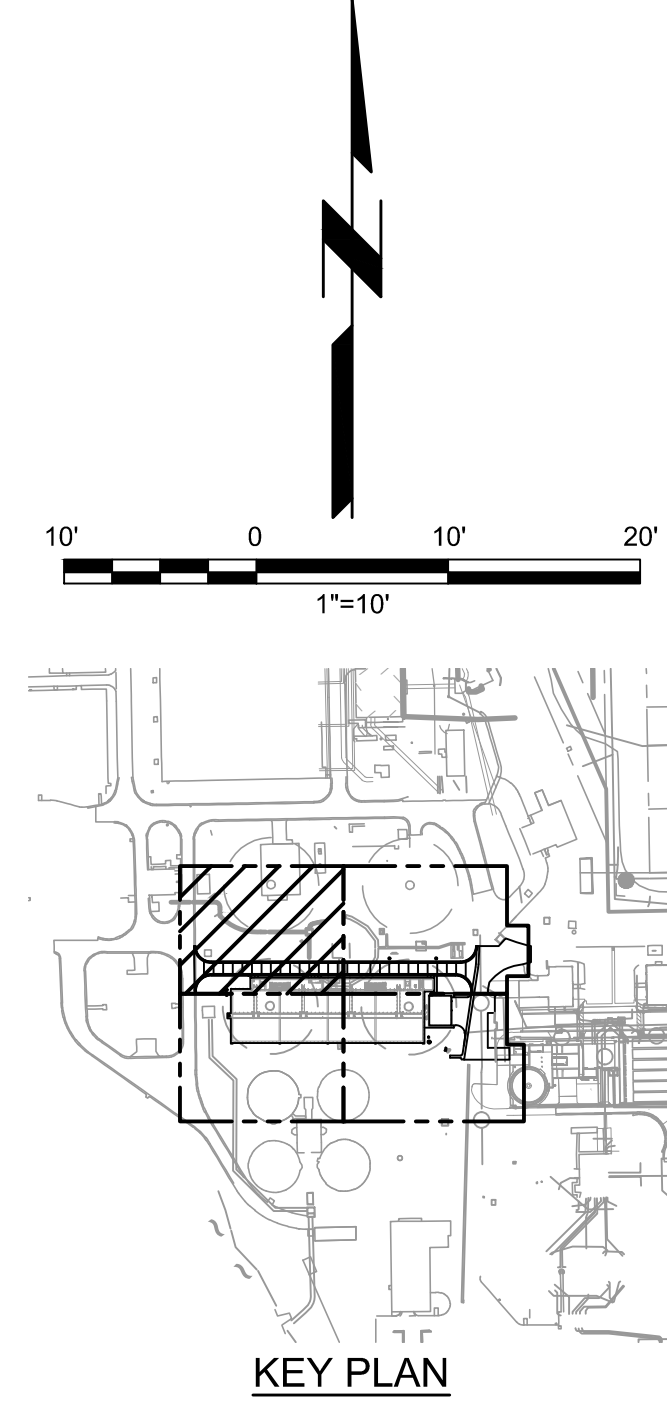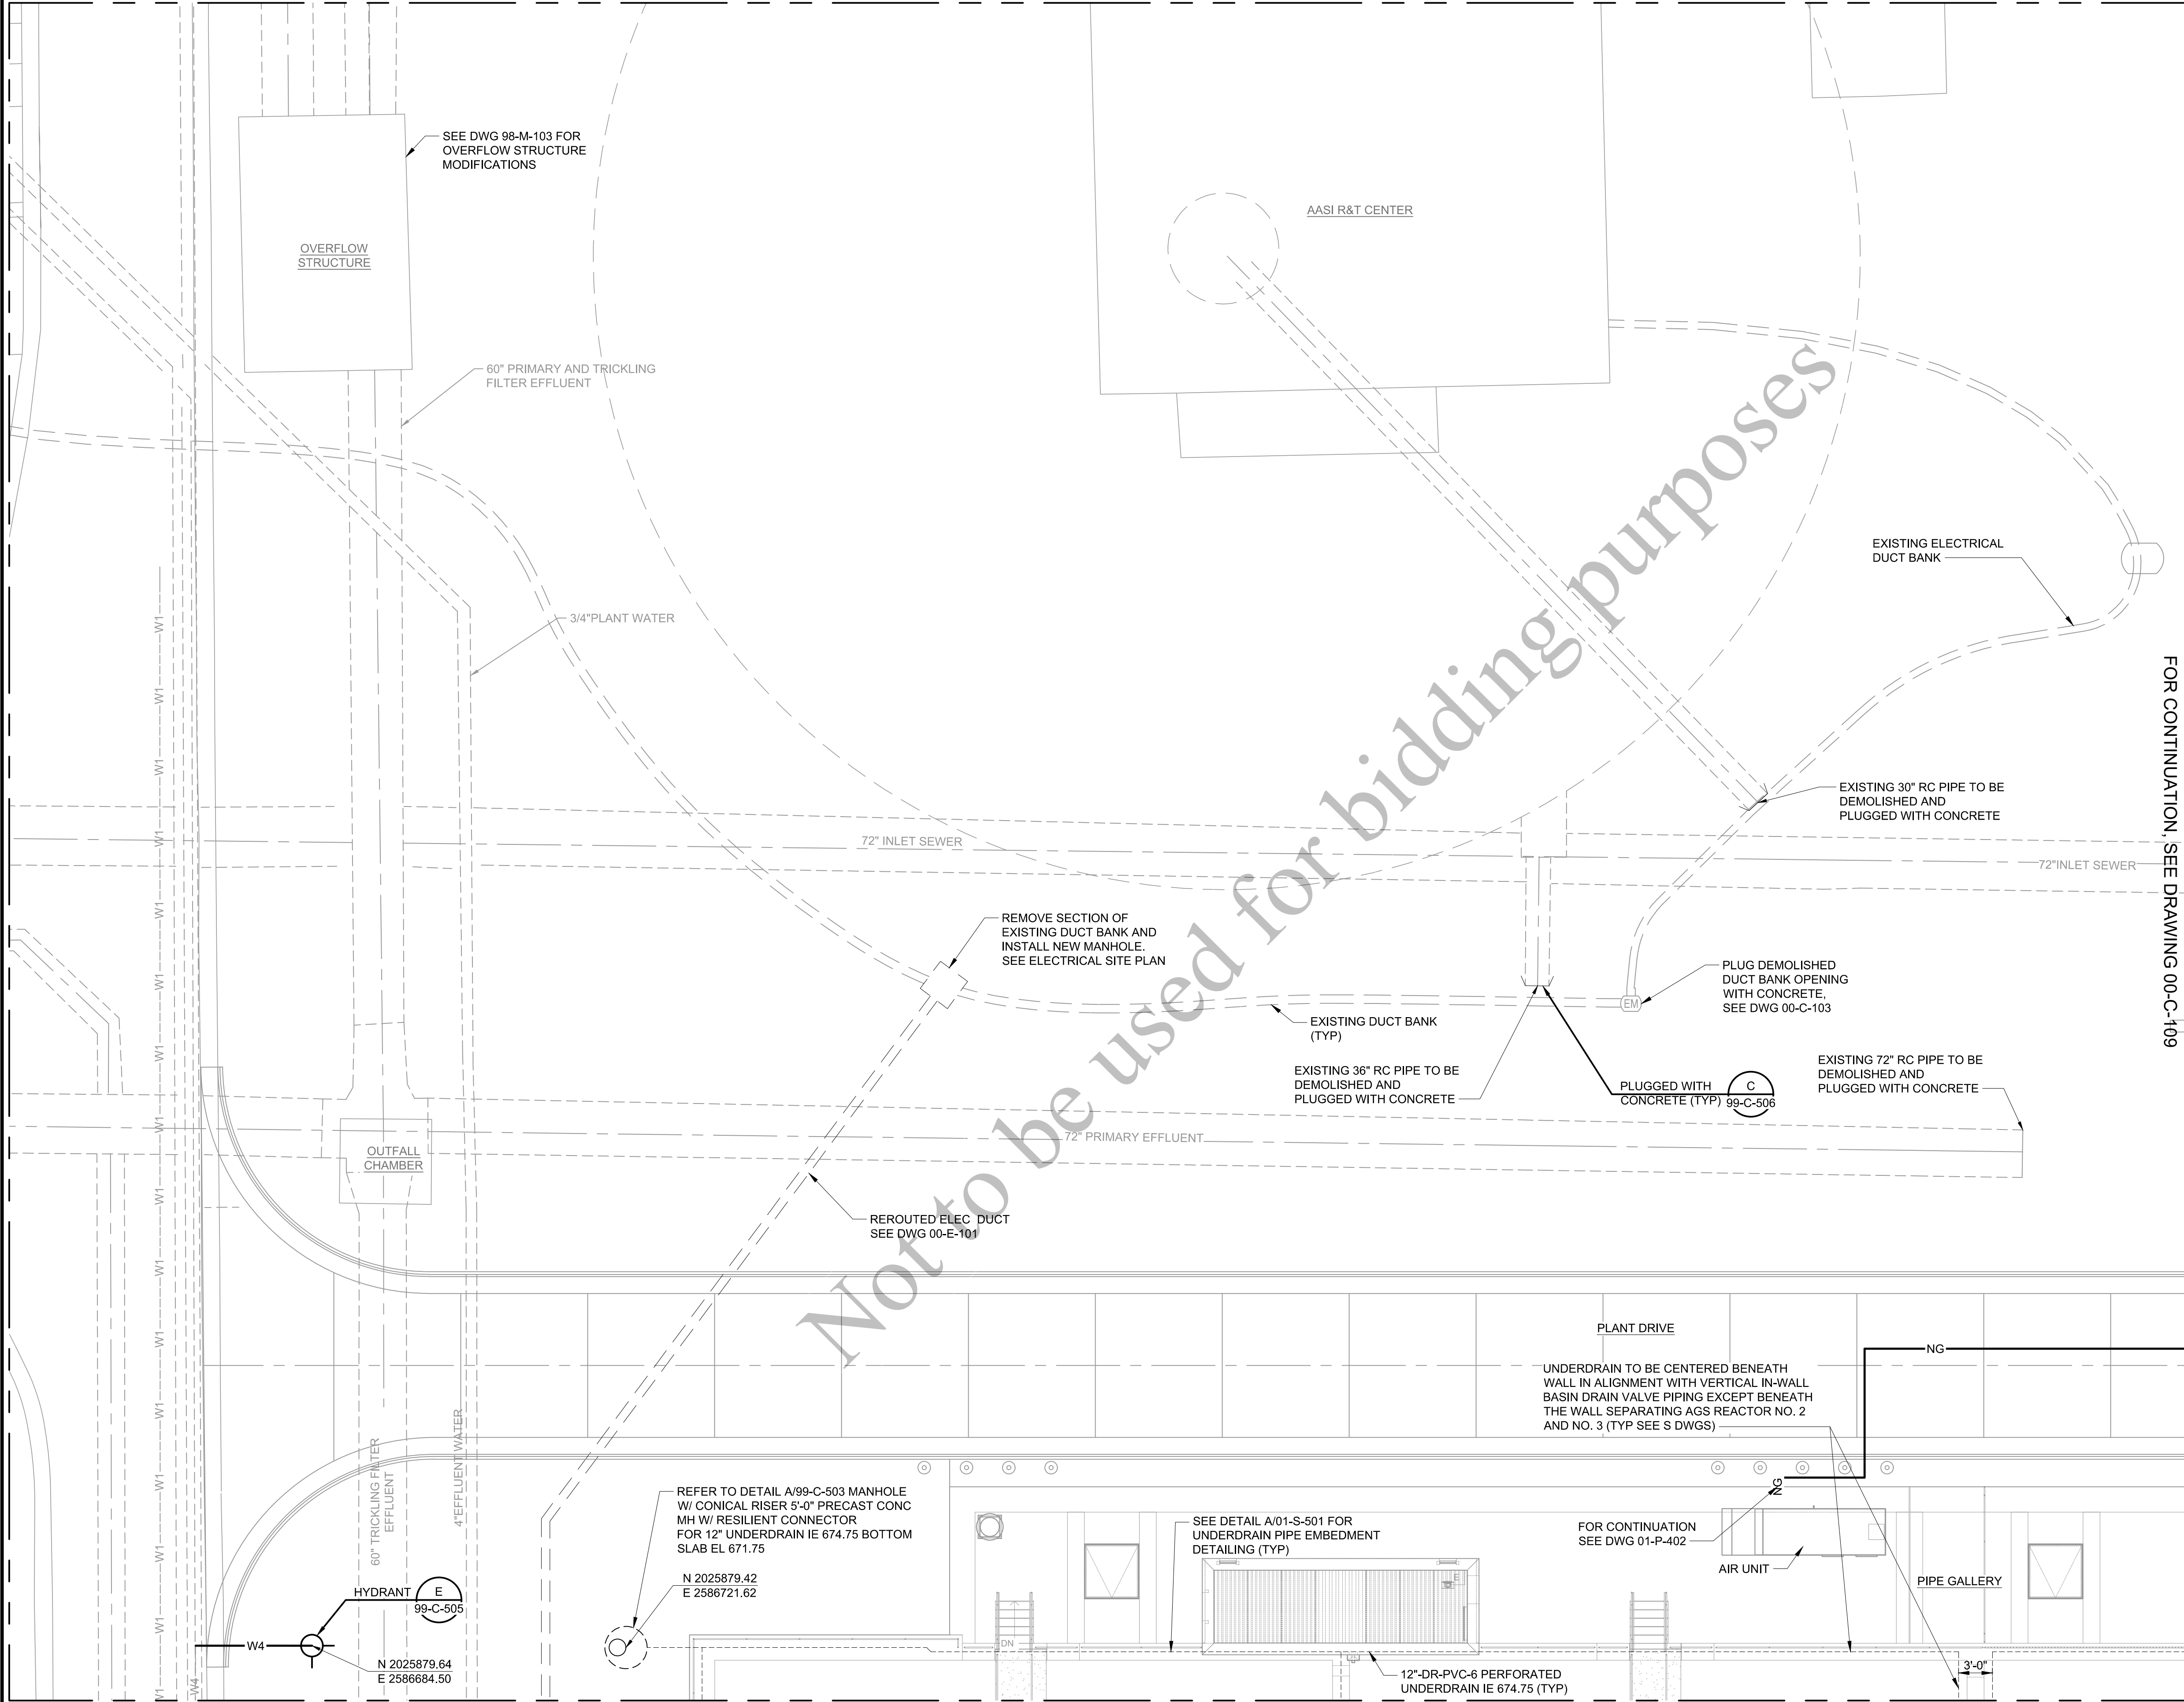

- NOTES:
- SEE DWG 00-C-107 FOR YARD PIPING GENERAL NOTES.

AEROBIC GRANULAR
 SLUDGE - PHASE 1

REVISIONS AND RECORD OF ISSUE	
DESIGNED:	SM
DETAILED:	AB
CHECKED:	AM/JH
APPROVED:	MR
DATE:	12/20/2022
PROJECT NO.:	411752

GENERAL

CIVIL

PIPING PLAN 1 OF 4

(SCALE BAR IS 4" AT FULL SCALE)

REVISIONS AND RECORD OF ISSUE	
DESIGNED:	SM
DETAILED:	AB
CHECKED:	AM/JH
APPROVED:	MR
DATE:	12/20/2022
PROJECT NO.:	411752

GENERAL




CIVIL

PIPING PLAN 2 OF 4

00-C-109

39
OF
163

FOR CONTINUATION, SEE DRAWING 00-C-108

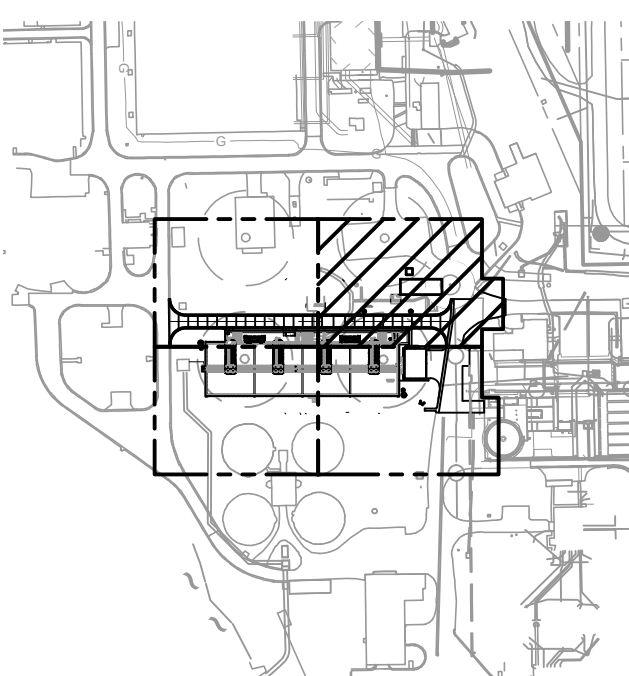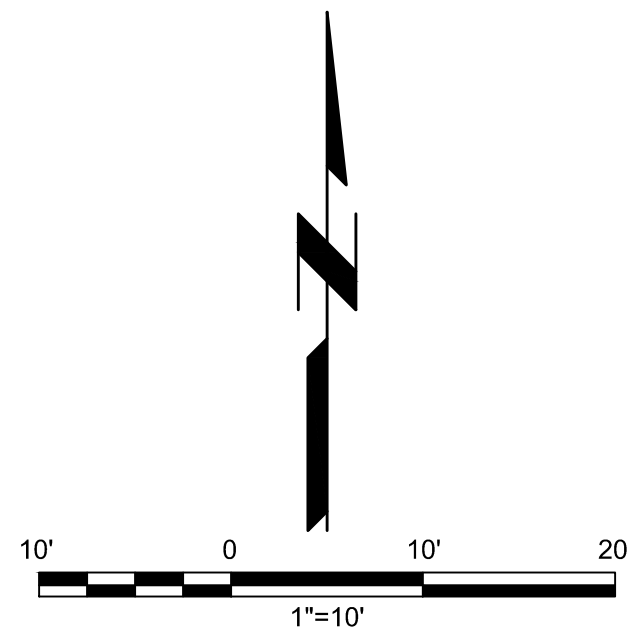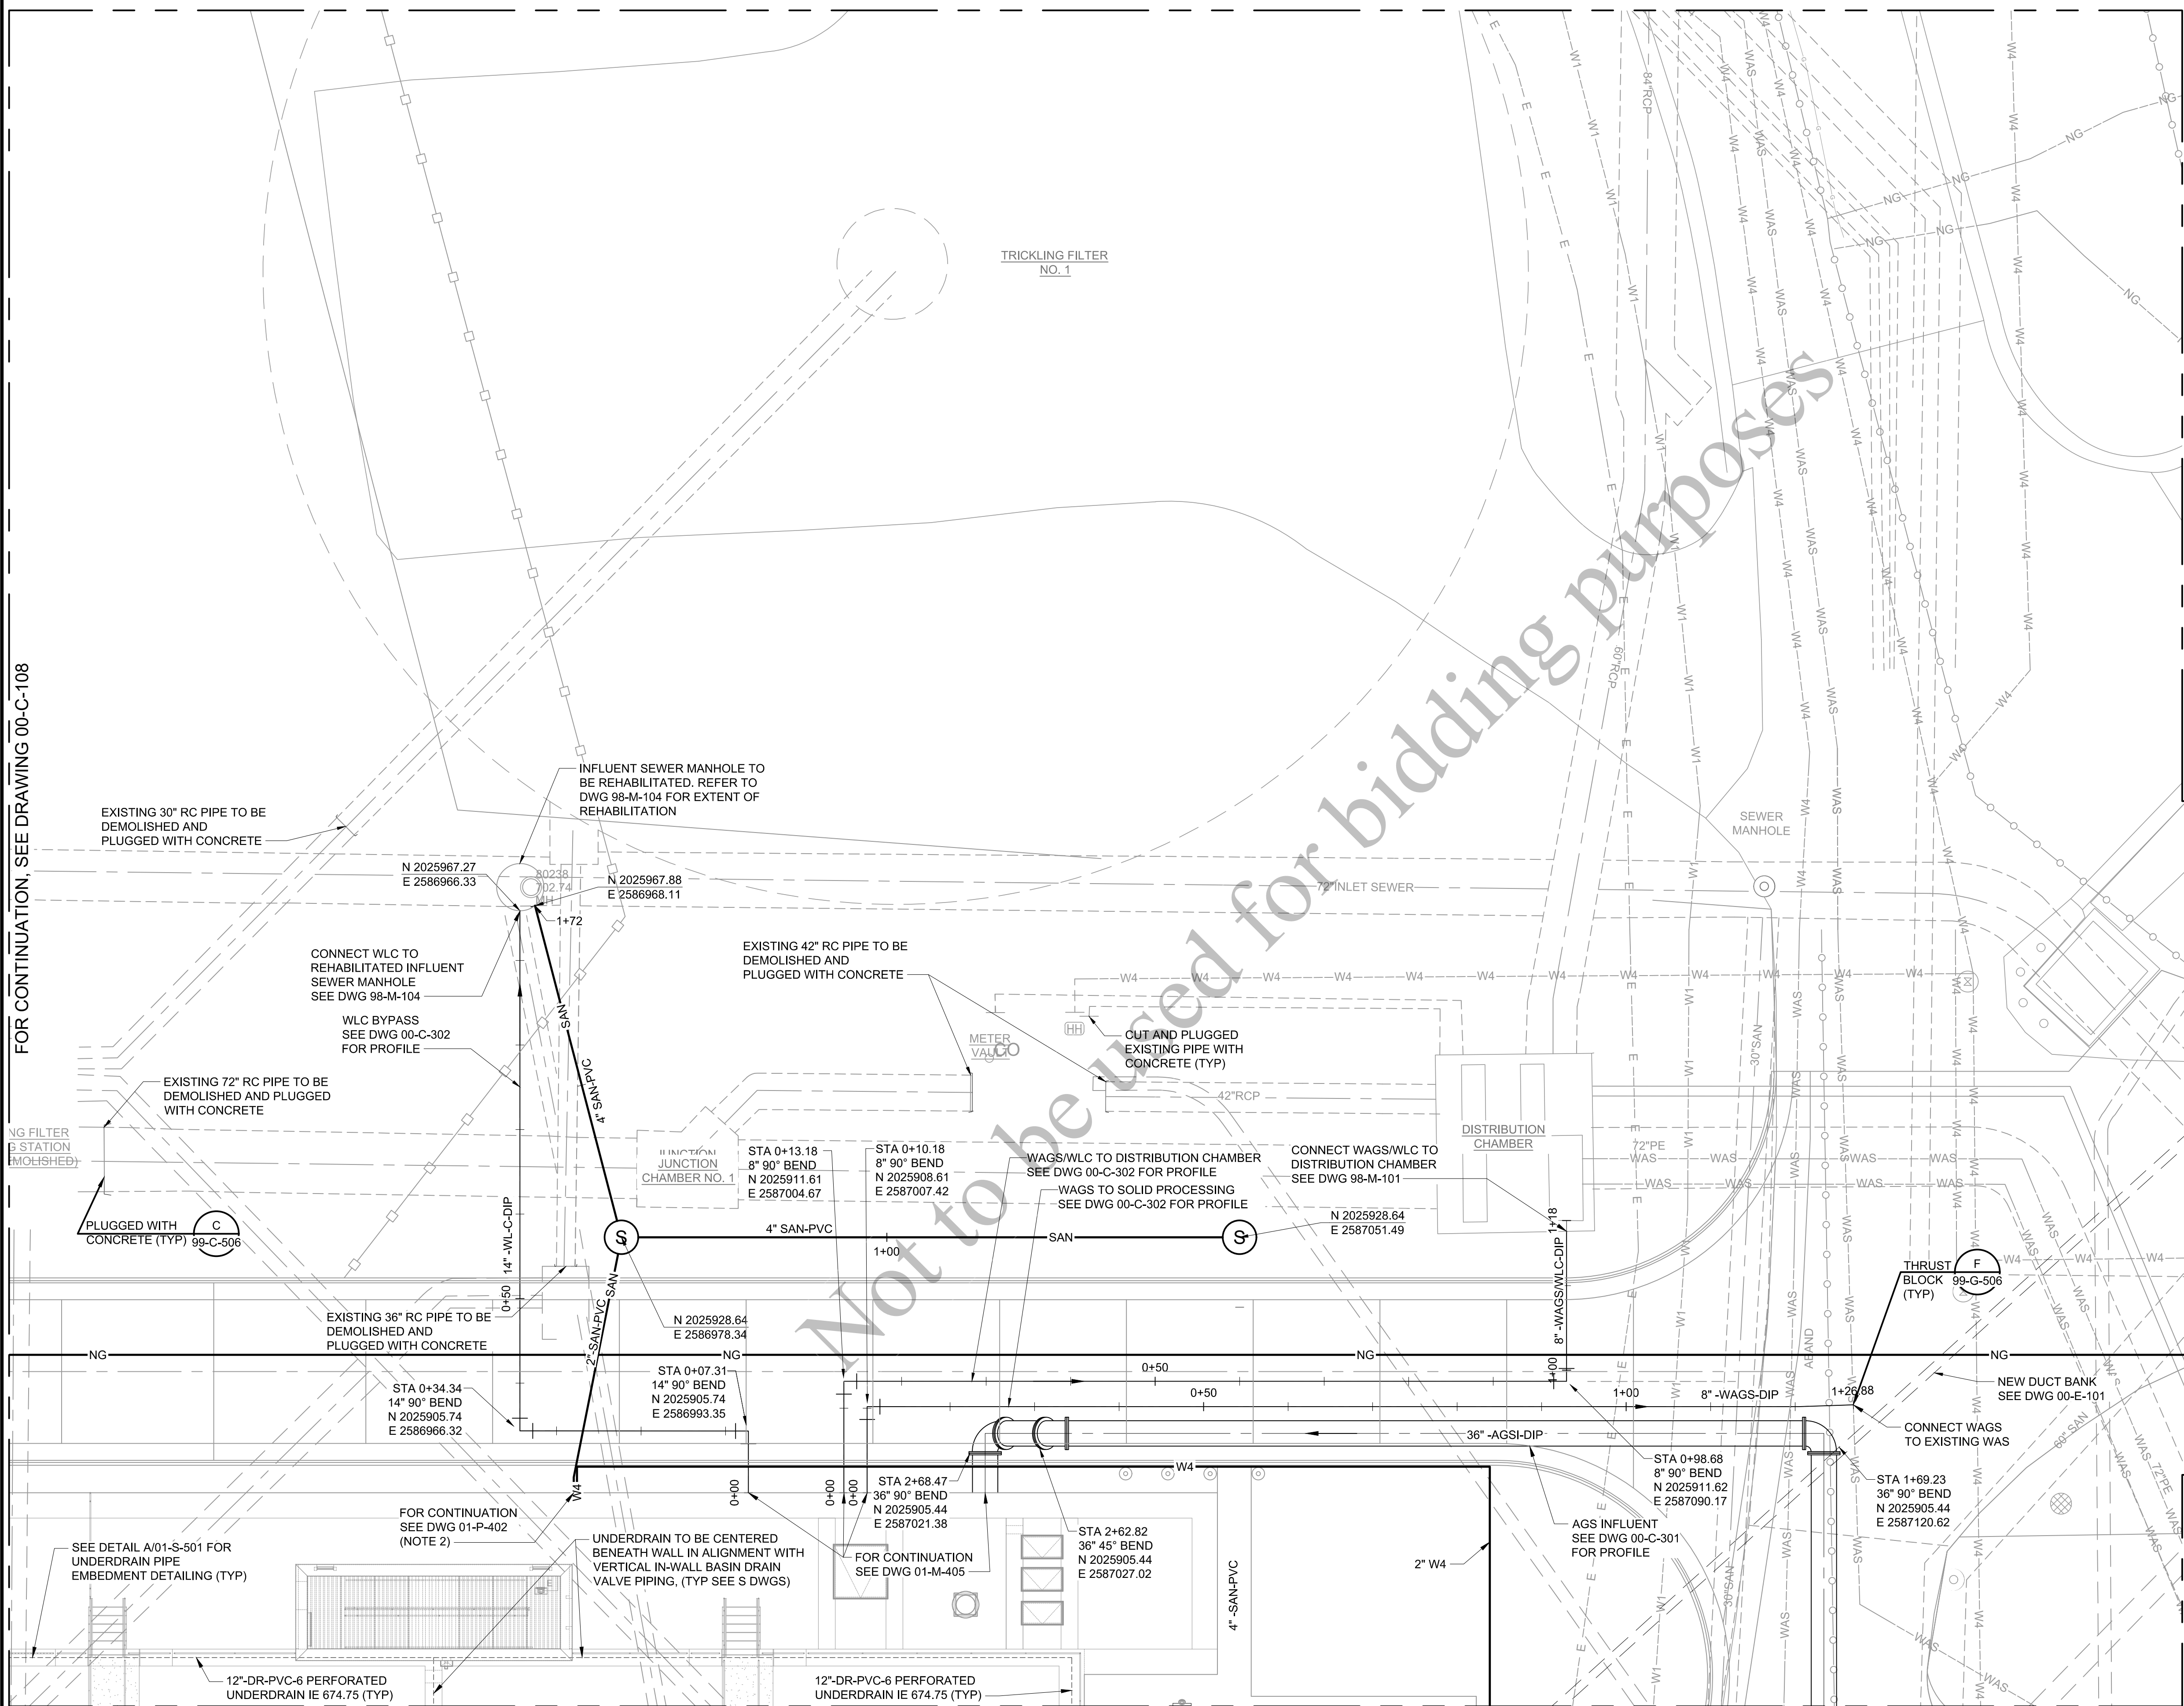

NOTES:

- SEE DWG 00-C-107 FOR YARD PIPING GENERAL NOTES.
- 2" PUMP DISCHARGE (PD) LINE ON DWG 01-F-402 CONTINUES AS 2" SANITARY LINE TO THE MANHOLE.

FOR CONTINUATION, SEE DRAWING 00-C-111

(SCALE BAR IS 4" AT FULL SCALE) 0 1/2 1 2 3 4

CONNECT 30" AGS EFFLUENT TO NORTHERN CHAMBER OF FILTER EFFLUENT PUMPING STATION. SEE DWG 98-M-102

30" AGSE-DIP

0+30

0+00

FILTER EFFLUENT PUMPING STATION

AGS EFFLUENT SEE DWG 00-C-301 FOR PROFILE

REFER TO PIEZOMETER DETAIL G/99-C-506
N 2025870.92
E 2586722.62

AGS REACTOR NO. 1

AGS REACTOR NO. 2

12"-DR-PVC-6 PERFORATED UNDERDRAIN IE 674.75 (TYP)

UNDERDRAIN TO BE CENTERED BENEATH WALL IN ALIGNMENT WITH VERTICAL IN-WALL BASIN DRAIN VALVE PIPING EXCEPT BENEATH THE WALL SEPARATING AGS REACTOR NO. 2 AND NO. 3 (TYP SEE S DWGS)

3'-00"

12"-DR-PVC-6 PERFORATED UNDERDRAIN IE 674.75 (TYP)

SEE DETAIL A/01-S-501 FOR UNDERDRAIN PIPE EMBEDMENT DETAILING (TYP)

NEW DUCT BANK SEE DWG 00-E-101

42" RC FILTER EFFLUENT


PLUGGED WITH CONCRETE (TYP) 99-C-506

EXISTING 42" RC PIPE TO BE DEMOLISHED AND PLUGGED WITH CONCRETE

RIVER STATION TANK NO. 3

RIVER STATION TANK NO. 1

FOR CONTINUATION, SEE DRAWING 00-C-111

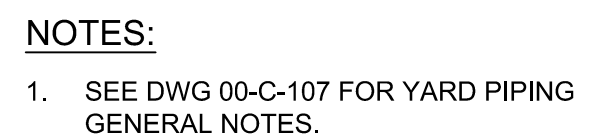

Black & Veatch Corporation
Chicago, Illinois
ILLINOIS PROFESSIONAL
DESIGN FIRM - 184.002143 -0006



AEROBIC GRANULAR SLUDGE - PHASE 1

[illegible]

GENERAL

CIVIL


PIPING PLAN 3 OF 4

00-C-110



40
OF
163

PLOTTED:	12/13/2022 10:56:55 AM
FILE:	C:\PW_WORKING\BWW_AMERICAS\ID1495368\00-C-110.DWG
FD11000	
D11000	

(SCALE BAR IS 4" AT FULL SCALE) 0 1/2 1 2 3 4

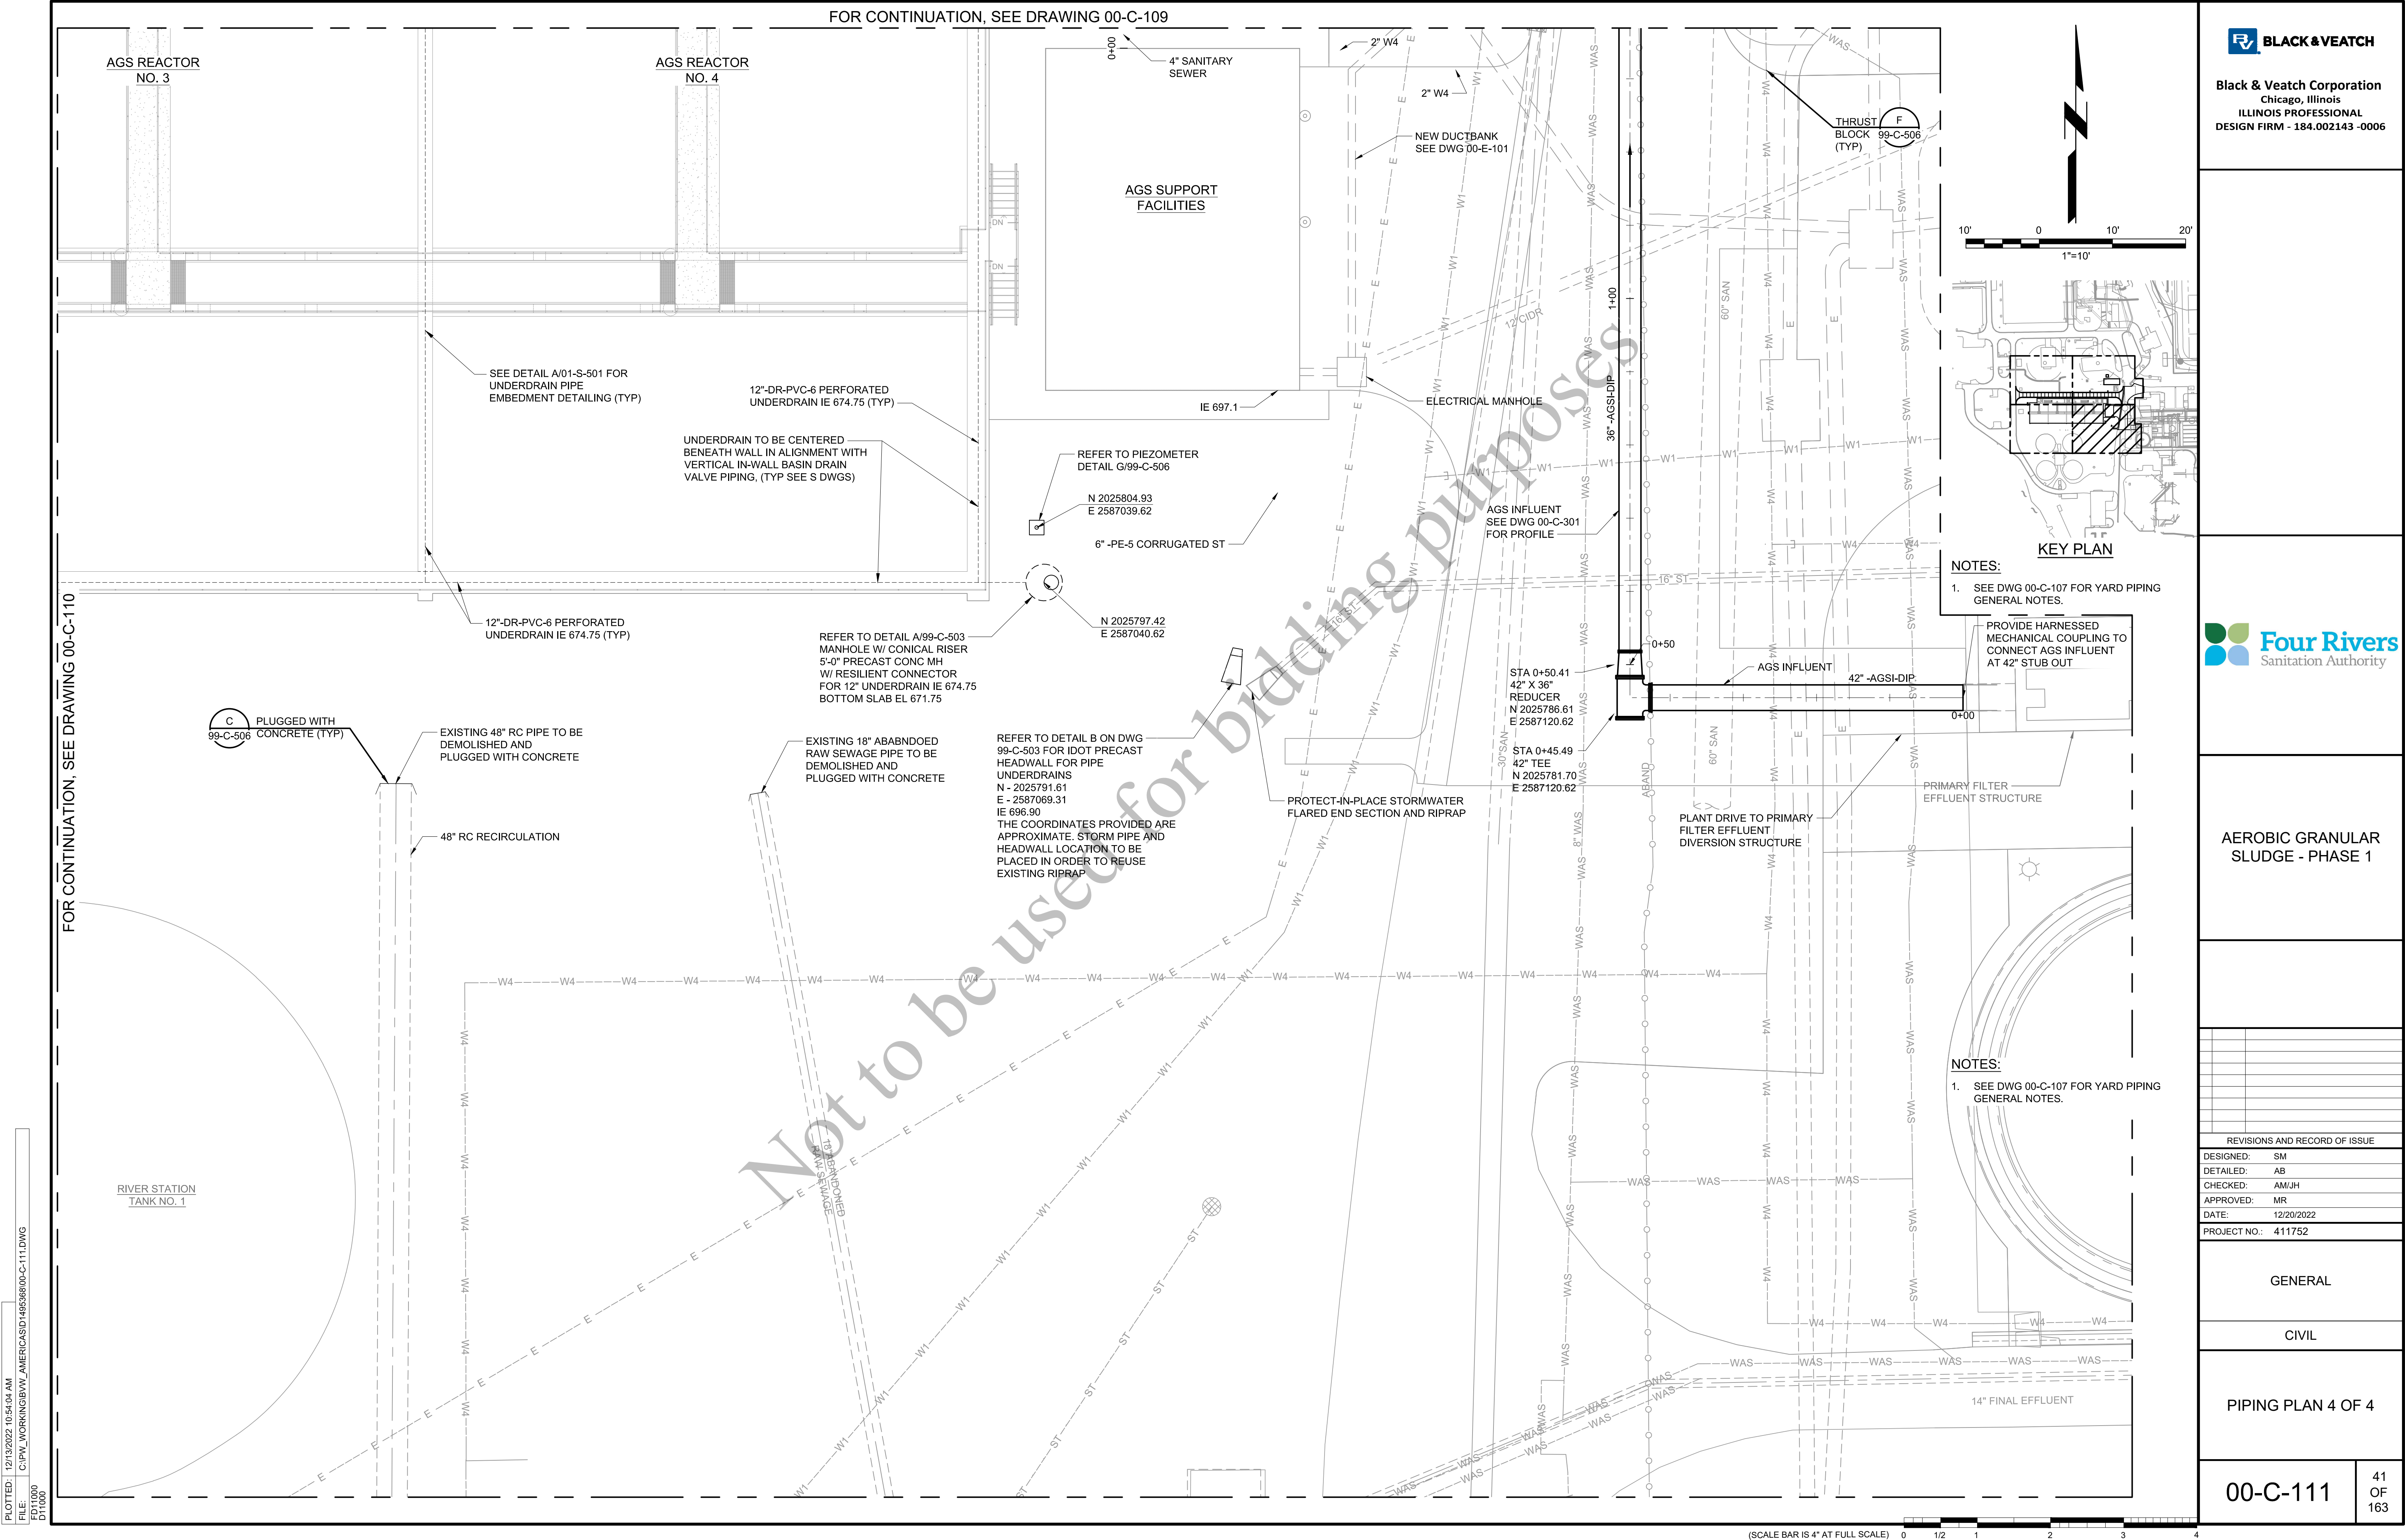

PLOTTED: 12/19/2022 5:38:11 PM
FILE: C:\PW\WORKING\BWV_AMERICAS\01495388\00-C-112.DWG
FD1000
D11000

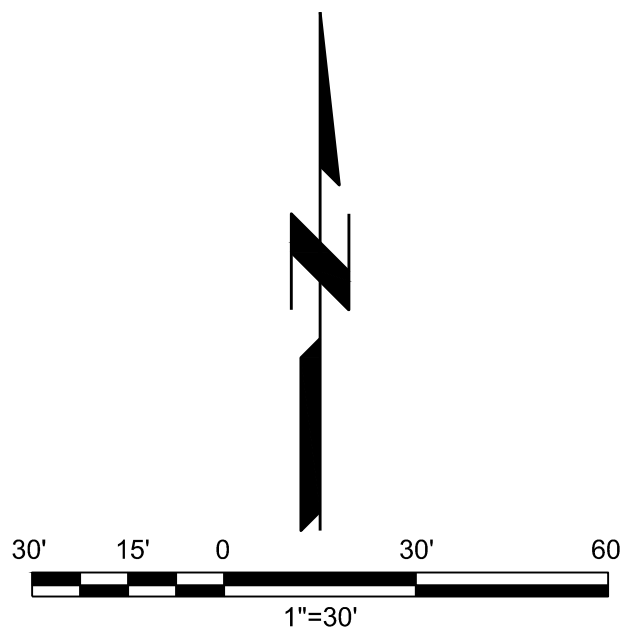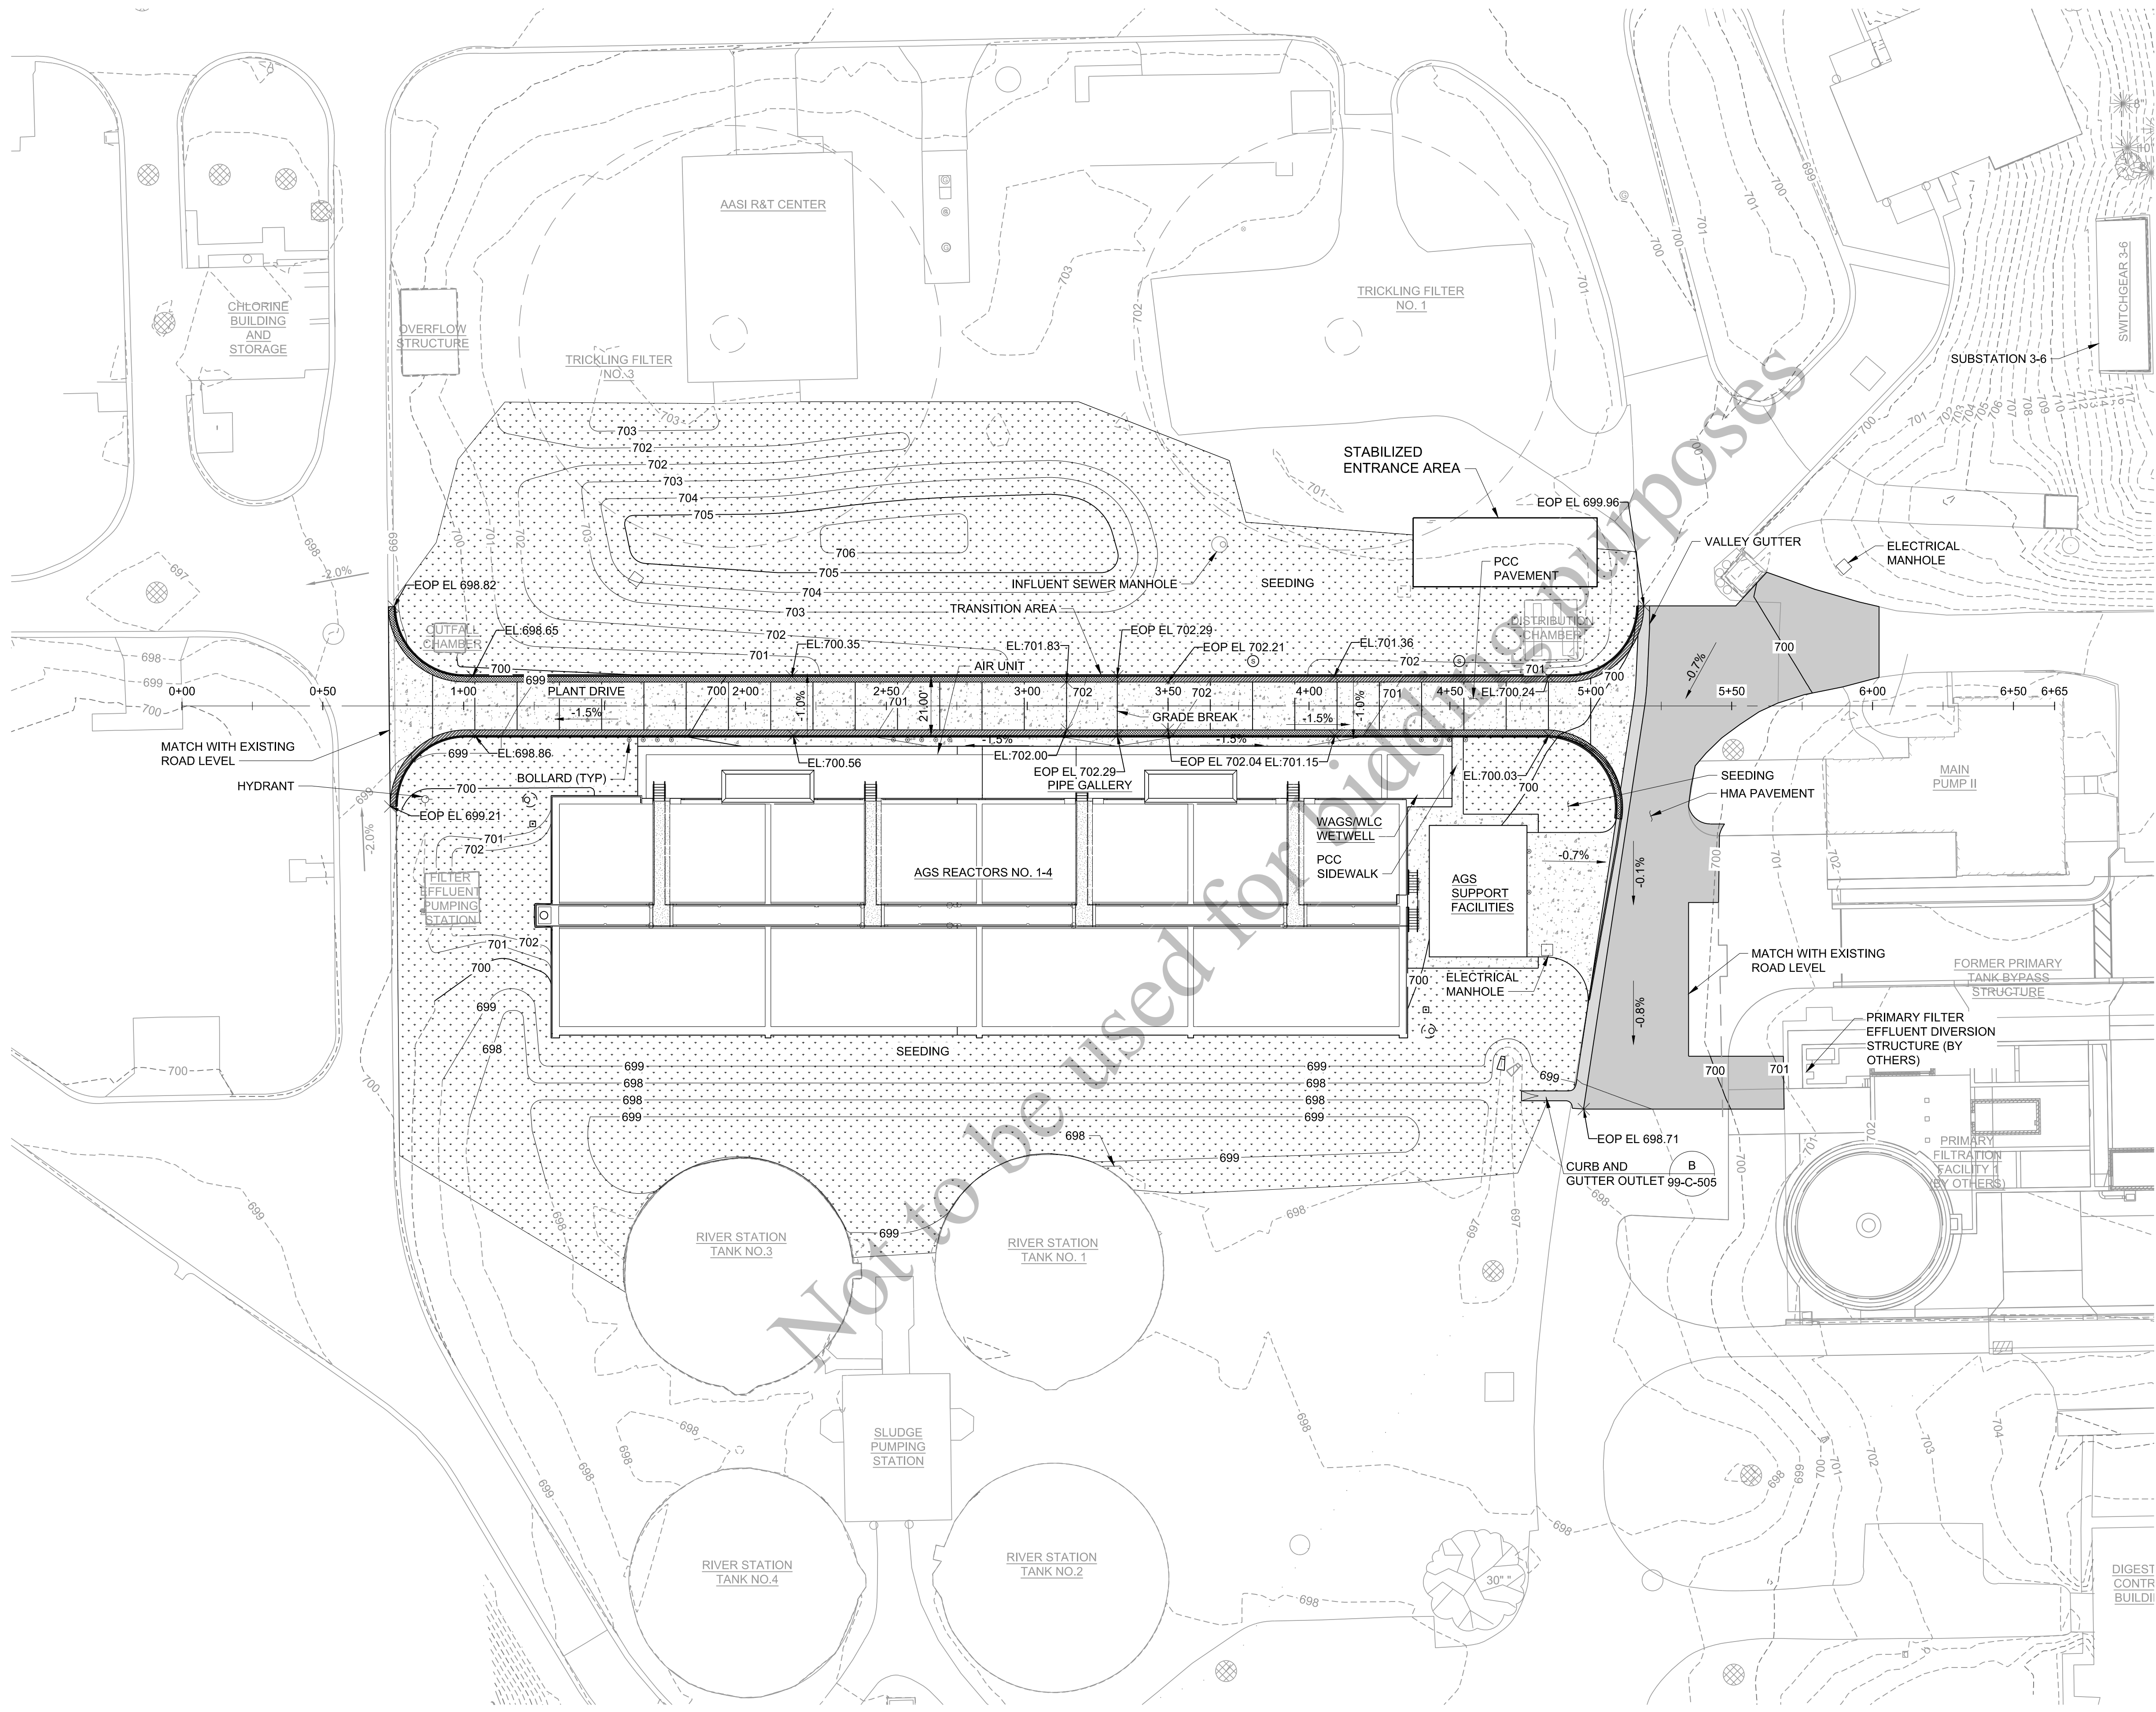

- NOTES:**
- SEE DWG 00-C-001 FOR LEGENDS AND GENERAL NOTES.
 - TRENCH, PAVEMENT, AND SITE RESTORATION SHALL MATCH ADJACENT EXISTING GRADE UNLESS OTHERWISE NOTED.
 - ALL EXISTING MANHOLES, CATCH BASINS, AND INLETS WITHIN THE LIMITS OF CONSTRUCTION TO REMAIN SHALL BE PROTECTED DURING CONSTRUCTION AND, IF REQUIRED DUE TO NEW CONSTRUCTION, ADJUSTED TO FINAL GRADE AND/OR TO ACCEPT DRAINAGE.
 - PROVIDE PCC PAVEMENT JOINTING PER IDOT STANDARD 420001-09 AND 420101-07. PROVIDE JOINTING AND TIE BARS FOR PCC CURB AND GUTTER PER IDOT STANDARD 606001-07. PROVIDE PCC PAVEMENT ROUNDOUTS AT CASTING PER IDOT STANDARD 420111-04.
 - TYPICAL PCC PAVEMENT TRANSVERSE JOINT SPACING IS 15 FEET.
 - WHERE NEW PCC PAVEMENT IS REPLACING EXISTING, THE INTENT IS TO MATCH PRE-CONSTRUCTION GRADES, GEOMETRY AND JOINTING PATTERN.

- LEGEND:**
- SEEDING
 - PCC PAVEMENT
 - HMA PAVEMENT
 - CURB AND GUTTER
 - TIP OUT CURB
 - M6.18 DEPRESSED CURB


**AEROBIC GRANULAR
SLUDGE - PHASE 1**

REVISIONS AND RECORD OF ISSUE	
DESIGNED:	SM
DETAILED:	AB
CHECKED:	AM/JH
APPROVED:	MR
DATE:	12/20/2022
PROJECT NO.:	411752

GENERAL
CIVIL

**OVERALL GRADING AND
PAVING PLAN**


PLOTTED: 12/19/2022 5:39:02 PM
FILE: C:\PW\WORKING\BWV_AMERICAS\01495388\00-C-113.DWG
FDI1000
D11000

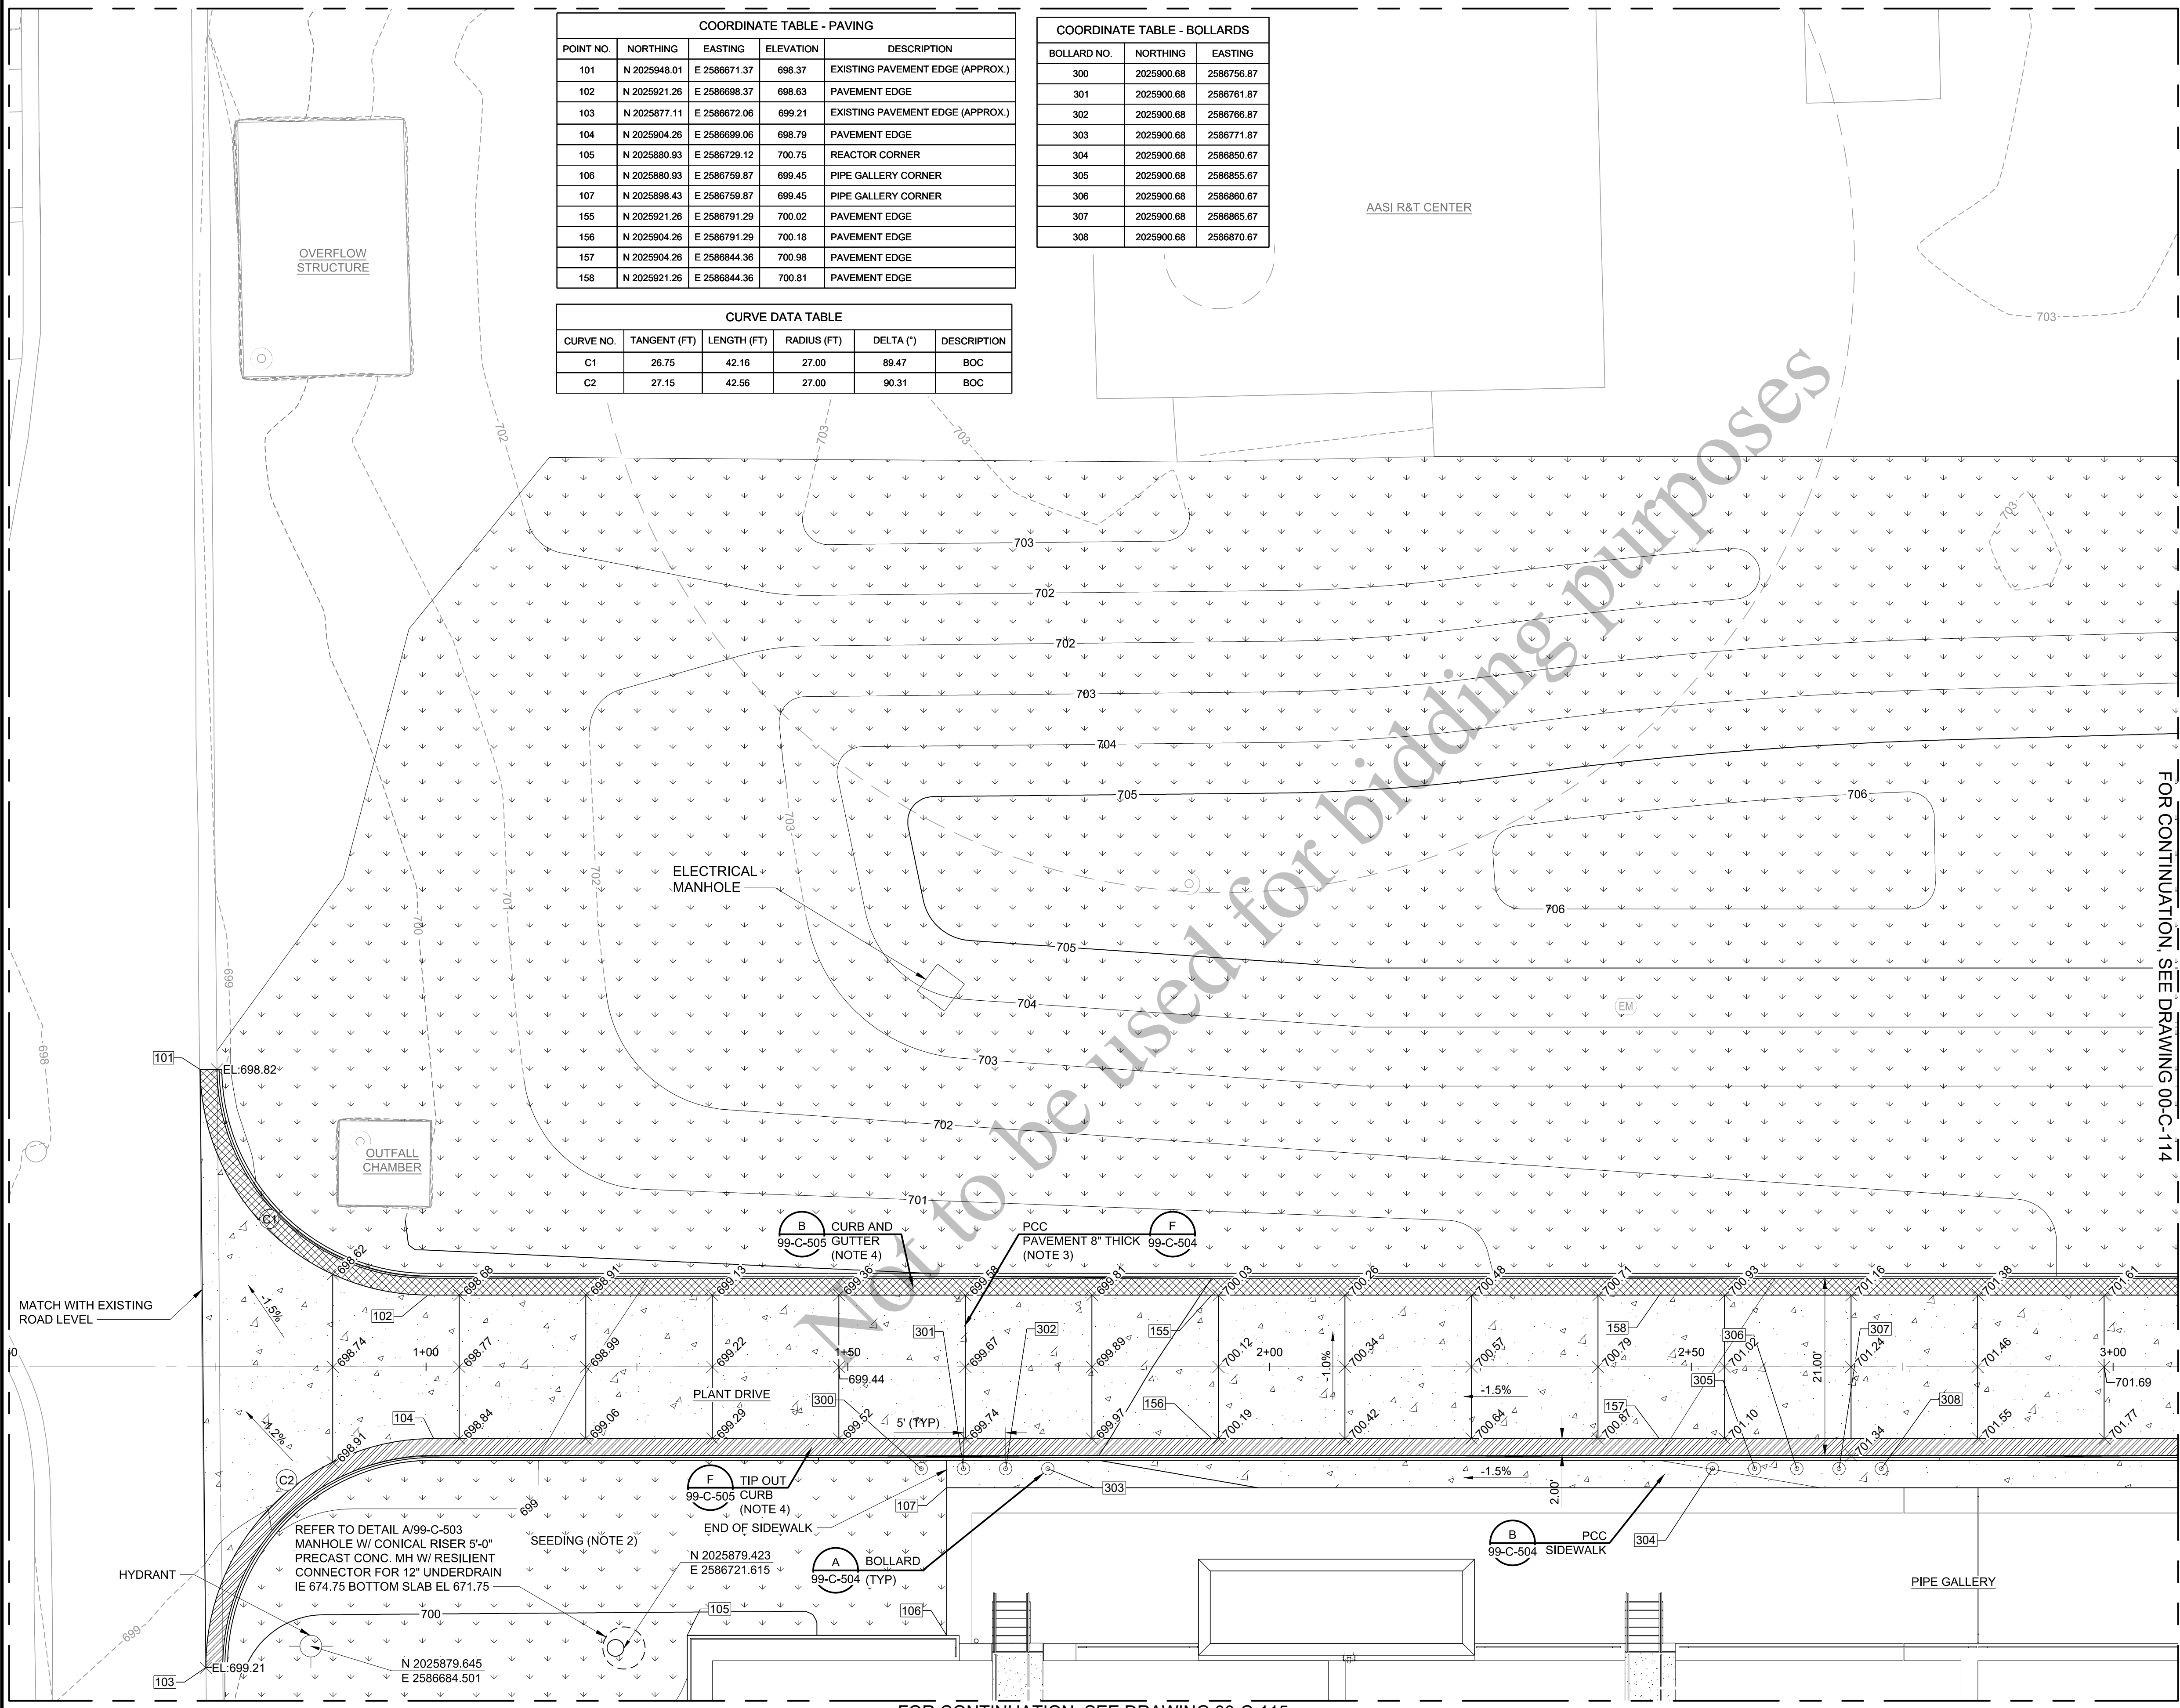

COORDINATE TABLE - PAVING				
POINT NO.	NORTHING	EASTING	ELEVATION	DESCRIPTION
101	N 2025948.01	E 2586671.37	698.37	EXISTING PAVEMENT EDGE (APPROX.)
102	N 2025921.26	E 2586698.37	698.63	PAVEMENT EDGE
103	N 2025877.11	E 2586672.06	699.21	EXISTING PAVEMENT EDGE (APPROX.)
104	N 2025904.26	E 2586699.06	698.79	PAVEMENT EDGE
105	N 2025880.93	E 2586729.12	700.75	REACTOR CORNER
106	N 2025880.93	E 2586759.87	699.45	PIPE GALLERY CORNER
107	N 2025898.43	E 2586759.87	699.45	PIPE GALLERY CORNER
155	N 2025921.26	E 2586791.29	700.02	PAVEMENT EDGE
156	N 2025904.26	E 2586791.29	700.18	PAVEMENT EDGE
157	N 2025904.26	E 2586844.36	700.98	PAVEMENT EDGE
158	N 2025921.26	E 2586844.36	700.81	PAVEMENT EDGE

CURVE DATA TABLE					
CURVE NO.	TANGENT (FT)	LENGTH (FT)	RADIUS (FT)	DELTA (°)	DESCRIPTION
C1	26.75	42.16	27.00	89.47	BOC
C2	27.15	42.56	27.00	90.31	BOC

COORDINATE TABLE - BOLLARDS		
BOLLARD NO.	NORTHING	EASTING
300	2025900.68	2586756.87
301	2025900.68	2586761.87
302	2025900.68	2586766.87
303	2025900.68	2586771.87
304	2025900.68	2586850.67
305	2025900.68	2586855.67
306	2025900.68	2586860.67
307	2025900.68	2586865.67
308	2025900.68	2586870.67

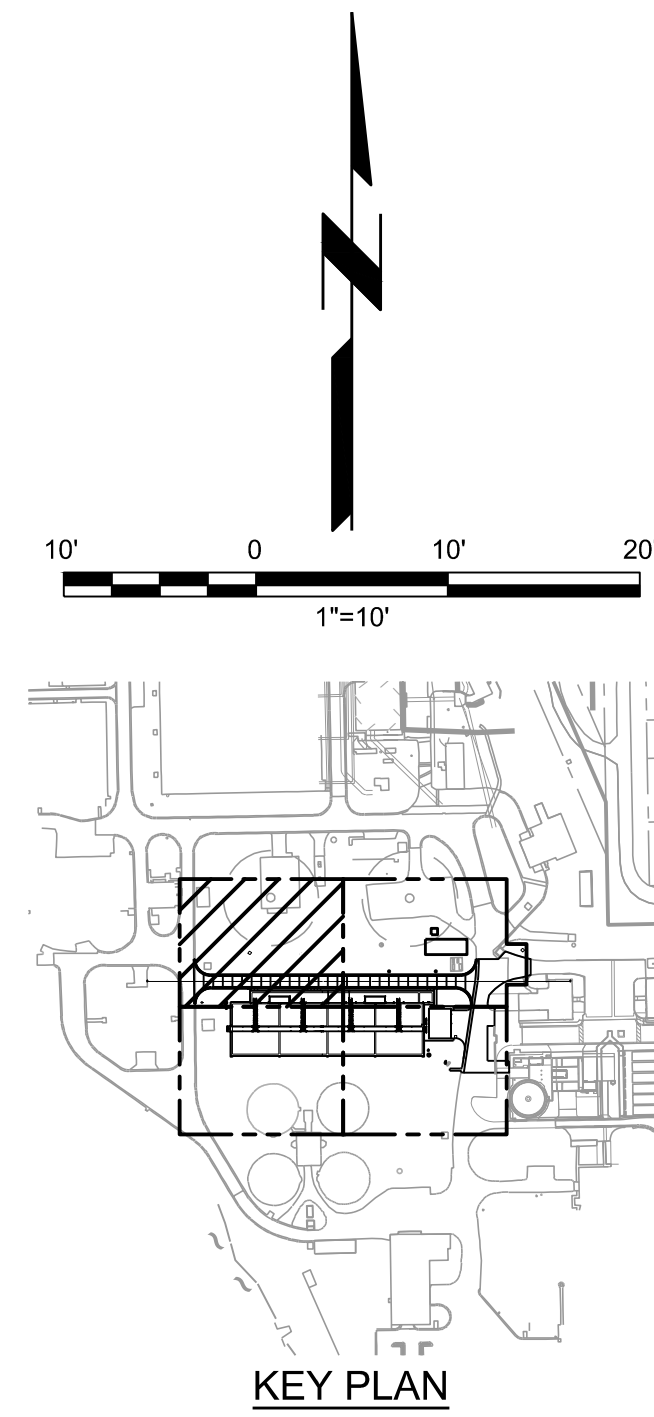

- NOTES:
- SEE DWG 00-C-001 FOR LEGENDS AND GENERAL NOTES AND DWG 00-C-112 FOR GRADING AND PAVING NOTES.
 - SEEDING SHALL BE PROVIDED IN ACCORDANCE WITH SECTION 329221.
 - REFER TO DETAIL D ON DWG 99-C-504 FOR JOINTING AND DWG 99-C-502 FOR REINFORCEMENT, AND ADDITIONAL PAVEMENT REQUIREMENTS.
 - REFER TO DETAIL A ON DWG 99-C-505 FOR ADDITIONAL CURB AND GUTTER REQUIREMENTS.

LEGEND:	
SEEDING	
PCC PAVEMENT	
CURB AND GUTTER	
TIP OUT CURB	
BACK OF CURB	
	BOC


REVISIONS AND RECORD OF ISSUE	
DESIGNED:	SM
DETAILED:	AB
CHECKED:	AM/JH
APPROVED:	MR
DATE:	12/20/2022
PROJECT NO.:	411752

FOR CONTINUATION, SEE DRAWING 00-C-115

(SCALE BAR IS 4" AT FULL SCALE) 0 1/2 1 2 3 4

PLOTTED: 12/19/2022 5:40:14 PM
 FILE: C:\PW\WORKING\BW\AMERICAS\01495388\00-C-114.DWG
 F01000
 D11000

FOR CONTINUATION, SEE DRAWING 00-C-113

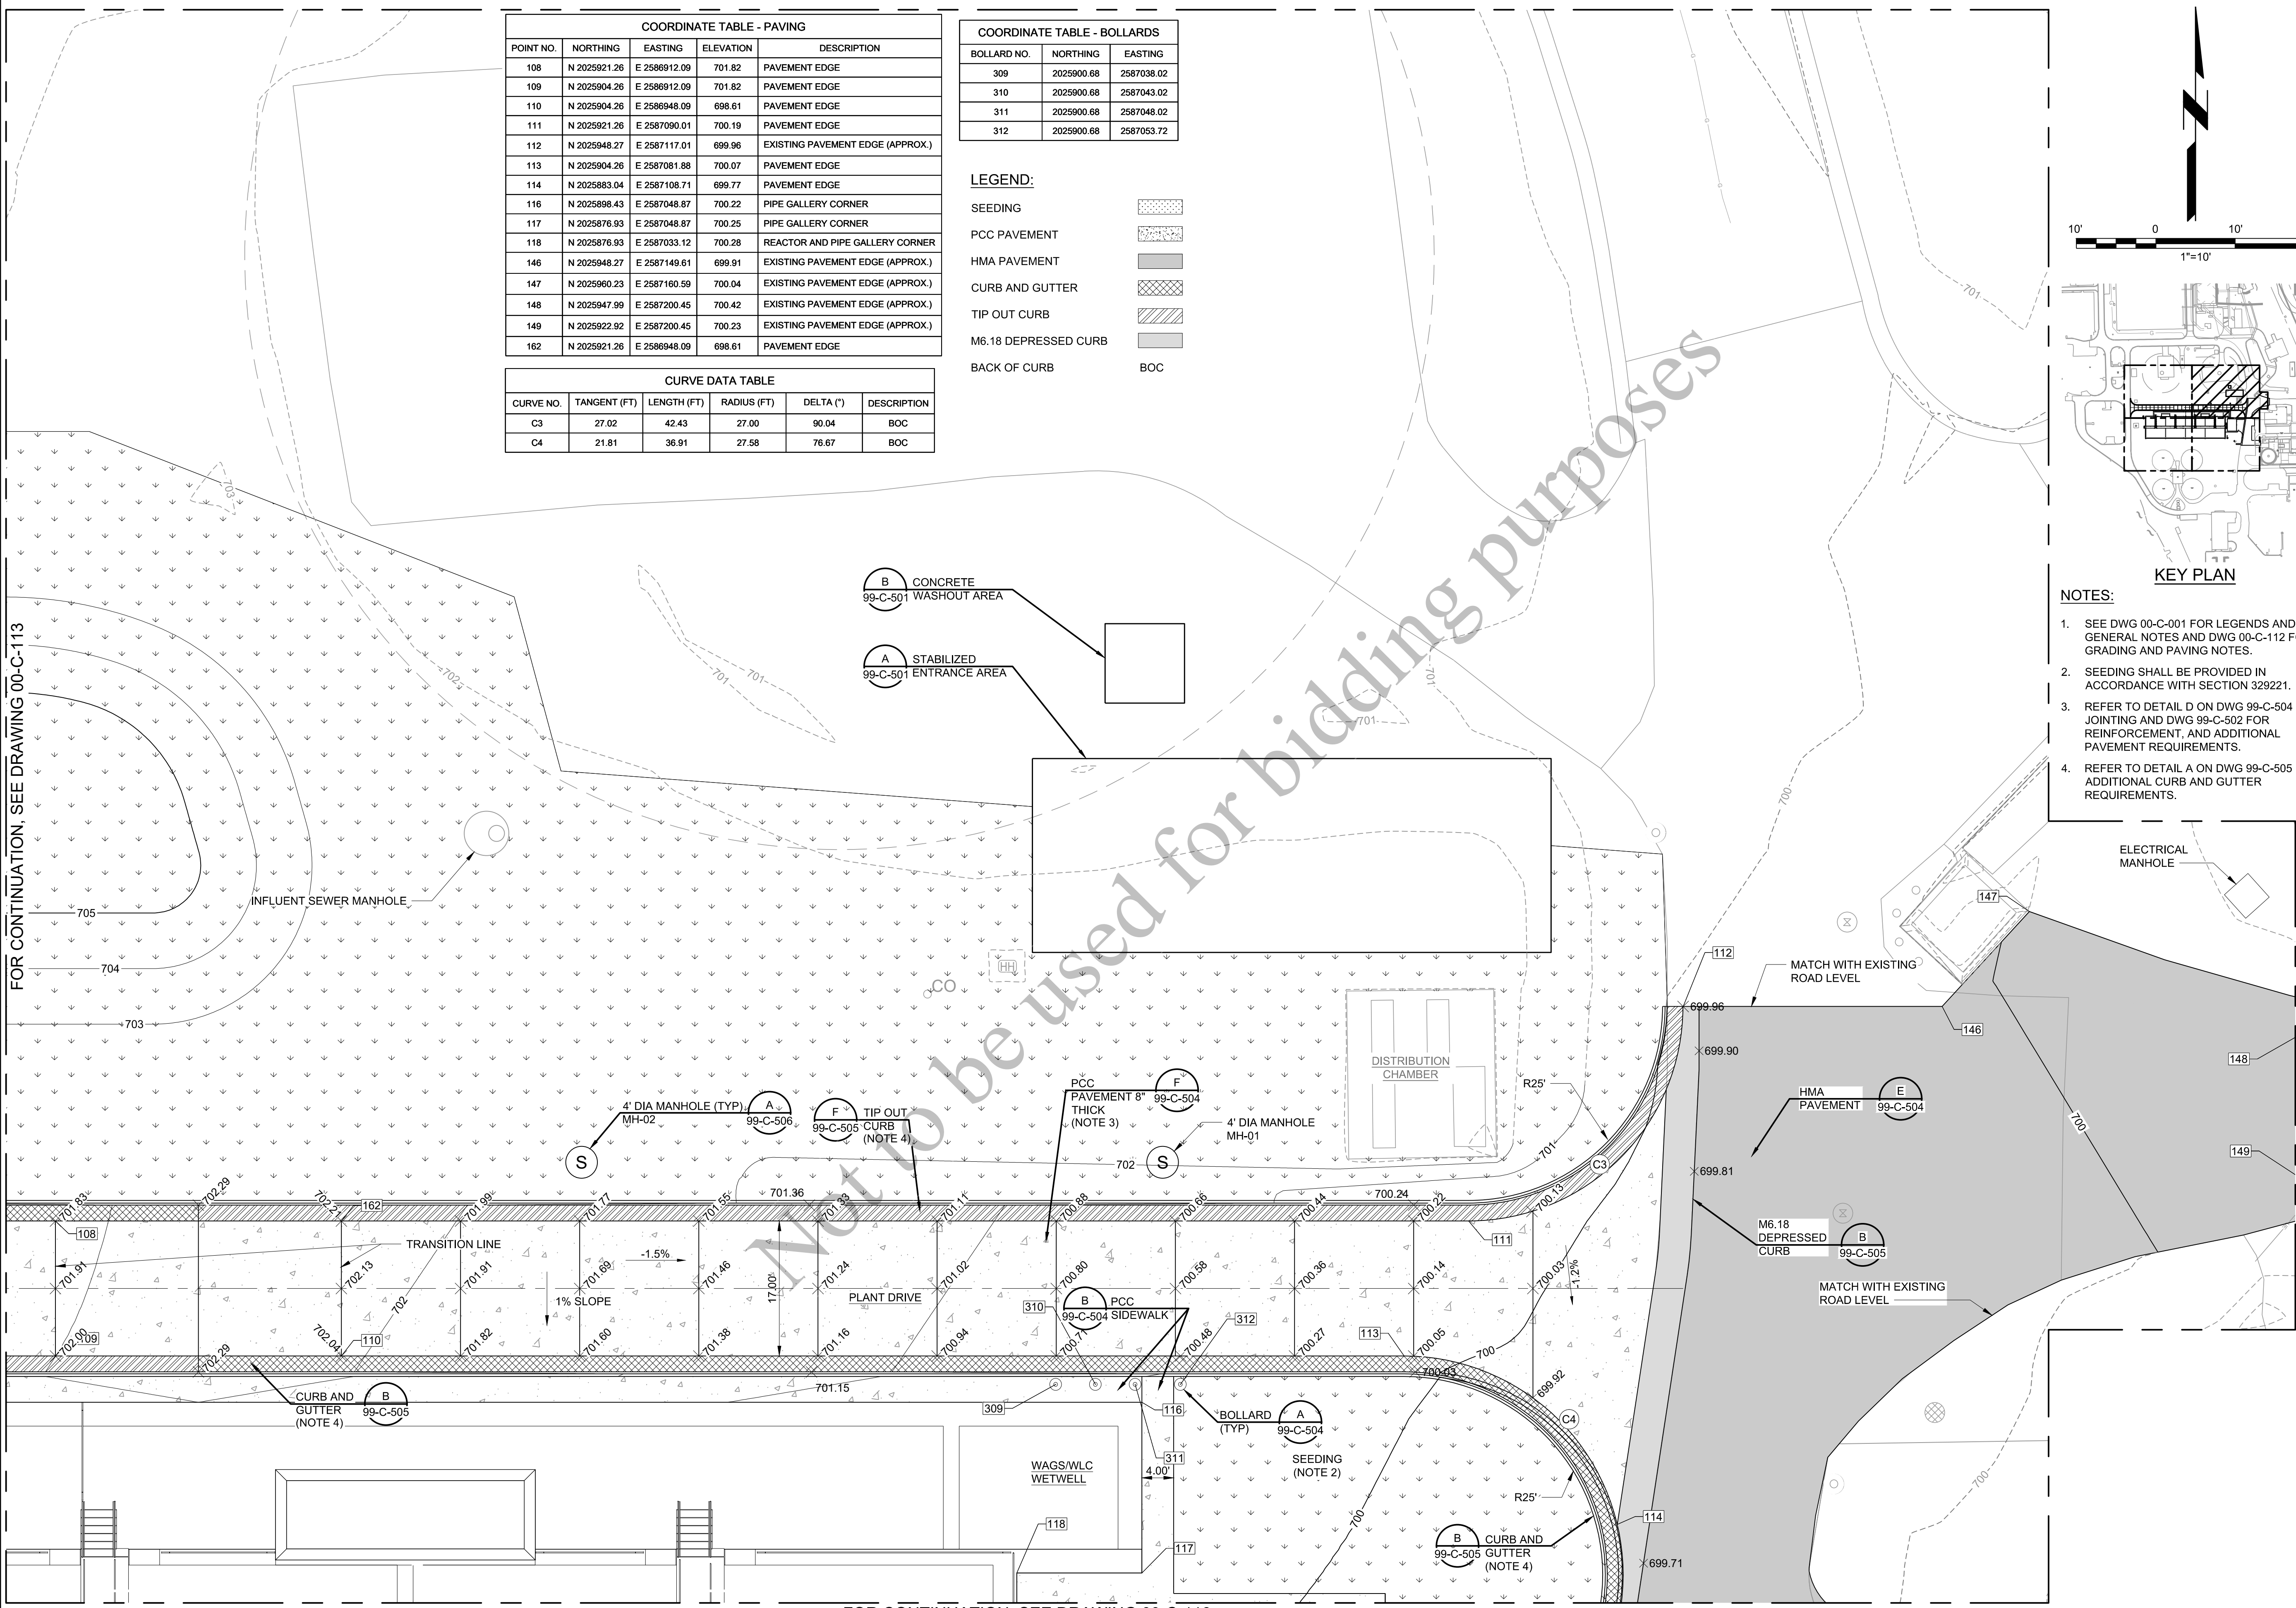

AEROBIC GRANULAR
 SLUDGE - PHASE 1

REVISIONS AND RECORD OF ISSUE	
DESIGNED:	SM
DETAILED:	AB
CHECKED:	AM/JH
APPROVED:	MR
DATE:	12/20/2022
PROJECT NO.:	411752

GENERAL

CIVIL

GRADING AND PAVING
 PLAN 2 OF 4

00-C-114

44
 OF
 163

(SCALE BAR IS 4" AT FULL SCALE) 0 1/2 1 2 3 4

Not to be used for bidding purposes

FOR CONTINUATION SEE DRAWING 00-C-116

COORDINATE TABLE - AGS REACTOR				
POINT NO.	NORTHING	EASTING	ELEVATION	DESCRIPTION
121	N 2025842.59	E 2586729.12	702.00	EFFLUENT BOX CORNER
122	N 2025842.59	E 2586723.45	702.00	EFFLUENT BOX CORNER
123	N 2025834.26	E 2586723.45	702.00	EFFLUENT BOX CORNER
124	N 2025834.26	E 2586729.12	702.00	EFFLUENT BOX CORNER
125	N 2025794.93	E 2586729.12	699.50	REACTOR WALL CORNER
126	N 2025795.93	E 2586732.12	699.50	REACTOR WALL CORNER
127	N 2025794.93	E 2586732.12	699.50	REACTOR WALL CORNER
128	N 2025795.93	E 2586805.12	699.50	REACTOR WALL CORNER
129	N 2025794.93	E 2586805.12	699.50	REACTOR WALL CORNER
130	N 2025794.93	E 2586807.12	699.50	REACTOR WALL CORNER
131	N 2025795.93	E 2586807.12	699.50	REACTOR WALL CORNER
132	N 2025795.93	E 2586880.12	699.50	REACTOR WALL CORNER
133	N 2025794.93	E 2586880.12	699.50	REACTOR WALL CORNER
134	N 2025794.93	E 2586882.12	699.50	REACTOR WALL CORNER
135	N 2025795.93	E 2586882.12	699.50	REACTOR WALL CORNER

45
OF
63

(SCALE BAR IS 4" AT FULL SCALE) 0 1/2 1 2 3 4

AGS REACTOR NO. 3

AGS REACTOR NO. 4

AGS SUPPORT FACILITIES

SEEDING (NOTE 2)

PCC PAVEMENT 8" THICK (NOTE 3)

HMA PAVEMENT

ELECTRICAL MANHOLE

M6.18 DEPRESSED CURB

CURB AND GUTTER OUTLET, SPECIAL

REFER PIEZOMETER DETAIL G/99-C-506

SEE DWG 00-C-111 FOR STORMWATER PRECAST HEADWALL INFORMATION

PROTECT IN-PLACE STORMWATER FLARED END SECTION AND RIPRAP

RIVER STATION TANK NO. 1



PLANT DRIVE TO PRIMARY FILTER EFFLUENT DIVERSION STRUCTURE

COORDINATE TABLE

POINT NO.	NORTHING	EASTING	ELEVATION	DESCRIPTION
119	N 2025776.13	E 2587073.53	697.98	OUTLET EDGE POINT
120	N 2025776.13	E 2587089.97	698.86	OUTLET EDGE POINT
136	N 2025795.93	E 2587030.13	699.50	REACTOR WALL CORNER
137	N 2025794.93	E 2587030.13	699.50	REACTOR WALL CORNER
138	N 2025794.93	E 2587033.12	699.96	REACTOR WALL CORNER
139	N 2025823.68	E 2587040.83	699.96	SUPPORT FACILITIES CORNER
140	N 2025870.34	E 2587040.83	700.25	SUPPORT FACILITIES CORNER
141	N 2025870.34	E 2587075.50	699.91	SUPPORT FACILITIES CORNER
142	N 2025823.68	E 2587075.50	699.83	SUPPORT FACILITIES CORNER
143	N 2025823.68	E 2587082.26	699.76	CURB GUTTER / PAVEMENT EDGE
144	N 2025806.43	E 2587097.09	699.96	CURB GUTTER / PAVEMENT EDGE
145	N 2025778.04	E 2587092.78	698.94	OUTLET EDGE POINT
150	N 2025788.45	E 2587132.86	699.75	EXISTING PAVEMENT EDGE
151	N 2025795.93	E 2586955.12	699.50	REACTOR WALL CORNER
152	N 2025794.93	E 2586955.12	699.50	REACTOR WALL CORNER
153	N 2025794.93	E 2586957.12	699.50	REACTOR WALL CORNER
154	N 2025795.93	E 2586957.12	699.50	REACTOR WALL CORNER
159	N 2025772.63	E 2587073.53	698.00	OUTLET EDGE POINT
160	N 2025772.63	E 2587089.32	698.73	OUTLET EDGE POINT
161	N 2025770.00	E 2587091.54	698.67	OUTLET EDGE POINT

CURVE DATA TABLE

CURVE NO.	TANGENT (FT)	LENGTH (FT)	RADIUS (FT)	DELTA (°)	DESCRIPTION
C5	17.45	25.82	15.00	98.63	BOC
C6	4.73	7.81	5.50	81.37	BOC

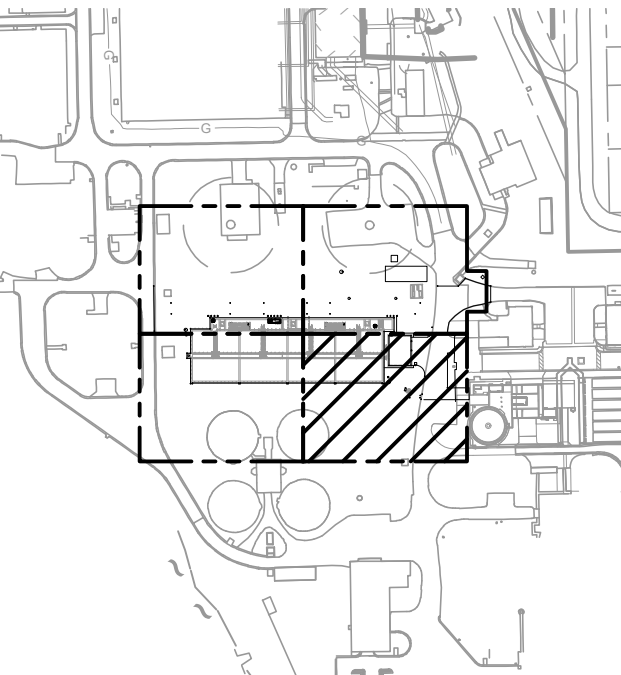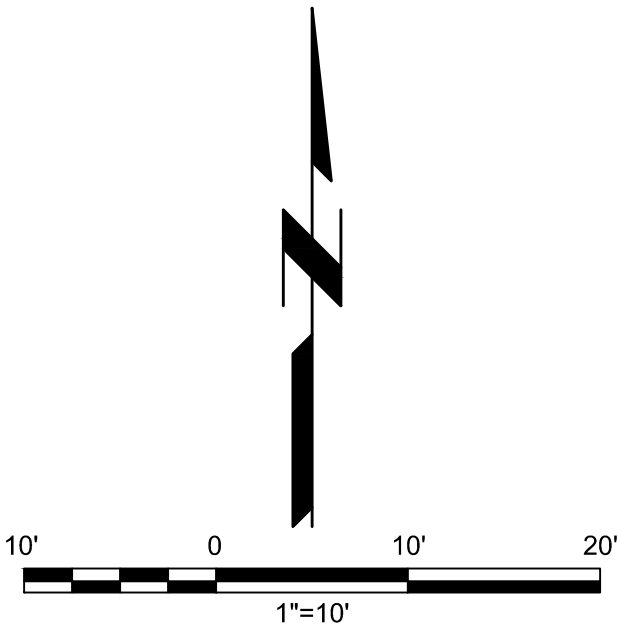46
DF
63

NOTES:

1. SEE DWG 00-C-001 FOR LEGENDS AND GENERAL NOTES AND DWG 00-C-112 FOR GRADING AND PAVING NOTES.
2. SEEDING SHALL BE PROVIDED IN ACCORDANCE WITH SECTION 329221.
3. REFER TO DETAIL D ON DWG 99-C-504 FOR JOINTING AND DWG 99-C-502 FOR REINFORCEMENT, AND ADDITIONAL PAVEMENT REQUIREMENTS.

LEGEND:

SEEDING

PCC PAVEMENT

HMA PAVEMENT

M6.18 DEPRESSI

score



11/11/2016



COORDINATE TABLE				
POINT NO.	NORTHING	EASTING	ELEVATION	DESCRIPTION
119	N 2025776.43	E 2587073.53	697.98	OUTLET EDGE POINT
120	N 2025776.13	E 2587089.97	698.86	OUTLET EDGE POINT
136	N 2025796.93	E 2587030.13	699.50	REACTOR WALL CORNER
137	N 2025794.93	E 2587030.13	699.50	REACTOR WALL CORNER
138	N 2025794.93	E 2587033.12	699.96	REACTOR WALL CORNER
139	N 2025823.68	E 2587040.83	699.96	SUPPORT FACILITIES CORNER
140	N 2025870.34	E 2587040.83	700.25	SUPPORT FACILITIES CORNER
141	N 2025870.34	E 2587075.50	699.91	SUPPORT FACILITIES CORNER
142	N 2025823.68	E 2587075.50	699.83	SUPPORT FACILITIES CORNER
143	N 2025823.68	E 2587082.26	699.76	CURB GUTTER / PAVEMENT EDGE
144	N 2025806.43	E 2587097.09	699.96	CURB GUTTER / PAVEMENT EDGE
145	N 2025778.04	E 2587092.78	698.94	OUTLET EDGE POINT
150	N 2025788.45	E 2587132.86	699.75	EXISTING PAVEMENT EDGE
151	N 2025795.93	E 2586955.12	699.50	REACTOR WALL CORNER
152	N 2025794.93	E 2586955.12	699.50	REACTOR WALL CORNER
153	N 2025794.93	E 2586957.12	699.50	REACTOR WALL CORNER
154	N 2025795.93	E 2586957.12	699.50	REACTOR WALL CORNER
159	N 2025772.63	E 2587073.53	698.00	OUTLET EDGE POINT
160	N 2025772.63	E 2587089.97	698.73	OUTLET EDGE POINT
161	N 2025770.00	E 2587091.54	698.67	OUTLET EDGE POINT

CURVE DATA TABLE					
CURVE NO.	TANGENT (FT)	LENGTH (FT)	RADIUS (FT)	DELTA (°)	DESCRIPTION
C5	17.45	25.82	15.00	98.63	BOC
C6	4.73	7.81	5.50	81.37	BOC

FILE:	C:\PW_WORKING\BWV_AMERICAS\ID1495368\00-C-116.DWG
FD11000	
D11000	

(SCALE BAR IS 4" AT FULL SCALE) 0 1/2 1 2 3 4

PLOTTED: 12/12/2022 12:50:51 PM
 FILE: C:\PW\WORKING\BWV_AMERICAS\01495388\00-C-301.DWG
 FD11000
 D111000

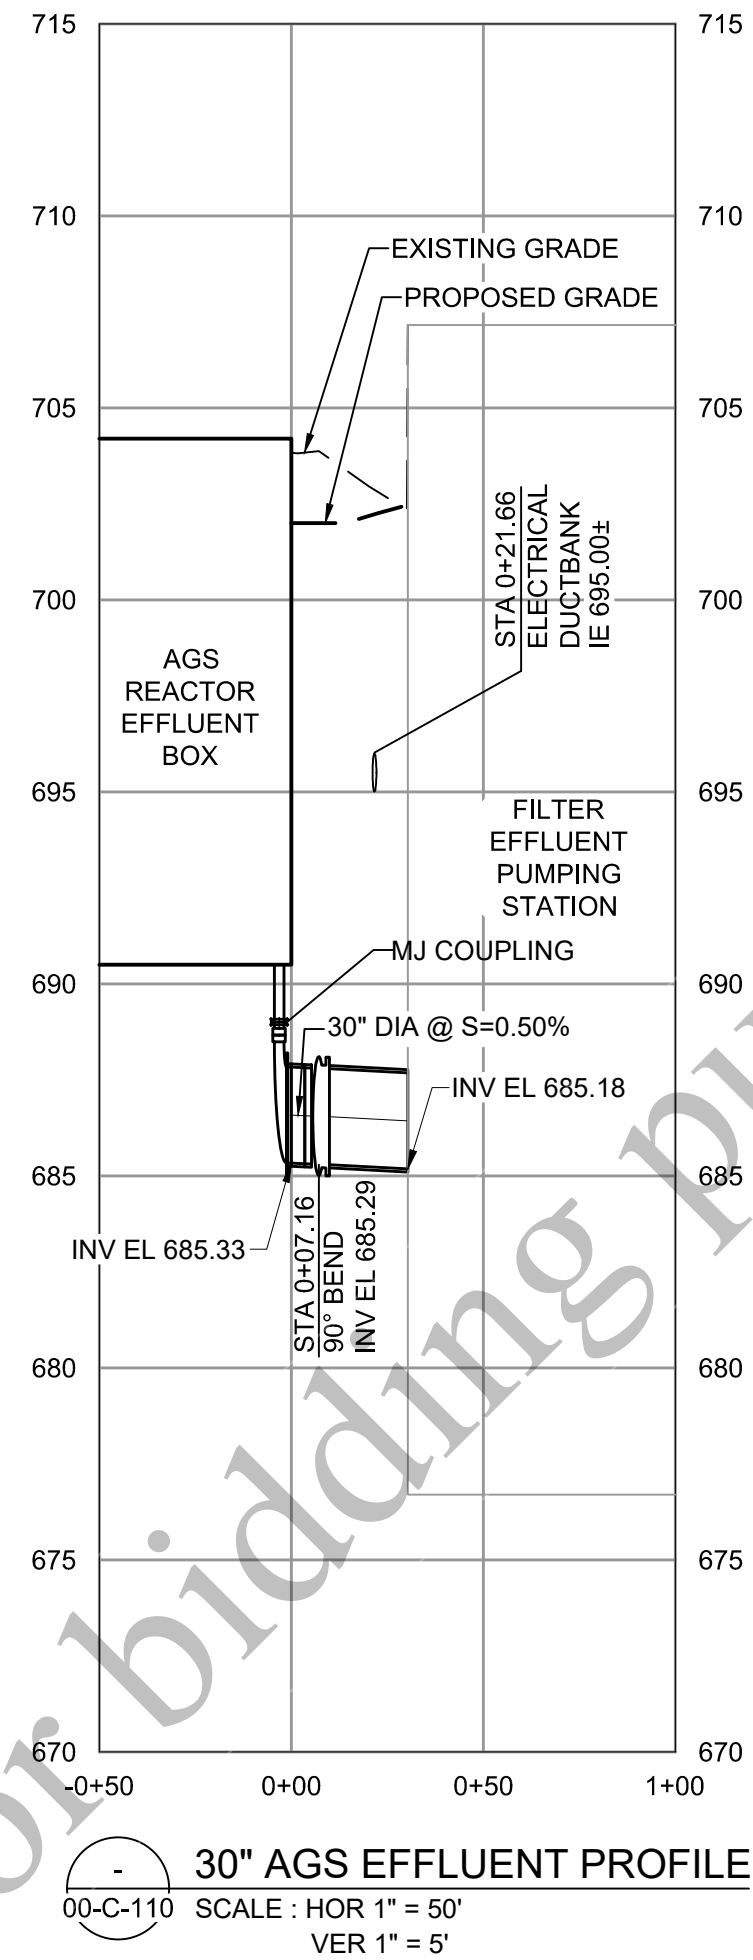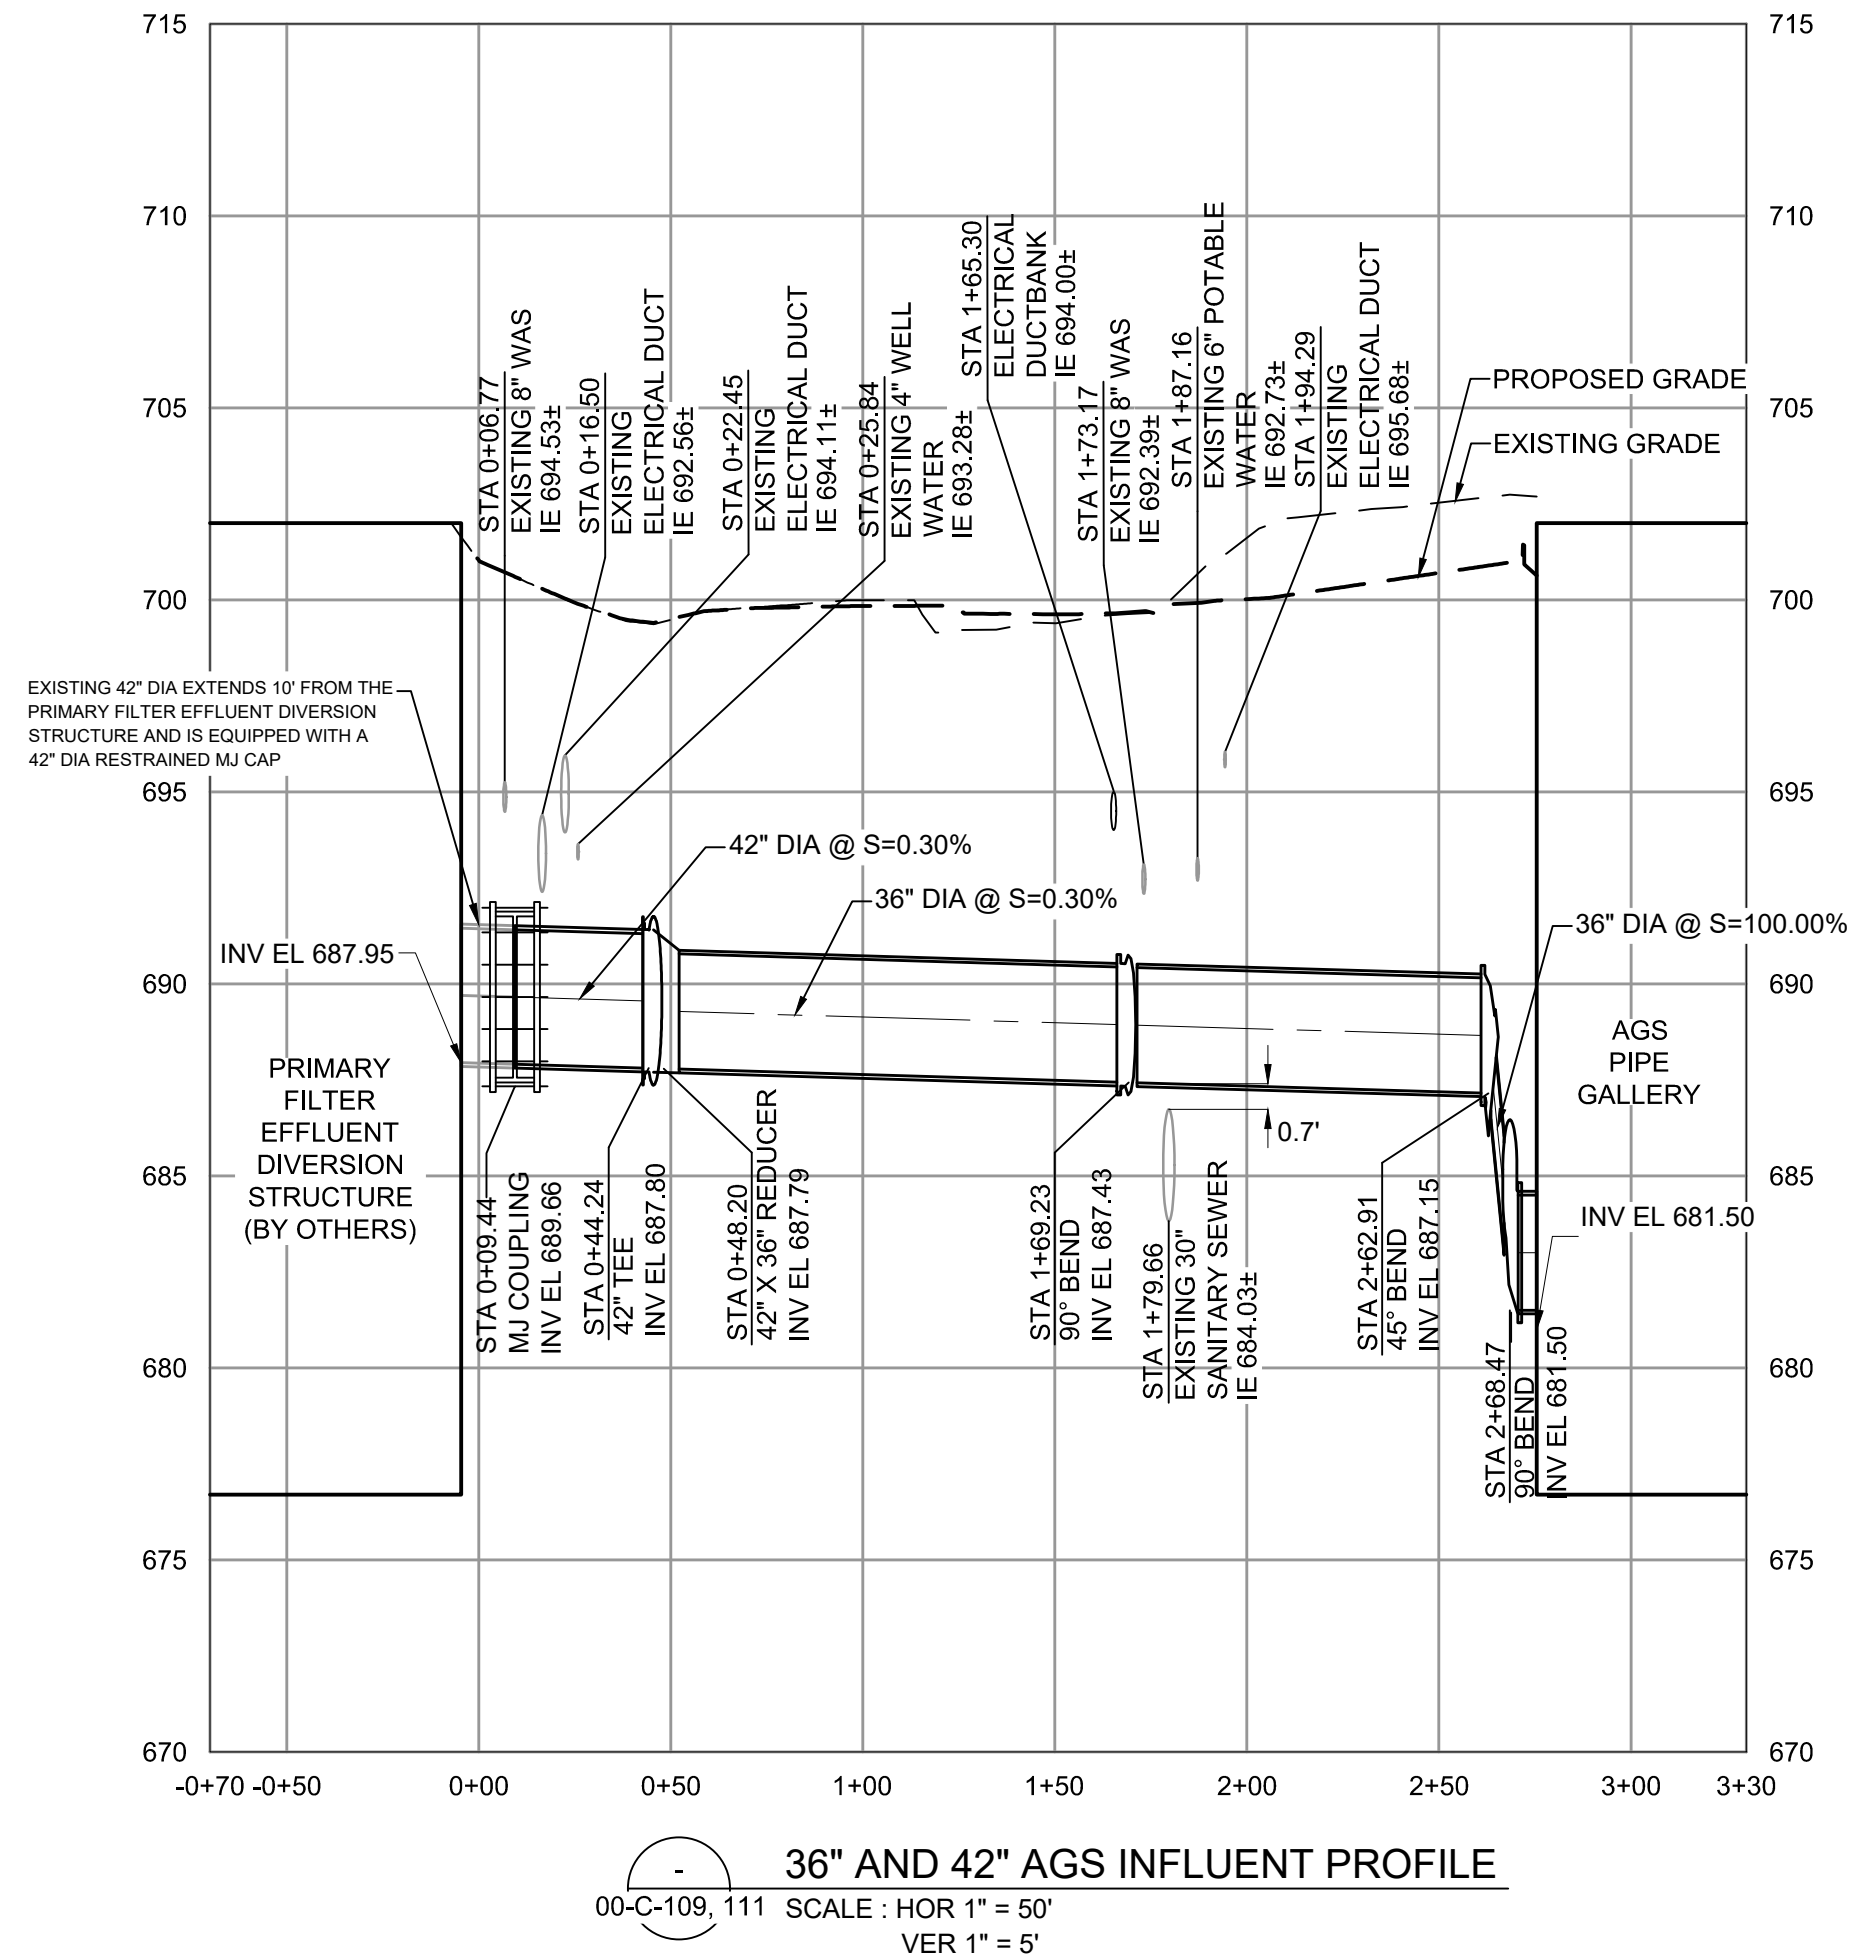

AEROBIC GRANULAR
SLUDGE - PHASE 1

REVISIONS AND RECORD OF ISSUE	
DESIGNED:	SM
DETAILED:	AB
CHECKED:	AM/JH
APPROVED:	MR
DATE:	12/20/2022

PROJECT NO.: 411752


GENERAL

CIVIL




PIPING PROFILES 1 OF 2

00-C-301

47
OF
163

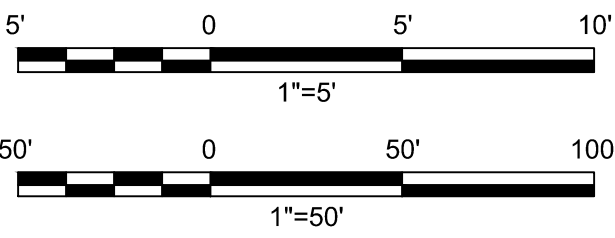

PLOTTED: 12/12/2022 12:51:13 PM
 FILE: C:\PW\WORKING\BW\AMERICAS\01495388\00-C-302.DWG
 FD1000
 D11000

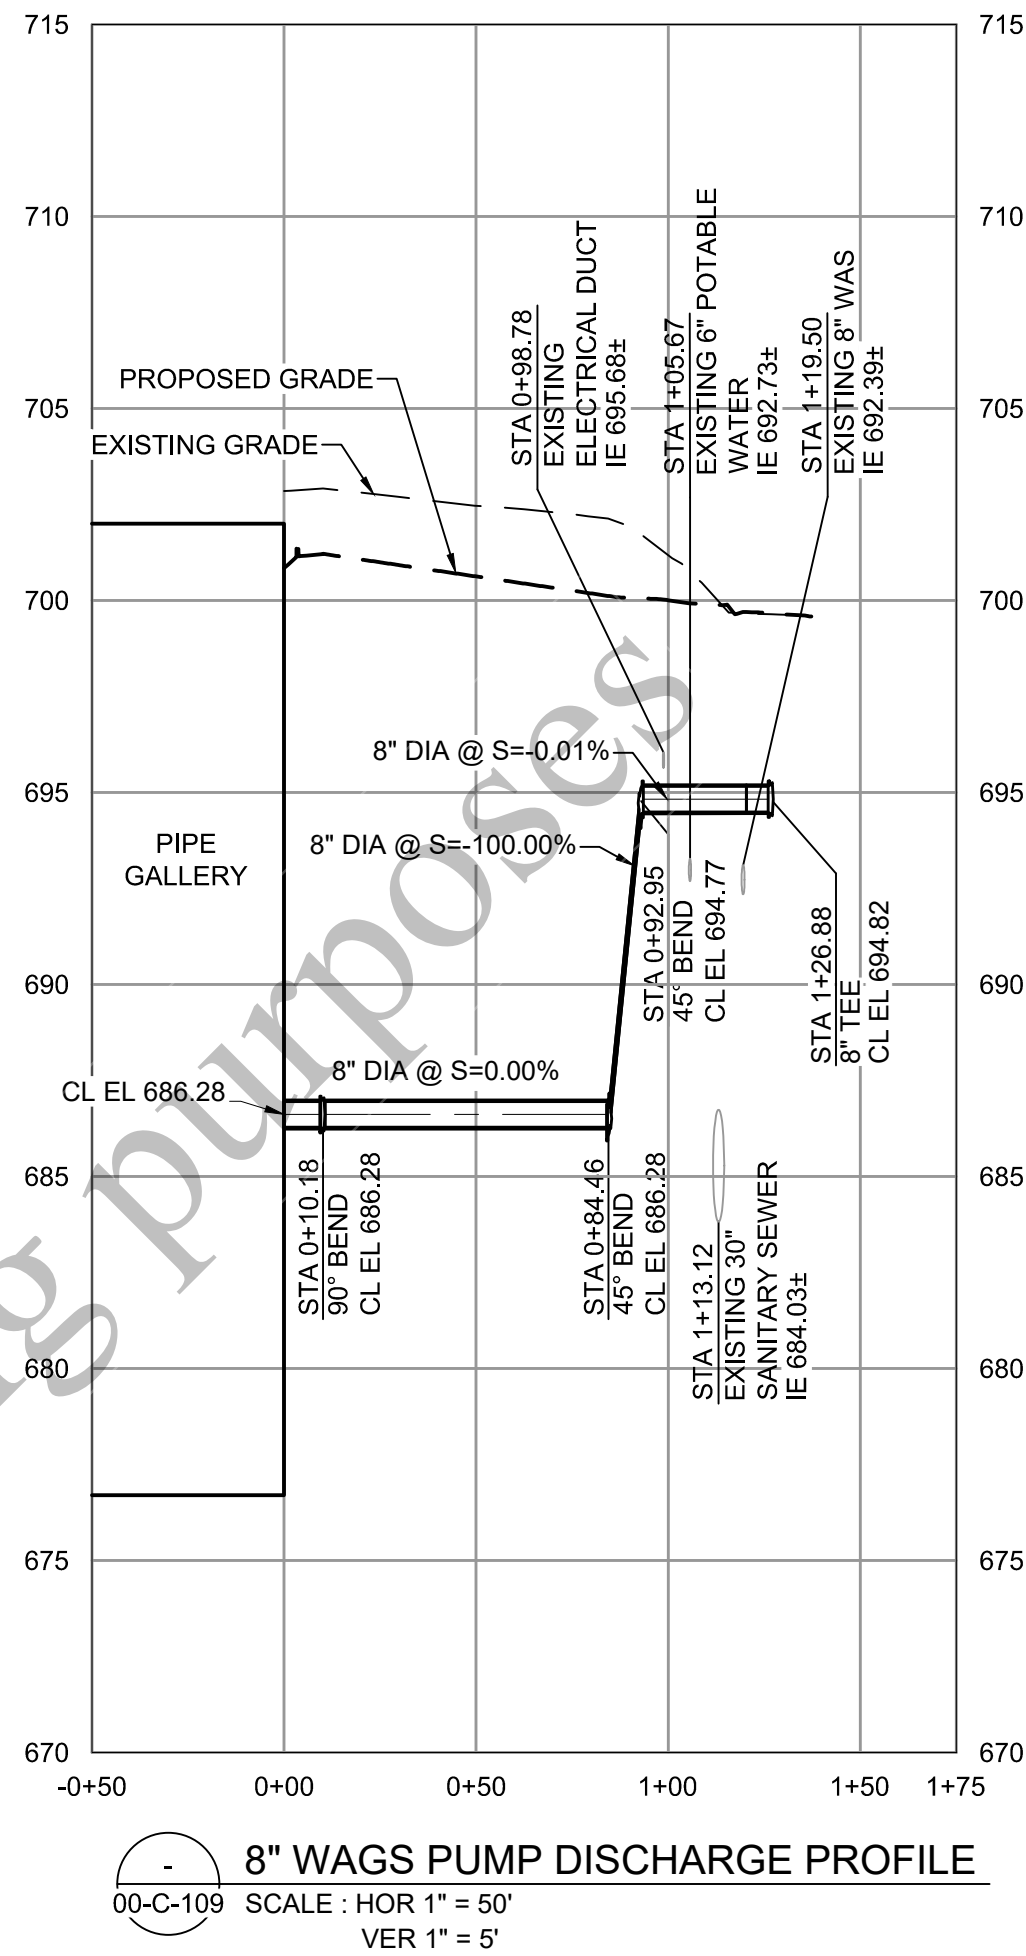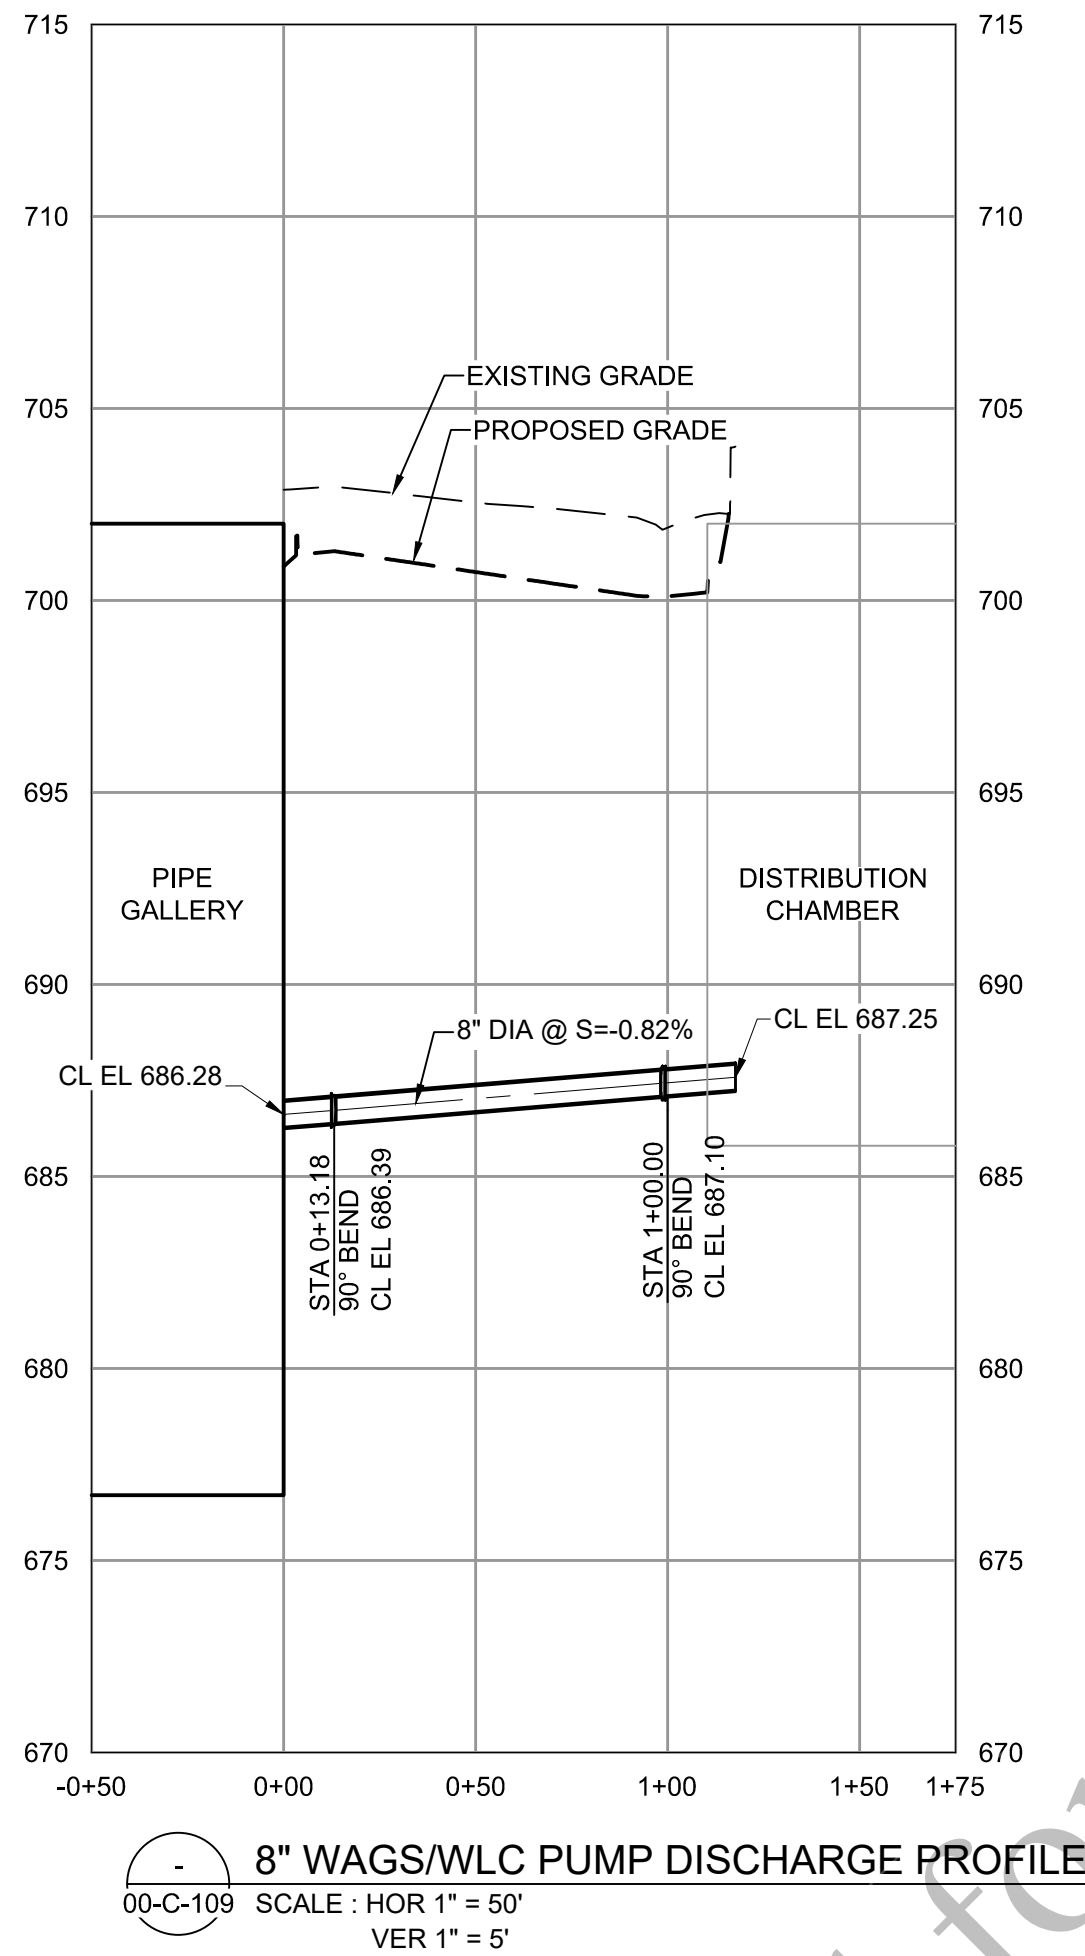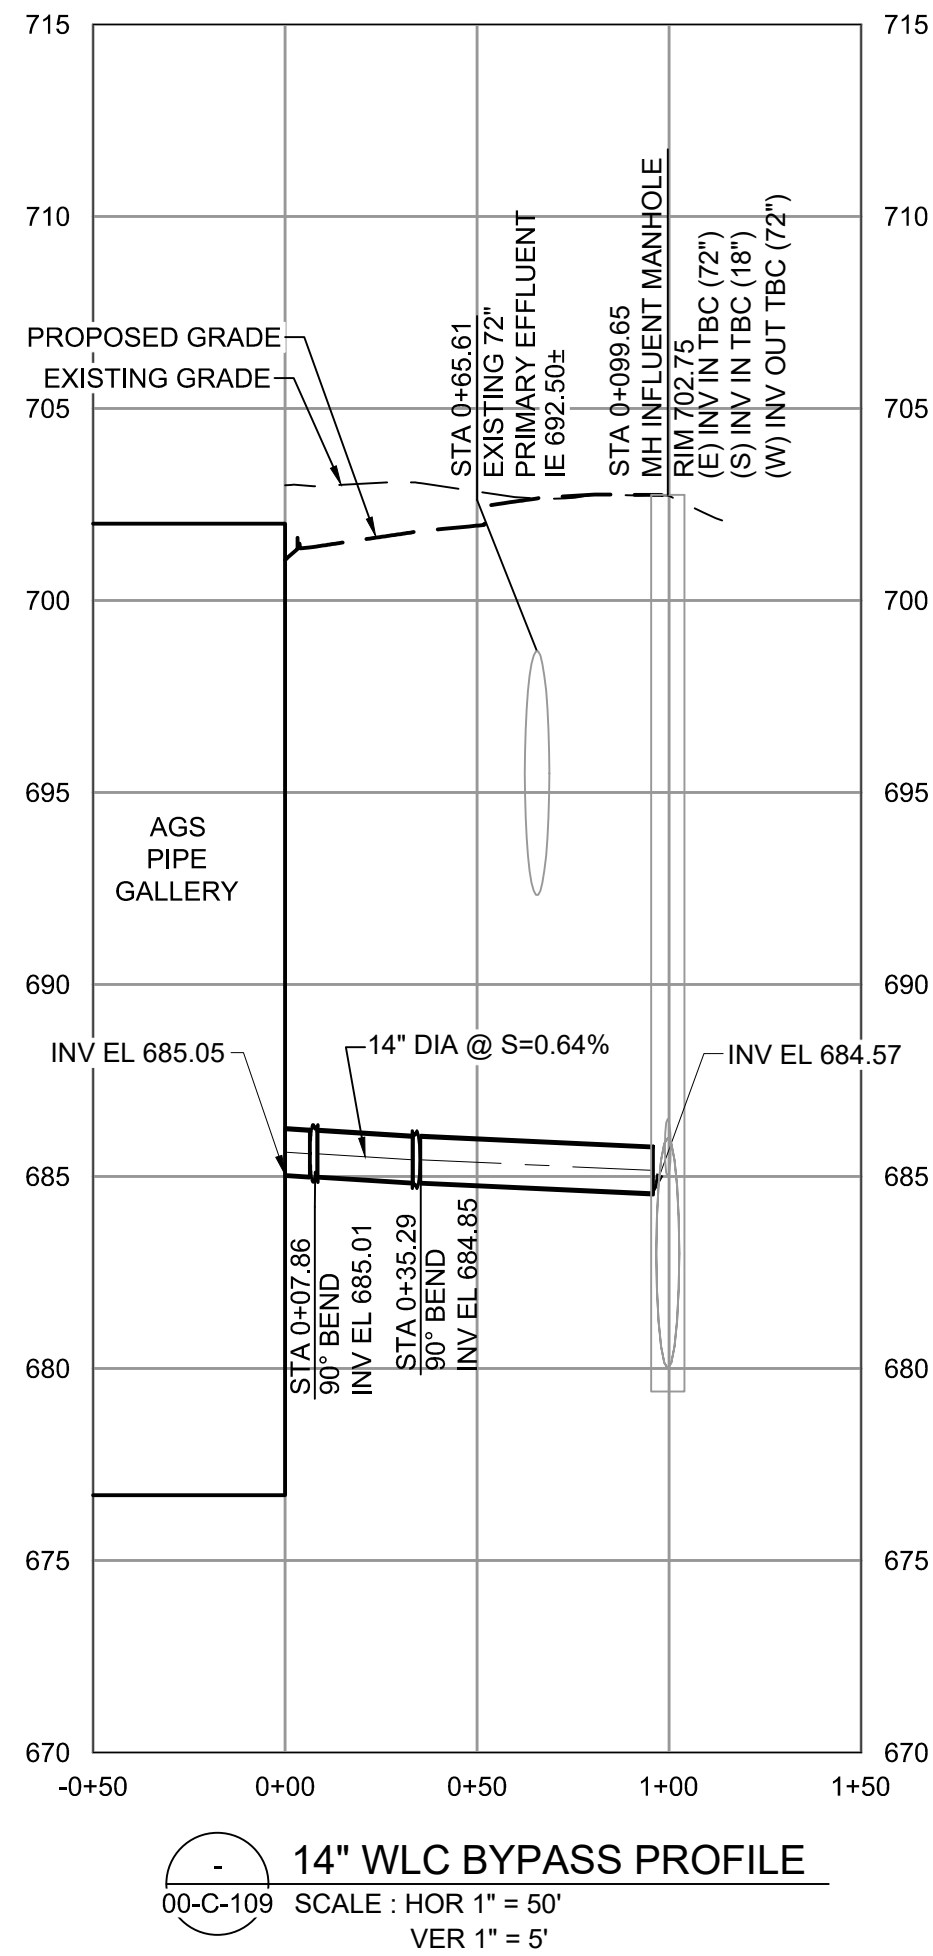

Black & Veatch Corporation
 Chicago, Illinois
 ILLINOIS PROFESSIONAL
 DESIGN FIRM - 184.002143 -0006



AEROBIC GRANULAR
 SLUDGE - PHASE 1

REVISIONS AND RECORD OF ISSUE	
DESIGNED:	SM
DETAILED:	AB
CHECKED:	AM/JH
APPROVED:	MR
DATE:	12/20/2022
PROJECT NO.:	411752


GENERAL

CIVIL

PIPING PROFILES 2 OF 2


00-C-302

48
OF
163

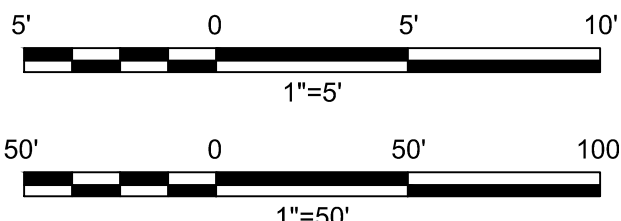

(SCALE BAR IS 4" AT FULL SCALE)

PLOTTED: 12/19/2022 11:02:46 AM
FILE: C:\PW\WORKING\BW\AMERICAS\01495380\00-E-101.DWG
FDI:000
D11000

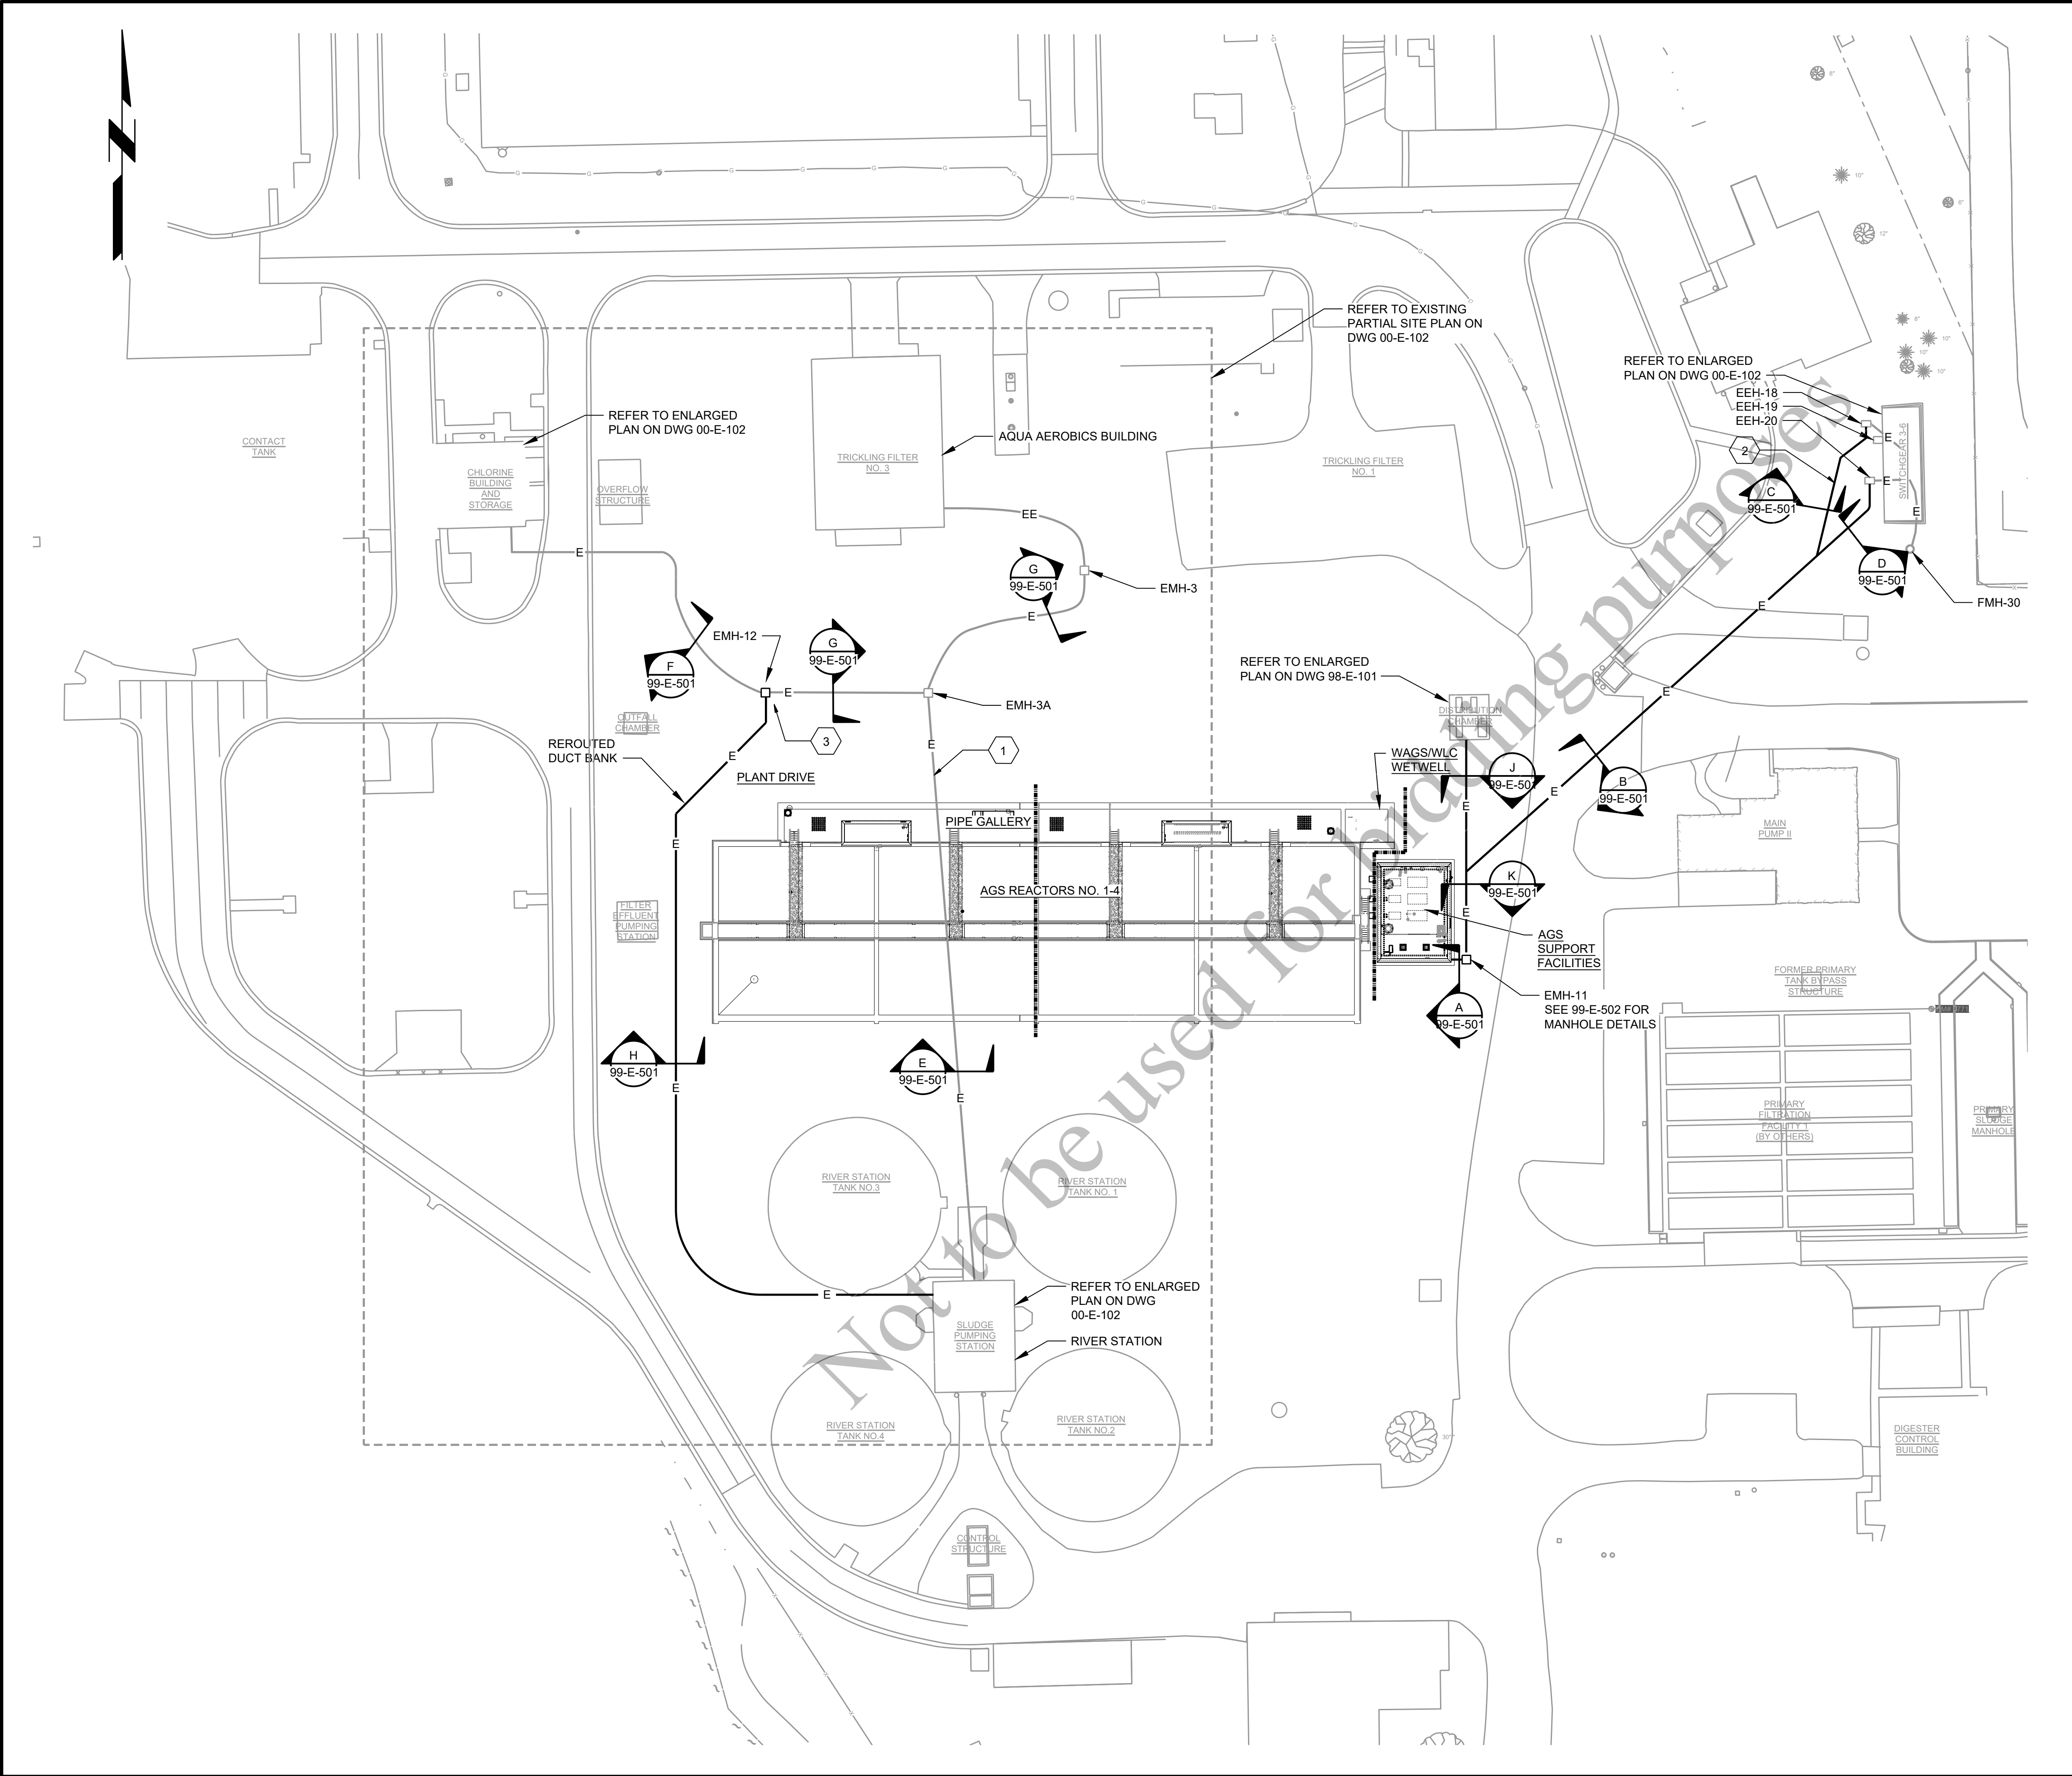

GENERAL SHEET NOTES


1. SEE DRAWINGS 00-E-001 AND 00-E-002 FOR LEGENDS, ABBREVIATIONS AND NOTES.

SHEET KEYNOTES

1. CONTRACTOR SHALL DEMOLISH EXISTING DUCT BANK BETWEEN EXISTING MANHOLE EMH-3A AND THE RIVER STATION. ALL CIRCUITS WITHIN SHALL BE REPLACED, TERMINATED, TESTED, AND PLACED BACK INTO SERVICE UTILIZING NEW CABLES IN NEW "REROUTED" DUCT BANK. FOR EXISTING CABLE DETAILS SEE 99-E-501. ANY OPENINGS IN EMH-3A FROM THE DEMOLISHED DUCT BANK SHALL BE SEALED FLUSH WITH CONCRETE.
2. CONTRACTOR SHALL CONNECT DUCT BANK GROUNDING CONDUCTORS TO EXISTING GROUNDING GRID AT SWITCHGEAR 3-6.
3. CONTRACTOR SHALL REMOVE A SECTION OF THE EXISTING DUCT BANK AND INSTALL A NEW MANHOLE. THE EXISTING DUCT BANK AND NEW DUCT BANK SHALL BE CONNECTED TO THIS NEW MANHOLE.

EXISTING DUCT BANK AT NEW MANHOLE LOCATION IS THREE 4" DIAMETER CONDUITS WIDE AND TWO 4" CONDUITS TALL (APPROX 2'-0" W X 1'-5" H). CONTRACTOR SHALL SAW CUT NO MORE THAN 6" WIDE SECTION FOR REMOVAL OF DUCT BANK SECTION. EXCAVATION SHALL BE SUPPORTED AS NEEDED. PLACE AND COMPACT STONE BENEATH, POUR SLAB BENEATH, FORM WALLS AROUND EXISTING DUCT BANK, CAST WALLS, REMOVE FORMS, FORM AND INSTALL TOP SLAB WITH 36" DIAMETER FRAME.

EXISTING INFLUENT 72" INFLUENT SEWER IS APPROXIMATELY 18 TO 20-FT DEEP IN THIS AREA.

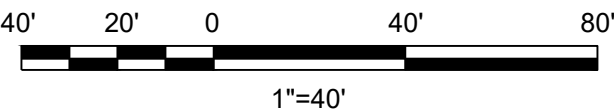

(SCALE BAR IS 4" AT FULL SCALE) 0 1/2 1 2 3 4



Black & Veatch Corporation
Chicago, Illinois
ILLINOIS PROFESSIONAL
DESIGN FIRM - 184.002143 -0006



AEROBIC GRANULAR
SLUDGE - PHASE 1

REVISIONS AND RECORD OF ISSUE	
DESIGNED:	EJB
DETAILED:	SFR
CHECKED:	SDS
APPROVED:	EJB
DATE:	12/20/2022
PROJECT NO.:	411752

GENERAL


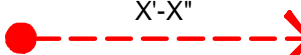


ELECTRICAL

SITE PLAN

00-E-101

49
OF
163



LIFE SAFETY LEGEND				
	WALL MOUNTED FIRE EXTINGUISHER CABINET (FEC)			
	PATH OF EGRESS TRAVEL			
<table border="1" data-bbox="1930 201 2032 254"><tr><td>100 SF/PERSON</td></tr><tr><td>1</td></tr><tr><td>F-2</td></tr></table>	100 SF/PERSON	1	F-2	OCCUPANTS PER SF OCCUPANT LOAD OCCUPANCY CLASSIFICATION
100 SF/PERSON				
1				
F-2				
<table border="1" data-bbox="1967 282 1995 300"><tr><td>5</td></tr></table>	5	CUMULATIVE OCCUPANT LOAD		
5				
	EXIT			
AL	ACTIVE LEAF			
	1 HOUR FIRE BARRIER			

GENERAL SHEET NOTES	
BUILDING CODE ANALYSIS	
BUILDING CODES: 2015 INTERNATIONAL BUILDING CODE WITH AMENDMENTS	
AGS REACTORS AND PIPE GALLERY	
OCCUPANCY	F-1 MODERATE HAZARD FACTORY INDUSTRIAL
TYPE OF CONSTRUCTION	II-B NON COMBUSTIBLE
ACTUAL AREA	3,373 SF
ACTUAL HEIGHT	16'
ALLOWABLE AREA	15,500 SF
ALLOWABLE HEIGHT	55'
DESIGN OCCUPANT LOAD	12
NUMBER OF STORIES	1
ALLOWABLE NUMBER OF STORIES	2
MINIMUM EXITS REQUIRED	3
NUMBER OF EXITS	4
ADA ACCESSIBILITY	EXEMPT PER SECTION 1103.2.9
FIRE SEPARATION	1-HOUR FIRE BARRIERS AROUND EGRESS STAIRS
FIRE SPRINKLERS	REQUIRED OWNER TO SEEK VARIANCE
MAX EXIT TRAVEL DISTANCE	300'
ENERGY CODE COMPLIANCE	WALLS - R-5.7 C.I. ROOF - R-25 C.I.
MAXIMUM COMMON PATH OF EGRESS TRAVEL	75'

B&V Design, LLC
Kansas City, Missouri
ILLINOIS PROFESSIONAL
DESIGN FIRM - 184007283



AEROBIC GRANULAR
SLUDGE - PHASE 1

REVISIONS AND RECORD OF ISSUE	
DESIGNED:	RAB
DETAILED:	TMB
CHECKED:	PDR
APPROVED:	PDR
DATE:	12/20/2022
PROJECT NO.:	411752


AGS REACTORS AND PIPE
GALLERY

ARCHITECTURAL

REACTORS AND
GALLERY LIFE SAFETY
PLAN AND CODE
ANALYSIS

01-A-001


51
OF
163

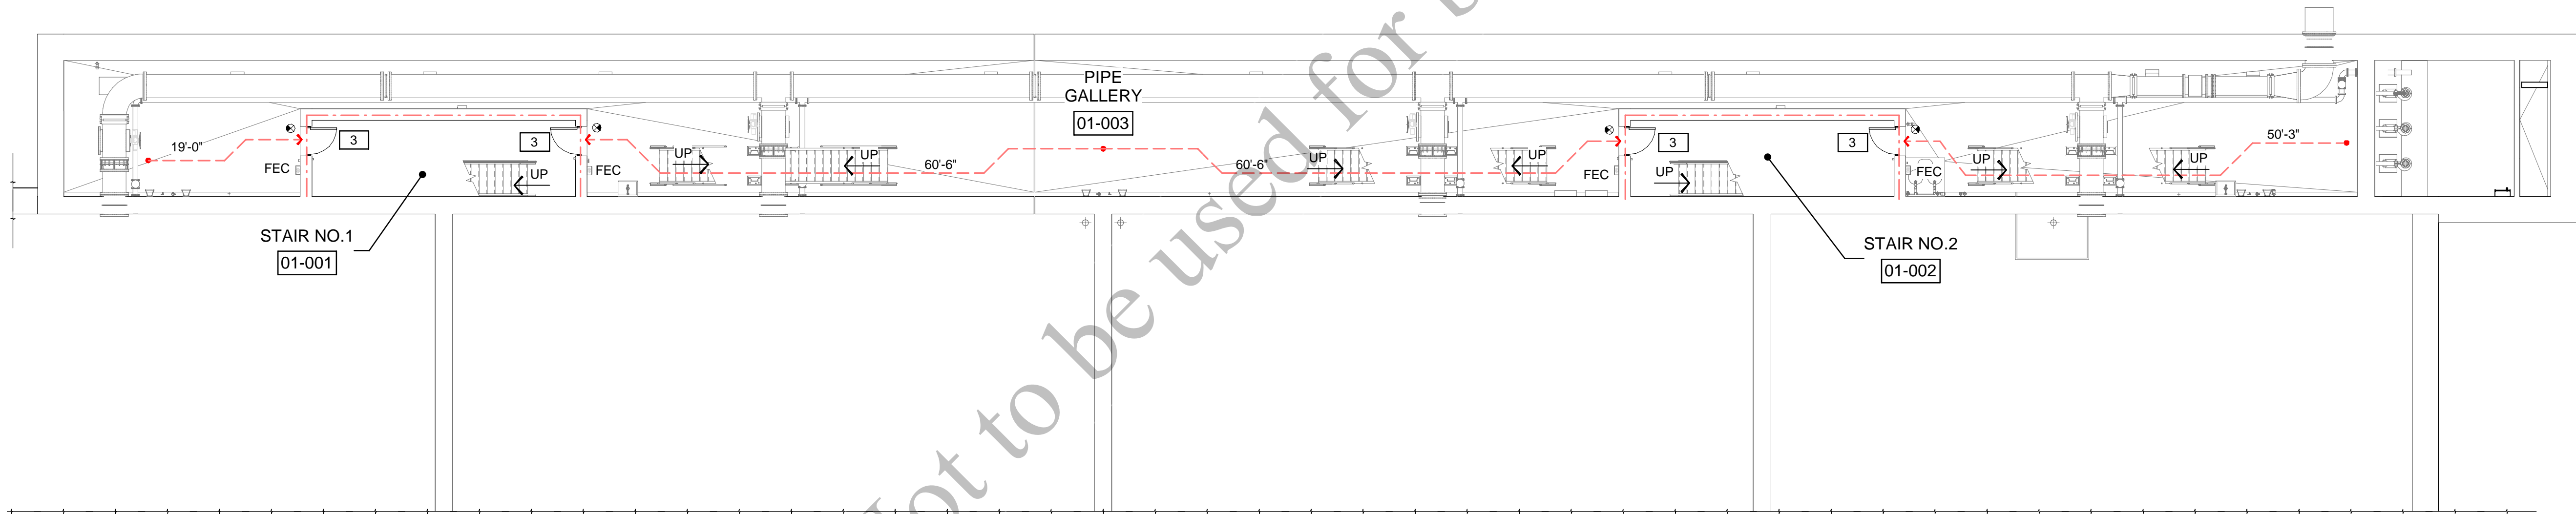

REACTORS, SEE STRUCT DRAWINGS FOR CONTINUATION

GALLERY - LIFE SAFETY PLAN

3/32" = 1'-0"

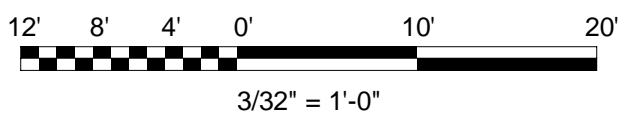


(SCALE BAR IS 4" AT FULL SCALE)




Four Rivers
Sanitation Authority

01-A-101

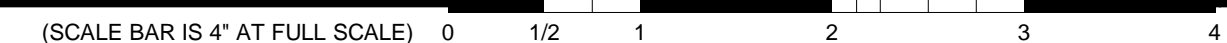

PLOTTED: 12/16/2022 11:52:49 AM
FILE: BIM 360://409469 - Aerobic Granular Sludge Phase 1/409469 - AGS.rvt
D11000

PLOTTED: 12/16/2022 11:51:20 AM
 FILE: BIM 360/409469 - Aerobic Granular Sludge Phase 1/409469 - AGS.rvt
 D11000

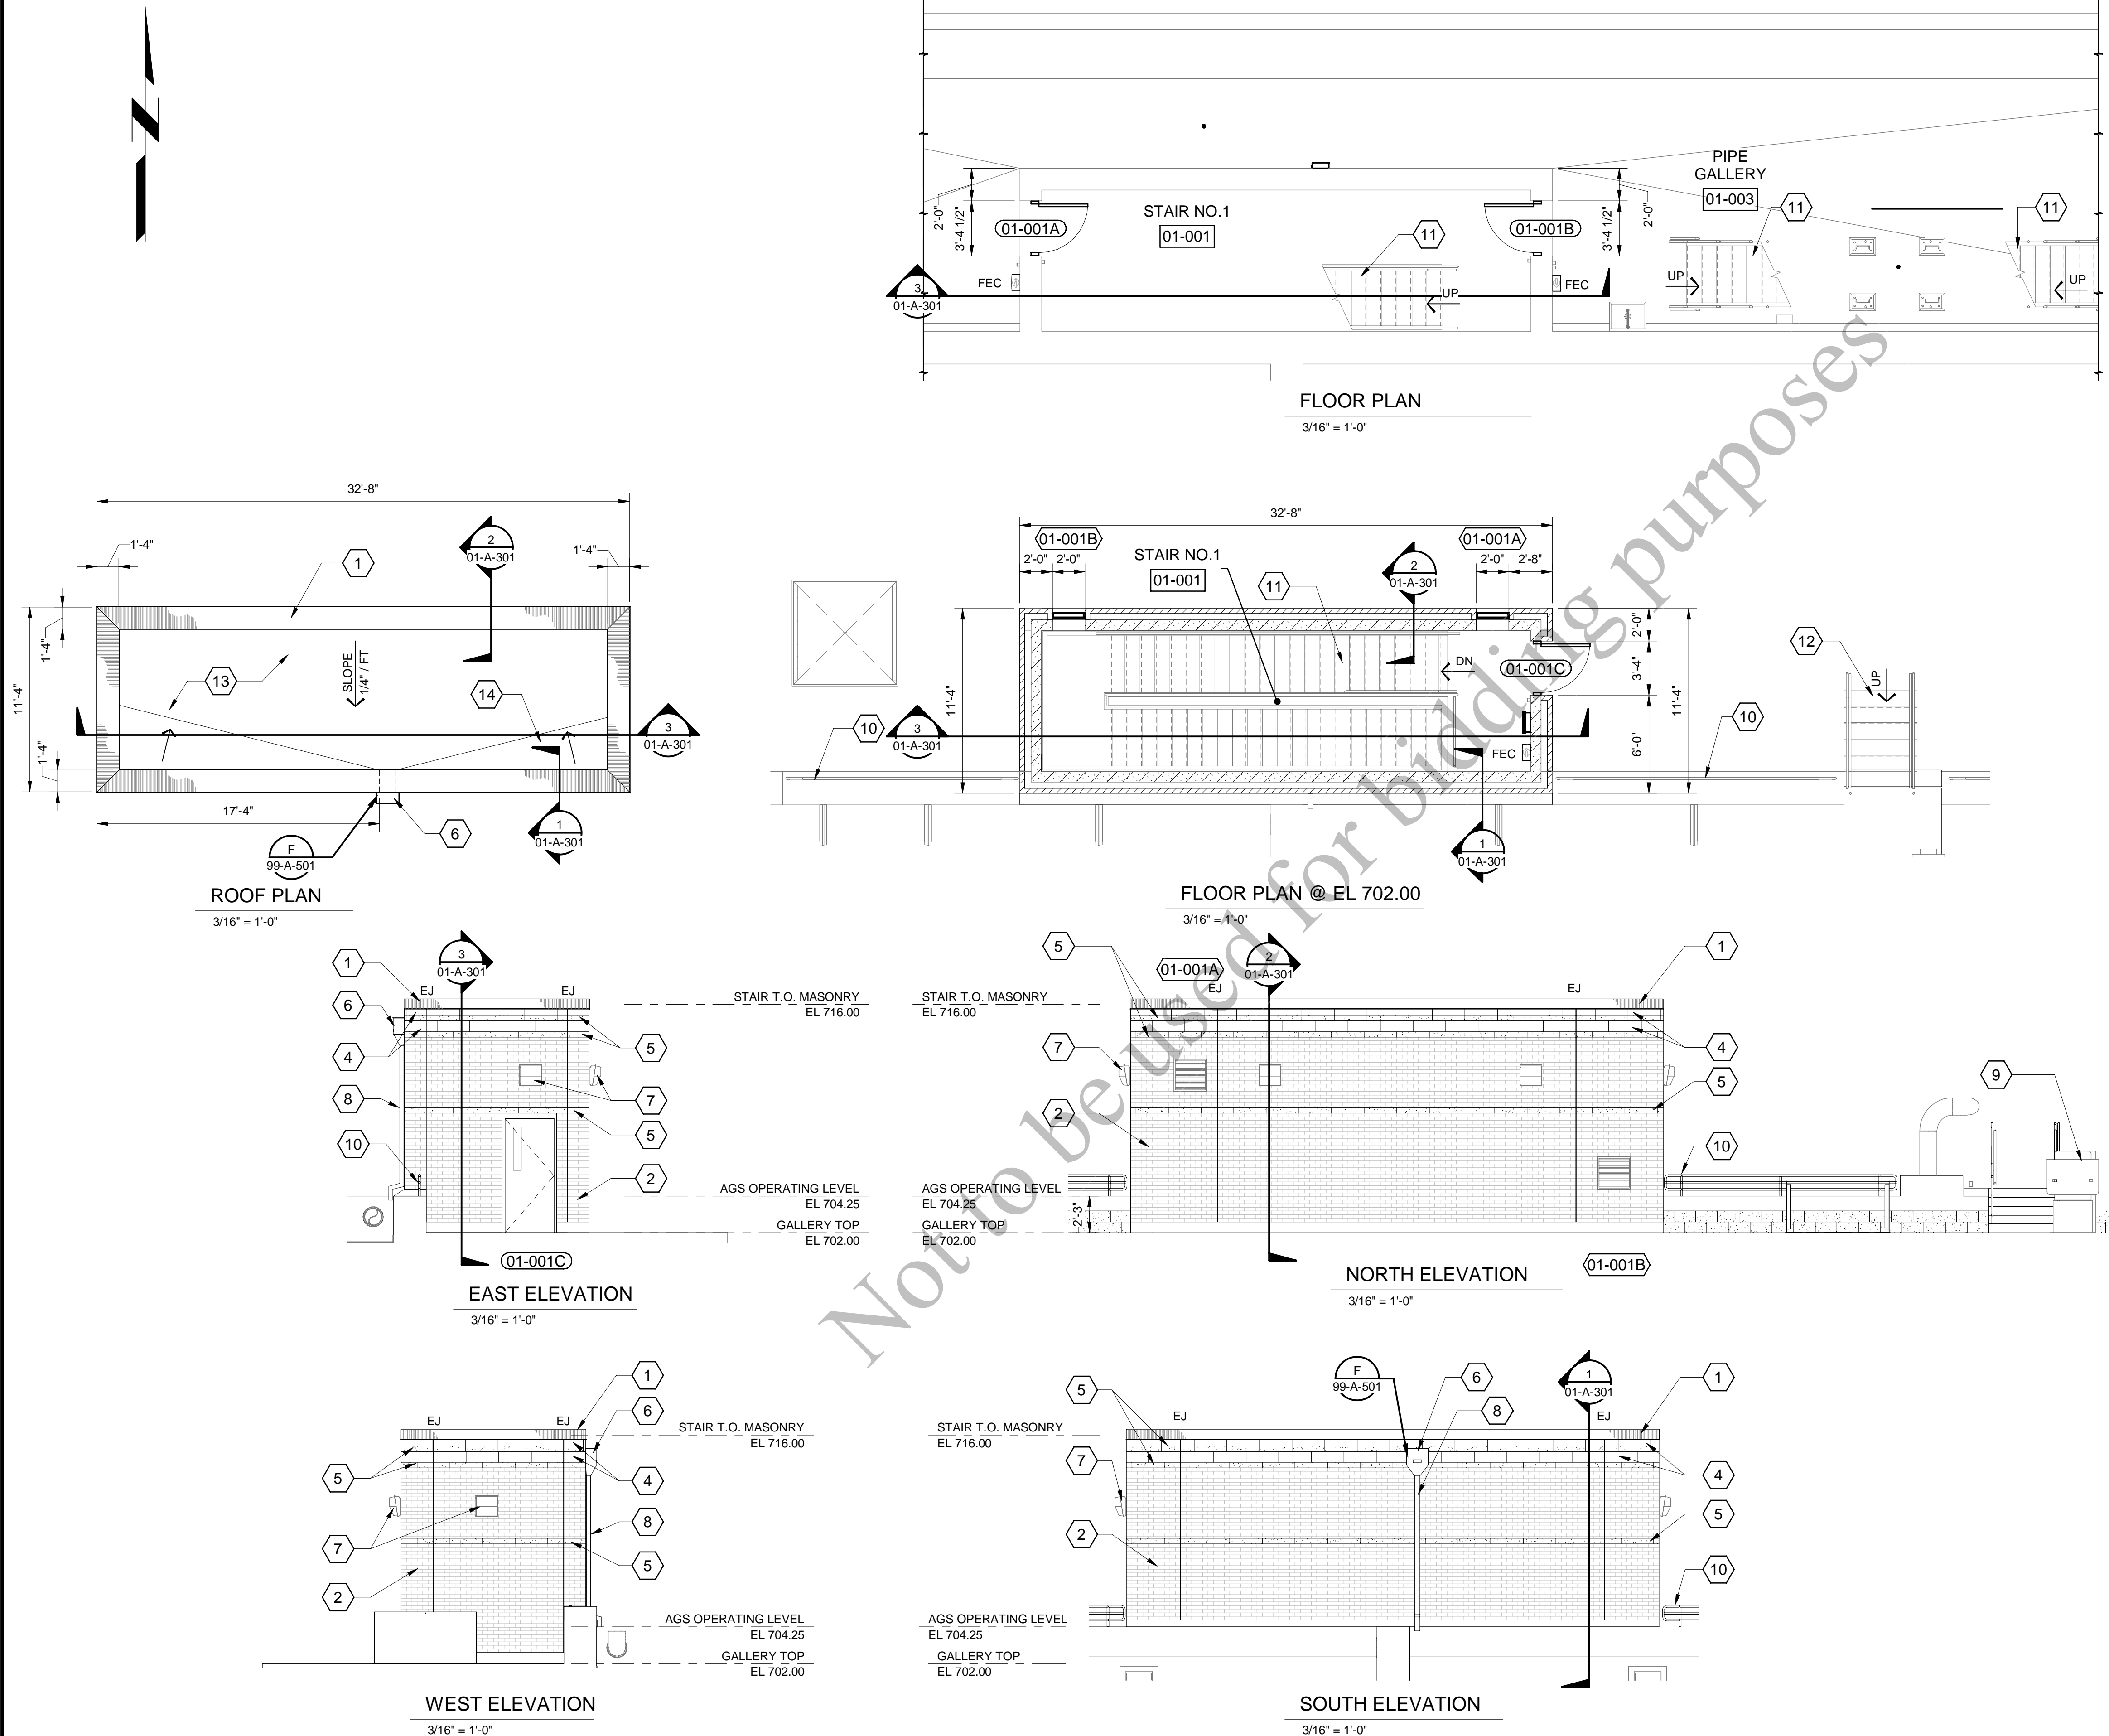

GENERAL SHEET NOTES

- VENEER FACE BRICK EXPANSION JOINT (EJ). SEE STRUCTURAL DRAWINGS FOR BACKUP MASONRY UNITS (CMU) WALL CONTROL JOINT (CJ) WALL CONTROL JOINT LOCATIONS.
- STAIR NO.2 MASONRY WALLS AND ROOF DESIGN TO BE SAME AS STAIR NO.1 SHOWN ON DRAWING.
- SHERWIN WILLIAMS STAIN COLORS:
ACCENT BANDS (4",8", AND 12"); SW6107 NOMADIC DESERT
UPPER DARK COLOR: SW7675 SEAL SKIN

SHEET KEYNOTES

- PREFINISHED METAL COPING.
- FACE BRICK - COLOR TO MATCH EXISTING PRIMARY FILTRATION FACILITY.
- NOT USED.
- 8 x 24 SMOOTHFACE MASONRY UNITS - SIZE, PATTERN AND COLOR TO MATCH EXISTING PRIMARY FILTRATION FACILITY.
- 4 x 24 ROCKFACE MASONRY UNITS - SIZE, PATTERN AND COLOR TO MATCH EXISTING PRIMARY FILTRATION FACILITY.
- PREFINISHED METAL CONDUCTOR HEAD WITH 16" x 8" OPENING.
- LIGHT FIXTURE (TYP) - SEE ELECTRICAL DRAWINGS.
- PREFINISHED METAL DOWNSPOUT.
- HVAC EQUIPMENT - SEE HVAC DRAWINGS.
- GUARDRAIL - SEE STRUCTURAL DRAWINGS.
- METAL STAIRS - SEE STRUCTURAL DRAWINGS.
- CONCRETE STAIRS - SEE STRUCTURAL DRAWINGS.
- SINGLE-PLY ROOFING MEMBRANE OVER 1/2" COVER BOARD AND TAPERED INSULATION R-30.
- CRICKET SYSTEM (TYP).



AEROBIC GRANULAR
SLUDGE - PHASE 1

REVISIONS AND RECORD OF ISSUE

DESIGNED:	RAB
DETAILED:	TMB
CHECKED:	PDR
APPROVED:	PDR
DATE:	12/20/2022
PROJECT NO.:	411752

AGS REACTORS AND PIPE
GALLERY


ARCHITECTURAL

GALLERY STAIR NO.1
PLANS AND ELEVATIONS

01-A-102


53
OF
163

(SCALE BAR IS 4" AT FULL SCALE) 0 1/2 1 2 3 4

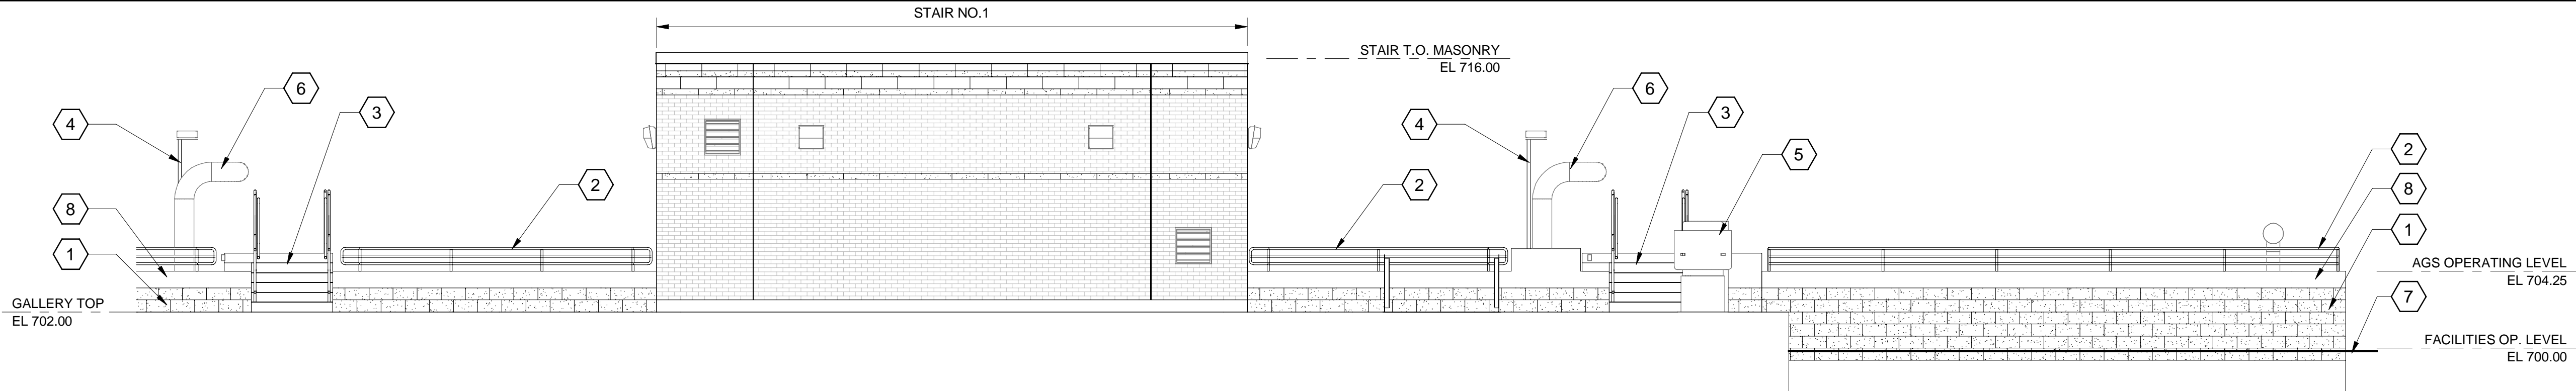


NORTH ELEVATION

3/16" = 1'-0"

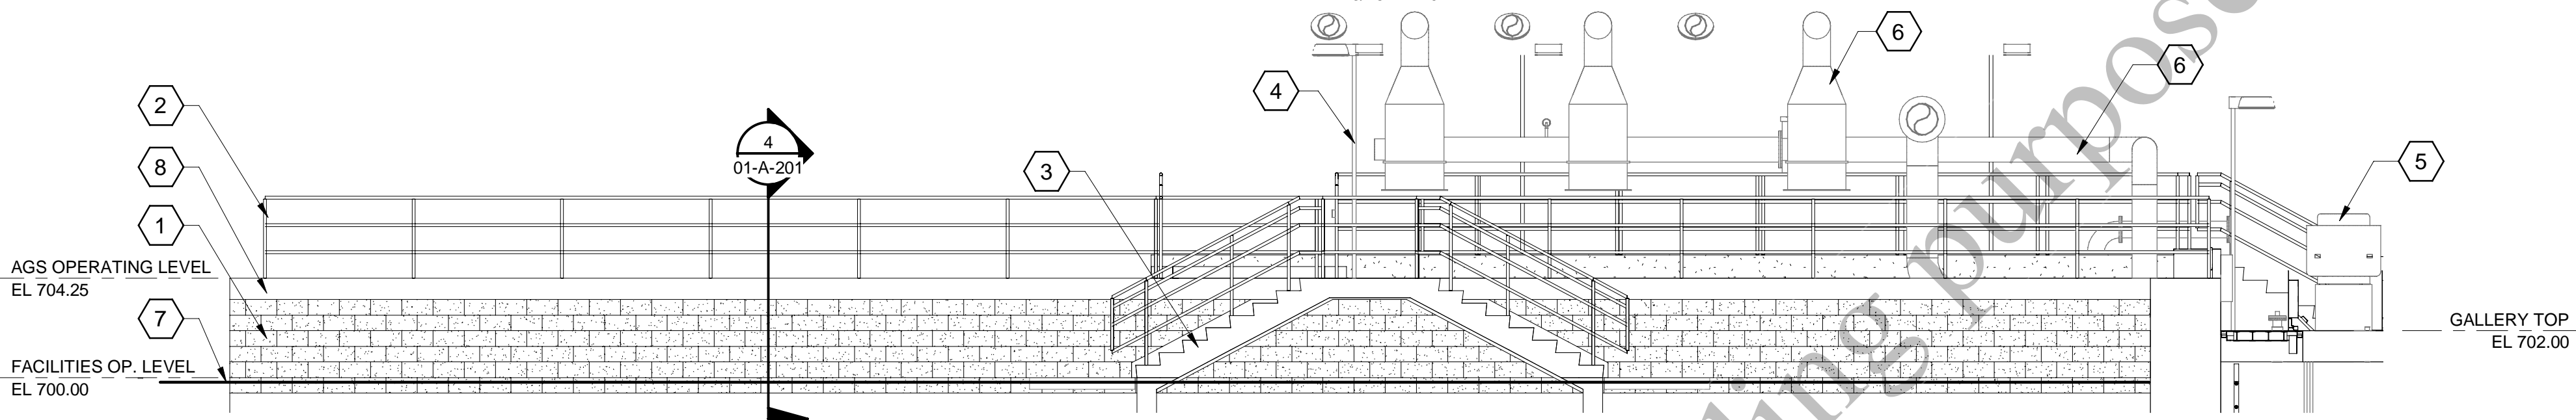


EAST ELEVATION

3/16" = 1'-0"

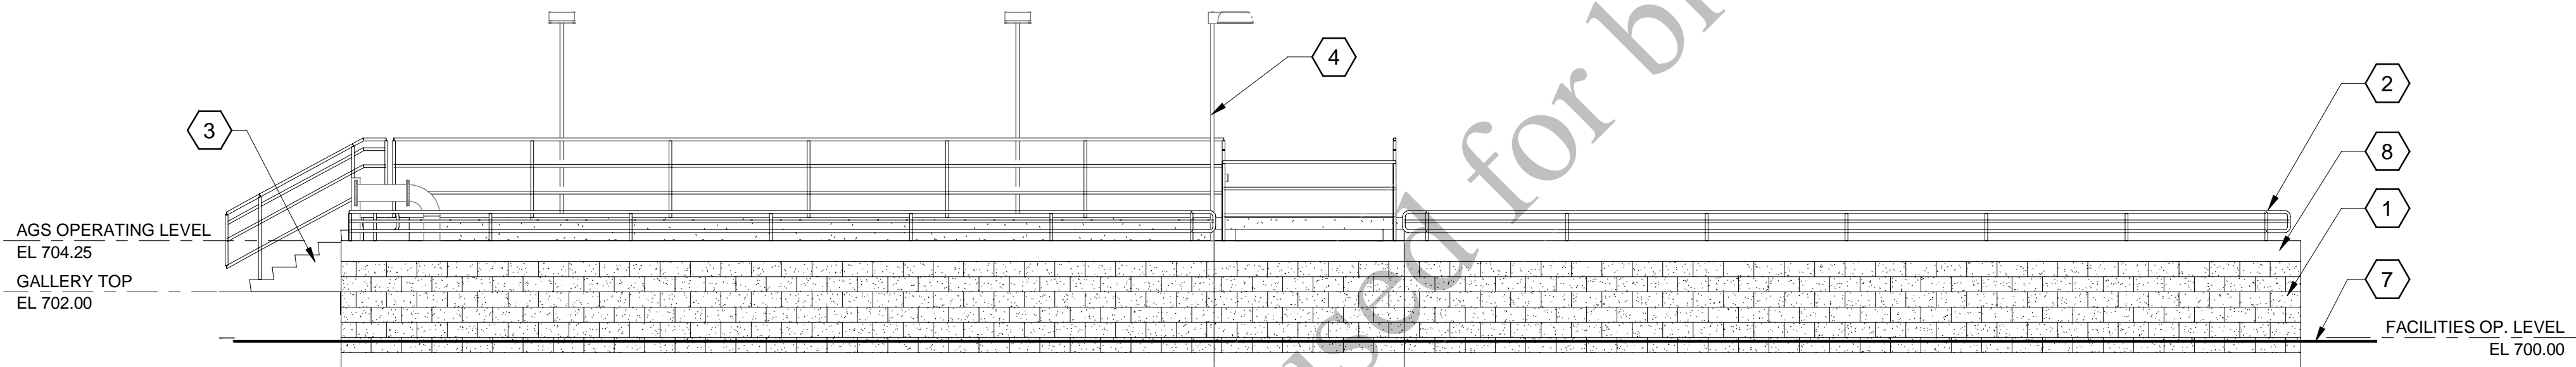

WEST ELEVATION

3/16" = 1'-0"

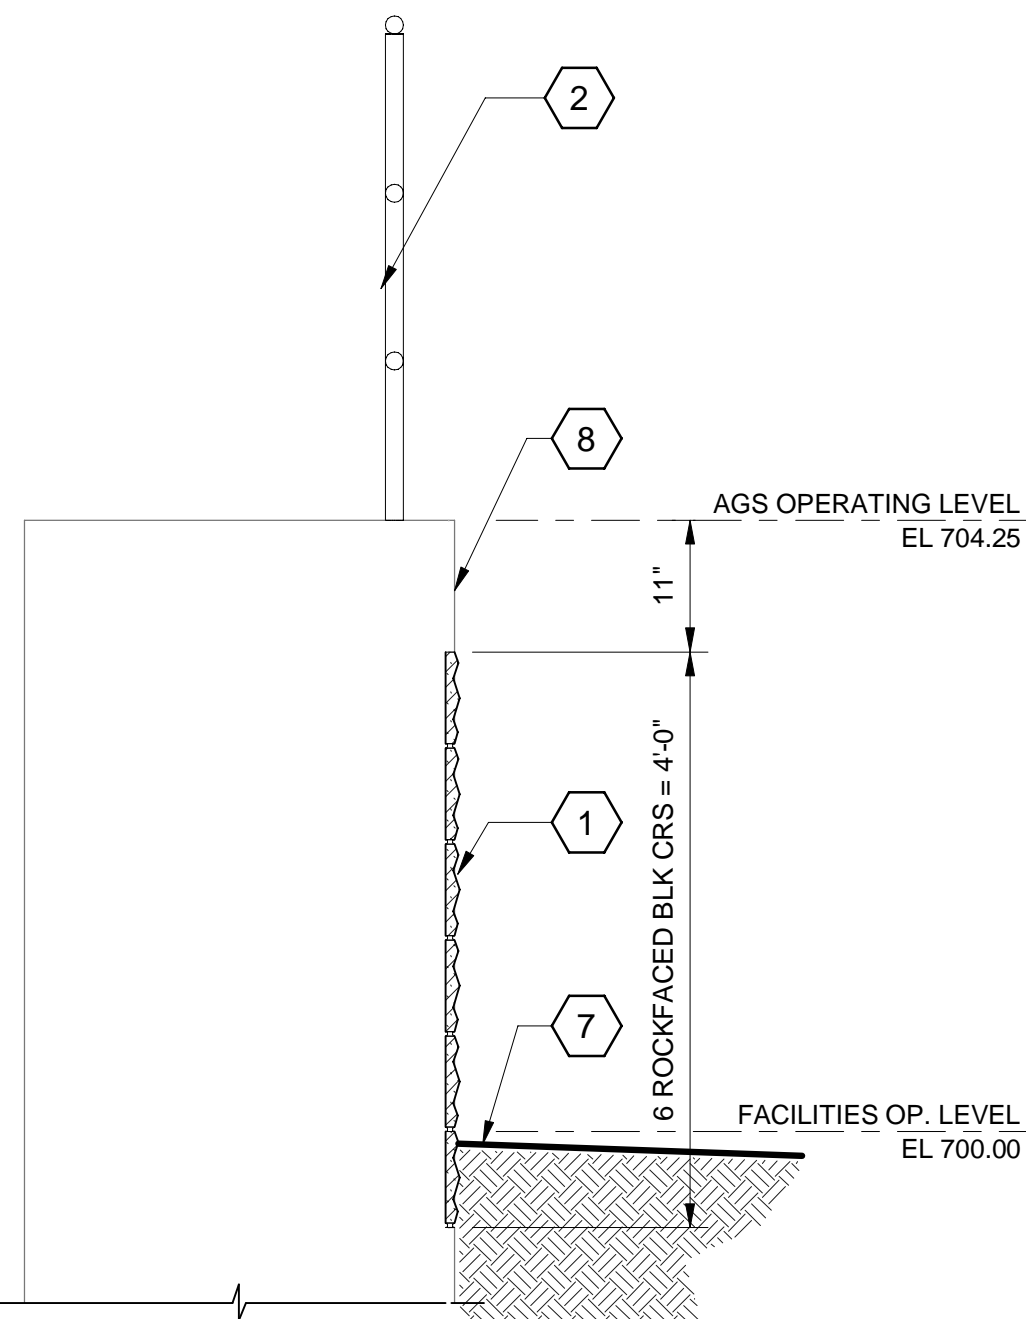

SECTION
01-A-201
3/4" = 1'-0"

GENERAL SHEET NOTES

1. SHERWIN WILLIAMS STAIN COLORS:
ROCKFACE FORM LINER SCOTT SYSTEM #1516: SW6108 LATTE
SMOOTH MASONRY UNIT LINER SCOTT SYSTEM #1500:
SW6115 TOTALLY TAN

SHEET KEYNOTES

1. CAST IN PLACE CONCRETE BASIN WALL W/ FORMLINER - SIZE, PATTERN AND COLOR TO MATCH EXISTING PRIMARY FILTRATION FACILITY.
2. GUARDRAIL - SEE STRUCTURAL DRAWINGS.
3. CONCRETE STAIRS - SEE STRUCTURAL DRAWINGS.
4. LIGHT FIXTURE (TYP) - SEE ELECTRICAL DRAWINGS.
5. HVAC EQUIPMENT - SEE HVAC DRAWINGS.
6. MECHANICAL EQUIPMENT - SEE MECHANICAL DRAWINGS.
7. FINISHED GRADE - CIVIL DRAWINGS.
8. LIGHT/MEDIUM SANDBLAST BAND.

REVISIONS AND RECORD OF ISSUE

DESIGNED:	RAB
DETAILED:	TMB
CHECKED:	PDR
APPROVED:	PDR
DATE:	12/20/2022
PROJECT NO.:	411752


**AGS REACTORS AND PIPE
GALLERY**

ARCHITECTURAL


**REACTOR PARTIAL
ELEVATIONS**

01-A-201


54
OF
163

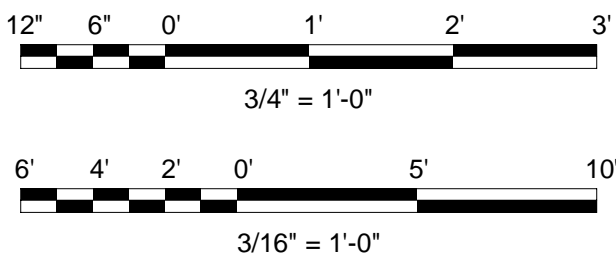


PLOTTED: 12/16/2022 11:53:37 AM
 FILE: BIM 360/409469 - Aerobic Granular Sludge Phase 1/409469 - AGS.rvt
 D11000

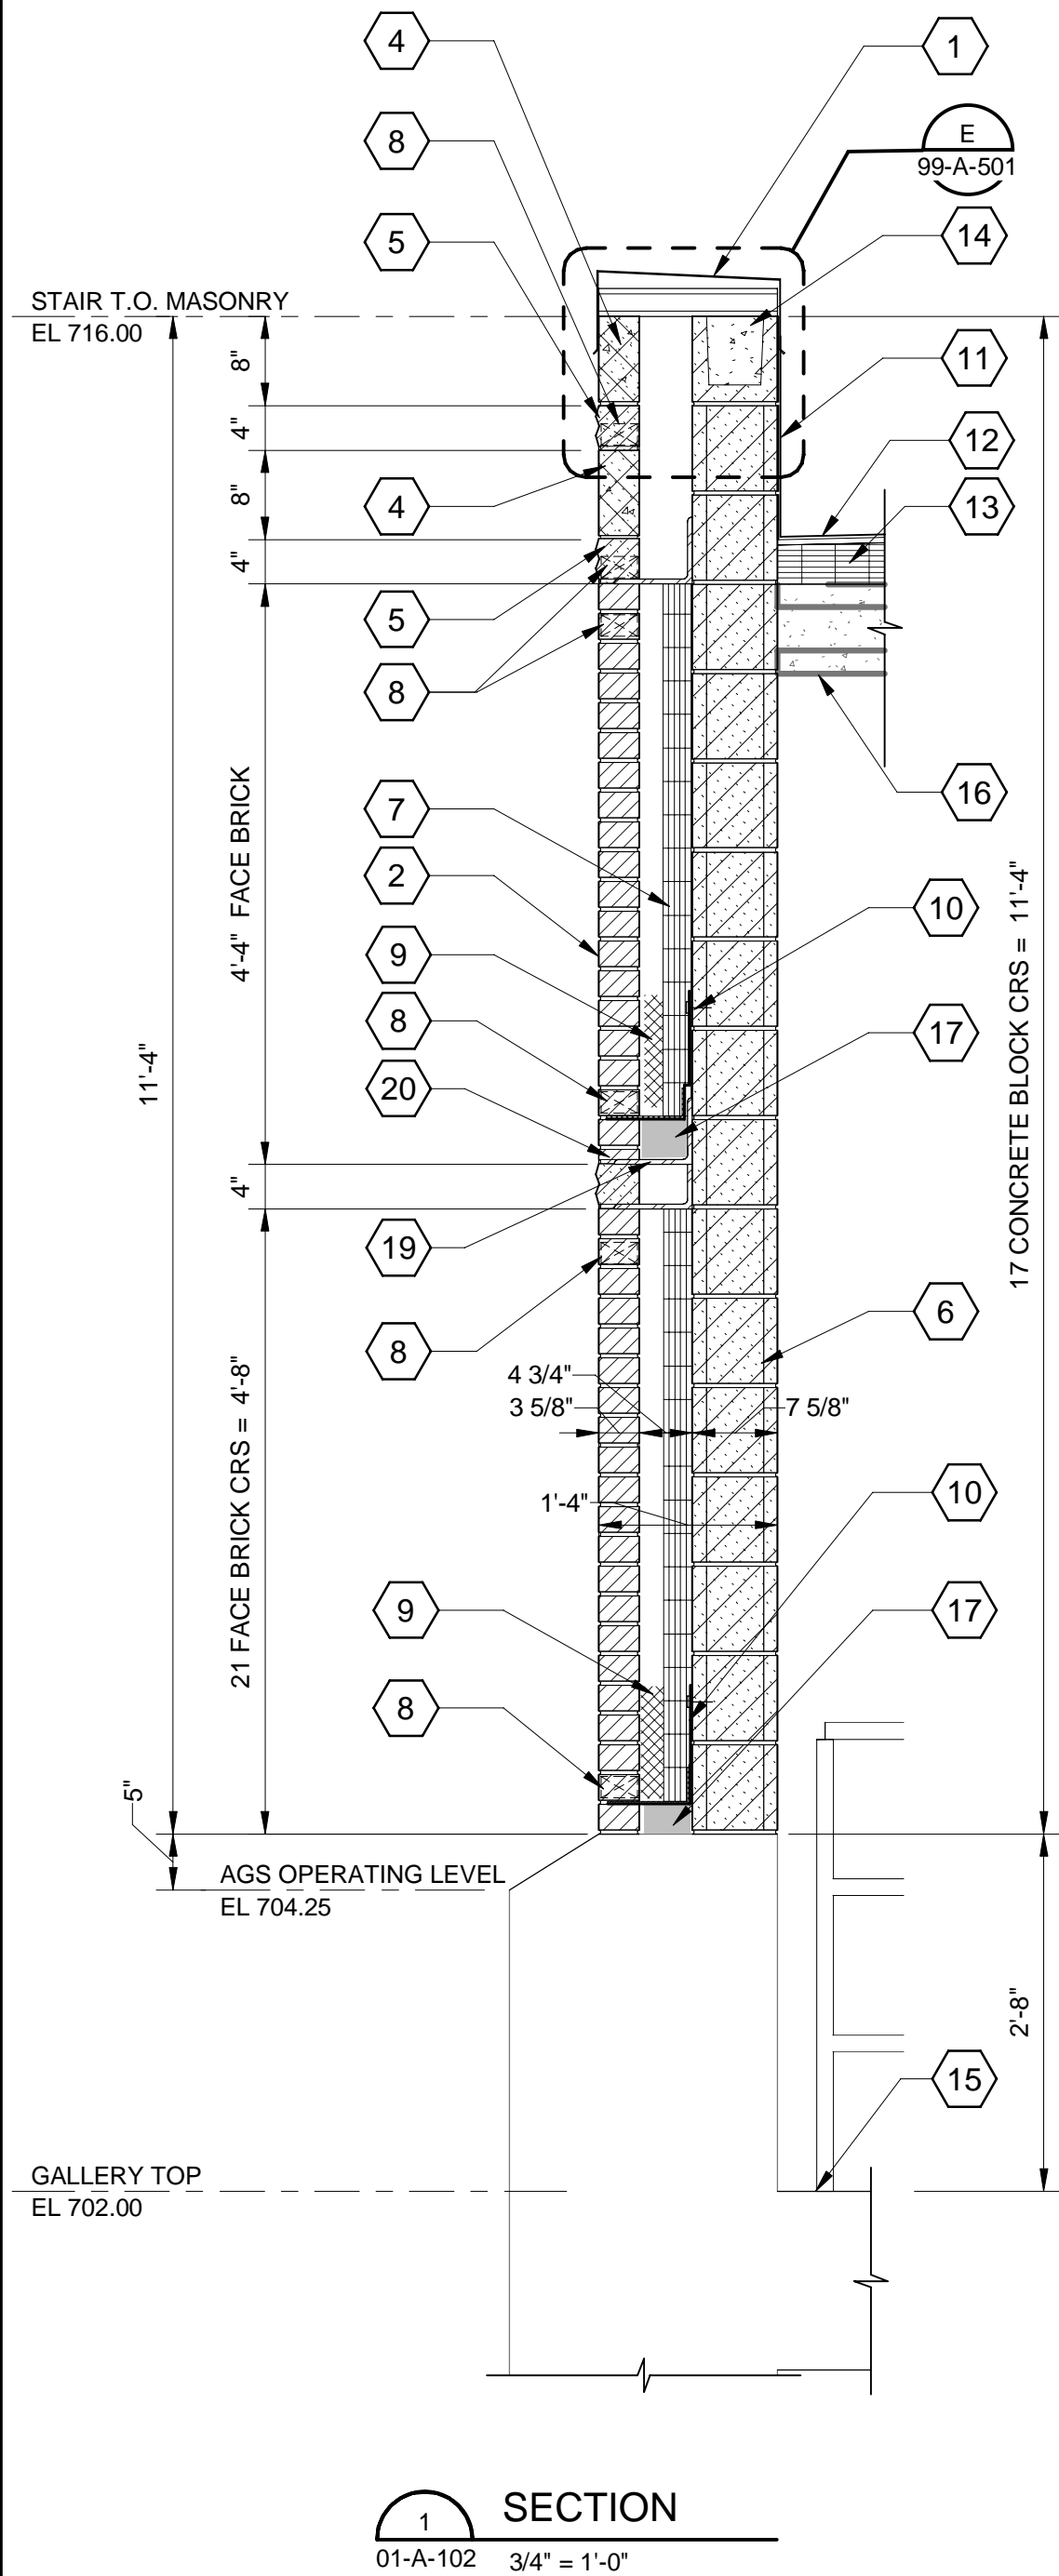

SECTION
 01-A-102 3/4" = 1'-0"

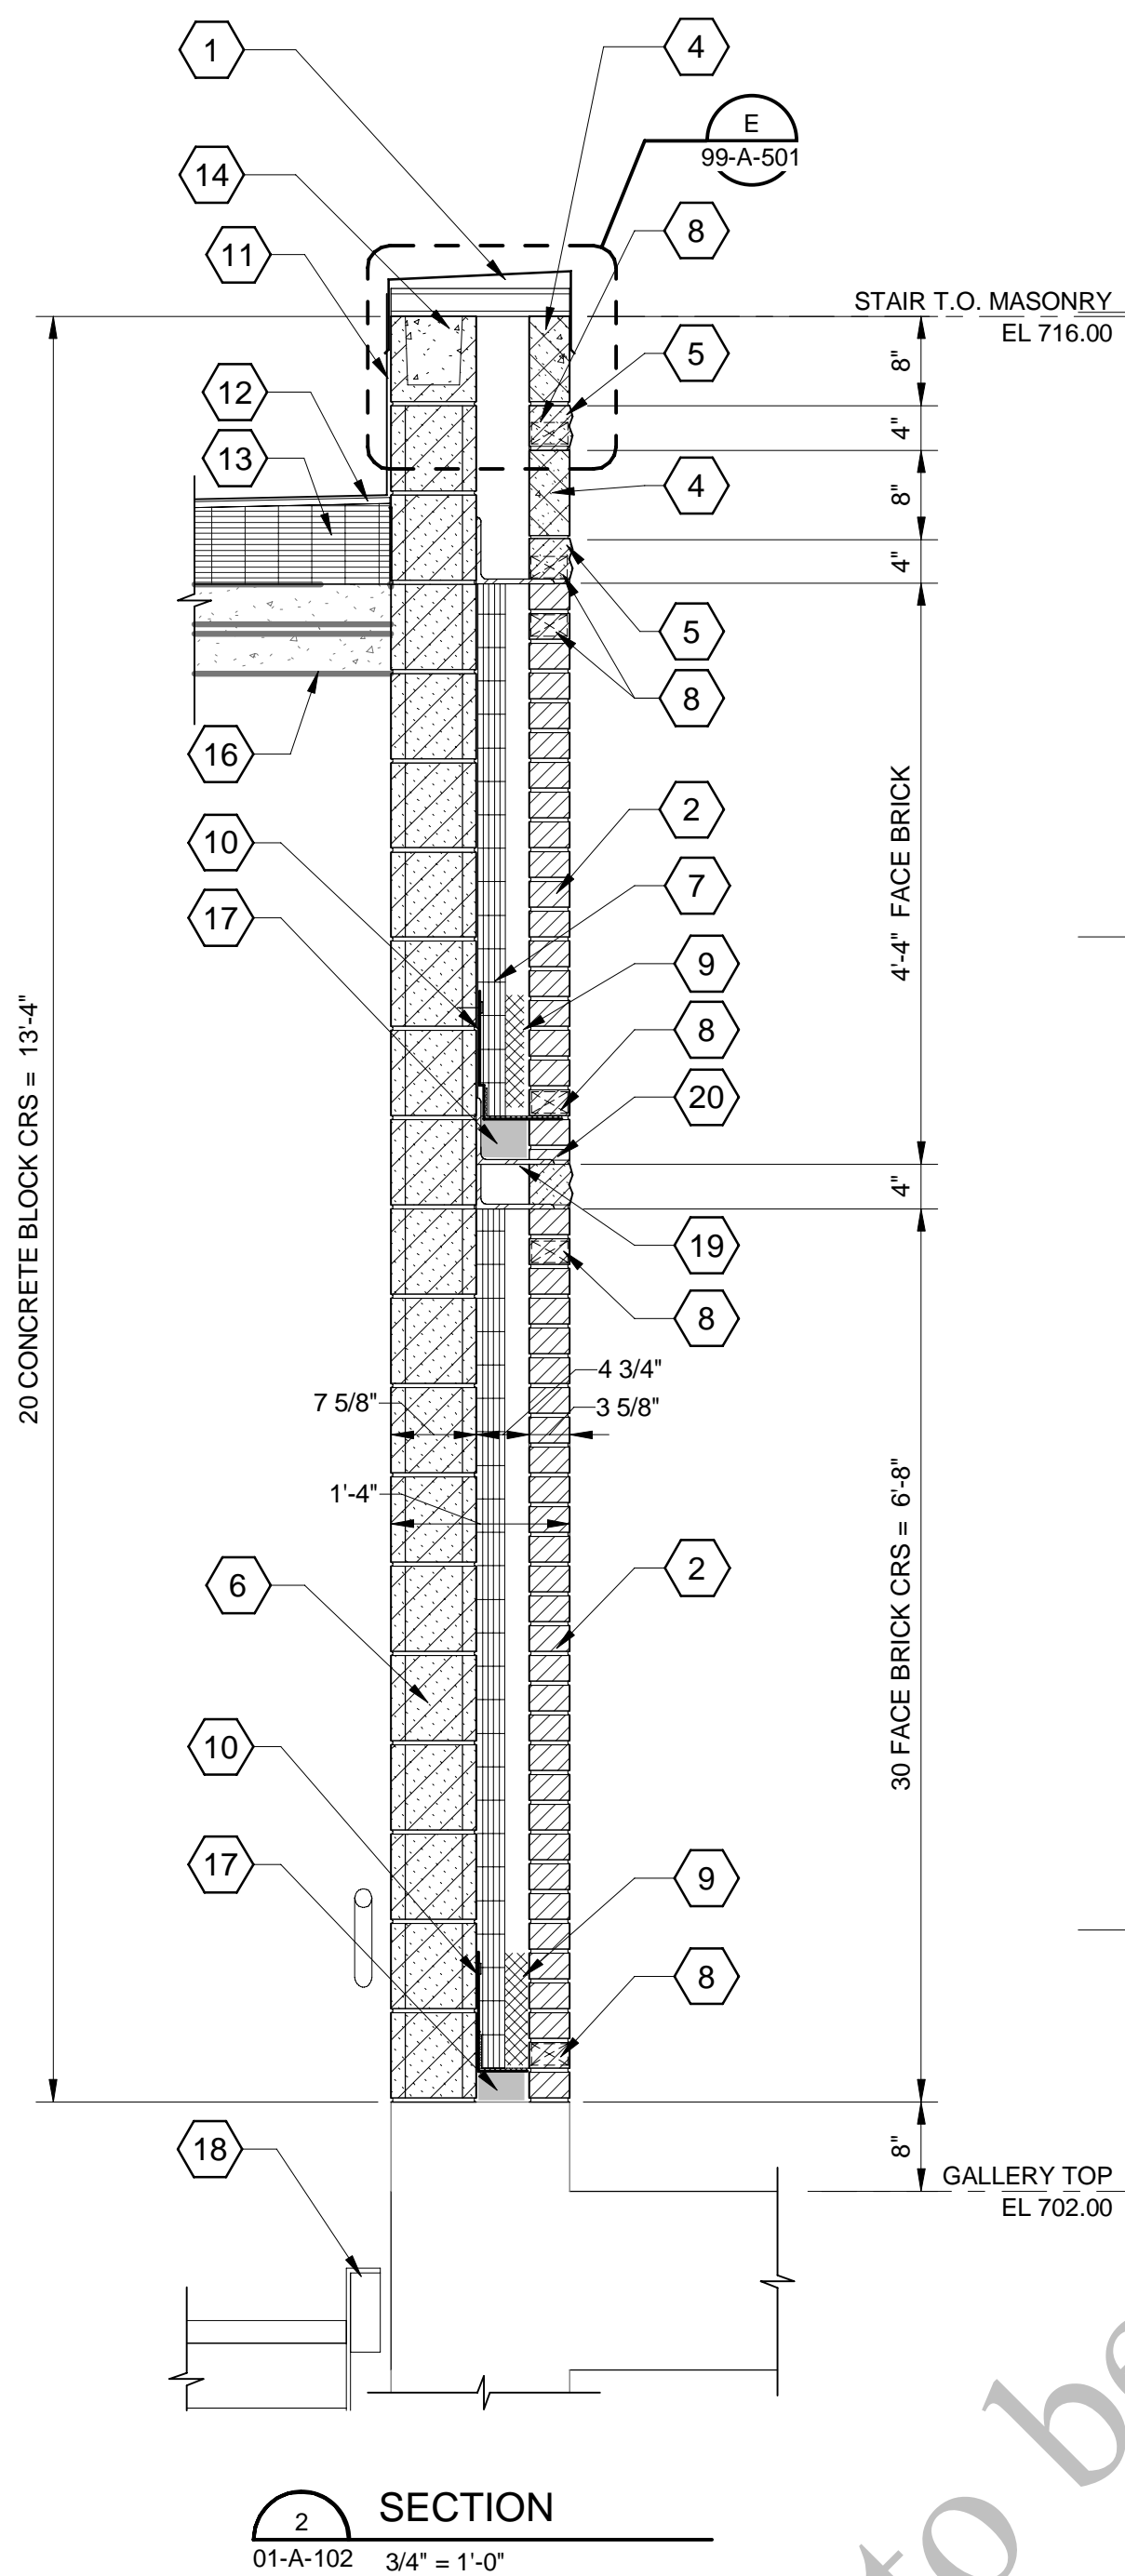

SECTION
 01-A-102 3/4" = 1'-0"

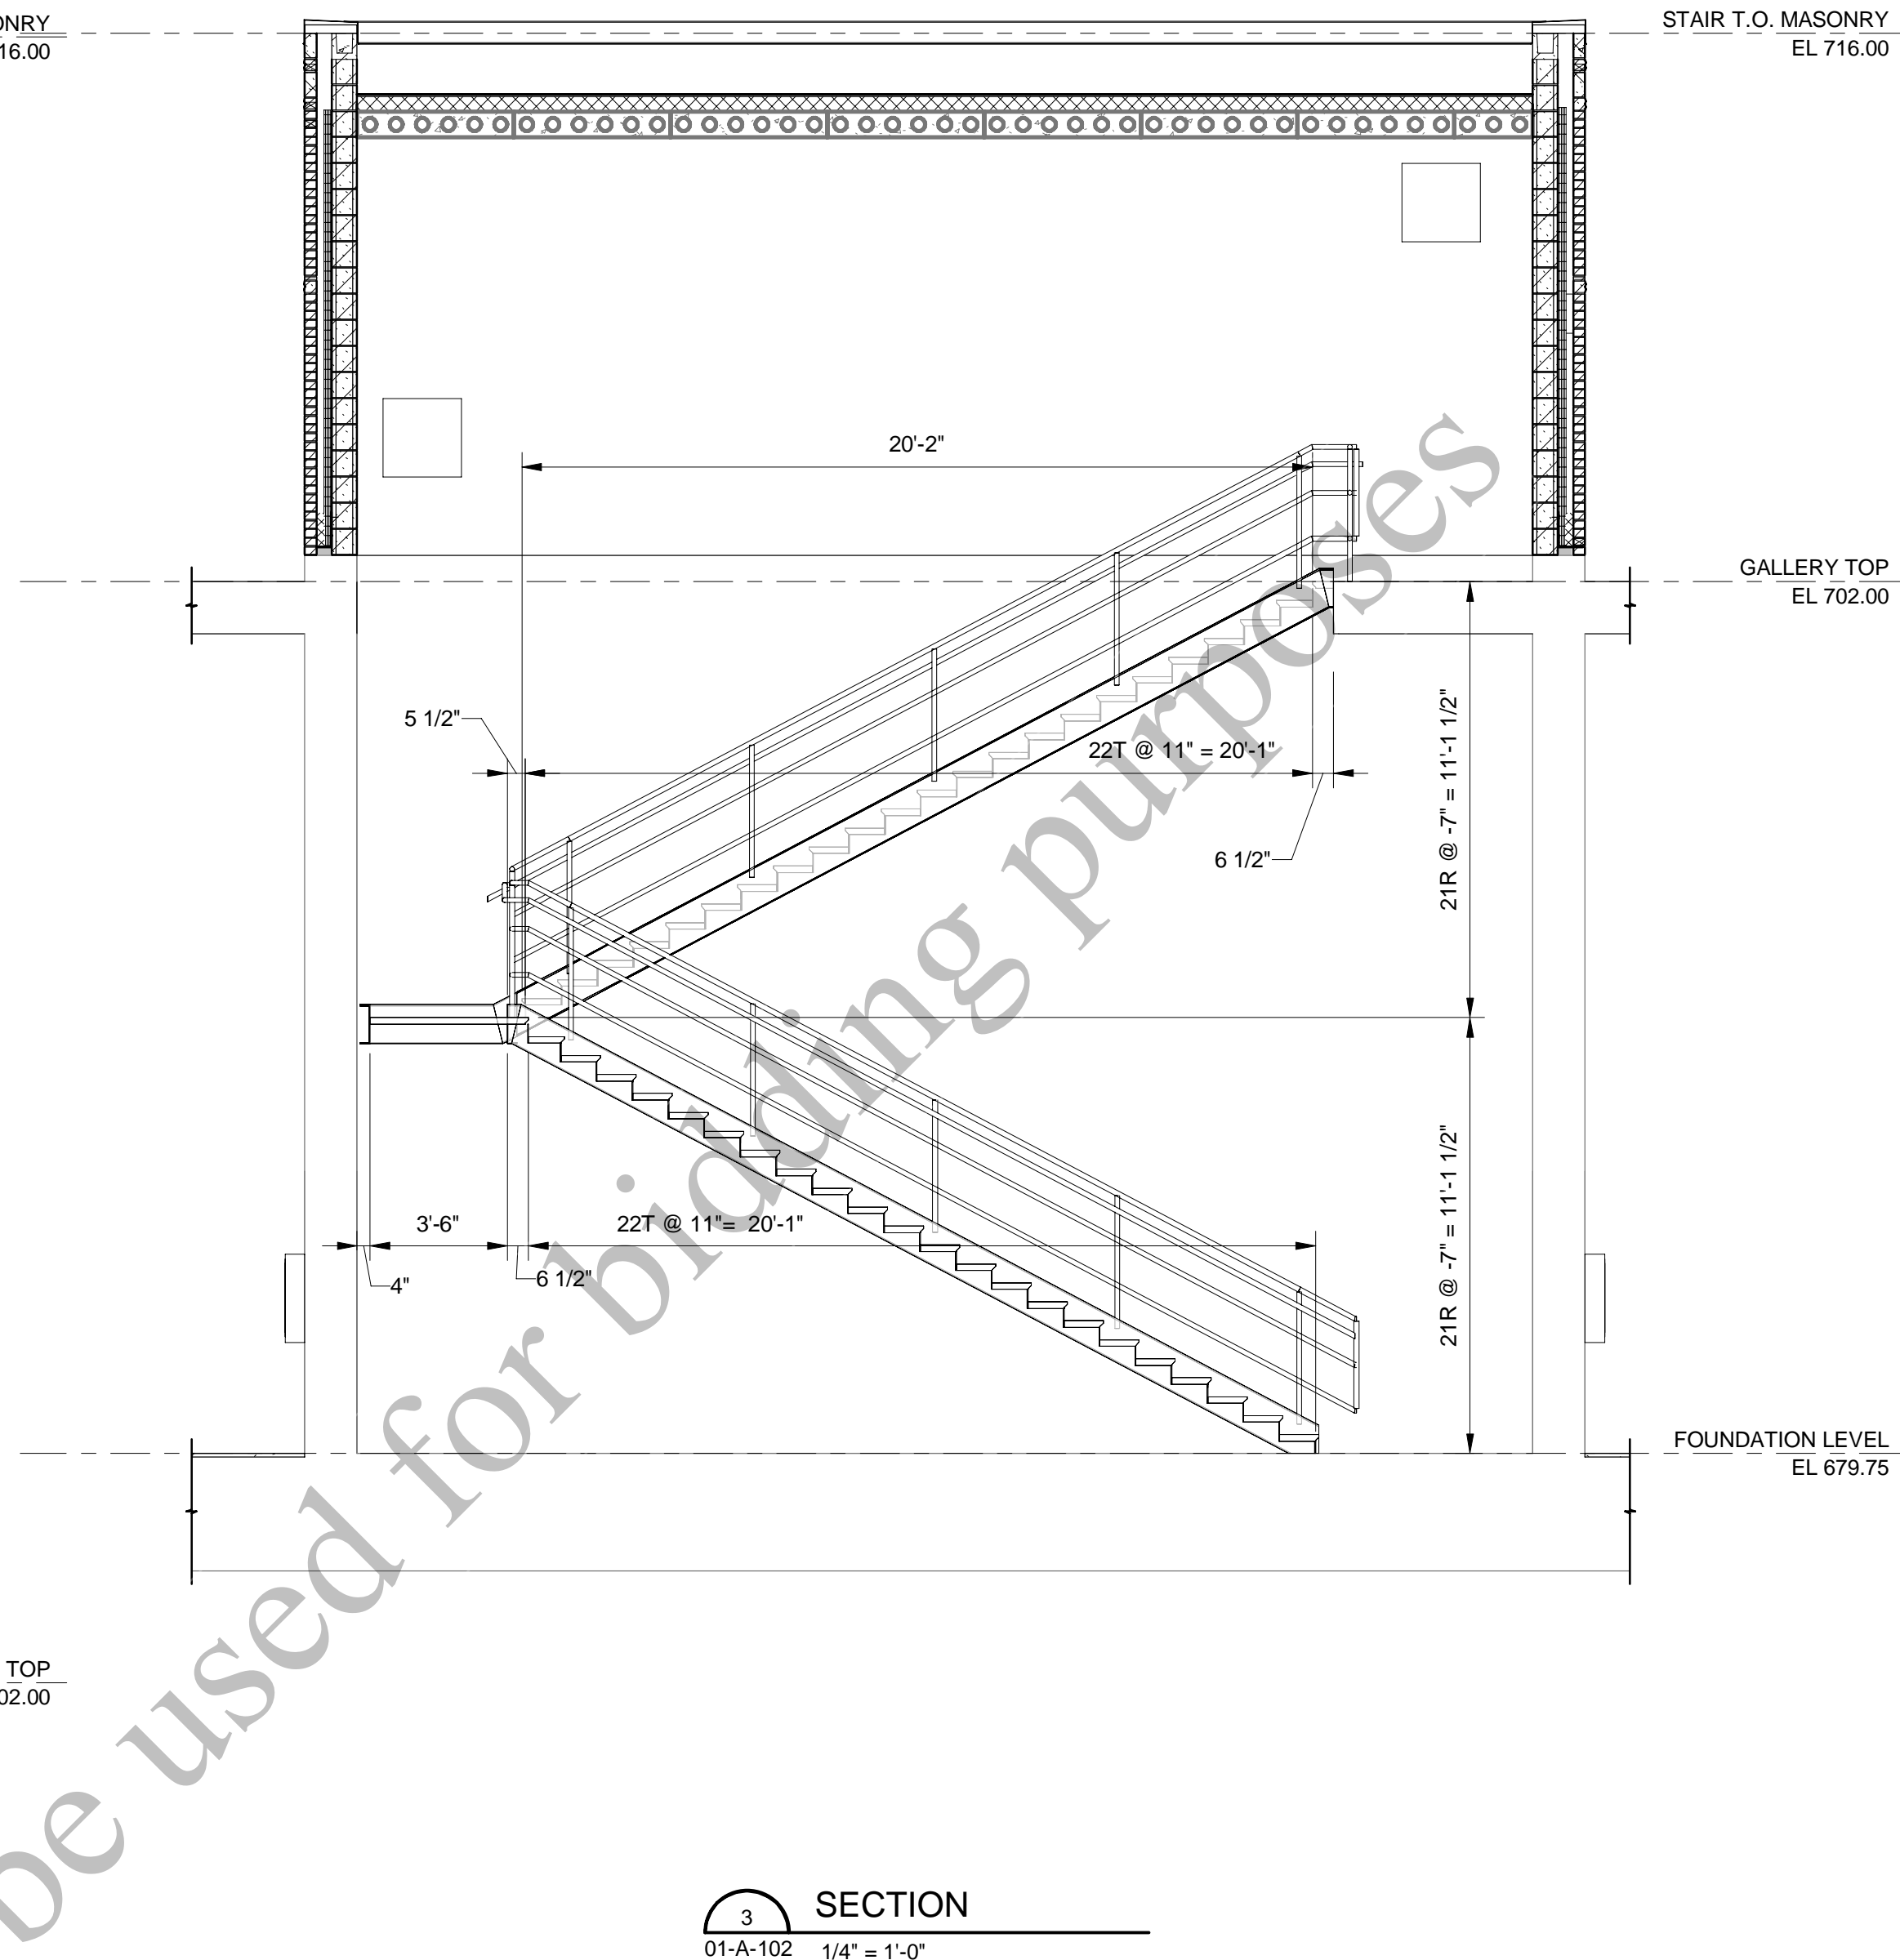

SECTION
 01-A-102 1/4" = 1'-0"

GENERAL SHEET NOTES

- FOR VERTICAL REINFORCING AND BOND BEAMS IN MASONRY DESIGN - SEE STRUCTURAL DRAWINGS.
- FOR HORIZONTAL JOINT REINFORCING - SEE SPECIFICATION SECTION 042000.

SHEET KEYNOTES

- PREFINISHED METAL COPING - SIZE, PATTERN AND COLOR TO MATCH EXISTING PRIMARY FILTRATION FACILITY.
- FACE BRICK - SIZE, PATTERN AND COLOR TO MATCH EXISTING PRIMARY FILTRATION FACILITY.
- 8 x 16 ROCKFACE MASONRY UNITS - SIZE, PATTERN AND COLOR TO MATCH EXISTING PRIMARY FILTRATION FACILITY.
- 8 x 24 SMOOTHFACE MASONRY UNITS - SIZE, PATTERN AND COLOR TO MATCH EXISTING PRIMARY FILTRATION FACILITY.
- 4 x 24 ROCKFACE MASONRY UNITS - SIZE, PATTERN AND COLOR TO MATCH EXISTING PRIMARY FILTRATION FACILITY.
- 8" CONCRETE MASONRY UNIT.
- 2 1/2" RIGID INSULATION R-12.
- WEEP VENTS @ 24" O.C.
- 10" HIGH x 2" THICK MORTAR NET.
- TOTALFLASH CAVITY-WALL DRAINAGE SYSTEM.
- SINGLE-PLY ROOFING MEMBRANE EXTEND OVER PARAPET WALL.
- 1/2" COVER BOARD.
- TAPERED INSULATION R-30.
- BOND BEAM - SEE STRUCTURAL DRAWINGS.
- FINISHED FLOOR AS SCHEDULED.
- HOLLOW CORE SLAB - SEE STRUCTURAL DRAWINGS.
- MORTAR FILL UNDER THE TOTALFLASH CAVITY-WALL DRAINAGE SYSTEM.
- METAL STAIRS - SEE STRUCTURAL DRAWINGS.
- BRICK SHELF ANGLE - SEE DETAIL D/99-A-501.
- CUT FACE BRICK AS REQUIRED.

B&V Design, LLC
 Kansas City, Missouri
 ILLINOIS PROFESSIONAL
 DESIGN FIRM - 184007283



AEROBIC GRANULAR
 SLUDGE - PHASE 1

REVISIONS AND RECORD OF ISSUE	
DESIGNED:	RAB
DETAILED:	TMB
CHECKED:	PDR
APPROVED:	PDR
DATE:	12/20/2022
PROJECT NO.:	411752


AGS REACTORS AND PIPE
 GALLERY

ARCHITECTURAL

WALL SECTIONS

01-A-301

55
 OF
 163

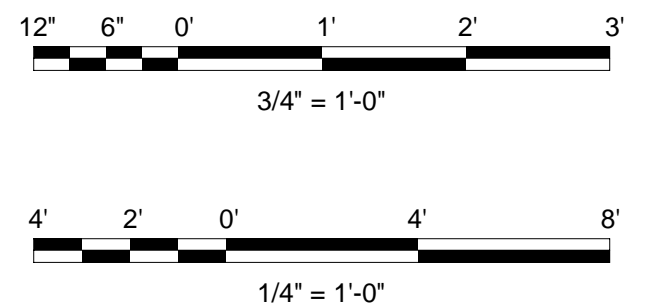

(SCALE BAR IS 4" AT FULL SCALE) 0 1/2 1 2 3 4



1. FOR GENERAL STRUCTURAL NOTES, REFER TO SHEET 00-S-001.
2. FOR STRUCTURAL ABBREVIATIONS, REFER TO SHEET 00-S-002.
3. FOR OTHER NOTES, REFER TO SHEET 01-S-103.
4. FOR PIPE SUPPORT TYPE AND LOCATIONS SEE PIPING DWGS AND SCHEDULE ON SHEET 99-M-502.
5. COORDINATE PUMP BASE DIMENSIONS WITH PUMP SUPPLIER.
6. HP, LP AND SLOPES SHOWN IS APPROXIMATE. SEE PLUMBING DWG FOR REQUIRED ELEVATIONS AND SLOPE.
7. AT WALKING SURFACES, EXPANSION JOINT SHALL BE COVERED WITH STAINLESS STEEL PLATE. EXPANSION JOINT COVER PLATE SHALL BE MINIMUM 1/4" THICK AS MANUFACTURED BY SLIPNOT OR APPROVED EQUAL.



REVISIONS AND RECORD OF ISSUE	
DESIGNED:	SKA
DETAILED:	UBS
CHECKED:	CG
APPROVED:	TNG
DATE:	12/20/2022
PROJECT NO.:	411752

AGS REACTORS AND GALLERY FOUNDATION PLAN

56
OF
163





GENERAL SHEET NOTES:

1. FOR GENERAL NOTES, REFER TO SHEET 00-S-101.
2. FOR STRUCTURAL ABBREVIATIONS, REFER TO SHEET 00-S-002.
3. FOR OTHER NOTES, REFER TO SHEET 01-S-103.
4. FOR PIPE SUPPORT TYPE AND LOCATIONS SEE PIPING DRAWINGS AND SCHEDULE ON SHEET 99-M-502.

SHEET KEYNOTES

- 1 WALL BASIN DRAIN VALVE PER DETAIL D ON SHEET 01-S-501, AT FUTURE EXPANSION SIDE.
- 2 WALL BASIN DRAIN VALVE PER DETAIL C ON SHEET 01-S-501, AT COMMON WALLS SHOWN.
- 3 WALL BASIN DRAIN VALVE PER DETAIL H ON SHEET 01-S-501, AT RADAR LEVEL TRANSMITTER MONITORING LOCATIONS.
- 4 WALL BASIN DRAIN VALVE PER DETAIL A ON SHEET 01-S-501.
- 5 WALL BASIN DRAIN VALVE PER DETAIL E ON SHEET 01-S-501, AT FUTURE EXPANSION SIDE RADAR LEVEL TRANSMITTER MONITORING LOCATIONS.



Black & Veatch Corporation
Chicago, Illinois
ILLINOIS PROFESSIONAL
DESIGN FIRM - 184.002143-0006



AEROBIC GRANULAR
SLUDGE - PHASE 1

REVISIONS AND RECORD OF ISSUE

DESIGNED:	SKA
DETAILED:	UBS
CHECKED:	CG
APPROVED:	TNG
DATE:	12/20/2022
PROJECT NO.:	411752


AGS REACTORS AND PIPE
GALLERY

STRUCTURAL

AGS REACTORS AND
GALLERY MID LEVEL
PLAN


01-S-102

57
OF
163

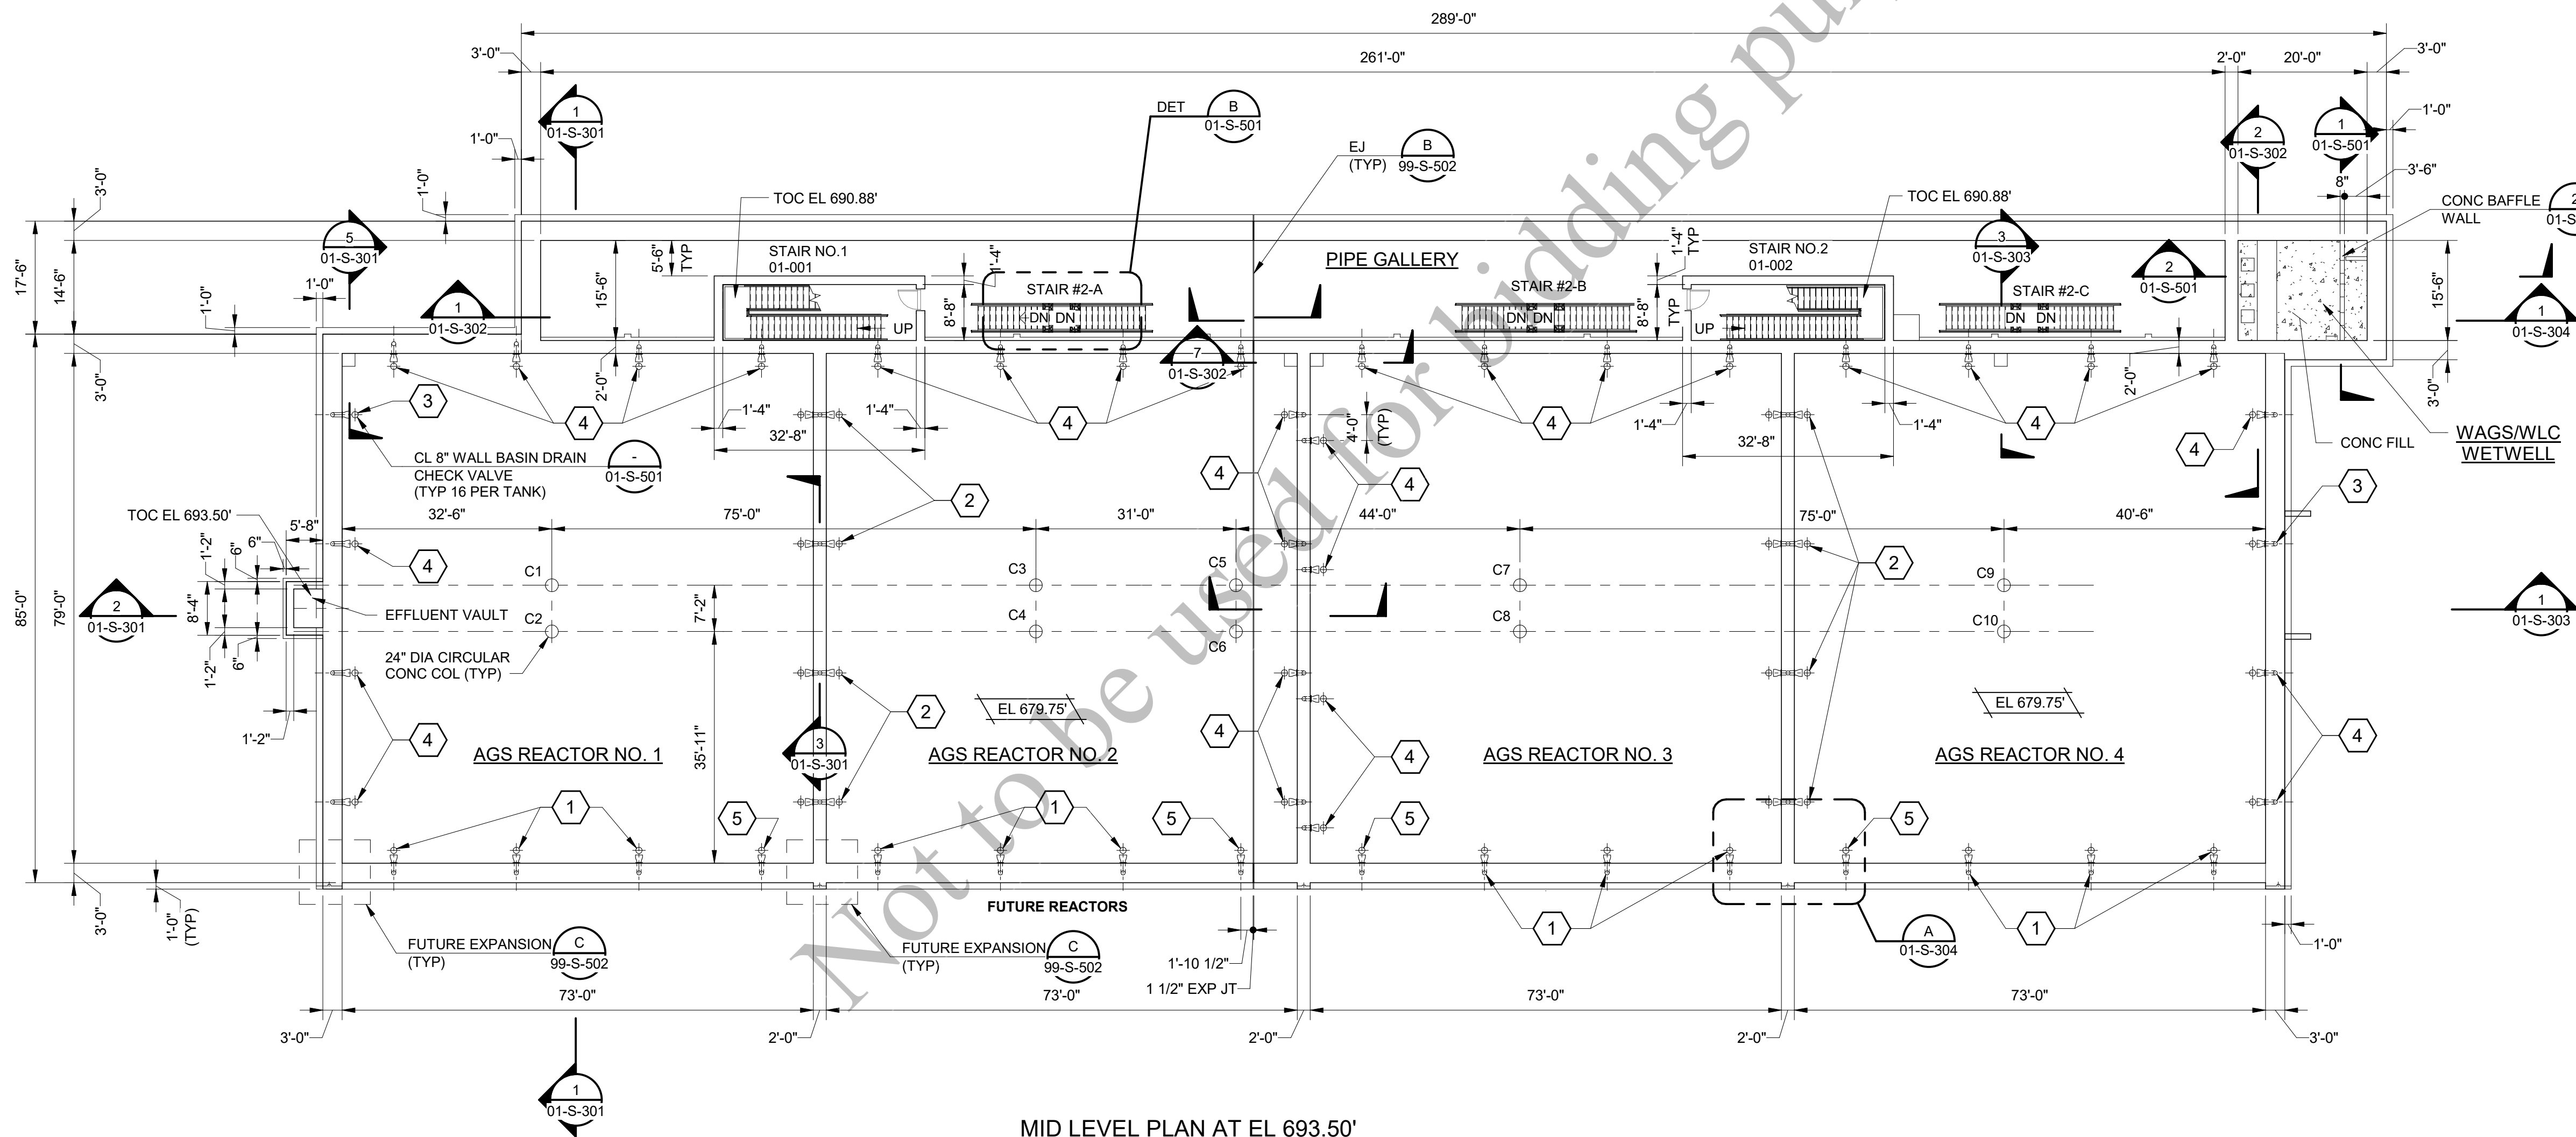

MID LEVEL PLAN AT EL 693.50'

1/16" = 1'-0"

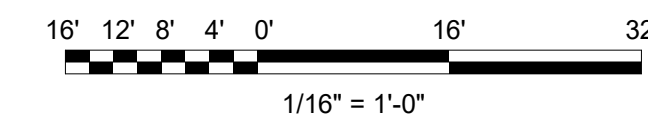

(SCALE BAR IS 4" AT FULL SCALE) 0 1/2 1 2 3 4



GENERAL SHEET NOTES:

- FOR GENERAL NOTES, REFER TO SHEET 01-S-101
- FOR PIPE SUPPORT TYPE AND LOCATIONS SEE PIPING DRAWINGS AND SCHEDULE ON SHEET 99-M-502.
- FOR STRUCTURAL ABBREVIATIONS, REFER TO SHEET 00-S-002.
- FOR PIPES / PIPE OPENINGS, SLAB OPENINGS, PIPE SUPPORTS EQUIPMENT LOCATION AND DETAILS REFER TO RELEVANT MECHANICAL DRAWINGS.
- FOR DUCT AND DUCT OPENING DETAILS REFER TO HVAC DRAWINGS.
- FOR ROOF SLOPE AND DETAILS, REFER TO ARCHITECTURAL DRAWINGS.
- AGS SUPPORT FACILITY REFER TO SHEETS 02-S-101 AND 02-S-102.
- FORMLINERS ARE REQUIRED AT THE EXTERIOR WALL SURFACE FROM 1 FT BELOW GRADE TO 11" BELOW TOP OF WALLS AT NORTH, EAST AND WEST SIDES OF AGS TANK. FORMLINERS ARE NOT REQUIRED AT FUTURE EXPANSION SIDE (SOUTH SIDE).
- FOR LIFTING EYE BOLT LOCATIONS AT PIPE GALLERY ROOF SLAB, SEE MECHANICAL PIPING SHEETS 01-M-401 THRU 01-M-404.
- AT WALKING SURFACES, EXPANSION JOINT SHALL BE COVERED WITH STAINLESS STEEL PLATE. EXPANSION JOINT COVER PLATE SHALL BE MINIMUM 1/4" THICK AS MANUFACTURED BY SLIPNOT OR APPROVED EQUAL.



Black & Veatch Corporation
Chicago, Illinois
ILLINOIS PROFESSIONAL
DESIGN FIRM - 184.002143-0006



AEROBIC GRANULAR
SLUDGE - PHASE 1

REVISIONS AND RECORD OF ISSUE

DESIGNED:	SKA
DETAILED:	UBS
CHECKED:	CG
APPROVED:	TNG
DATE:	12/20/2022
PROJECT NO.:	411752

AGS REACTORS AND PIPE
GALLERY

STRUCTURAL

AGS REACTORS AND
GALLERY TOP
PLAN

01-S-103

58
OF
163

TOP PLAN AT EL 704.25'

1/16" = 1'-0"

LOADING CRITERIA FOR PRECAST WALKWAY DESIGN



- DEAD LOAD AS CALCULATED BY PRECAST MANUFACTURER.
- LIVE LOAD : 100 PSF
- SNOW LOAD : 34 PSF
- VIBRATIONS CONSIDERATIONS FOR WALKWAY SHALL BE PROVIDED, MINIMUM $f_n = 4.4$ HERTZ. CALCULATIONS PROVIDED SHALL INCLUDE DETERMINATION OF MINIMUM FUNDAMENTAL NATURAL FREQUENCY.

WALKWAY LOADING


	DEAD LOAD (KIPS)	ICE LOAD (KIPS)	WIND LOADS				
			X (KIPS)	Z (KIPS)	Mx (KIP-FT)	My (KIP-FT)	Mz (KIP-FT)
AIR PIPE SUPPORT	0.5	0.3	0.6	0.2	0.8	0.1	3
LAMP POST	0.6	0.6	1.0	1.0	6.0	0.1	6

NOTES:-

- WIND AND ICE LOAD REACTIONS INDICATED ABOVE ARE AT CODE LEVEL ULTIMATE REACTIONS.
- POSITIVE REACTIONS INDICATE DOWNWARD LOAD ON SLAB.
- SEE SPECIFICATION 03 41 00 FOR OTHER DESIGN REQUIREMENTS.
- SEE MECHANICAL AND ELECTRICAL SHEETS FOR AIR PIPE SUPPORT AND LAMP POST LOCATIONS.

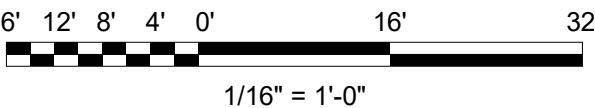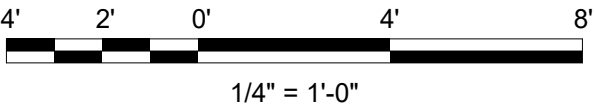


(SCALE BAR IS 4" AT FULL SCALE)

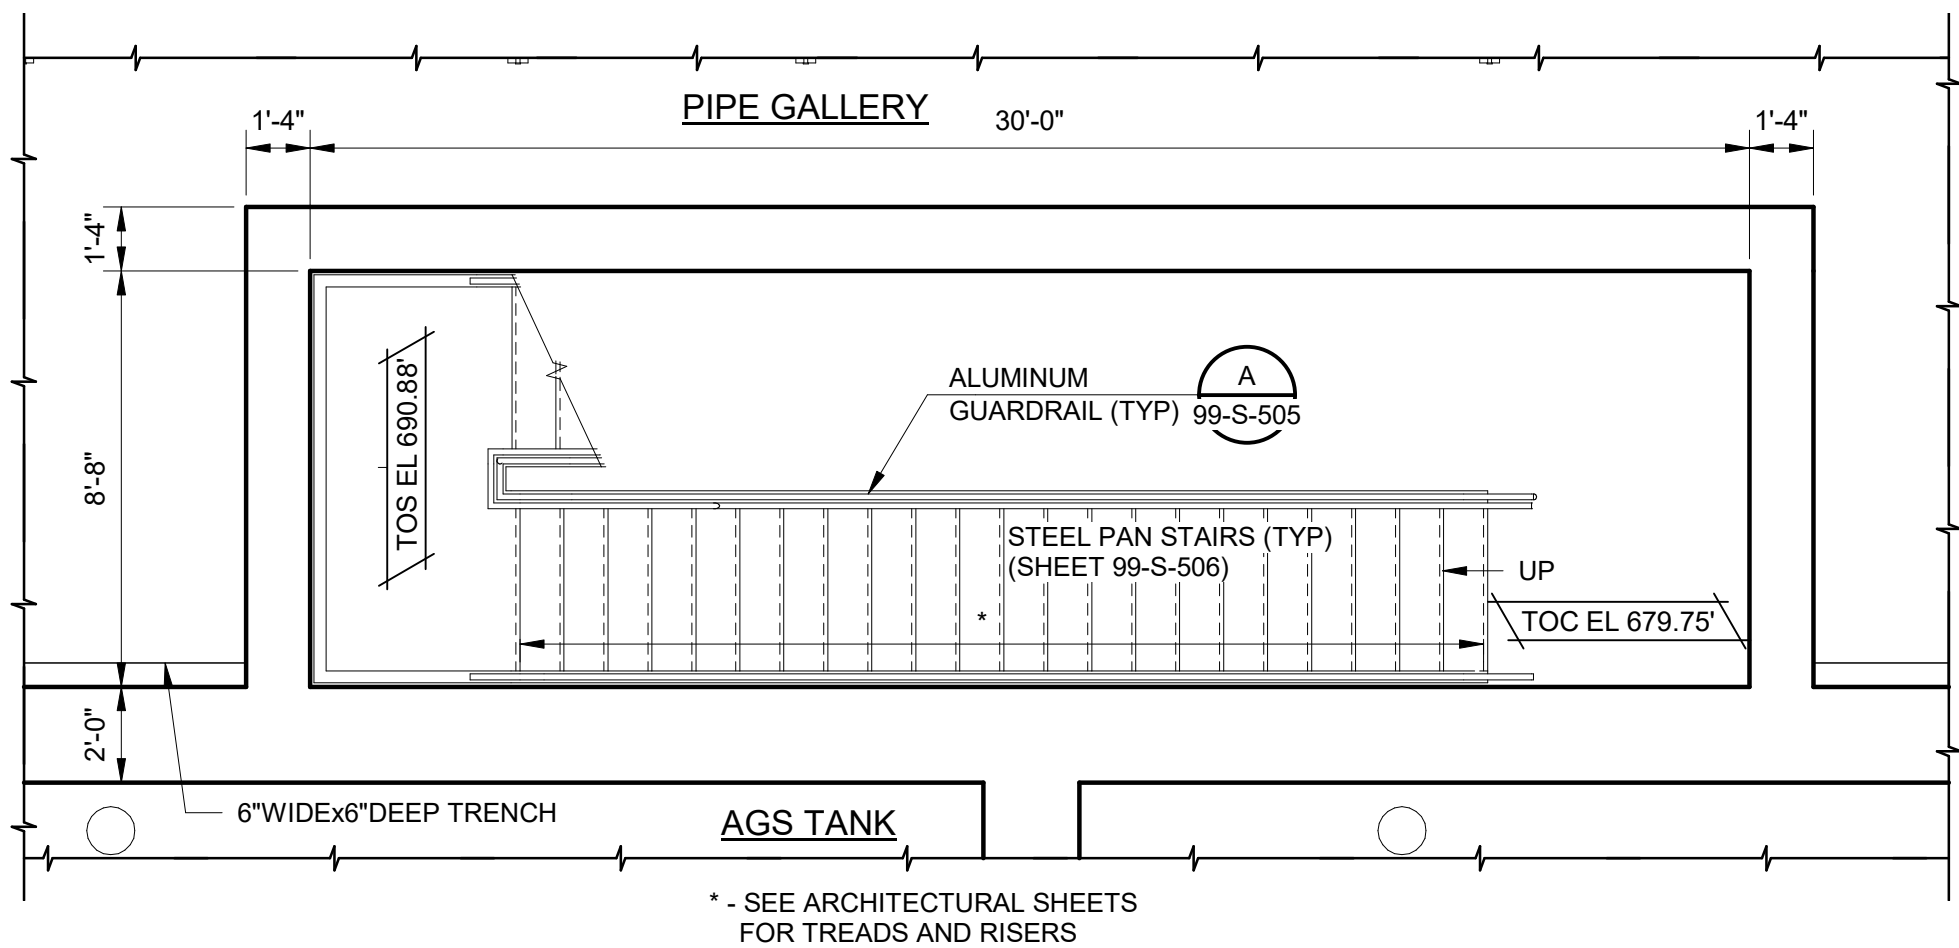


PIPE GALLERY STAIR TOWER LOWER LEVEL PLAN

1/4" = 1'-0" (STAIR NO.1 (01-001) SHOWN. STAIR NO.2 (01-002) IS SIMILAR, MIRROR IMAGE OF STAIR NO.1)

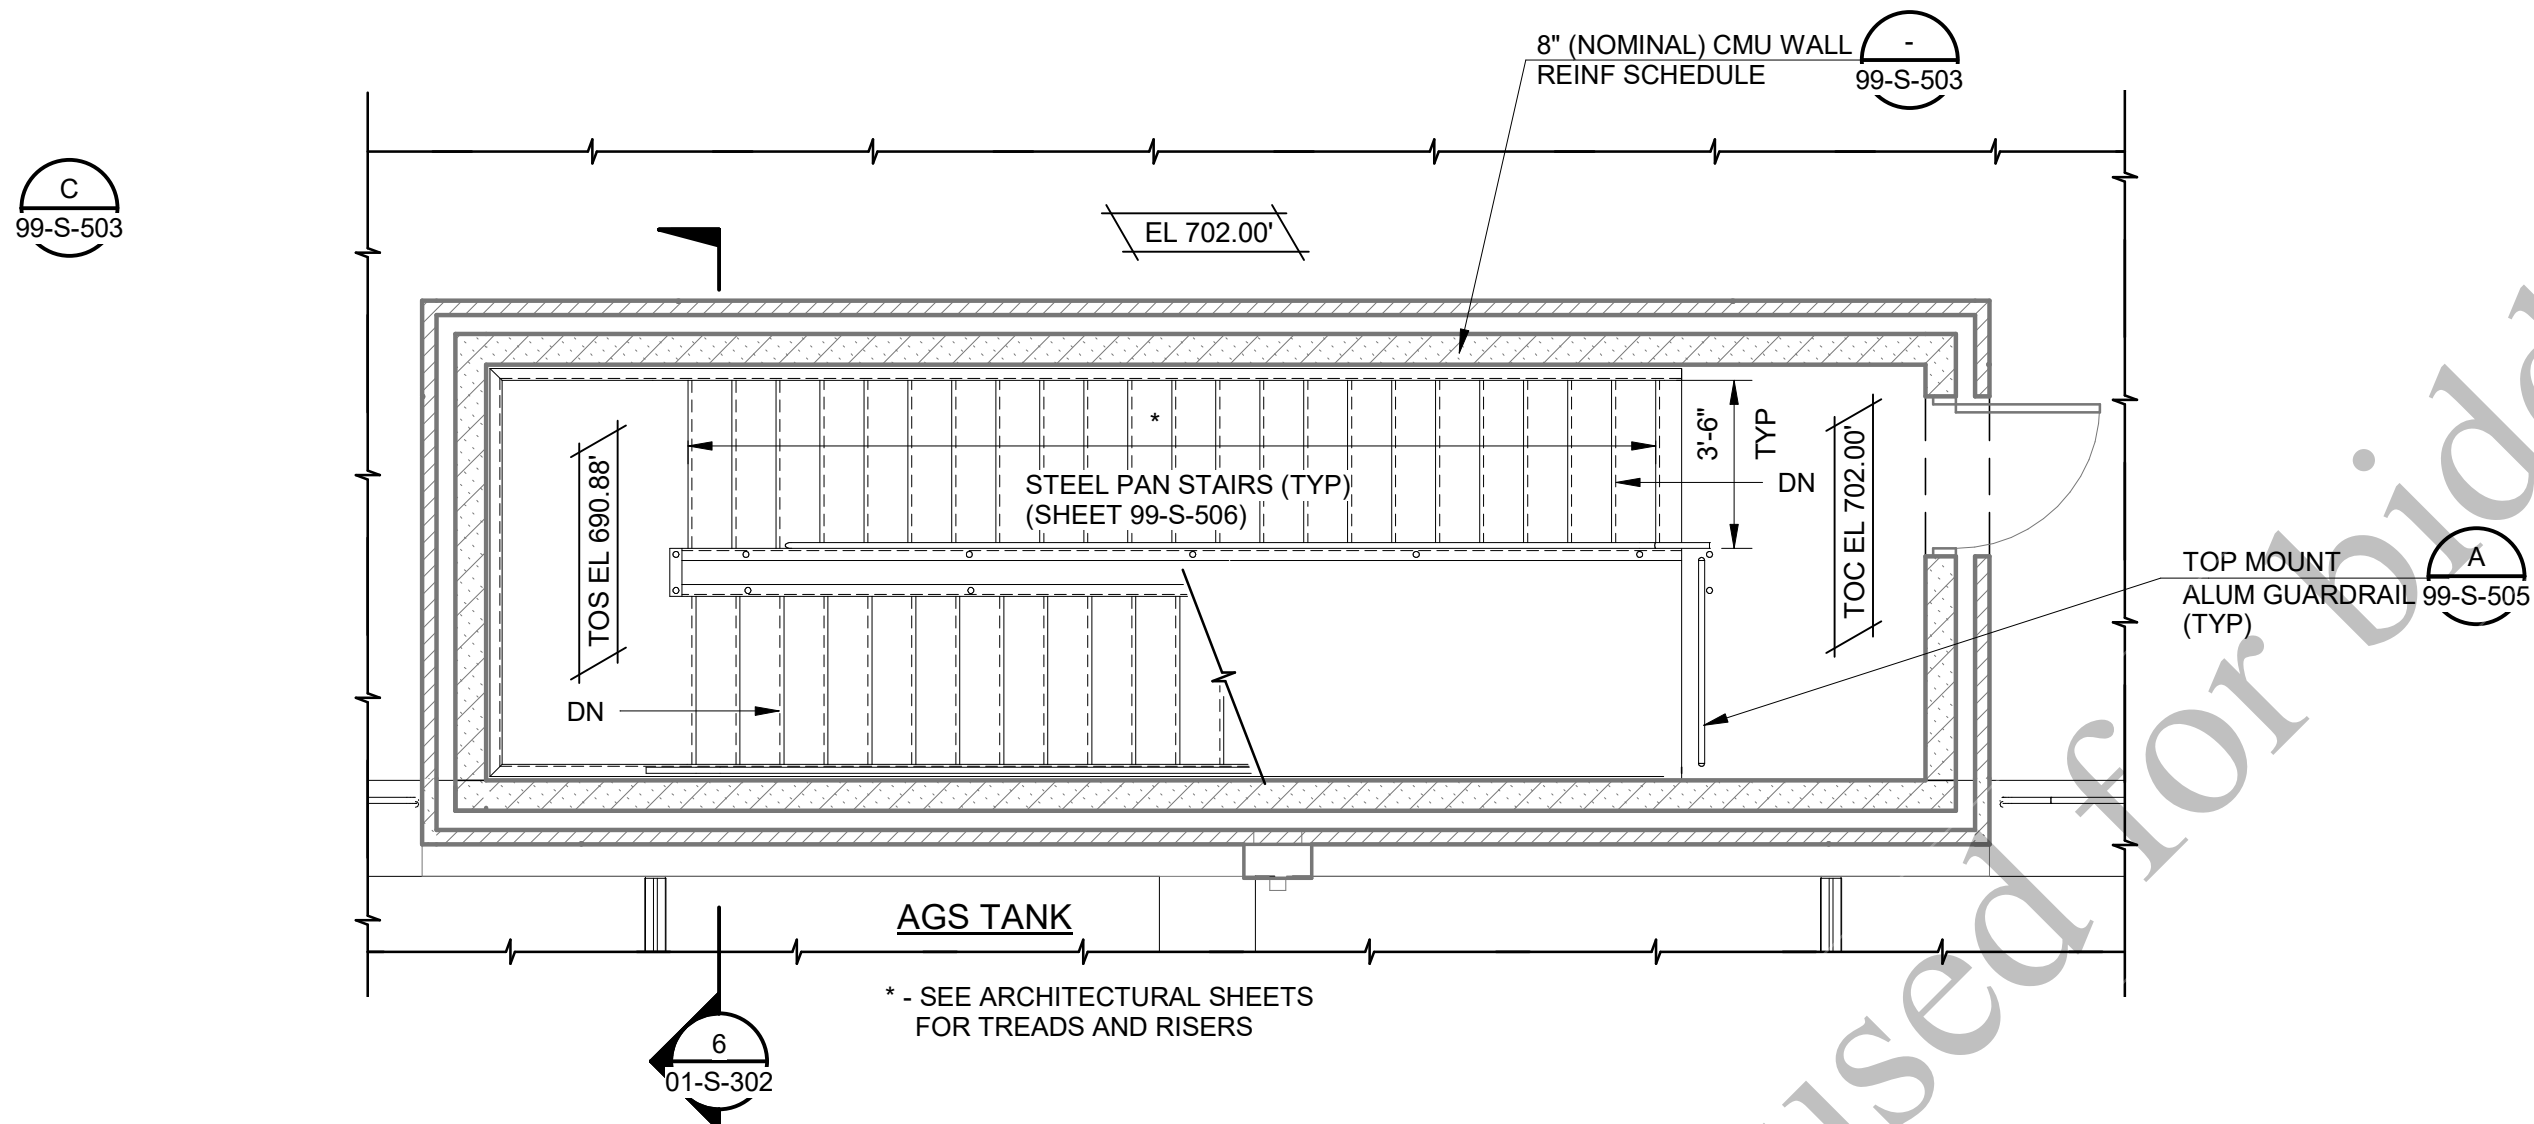









PIPE GALLERY STAIR TOWER PLAN AT EL 702.00

1/4" = 1'-0" (STAIR NO.1 (01-001) SHOWN. STAIR NO.2 (01-002) IS SIMILAR, MIRROR IMAGE OF STAIR NO.1)

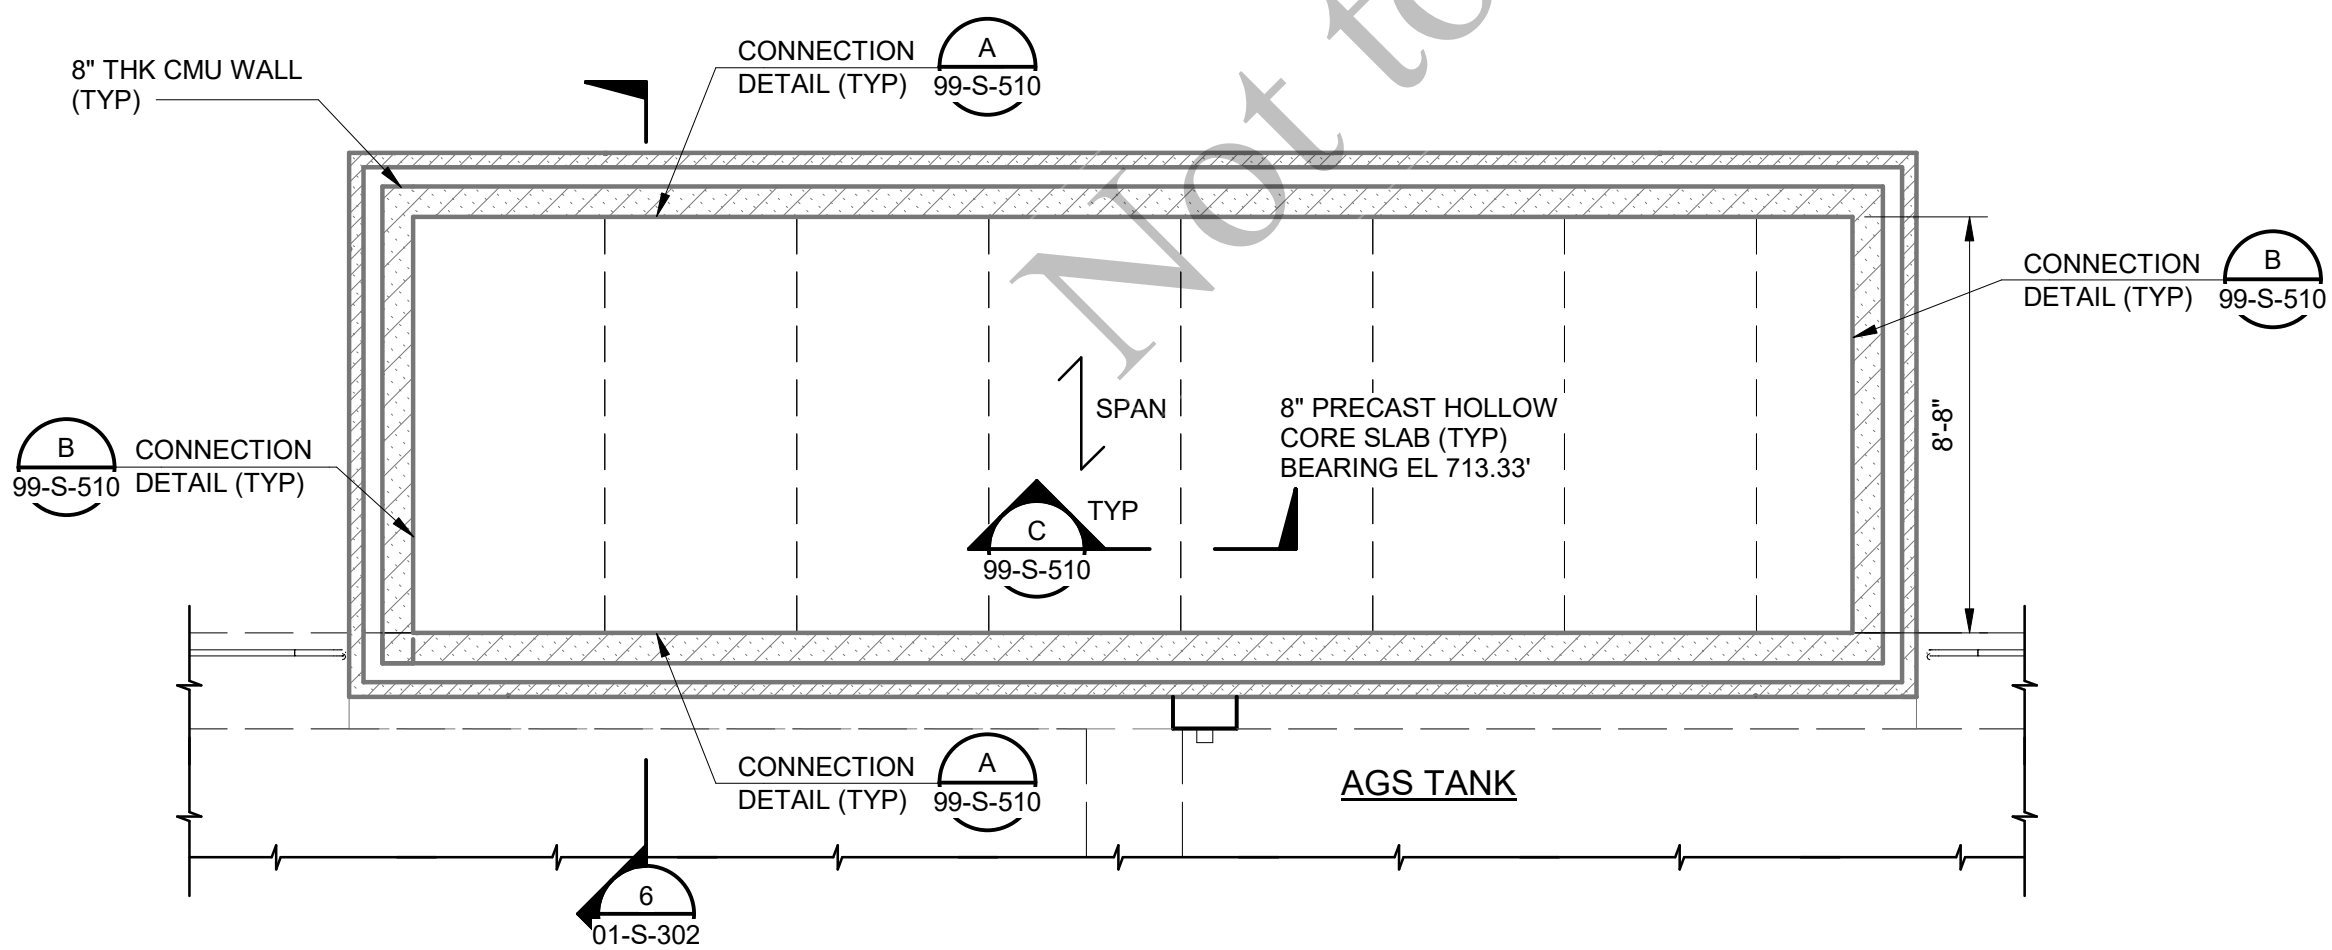


PIPE GALLERY STAIR TOWER ROOF PLAN

1/4" = 1'-0" (STAIR NO.1 (01-001) SHOWN. STAIR NO.2 (01-002) IS SIMILAR, MIRROR IMAGE OF STAIR NO.1)

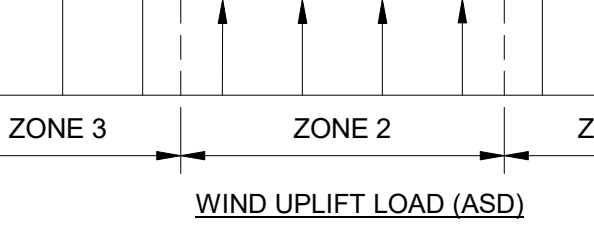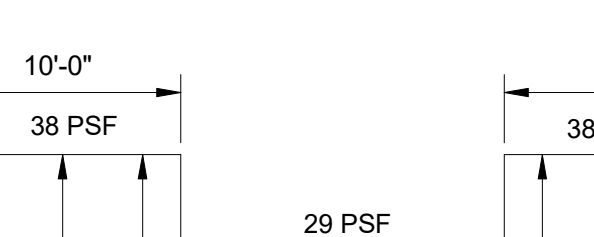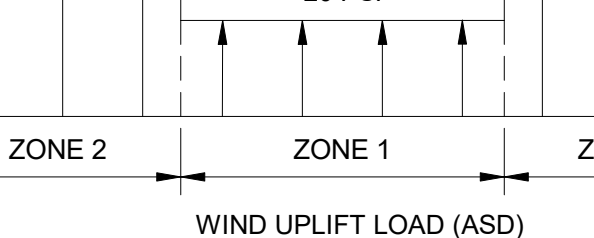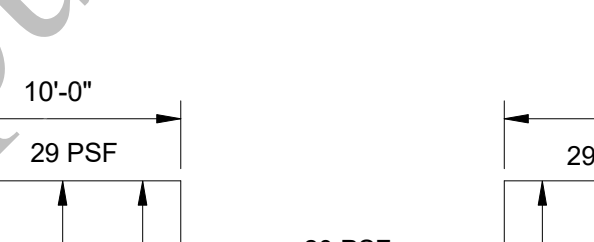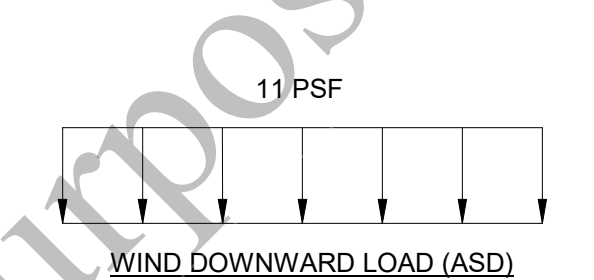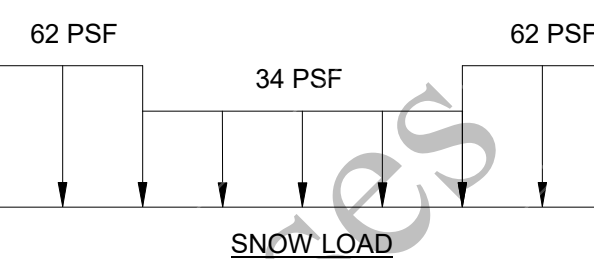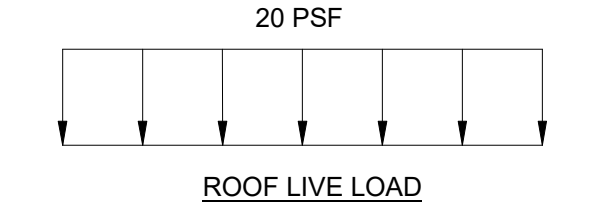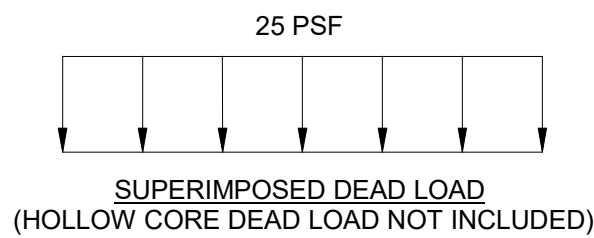


LOADING DIAGRAM FOR PRECAST HOLLOW CORE ROOF SLAB

NO SCALE

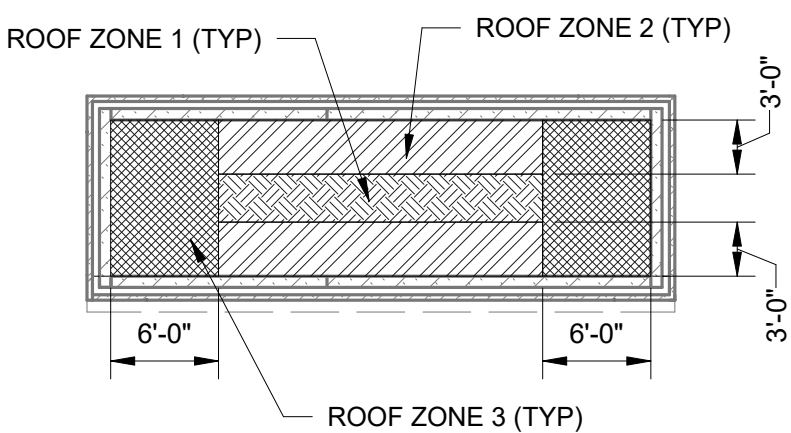

ROOF WIND ZONES PLAN

3/32" = 1'-0"

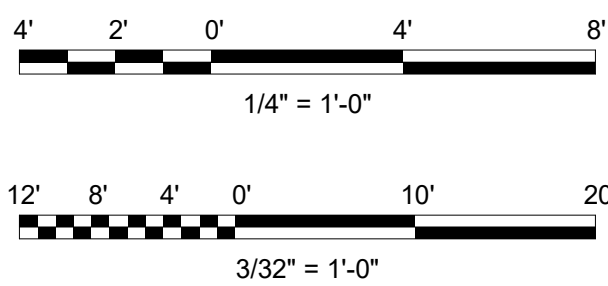

(SCALE BAR IS 4" AT FULL SCALE)

GENERAL SHEET NOTES:

1. FOR GENERAL NOTES, REFER TO SHEET 01-S-101.
2. FOR STRUCTURAL ABBREVIATIONS, REFER TO SHEET 00-S-002.
3. FOR OTHER NOTES, REFER TO SHEET 01-S-103.
4. FOR PIPE SUPPORT TYPE AND LOCATIONS SEE PIPING DRAWINGS AND SCHEDULE ON SHEET 99-M-502.



Black & Veatch Corporation
Chicago, Illinois
ILLINOIS PROFESSIONAL
DESIGN FIRM - 184.002143-0006



AEROBIC GRANULAR
SLUDGE - PHASE 1

REVISIONS AND RECORD OF ISSUE	
DESIGNED:	SKA
DETAILED:	UBS
CHECKED:	CG
APPROVED:	TNG
DATE:	12/20/2022
PROJECT NO.:	411752

AGS REACTORS AND PIPE
GALLERY


STRUCTURAL

PIPE GALLERY
STAIR TOWER PLANS

01-S-104

59
OF
163

PLOTTED: 12/19/2022 3:19:04 PM
FILE: BIM 360/1409469 - Aerobic Granular Sludge Phase 1409469 - AGS.rvt
D11000

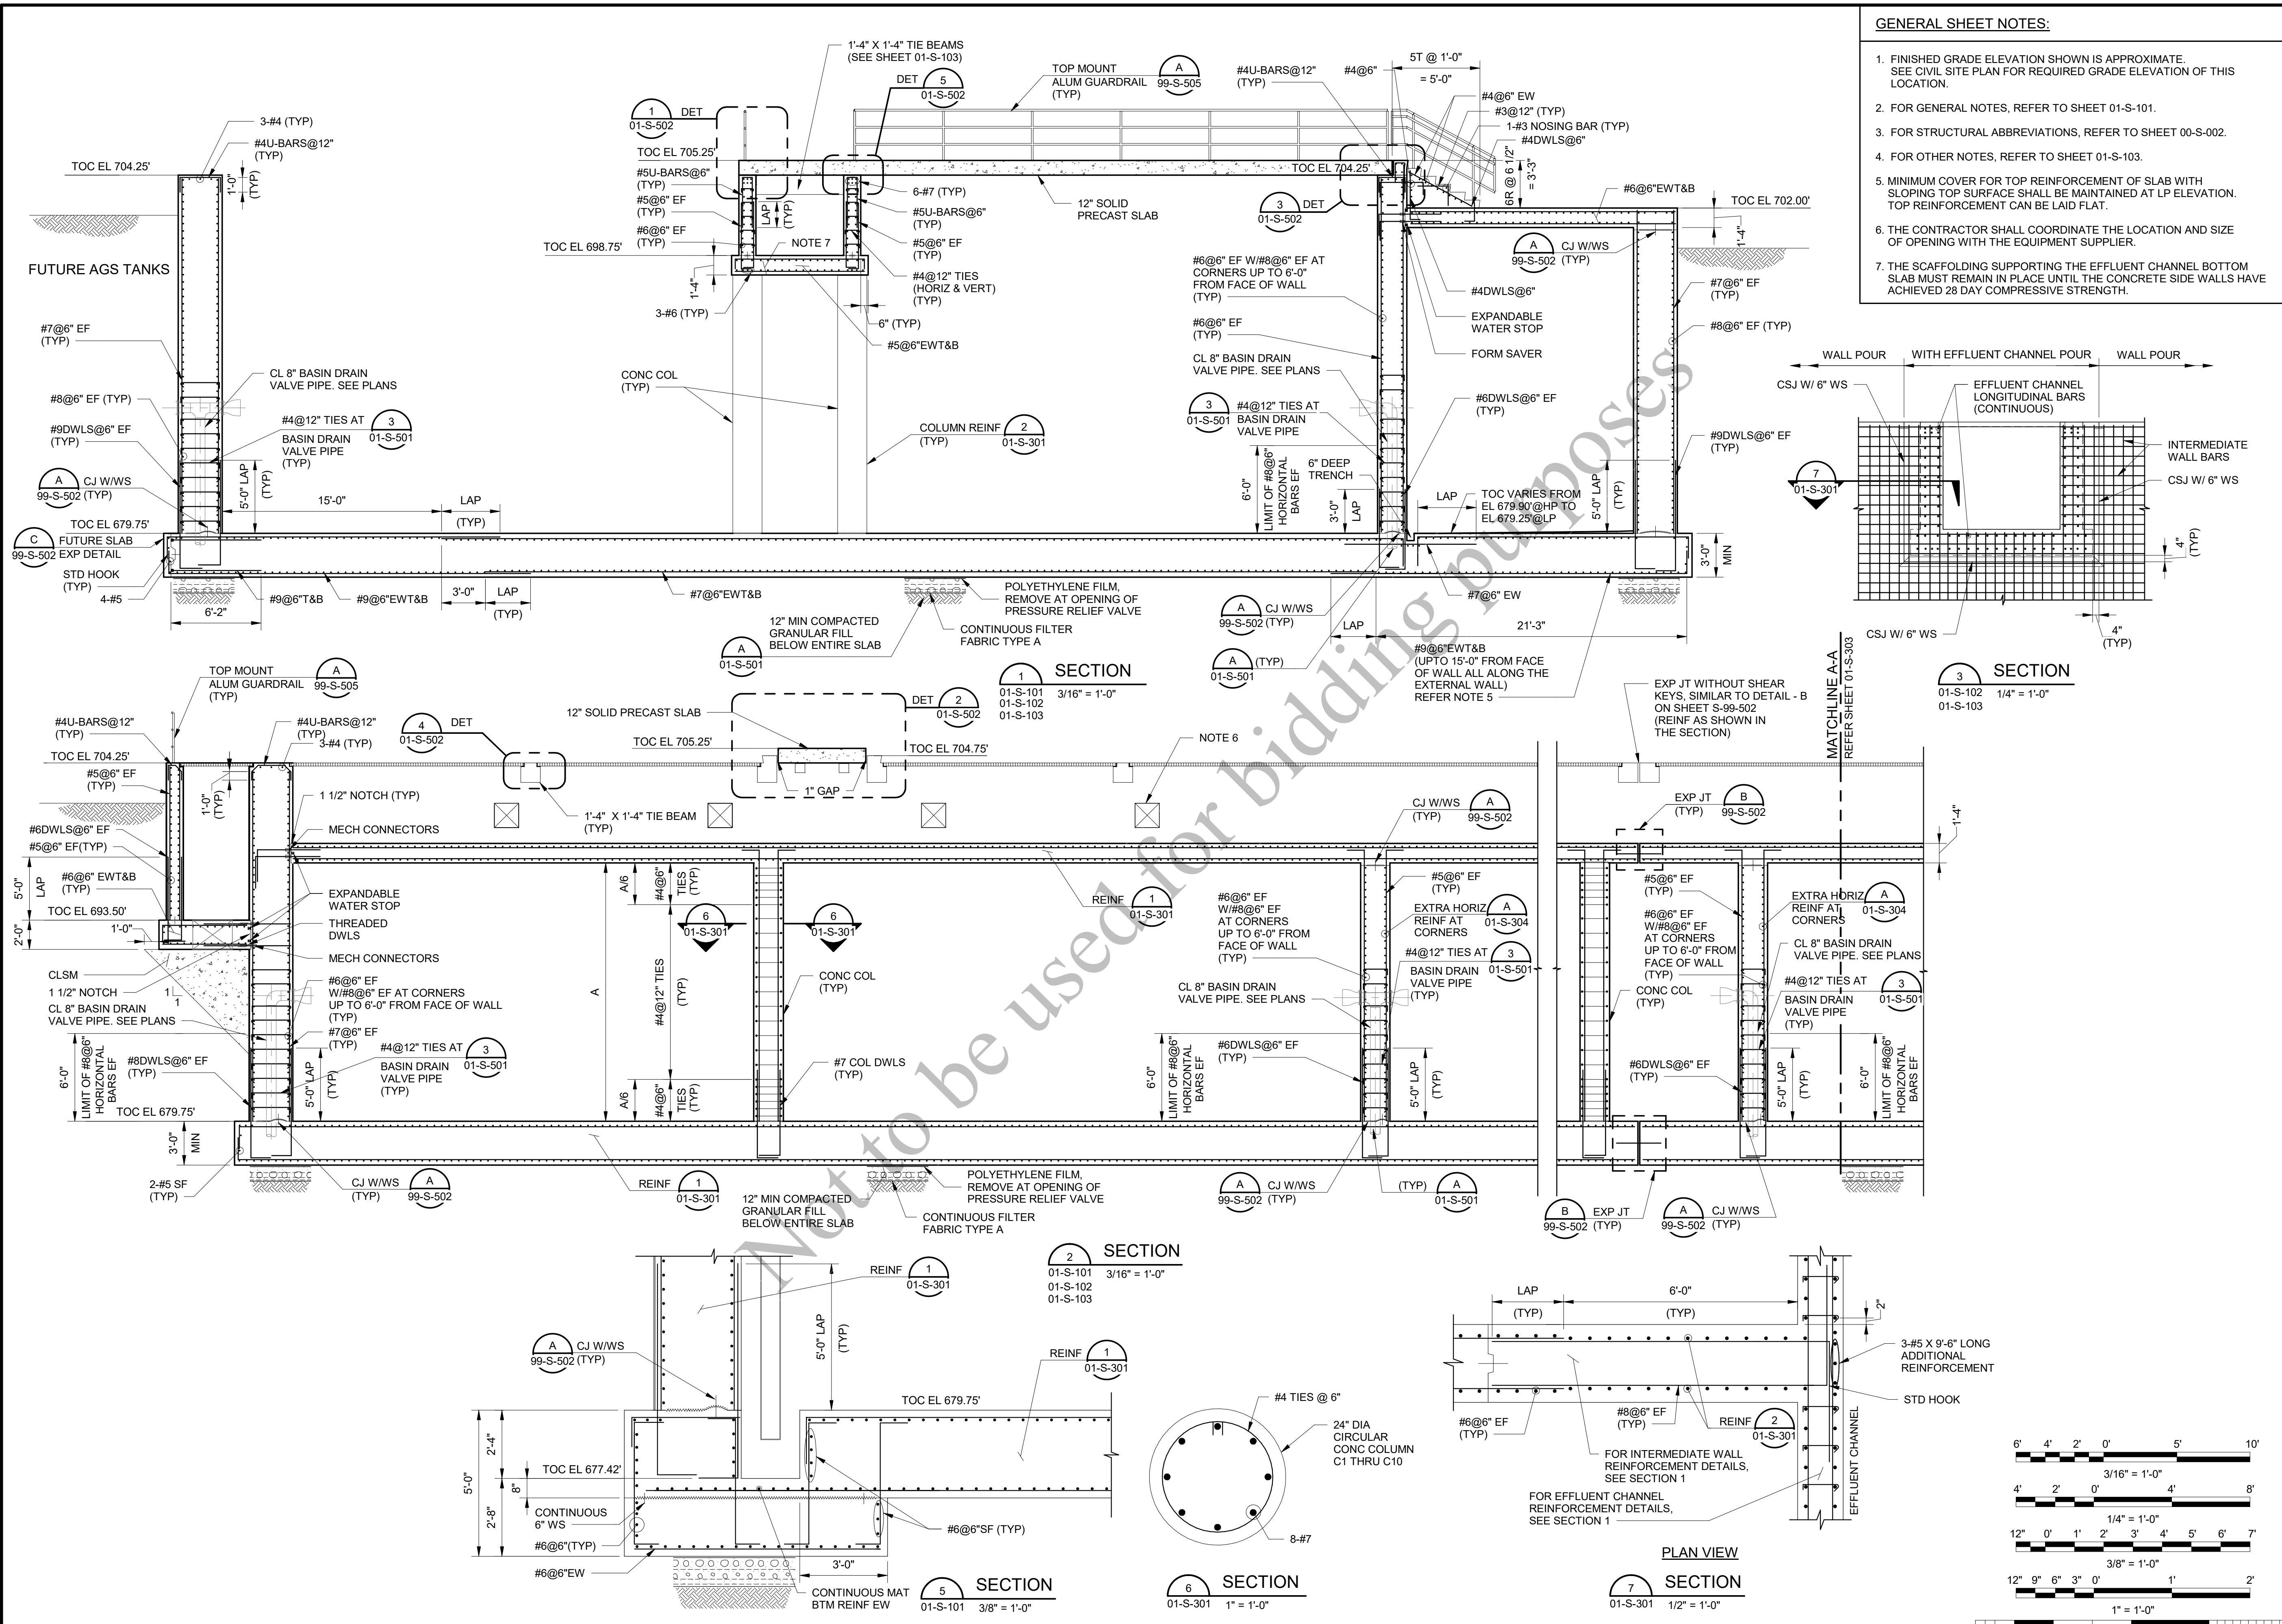

GENERAL SHEET NOTES:

1. FINISHED GRADE ELEVATION SHOWN IS APPROXIMATE. SEE CIVIL SITE PLAN FOR REQUIRED GRADE ELEVATION OF THIS LOCATION.
2. FOR GENERAL NOTES, REFER TO SHEET 01-S-101.
3. FOR STRUCTURAL ABBREVIATIONS, REFER TO SHEET 00-S-002.
4. FOR OTHER NOTES, REFER TO SHEET 01-S-103.
5. MINIMUM COVER FOR TOP REINFORCEMENT OF SLAB WITH SLOPING TOP SURFACE SHALL BE MAINTAINED AT LP ELEVATION. TOP REINFORCEMENT CAN BE LAID FLAT.
6. THE CONTRACTOR SHALL COORDINATE THE LOCATION AND SIZE OF OPENING WITH THE EQUIPMENT SUPPLIER.
7. THE SCAFFOLDING SUPPORTING THE EFFLUENT CHANNEL BOTTOM SLAB MUST REMAIN IN PLACE UNTIL THE CONCRETE SIDE WALLS HAVE ACHIEVED 28 DAY COMPRESSIVE STRENGTH.



Black & Veatch Corporation
Chicago, Illinois
ILLINOIS PROFESSIONAL
DESIGN FIRM - 184.002143-0006



AEROBIC GRANULAR
SLUDGE - PHASE 1

REVISIONS AND RECORD OF ISSUE	
DESIGNED:	SKA
DETAILED:	UBS
CHECKED:	CG
APPROVED:	TNG
DATE:	12/20/2022
PROJECT NO.:	411752

AGS REACTORS AND PIPE
GALLERY

STRUCTURAL







SECTIONS AND DETAILS
1 OF 4

01-S-301

60
OF
163

(SCALE BAR IS 4" AT FULL SCALE) 0 1/2 1 2 3 4

- GENERAL SHEET NOTES:**
1. FINISHED GRADE ELEVATION SHOWN IS APPROXIMATE. SEE CIVIL SITE PLAN FOR REQUIRED GRADE ELEVATION OF THIS LOCATION.
 2. FOR GENERAL NOTES, REFER TO SHEET 01-S-101.
 3. FOR STRUCTURAL ABBREVIATIONS, REFER TO SHEET 00-S-002.
 4. FOR OTHER NOTES, REFER TO SHEET 01-S-103.

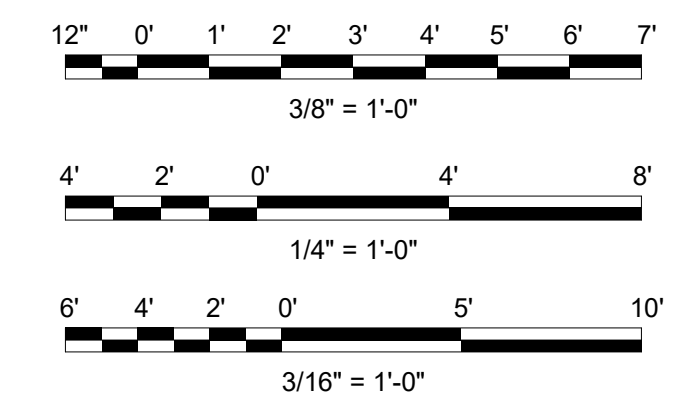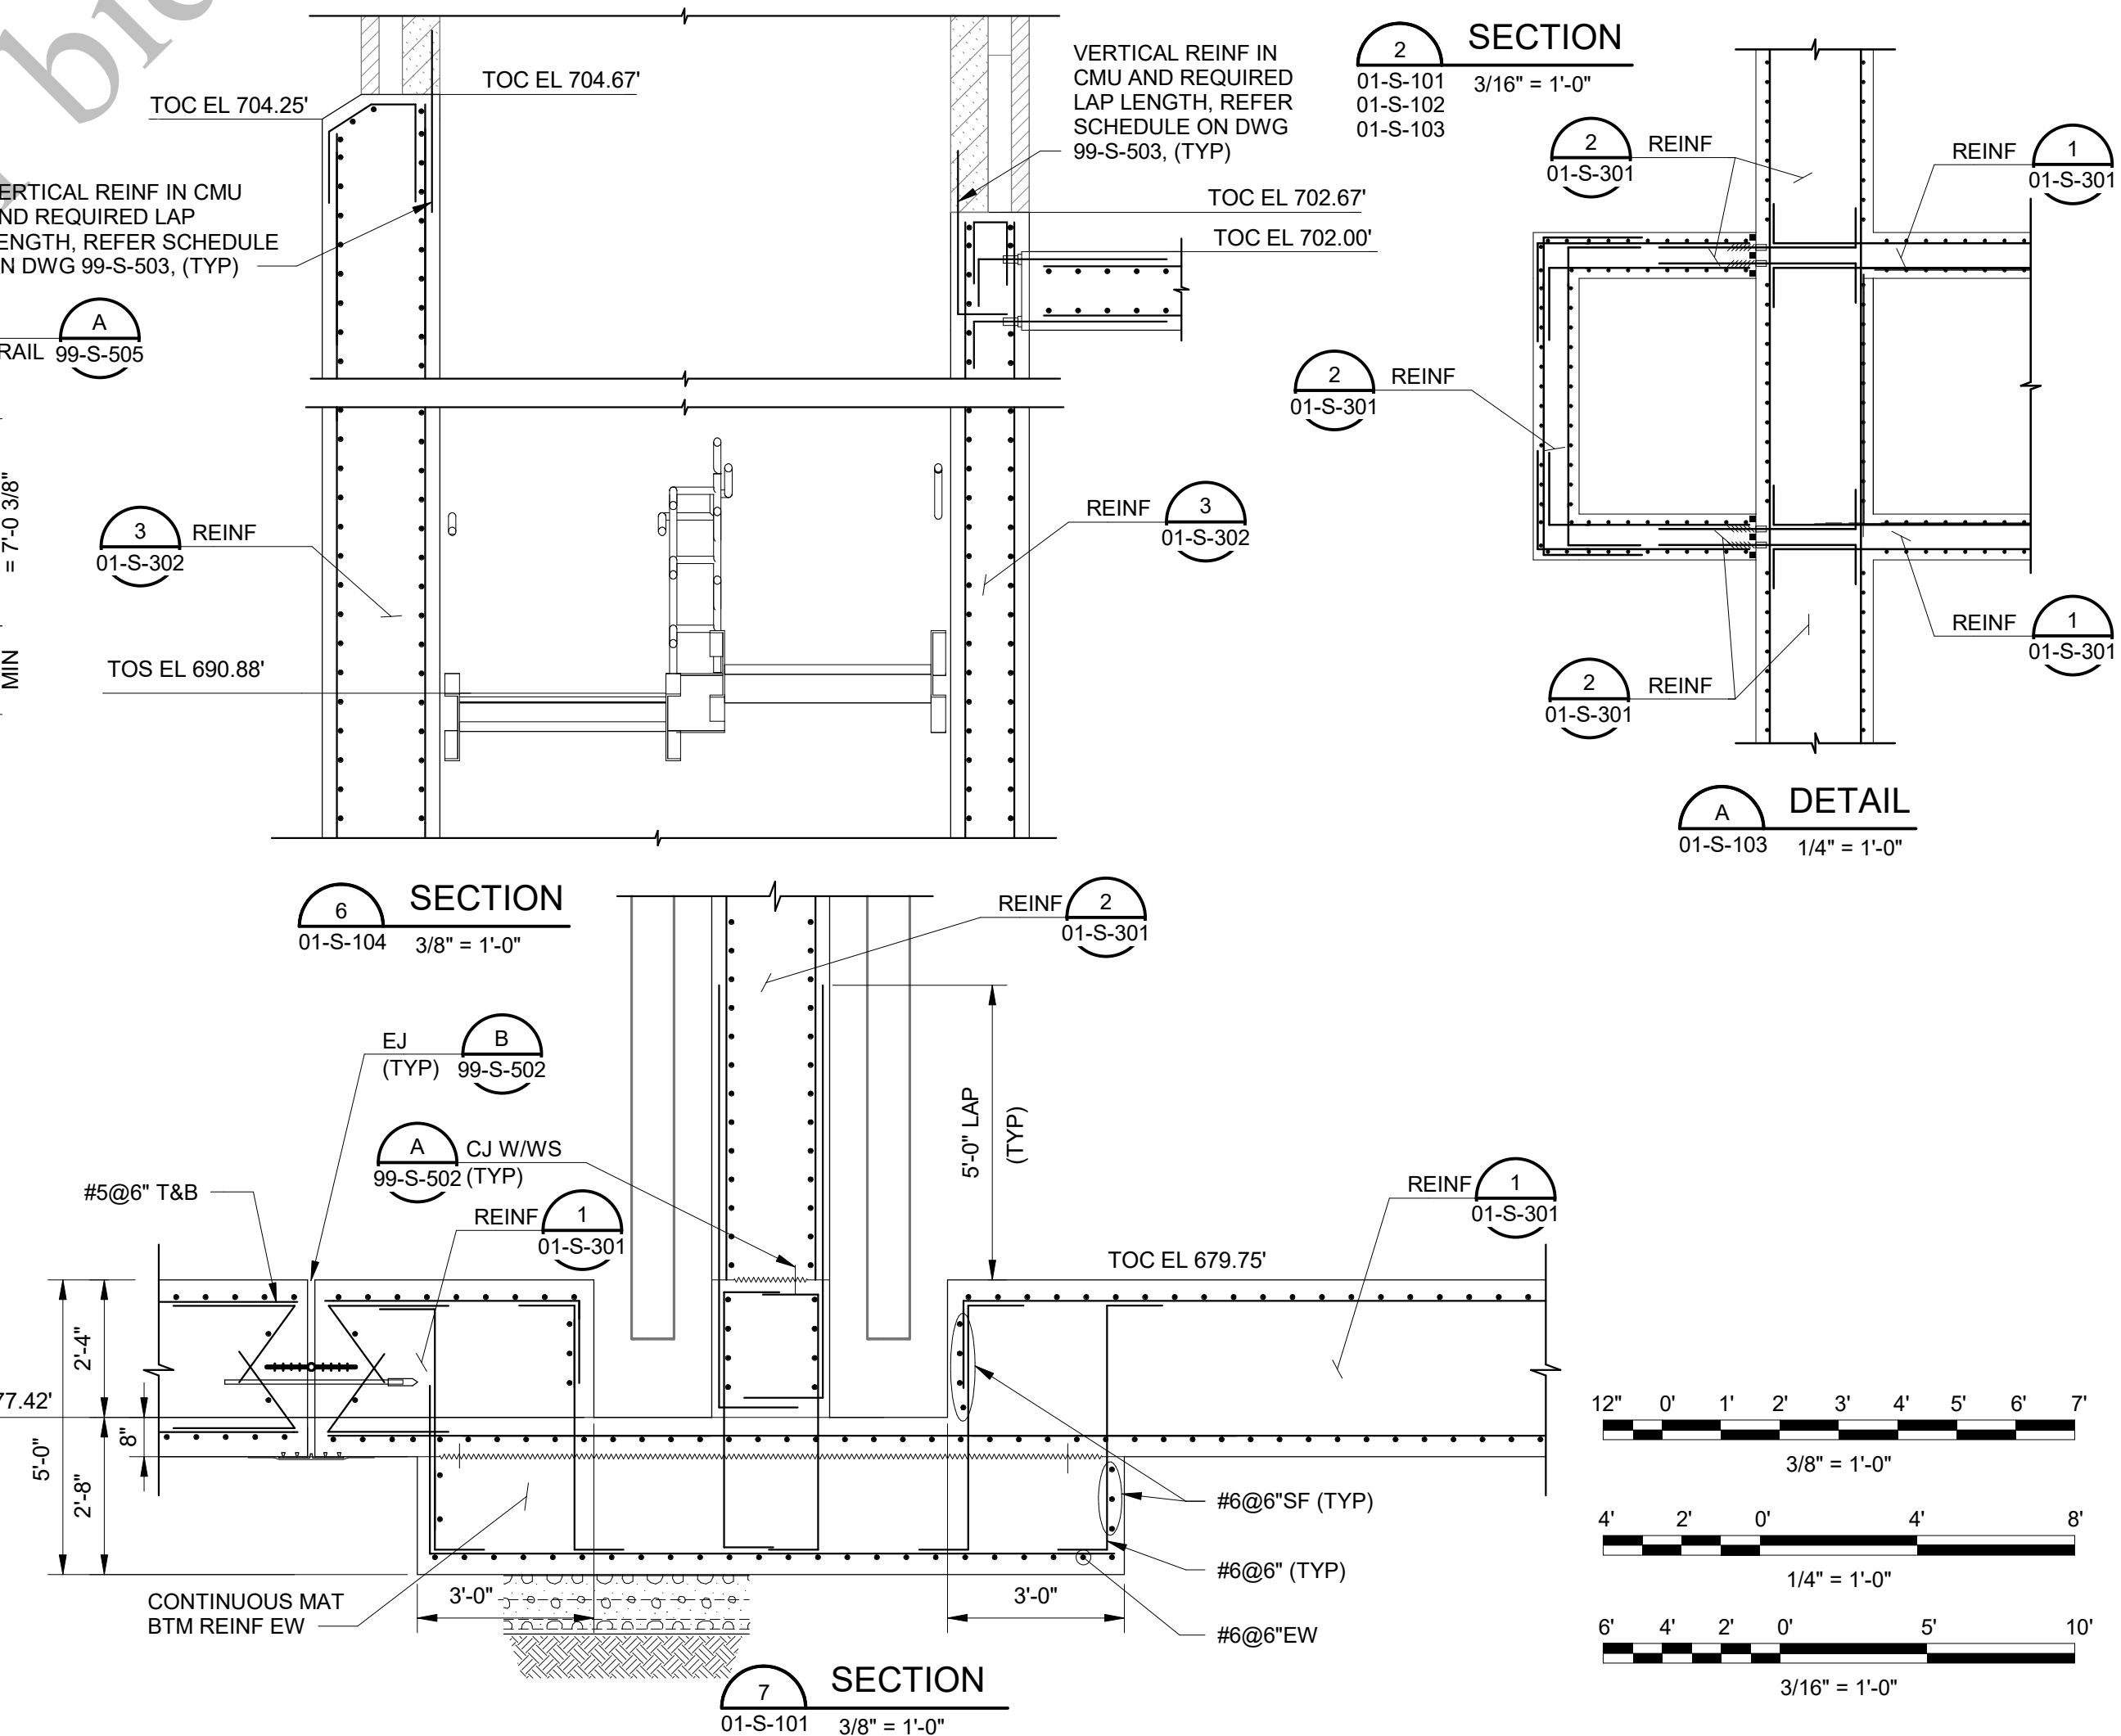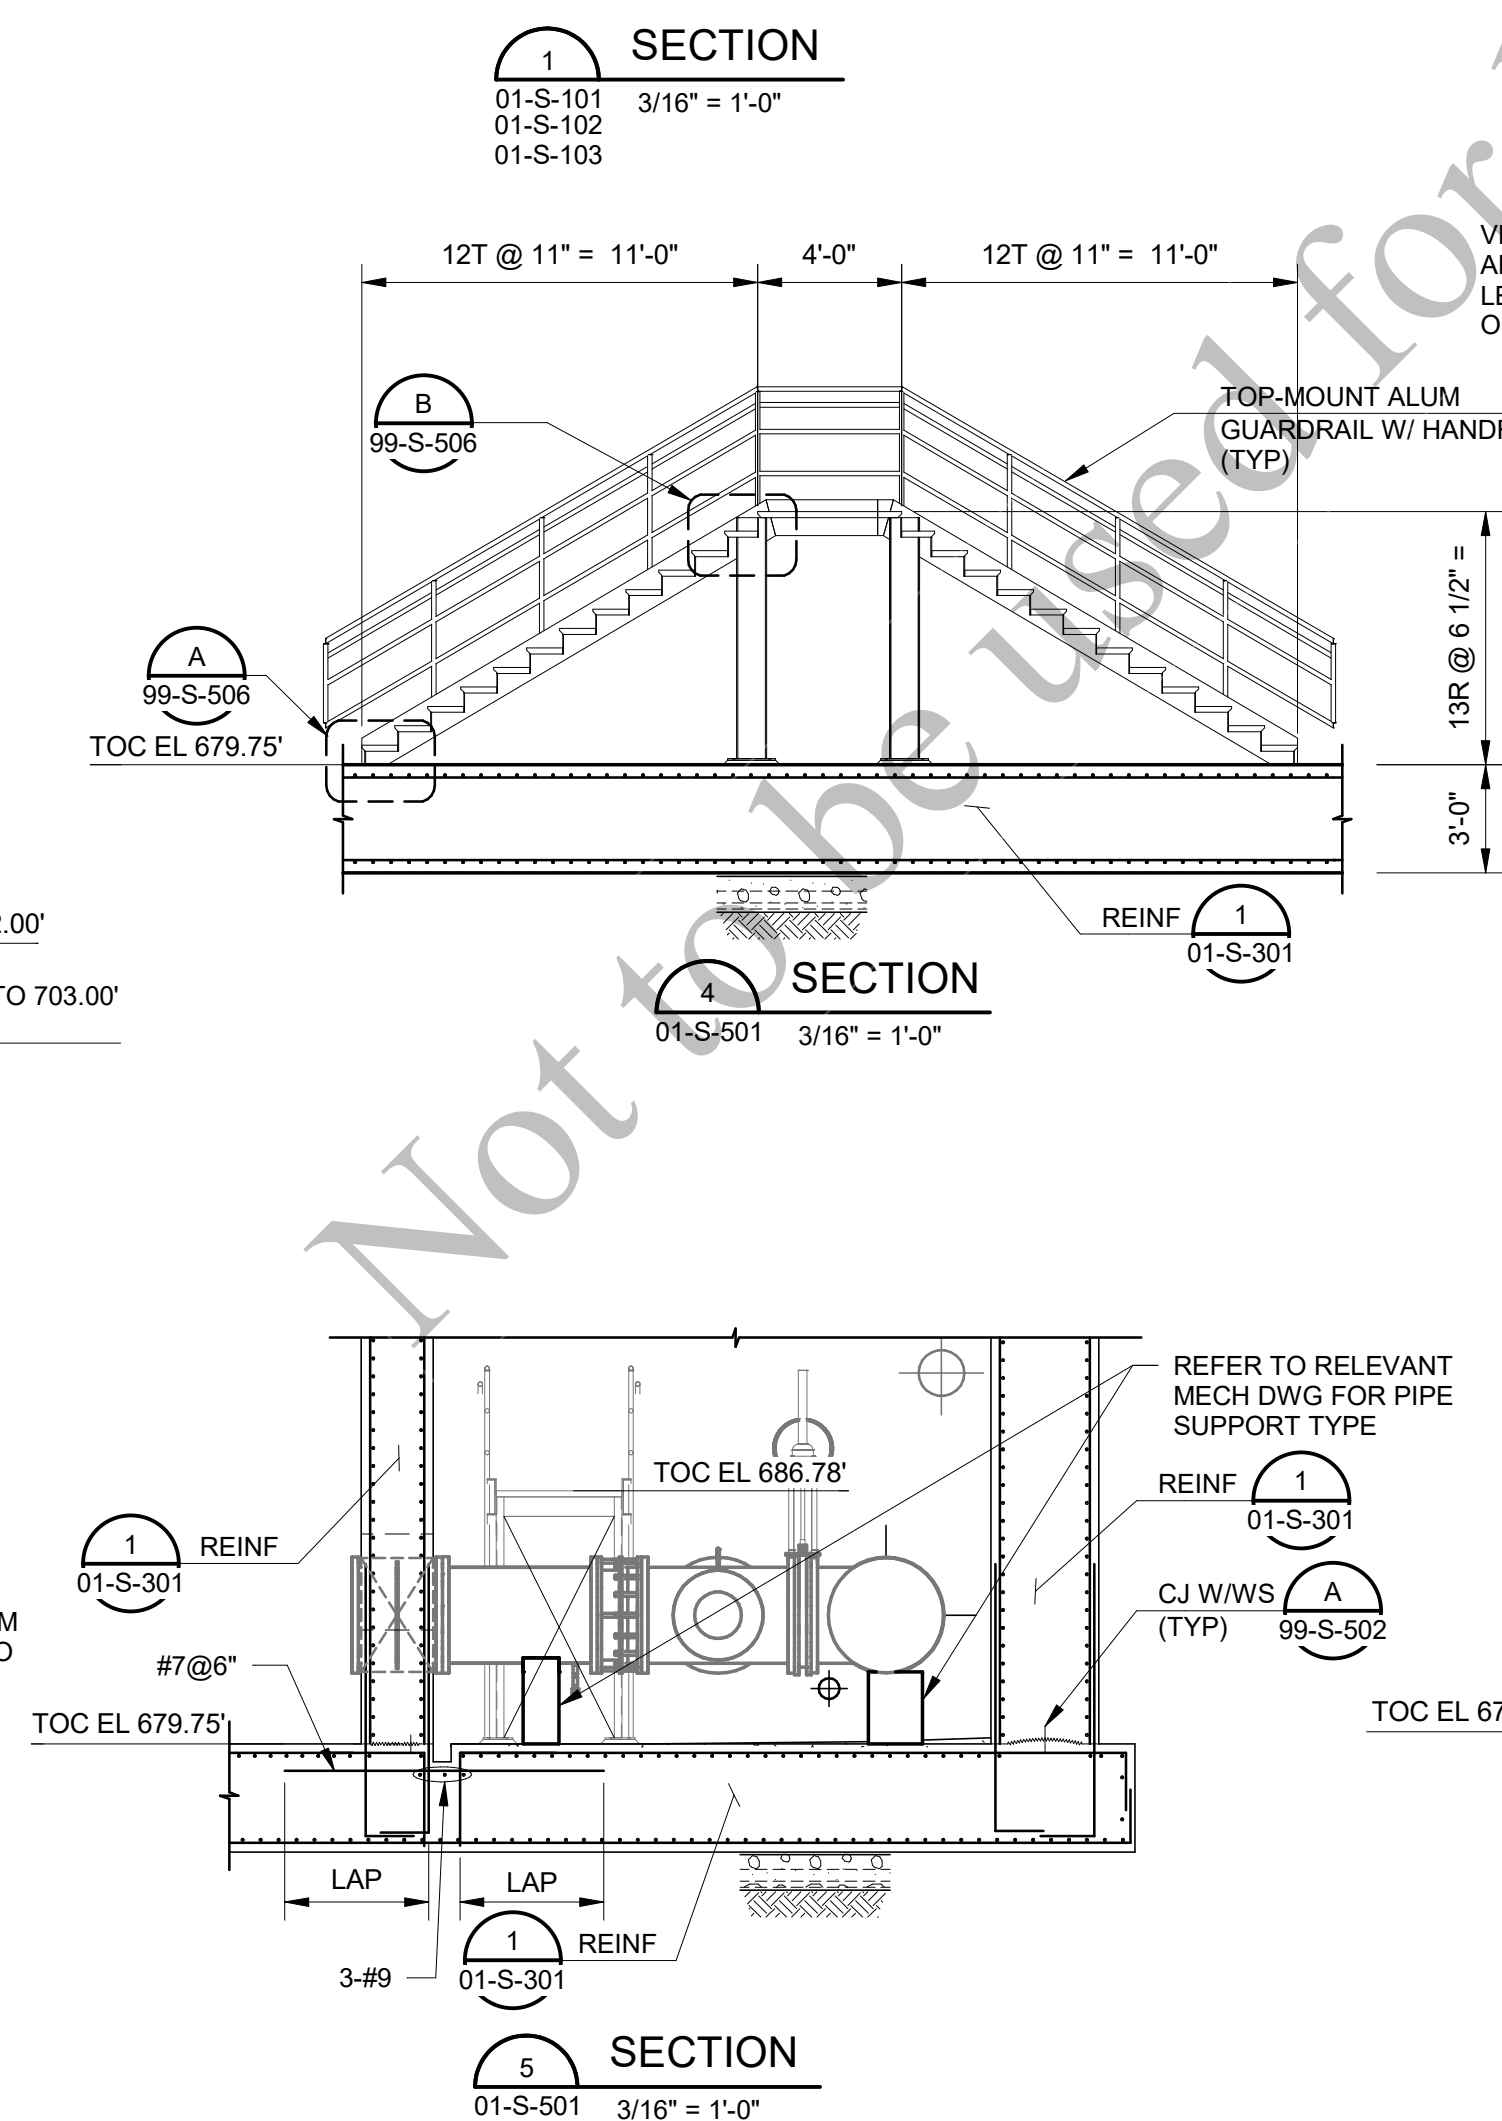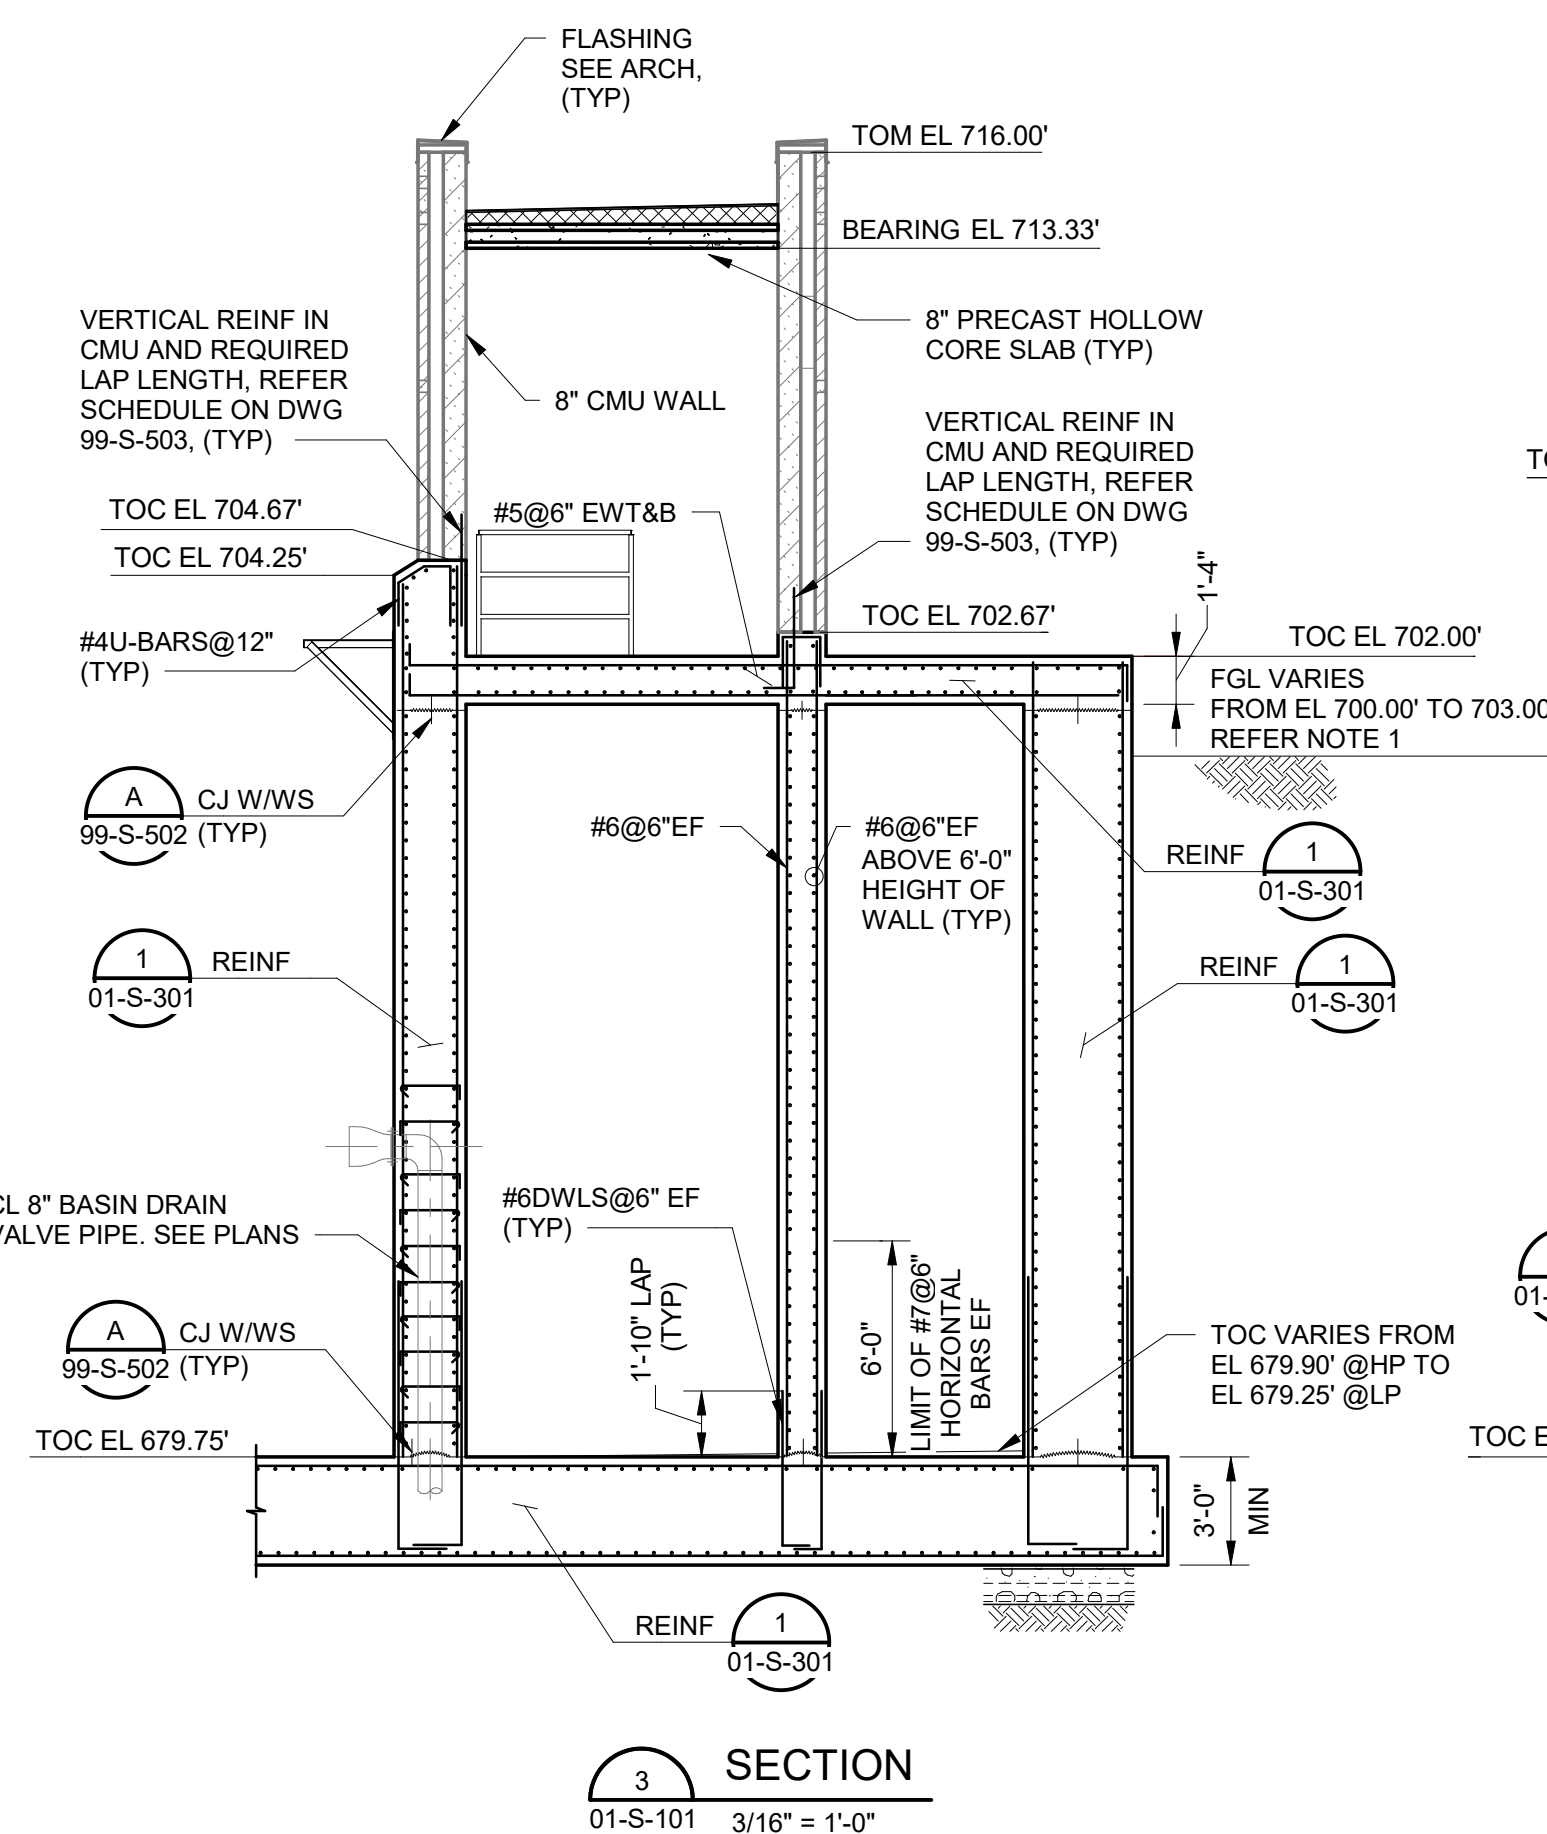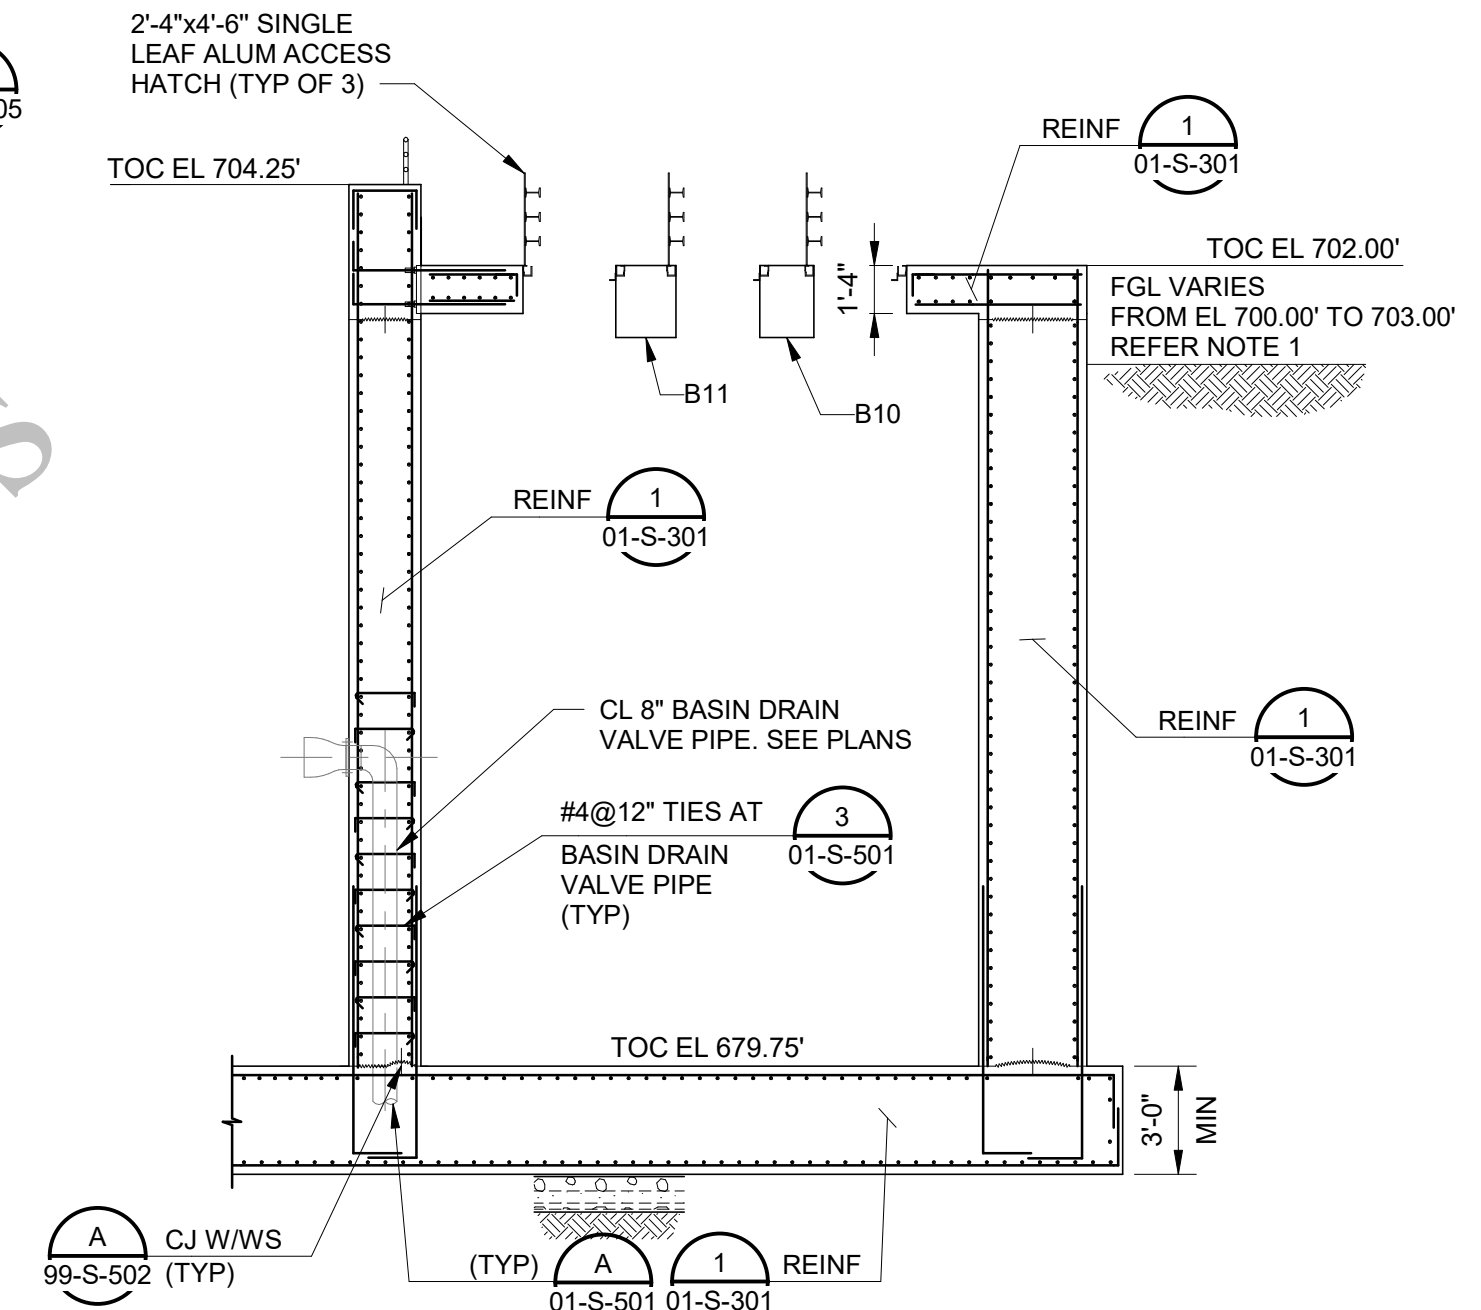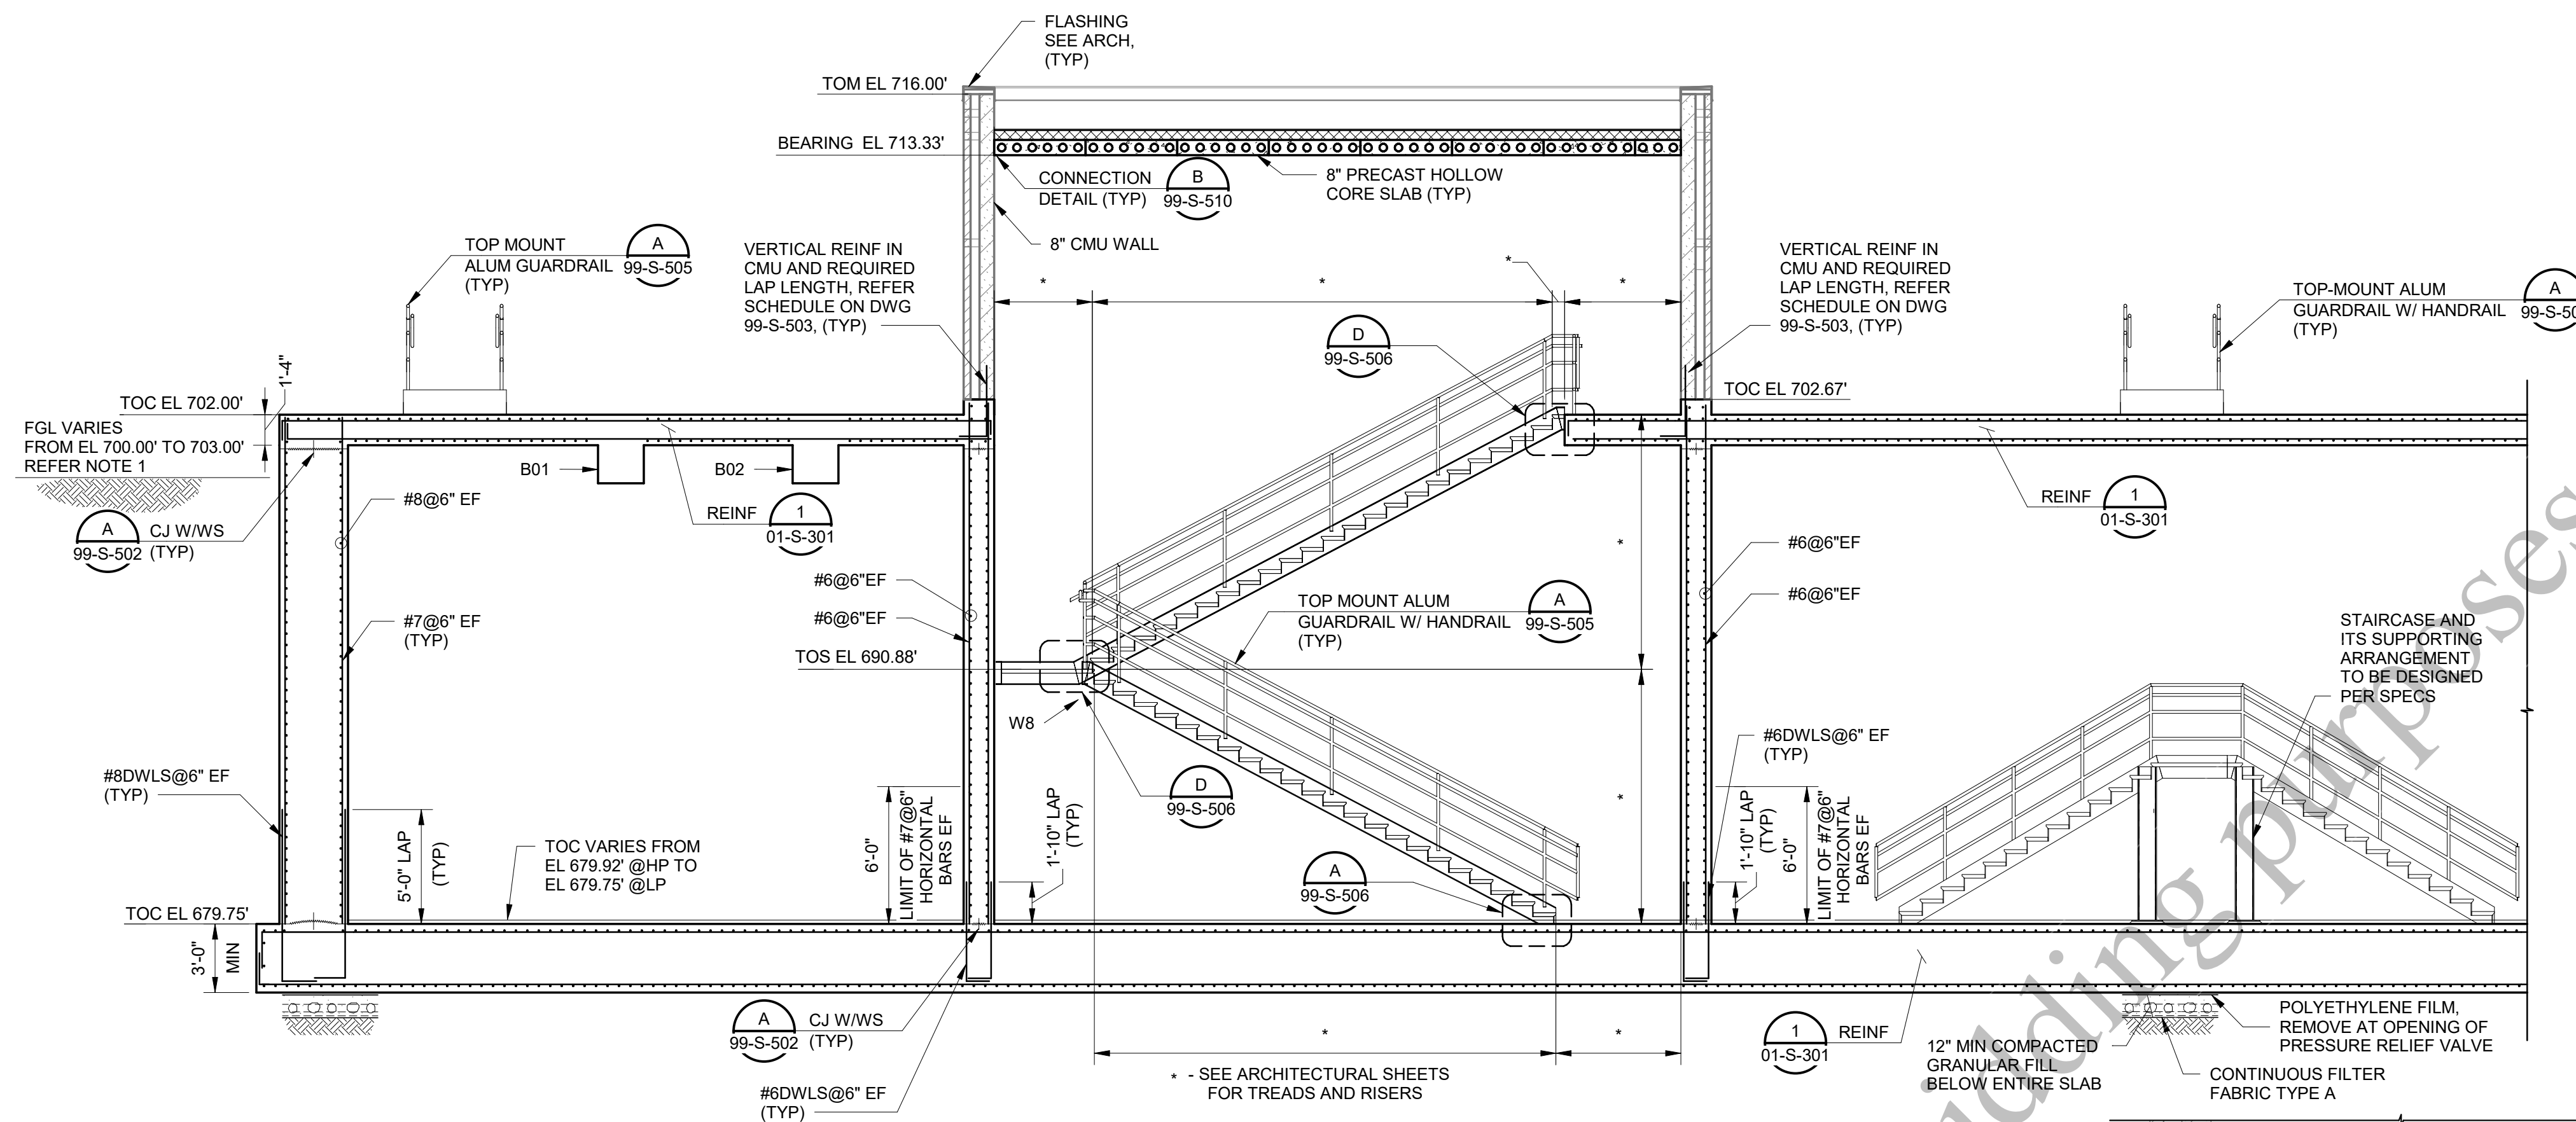

REVIEWS AND RECORD OF ISSUE	
DESIGNED:	SKA
DETAILED:	UBS
CHECKED:	CG
APPROVED:	TNG
DATE:	12/20/2022
PROJECT NO.:	411752





AEROBIC GRANULAR
SLUDGE - PHASE 1

STRUCTURAL

SECTIONS AND DETAILS
2 OF 4

01-S-302

1. FINISHED GRADE ELEVATION SHOWN IS APPROXIMATE. SEE CIVIL SITE PLAN FOR REQUIRED GRADE ELEVATION OF THIS LOCATION.
2. FOR GENERAL NOTES, REFER TO SHEET 01-S-101.
3. FOR STRUCTURAL ABBREVIATIONS, REFER TO SHEET 00-S-002.
4. FOR OTHER NOTES, REFER TO SHEET 01-S-103.
5. THE CONTRACTOR SHALL COORDINATE THE LOCATION AND SIZE OF OPENING WITH THE EQUIPMENT SUPPLIER.

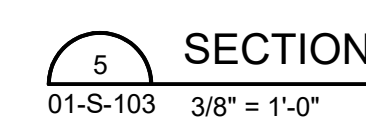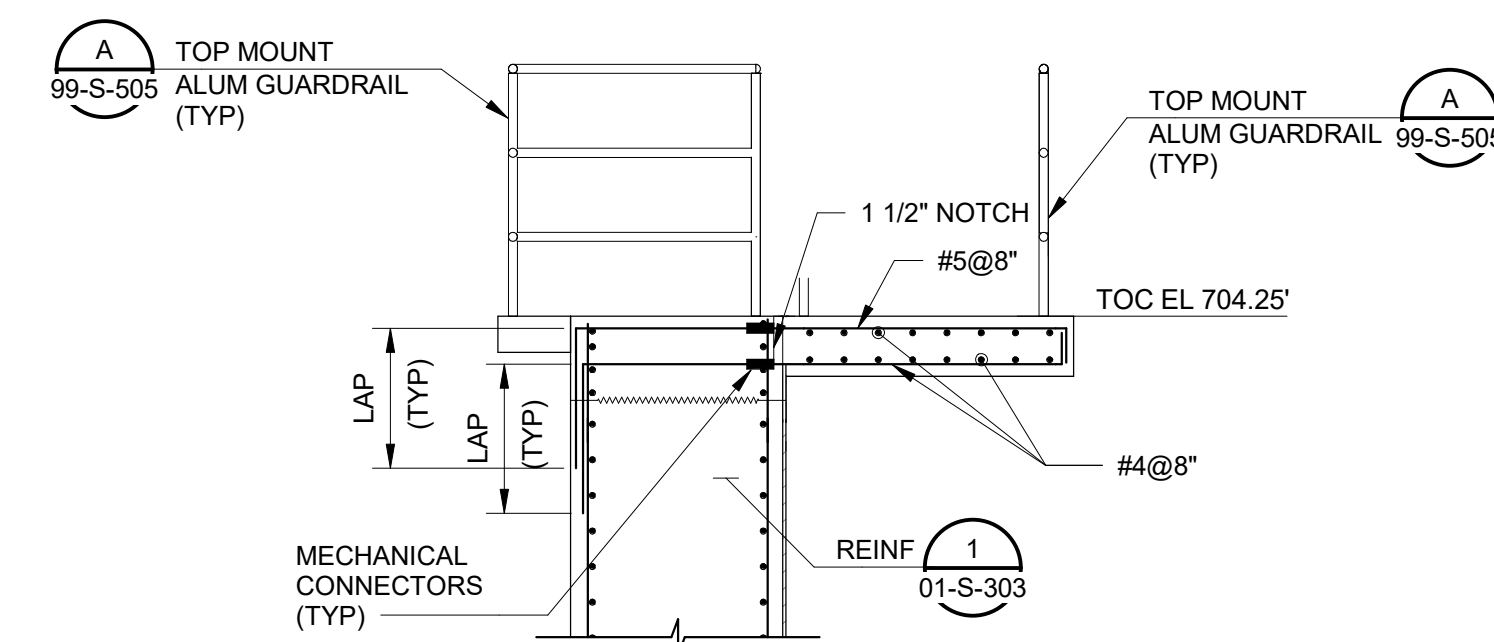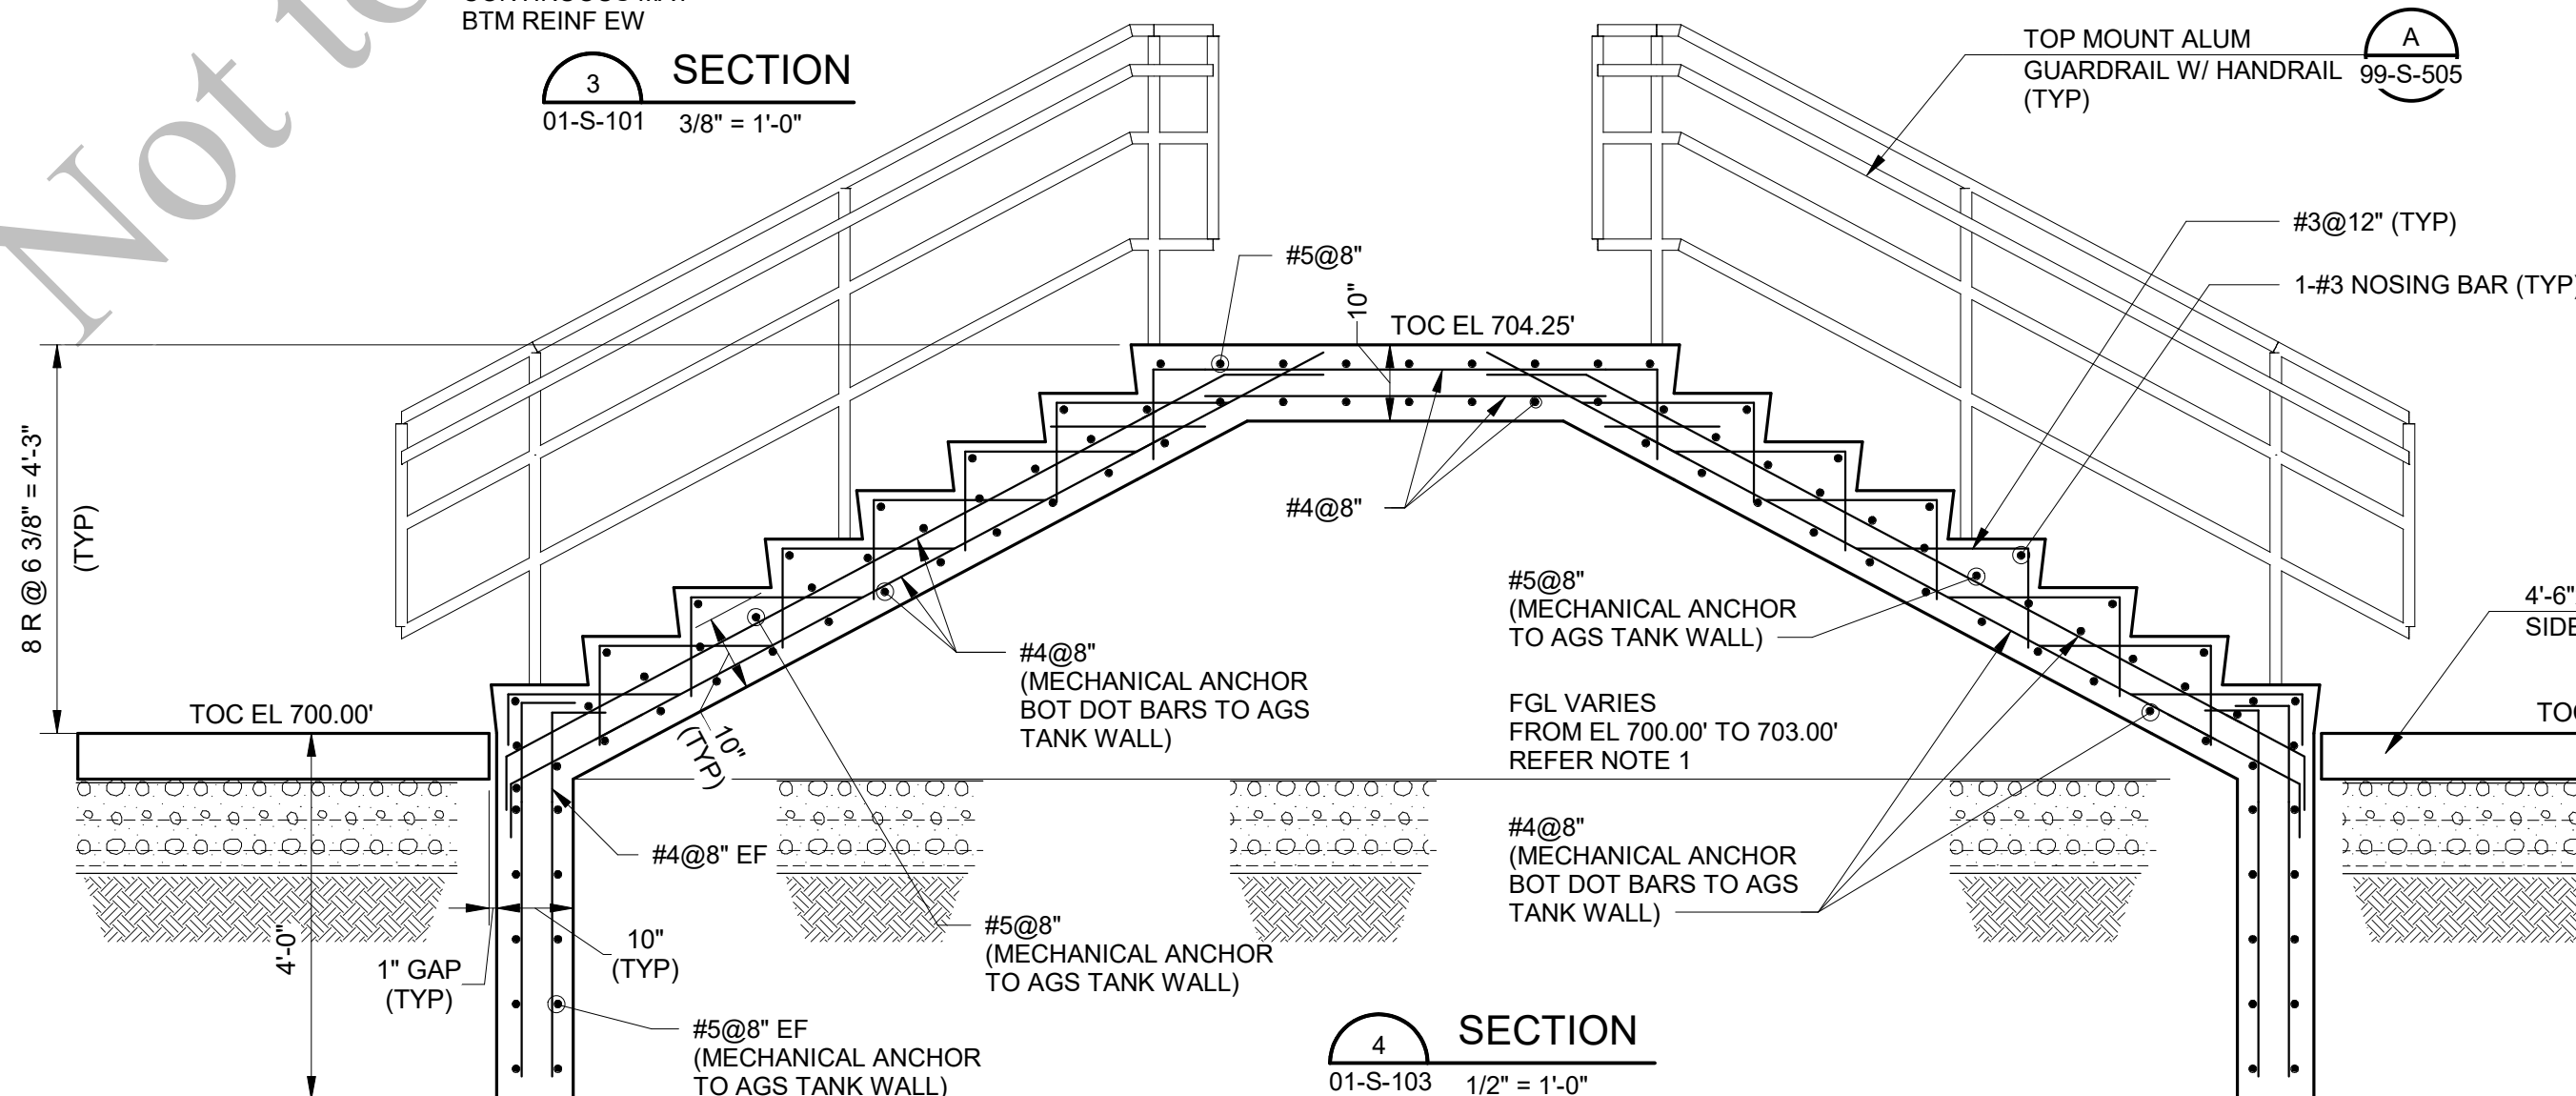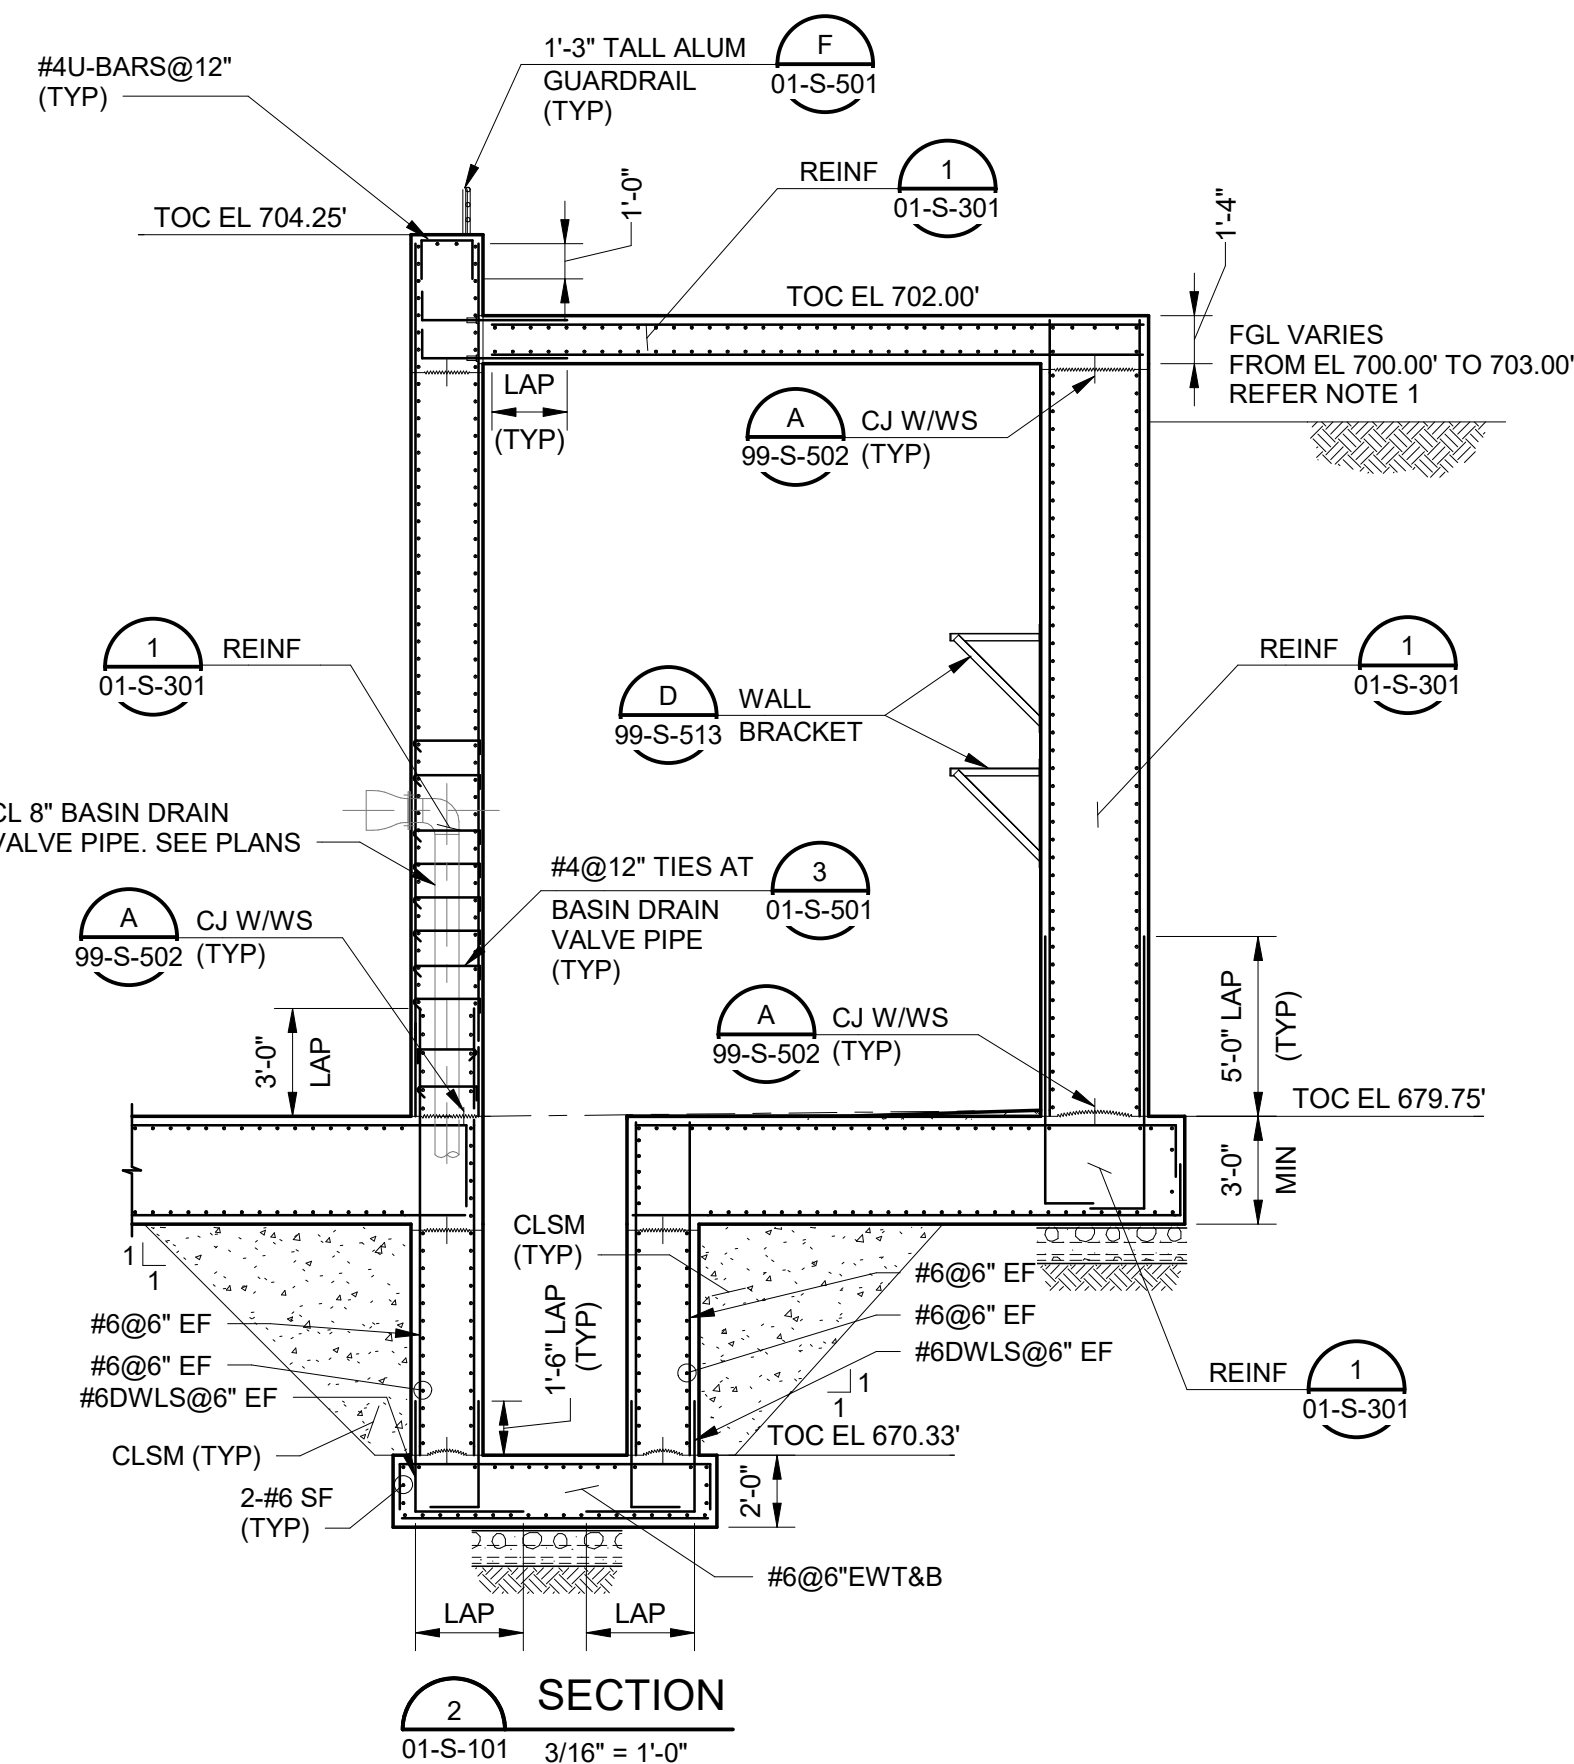


REVISIONS AND RECORD OF ISSUE	
DESIGNED:	SKA
DETAILED:	UBS
CHECKED:	CG
APPROVED:	TNG
DATE:	12/20/2022
PROJECT NO.:	411752

AGS REACTORS AND PIPE GALLERY

STRUCTURAL


SECTIONS AND DETAILS
3 OF 4

01-S-303

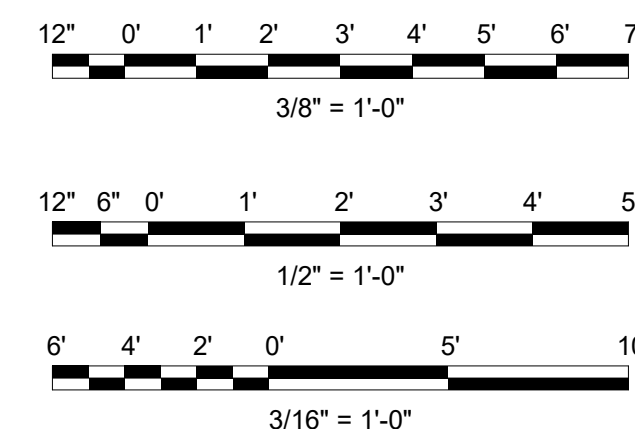62
OF
163

(SCALE BAR IS 4" AT FULL SCALE) 0 1/2 1 2 3

1. FINISHED GRADE ELEVATION SHOWN IS APPROXIMATE. SEE CIVIL SITE PLAN FOR REQUIRED GRADE ELEVATION OF THIS LOCATION.
2. FOR GENERAL NOTES, REFER TO SHEET 01-S-101.
3. FOR STRUCTURAL ABBREVIATIONS, REFER TO SHEET 00-S-002.
4. FOR OTHER NOTES, REFER TO SHEET 01-S-103.
5. COORDINATE PUMP DIMENSIONS WITH EQUIPMENT SUPPLIER.

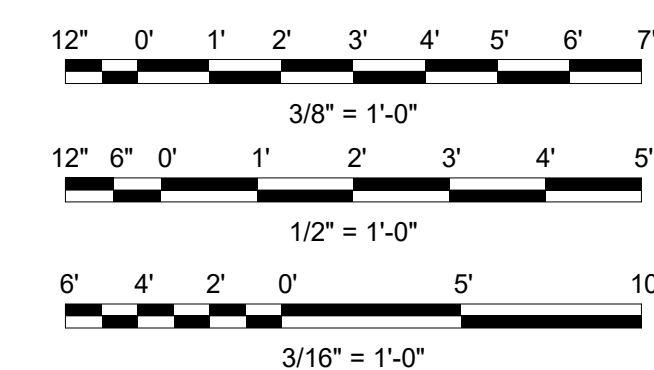AEROBIC GRANULAR
SLUDGE - PHASE 1

AGS REACTORS AND PIPE GALLERY


STRUCTURAL

SECTIONS AND DETAILS
4 OF 4


01-S-304

63
OF
163


PLOTTED: 12/19/2022 4:26:08 PM
FILE: BIM 360/1409469- Aerobic Granular Sludge Phase 1409469 - AGS.rvt
D11000

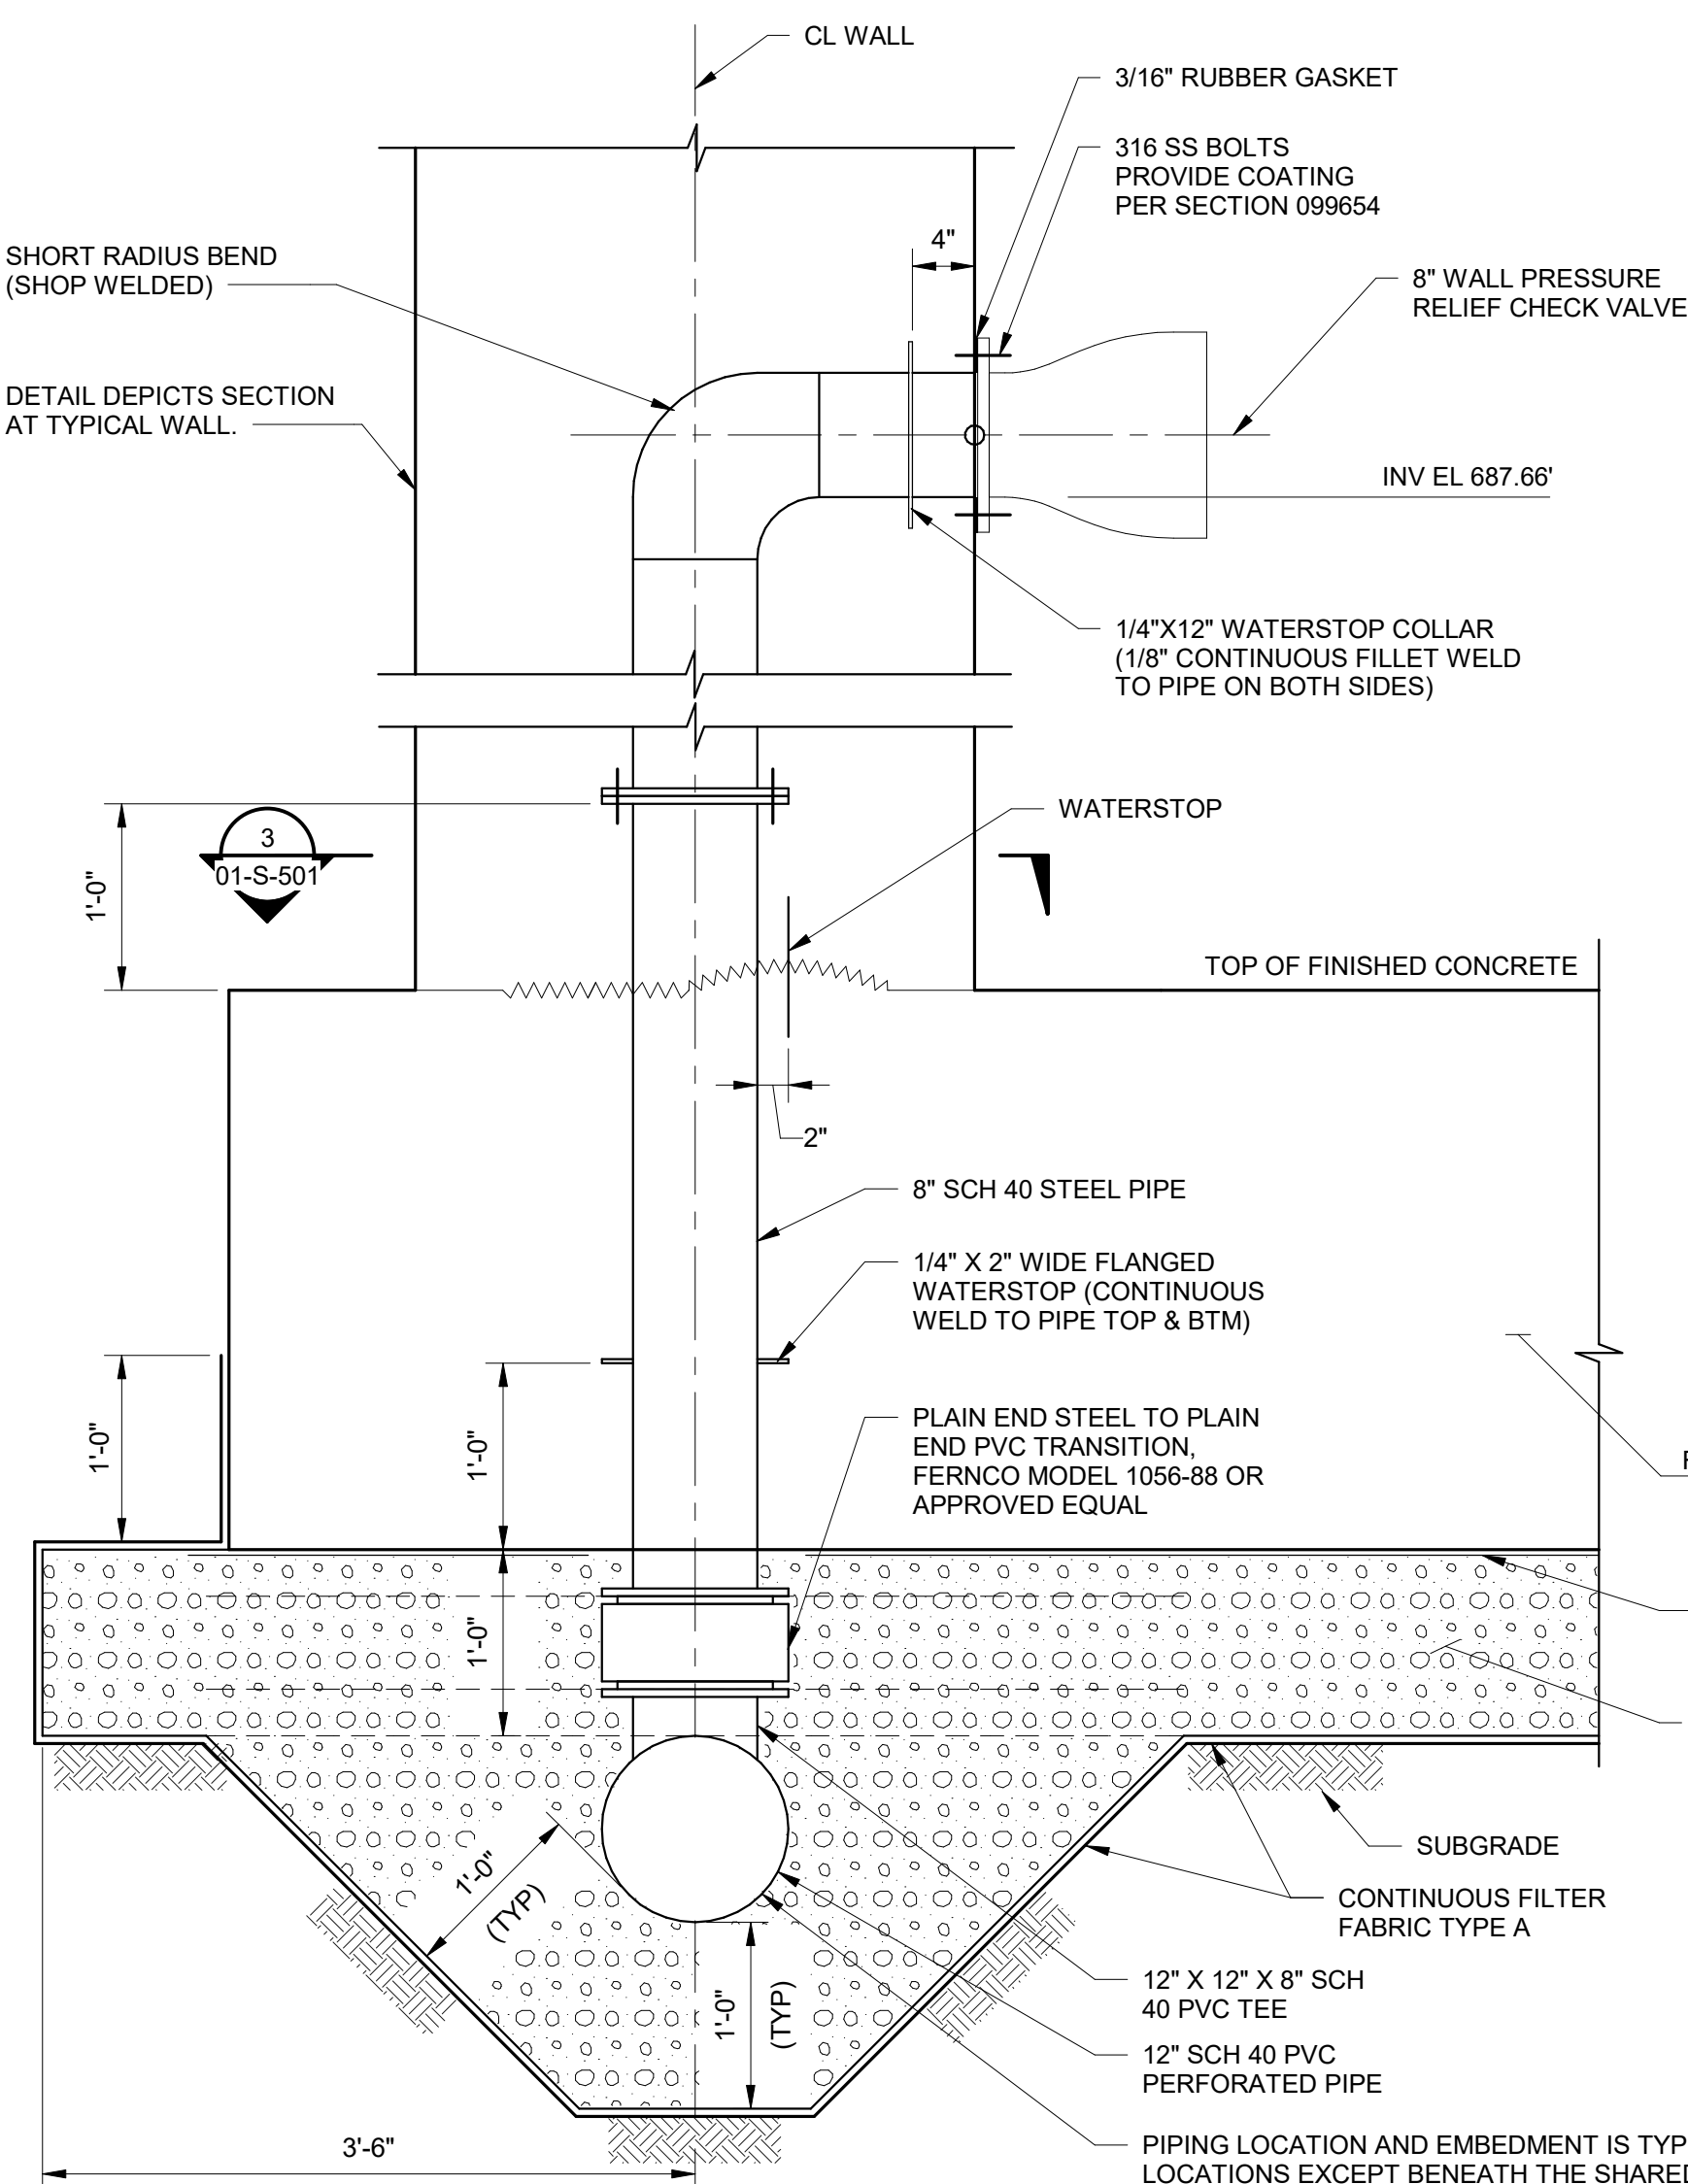


WALL BASIN DRAIN VALVE
01-S-101 1" = 1'-0"

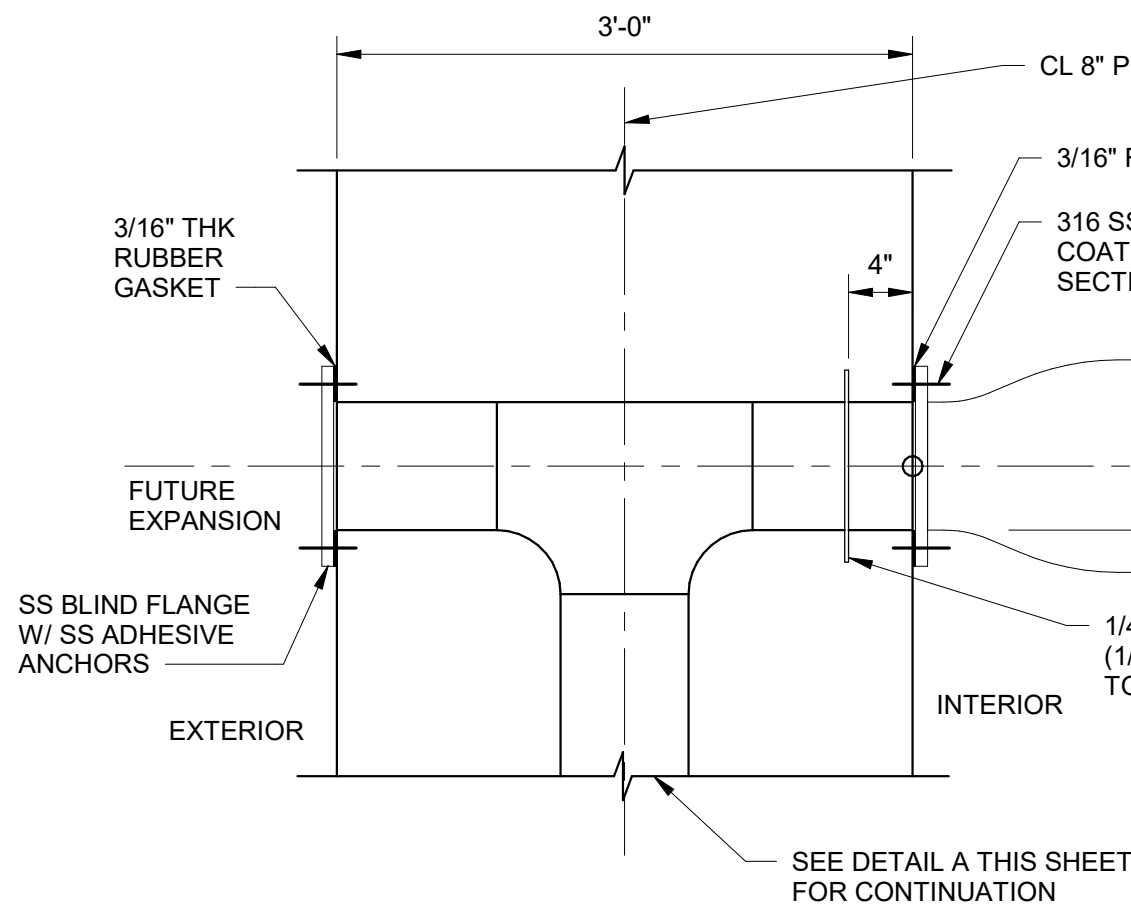


AT FUTURE EXPANSION WALL
1" = 1'-0"

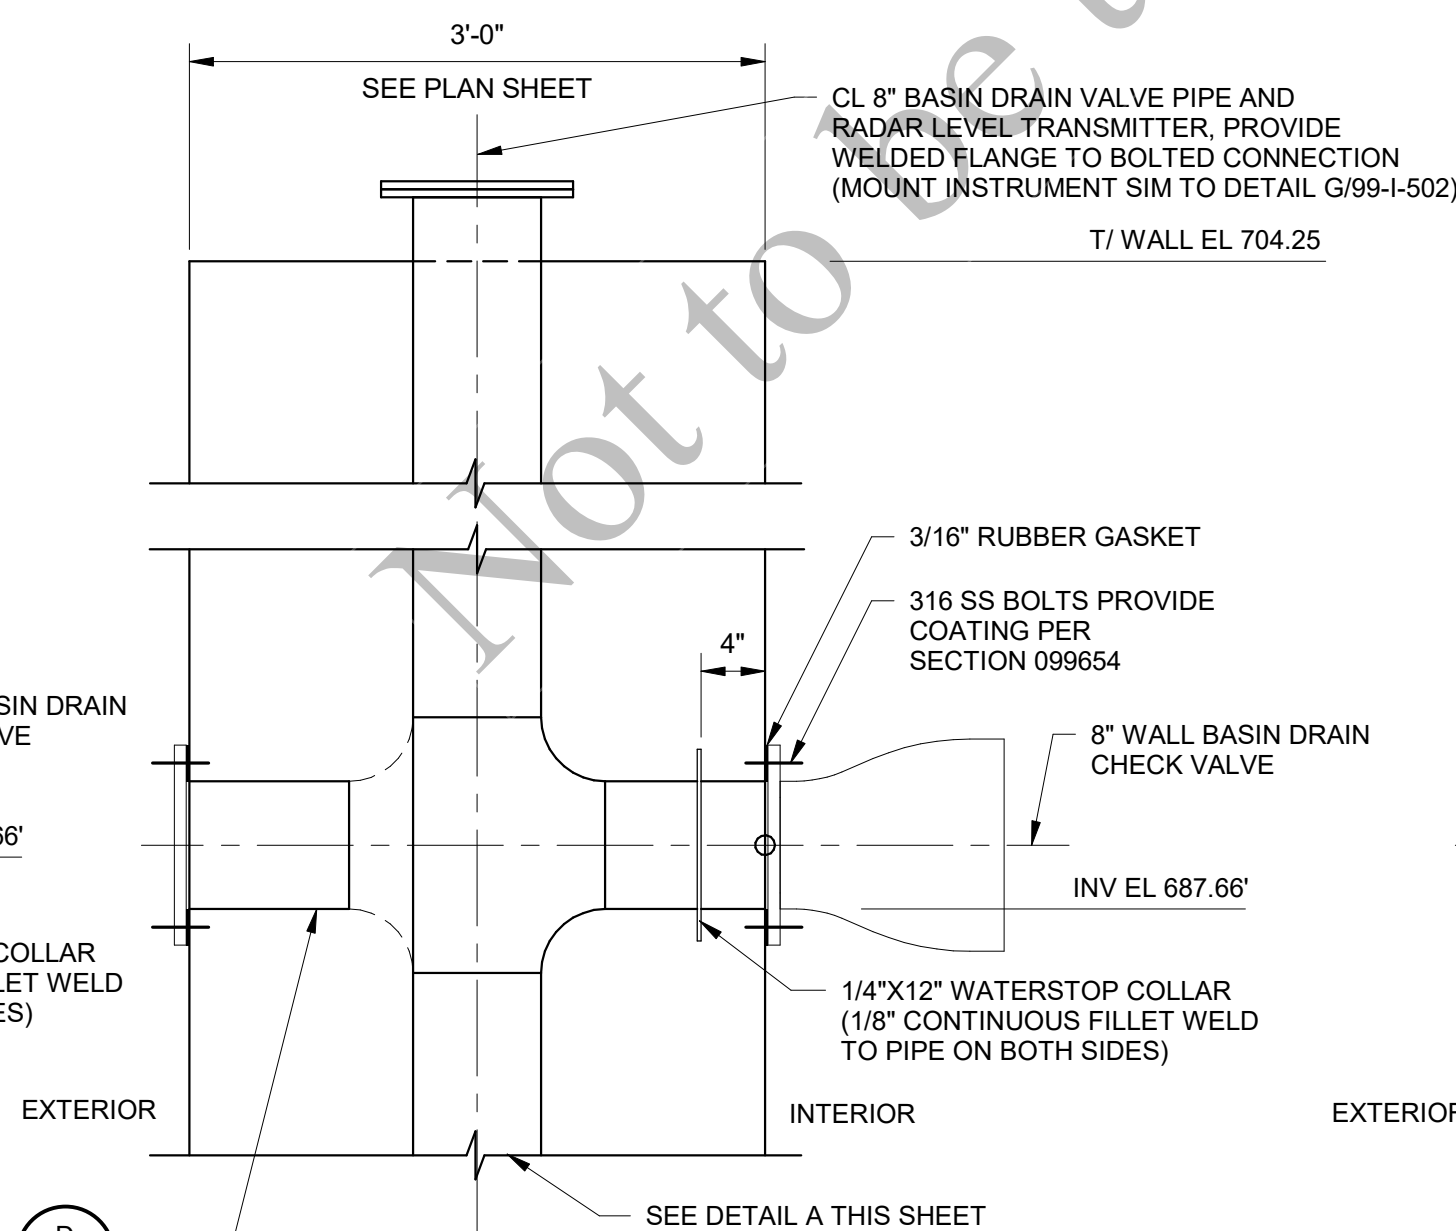


DETAIL AT SOUTH WALL
1" = 1'-0"

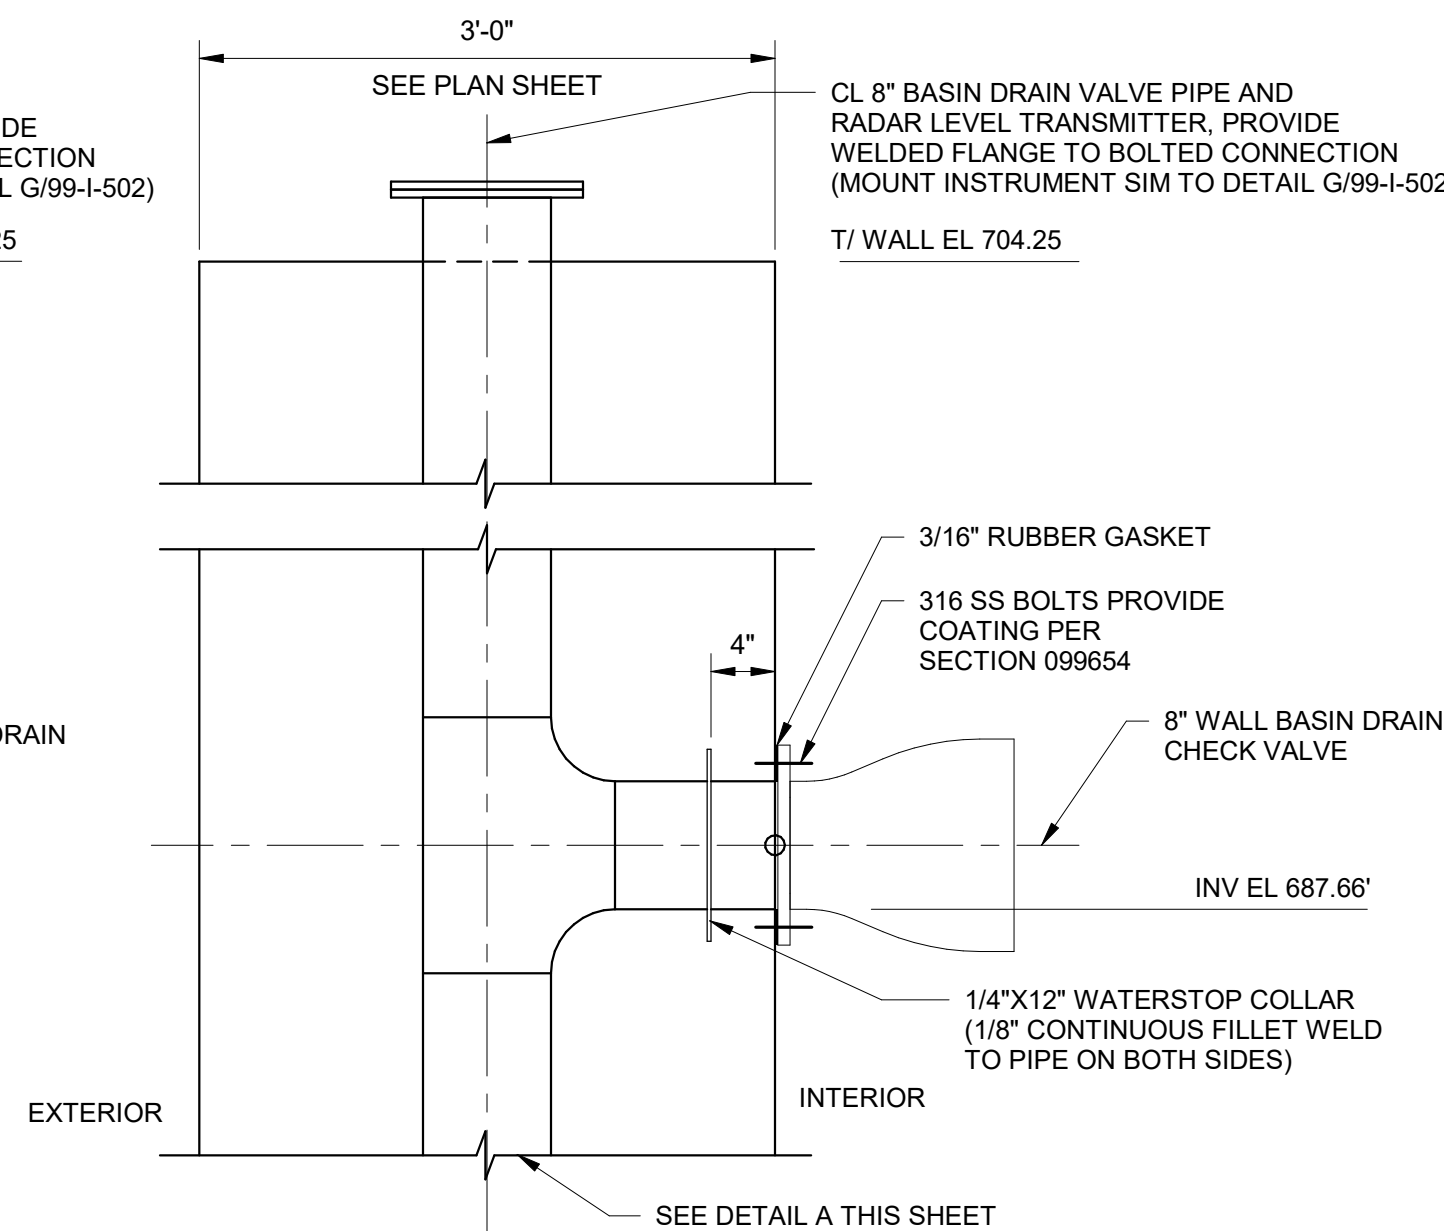


DETAIL AT EAST AND WEST WALLS
1" = 1'-0"

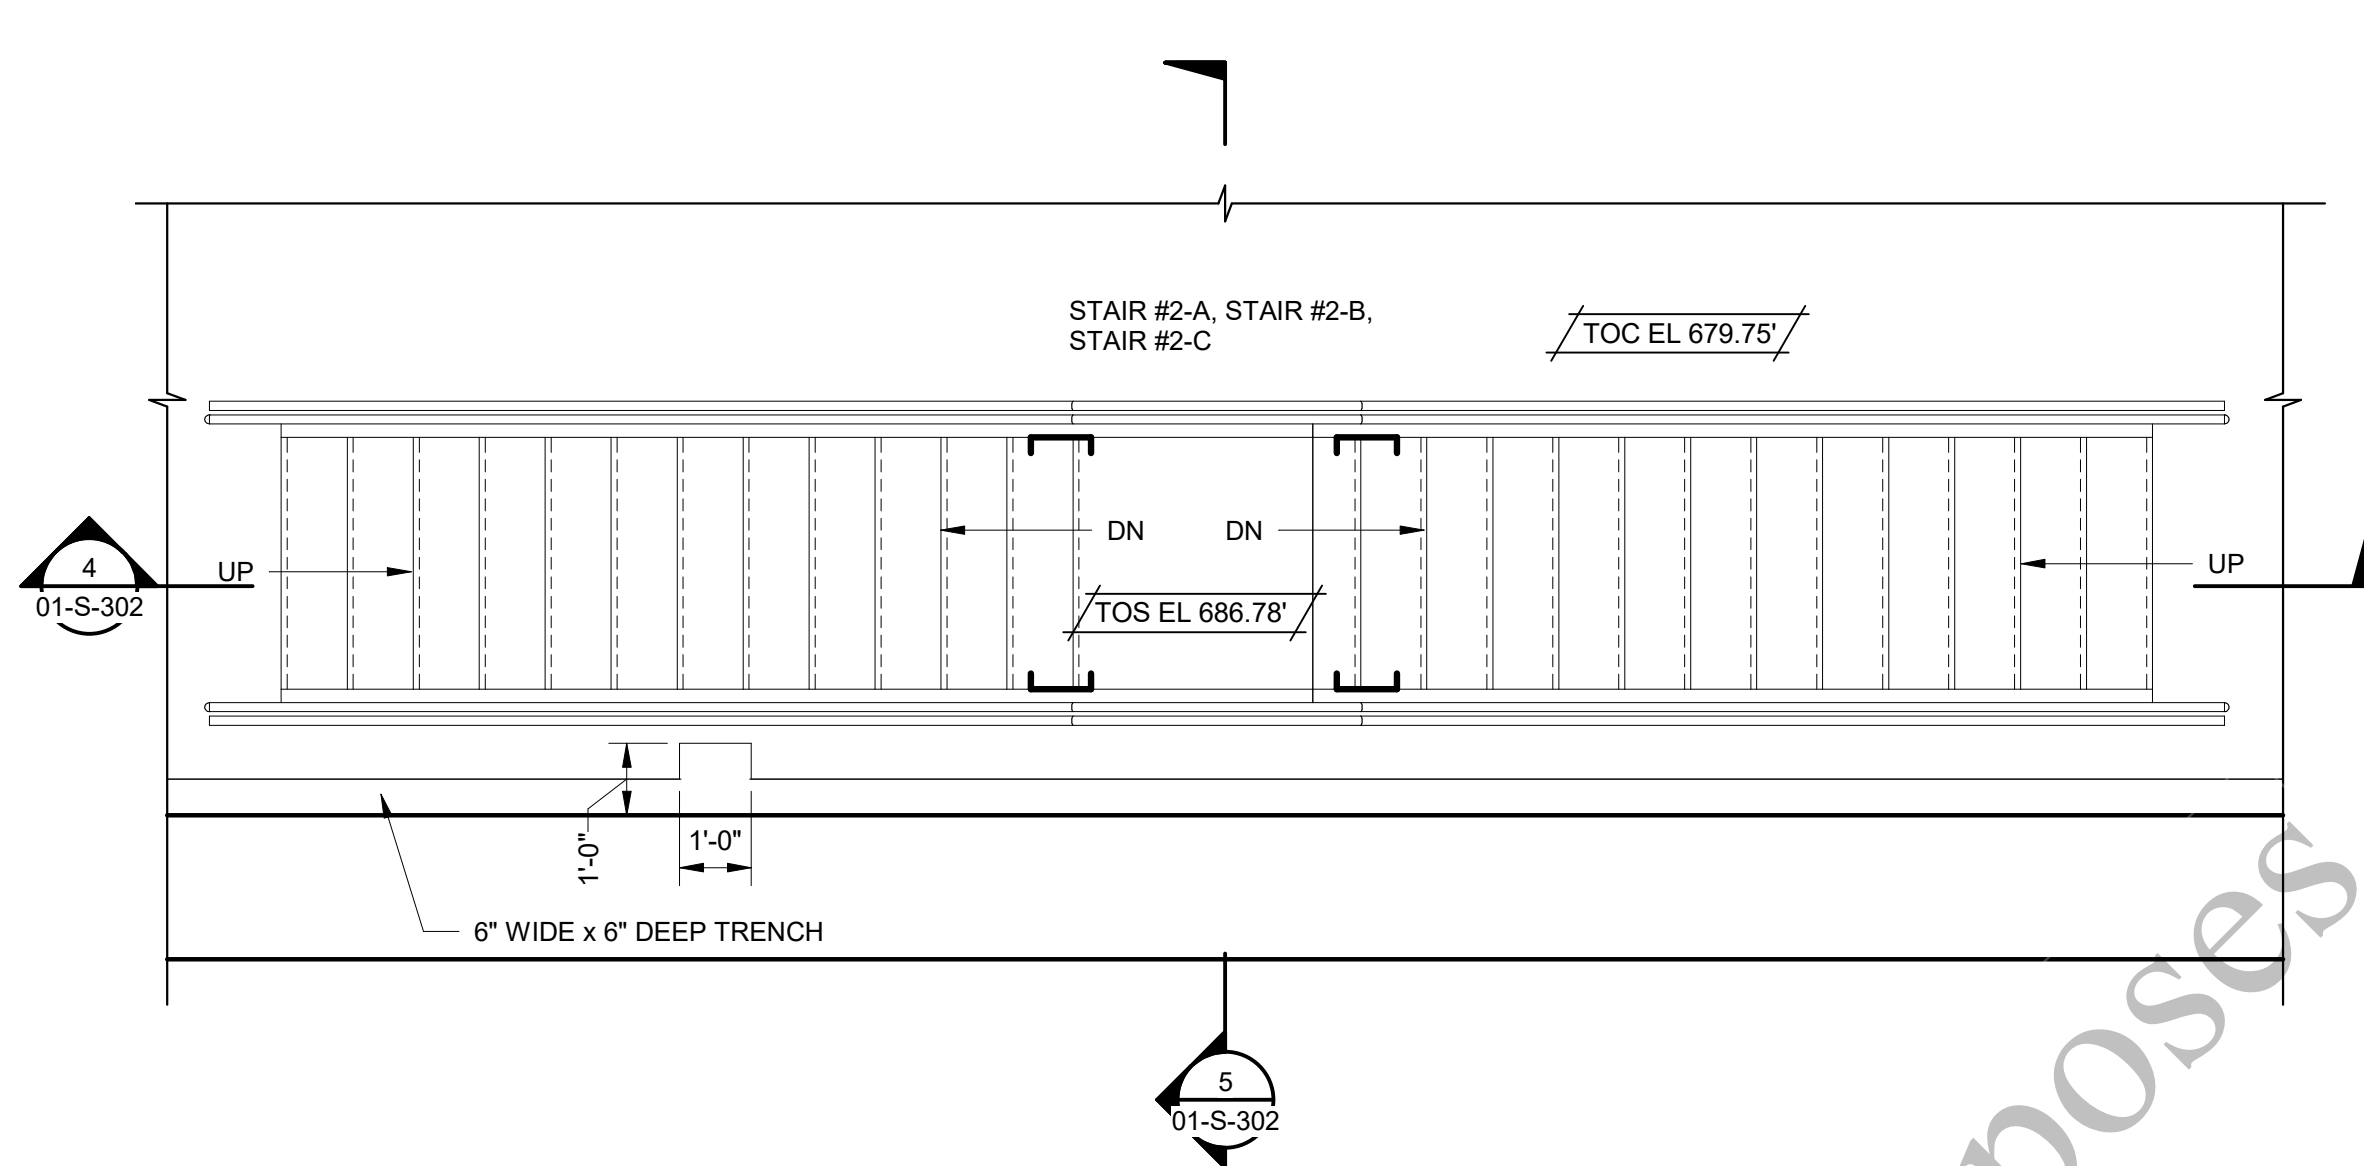


DETAIL
01-S-101 3/8" = 1'-0"

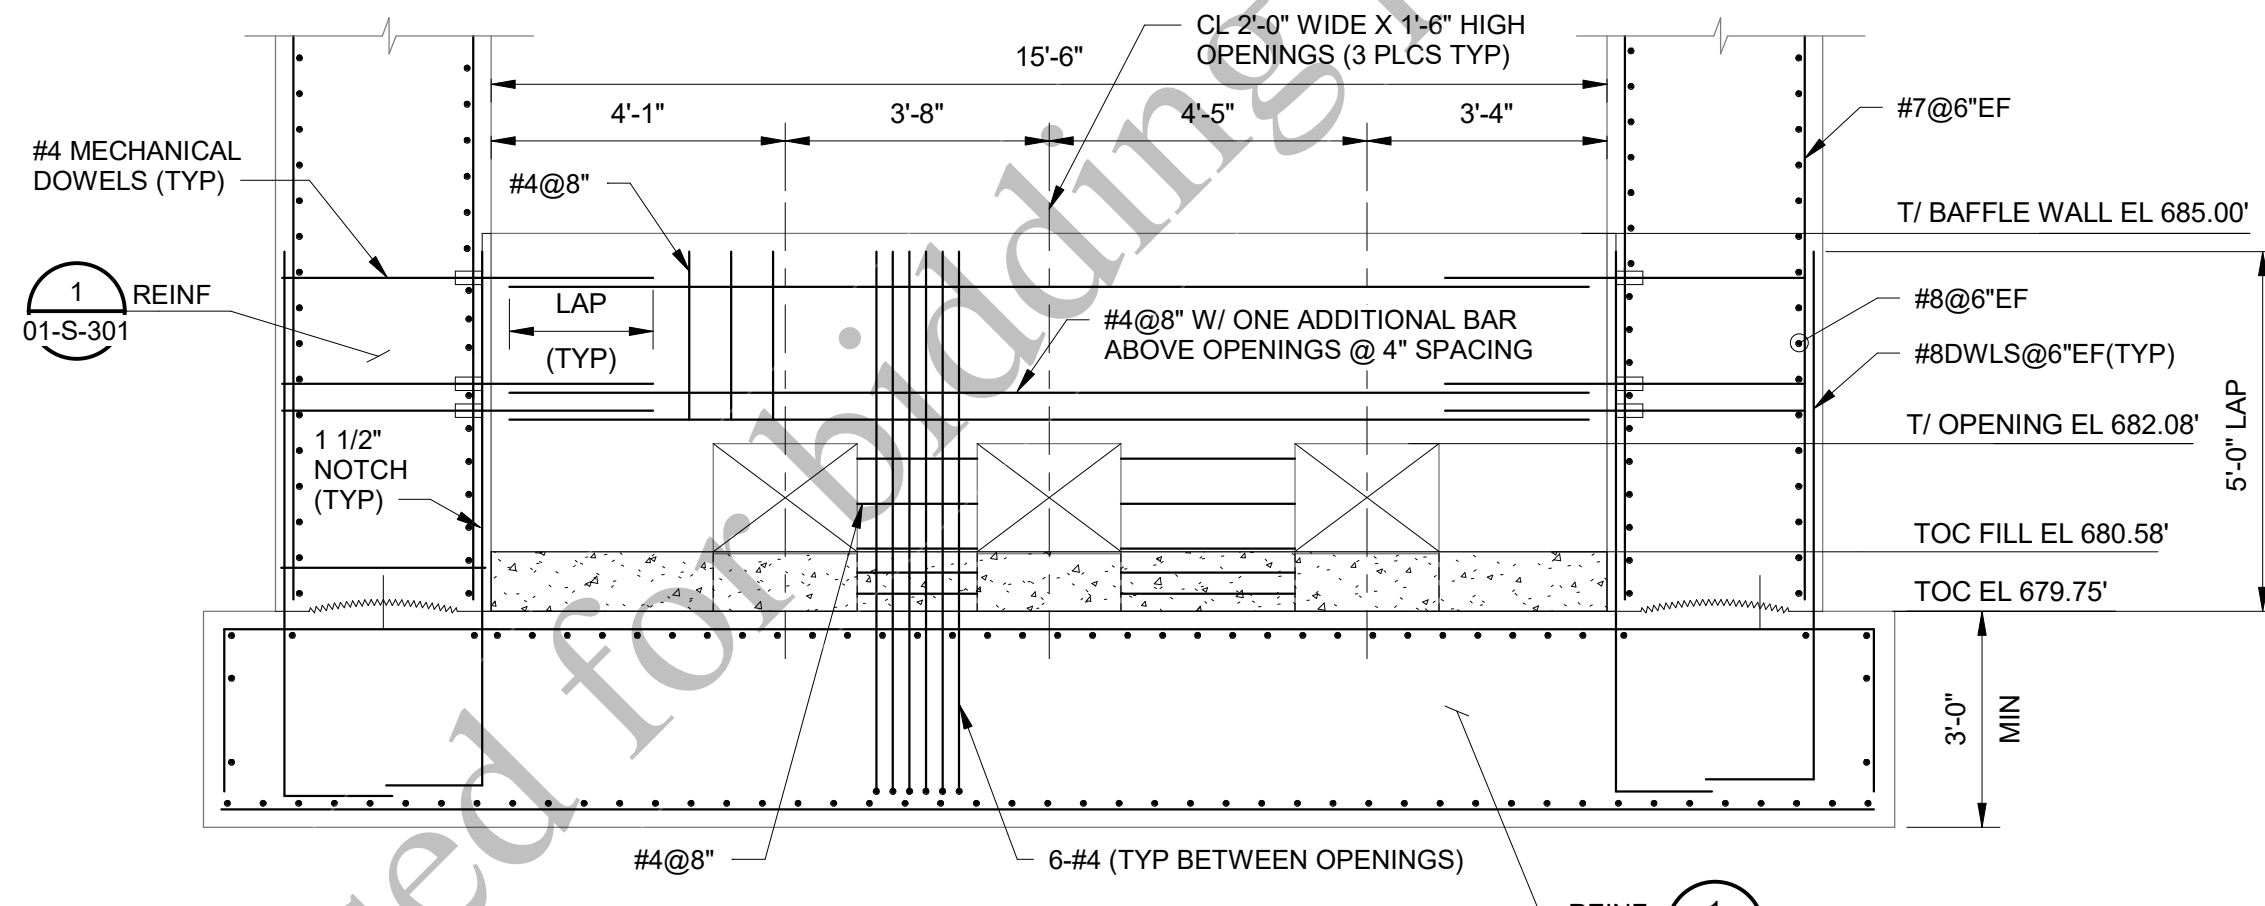


SECTION 1
01-S-101 3/8" = 1'-0"

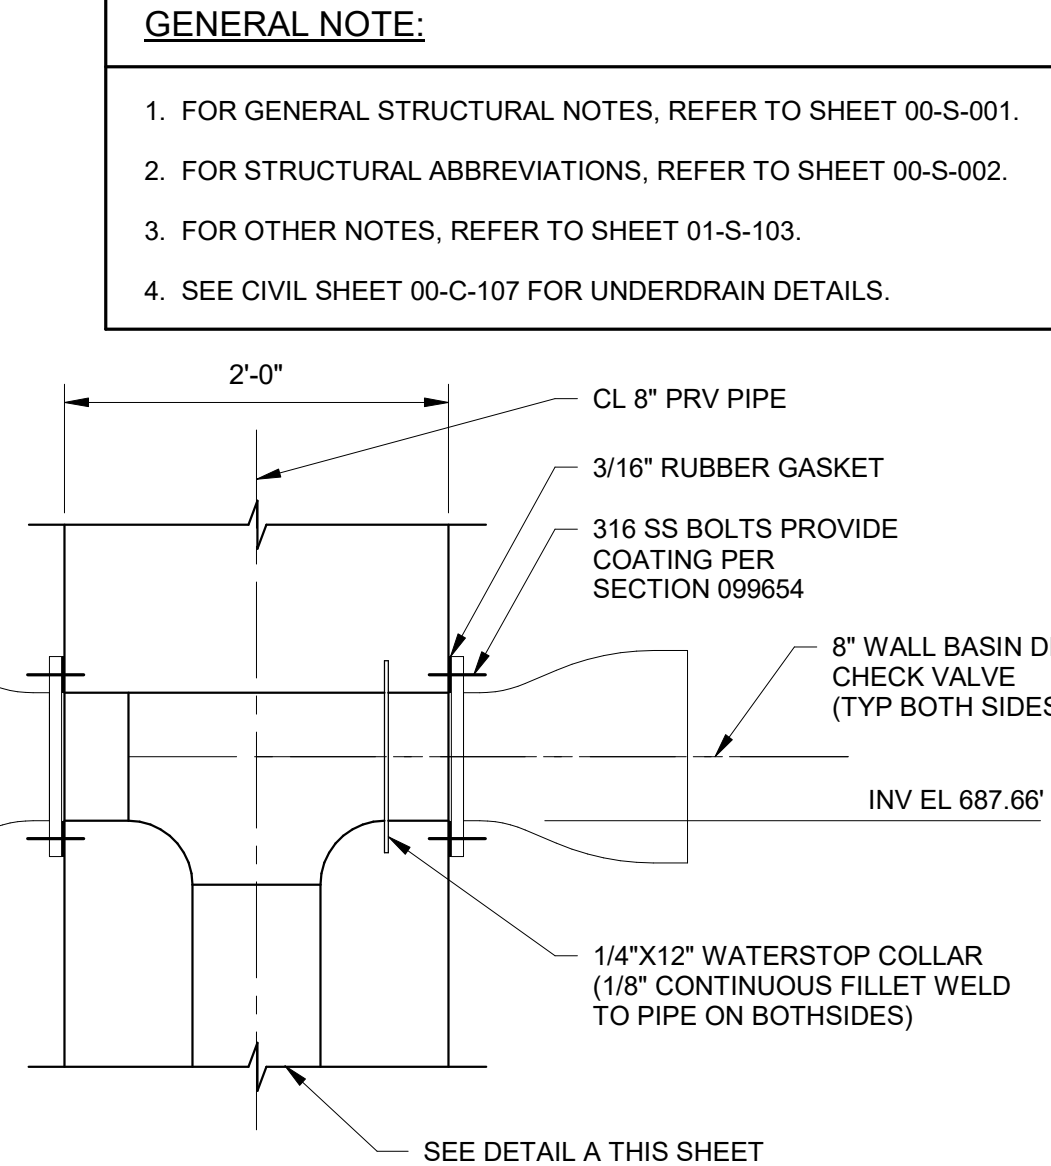


AT COMMON WALL W/ BASIN DRAIN VALVES ON BOTH SIDES
1" = 1'-0"

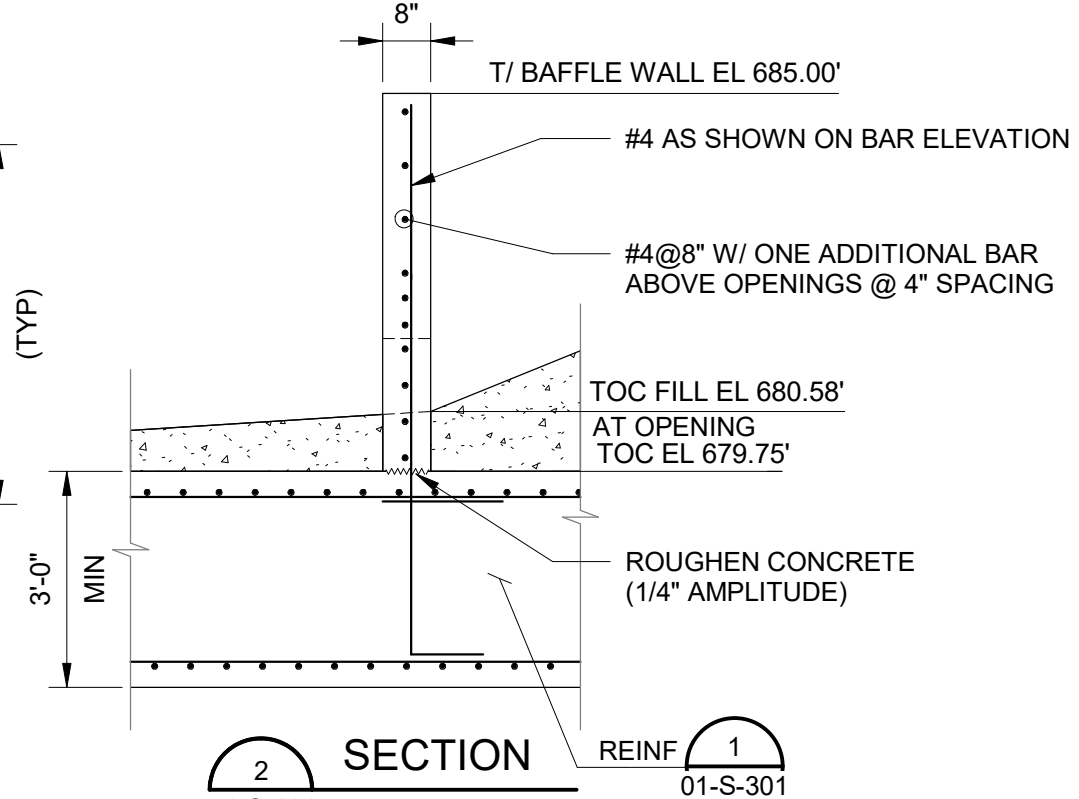


SECTION 2
01-S-101 3/8" = 1'-0"

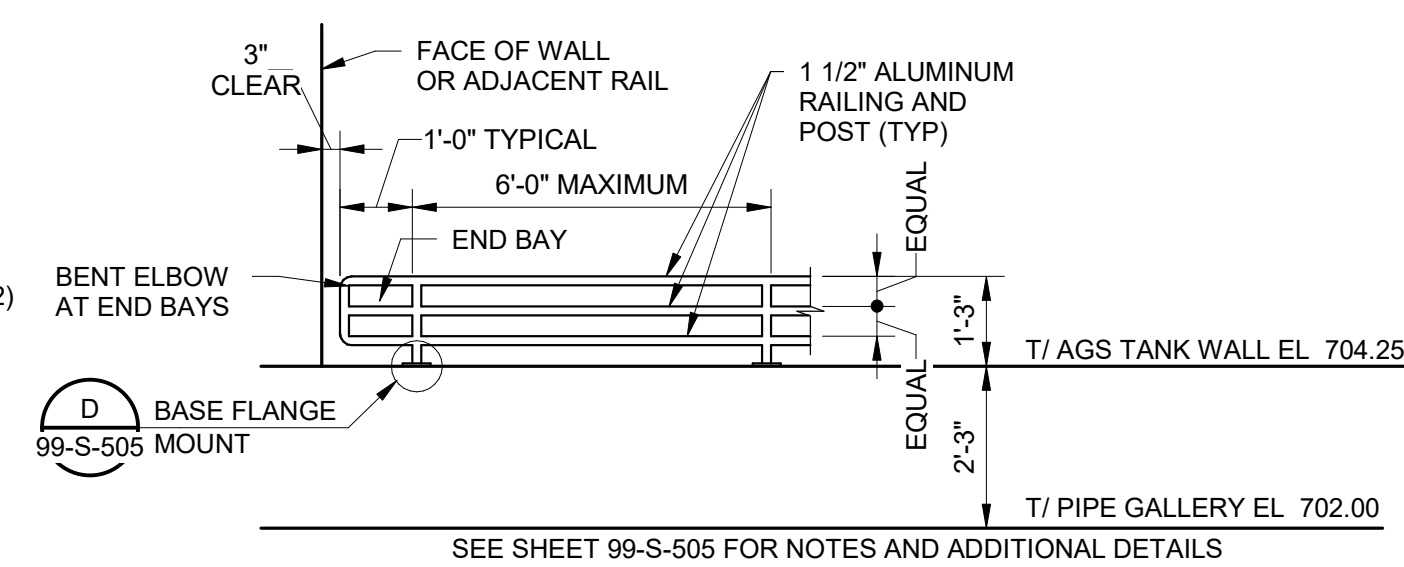

1'-3" TALL GUARDRAIL DETAIL
3/8" = 1'-0"

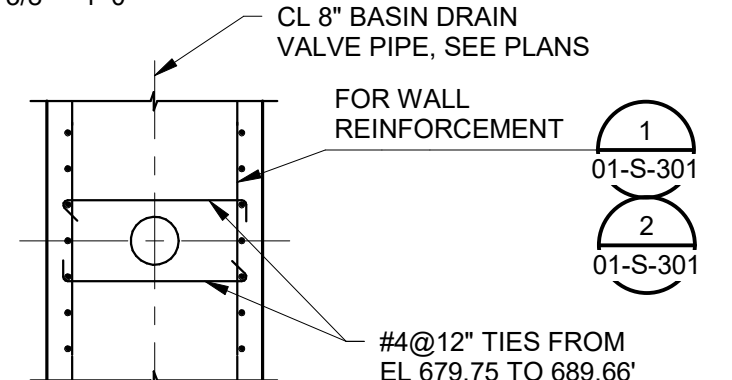

SECTION 3
3/8" = 1'-0"

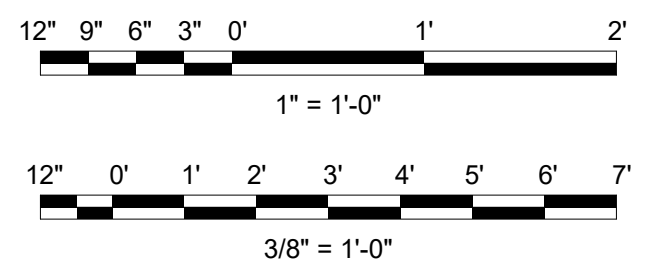

(SCALE BAR IS 4" AT FULL SCALE) 0 1/2 1 2 3 4

- GENERAL NOTE:**
1. FOR GENERAL STRUCTURAL NOTES, REFER TO SHEET 00-S-001.
 2. FOR STRUCTURAL ABBREVIATIONS, REFER TO SHEET 00-S-002.
 3. FOR OTHER NOTES, REFER TO SHEET 01-S-103.
 4. SEE CIVIL SHEET 00-C-107 FOR UNDERDRAIN DETAILS.



Black & Veatch Corporation
Chicago, Illinois
ILLINOIS PROFESSIONAL
DESIGN FIRM - 184.002143-0006



**AEROBIC GRANULAR
SLUDGE - PHASE 1**

REVISIONS AND RECORD OF ISSUE	
DESIGNED:	SKA
DETAILED:	UBS
CHECKED:	CG
APPROVED:	TNG
DATE:	12/20/2022
PROJECT NO.:	411752

**AGS REACTORS AND PIPE
GALLERY**

STRUCTURAL

**DETAILS
1 OF 2**

01-S-501

64
OF
164

AEROBIC GRANULAR
SLUDGE - PHASE 1







REVISIONS AND RECORD OF ISSUE	
DESIGNED:	SKA
DETAILED:	UBS
CHECKED:	CG
APPROVED:	TNG
DATE:	12/20/2022
PROJECT NO.:	411752

LAGS REACTORS AND PIPE GALLERY


STRUCTURAL

DETAILS
2 OF 2

01-S-502

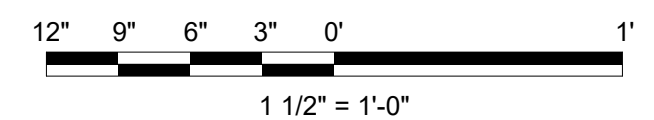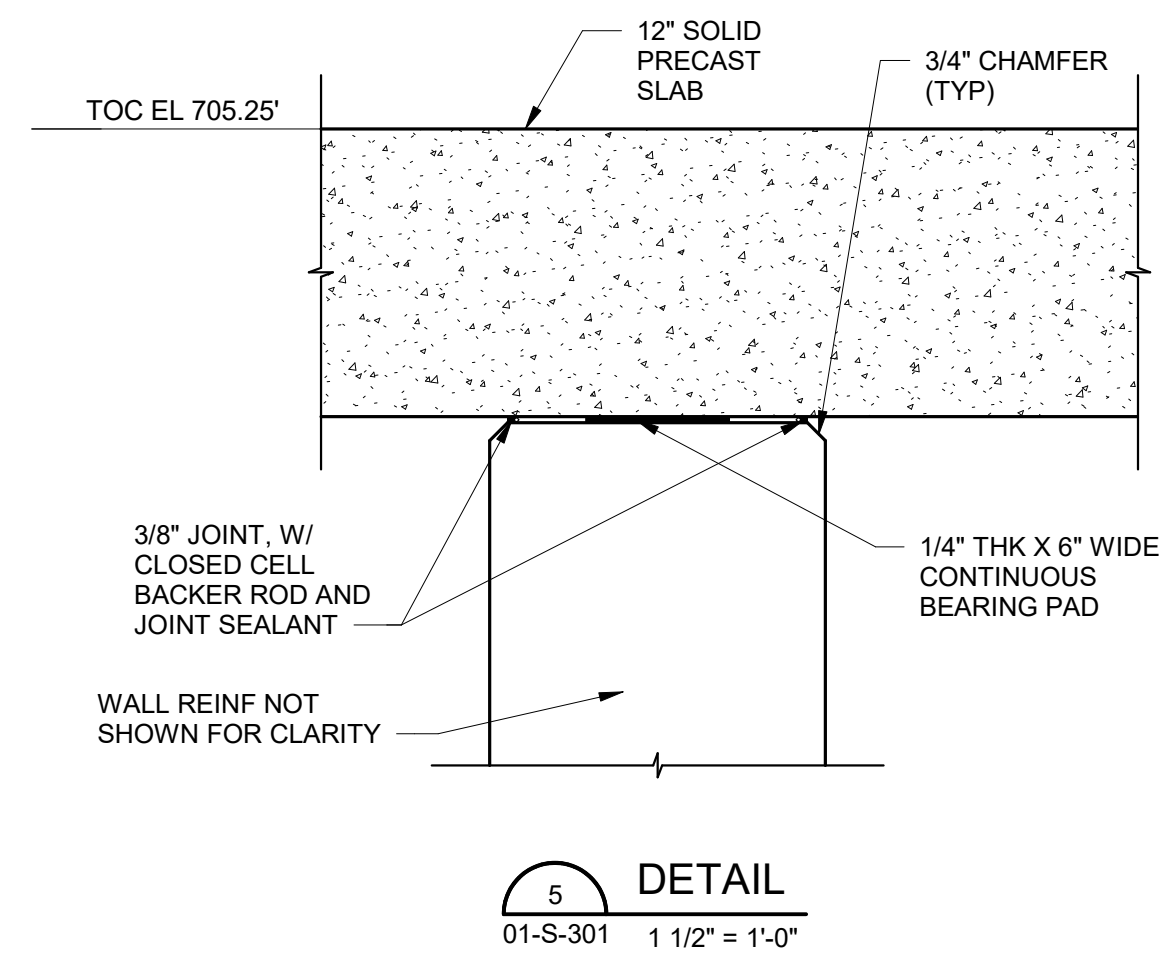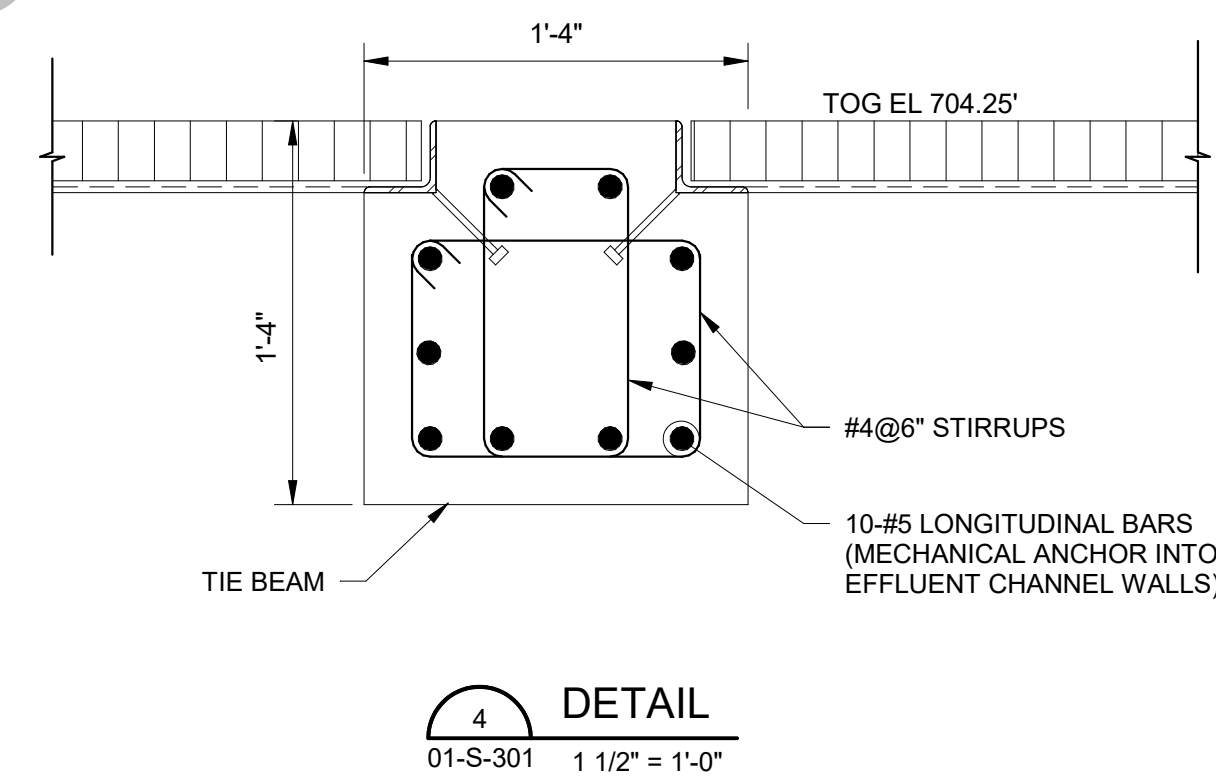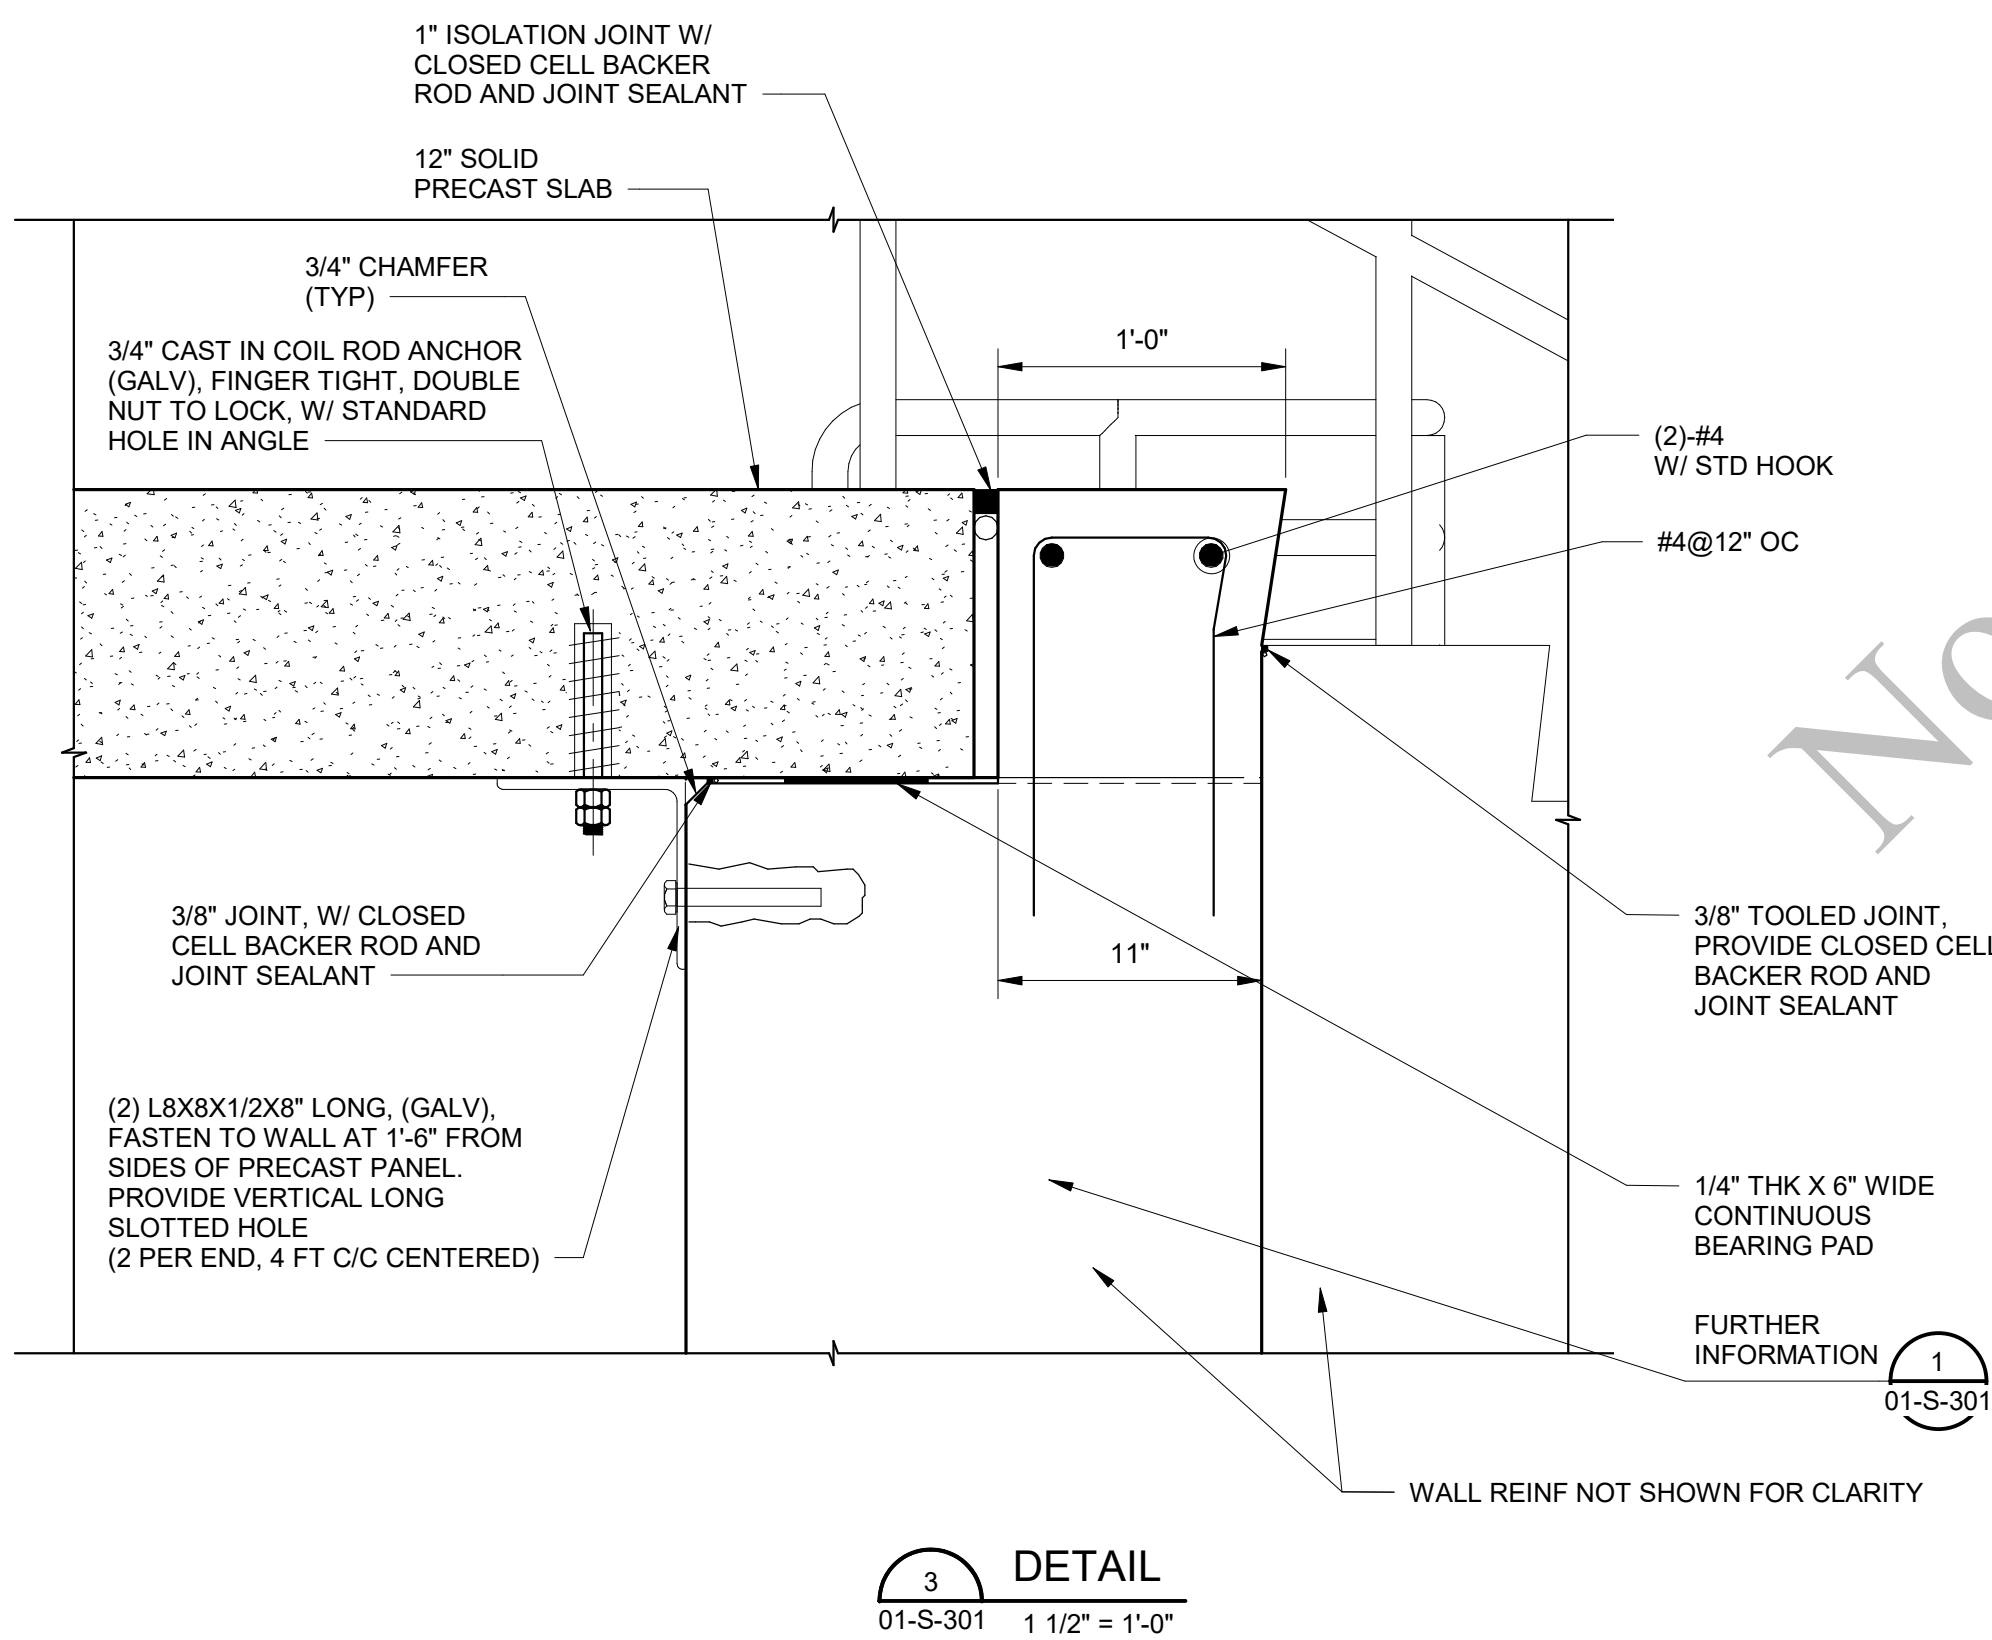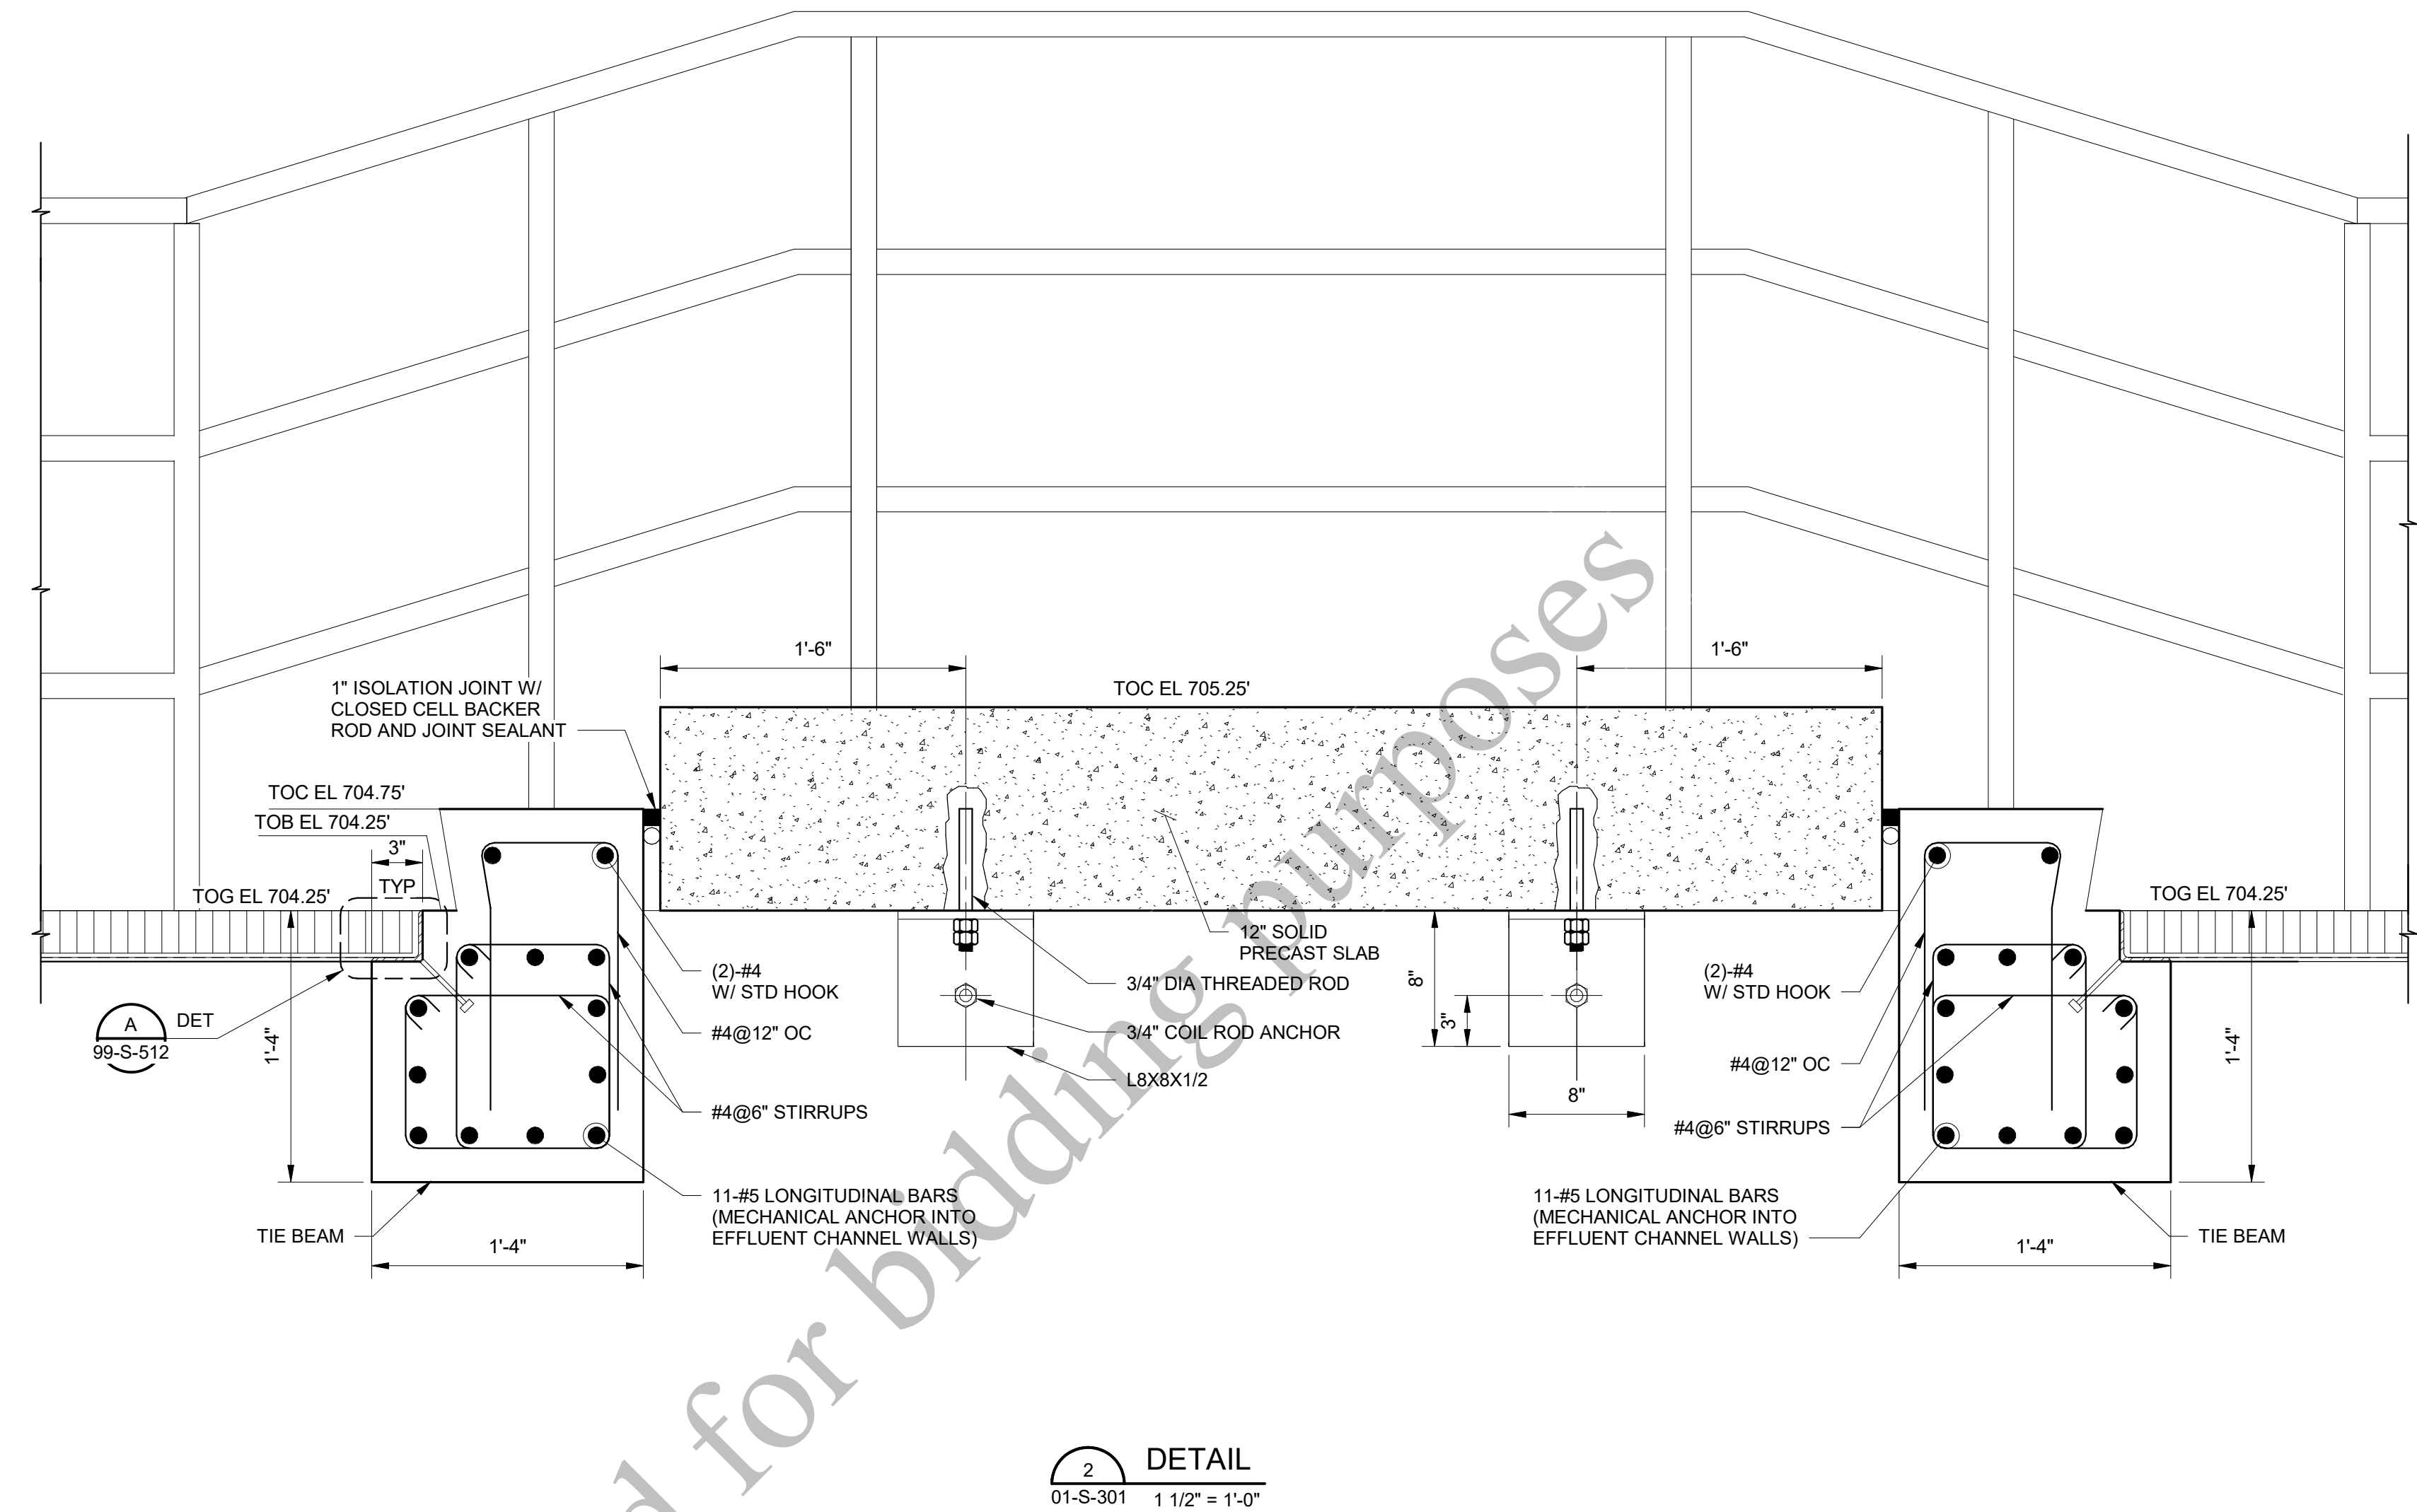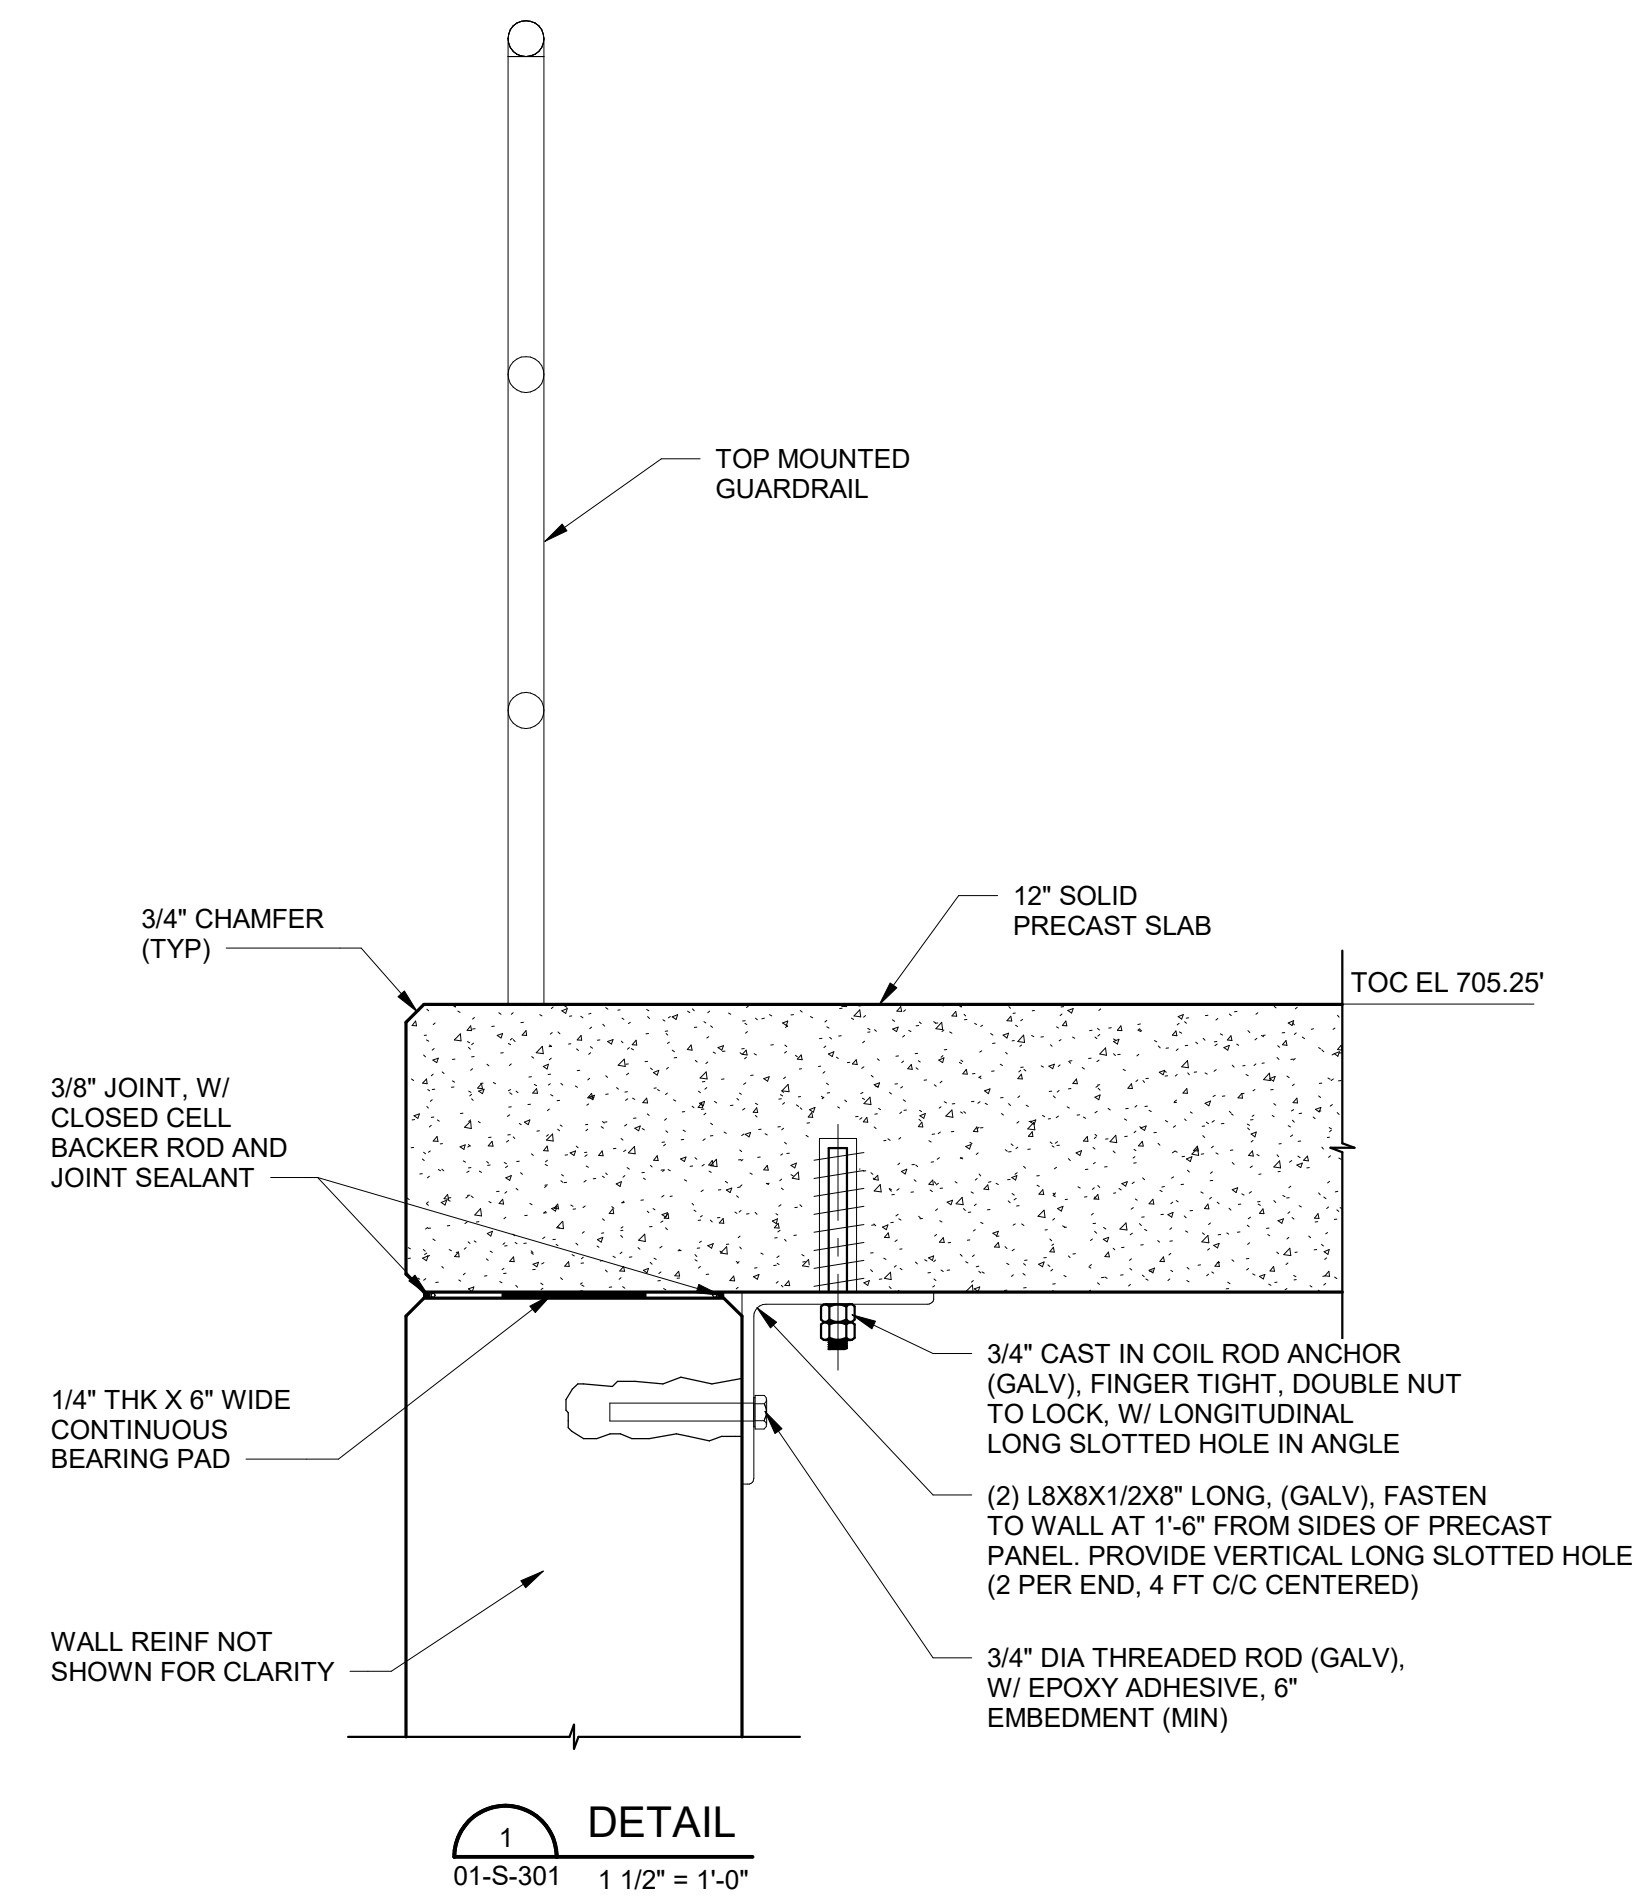

PLOTTED: 12/18/2022 11:47:24 AM
FILE: BIM 360/409469 - Aerobic Granular Sludge Phase 1/409469 - AGS.rvt
D11000

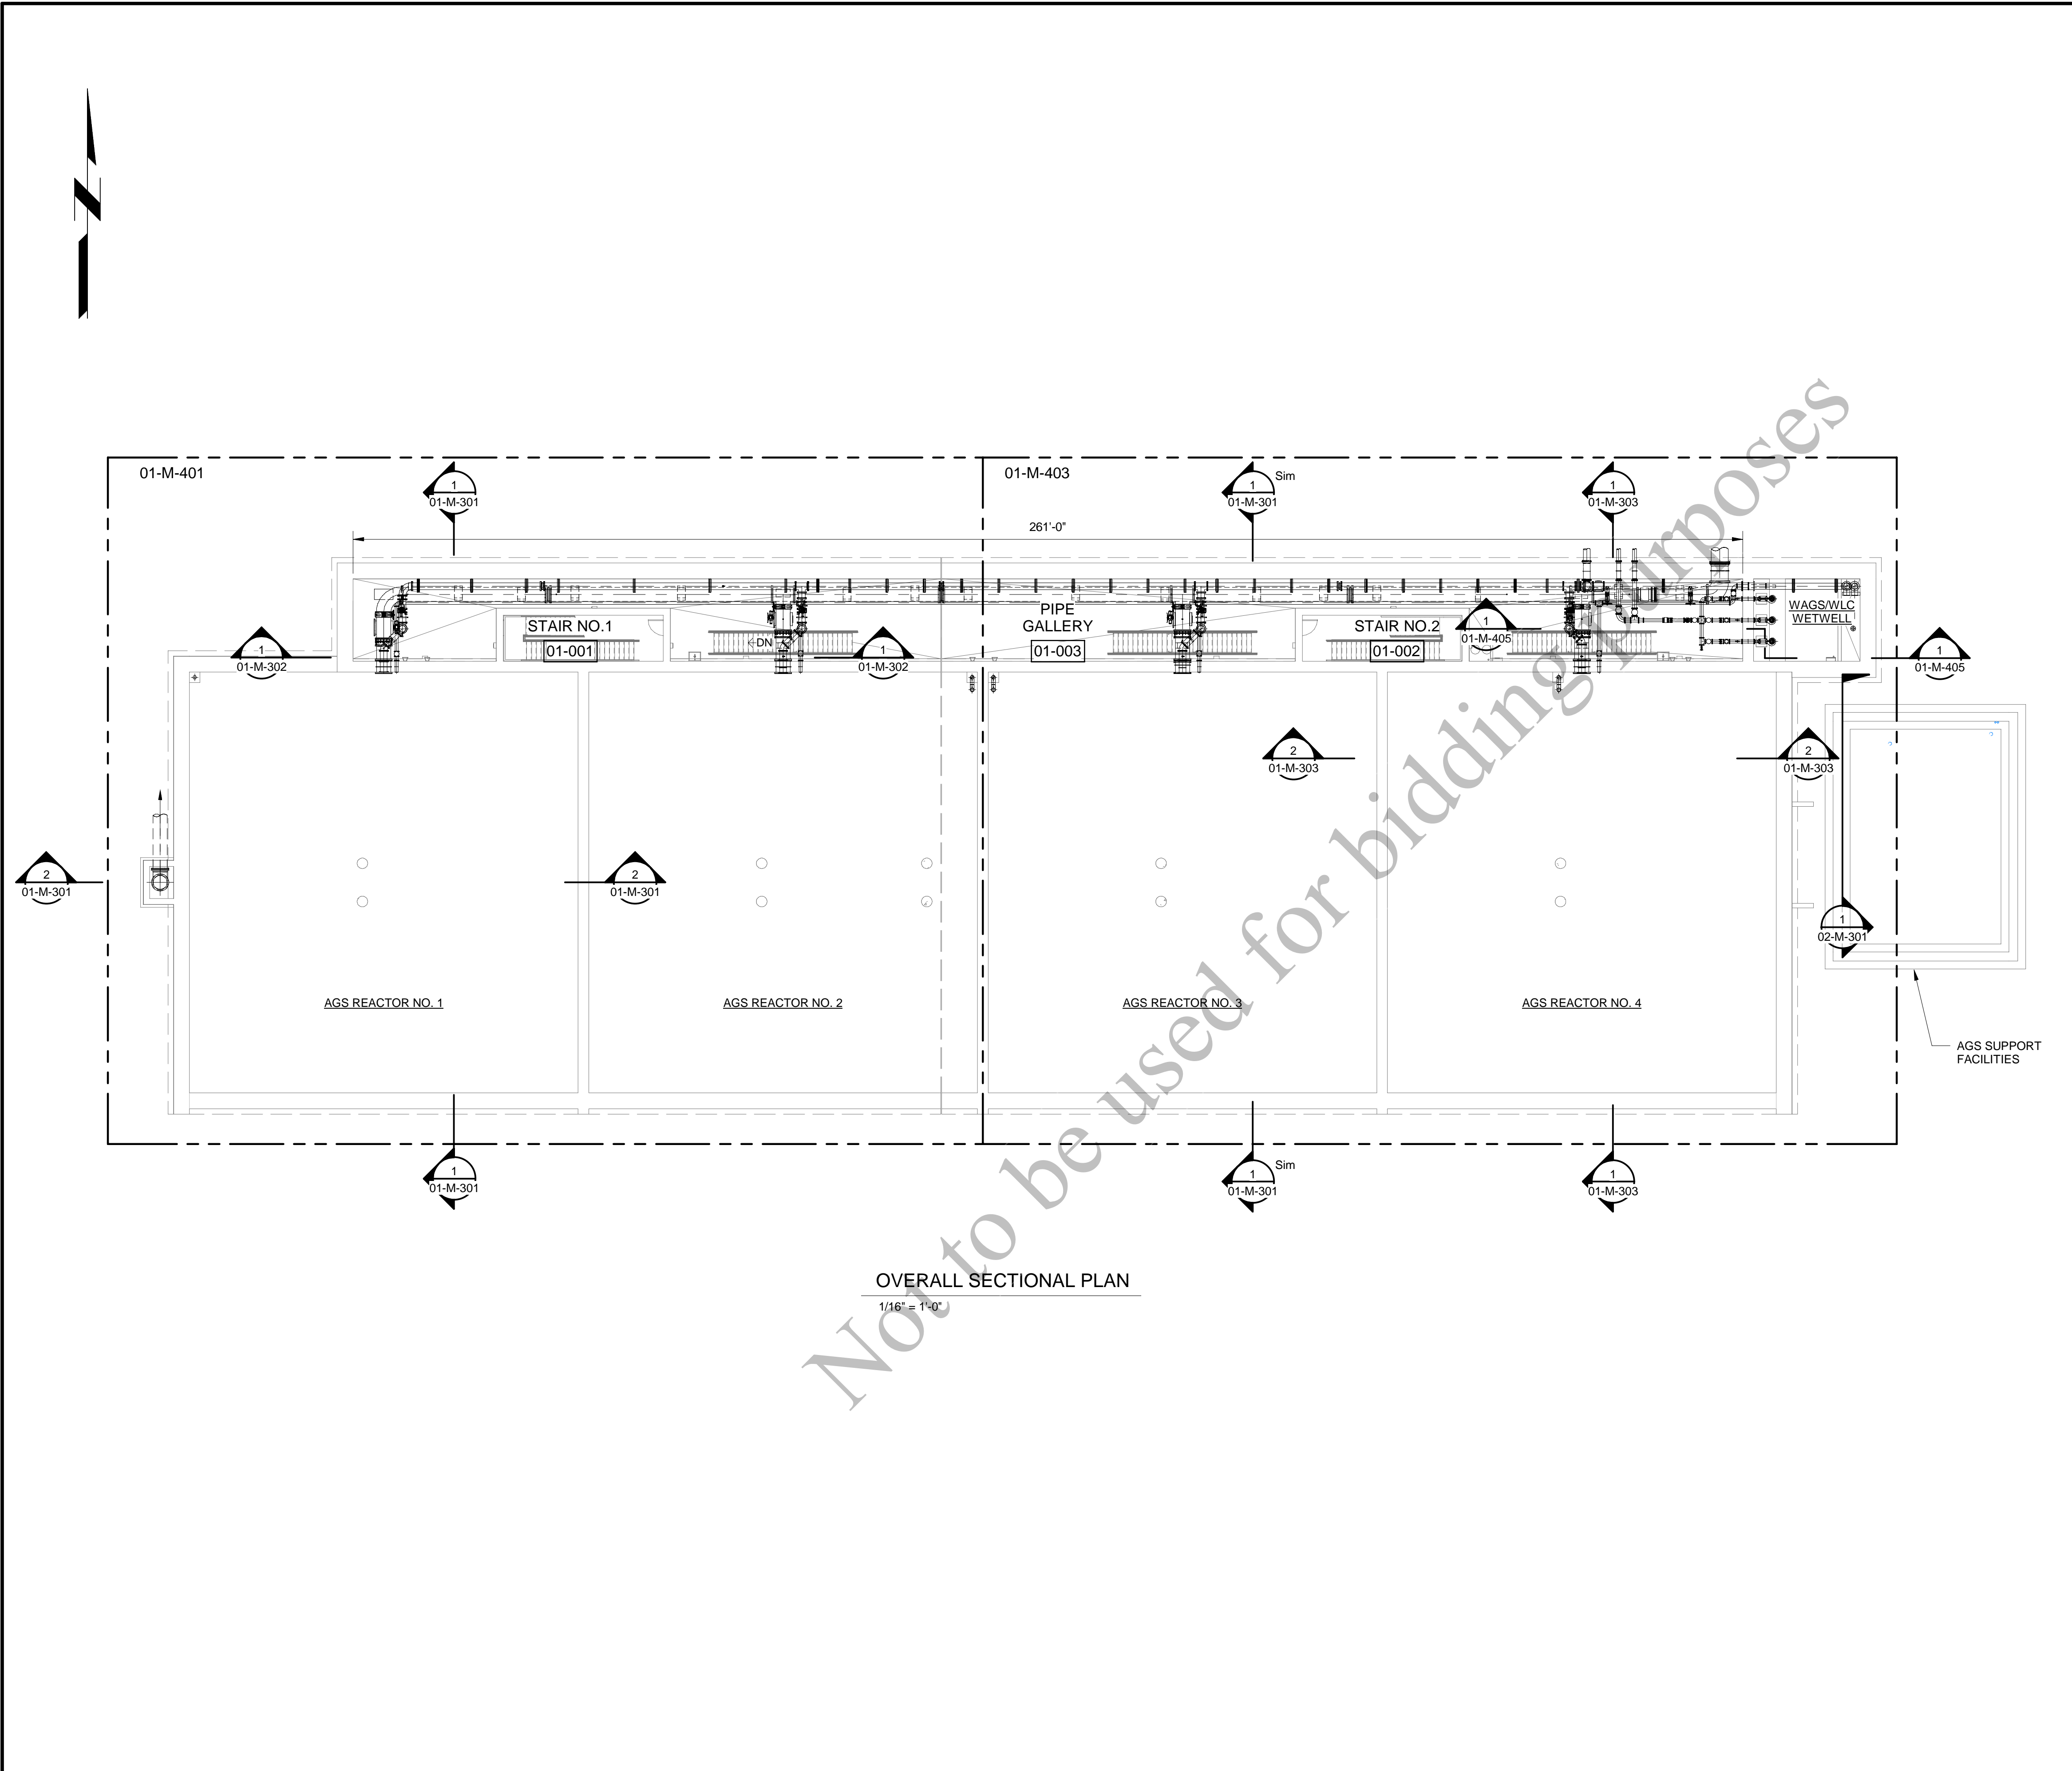

GENERAL SHEET NOTES

1. REFER TO ENLARGED PLANS FOR ADDITIONAL DETAIL.
2. ALL BLOWER INLET, BLOW-OFF AND DISCHARGE PIPING SHALL BE INSULATED AND JACKETED. REFER TO SECTION 40 42 11 - MECHANICAL INSULATION FOR REQUIREMENTS.



Black & Veatch Corporation
Chicago, Illinois
ILLINOIS PROFESSIONAL
DESIGN FIRM - 184.002143-0006



AEROBIC GRANULAR
SLUDGE - PHASE 1

REVISIONS AND RECORD OF ISSUE	
DESIGNED:	JL
DETAILED:	VP
CHECKED:	AM/JH
APPROVED:	MR
DATE:	12/20/2022
PROJECT NO.:	411752


AGS REACTORS AND PIPE
GALLERY

PROCESS MECHANICAL


OVERALL SECTIONAL
PLAN

01-M-101

66
OF
163

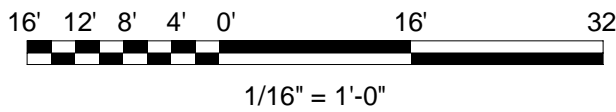

(SCALE BAR IS 4" AT FULL SCALE)

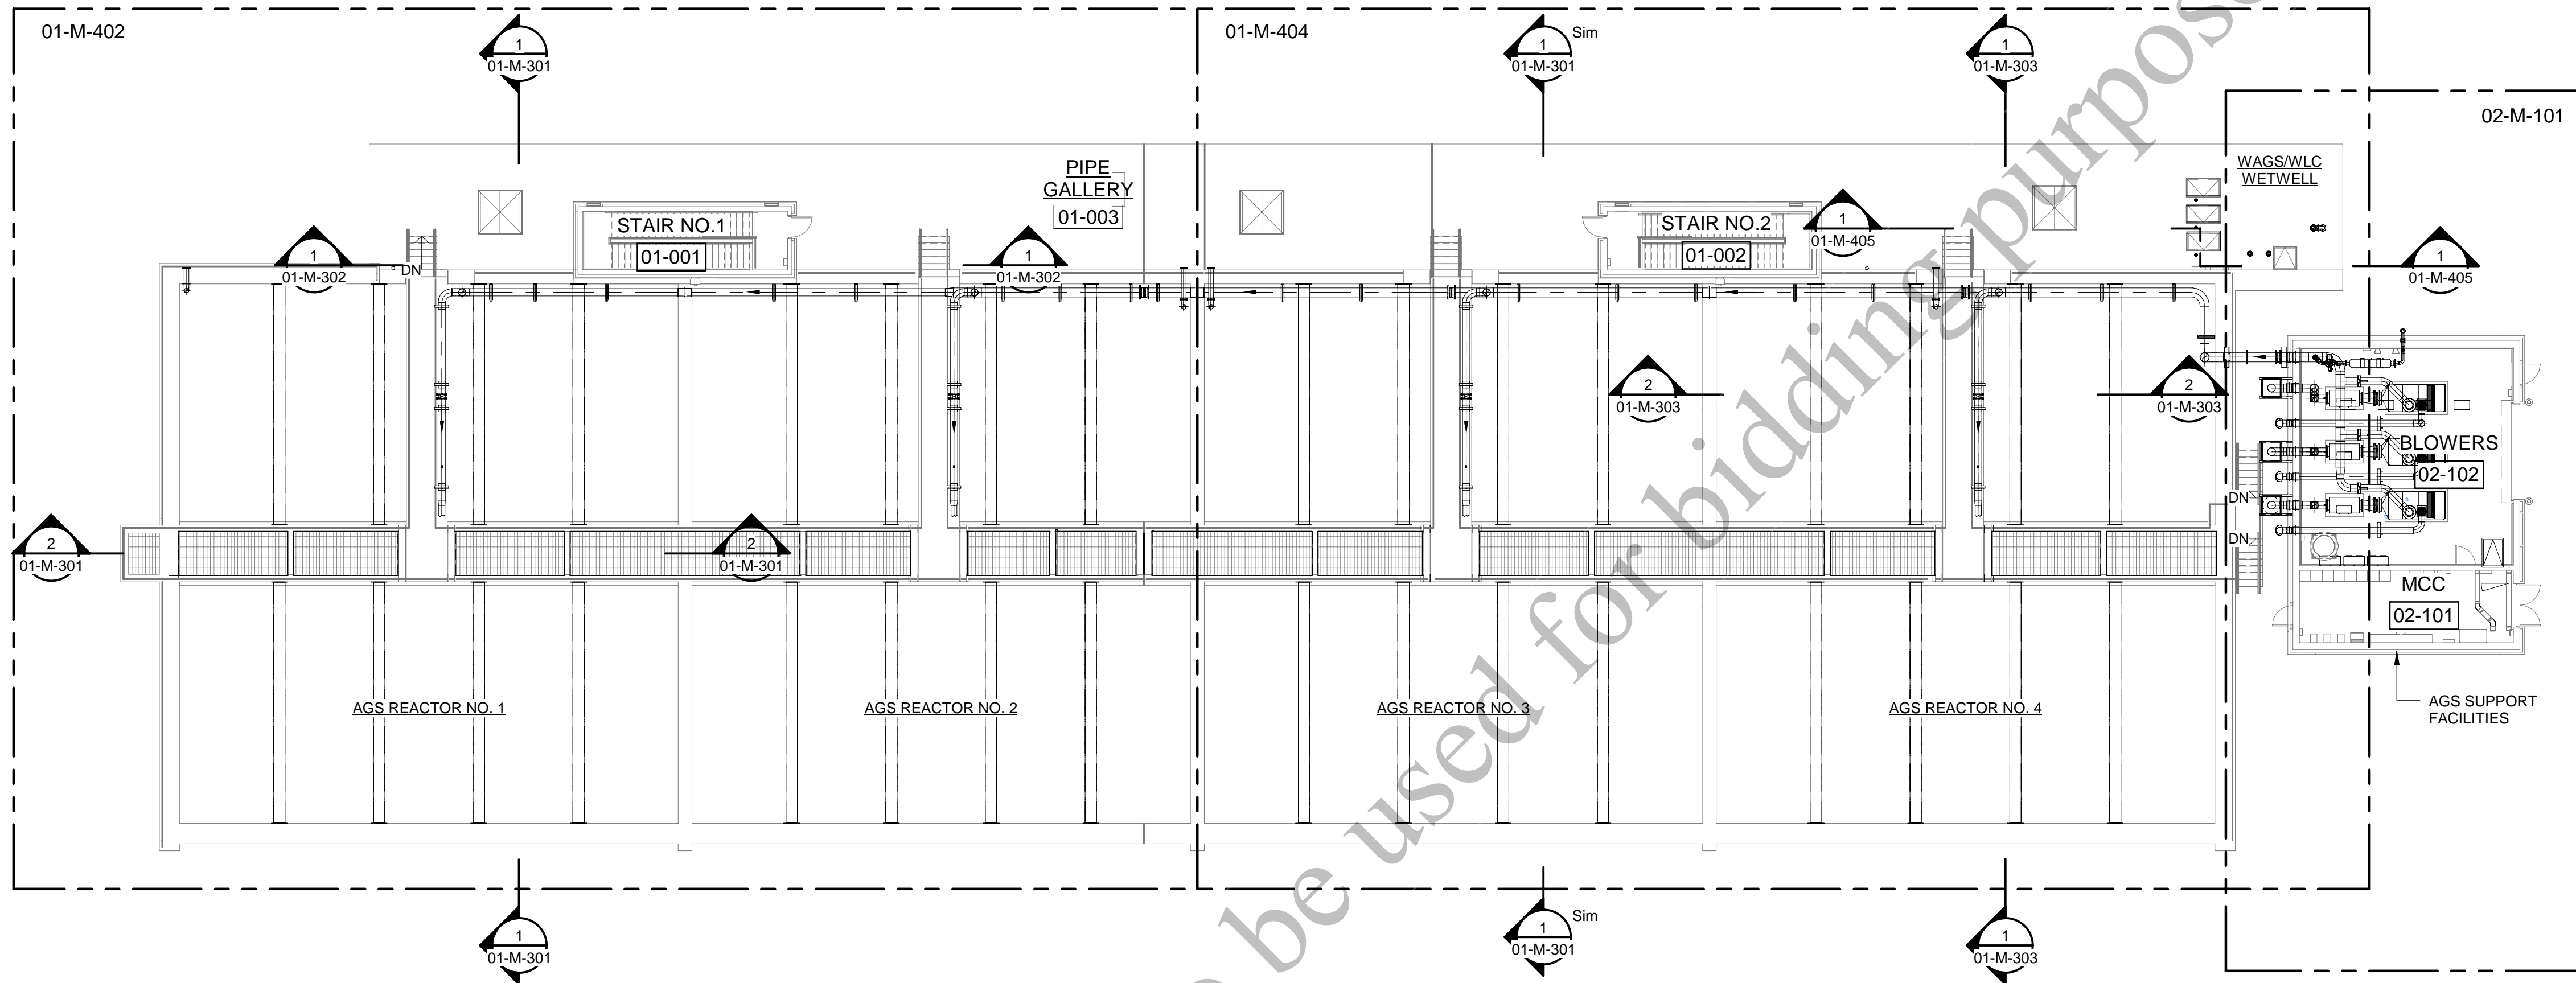

OVERALL TOP PLAN
1/16" = 1'-0"

GENERAL SHEET NOTES

1. REFER TO ENLARGED PLANS FOR ADDITIONAL DETAIL.
2. ALL BLOWER INLET, BLOW-OFF AND DISCHARGE PIPING SHALL BE INSULATED AND JACKETED. REFER TO SECTION 40 42 11 - MECHANICAL INSULATION FOR REQUIREMENTS.



Black & Veatch Corporation
Chicago, Illinois
ILLINOIS PROFESSIONAL
DESIGN FIRM - 184.002143-0006



AEROBIC GRANULAR
SLUDGE - PHASE 1

REVISIONS AND RECORD OF ISSUE	
DESIGNED:	JL
DETAILED:	VP
CHECKED:	AM/JH
APPROVED:	MR
DATE:	12/20/2022
PROJECT NO.:	411752


AGS REACTORS AND PIPE
GALLERY

PROCESS MECHANICAL

OVERALL TOP PLAN


01-M-102

67
OF
163

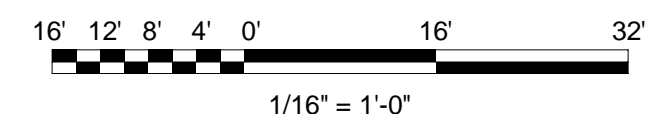

(SCALE BAR IS 4" AT FULL SCALE) 0 1/2 1 2 3 4

PLOTTED: 12/16/2022 11:48:07 AM
FILE: BIN 360/409469 - Aerobic Granular Sludge Phase 1/409469 - AGS.rvt
D11000

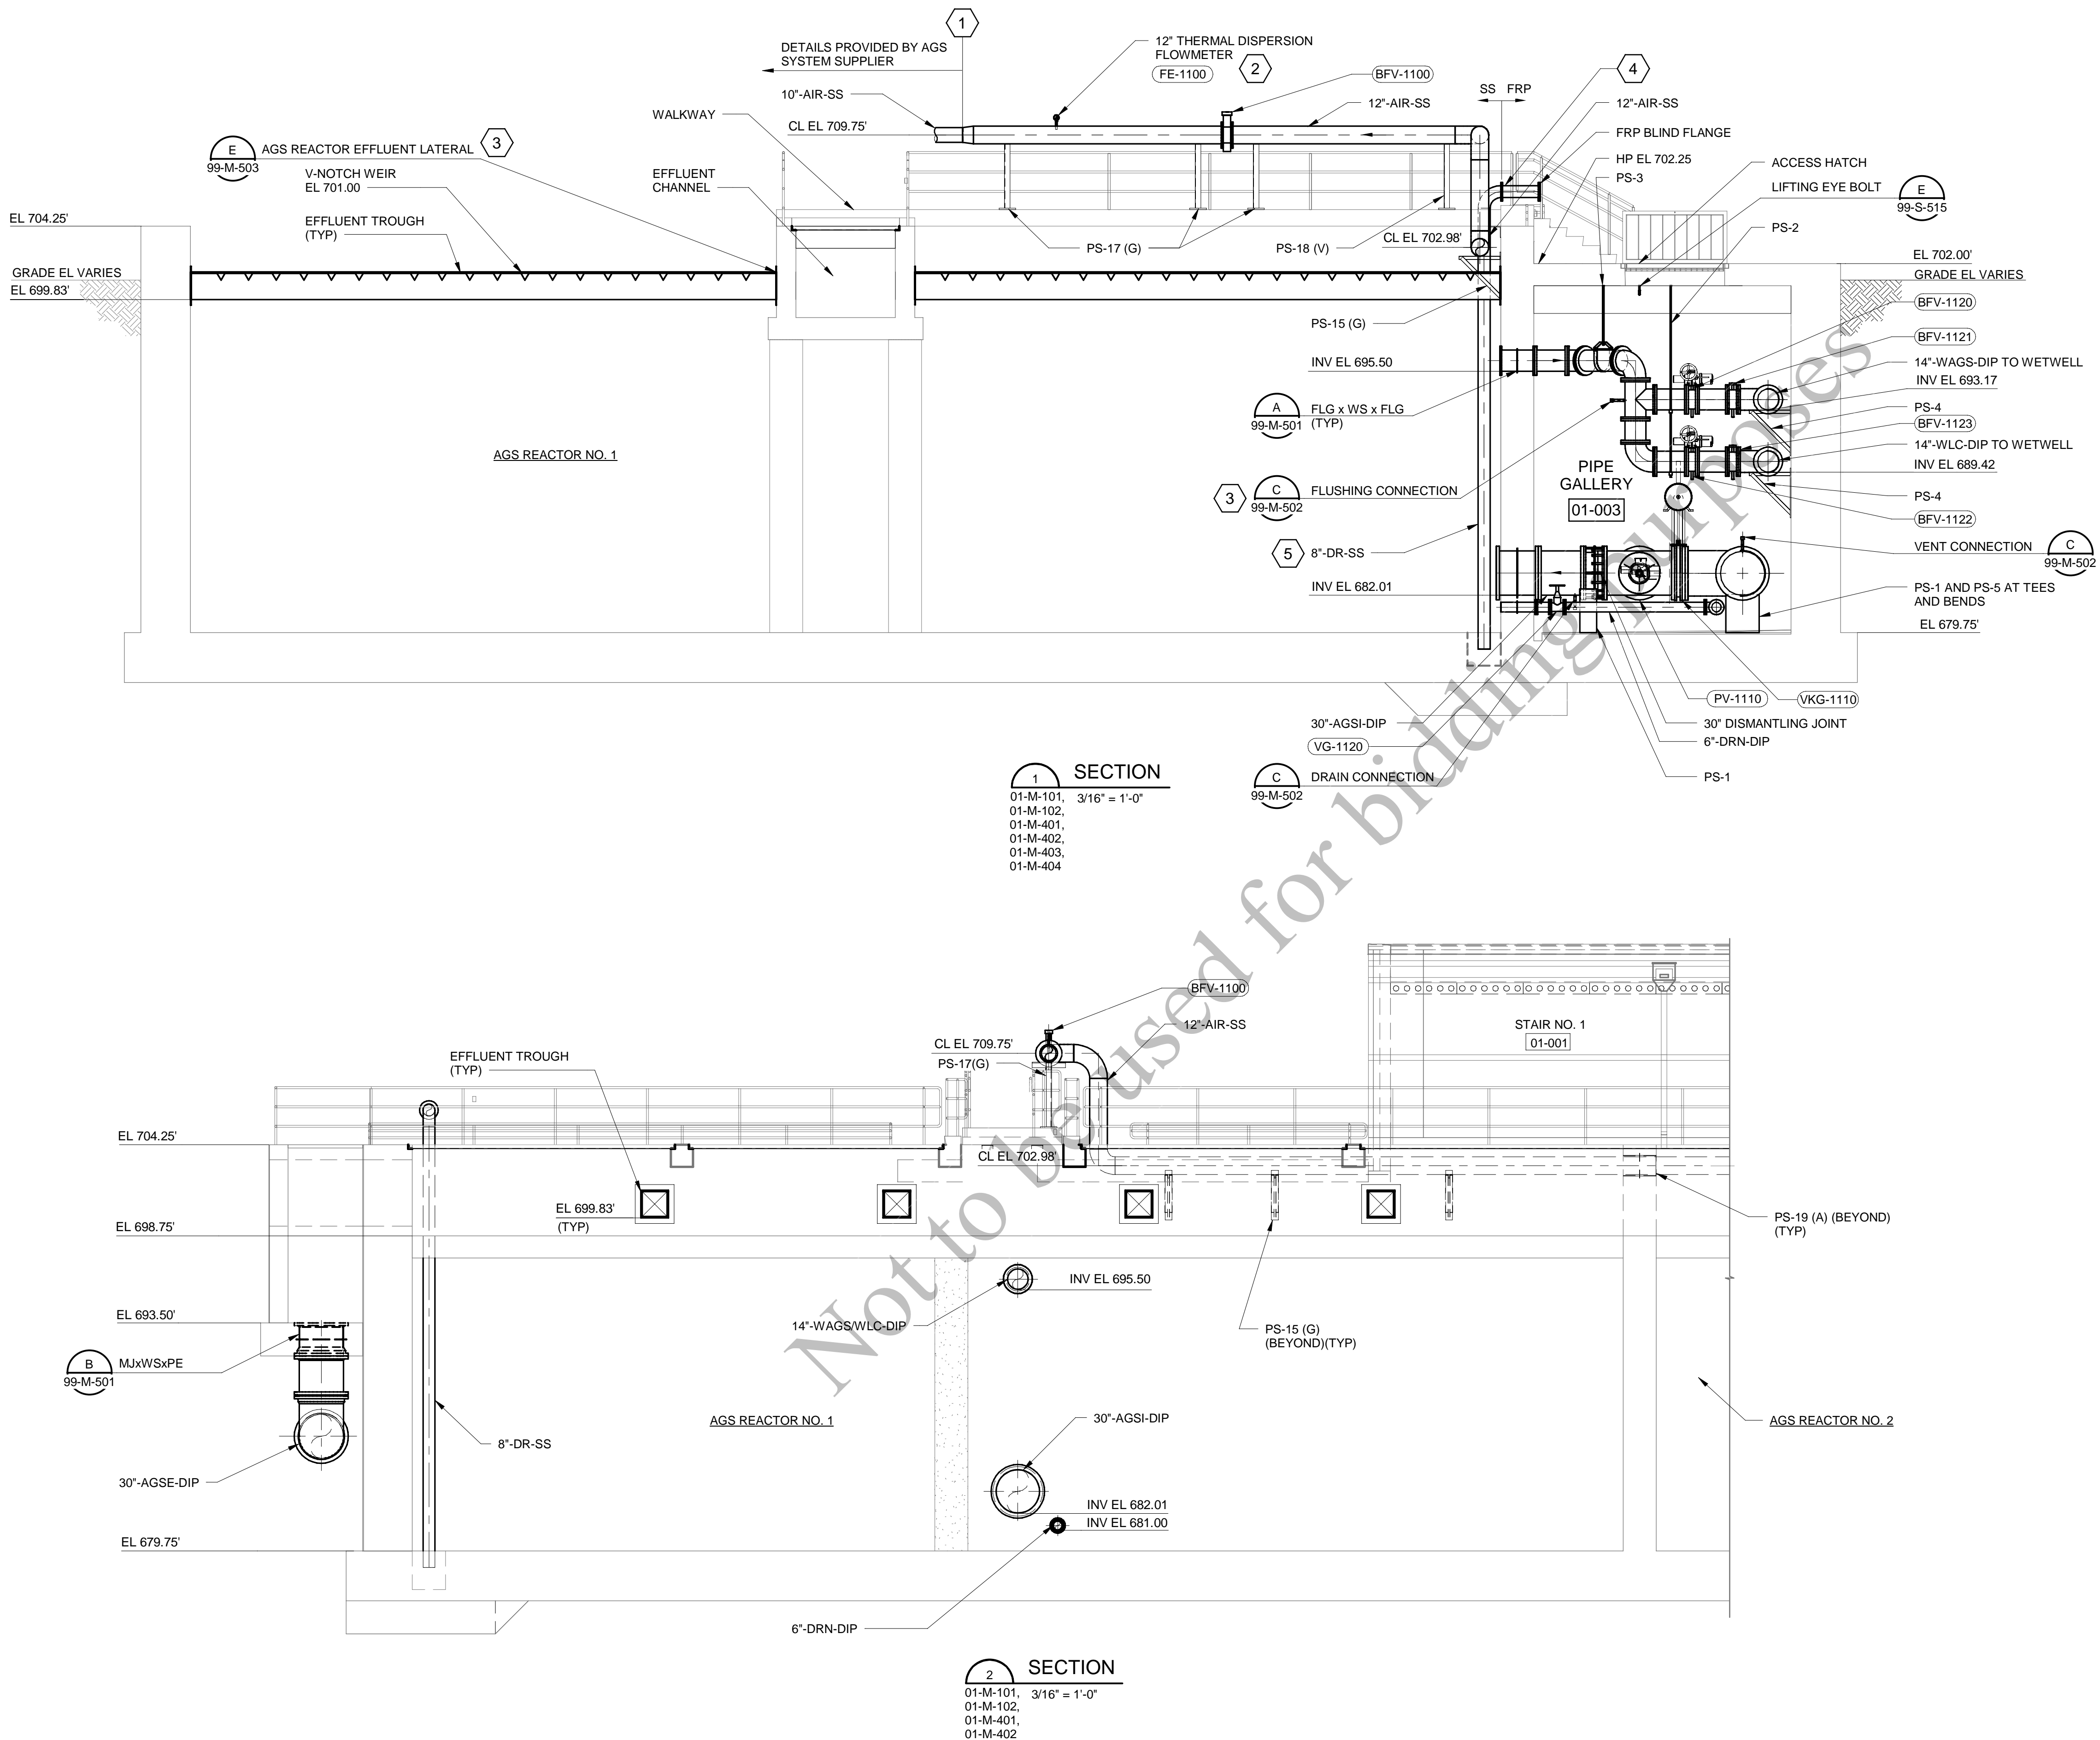

GENERAL SHEET NOTES

- AIR DIFFUSER LAYOUT AND CONNECTION DETAILS SHALL BE PROVIDED BY AGS SYSTEM SUPPLIER AFTER AWARD OF CONTRACT.
- AGS REACTOR TANK INTERNAL EQUIPMENT INCLUDING MANIFOLDS, TROUGHS, SUPPORTS AND DIFFUSERS ARE PROVIDED BY AGS SYSTEM SUPPLIER. FINAL EQUIPMENT AND PIPING LAYOUT IS PROPRIETARY AND SHALL BE AS PROVIDED IN VENDOR SUBMITTAL DRAWINGS. FINAL EQUIPMENT LIST AND QUANTITIES TO BE PROVIDED BY AGS SYSTEM SUPPLIER. REFER TO AGS SPECIFICATION AND SHEETS 99-M-502, 99-M-503, AND 99-M-504 FOR ADDITIONAL DETAIL.
- PS-X REPRESENTS PIPE SUPPORT TYPE. SEE PIPE SUPPORT SCHEDULE ON SHEET 99-M-502.

AIR PIPING SUPPORT TYPES ARE IDENTIFIED USING THE FOLLOWING DESIGNATIONS:
(G) : GUIDE SUPPORT
(A) : AXIAL STOP
(V) : VERTICAL SUPPORT
(SPR) : SPRING HANGER SUPPORT

- PIPE SUPPORTS TO BE ADJUSTED IN THE FIELD AS REQUIRED TO AVOID FLANGE LOCATIONS IN PIPES.

SHEET KEYNOTES

- REFER TO P&IDS AND EQUIPMENT SPECIFICATION FOR ADDITIONAL INFORMATION ON AGS SYSTEM SUPPLIER SCOPE. DETAILED PIPE ROUTING AND EQUIPMENT LOCATIONS TO BE PROVIDED BY SUPPLIER AFTER AWARD OF CONTRACT. AGS SYSTEM SUPPLIER IS RESPONSIBLE FOR PIPE SUPPORTS WITHIN THE PIPING PROVIDED BY THE AGS SYSTEM SUPPLIER.
- THERMAL DISPERSION FLOWMETER PROVIDED BY AGS SYSTEM SUPPLIER. FLOWMETERS SHALL BE PROVIDED WITH MINIMUM UPSTREAM STRAIGHT RUN OF 10 PIPE DIAMETERS AND MINIMUM DOWNSTREAM STRAIGHT RUN OF 5 PIPE DIAMETERS.
- CONTRACTOR SHALL COORDINATE THE LOCATION AND SIZE OF EFFLUENT CHANNEL OPENINGS WITH THE AGS SYSTEM SUPPLIER.
- DRAIN PIPING SHOWN IS TYPICAL OF AGS REACTOR NO. 1. FOR AGS REACTORS NO. 2, 3, AND 4, CONTRACTOR SHALL ROUTE DRAIN PIPING TO AVOID AIR PIPING.
- SUPPORTS FOR DRAIN PIPING SHALL BE DUPLEX SS AND SHALL MEET THE REQUIREMENTS OF SECTION 40 05 07 PIPE SUPPORTS.



Black & Veatch Corporation
Chicago, Illinois
ILLINOIS PROFESSIONAL
DESIGN FIRM - 184.002143-0006



AEROBIC GRANULAR
SLUDGE - PHASE 1

REVISIONS AND RECORD OF ISSUE	
DESIGNED:	JL
DETAILED:	VP
CHECKED:	AM/JH
APPROVED:	MR
DATE:	12/20/2022
PROJECT NO.:	411752

AGS REACTORS AND PIPE
GALLERY


PROCESS MECHANICAL

REACTOR SECTIONS
1 OF 3

01-M-301

68
OF
163

(SCALE BAR IS 4" AT FULL SCALE) 0 1/2 1 2 3 4

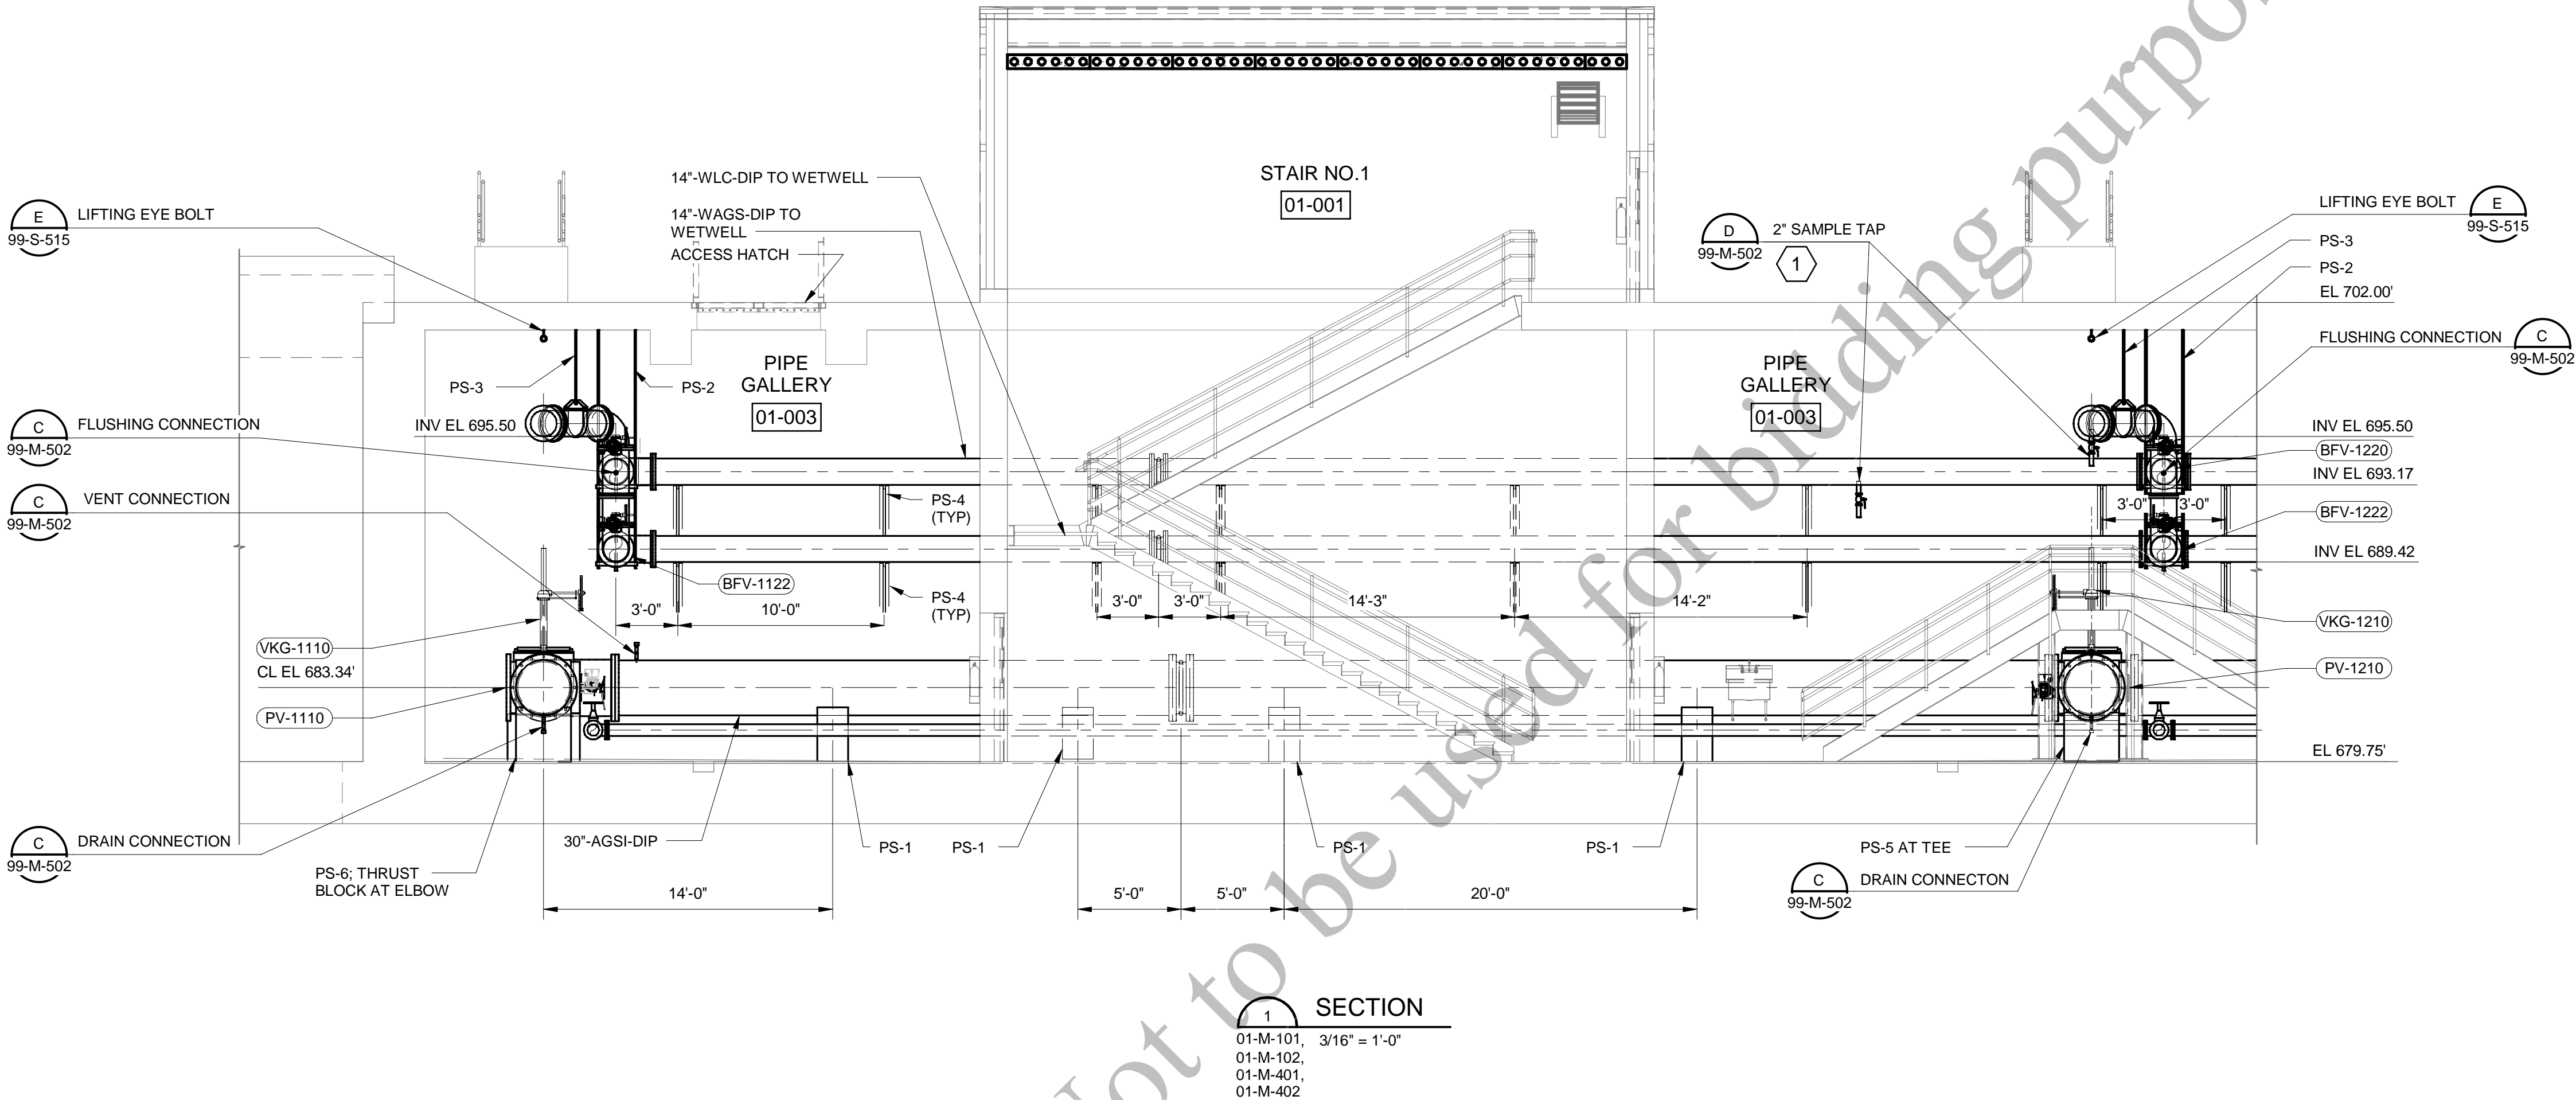

GENERAL SHEET NOTES

- PIPE SUPPORTS TO BE ADJUSTED IN THE FIELD AS REQUIRED TO AVOID FLANGE LOCATIONS IN PIPES.
 - PS-X REPRESENTS PIPE SUPPORT TYPE. SEE PIPE SUPPORT SCHEDULE ON SHEET 99-M-502.
- AIR PIPING SUPPORT TYPES ARE IDENTIFIED USING THE FOLLOWING DESIGNATIONS:
- (G) : GUIDE SUPPORT
 - (A) : AXIAL STOP
 - (V) : VERTICAL SUPPORT
 - (SPR) : SPRING HANGER SUPPORT



Black & Veatch Corporation
 Chicago, Illinois
 ILLINOIS PROFESSIONAL
 DESIGN FIRM - 184.002143-0006

SHEET KEYNOTES

- CONTRACTOR TO FIELD ROUTE SAMPLE PIPING TO NEAREST SERVICE SINK.



AEROBIC GRANULAR
 SLUDGE - PHASE 1

REVISIONS AND RECORD OF ISSUE	
DESIGNED:	JL
DETAILED:	VP
CHECKED:	AM/JH
APPROVED:	MR
DATE:	12/20/2022
PROJECT NO.:	411752


AGS REACTORS AND PIPE
 GALLERY

PROCESS MECHANICAL

REACTOR SECTIONS
 2 OF 3


01-M-302

69
 OF
 163

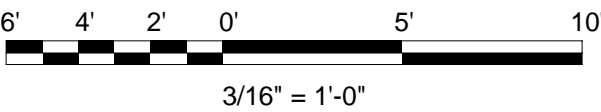

(SCALE BAR IS 4" AT FULL SCALE)

PLOTTED: 12/16/2022 11:50:03 AM
FILE: BIM 360/409469 - Aerobic Granular Sludge Phase 1/409469 - AGS.rvt
D11000

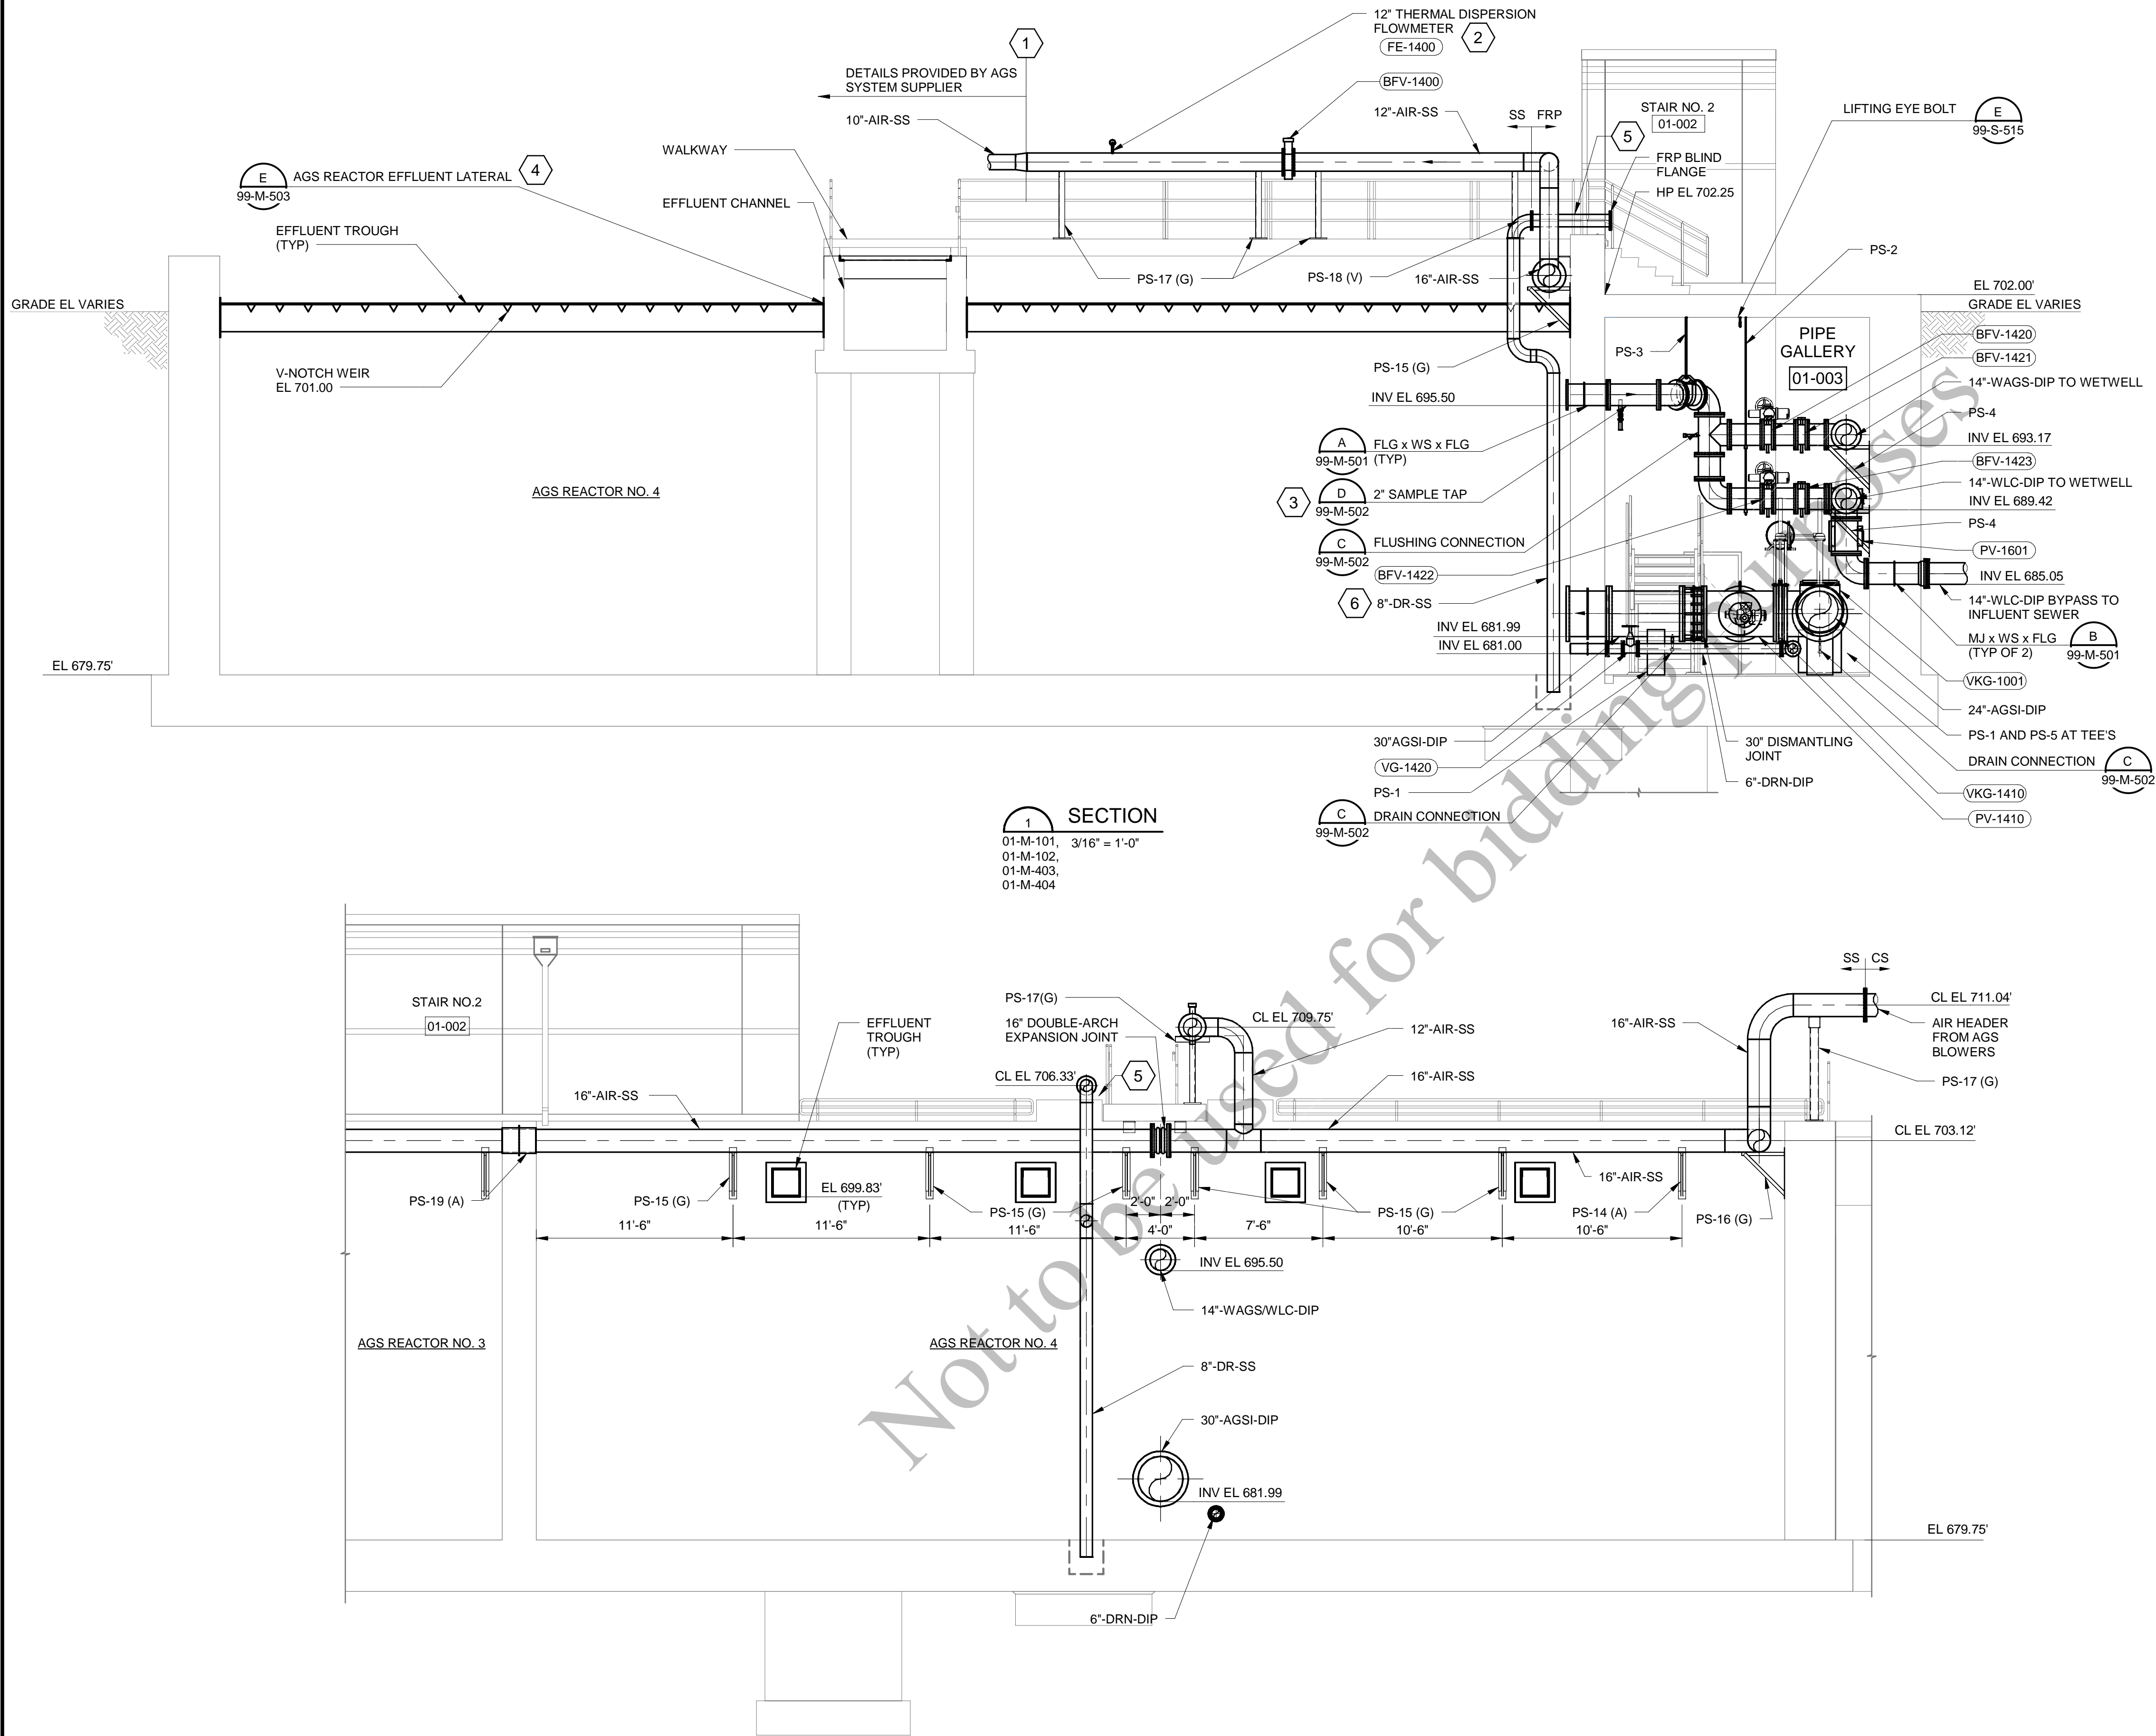

GENERAL SHEET NOTES

- AIR DIFFUSER LAYOUT AND CONNECTION DETAILS SHALL BE PROVIDED BY AGS SYSTEM SUPPLIER AFTER AWARD OF CONTRACT.
- AGS REACTOR TANK INTERNAL EQUIPMENT INCLUDING MANIFOLDS, TROUGHS, SUPPORTS AND DIFFUSERS ARE PROVIDED BY AGS SYSTEM SUPPLIER. FINAL EQUIPMENT AND PIPING LAYOUT IS PROPRIETARY AND SHALL BE AS PROVIDED IN VENDOR SUBMITTAL DRAWINGS. FINAL EQUIPMENT LIST AND QUANTITIES TO BE PROVIDED BY AGS SYSTEM SUPPLIER. REFER TO AGS SPECIFICATION AND SHEETS 99-M-502, 99-M-503, AND 99-M-504 FOR ADDITIONAL DETAIL.
- PS-X REPRESENTS PIPE SUPPORT TYPE. SEE PIPE SUPPORT SCHEDULE ON SHEET 99-M-502.

AIR PIPING SUPPORT TYPES ARE IDENTIFIED USING THE FOLLOWING DESIGNATIONS:
(G) : GUIDE SUPPORT
(A) : AXIAL STOP
(V) : VERTICAL SUPPORT
(SPR) : SPRING HANGER SUPPORT
- PIPE SUPPORTS TO BE ADJUSTED IN THE FIELD AS REQUIRED TO AVOID FLANGE LOCATIONS IN PIPES.

SHEET KEYNOTES

- REFER TO P&IDS AND EQUIPMENT SPECIFICATION FOR ADDITIONAL INFORMATION ON AGS SYSTEM SUPPLIER SCOPE. DETAILED PIPE ROUTING AND EQUIPMENT LOCATIONS TO BE PROVIDED BY SUPPLIER AFTER AWARD OF CONTRACT. AGS SYSTEM SUPPLIER IS RESPONSIBLE FOR PIPE SUPPORTS WITHIN THE PIPING PROVIDED BY THE AGS SYSTEM SUPPLIER.
- THERMAL DISPERSION FLOWMETER PROVIDED BY AGS SYSTEM SUPPLIER. FLOWMETERS SHALL BE PROVIDED WITH MINIMUM UPSTREAM STRAIGHT RUN OF 10 PIPE DIAMETERS AND MINIMUM DOWNSTREAM STRAIGHT RUN OF 5 PIPE DIAMETERS.
- CONTRACTOR TO FIELD ROUT SAMPLE PIPING TO NEAREST SERVICE SINK.
- CONTRACTOR SHALL COORDINATE THE LOCATION AND SIZE OF EFFLUENT CHANNEL OPENINGS WITH THE AGS SYSTEM SUPPLIER.
- DRAIN PIPING SHOWN IS TYPICAL OF AGS REACTOR NO. 2,3,4. CONTRACTOR SHALL ROUTE DRAIN PIPING TO AVOID AIR PIPING.
- SUPPORTS FOR DRAIN PIPING SHALL BE DUPLEX SS AND SHALL MEET THE REQUIREMENTS OF SECTION 40 05 07 PIPE SUPPORTS.


AEROBIC GRANULAR SLUDGE - PHASE 1

REVISIONS AND RECORD OF ISSUE	
DESIGNED:	JL
DETAILED:	VP
CHECKED:	AM/JH
APPROVED:	MR
DATE:	12/20/2022
PROJECT NO.:	411752


AGS REACTORS AND PIPE GALLERY

PROCESS MECHANICAL

REACTOR SECTIONS 3 OF 3

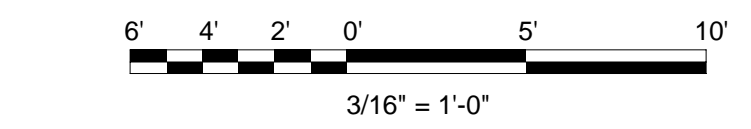

PLOTTED: 12/16/2022 11:48:17 AM
 FILE: BIM 360/409469 - Aerobic Granular Sludge Phase 1/409469 - AGS.rvt
 D11000

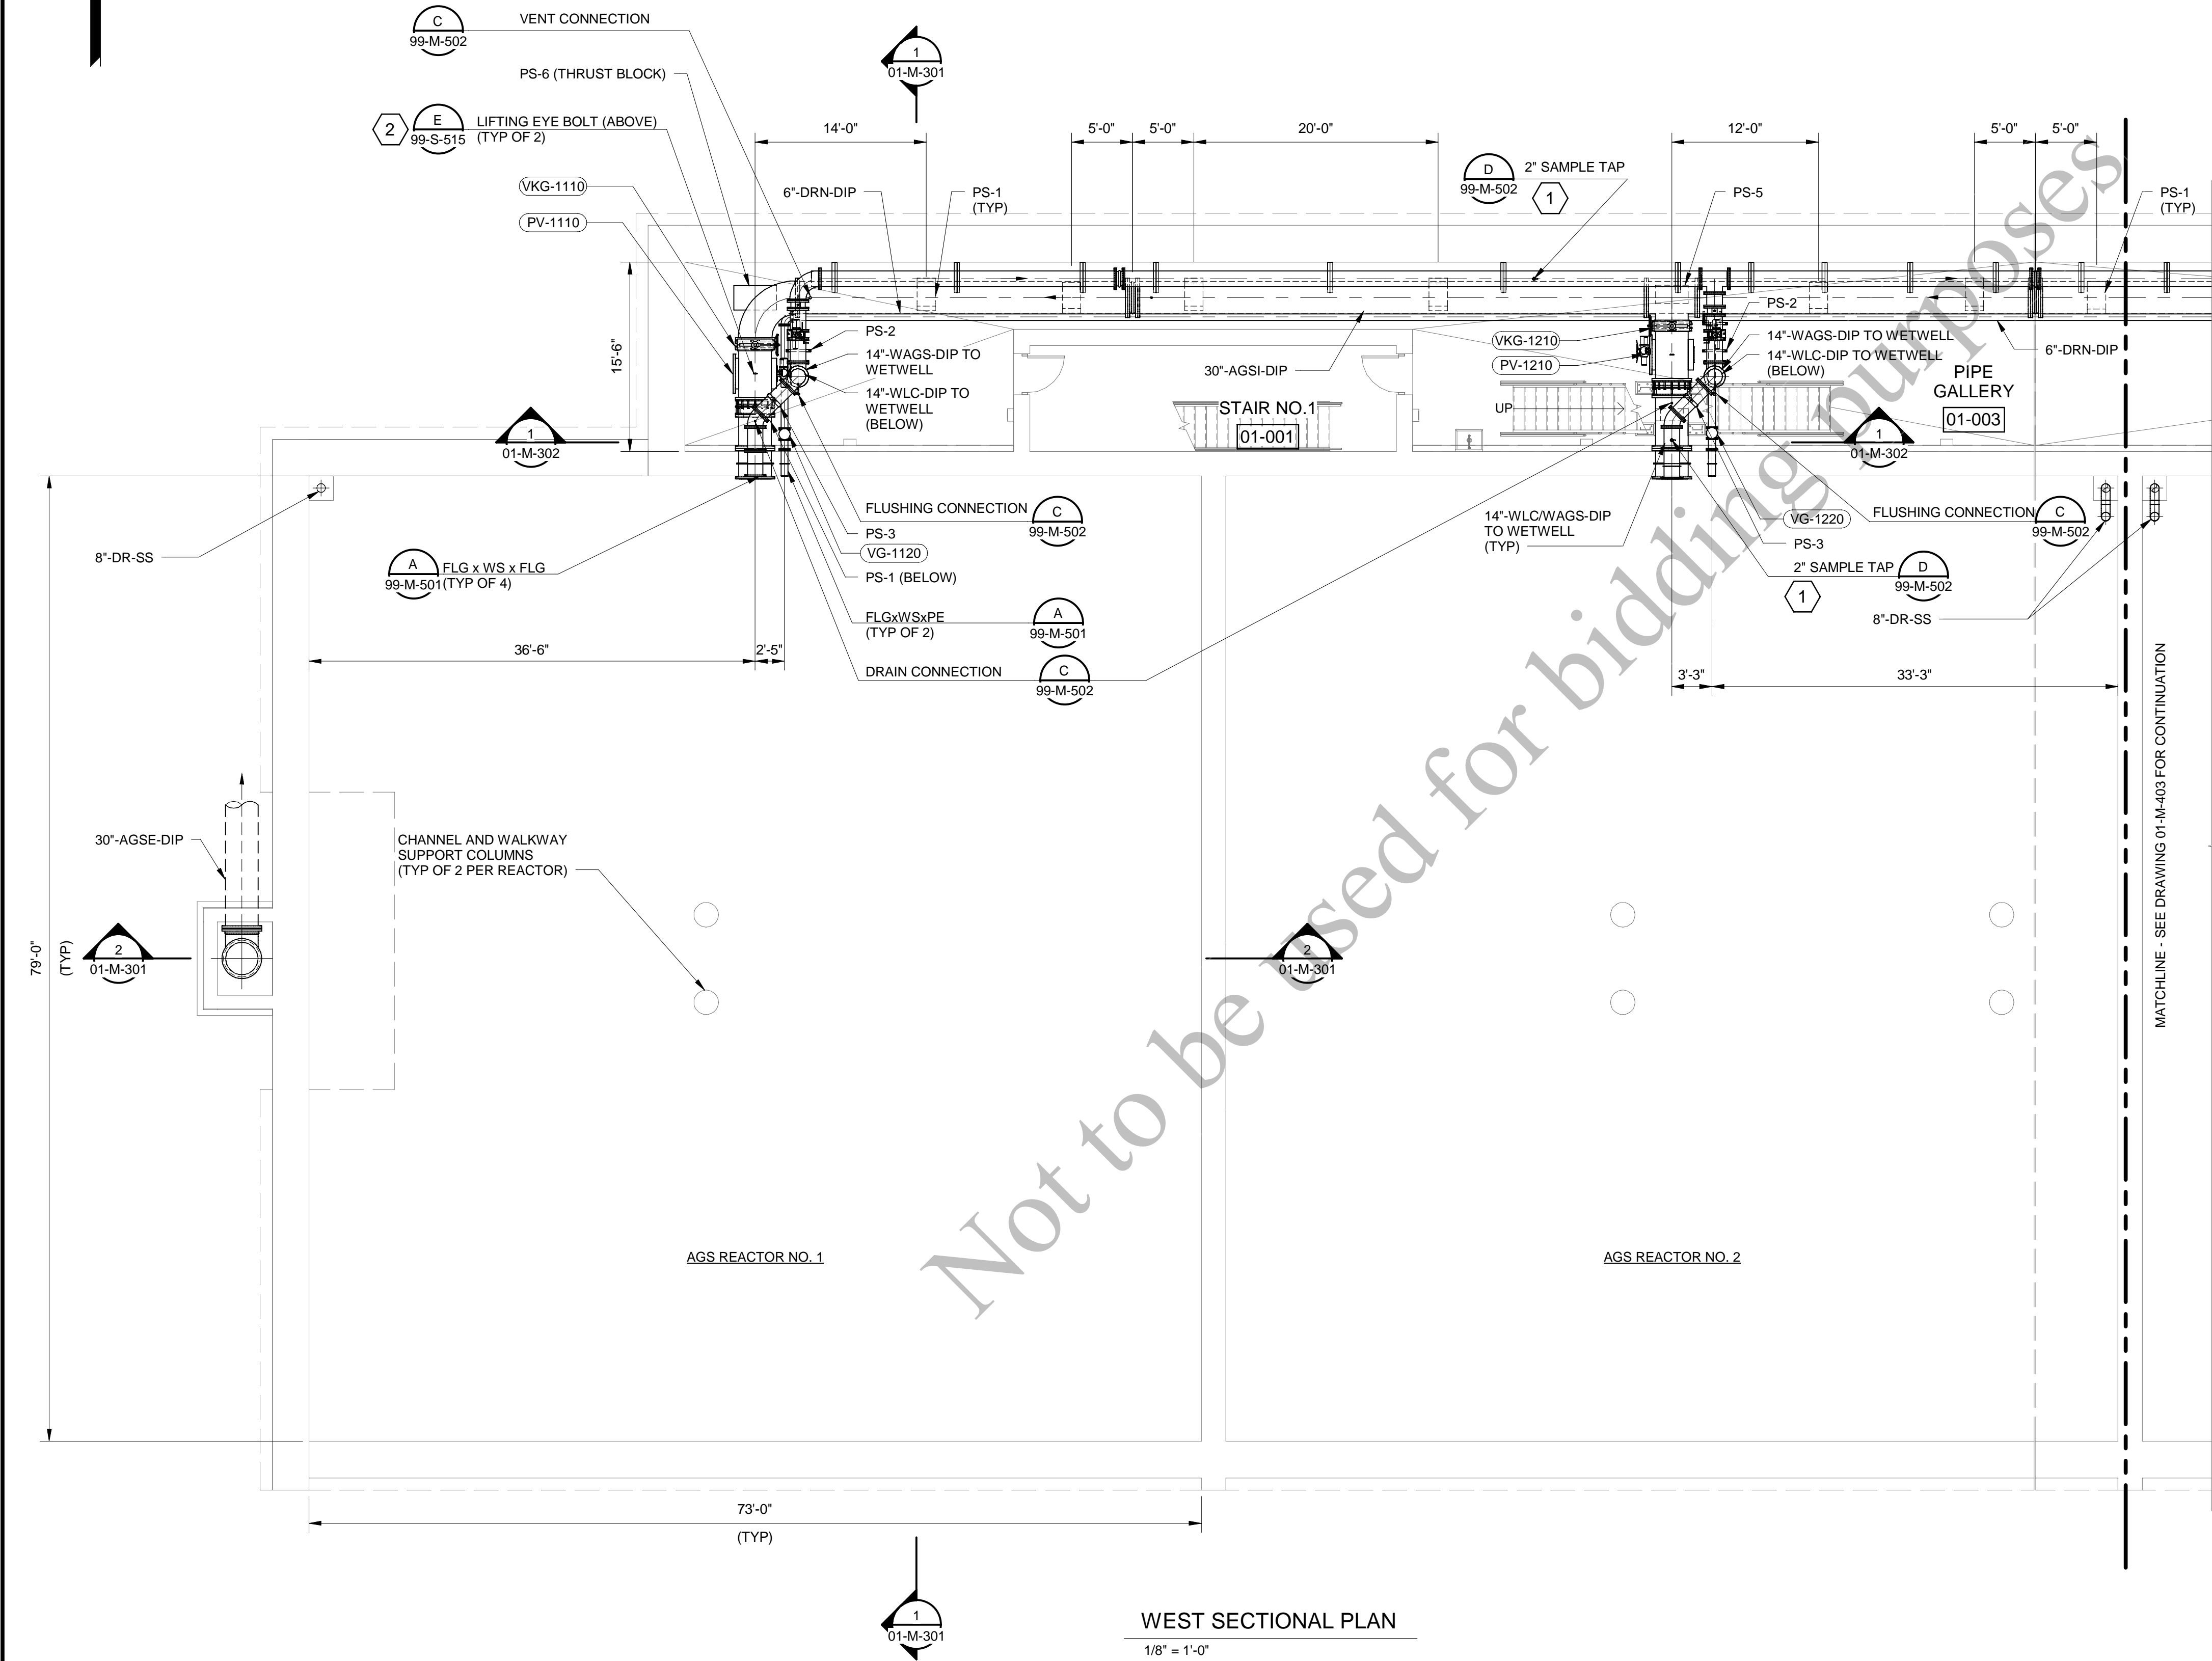

GENERAL SHEET NOTES

- AIR DIFFUSER LAYOUT AND CONNECTION DETAILS SHALL BE PROVIDED BY AGS SYSTEM SUPPLIER AFTER AWARD OF CONTRACT.
 - AGS REACTOR TANK INTERNAL EQUIPMENT INCLUDING MANIFOLDS, TROUGHS, SUPPORTS, AND DIFFUSERS ARE PROVIDED BY AGS SYSTEM SUPPLIER. FINAL EQUIPMENT AND PIPING LAYOUT IS PROPRIETARY AND SHALL BE AS PROVIDED IN VENDOR SUBMITTAL DRAWINGS. FINAL EQUIPMENT LIST AND QUANTITIES TO BE PROVIDED BY AGS SYSTEM SUPPLIER. REFER TO AGS SPECIFICATION AND SHEETS 99-M-502, 99-M-503, AND 99-M-504 FOR ADDITIONAL DETAIL.
 - PIPE SUPPORTS TO BE ADJUSTED IN THE FIELD AS REQUIRED TO AVOID FLANGE LOCATIONS IN PIPES.
 - PS-X REPRESENTS PIPE SUPPORT TYPE. SEE PIPE SUPPORT SCHEDULE ON SHEET 99-M-502.
- AIR PIPING SUPPORT TYPES ARE IDENTIFIED USING THE FOLLOWING DESIGNATIONS:
- (G) : GUIDE SUPPORT
 - (A) : AXIAL STOP
 - (V) : VERTICAL SUPPORT
 - (SPR) : SPRING HANGER SUPPORT

SHEET KEYNOTES

- CONTRACTOR TO FIELD ROUTE SAMPLE PIPING TO NEAREST SERVICE SINK.
- LIFTING EYE BOLT TO BE LOCATED DIRECTLY ABOVE CENTER OF 30-INCH PLUG VALVE.

BLACK & VEATCH
 Black & Veatch Corporation
 Chicago, Illinois
 ILLINOIS PROFESSIONAL
 DESIGN FIRM - 184.002143-0006

Four Rivers
 Sanitation Authority

AEROBIC GRANULAR
 SLUDGE - PHASE 1


REVISIONS AND RECORD OF ISSUE	
DESIGNED:	JL
DETAILED:	VP
CHECKED:	AM/JH
APPROVED:	MR
DATE:	12/20/2022
PROJECT NO.:	411752

AGS REACTORS AND PIPE
 GALLERY



PROCESS MECHANICAL

WEST SECTIONAL PLAN

01-M-401
 71
 OF
 163

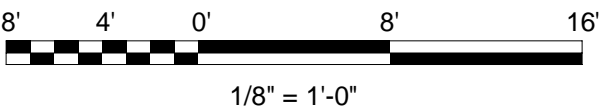

(SCALE BAR IS 4" AT FULL SCALE) 0 1/2 1 2 3 4

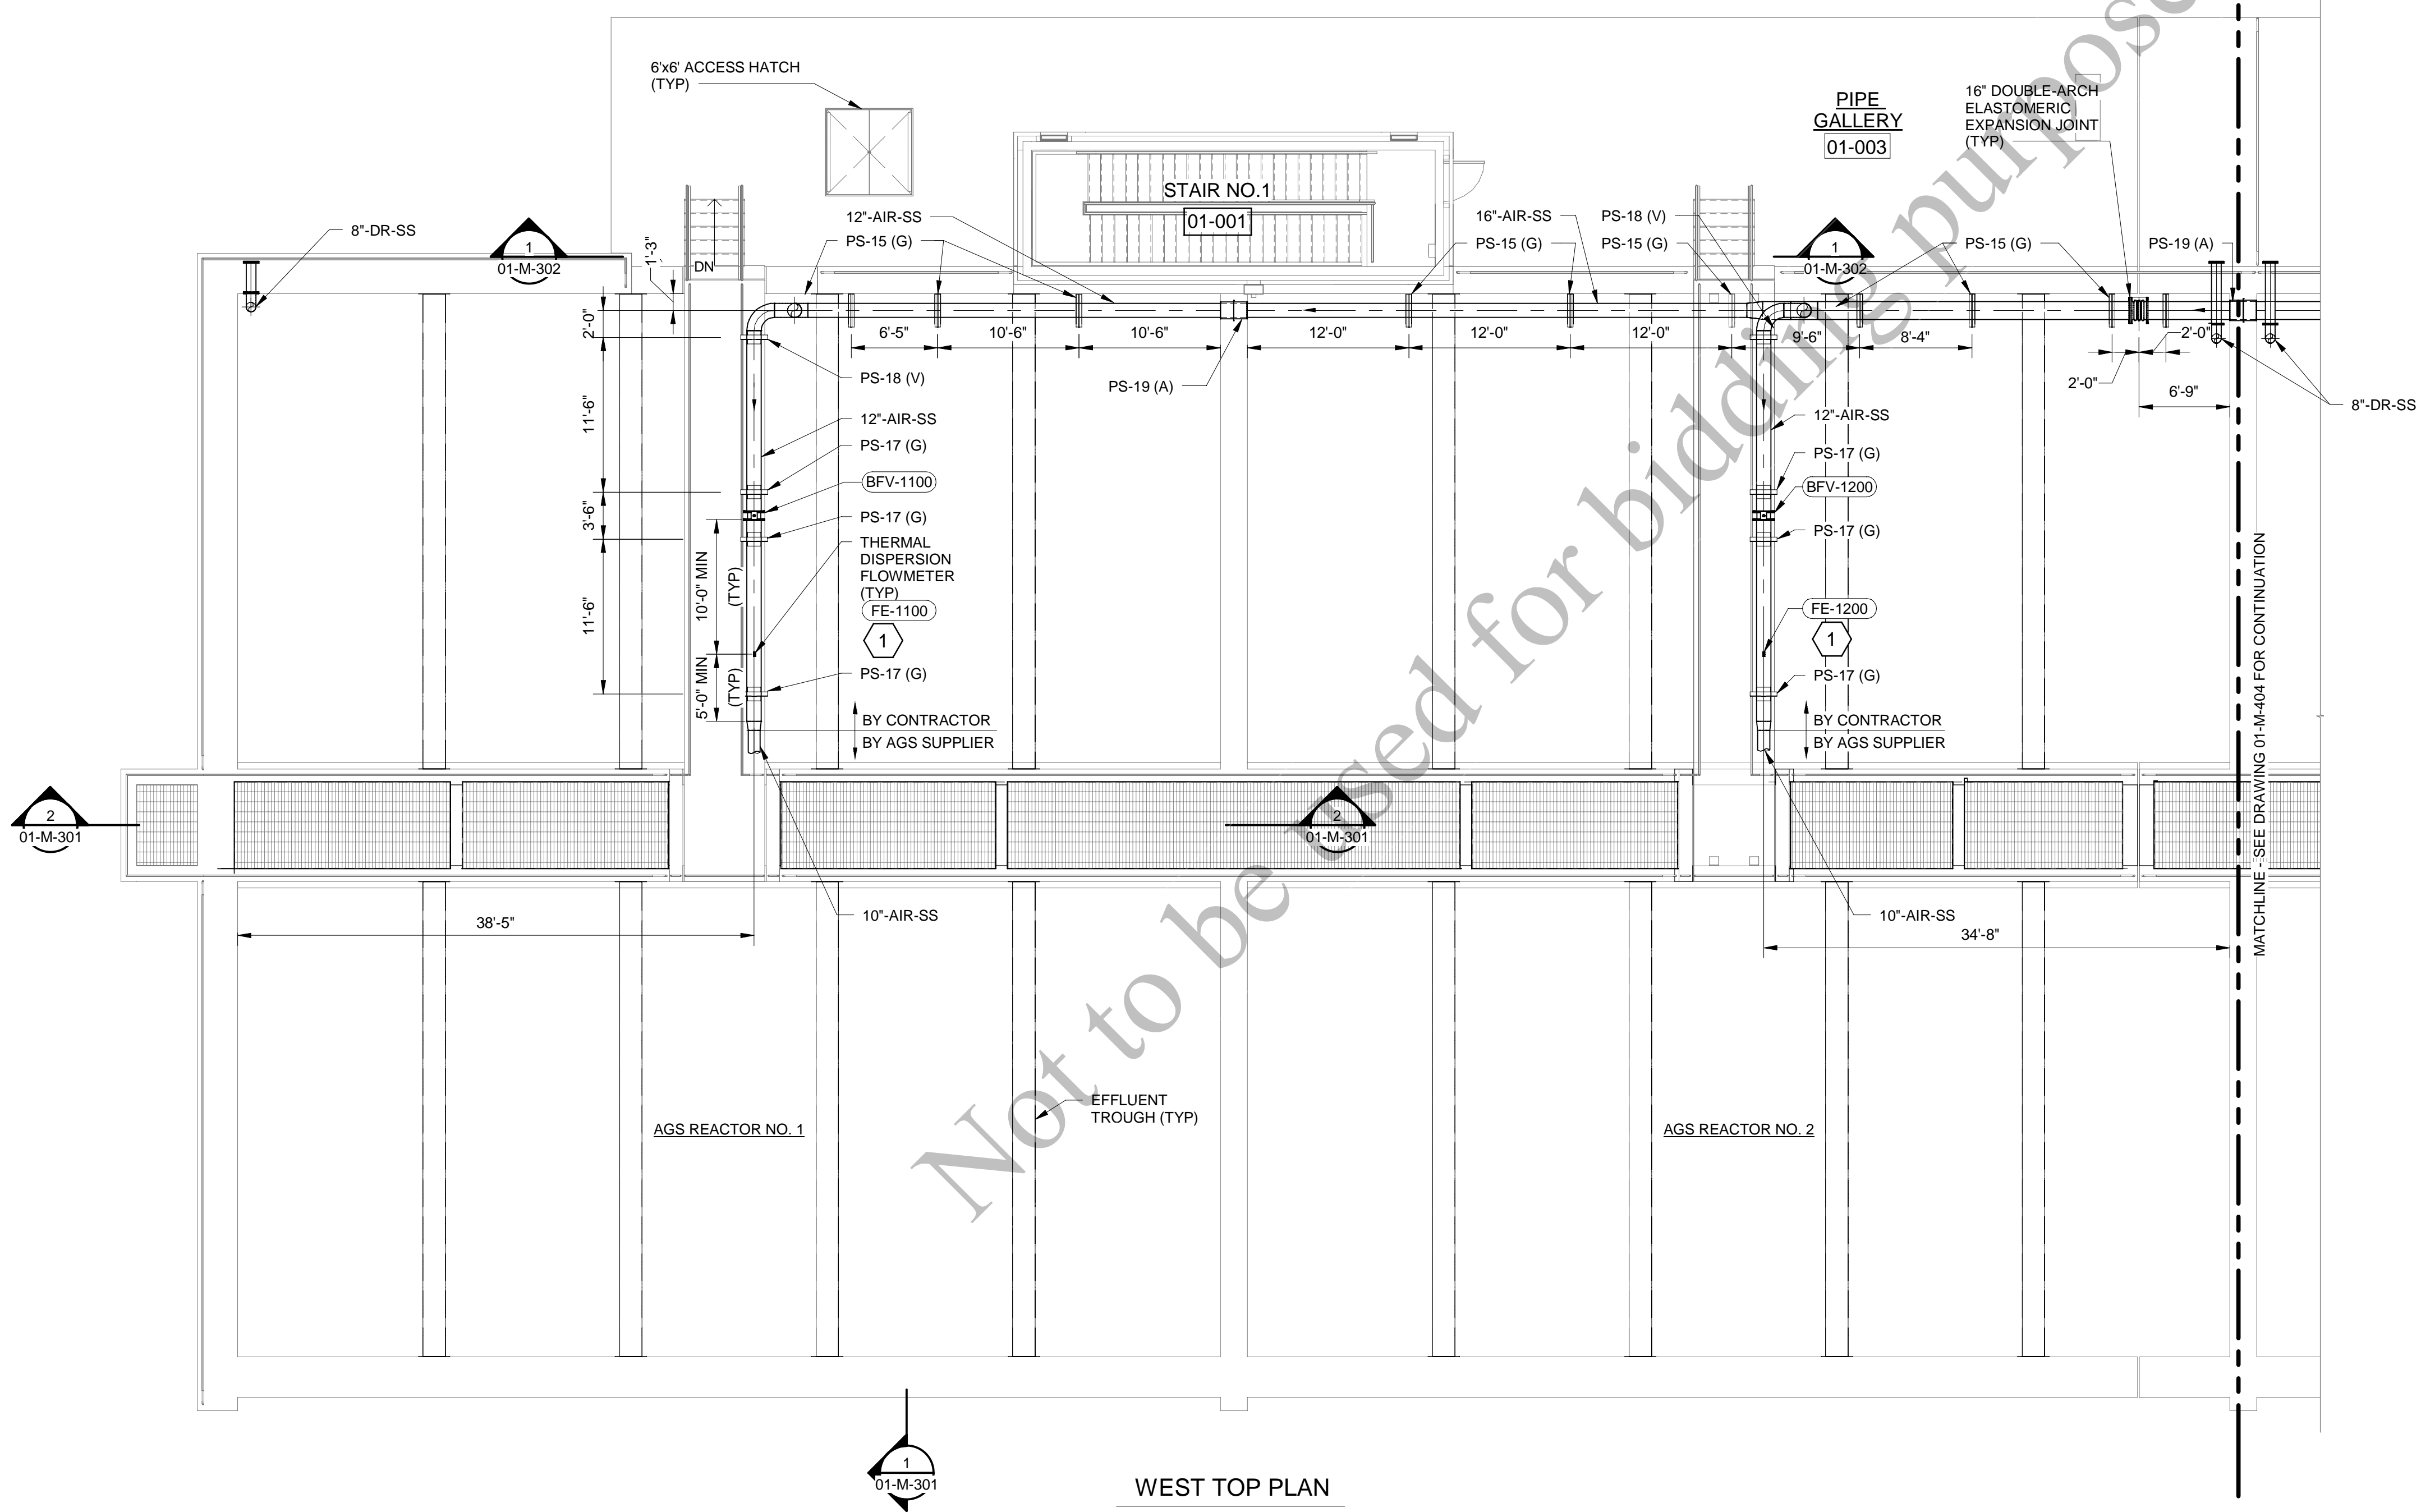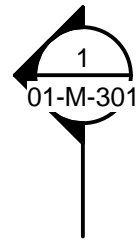

GENERAL SHEET NOTES

- AIR DIFFUSER LAYOUT AND CONNECTION DETAILS SHALL BE PROVIDED BY AGS SYSTEM SUPPLIER AFTER AWARD OF CONTRACT.
 - AGS REACTOR TANK INTERNAL EQUIPMENT INCLUDING MANIFOLDS, TROUGHS, SUPPORTS, AND DIFFUSERS ARE PROVIDED BY AGS SYSTEM SUPPLIER. FINAL EQUIPMENT AND PIPING LAYOUT IS PROPRIETARY AND SHALL BE AS PROVIDED IN VENDOR SUBMITTAL DRAWINGS. FINAL EQUIPMENT LIST AND QUANTITIES TO BE PROVIDED BY AGS SYSTEM SUPPLIER. REFER TO AGS SPECIFICATION AND SHEETS 99-M-502, 99-M-503, AND 99-M-504 FOR ADDITIONAL DETAIL.
 - PS-X REPRESENTS PIPE SUPPORT TYPE. SEE PIPE SUPPORT SCHEDULE ON SHEET 99-M-502.
- AIR PIPING SUPPORT TYPES ARE IDENTIFIED SING THE FOLLOWING DESIGNATIONS:
- (G) : GUIDE SUPPORT
(A) : AXIAL STOP
(V) : VERTICAL SUPPORT
(SPR) : SPRING HANGER SUPPORT

SHEET KEYNOTES

- THERMAL DISPERSION FLOWMETER PROVIDED BY AGS SYSTEM SUPPLIER. FLOWMETERS SHALL BE PROVIDED WITH MINIMUM UPSTREAM STRAIGHT RUN OF 10 PIPE DIAMETERS AND MINIMUM DOWNSTREAM STRAIGHT RUN OF 5 PIPE DIAMETERS.



Black & Veatch Corporation
Chicago, Illinois
ILLINOIS PROFESSIONAL
DESIGN FIRM - 184.002143-0006



AEROBIC GRANULAR
SLUDGE - PHASE 1

REVISIONS AND RECORD OF ISSUE	
DESIGNED:	JL
DETAILED:	VP
CHECKED:	AM/JH
APPROVED:	MR
DATE:	12/20/2022
PROJECT NO.:	411752


AGS REACTORS AND PIPE
GALLERY

PROCESS MECHANICAL


WEST TOP PLAN

01-M-402

72
OF
163

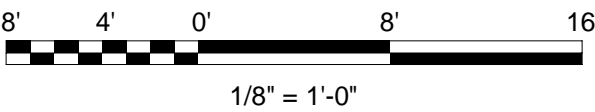

(SCALE BAR IS 4" AT FULL SCALE)

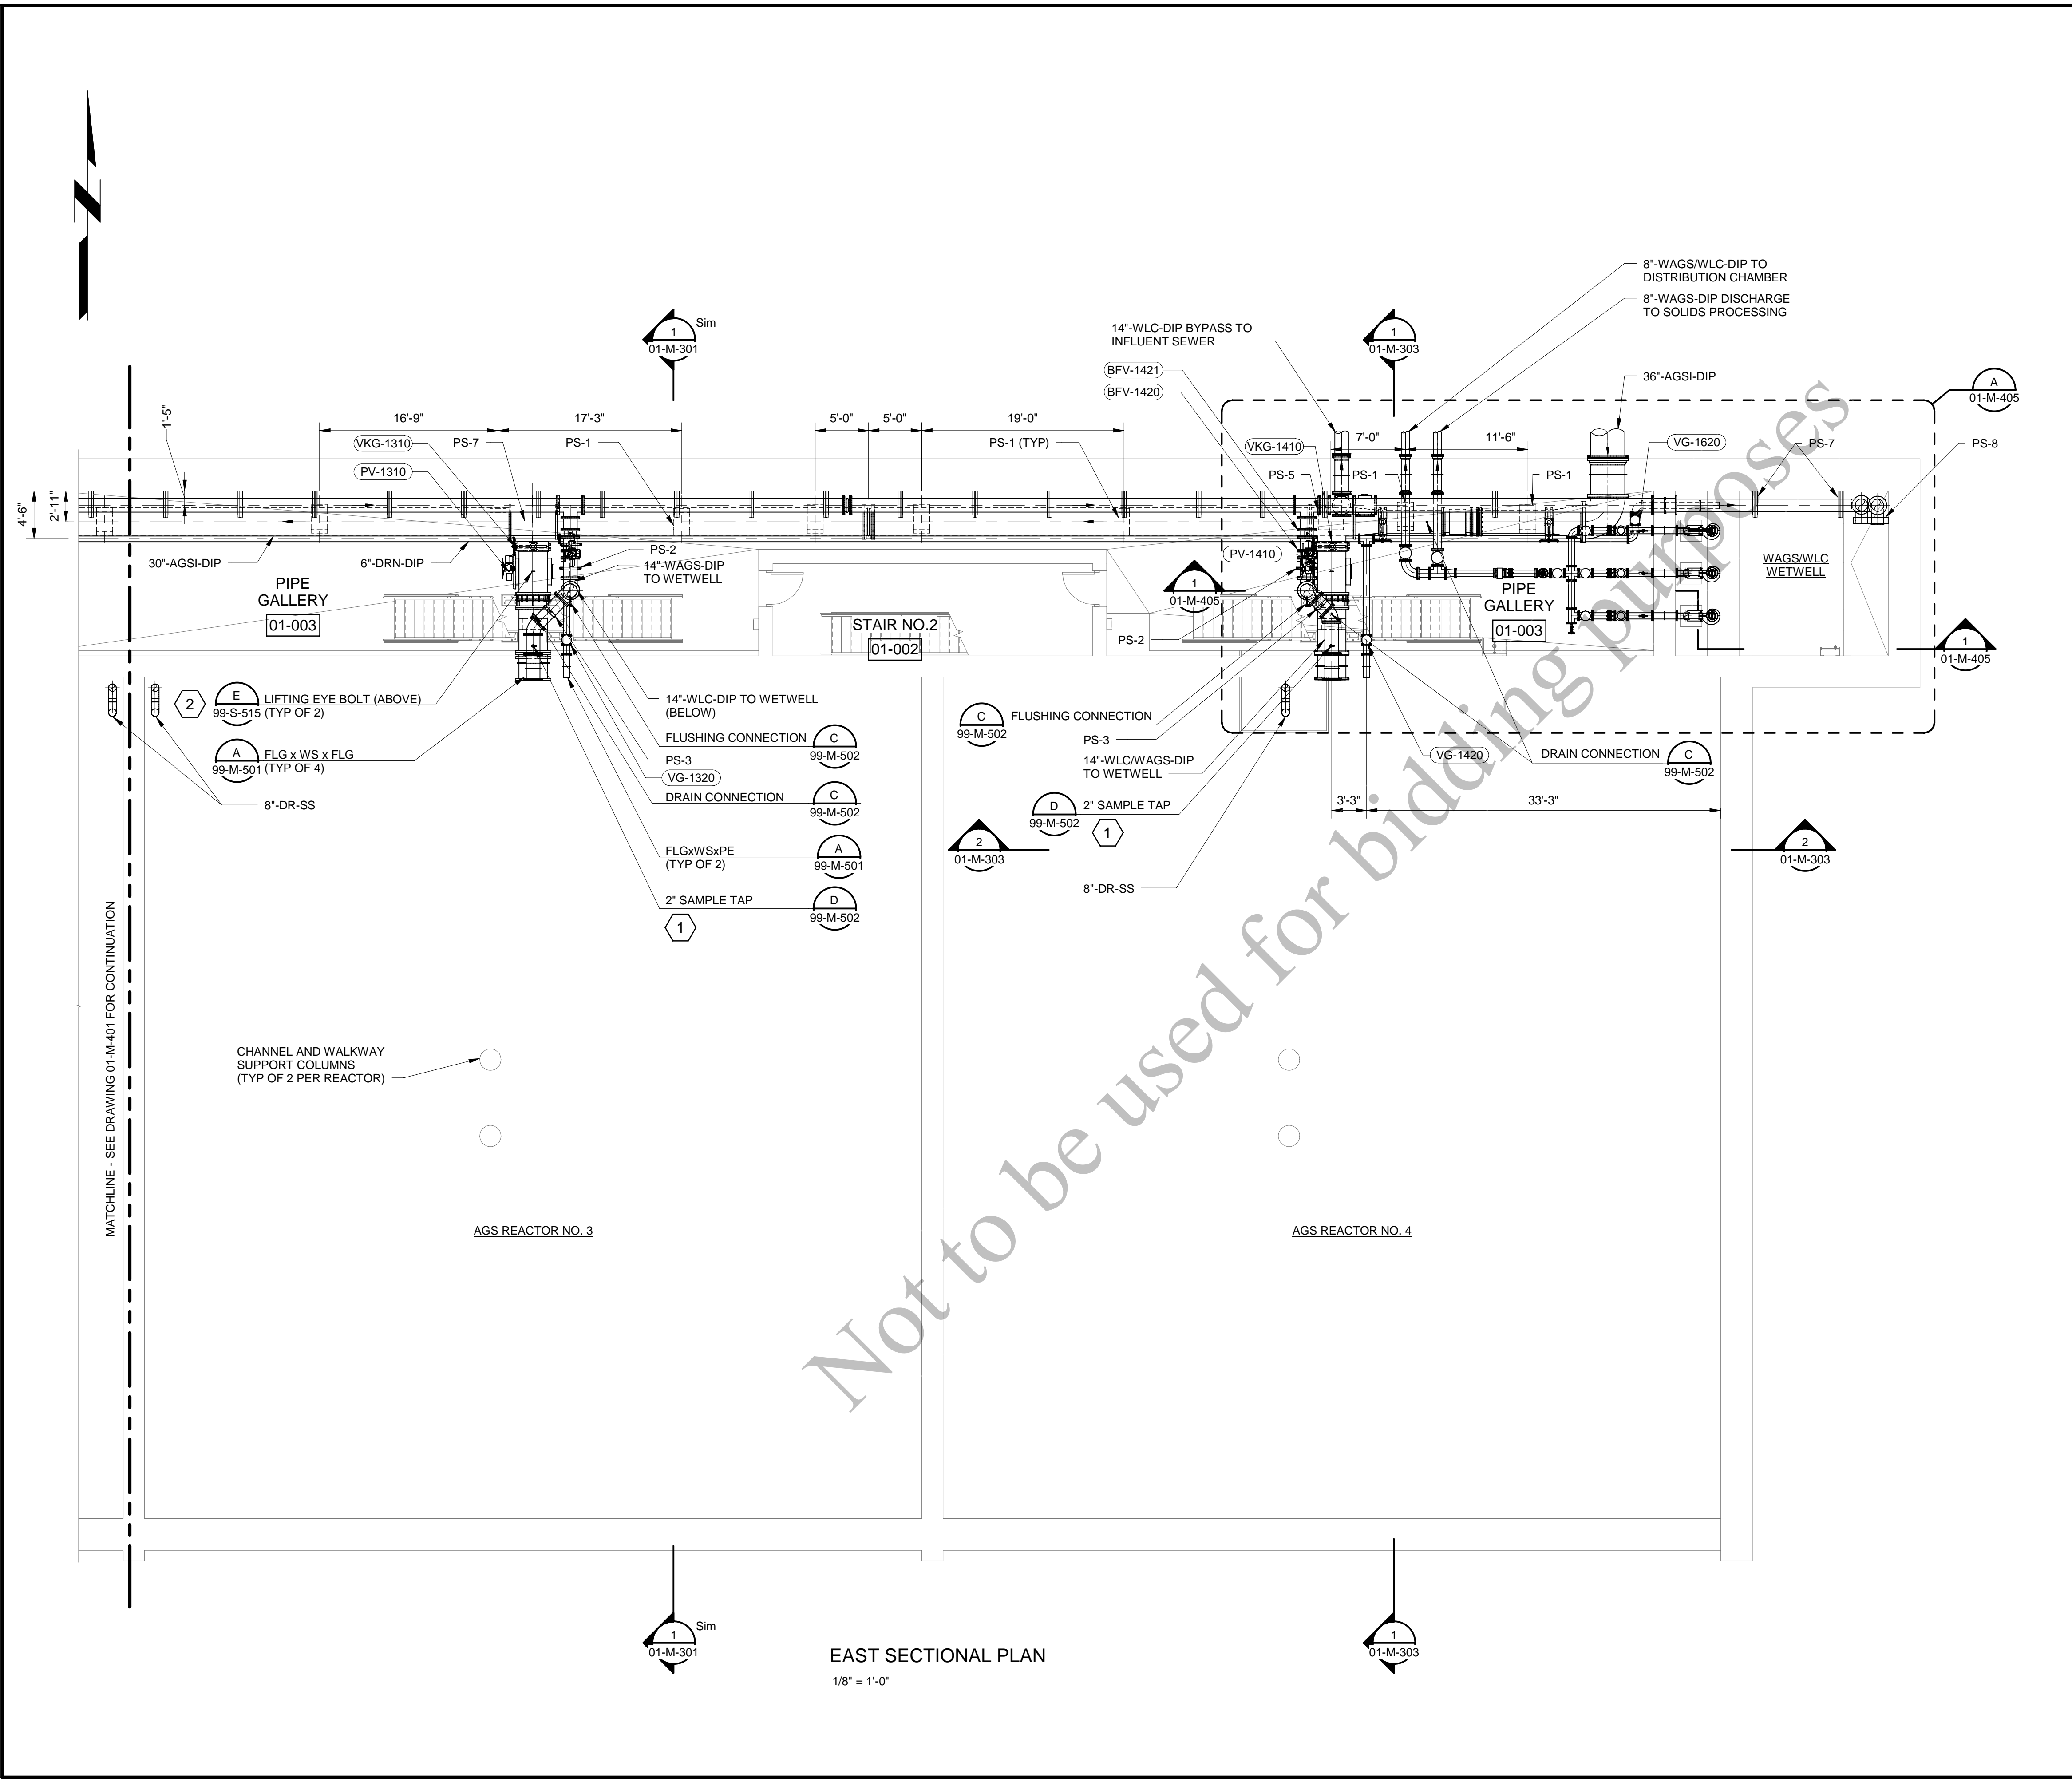

EAST SECTIONAL PLAN
 1/8" = 1'-0"

GENERAL SHEET NOTES

- AIR DIFFUSER LAYOUT AND CONNECTION DETAILS SHALL BE PROVIDED BY AGS SYSTEM SUPPLIER AFTER AWARD OF CONTRACT.
 - AGS REACTOR TANK INTERNAL EQUIPMENT INCLUDING MANIFOLDS, TROUGHS, SUPPORTS, AND DIFFUSERS ARE PROVIDED BY AGS SYSTEM SUPPLIER. FINAL EQUIPMENT AND PIPING LAYOUT IS PROPRIETARY AND SHALL BE AS PROVIDED IN VENDOR SUBMITTAL DRAWINGS. FINAL EQUIPMENT LIST AND QUANTITIES TO BE PROVIDED BY AGS SYSTEM SUPPLIER. REFER TO AGS SPECIFICATION AND SHEETS 99-M-502, 99-M-503, AND 99-M-504 FOR ADDITIONAL DETAIL.
 - PIPE SUPPORTS TO BE ADJUSTED IN THE FIELD AS REQUIRED TO AVOID FLANGE LOCATIONS IN PIPES.
 - PS-X REPRESENTS PIPE SUPPORT TYPE. SEE PIPE SUPPORT SCHEDULE ON SHEET 99-M-502.
- AIR PIPING SUPPORT TYPES ARE IDENTIFIED SING THE FOLLOWING DESIGNATIONS:
- (G) : GUIDE SUPPORT
 (A) : AXIAL STOP
 (V) : VERTICAL SUPPORT
 (SPR) : SPRING HANGER SUPPORT

SHEET KEYNOTES

- CONTRACTOR TO FIELD ROUTE SAMPLE PIPING TO NEAREST SERVICE SINK.
- LIFTING EYE BOLT TO BE LOCATED DIRECTLY ABOVE CENTER OF 30-INCH PLUG VALVE.



Black & Veatch Corporation
 Chicago, Illinois
 ILLINOIS PROFESSIONAL
 DESIGN FIRM - 184.002143-0006



AEROBIC GRANULAR
 SLUDGE - PHASE 1

REVISIONS AND RECORD OF ISSUE	
DESIGNED:	JL
DETAILED:	VP
CHECKED:	AM/JH
APPROVED:	MR
DATE:	12/20/2022
PROJECT NO.:	411752


AGS REACTORS AND PIPE
 GALLERY

PROCESS MECHANICAL

EAST SECTIONAL PLAN

01-M-403

73
 OF
 163

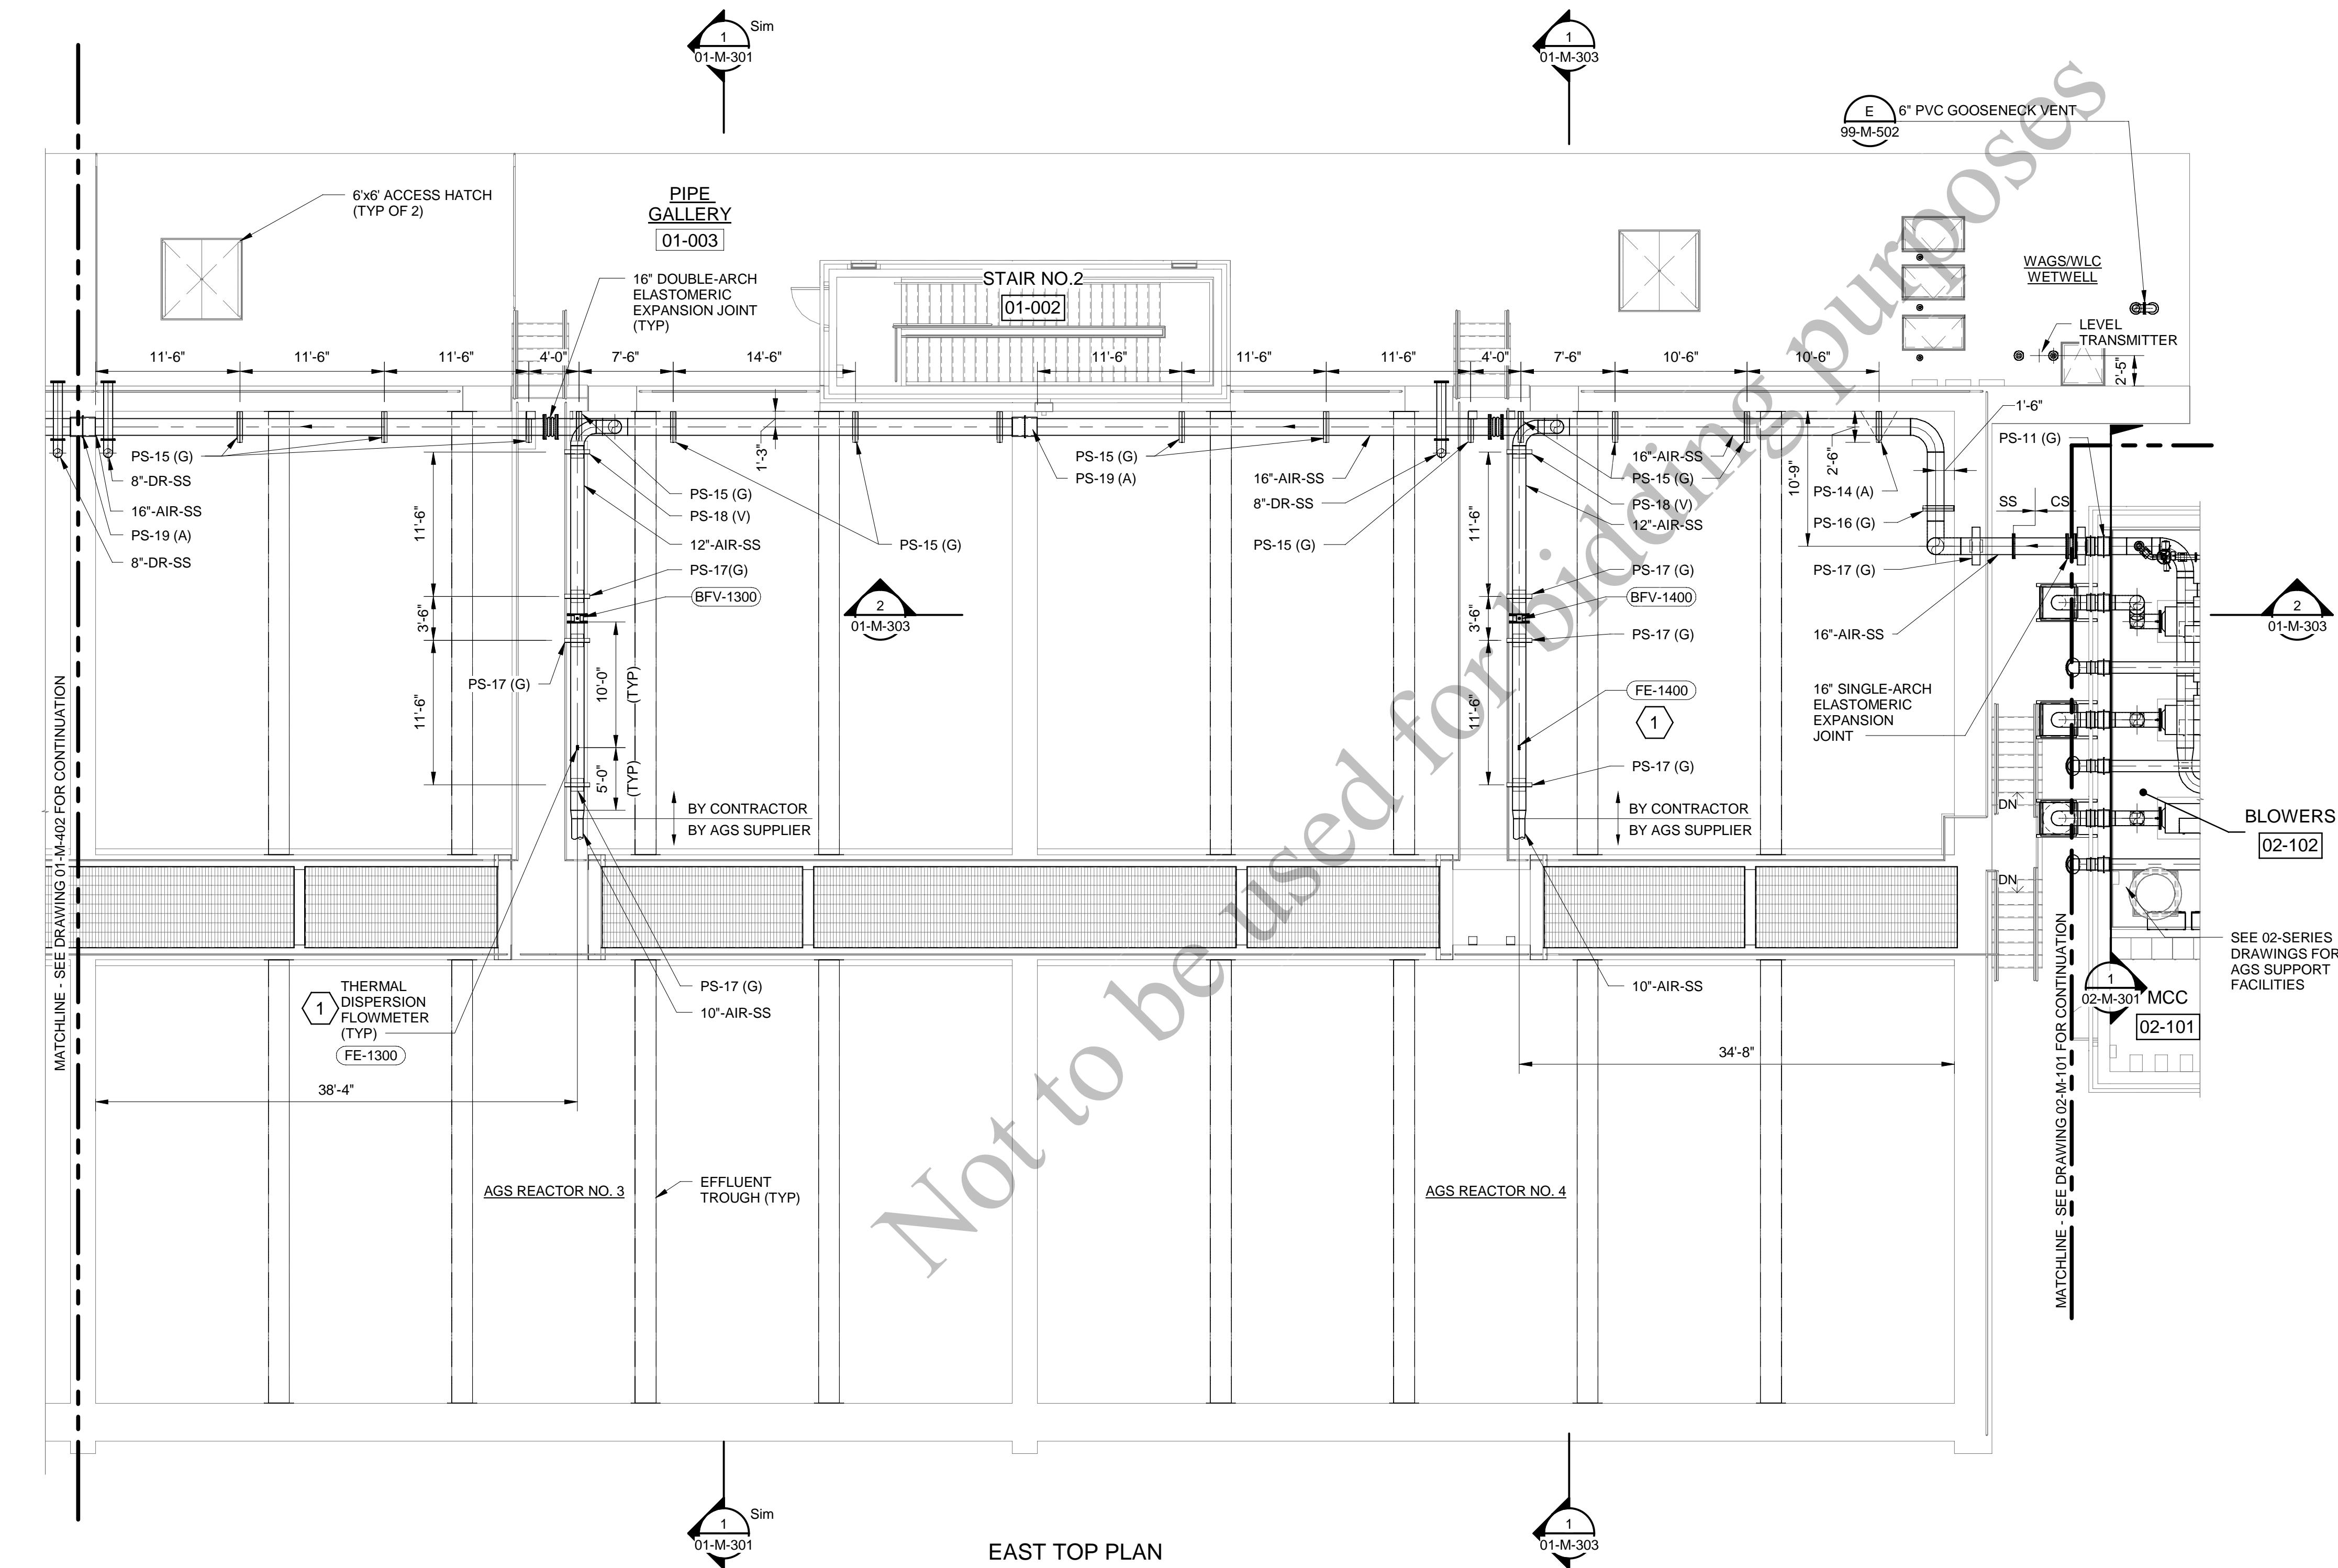

GENERAL SHEET NOTES

- AIR DIFFUSER LAYOUT AND CONNECTION DETAILS SHALL BE PROVIDED BY AGS SYSTEM SUPPLIER AFTER AWARD OF CONTRACT.
- AGS REACTOR TANK INTERNAL EQUIPMENT INCLUDING MANIFOLDS, TROUGHS, SUPPORTS, AND DIFFUSERS ARE PROVIDED BY AGS SYSTEM SUPPLIER. FINAL EQUIPMENT AND PIPING LAYOUT IS PROPRIETARY AND SHALL BE AS PROVIDED IN VENDOR SUBMITTAL DRAWINGS. FINAL EQUIPMENT LIST AND QUANTITIES TO BE PROVIDED BY AGS SYSTEM SUPPLIER. REFER TO AGS SPECIFICATION AND SHEETS 99-M-502, 99-M-503, AND 99-M-504 FOR ADDITIONAL DETAIL.
- PS-X REPRESENTS PIPE SUPPORT TYPE. SEE PIPE SUPPORT SCHEDULE ON SHEET 99-M-502.

AIR PIPING SUPPORT TYPES ARE IDENTIFIED USING THE FOLLOWING DESIGNATIONS:

(G) : GUIDE SUPPORT
(A) : AXIAL STOP
(V) : VERTICAL SUPPORT
(SPR) : SPRING HANGER SUPPORT

SHEET KEYNOTES

- THERMAL DISPERSION FLOWMETER PROVIDED BY AGS SYSTEM SUPPLIER. FLOWMETERS SHALL BE PROVIDED WITH MINIMUM UPSTREAM STRAIGHT RUN OF 10 PIPE DIAMETERS AND MINIMUM DOWNSTREAM STRAIGHT RUN OF 5 PIPE DIAMETERS.



Black & Veatch Corporation
Chicago, Illinois
ILLINOIS PROFESSIONAL
DESIGN FIRM - 184.002143-0006



AEROBIC GRANULAR
SLUDGE - PHASE 1

REVISIONS AND RECORD OF ISSUE

DESIGNED:	JL
DETAILED:	VP
CHECKED:	AM/JH
APPROVED:	MR
DATE:	12/20/2022
PROJECT NO.:	411752


AGS REACTORS AND PIPE
GALLERY

PROCESS MECHANICAL



EAST TOP PLAN

01-M-404

74
OF
163

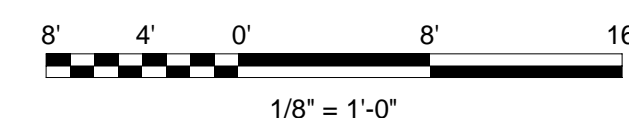

(SCALE BAR IS 4\"/>

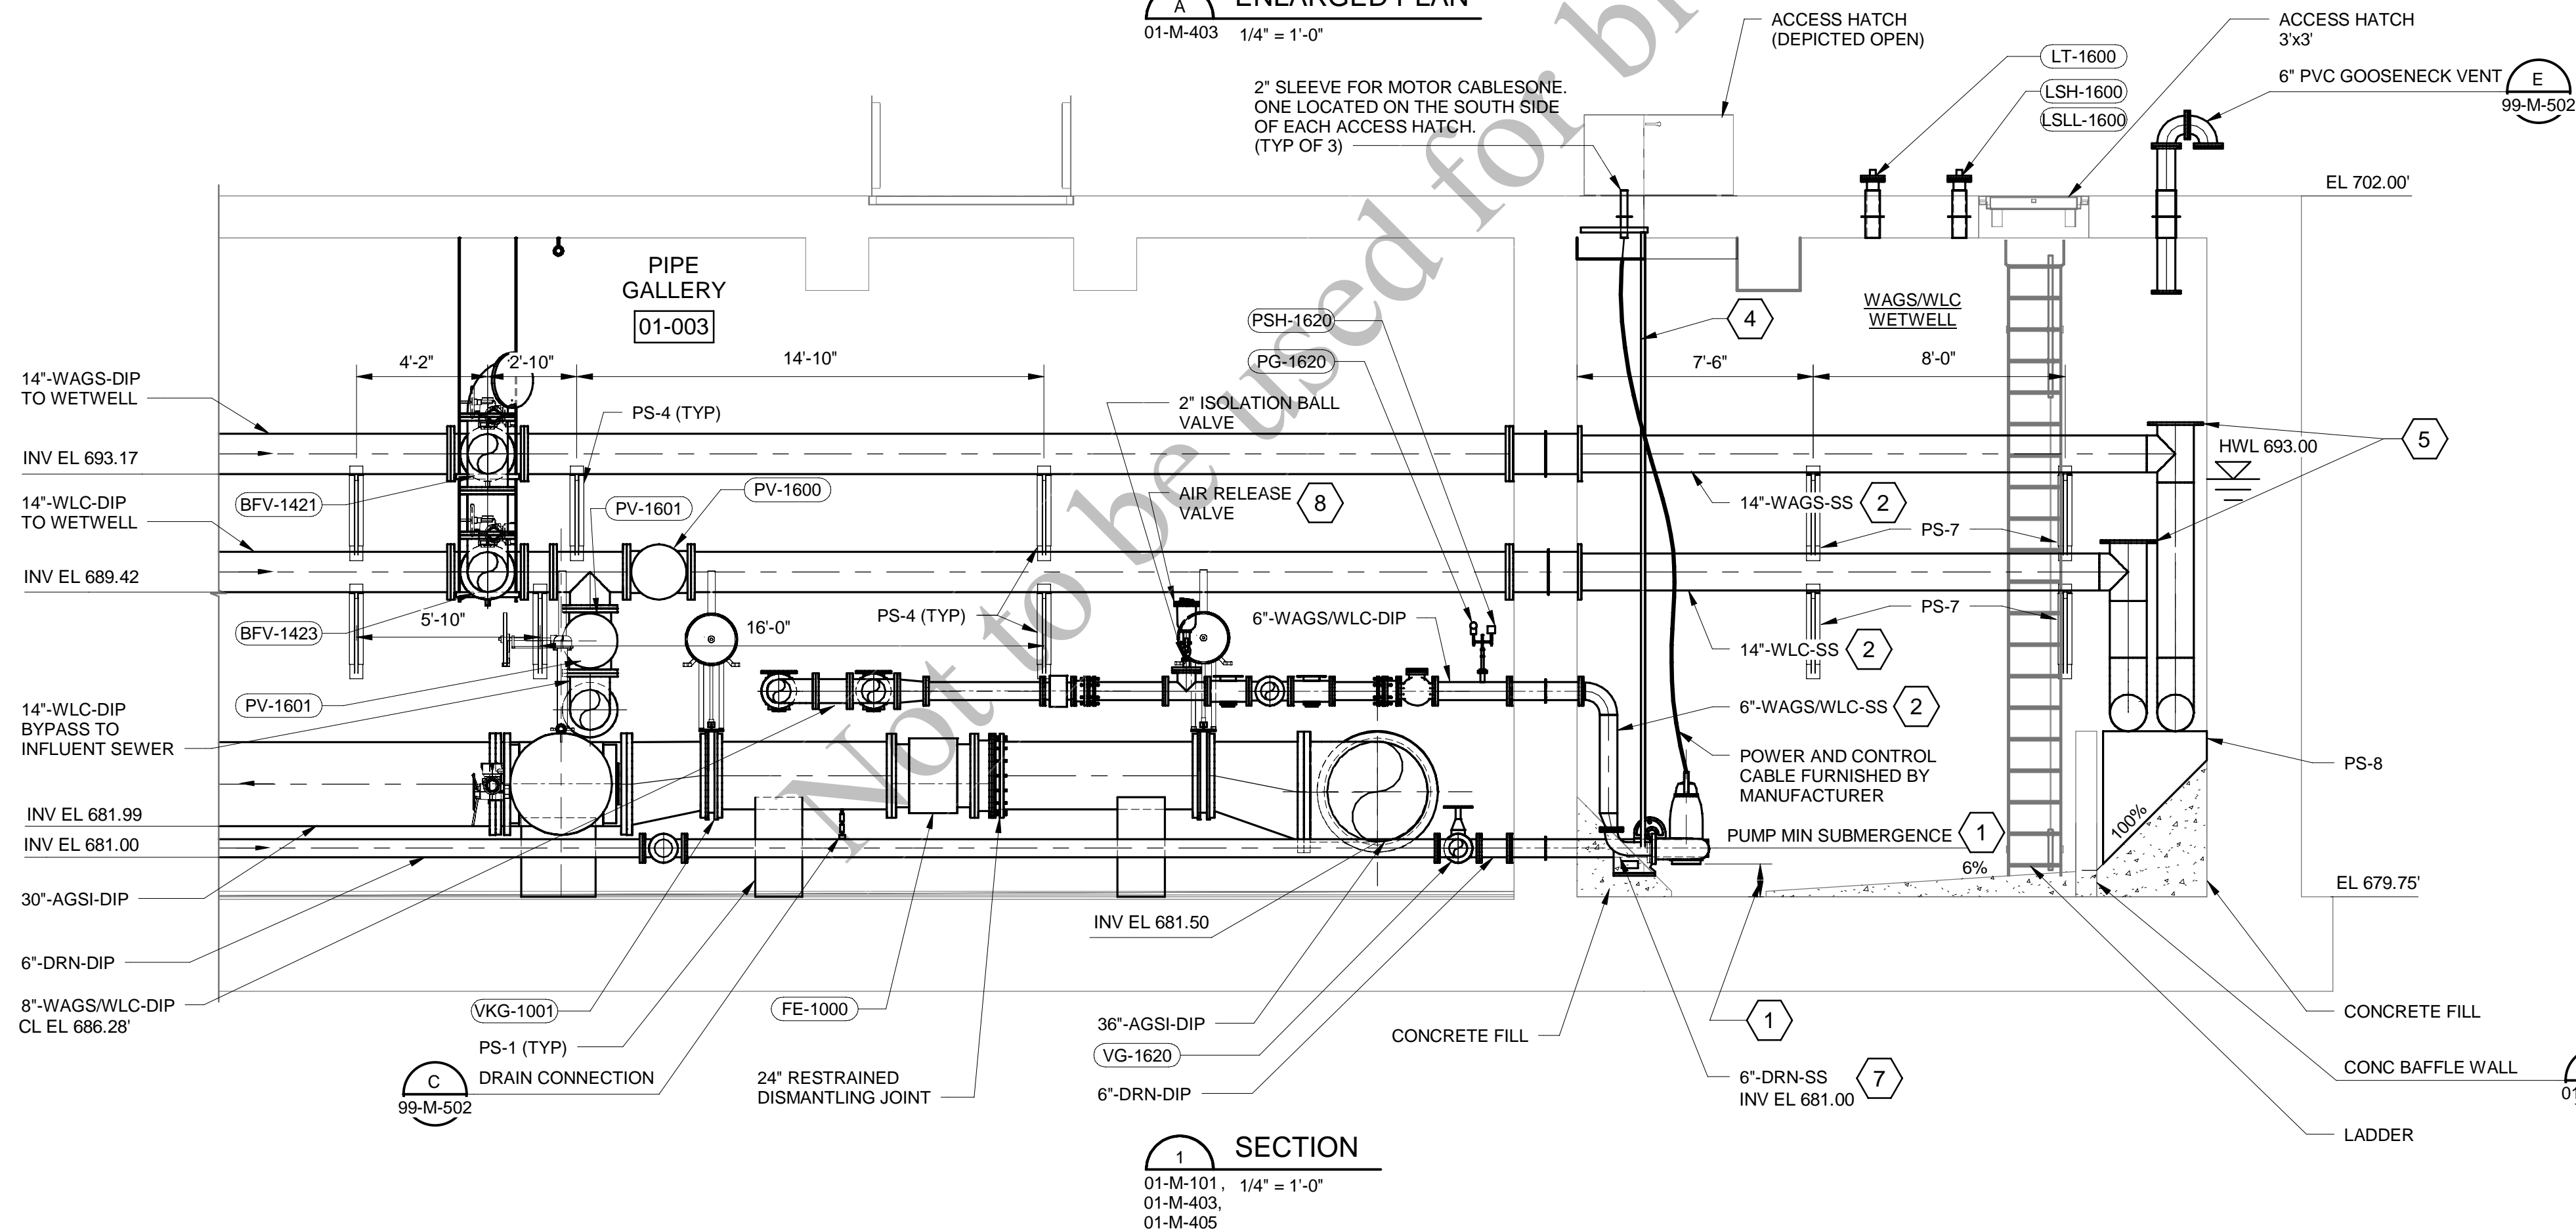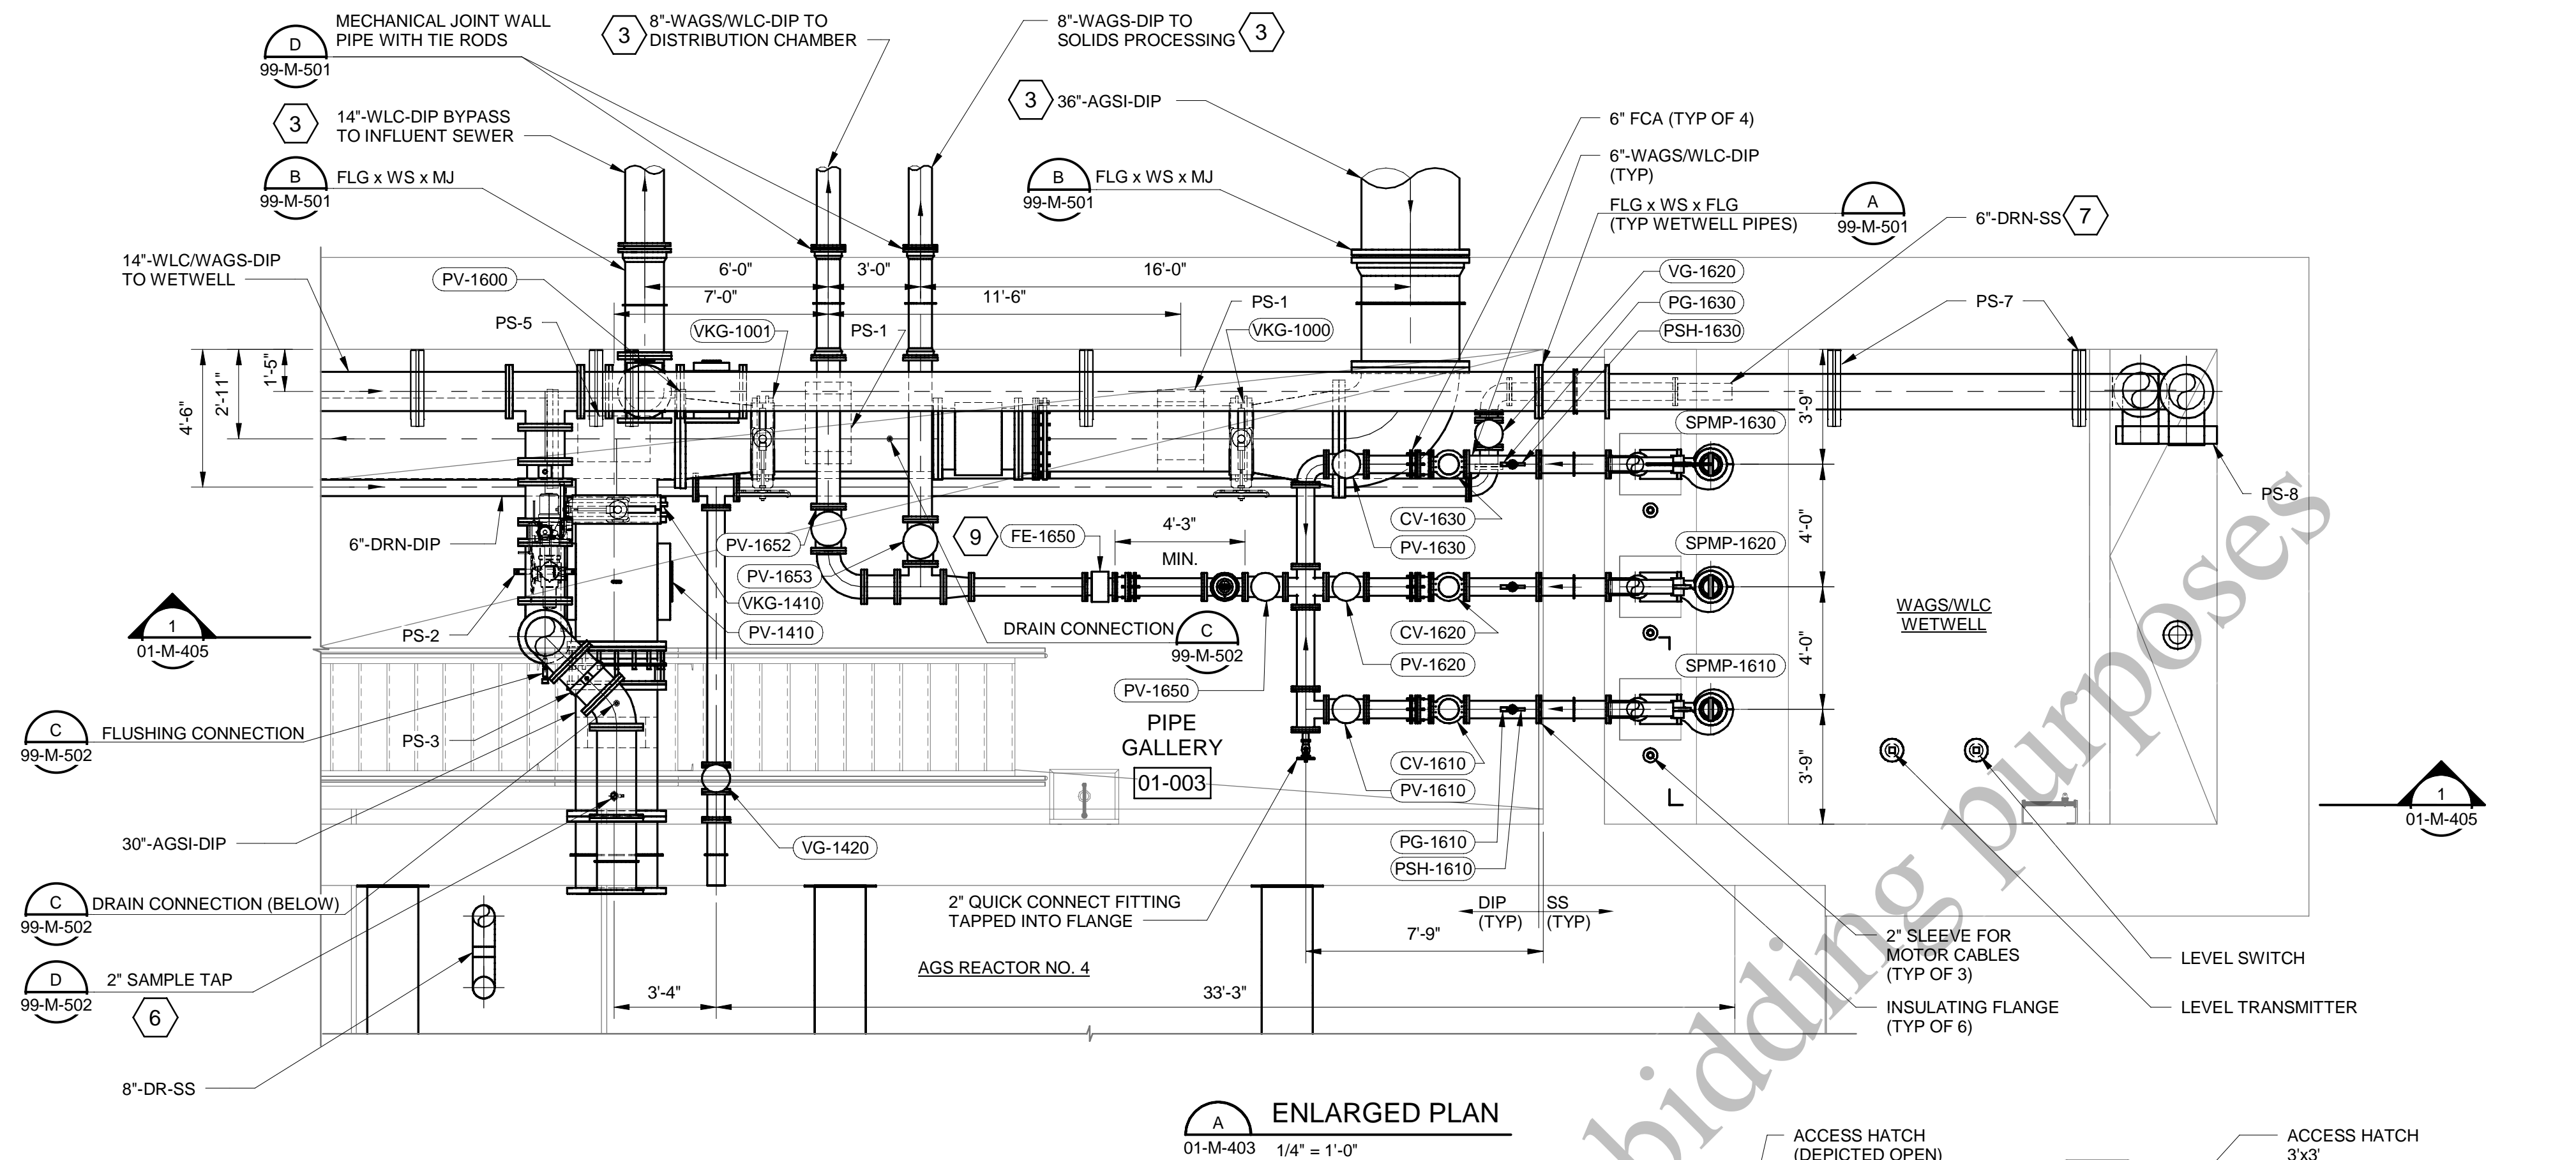

GENERAL SHEET NOTES

1. PIPING AND PIPE SUPPORTS IN WAGS/WLC WETWELL SHALL BE DUPLEX STAINLESS STEEL AND TRANSITION TO DUCTILE IRON PIPE AT LOCATION SHOWN IN PIPE GALLERY.
2. PS-X REPRESENTS PIPE SUPPORT TYPE. SEE PIPE SUPPORT SCHEDULE ON SHEET 99-M-502.

AIR PIPING SUPPORT TYPES ARE IDENTIFIED USING THE FOLLOWING DESIGNATIONS:

(G) : GUIDE SUPPORT
(A) : AXIAL STOP
(V) : VERTICAL SUPPORT
(SPR) : SPRING HANGER SUPPORT
3. CONTRACTOR SHALL USE HANGER SUPPORTS FROM THE ROOF FOR ALL THE WAGS/WLC DISCHARGE LINES IN THE PIPE GALLERY.
4. PIPE SUPPORTS TO BE ADJUSTED IN THE FIELD AS REQUIRED TO AVOID FLANGE LOCATIONS IN PIPES.
5. ALL MATERIALS LOCATED IN THE WAGS/WLC WETWELL SHALL BE CORROSION RESISTANT TO A CHLORIDE CONCENTRATION OF 300 MG/L.

SHEET KEYNOTES

1. VARIES BY PUMP MANUFACTURER. CONTRACTOR TO COORDINATE.
2. FLANGED STAINLESS STEEL CAN BE SUBSTITUTED FOR WELDED STAINLESS STEEL. PROVIDE FLANGED PIPE AT WALL FITTINGS AS SHOWN ON THE DRAWINGS.
3. SEE YARD PIPING DRAWINGS FOR CONTINUATION.
4. PUMP MANUFACTURER SHALL PROVIDE STAINLESS STEEL GUIDE RAIL, GUIDE RAIL SUPPORTS, INTERMEDIATE GUIDE RAIL BRACKETS, AND CABLE HOOK. CONTRACTOR SHALL COORDINATE GUIDE RAIL SPACING WITH PUMP MANUFACTURER.
5. PROVIDE TEE WITH OPEN FLANGE IN VERTICAL FOR AIR RELEASE.
6. CONTRACTOR TO FIELD ROUTE SAMPLE PIPING TO NEAREST SERVICE SINK.
7. PROVIDE 6" DUCKBILL CHECK VALVE, RED VALVE TIDEFLEX SERIES TF-2 OR APPROVED EQUAL. PER SHEET KEYNOTE 2, PROVIDE SERIES 35 OR APPROVED EQUAL FOR FLANGED PIPING.
8. DISCHARGE LINE FROM AIR RELEASE VALVE SHALL BE SLOPED AND FIELD ROUTED TO NEAREST FLOOR DRAIN.
9. FLOWMETER SHALL BE PROVIDED WITH MINIMUM UPSTREAM STRAIGHT RUN OF 5 PIPE DIAMETERS AND MINIMUM DOWNSTREAM STRAIGHT RUN OF 2 PIPE DIAMETERS.



Black & Veatch Corporation
Chicago, Illinois
ILLINOIS PROFESSIONAL
DESIGN FIRM - 184.002143-0006



AEROBIC GRANULAR SLUDGE - PHASE 1

REVISIONS AND RECORD OF ISSUE

DESIGNED:	JL
DETAILED:	VP
CHECKED:	AM/JH
APPROVED:	MR
DATE:	12/20/2022
PROJECT NO.:	411752


AGS REACTORS AND PIPE GALLERY

PROCESS MECHANICAL

WETWELL ENLARGED PLAN AND SECTION

01-M-405

75
OF
163

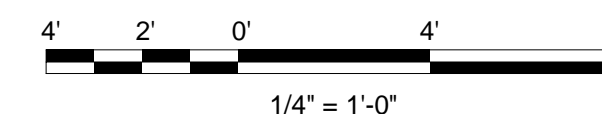

(SCALE BAR IS 4' AT FULL SCALE) 0 1/2 1 2 3 4

REVISIONS AND RECORD OF ISSUE	
DESIGNED:	AM
DETAILED:	KDG
CHECKED:	AM/JH
APPROVED:	MR
DATE:	12/20/2022
PROJECT NO.:	411752


AGS REACTORS AND PIPE
GALLERY

PROCESS MECHANICAL


PERSPECTIVE VIEWS

01-M-901


76
OF
163

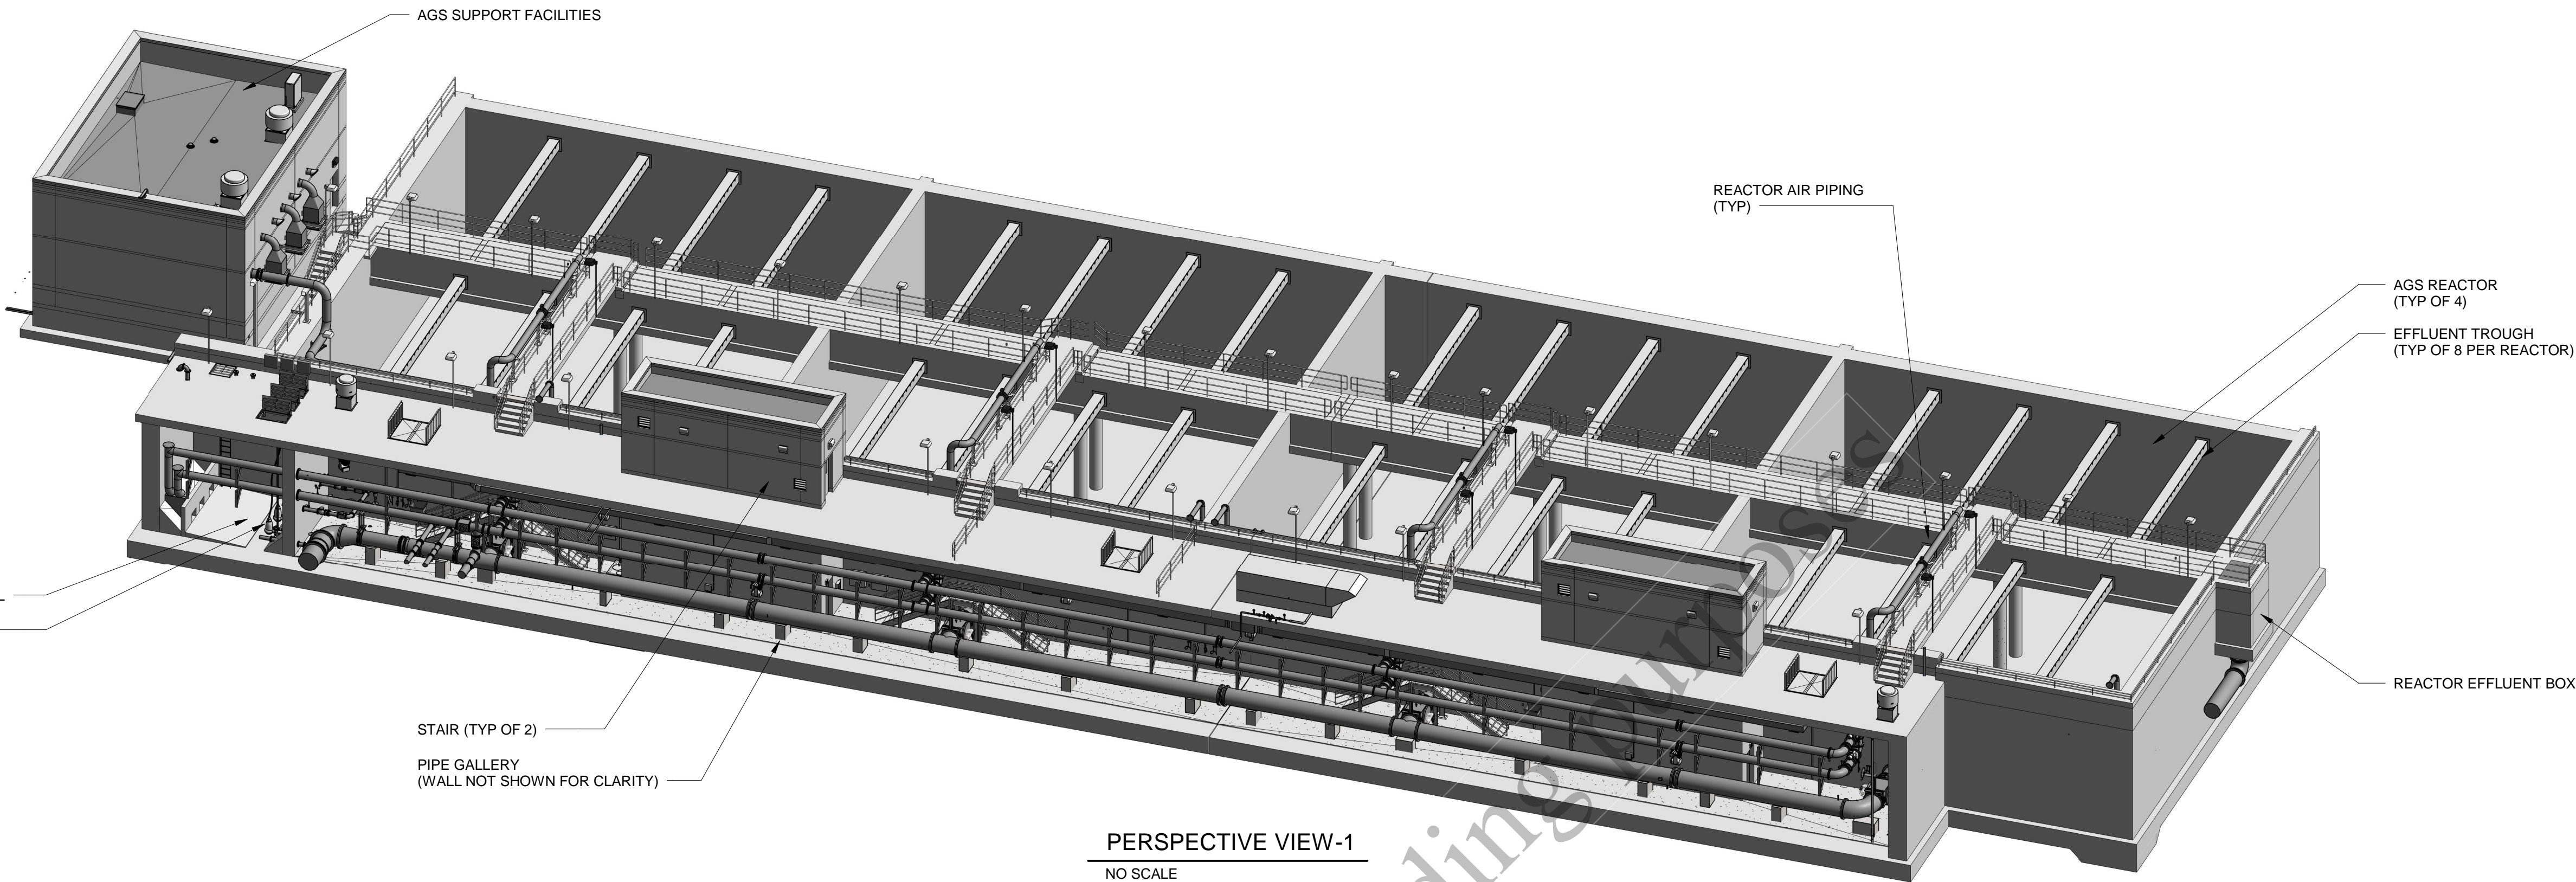

PERSPECTIVE VIEW-1
NO SCALE

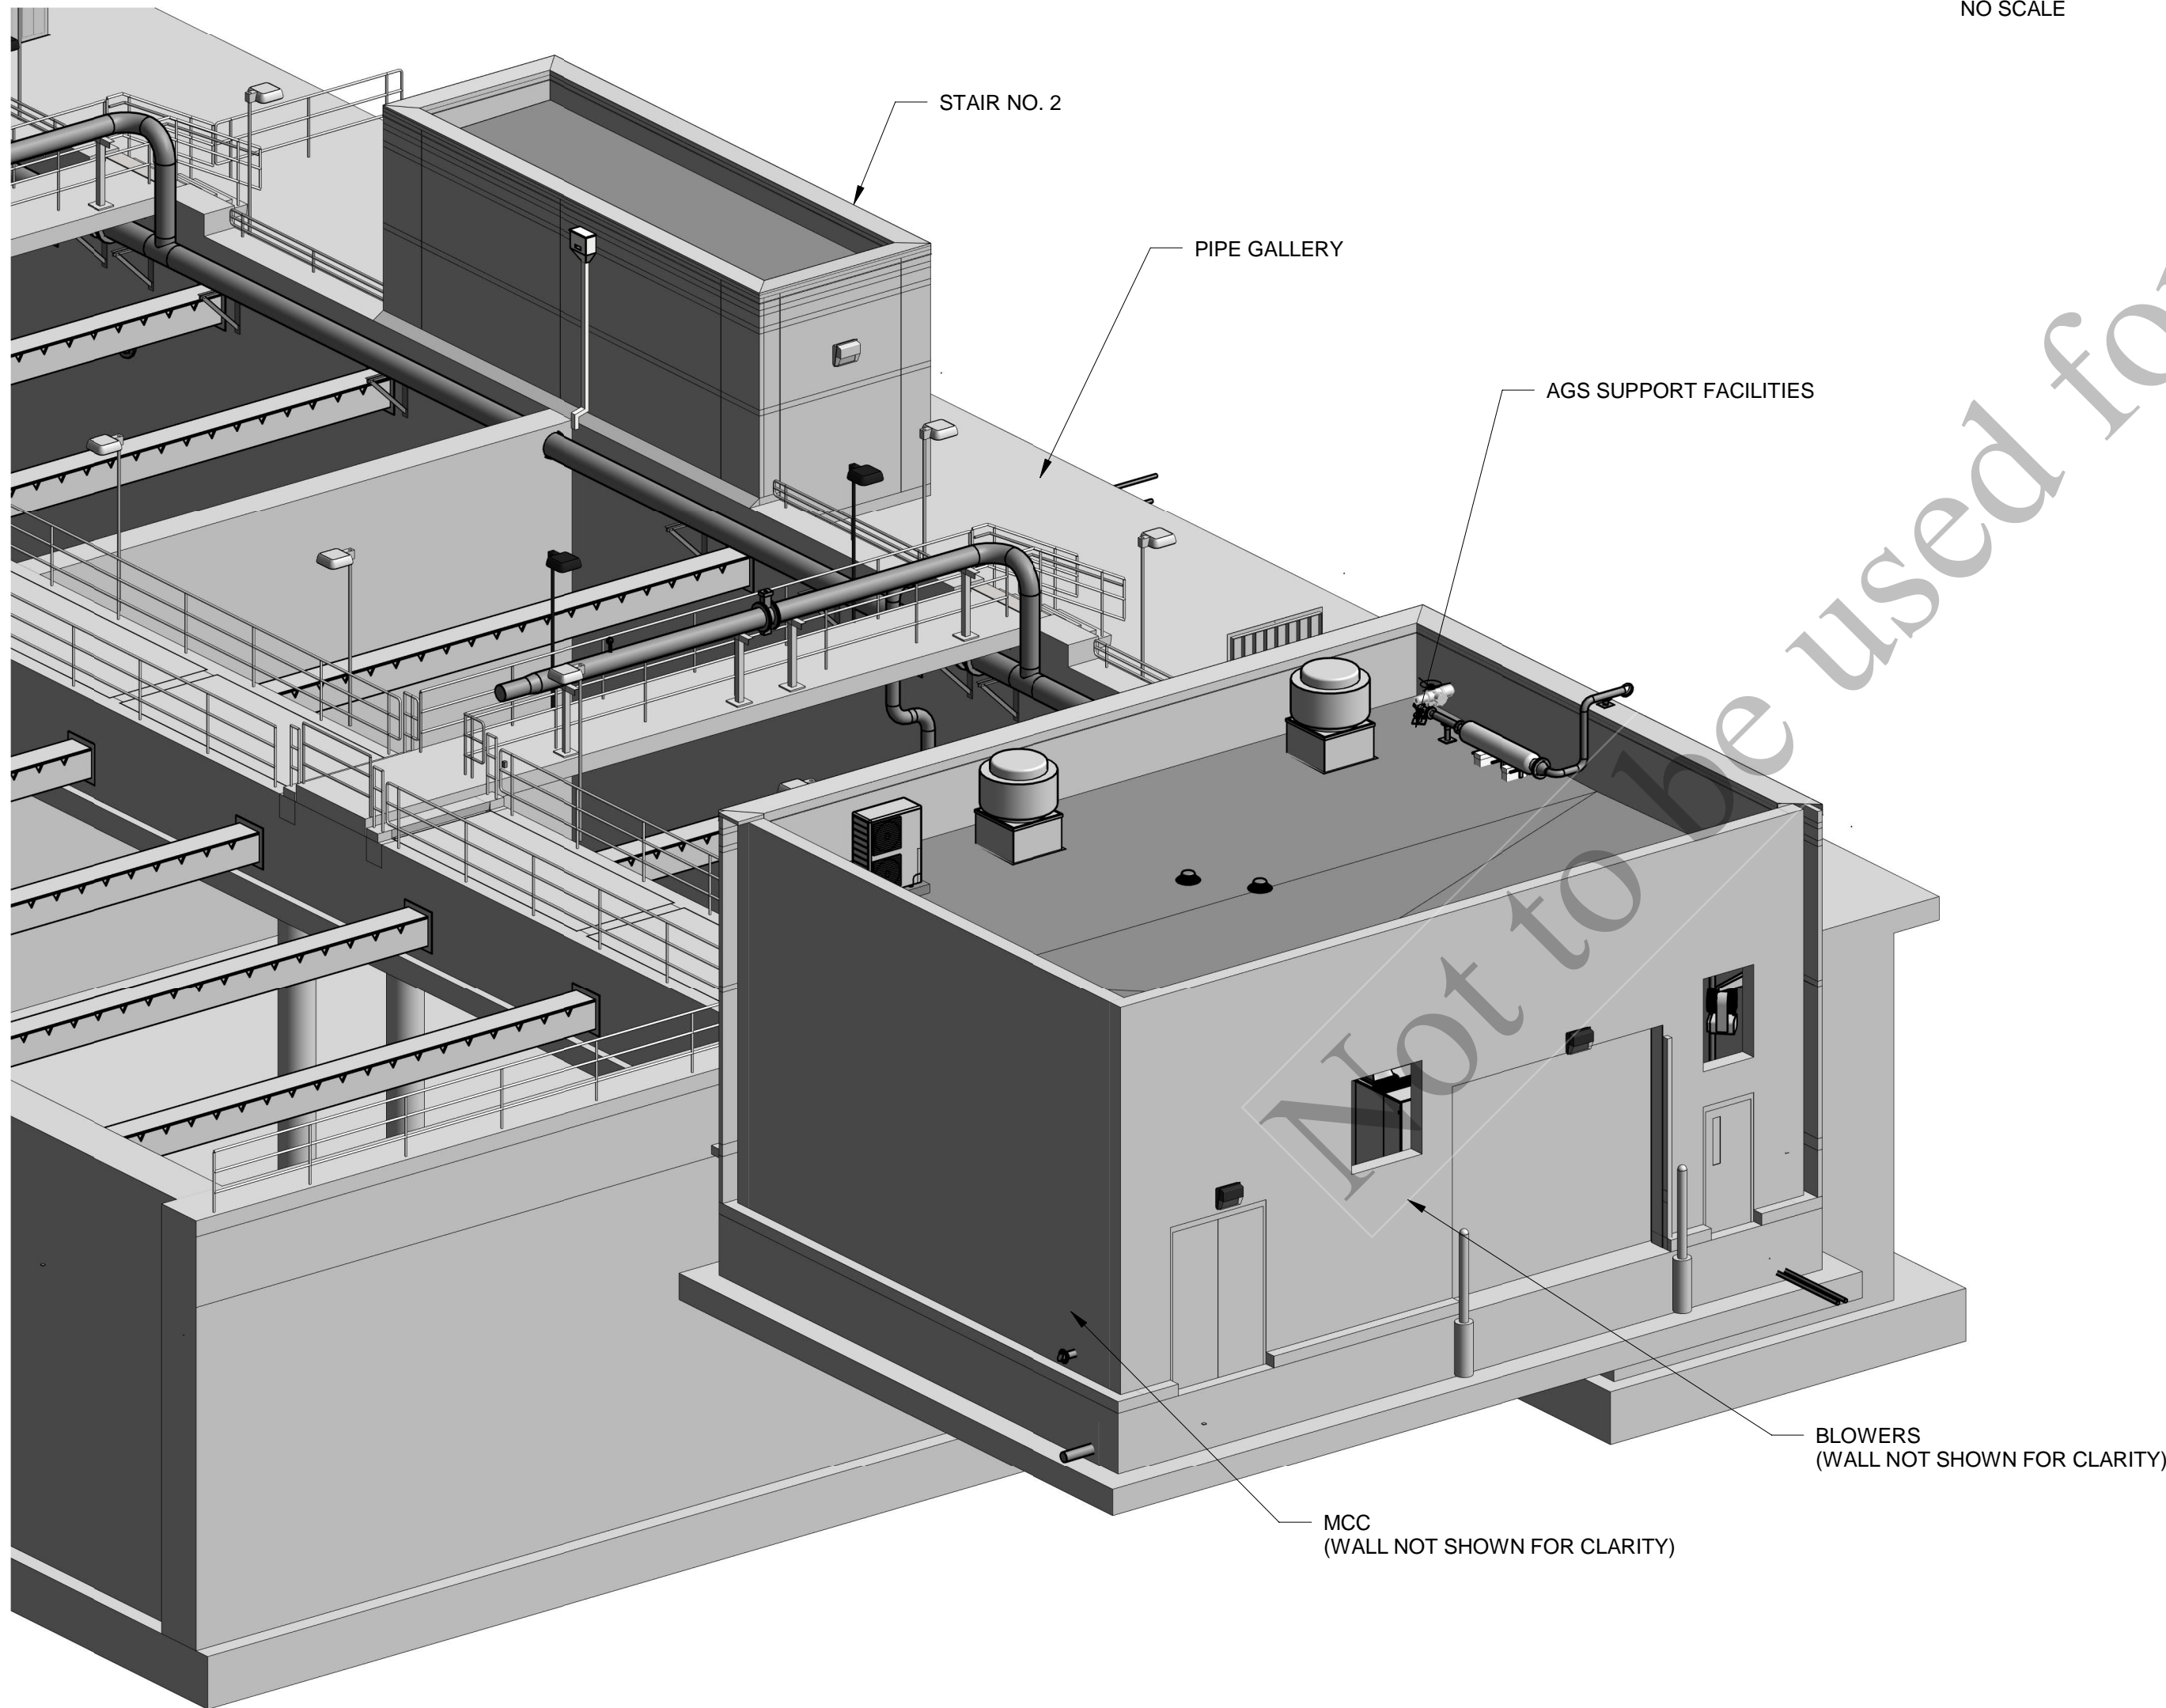

PERSPECTIVE VIEW-2
NO SCALE

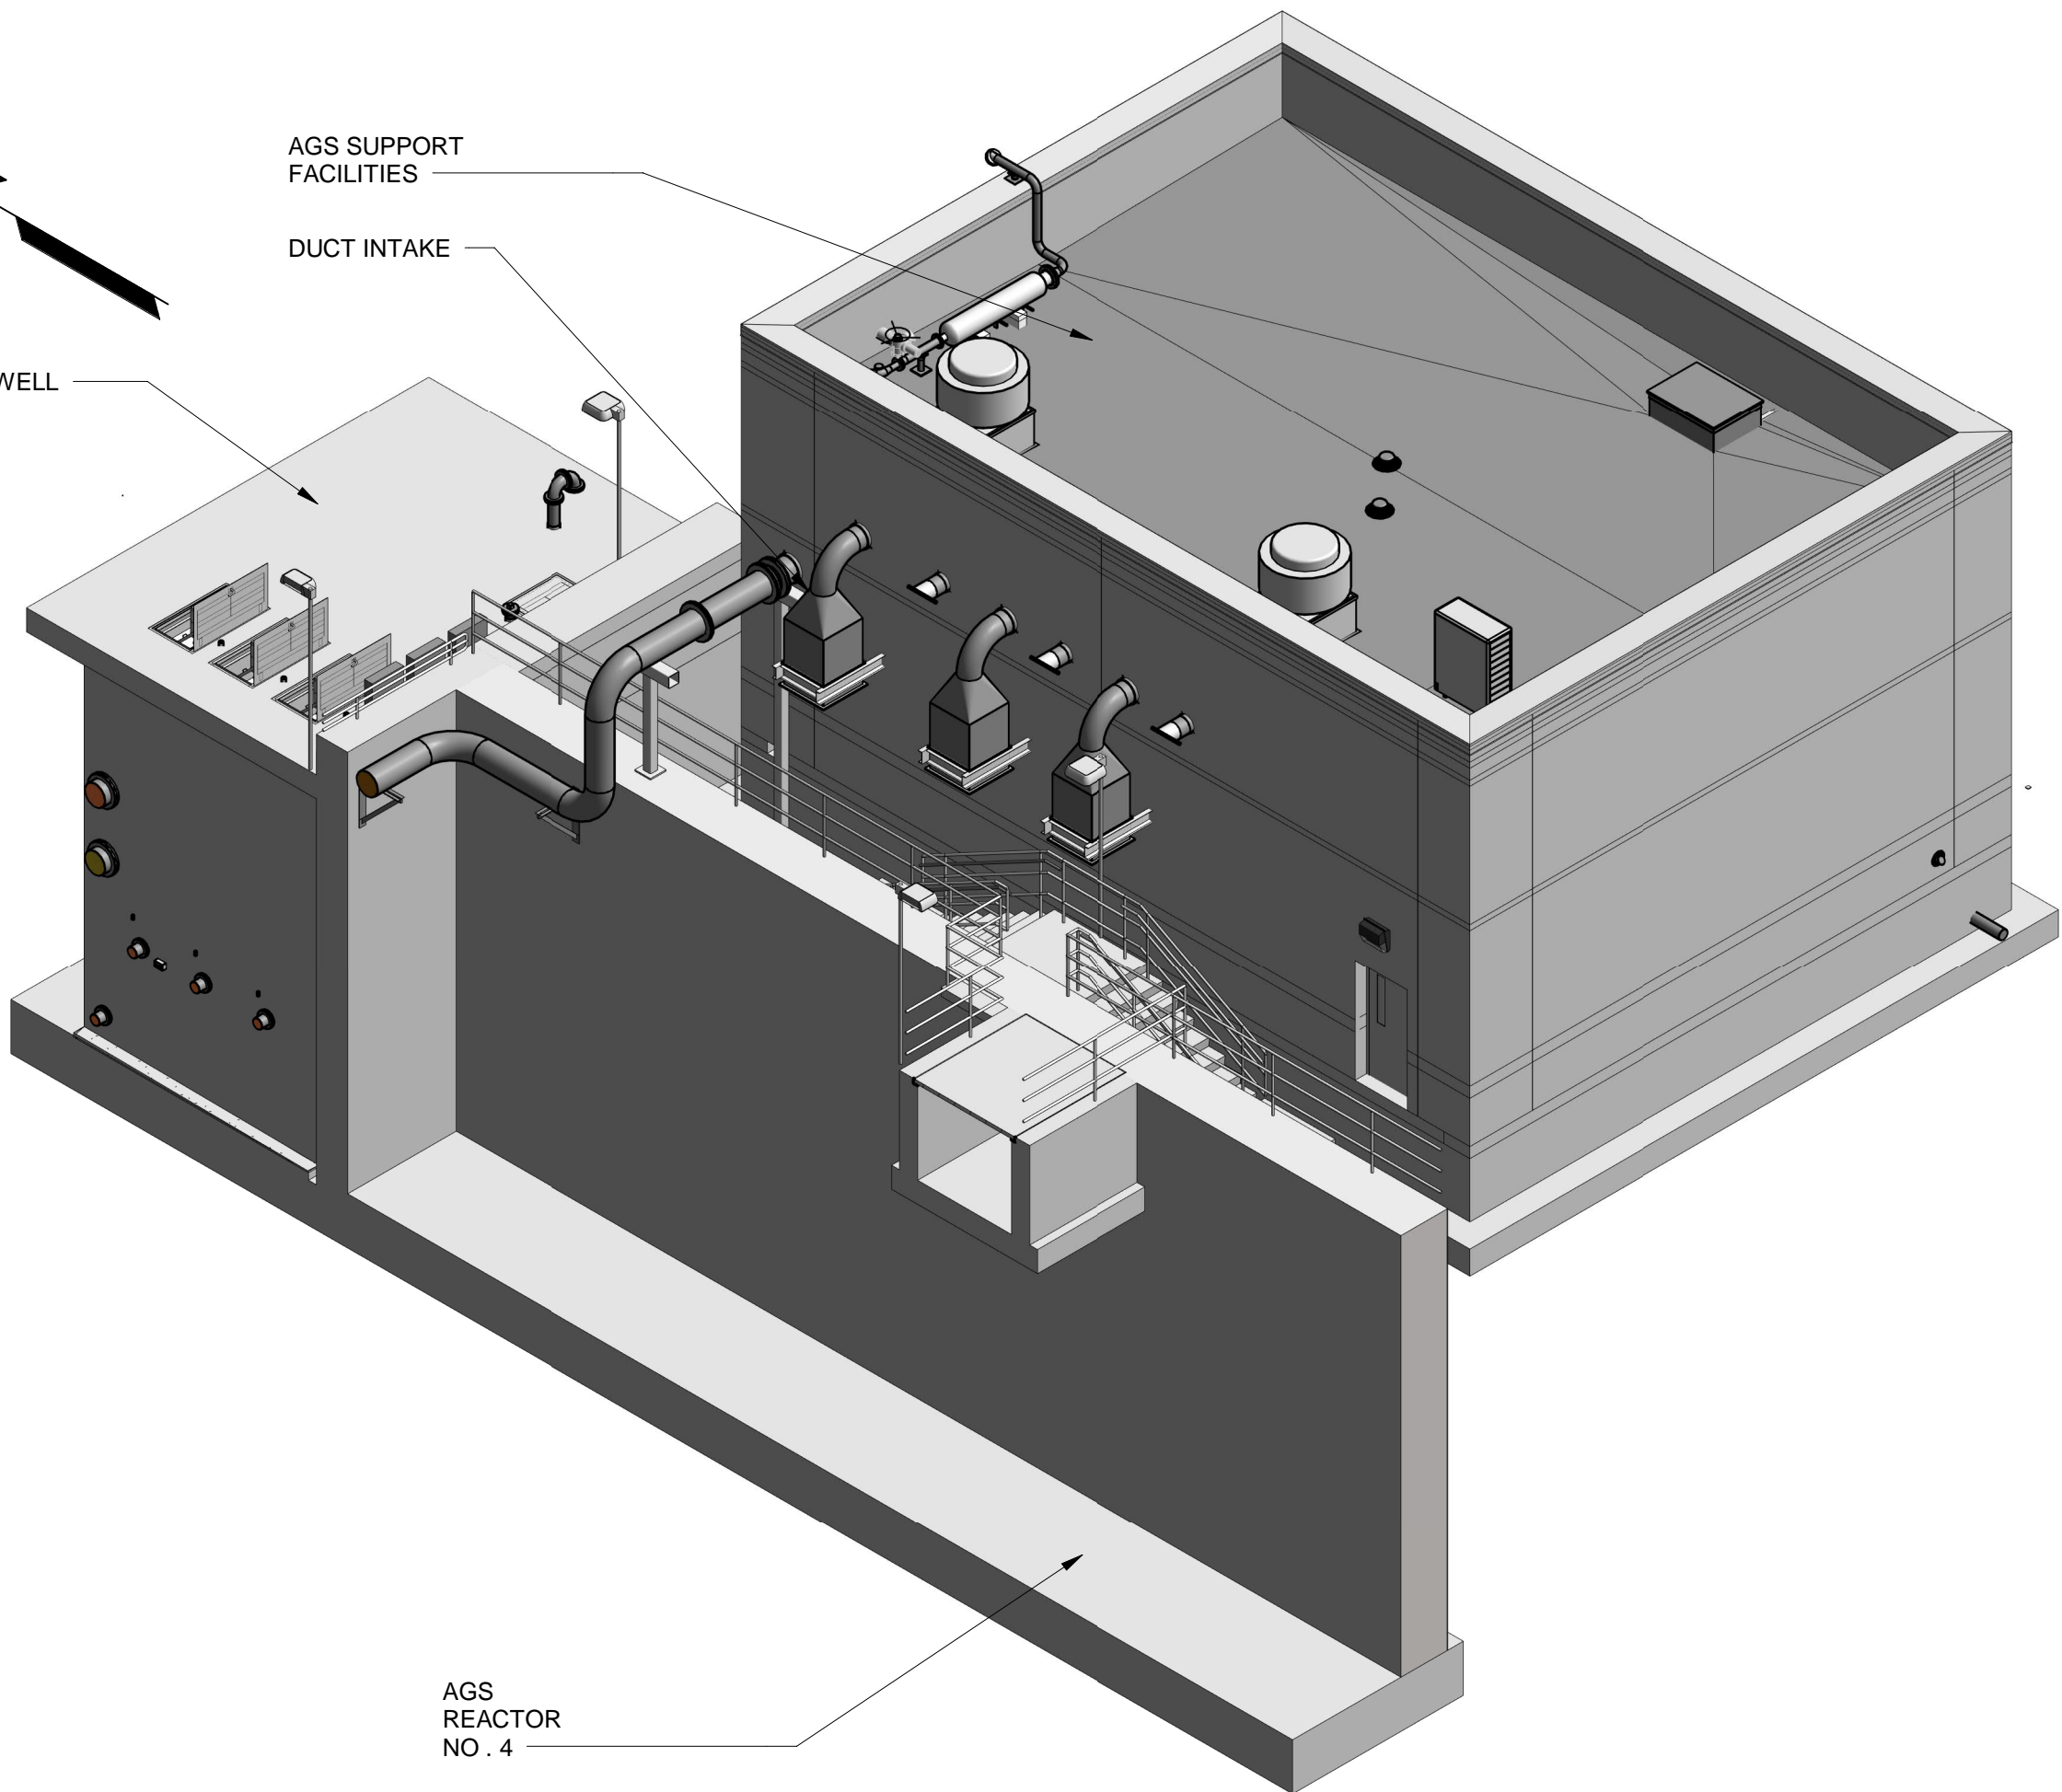

PERSPECTIVE VIEW-3
NO SCALE



GENERAL SHEET NOTES

1. SEE DRAWING 00-H-001 FOR LEGENDS, ABBREVIATIONS AND GENERAL NOTES.



Black & Veatch Corporation
Chicago, Illinois
ILLINOIS PROFESSIONAL
DESIGN FIRM - 184.002143-0006



AEROBIC GRANULAR
SLUDGE - PHASE 1

REVISIONS AND RECORD OF ISSUE	
DESIGNED:	VSS
DETAILED:	AJP
CHECKED:	KMC
APPROVED:	SP
DATE:	12/20/2022
PROJECT NO.:	411752


AGS REACTORS AND PIPE
GALLERY

HVAC

REACTORS AND
GALLERY
OVERALL FLOOR PLAN


01-H-101

77
OF
163

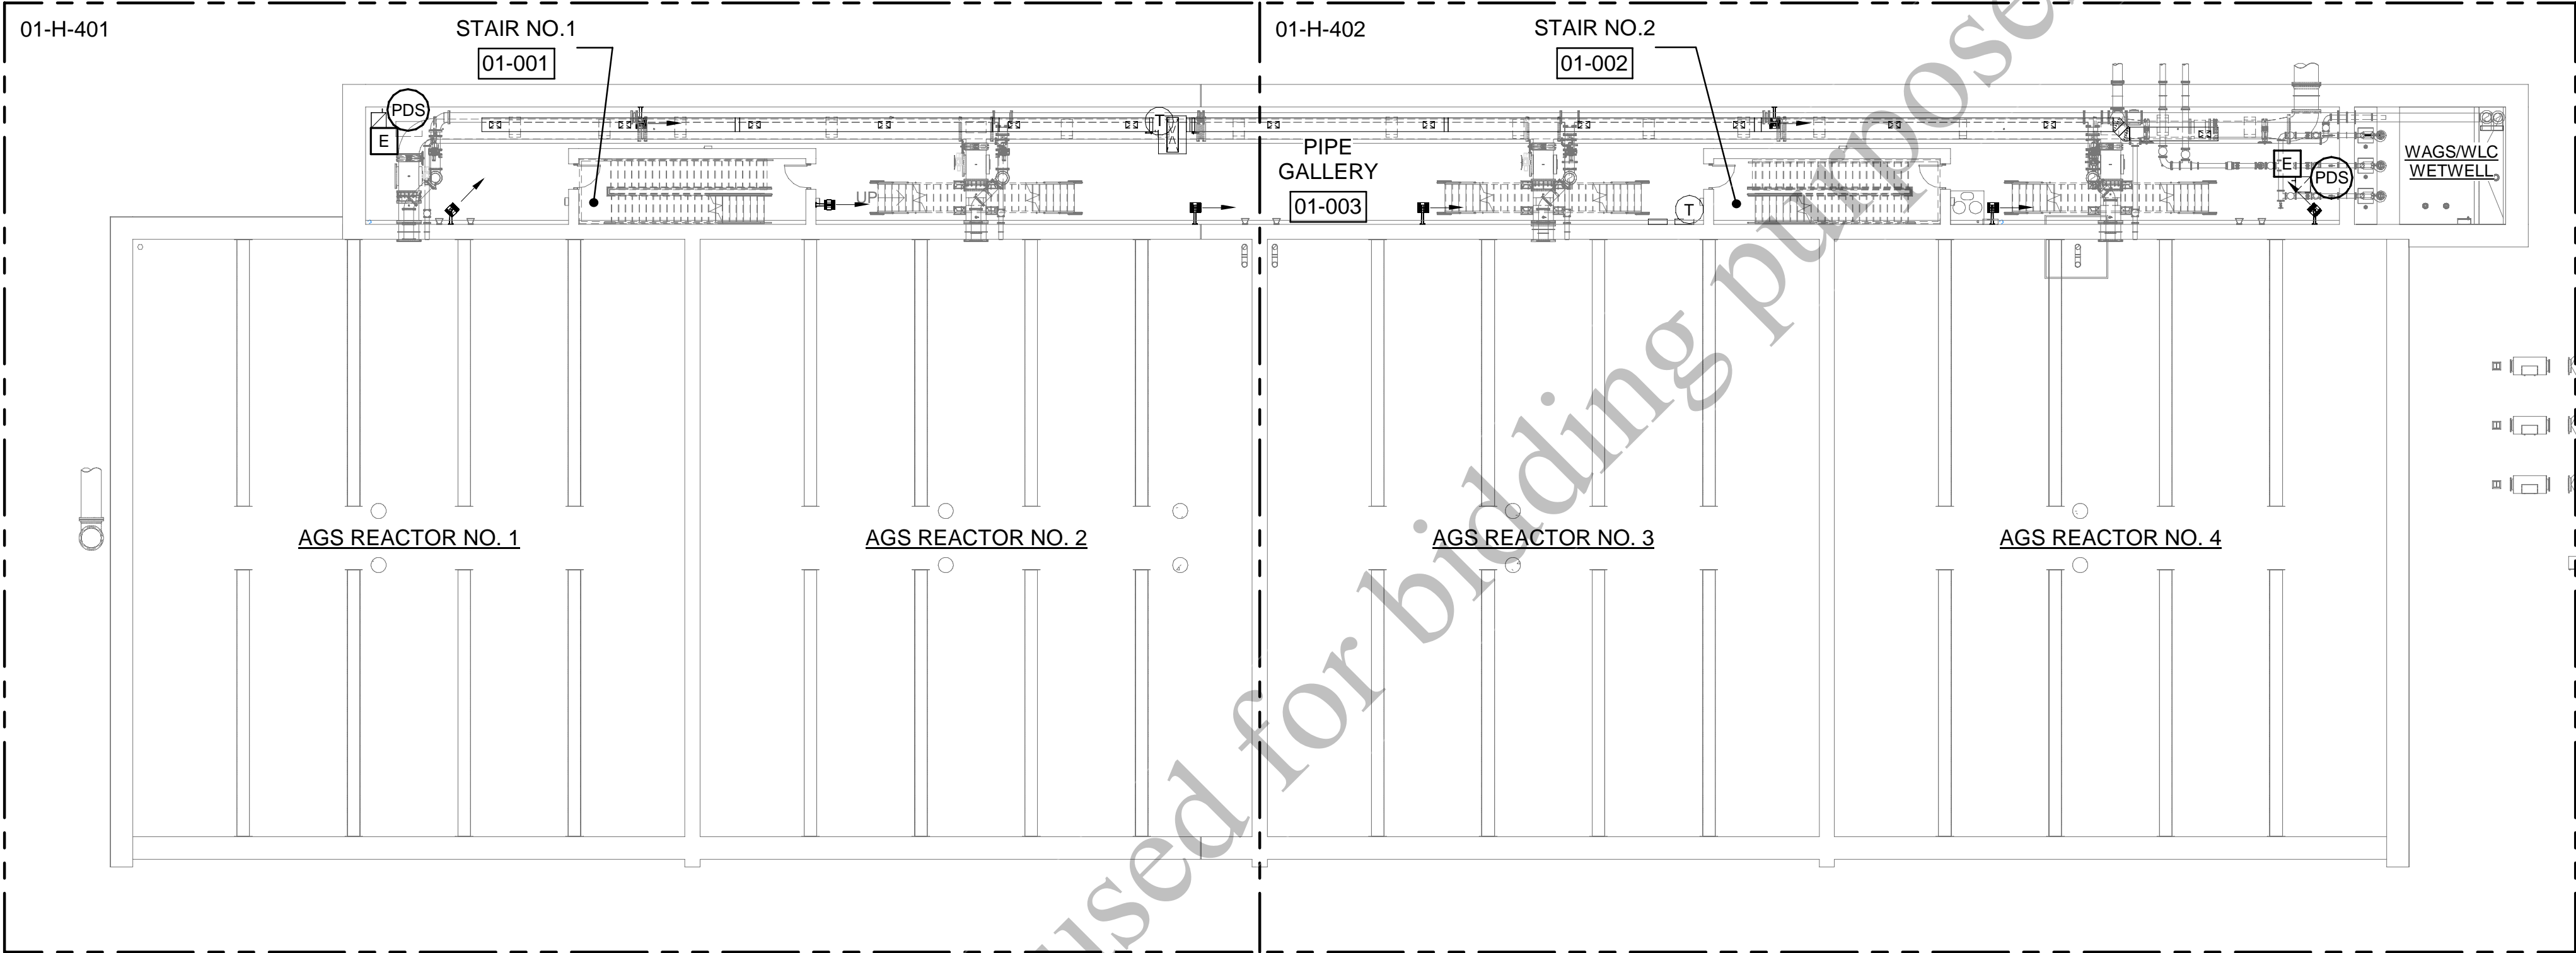

OVERALL FLOOR PLAN

1/16" = 1'-0"

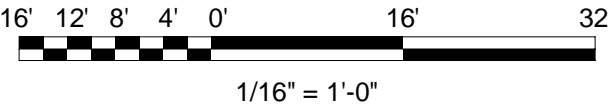

(SCALE BAR IS 4" AT FULL SCALE) 0 1/2 1 2 3 4



GENERAL SHEET NOTES

1. SEE DRAWING 00-H-001 FOR LEGENDS, ABBREVIATIONS AND GENERAL NOTES.



Black & Veatch Corporation
Chicago, Illinois
ILLINOIS PROFESSIONAL
DESIGN FIRM - 184.002143-0006



AEROBIC GRANULAR
SLUDGE - PHASE 1

REVISIONS AND RECORD OF ISSUE	
DESIGNED:	VSS
DETAILED:	AJP
CHECKED:	KMC
APPROVED:	SP
DATE:	12/20/2022
PROJECT NO.:	411752


AGS REACTORS AND PIPE
GALLERY

HVAC

REACTORS AND
GALLERY
OVERALL TOP PLAN


01-H-102

78
OF
163

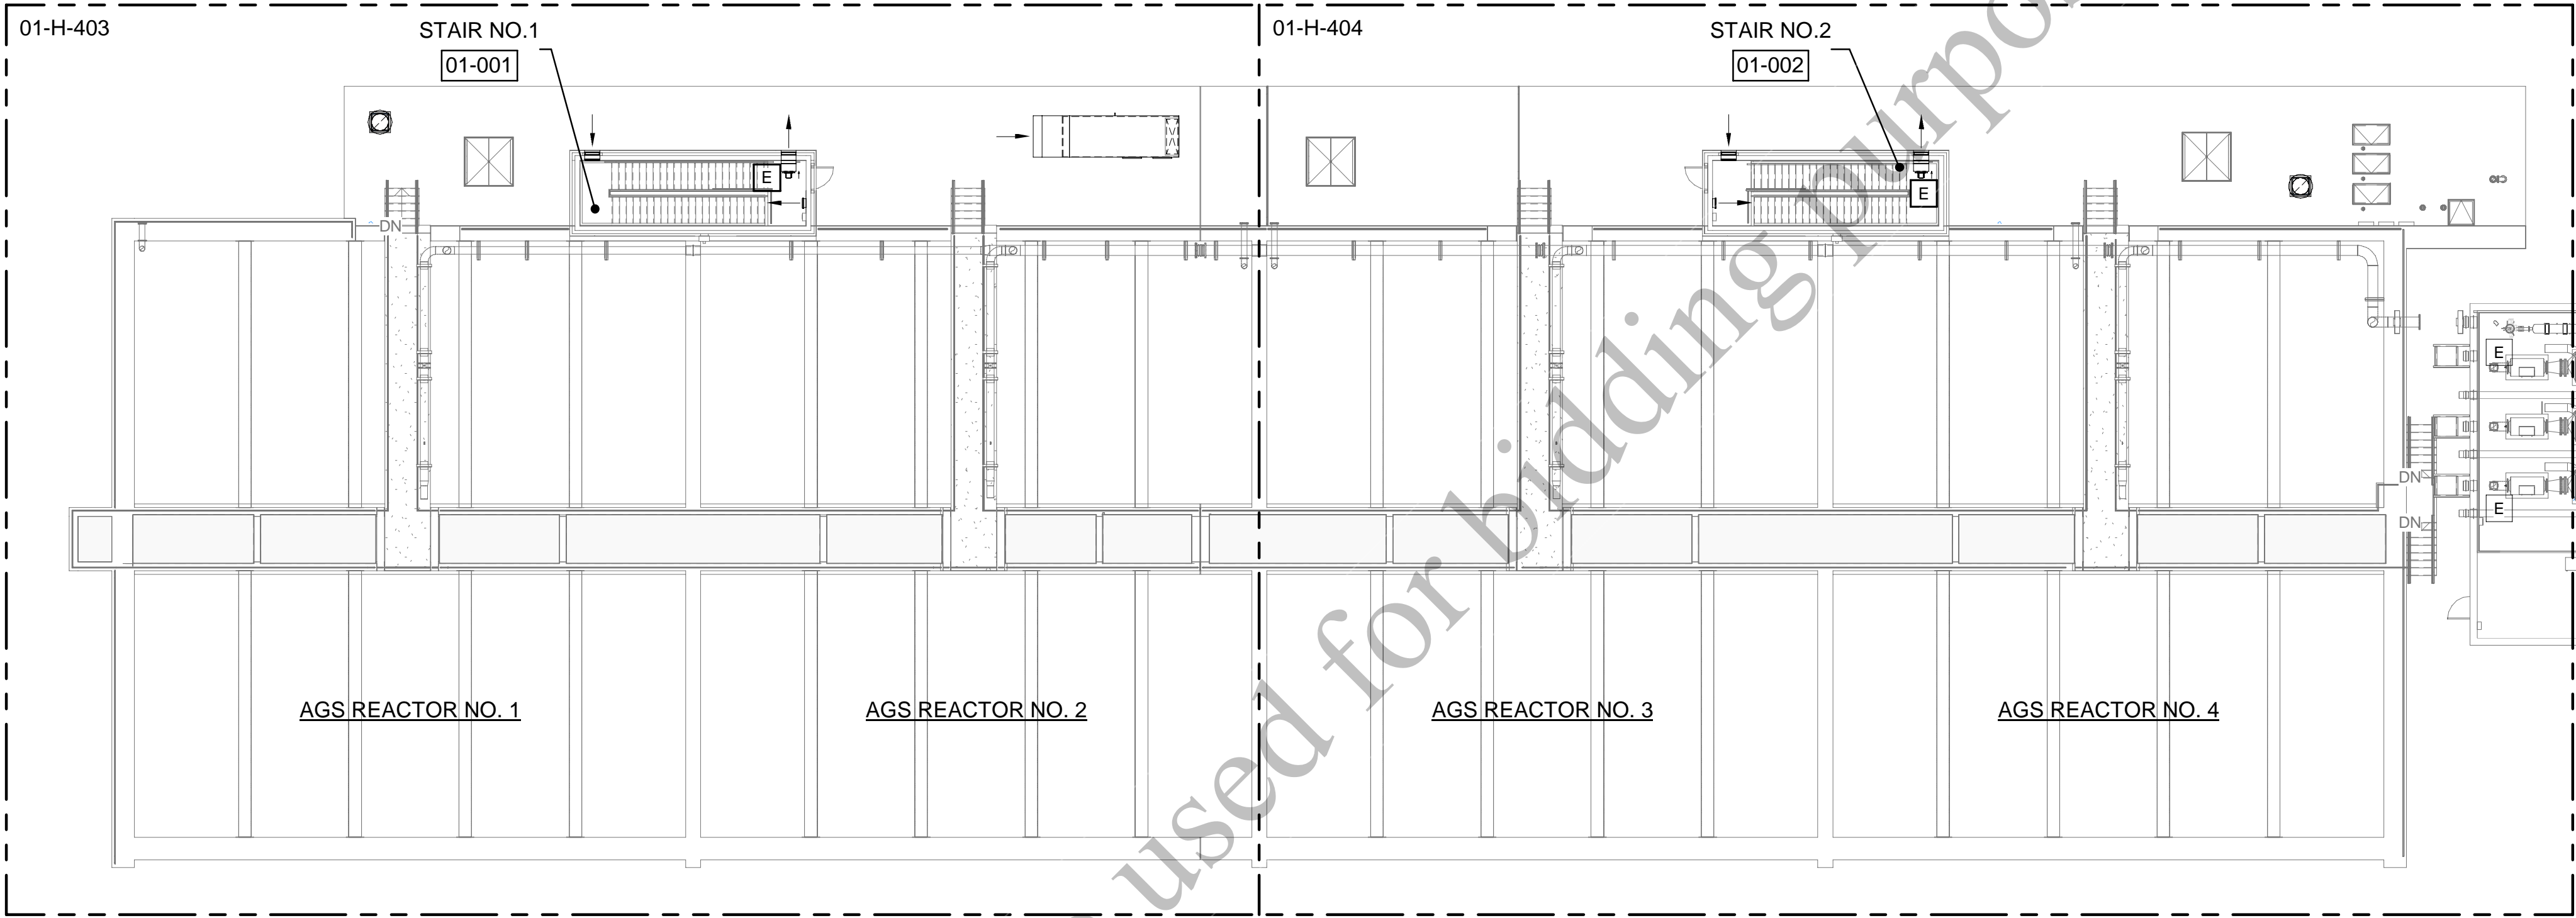


OVERALL TOP PLAN

1/16" = 1'-0"

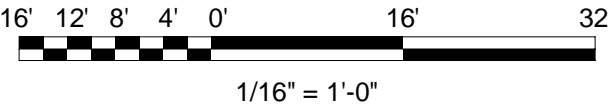

(SCALE BAR IS 4" AT FULL SCALE)

PLOTTED: 12/16/2022 11:48:39 AM
FILE: BIM 360/409469 - Aerobic Granular Sludge Phase 1/409469 - AGS.rvt
D11000

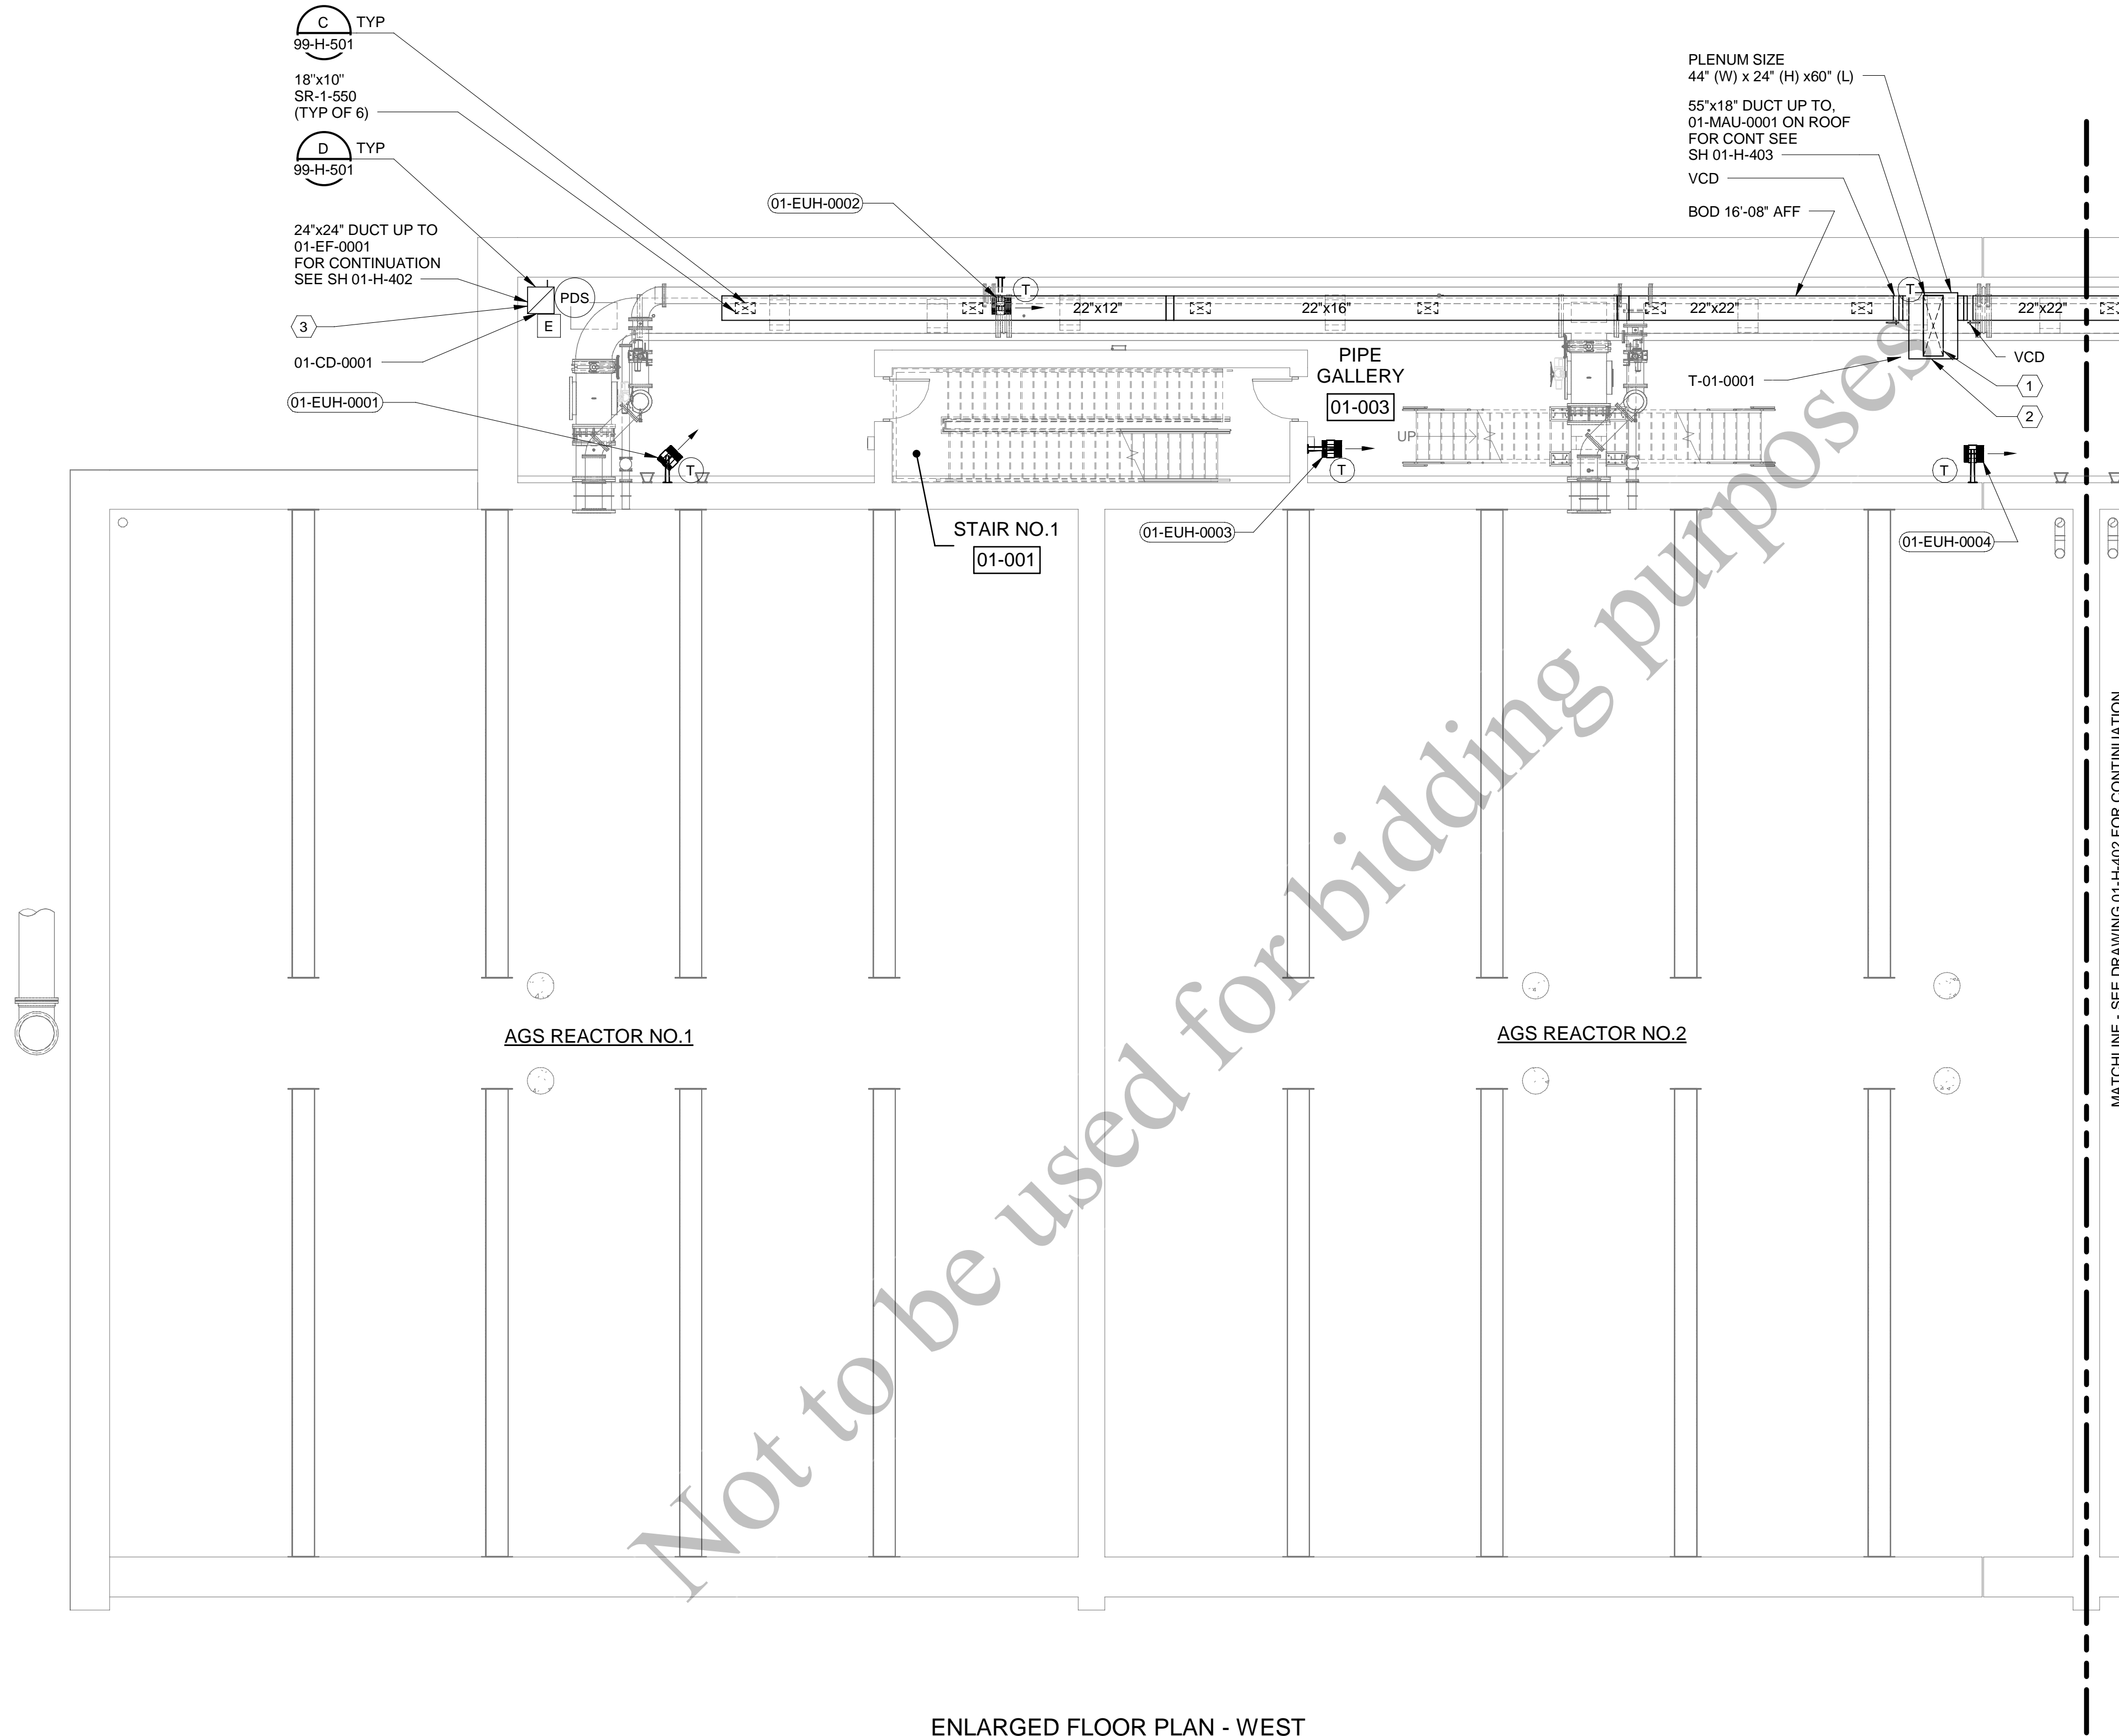

ENLARGED FLOOR PLAN - WEST
1/8" = 1'-0"

GENERAL SHEET NOTES

- SEE DRAWING 00-H-001 FOR LEGENDS, ABBREVIATIONS AND GENERAL NOTES.

SHEET KEYNOTES

- DUCT DROP FROM 01-MAU-0001
MATERIAL - STAINLESS STEEL 304L
- S/A DUCTING - FRP
- DUCT SLEEVES AND PLENUMS FOR
EXHAUST FANS - STAINLESS STEEL 304L



Black & Veatch Corporation
Chicago, Illinois
ILLINOIS PROFESSIONAL
DESIGN FIRM - 184.002143-0006



AEROBIC GRANULAR
SLUDGE - PHASE 1

REVISIONS AND RECORD OF ISSUE	
DESIGNED:	VSS
DETAILED:	AJP
CHECKED:	KMC
APPROVED:	SP
DATE:	12/20/2022
PROJECT NO.:	411752


AGS REACTORS AND PIPE
GALLERY

HVAC


REACTORS AND
GALLERY ENLARGED
FLOOR PLAN - WEST

01-H-401

79
OF
163

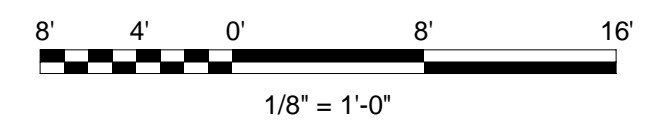

(SCALE BAR IS 4" AT FULL SCALE) 0 1/2 1 2 3 4

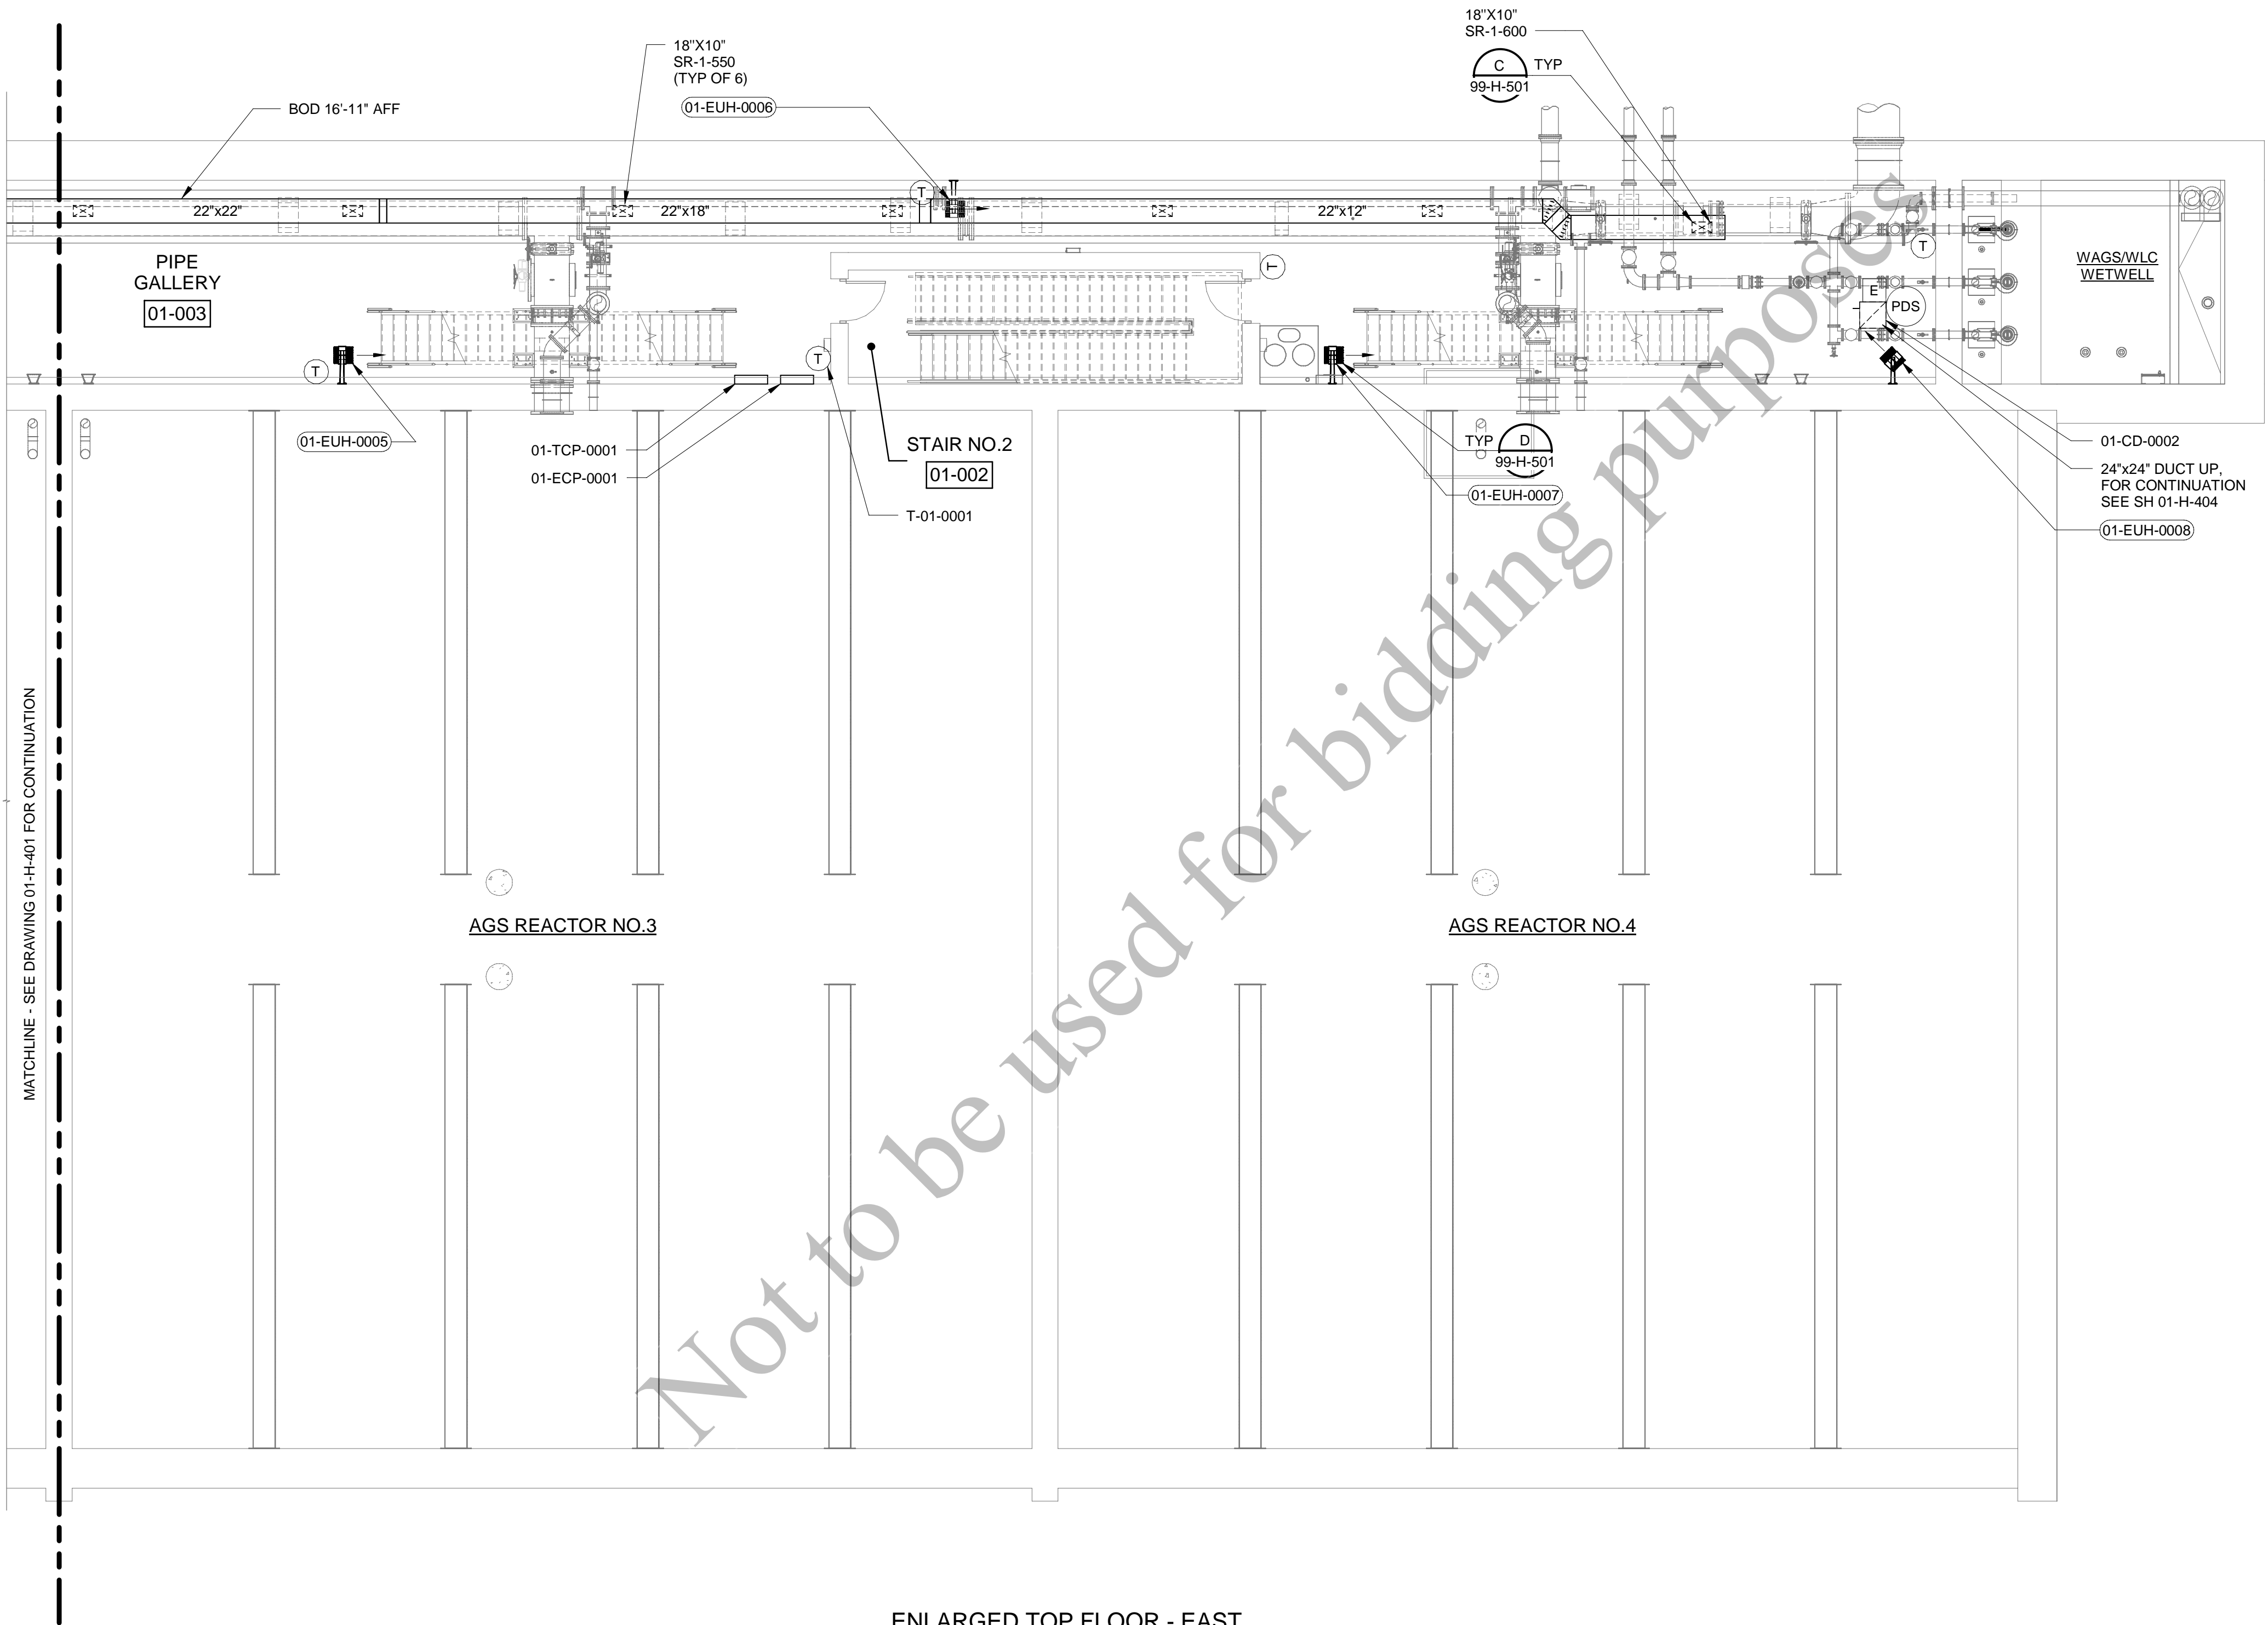

ENLARGED TOP FLOOR - EAST
1/8" = 1'-0"

GENERAL SHEET NOTES

1. SEE DRAWING 00-H-001 FOR LEGENDS, ABBREVIATIONS AND GENERAL NOTES.



Black & Veatch Corporation
Chicago, Illinois
ILLINOIS PROFESSIONAL
DESIGN FIRM - 184.002143-0006



AEROBIC GRANULAR
SLUDGE - PHASE 1

REVISIONS AND RECORD OF ISSUE	
DESIGNED:	VSS
DETAILED:	AJP
CHECKED:	KMC
APPROVED:	SP
DATE:	12/20/2022
PROJECT NO.:	411752


AGS REACTORS AND PIPE
GALLERY


HVAC

REACTORS AND
GALLERY ENLARGED
FLOOR PLAN - EAST

01-H-402

80
OF
163

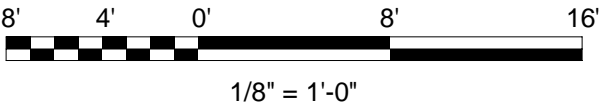

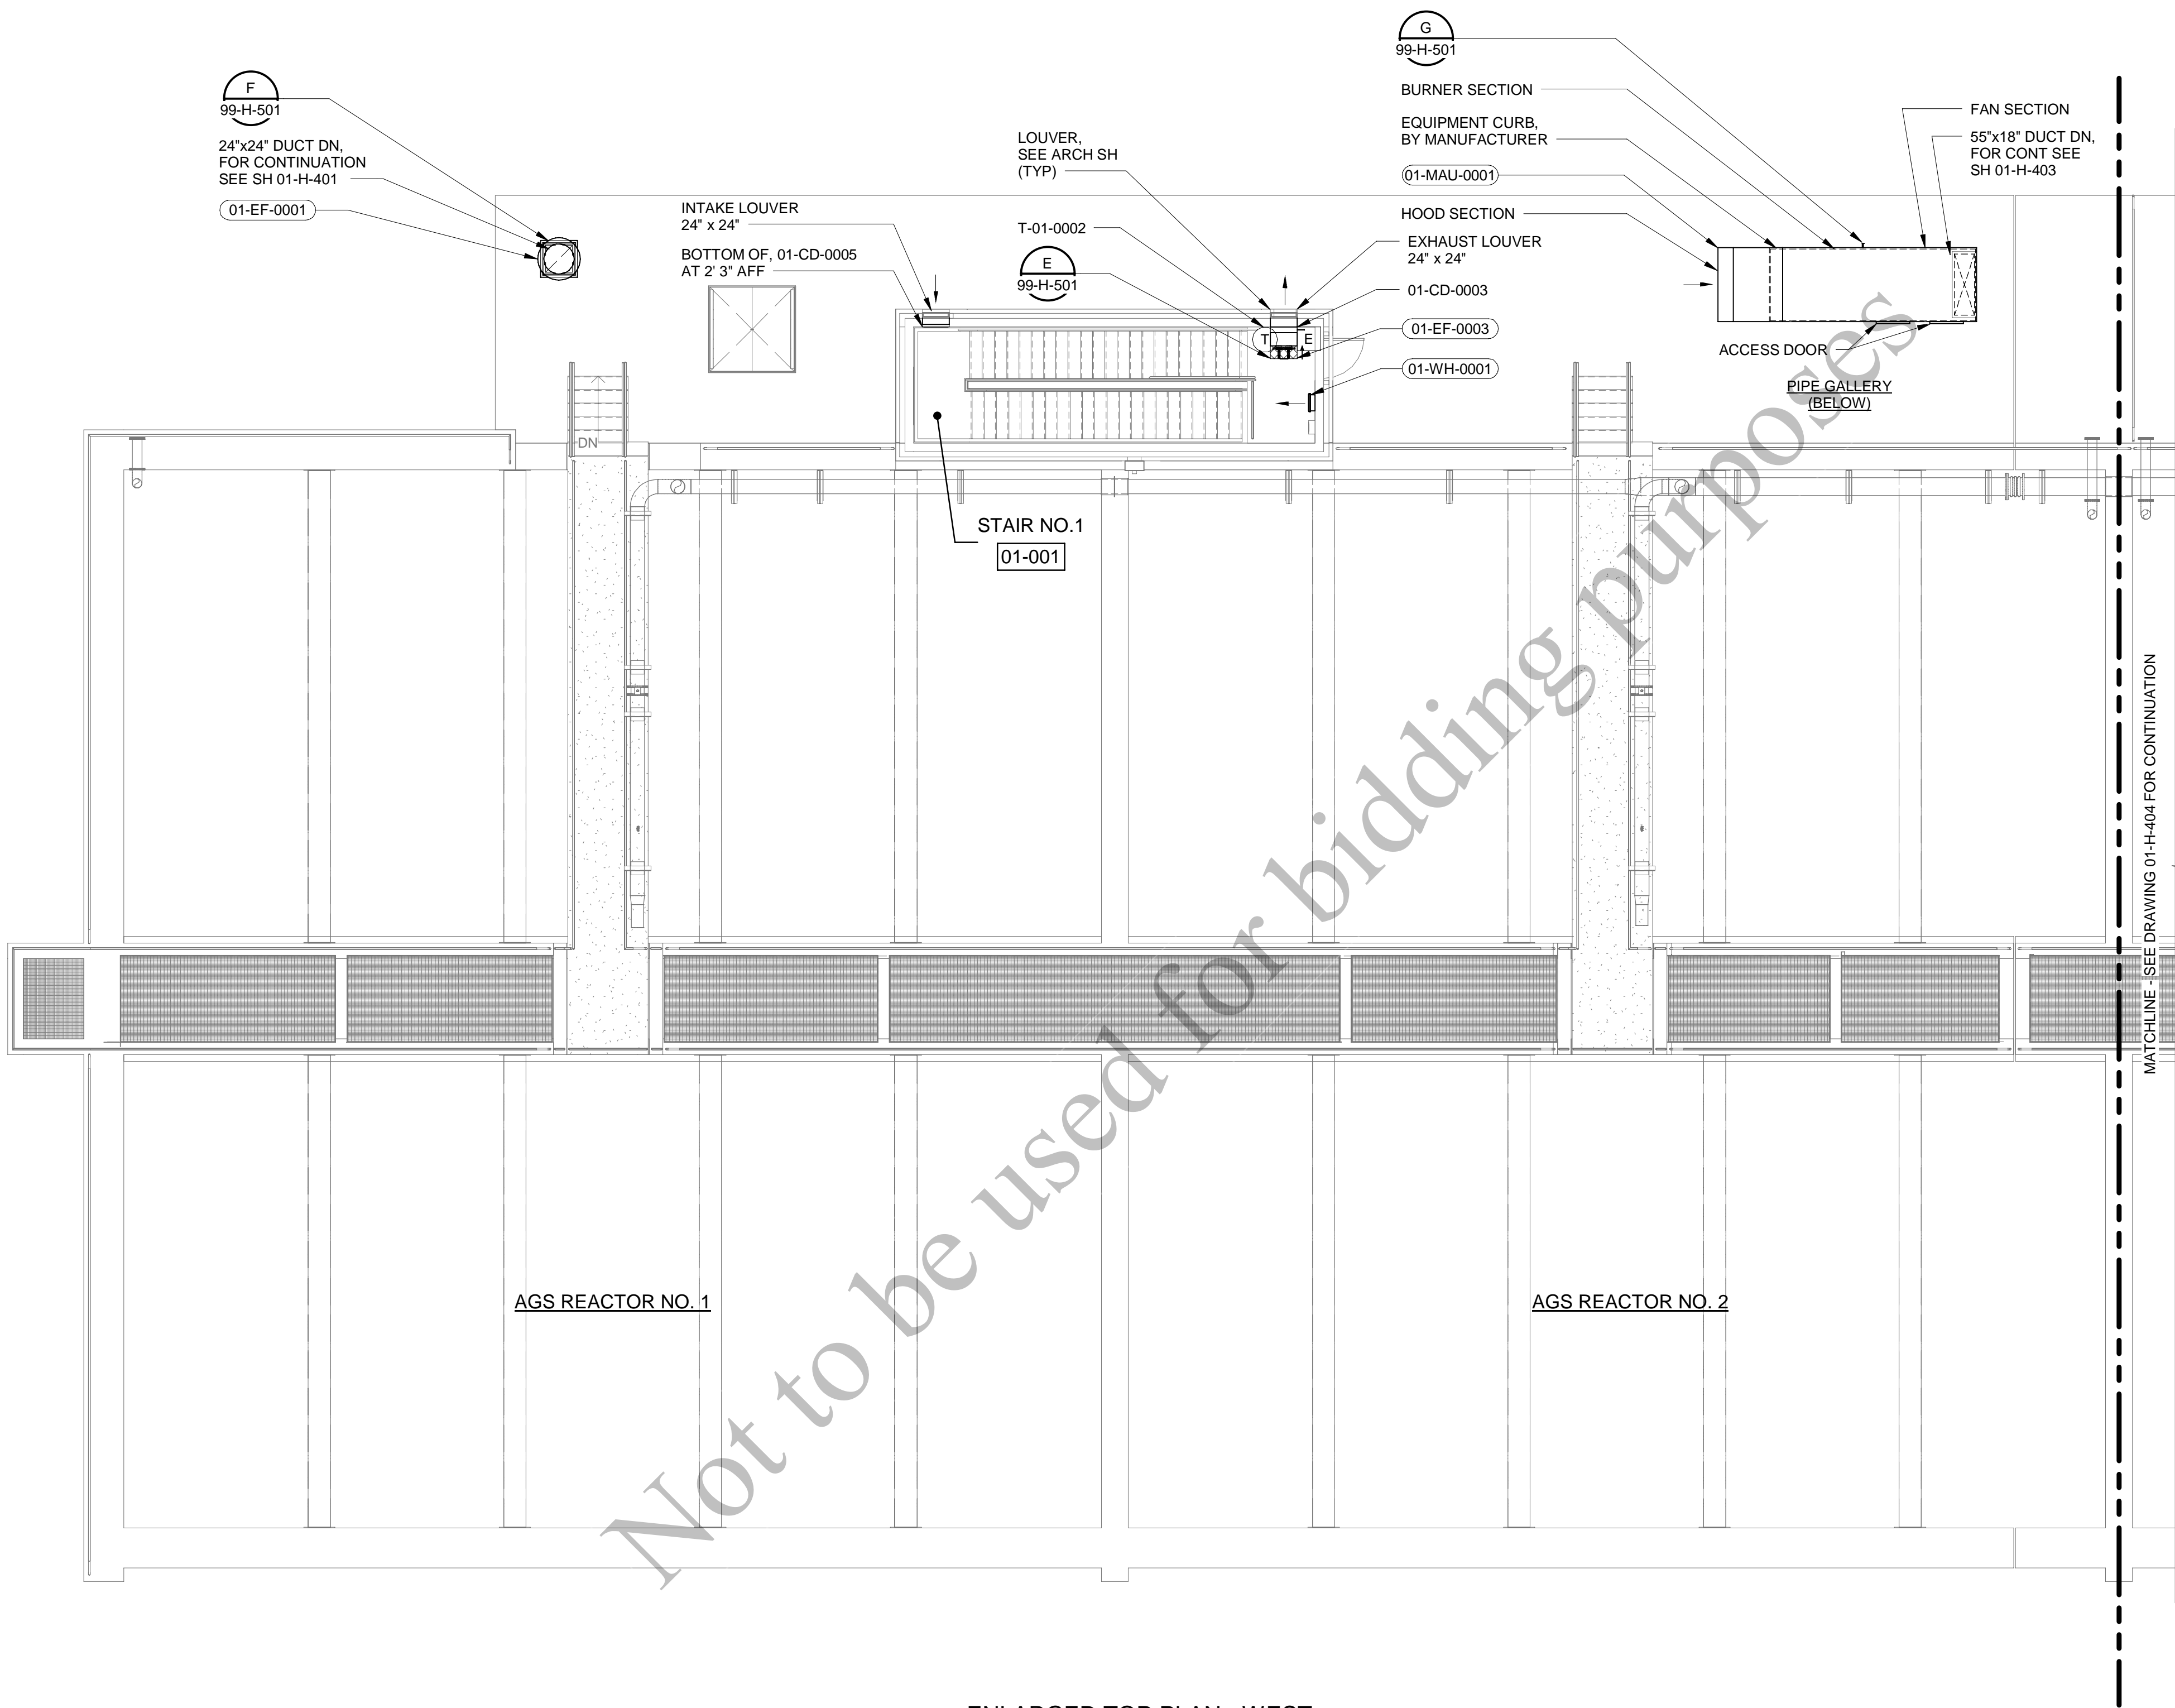

ENLARGED TOP PLAN - WEST

1/8" = 1'-0"

GENERAL SHEET NOTES

1. SEE DRAWING 00-H-001 FOR LEGENDS, ABBREVIATIONS AND GENERAL NOTES.



Black & Veatch Corporation
Chicago, Illinois
ILLINOIS PROFESSIONAL
DESIGN FIRM - 184.002143-0006



AEROBIC GRANULAR
SLUDGE - PHASE 1

REVISIONS AND RECORD OF ISSUE	
DESIGNED:	VSS
DETAILED:	AJP
CHECKED:	KMC
APPROVED:	SP
DATE:	12/20/2022
PROJECT NO.:	411752


AGS REACTORS AND PIPE
GALLERY

HVAC

REACTORS AND
GALLERY ENLARGED
TOP PLAN - WEST

01-H-403

81
OF
163

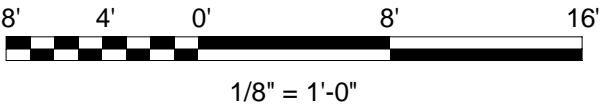

(SCALE BAR IS 4" AT FULL SCALE) 0 1/2 1 2 3 4



GENERAL SHEET NOTES

1. SEE DRAWING 00-H-001 FOR LEGENDS, ABBREVIATIONS AND GENERAL NOTES.



Black & Veatch Corporation
Chicago, Illinois
ILLINOIS PROFESSIONAL
DESIGN FIRM - 184.002143-0006



AEROBIC GRANULAR
SLUDGE - PHASE 1

REVISIONS AND RECORD OF ISSUE	
DESIGNED:	VSS
DETAILED:	AJP
CHECKED:	KMC
APPROVED:	SP
DATE:	12/20/2022
PROJECT NO.:	411752


AGS REACTORS AND PIPE
GALLERY

HVAC


REACTORS AND
GALLERY ENLARGED
TOP PLAN - EAST

01-H-404

82
OF
163

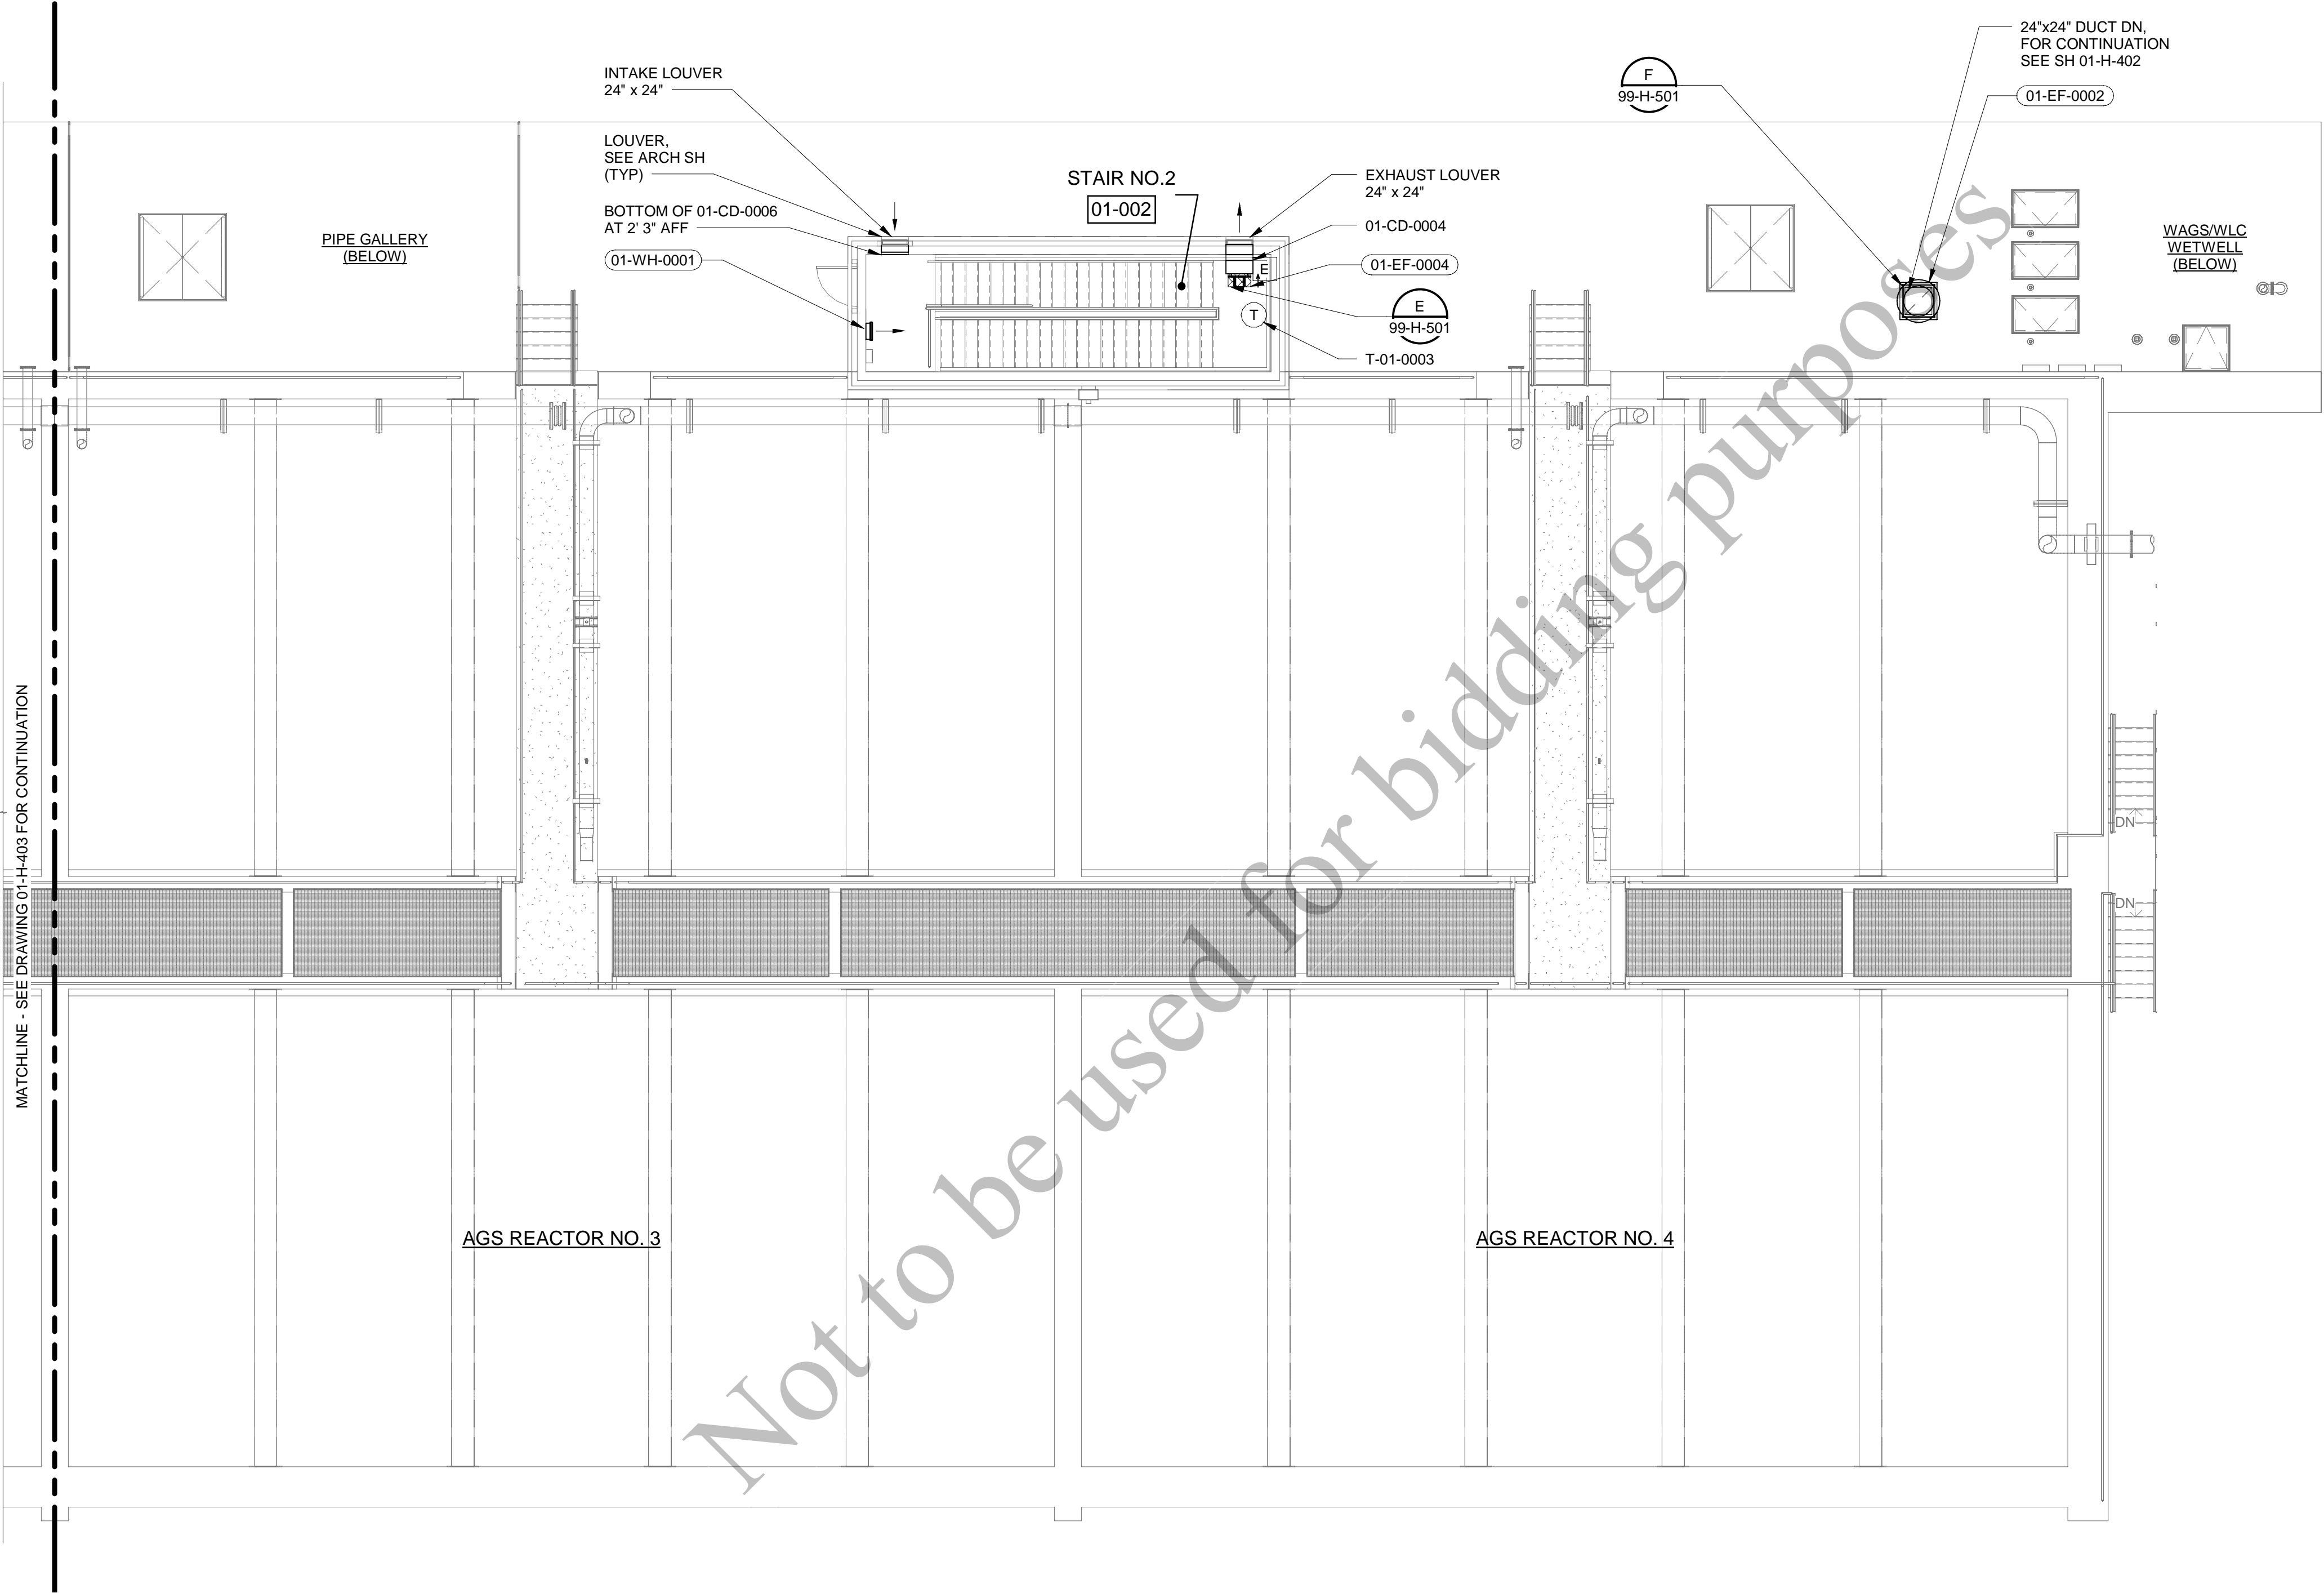

ENLARGED TOP PLAN - EAST
1/8" = 1'-0"

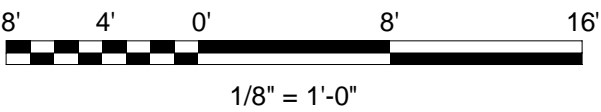

(SCALE BAR IS 4\"/>



GENERAL SHEET NOTES

1. SEE DRAWING 00-P-001 FOR LEGENDS, ABBREVIATIONS AND GENERAL NOTES.



Black & Veatch Corporation
Chicago, Illinois
ILLINOIS PROFESSIONAL
DESIGN FIRM - 184.002143-0006



AEROBIC GRANULAR
SLUDGE - PHASE 1

REVISIONS AND RECORD OF ISSUE	
DESIGNED:	SAM
DETAILED:	AJP
CHECKED:	DAV
APPROVED:	SP
DATE:	12/20/2022
PROJECT NO.:	411752


AGS REACTORS AND PIPE
GALLERY

PLUMBING


REACTORS AND
GALLERY OVERALL
FLOOR PLAN

01-P-101


83
OF
163

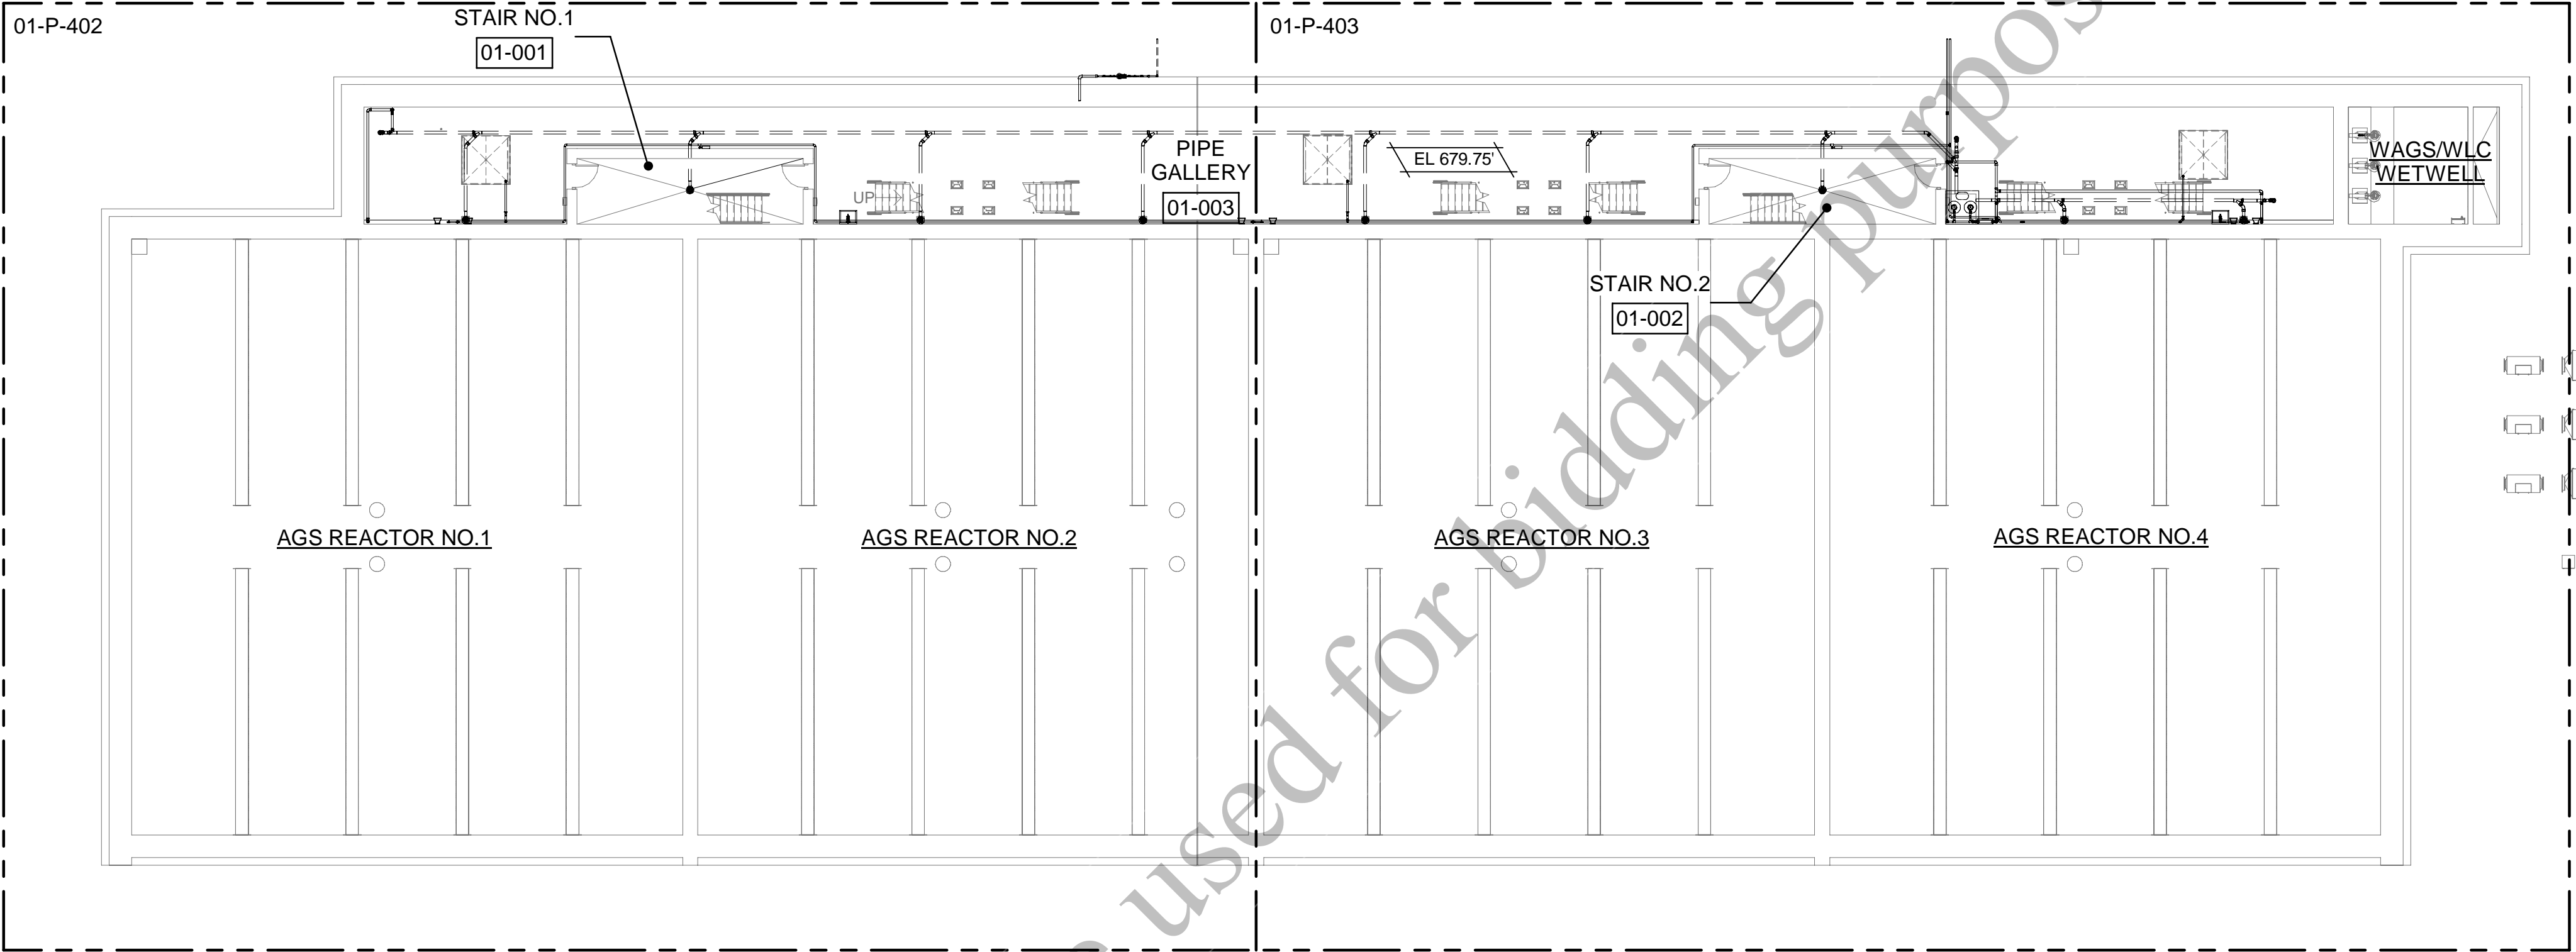

OVERALL FLOOR PLAN
1/16" = 1'-0"

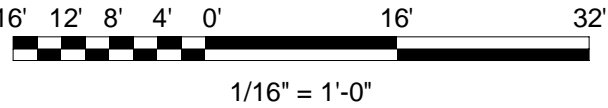

(SCALE BAR IS 4" AT FULL SCALE)

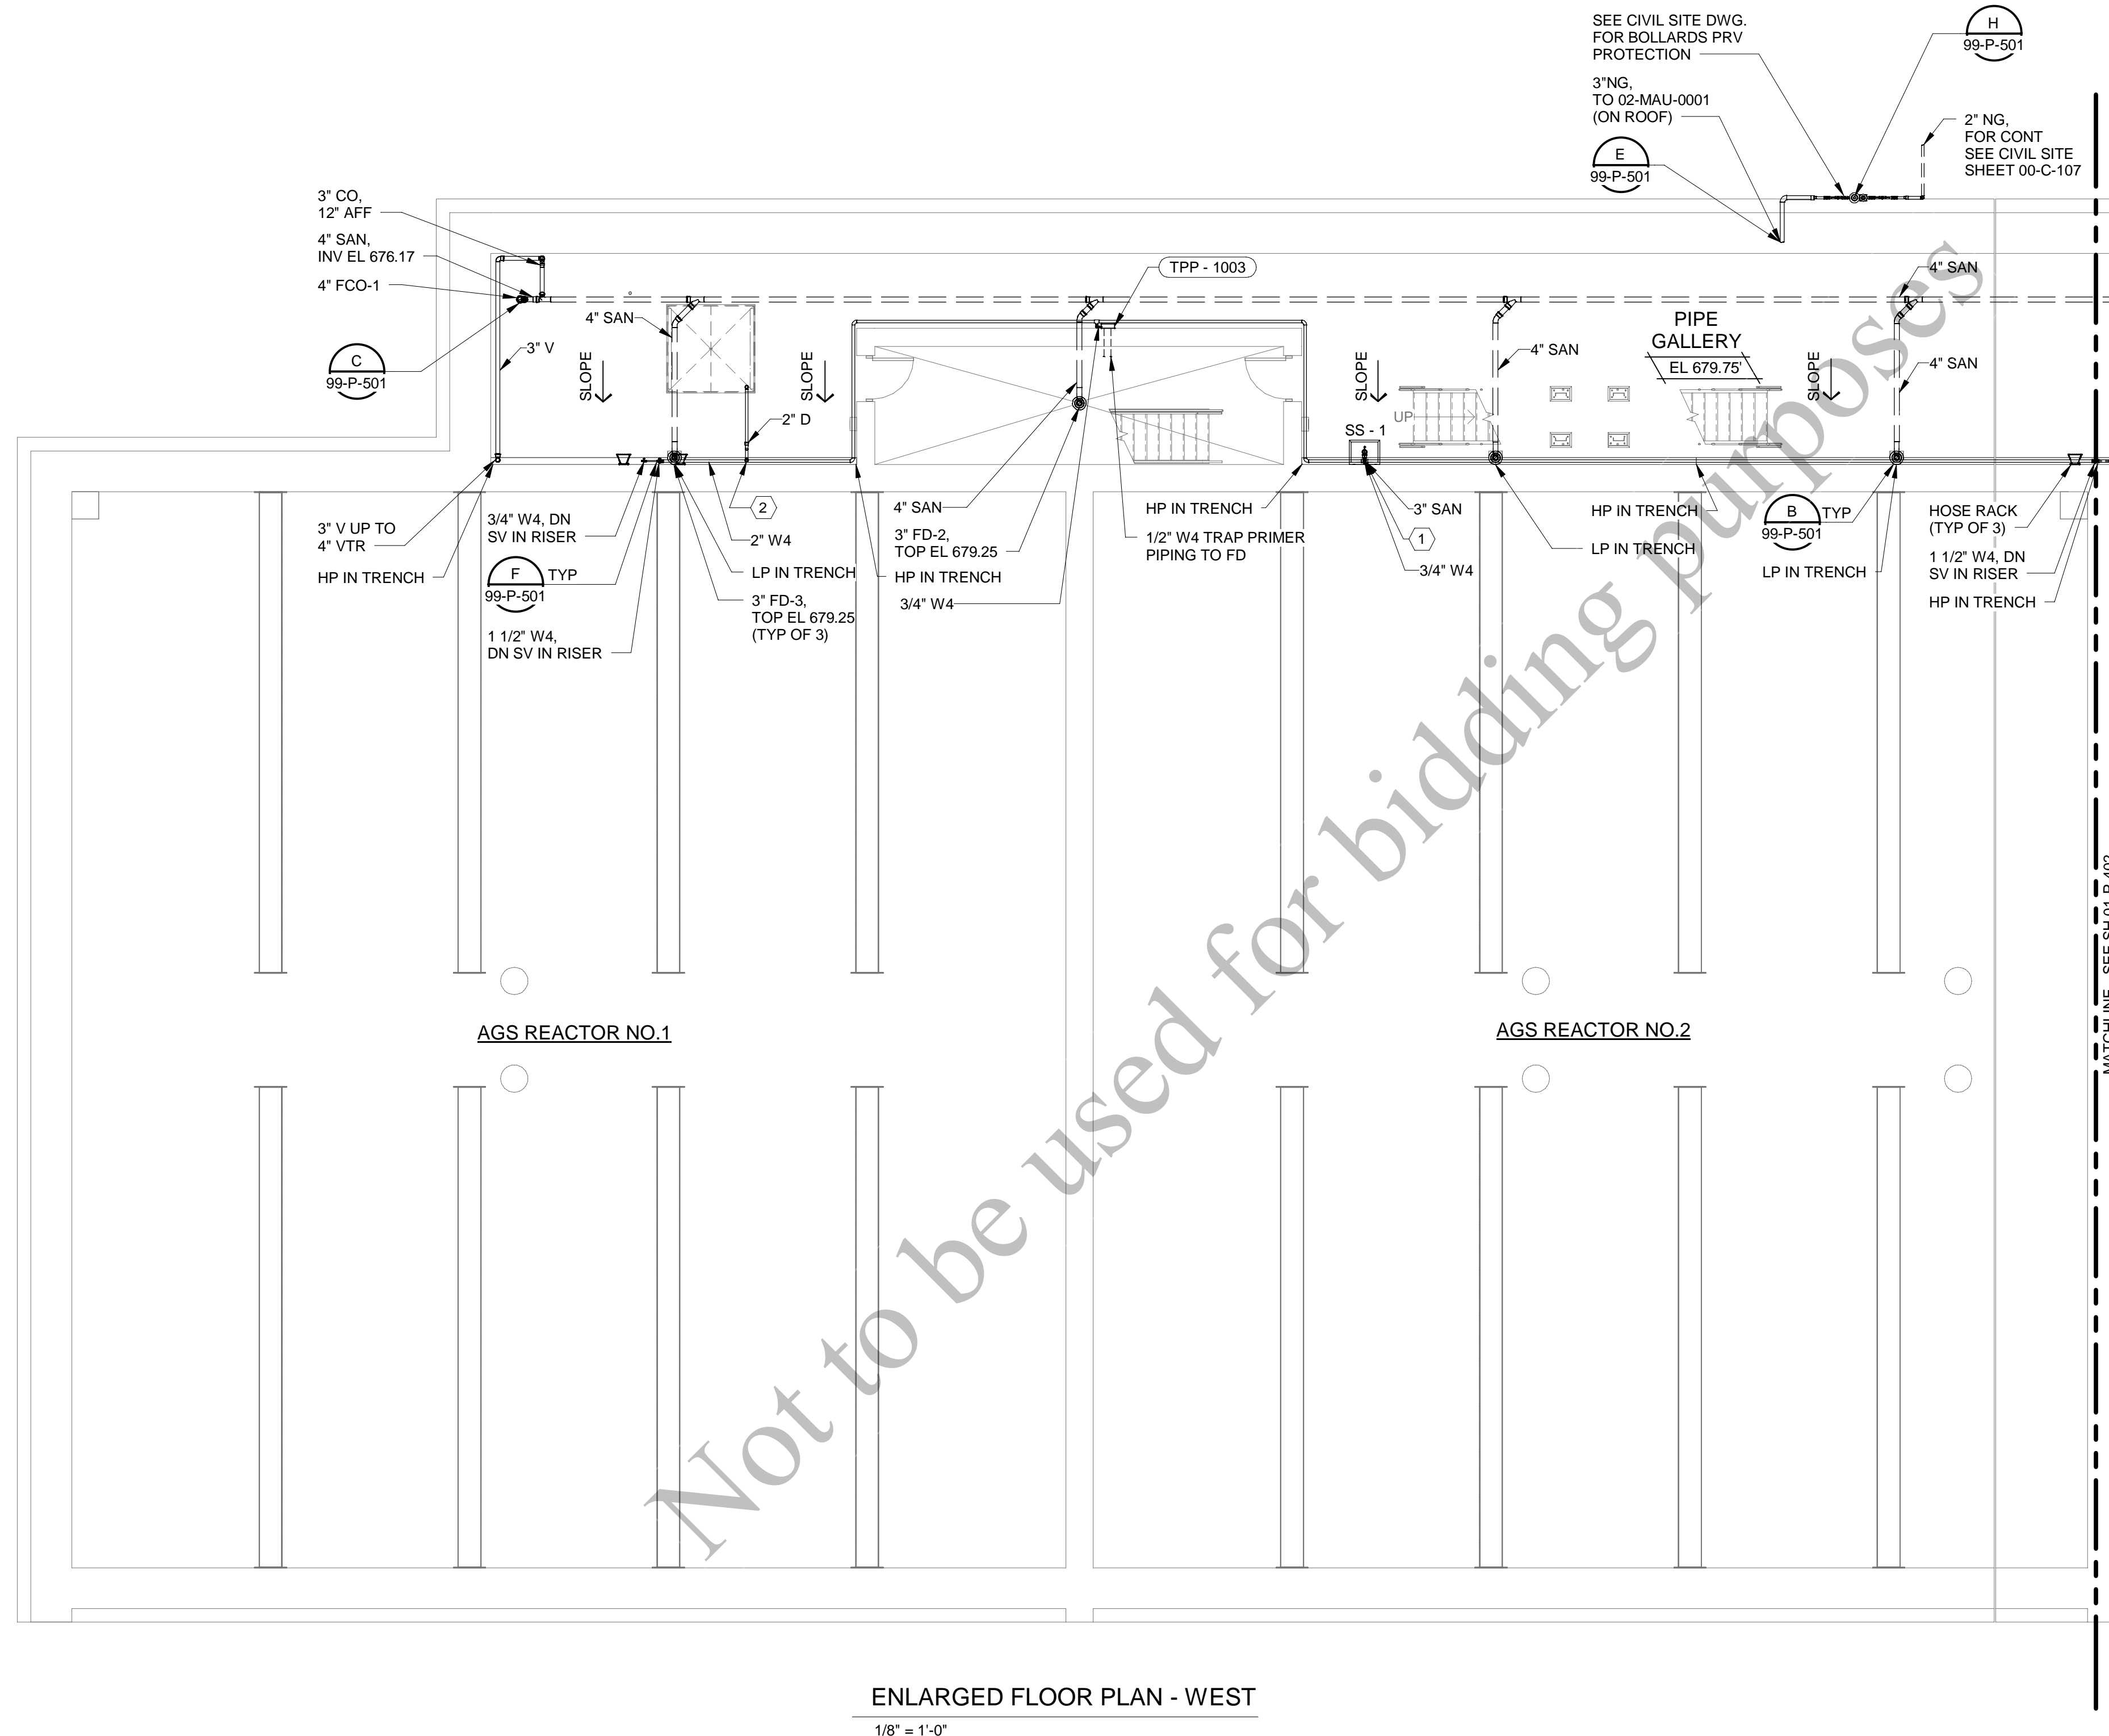

1. LEAVE 3" SAN LINE WITH 1" AIR GAP ABOVE TRENCH GRATING.
2. LEAVE 2" D LINE WITH 1" AIR GAP ABOVE TRENCH GRATING.



Black & Veatch Corporation
Chicago, Illinois
ILLINOIS PROFESSIONAL
DESIGN FIRM - 184.002143-0006



AEROBIC GRANULAR
SLUDGE - PHASE 1

REVISIONS AND RECORD OF ISSUE

DESIGNED:	SAM
DETAILED:	AJP
CHECKED:	DAV
APPROVED:	SP
DATE:	12/20/2022
PROJECT NO.:	411752

PROJECT NO.: 411752


AGS REACTORS AND PIPE GALLERY

PLUMBING


REACTORS AND
GALLERY ENLARGED
FLOOR PLAN - WEST

01-P-401


84
OF
163

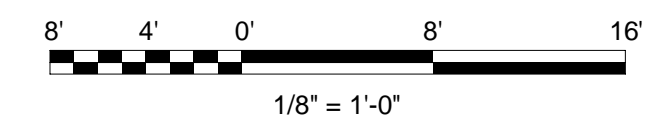

(SCALE BAR IS 4" AT FULL SCALE) 0 1/2 1 2 3 4

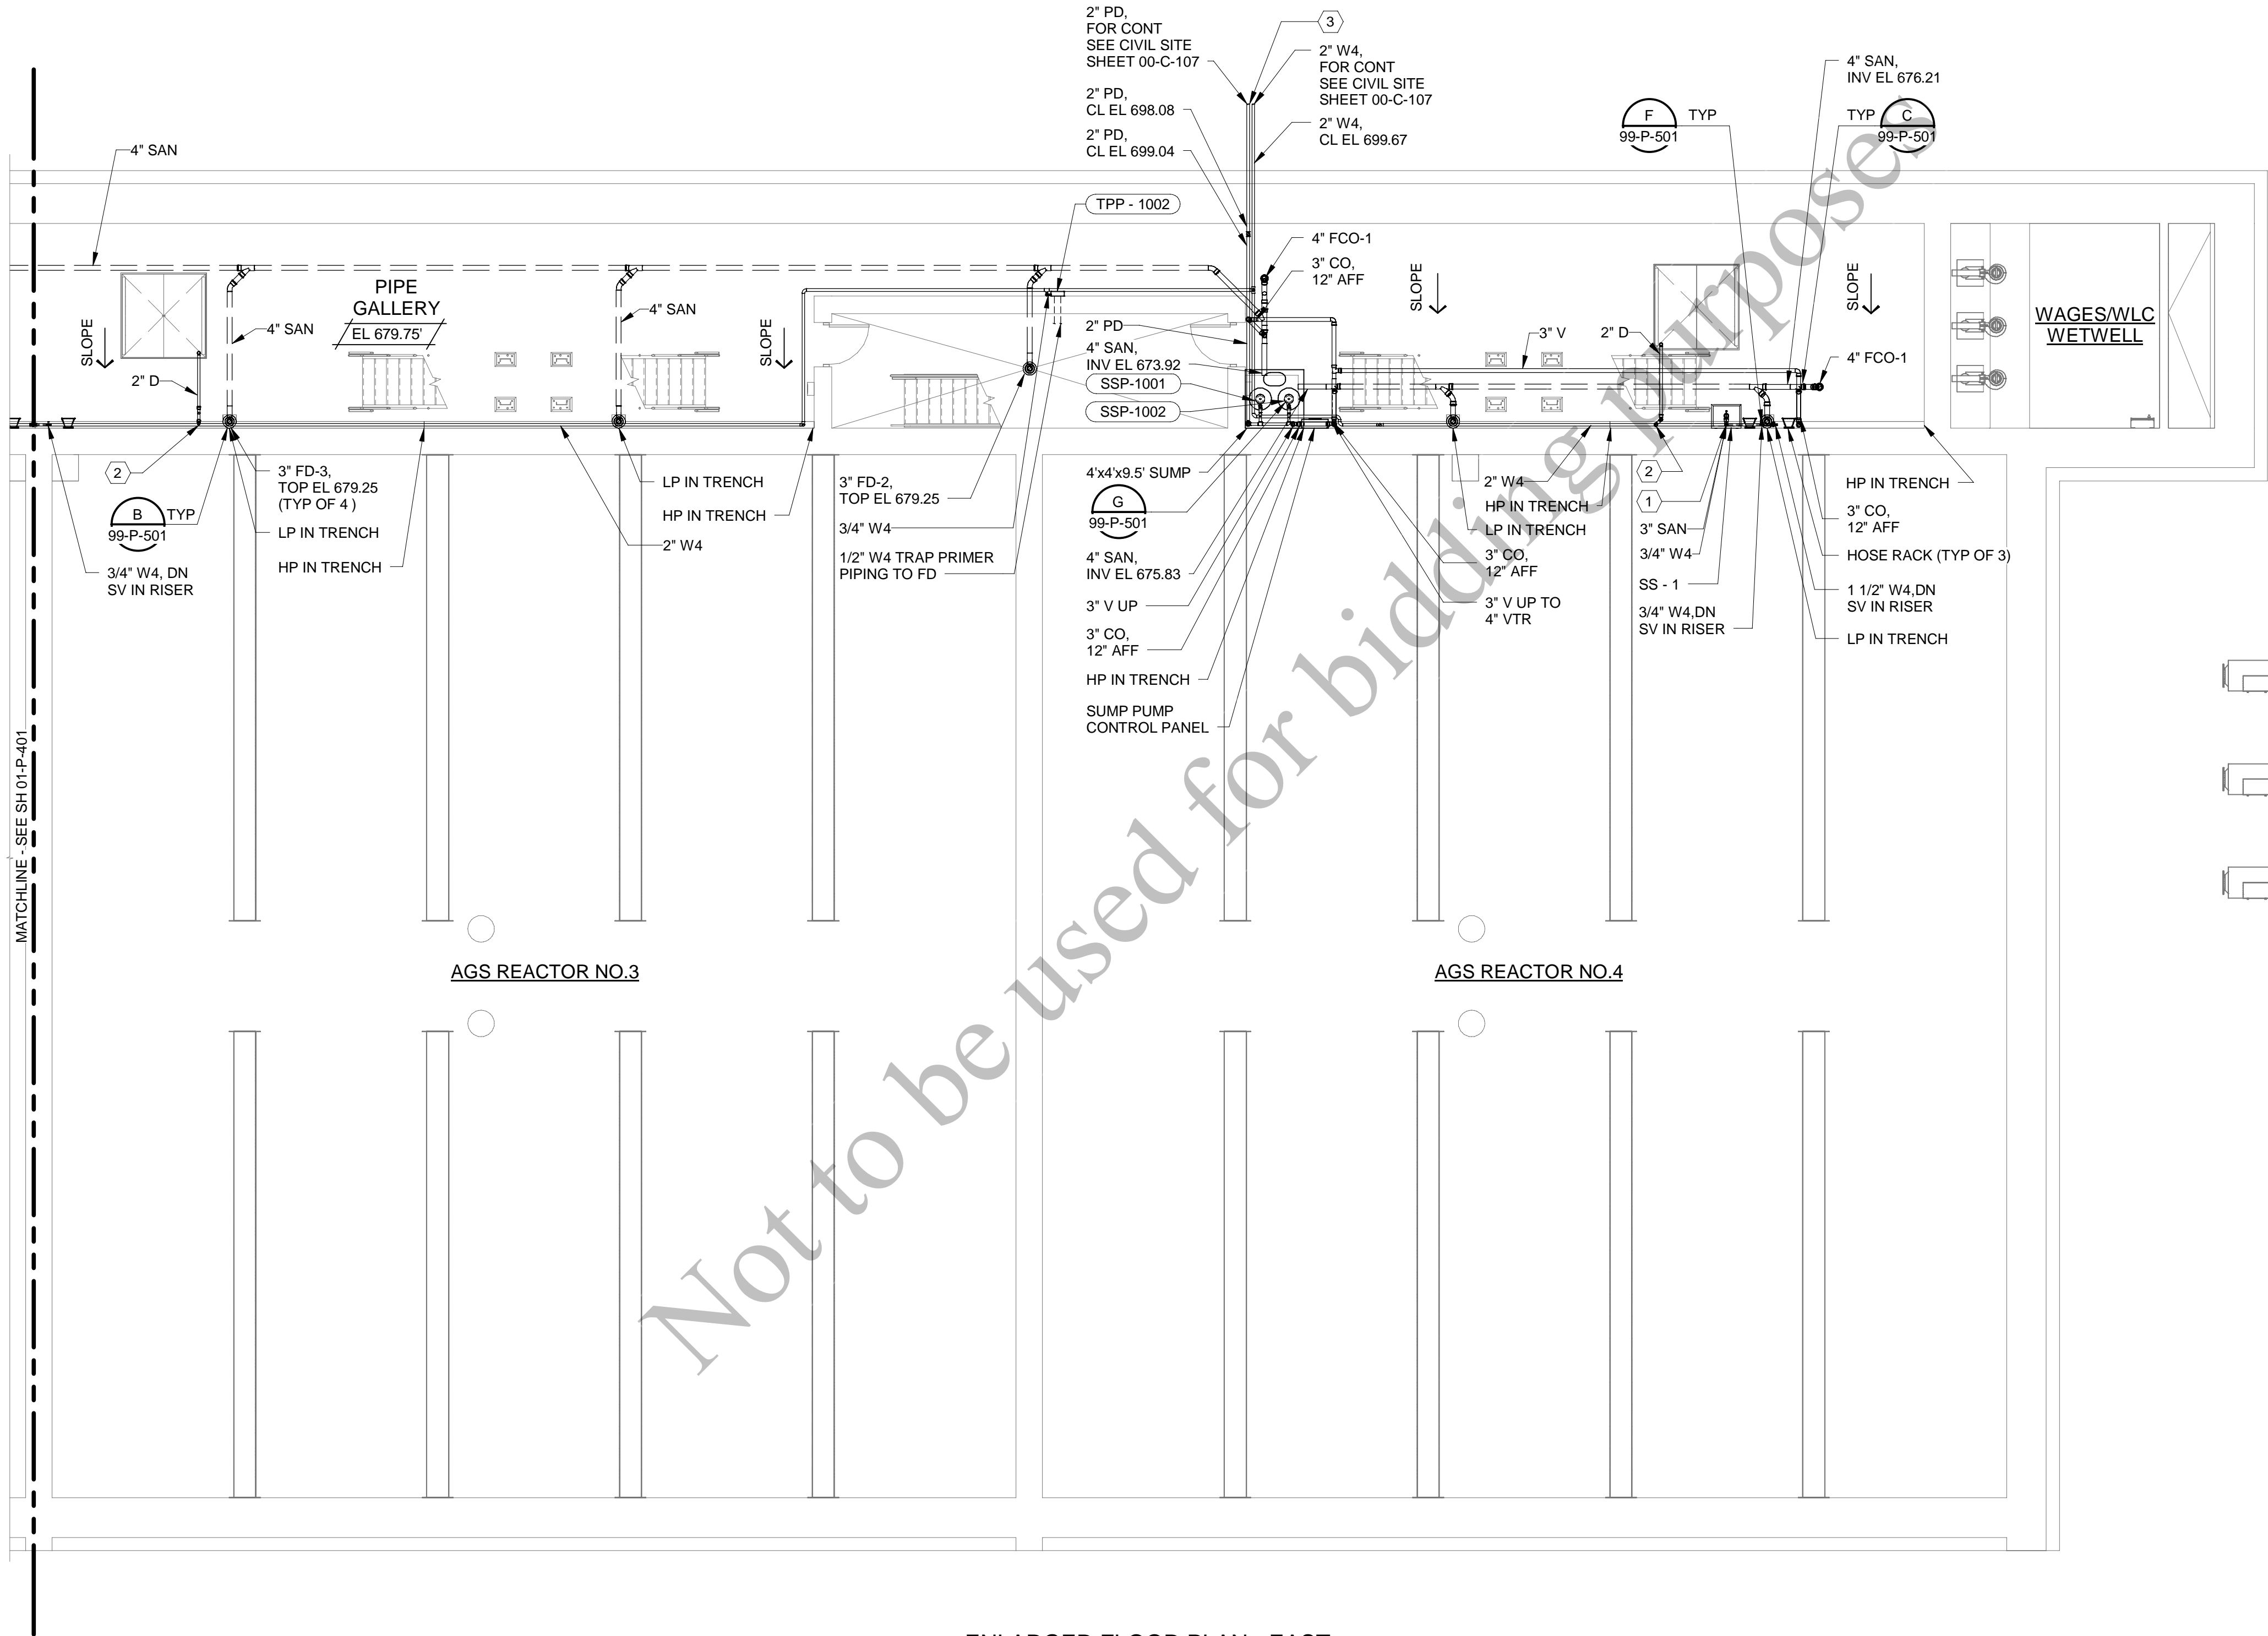

ENLARGED FLOOR PLAN - EAST
1/8" = 1'-0"

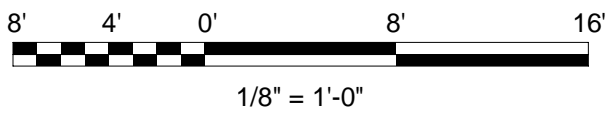

GENERAL SHEET NOTES

- SEE DRAWING 00-P-001 FOR LEGENDS, ABBREVIATIONS AND GENERAL NOTES.

SHEET KEYNOTES

- LEAVE 3" SAN LINE WITH 1" AIR GAP ABOVE TRENCH GRATING.
- LEAVE 2" D LINE WITH 1" AIR GAP ABOVE TRENCH GRATING.
- SUMP PUMP DISCHARGE (PD) CONTINUOUS AS SANITARY (SAN) ON 00-C-107.



Black & Veatch Corporation
Chicago, Illinois
ILLINOIS PROFESSIONAL
DESIGN FIRM - 184.002143-0006



AEROBIC GRANULAR
SLUDGE - PHASE 1

REVISIONS AND RECORD OF ISSUE

DESIGNED:	SAM
DETAILED:	AJP
CHECKED:	DAV
APPROVED:	SP
DATE:	12/20/2022
PROJECT NO.:	411752

AGS REACTORS AND PIPE
GALLERY


PLUMBING

REACTORS AND
GALLERY ENLARGED
FLOOR PLAN - EAST

01-P-402

85
OF
163

PLOTTED: 12/16/2022 11:53:19 AM
 FILE: BIM 360/409469 - Aerobic Granular Sludge Phase 1/409469 - AGS.rvt
 D11000

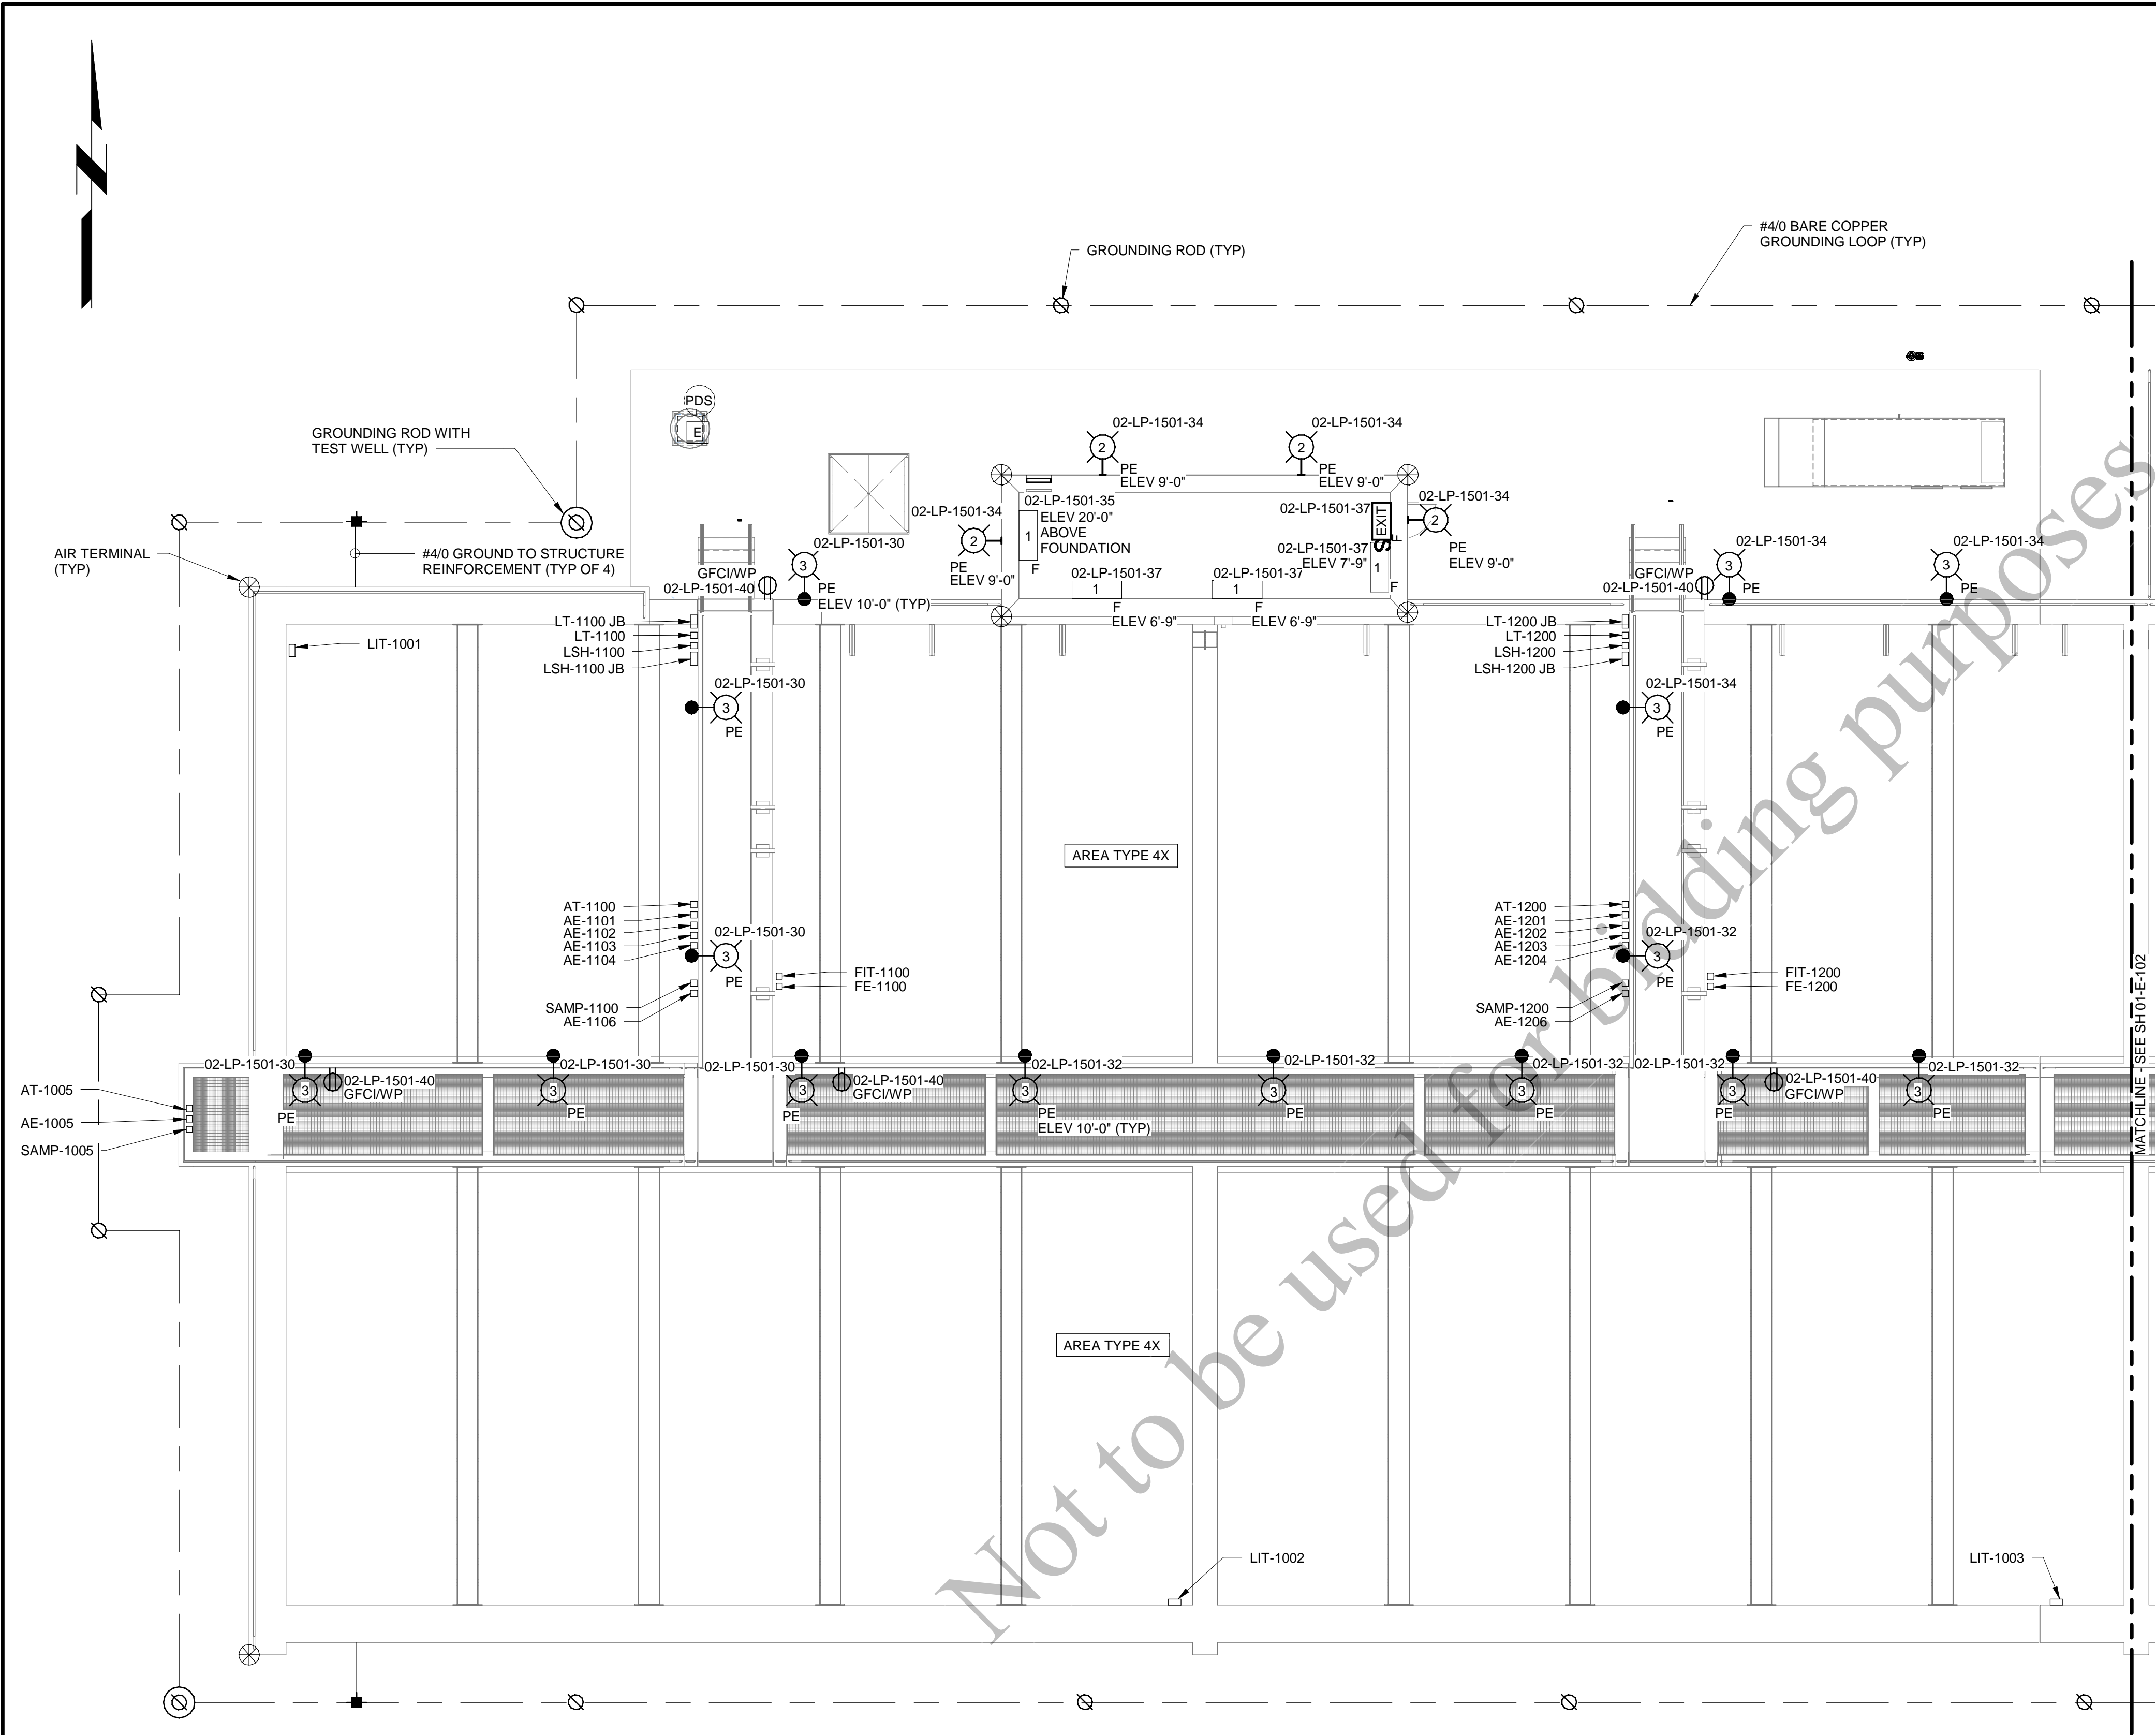

ELECTRICAL PLAN

1/8" = 1'-0"

GENERAL NOTES

- SEE DRAWINGS 00-E-001 AND 00-E-002 DOR LEGENDS, ABBREVIATIONS AND NOTES.
- LOCATIONS OF VALVE ACTUATORS AND PRESSURE TRANSMITTERS ON AIR PIPING INTERNAL TO AGS REACTORS ARE PROVIDED BY AGS SYSTEM SUPPLIER. FINAL EQUIPMENT AND PIPING LAYOUT IS PROPRIETARY AND SHALL BE AS PROVIDED IN VENDOR SUBMITTAL DRAWINGS.



Black & Veatch Corporation
Chicago, Illinois
ILLINOIS PROFESSIONAL
DESIGN FIRM - 184.002143-0006



AEROBIC GRANULAR
SLUDGE - PHASE 1

REVISIONS AND RECORD OF ISSUE	
DESIGNED:	EJB
DETAILED:	SFR
CHECKED:	SDS
APPROVED:	EJB
DATE:	12/20/2022
PROJECT NO.:	411752


AGS REACTORS AND PIPE
GALLERY

ELECTRICAL

REACTOR 1 AND
REACTOR 2 ELECTRICAL
PLAN


01-E-101

86
OF
163

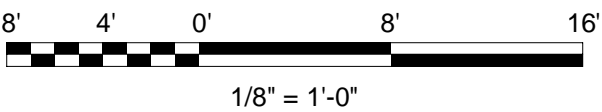

(SCALE BAR IS 4" AT FULL SCALE) 0 1/2 1 2 3 4

PLOTTED: 12/16/2022 11:53:15 AM
 FILE: BIM 360/409469 - Aerobic Granular Sludge Phase 1/409469 - AGS.rvt
 D11000

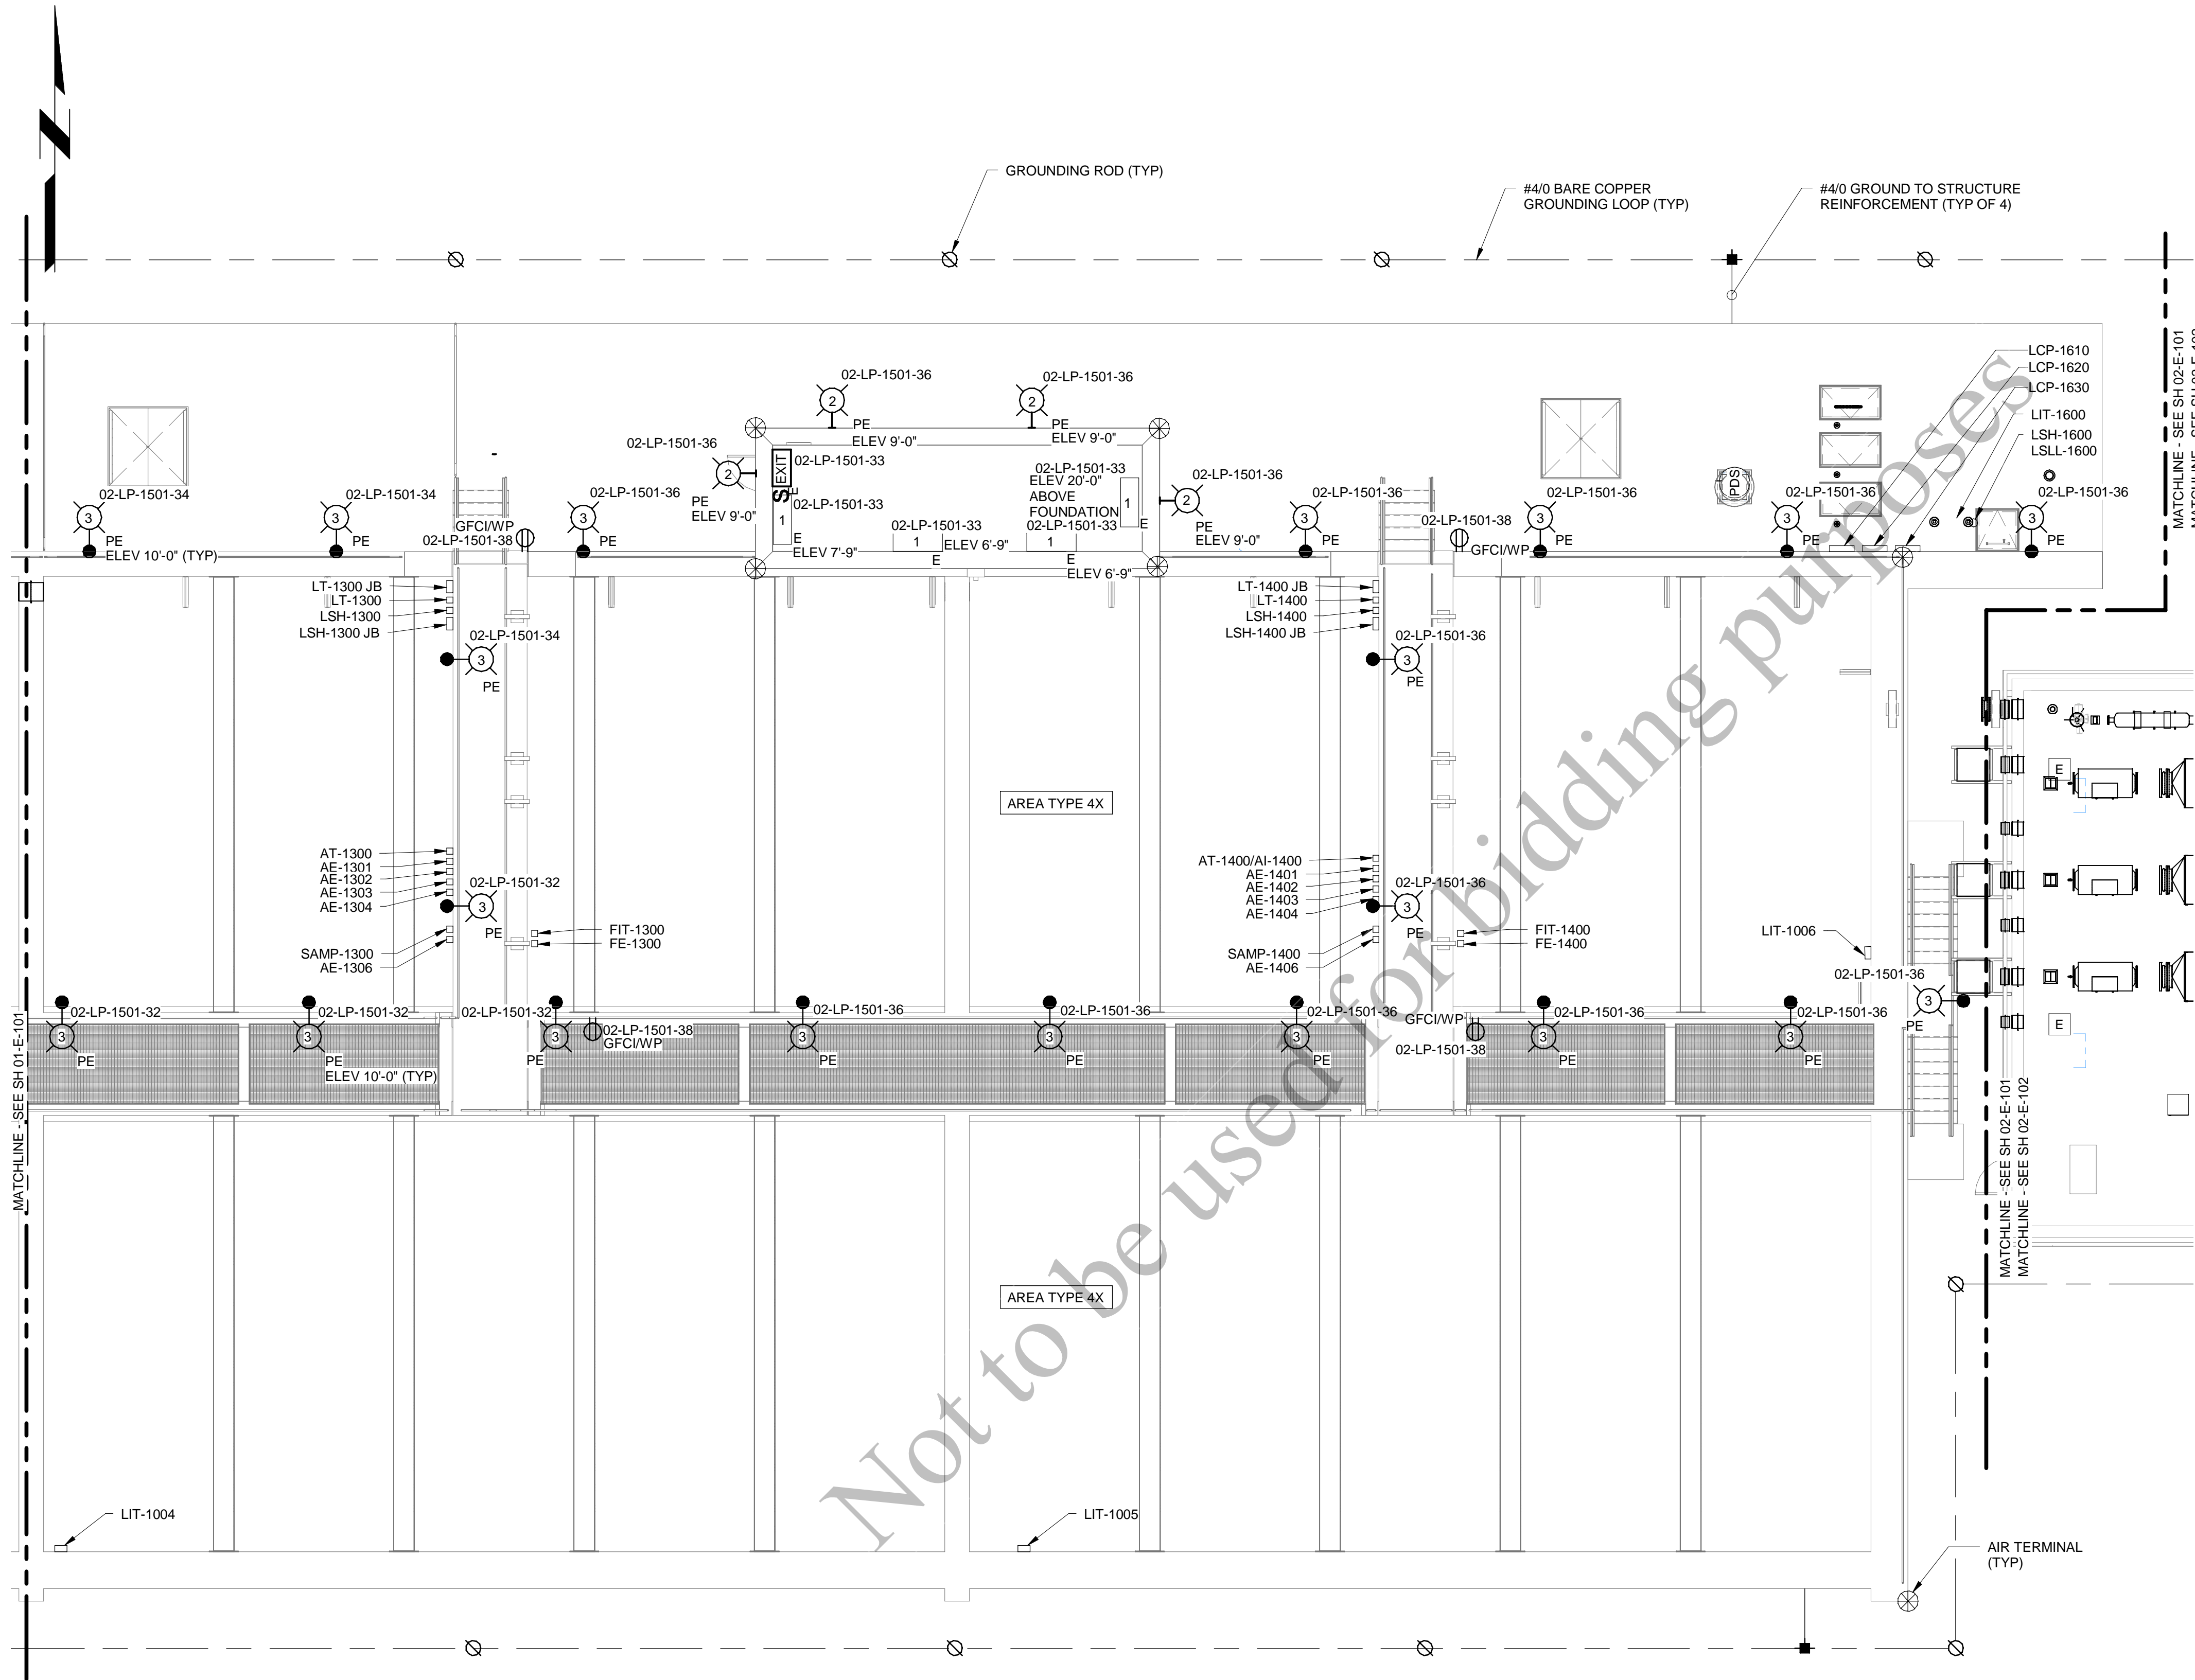

ELECTRICAL PLAN
 1/8" = 1'-0"

GENERAL NOTES

- SEE DRAWINGS 00-E-001 AND 00-E-002 DOR LEGENDS, ABBREVIATIONS AND NOTES.
- LOCATIONS OF VALVE ACTUATORS AND PRESSURE TRANSMITTERS ON AIR PIPING INTERNAL TO AGS REACTORS ARE PROVIDED BY AGS SYSTEM SUPPLIER. FINAL EQUIPMENT AND PIPING LAYOUT IS PROPRIETARY AND SHALL BE AS PROVIDED IN VENDOR SUBMITTAL DRAWINGS.



Black & Veatch Corporation
 Chicago, Illinois
 ILLINOIS PROFESSIONAL
 DESIGN FIRM - 184.002143-0006



AEROBIC GRANULAR
 SLUDGE - PHASE 1

REVISIONS AND RECORD OF ISSUE

DESIGNED:	EJB
DETAILED:	SFR
CHECKED:	SDS
APPROVED:	EJB
DATE:	12/20/2022

PROJECT NO.: 411752


AGS REACTORS AND PIPE
 GALLERY

ELECTRICAL


REACTOR 3 AND
 REACTOR 4 ELECTRICAL
 PLAN

01-E-102

87
 OF
 163

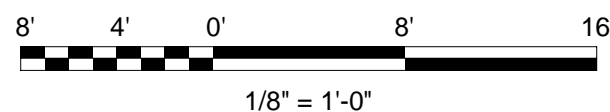


(SCALE BAR IS 4" AT FULL SCALE) 0 1/2 1 2 3 4

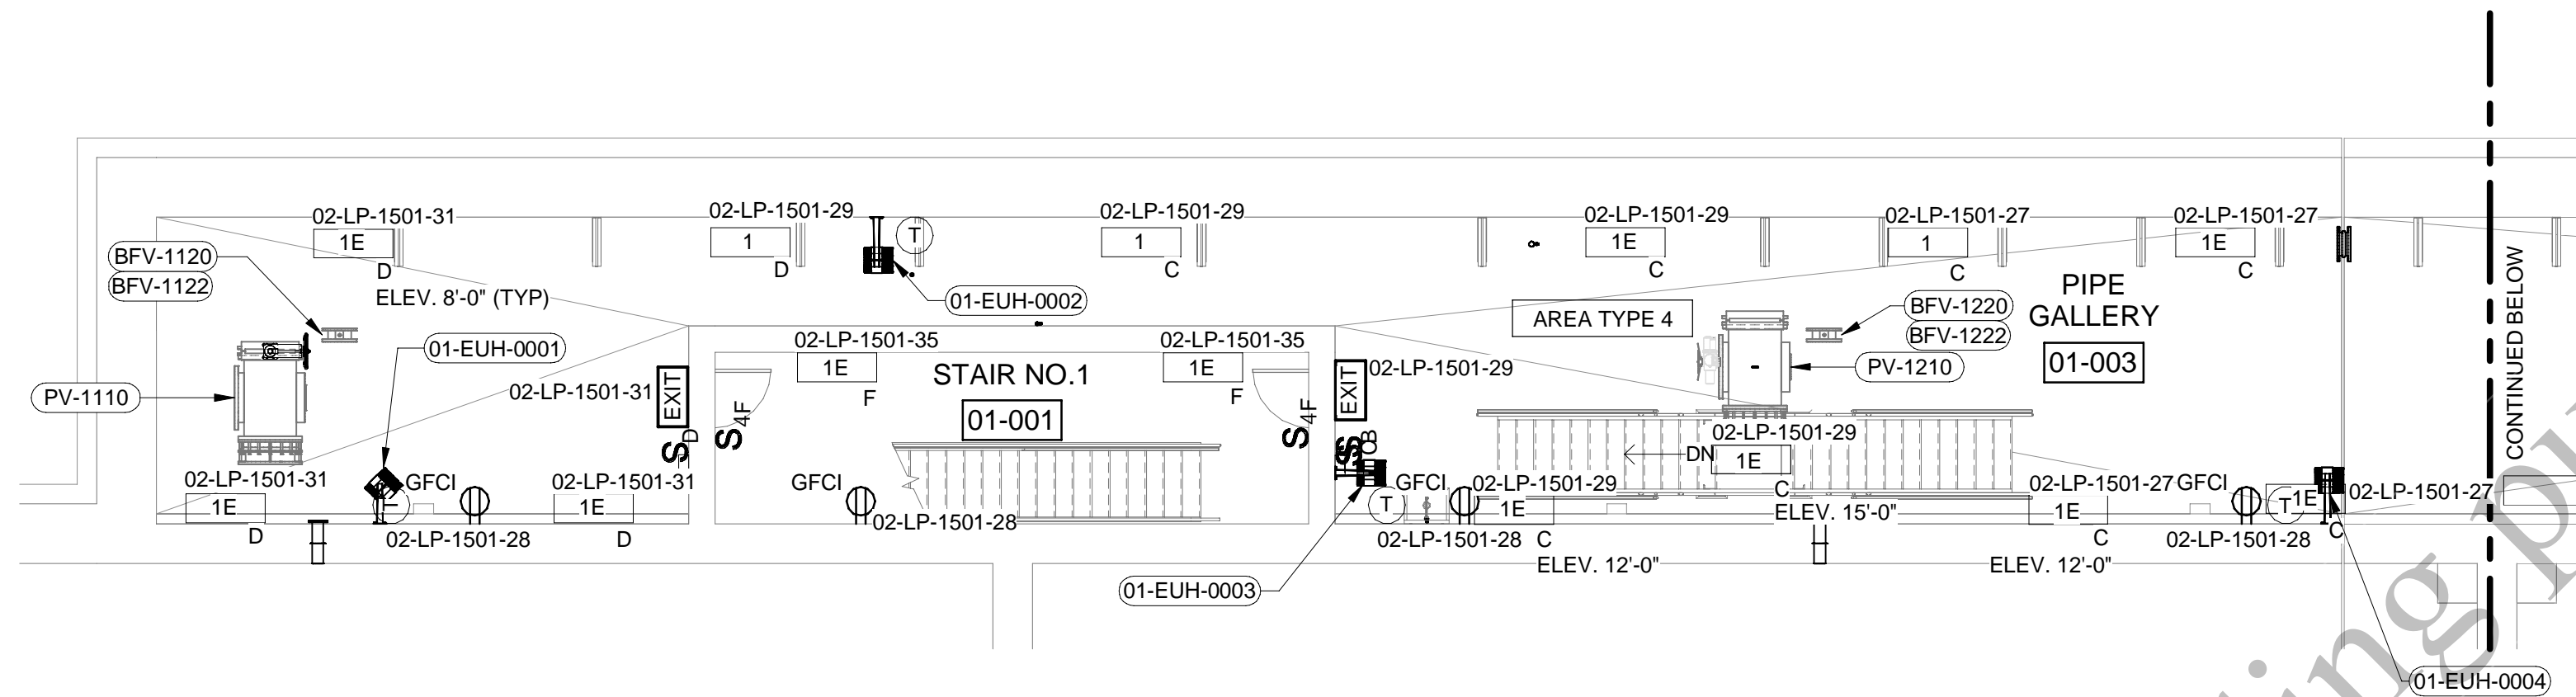

ELECTRICAL PLAN

1/8" = 1'-0"

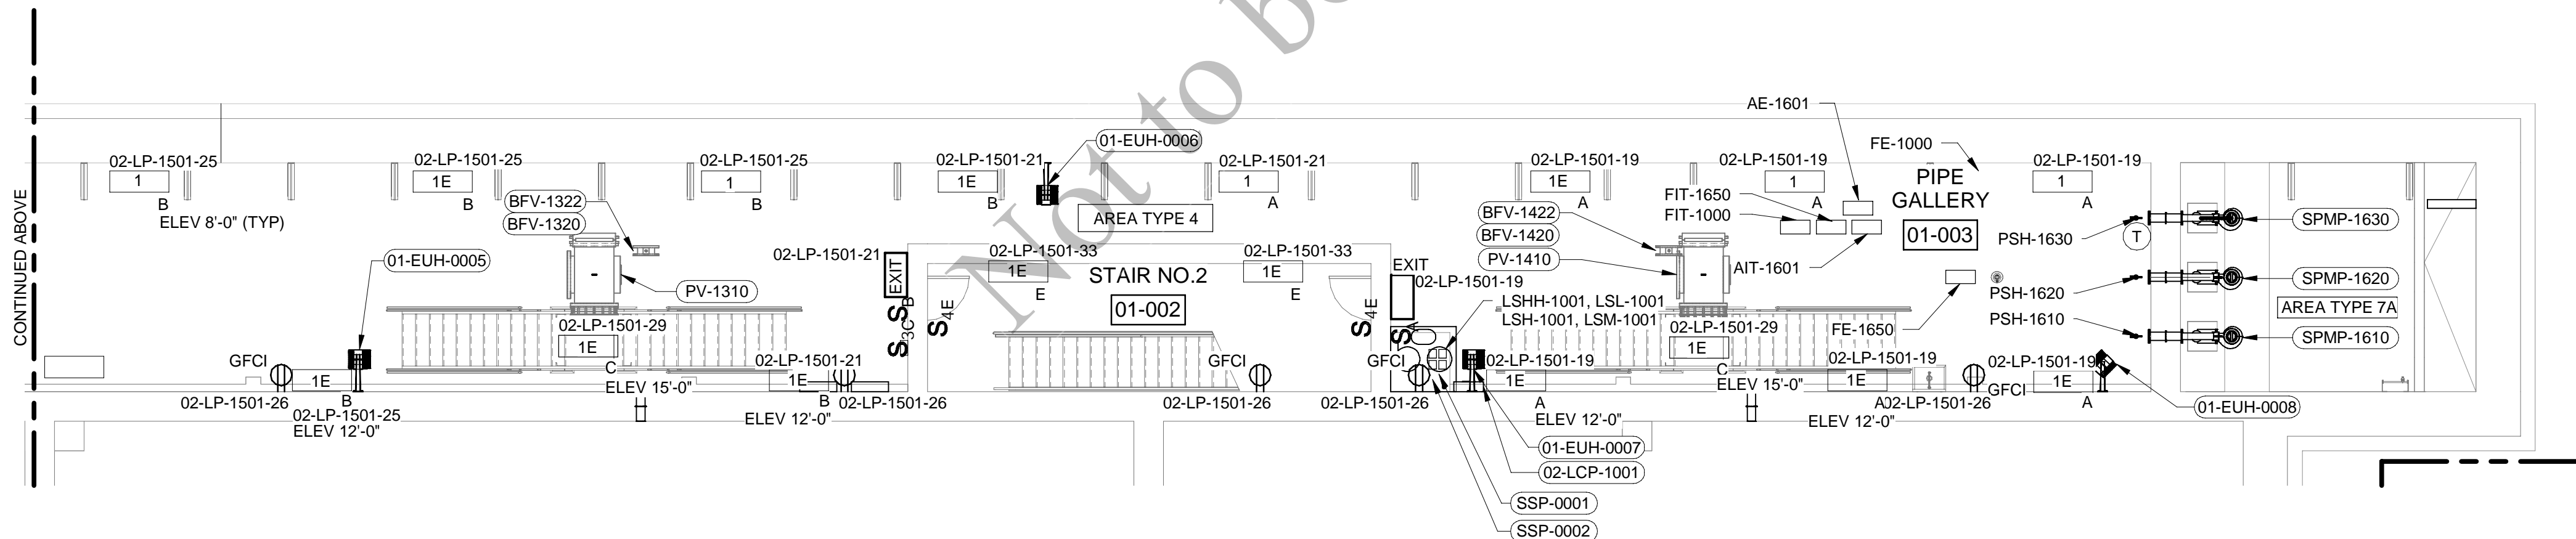

ELECTRICAL PLAN

1/8" = 1'-0"

GENERAL NOTES

- SEE DRAWINGS 00-E-001 AND 00-E-002 FOR LEGENDS, ABBREVIATIONS AND NOTES.



Black & Veatch Corporation
Chicago, Illinois
ILLINOIS PROFESSIONAL
DESIGN FIRM - 184.002143-0006



AEROBIC GRANULAR
SLUDGE - PHASE 1

REVISIONS AND RECORD OF ISSUE	
DESIGNED:	EJB
DETAILED:	SFR
CHECKED:	SDS
APPROVED:	EJB
DATE:	12/20/2022
PROJECT NO.:	411752


AGS REACTORS AND PIPE
GALLERY

ELECTRICAL

GALLERY ELECTRICAL
PLANS

01-E-103


88
OF
163

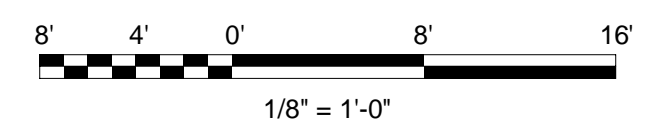

(SCALE BAR IS 4" AT FULL SCALE) 0 1/2 1 2 3 4



REACTORS, SEE STRUCT DRAWINGS FOR CONTINUATION

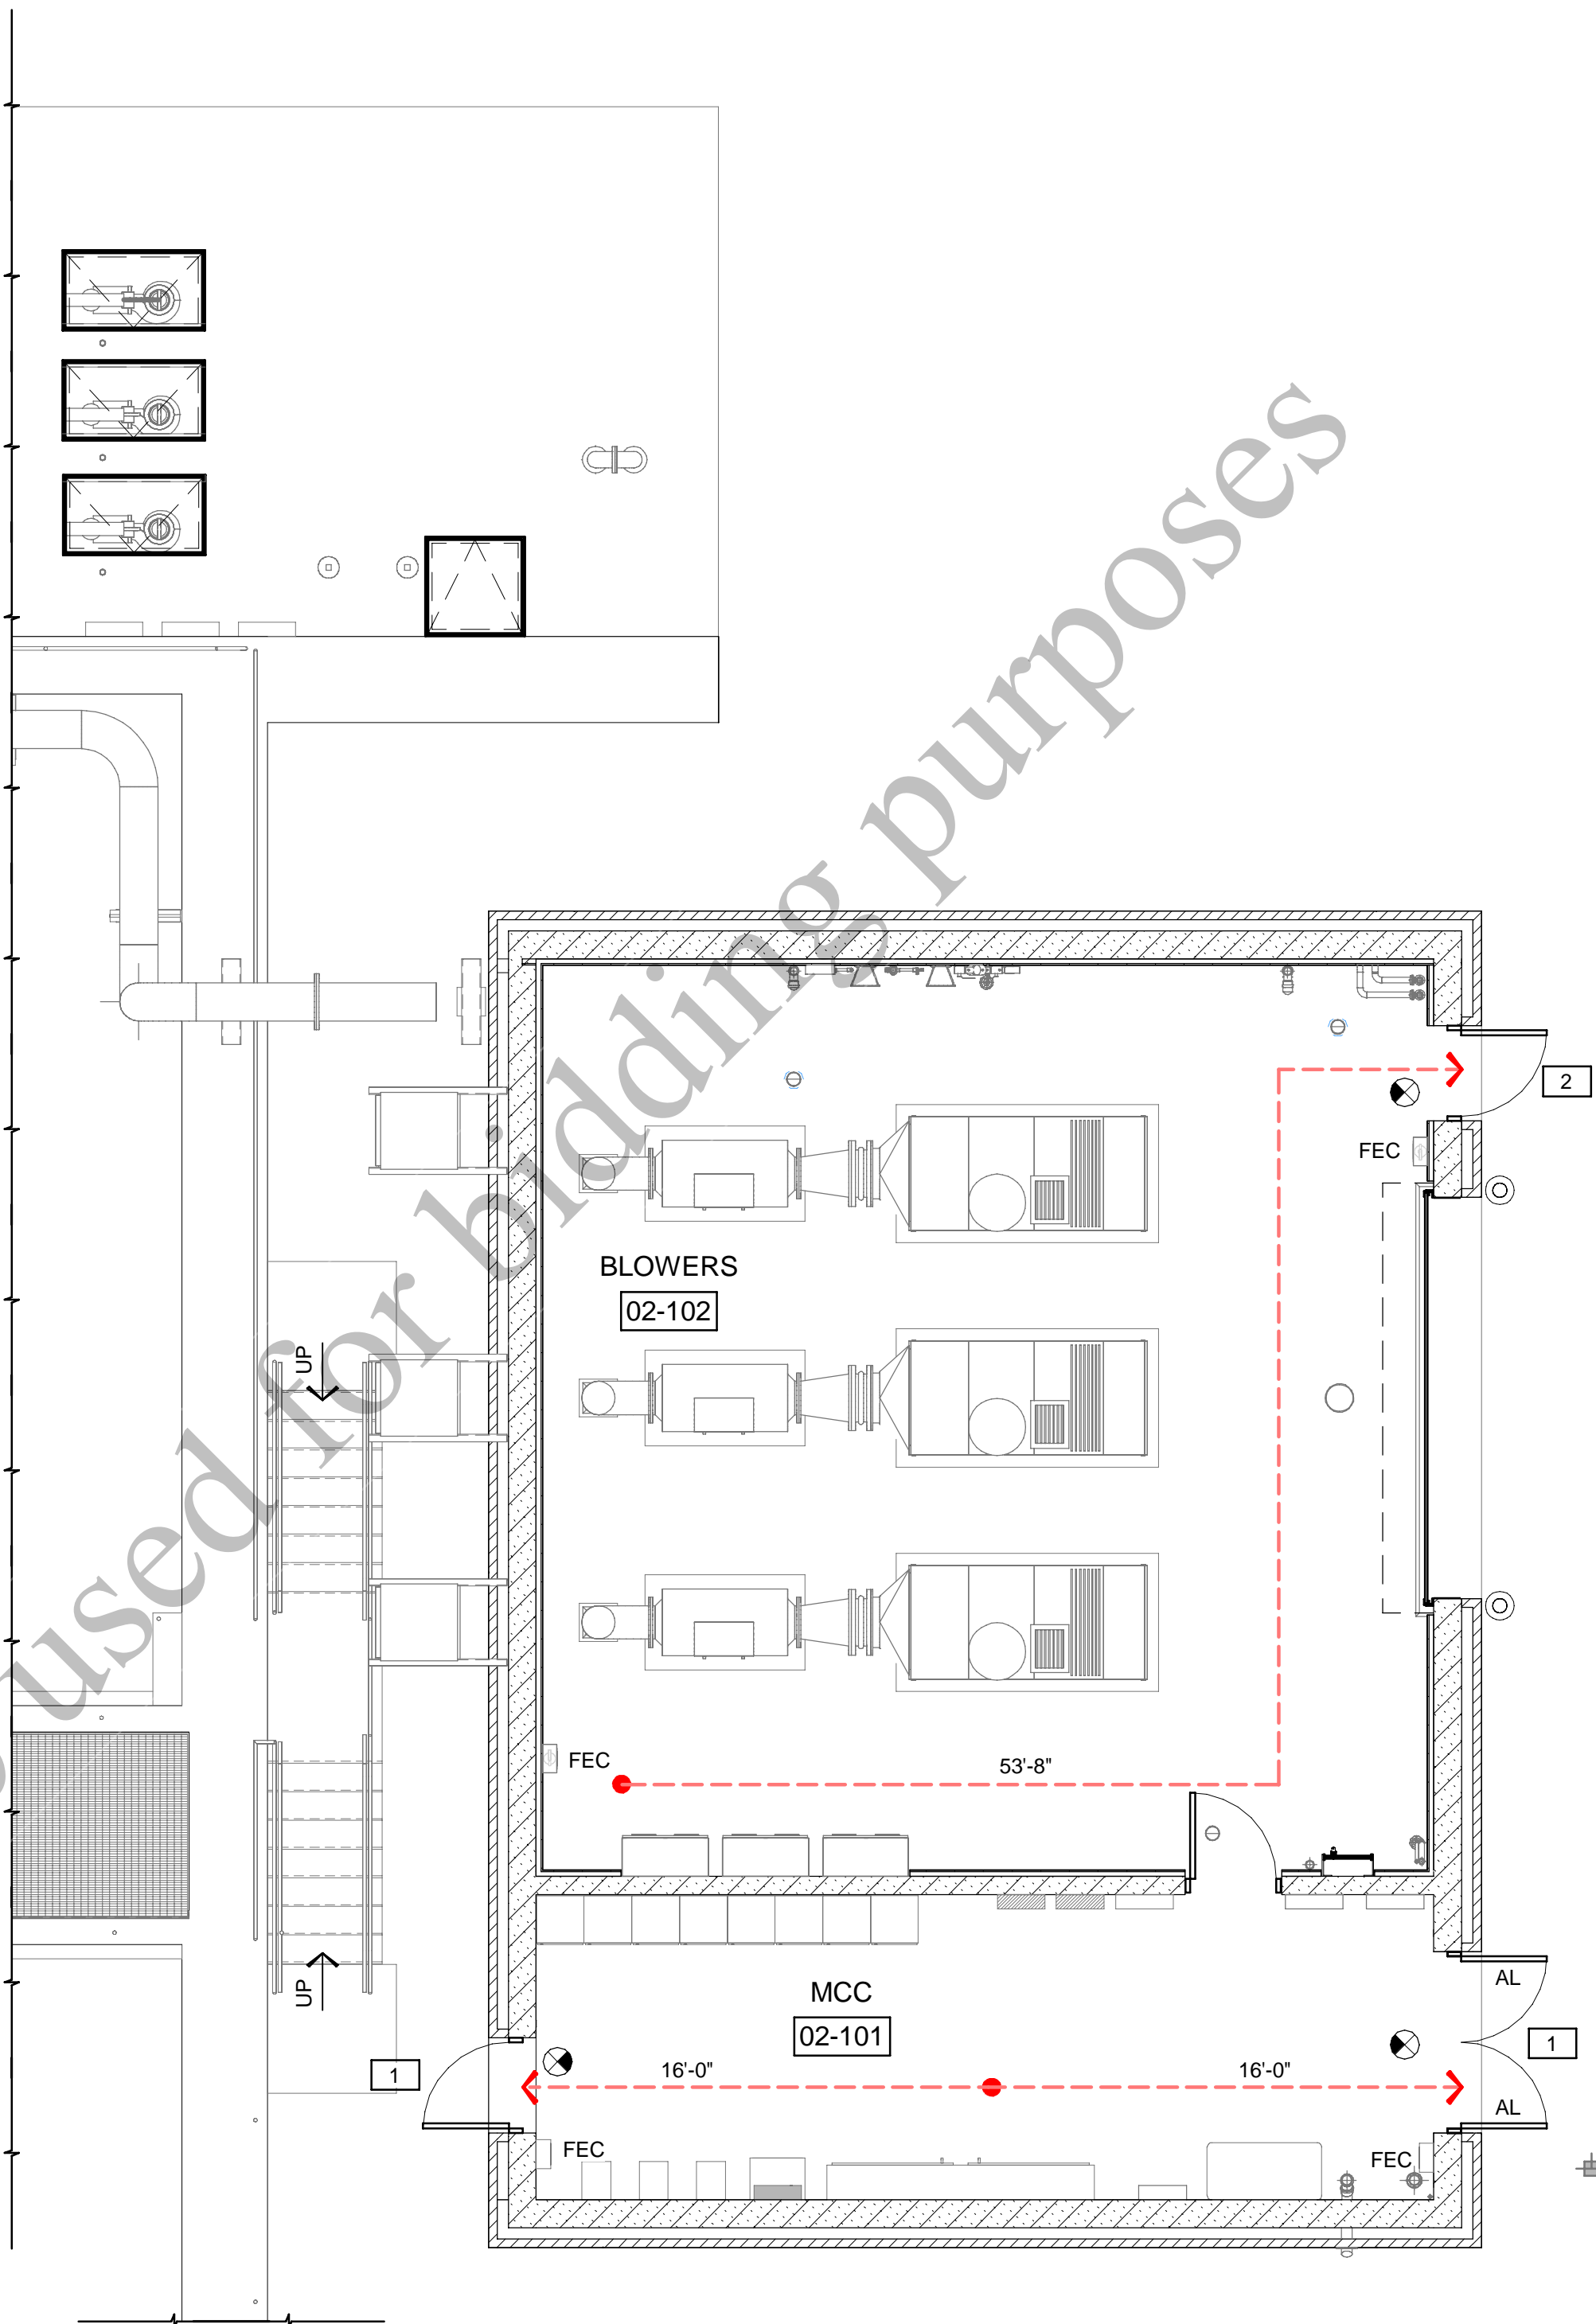

AGS SUPPORT FACILITIES - LIFE SAFETY PLAN

3/16" = 1'-0"

GENERAL SHEET NOTES

B&V Design, LLC
Kansas City, Missouri
ILLINOIS PROFESSIONAL
DESIGN FIRM - 184007283

BUILDING CODE ANALYSIS


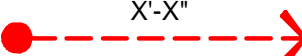


BUILDING CODES:
2015 INTERNATIONAL BUILDING CODE WITH AMENDMENTS
2018 ILLINOIS ENERGY CONSERVATION CODE WITH AMENDMENTS

AGS SUPPORT FACILITIES

OCCUPANCY	F-2 MODERATE HAZARD FACTORY INDUSTRIAL
TYPE OF CONSTRUCTION	II-B NON COMBUSTIBLE
ACTUAL AREA	1,617 SF
ACTUAL HEIGHT	20'-8"
ALLOWABLE AREA	15,500 SF
ALLOWABLE HEIGHT	55'
DESIGN OCCUPANT LOAD	16
NUMBER OF STORIES	1
ALLOWABLE NUMBER OF STORIES	2
MINIMUM EXITS REQUIRED	3
NUMBER OF EXITS	4
ADA ACCESSIBILITY	EXEMPT PER SECTION 1103.2.9
OCCUPANCY SEPARATION	NOT REQUIRED
FIRE SPRINKLERS	NOT REQUIRED
MAX EXIT TRAVEL DISTANCE	300'
ENERGY CODE COMPLIANCE	WALLS - R-5.7 C.I. ROOF - R-25 C.I.
MAXIMUM COMMON PATH OF EGRESS TRAVEL	75'



LIFE SAFETY LEGEND

	WALL MOUNTED FIRE EXTINGUISHER CABINET (FEC)			
	PATH OF EGRESS TRAVEL			
<table border="1" data-bbox="2399 1096 2501 1145"><tr><td>100 SF/PERSON</td></tr><tr><td>1</td></tr><tr><td>F-2</td></tr></table>	100 SF/PERSON	1	F-2	OCCUPANTS PER SF OCCUPANT LOAD OCCUPANCY CLASSIFICATION
100 SF/PERSON				
1				
F-2				
<table border="1" data-bbox="2436 1177 2467 1193"><tr><td>5</td></tr></table>	5	CUMULATIVE OCCUPANT LOAD		
5				
	EXIT			
AL	ACTIVE LEAF			
	1 HOUR FIRE BARRIER			

AEROBIC GRANULAR
SLUDGE - PHASE 1

REVISIONS AND RECORD OF ISSUE

DESIGNED:	RAB
DETAILED:	TMB
CHECKED:	PDR
APPROVED:	PDR
DATE:	12/20/2022
PROJECT NO.:	411752


AGS SUPPORT FACILITIES

ARCHITECTURAL




LIFE SAFETY PLAN AND
CODE ANALYSIS

02-A-001

89
OF
163


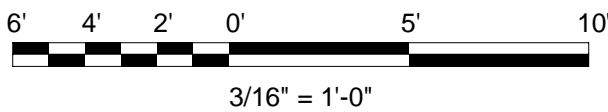


(SCALE BAR IS 4" AT FULL SCALE)

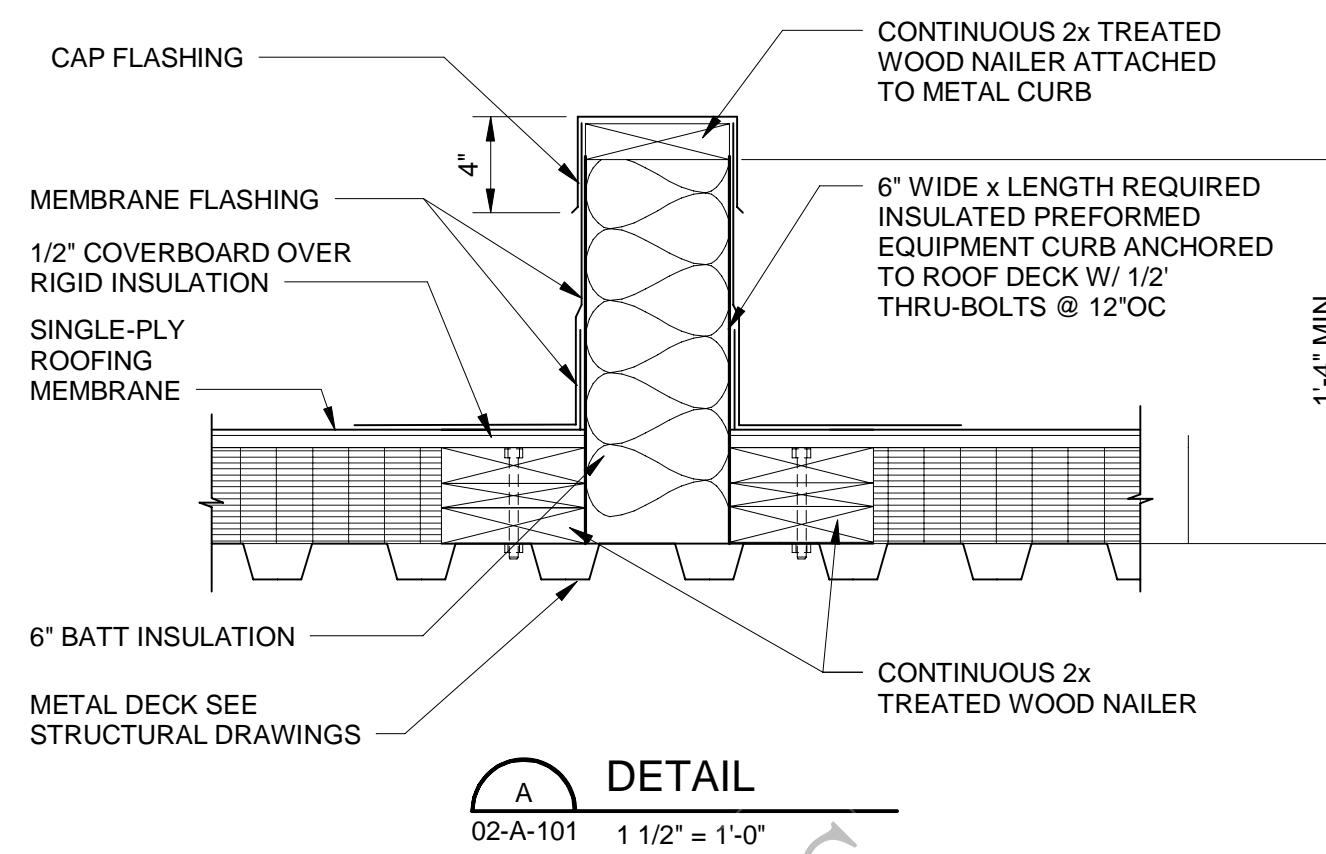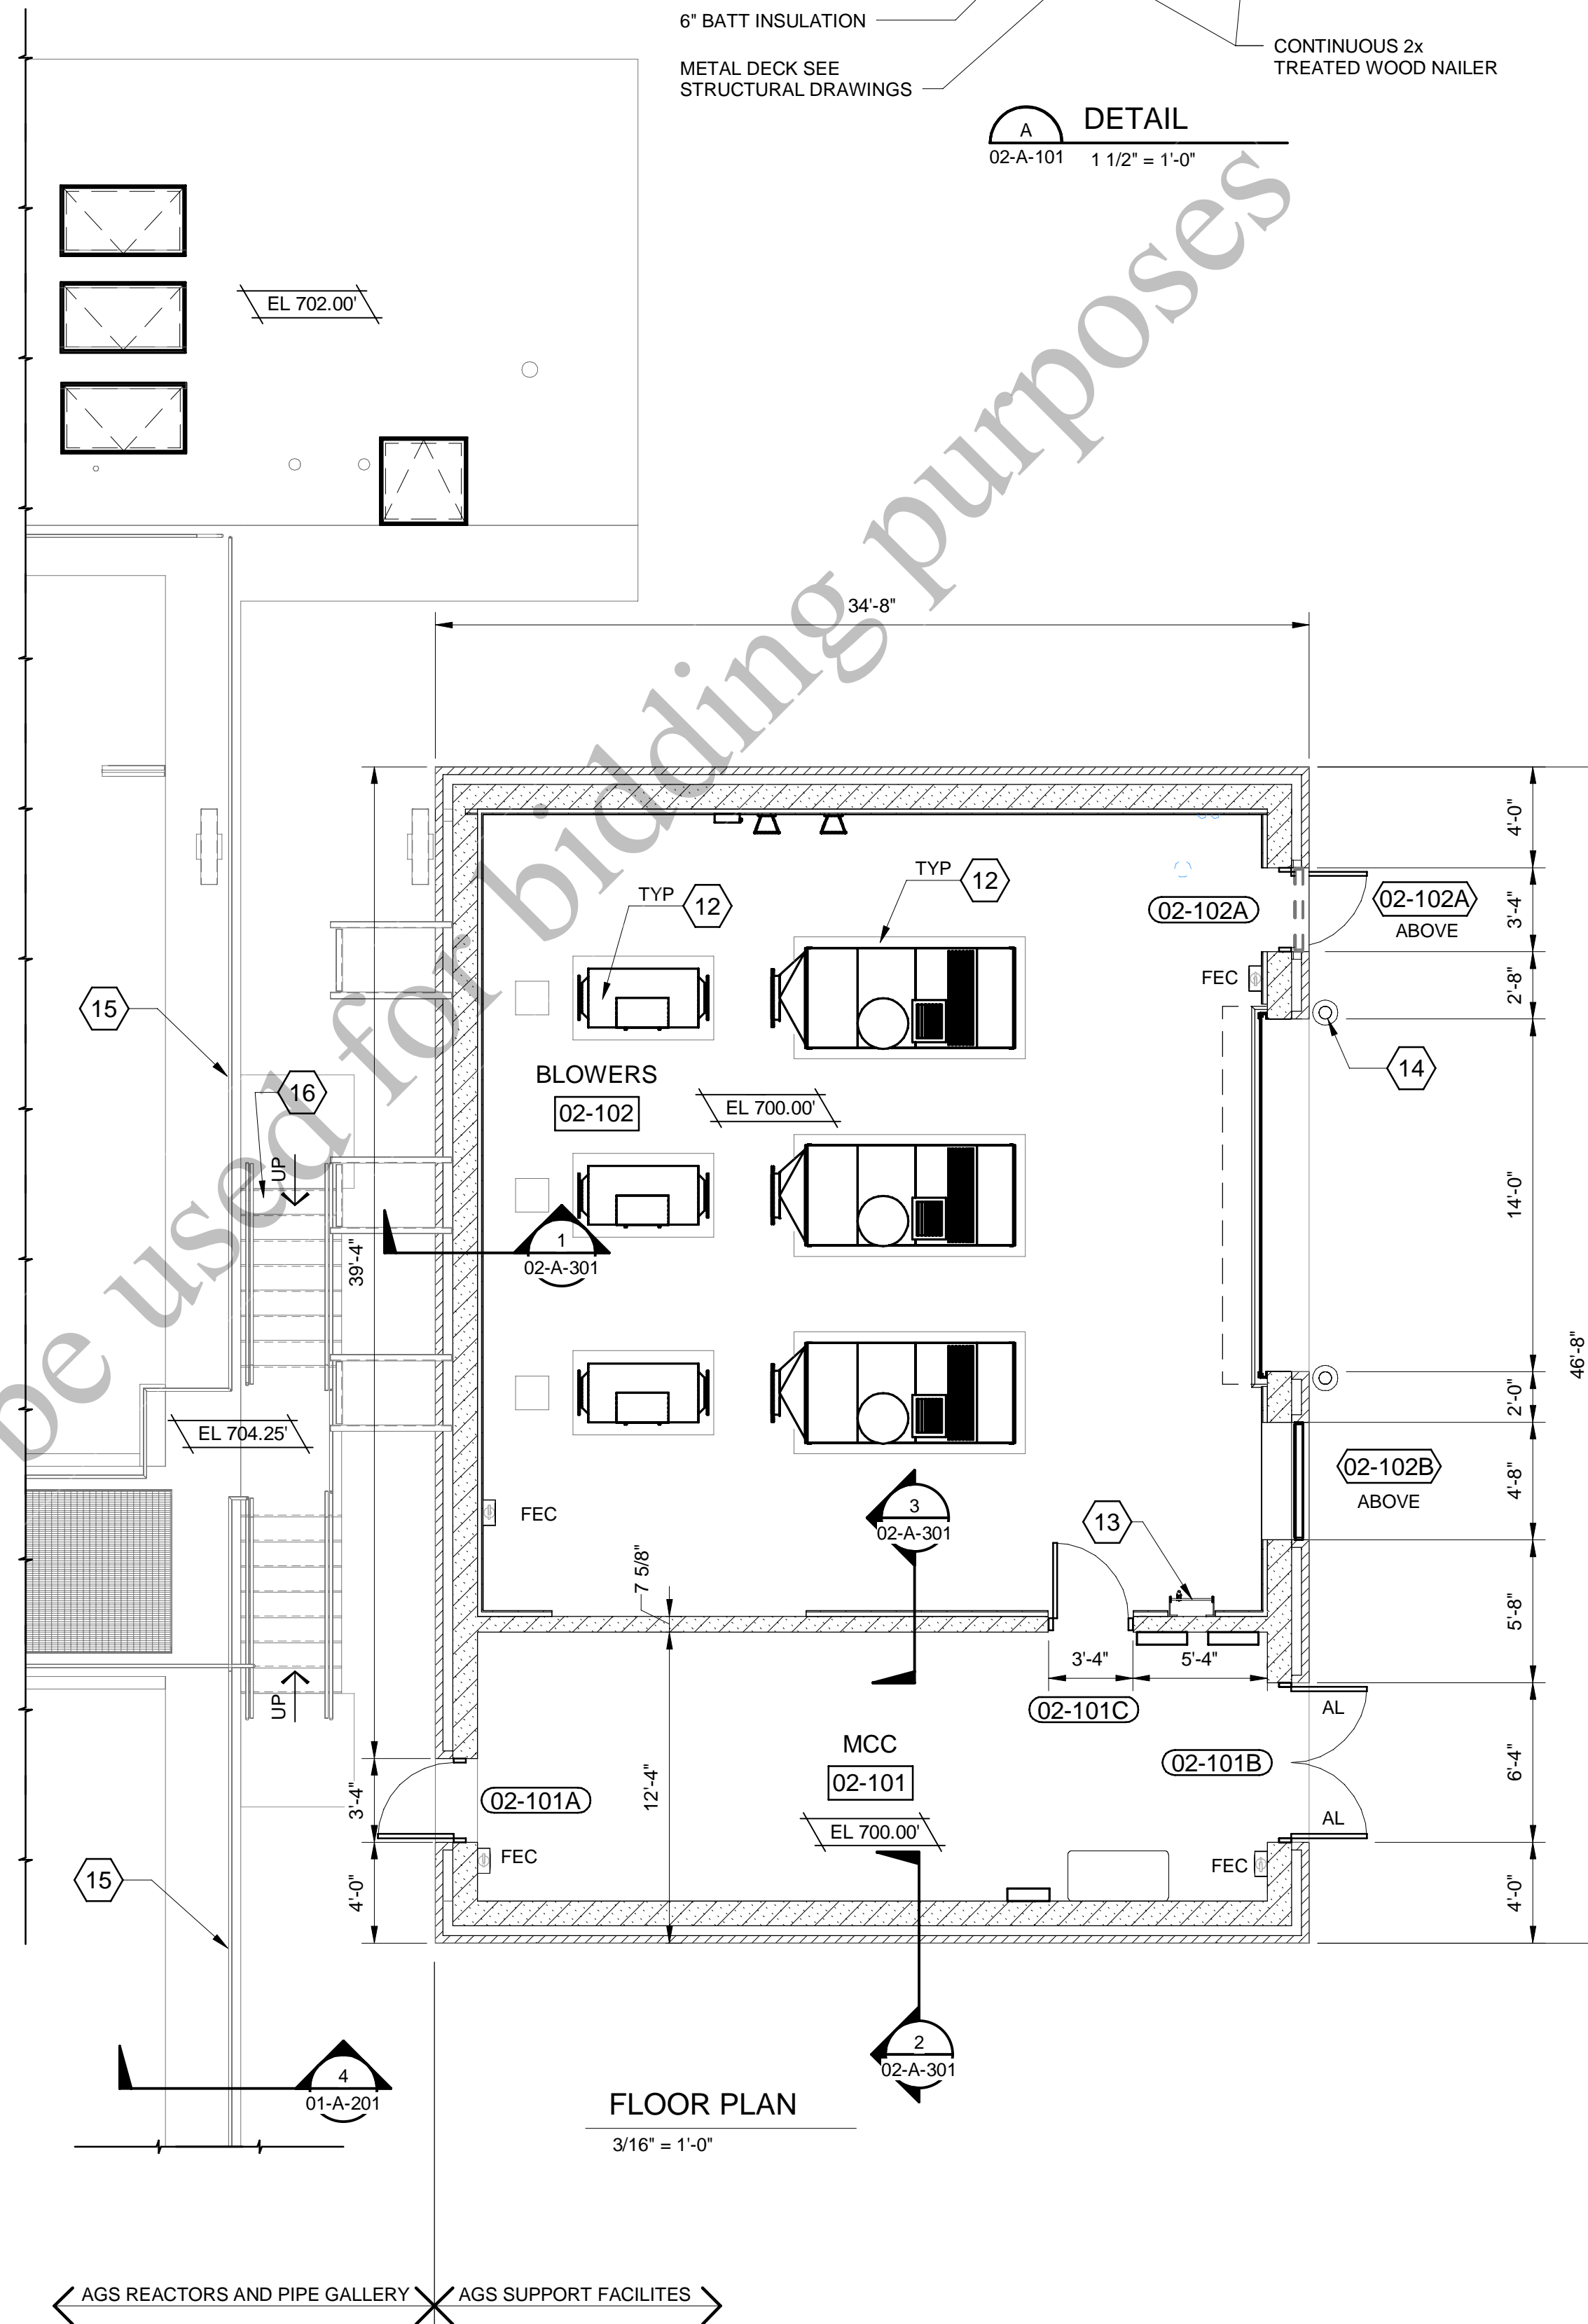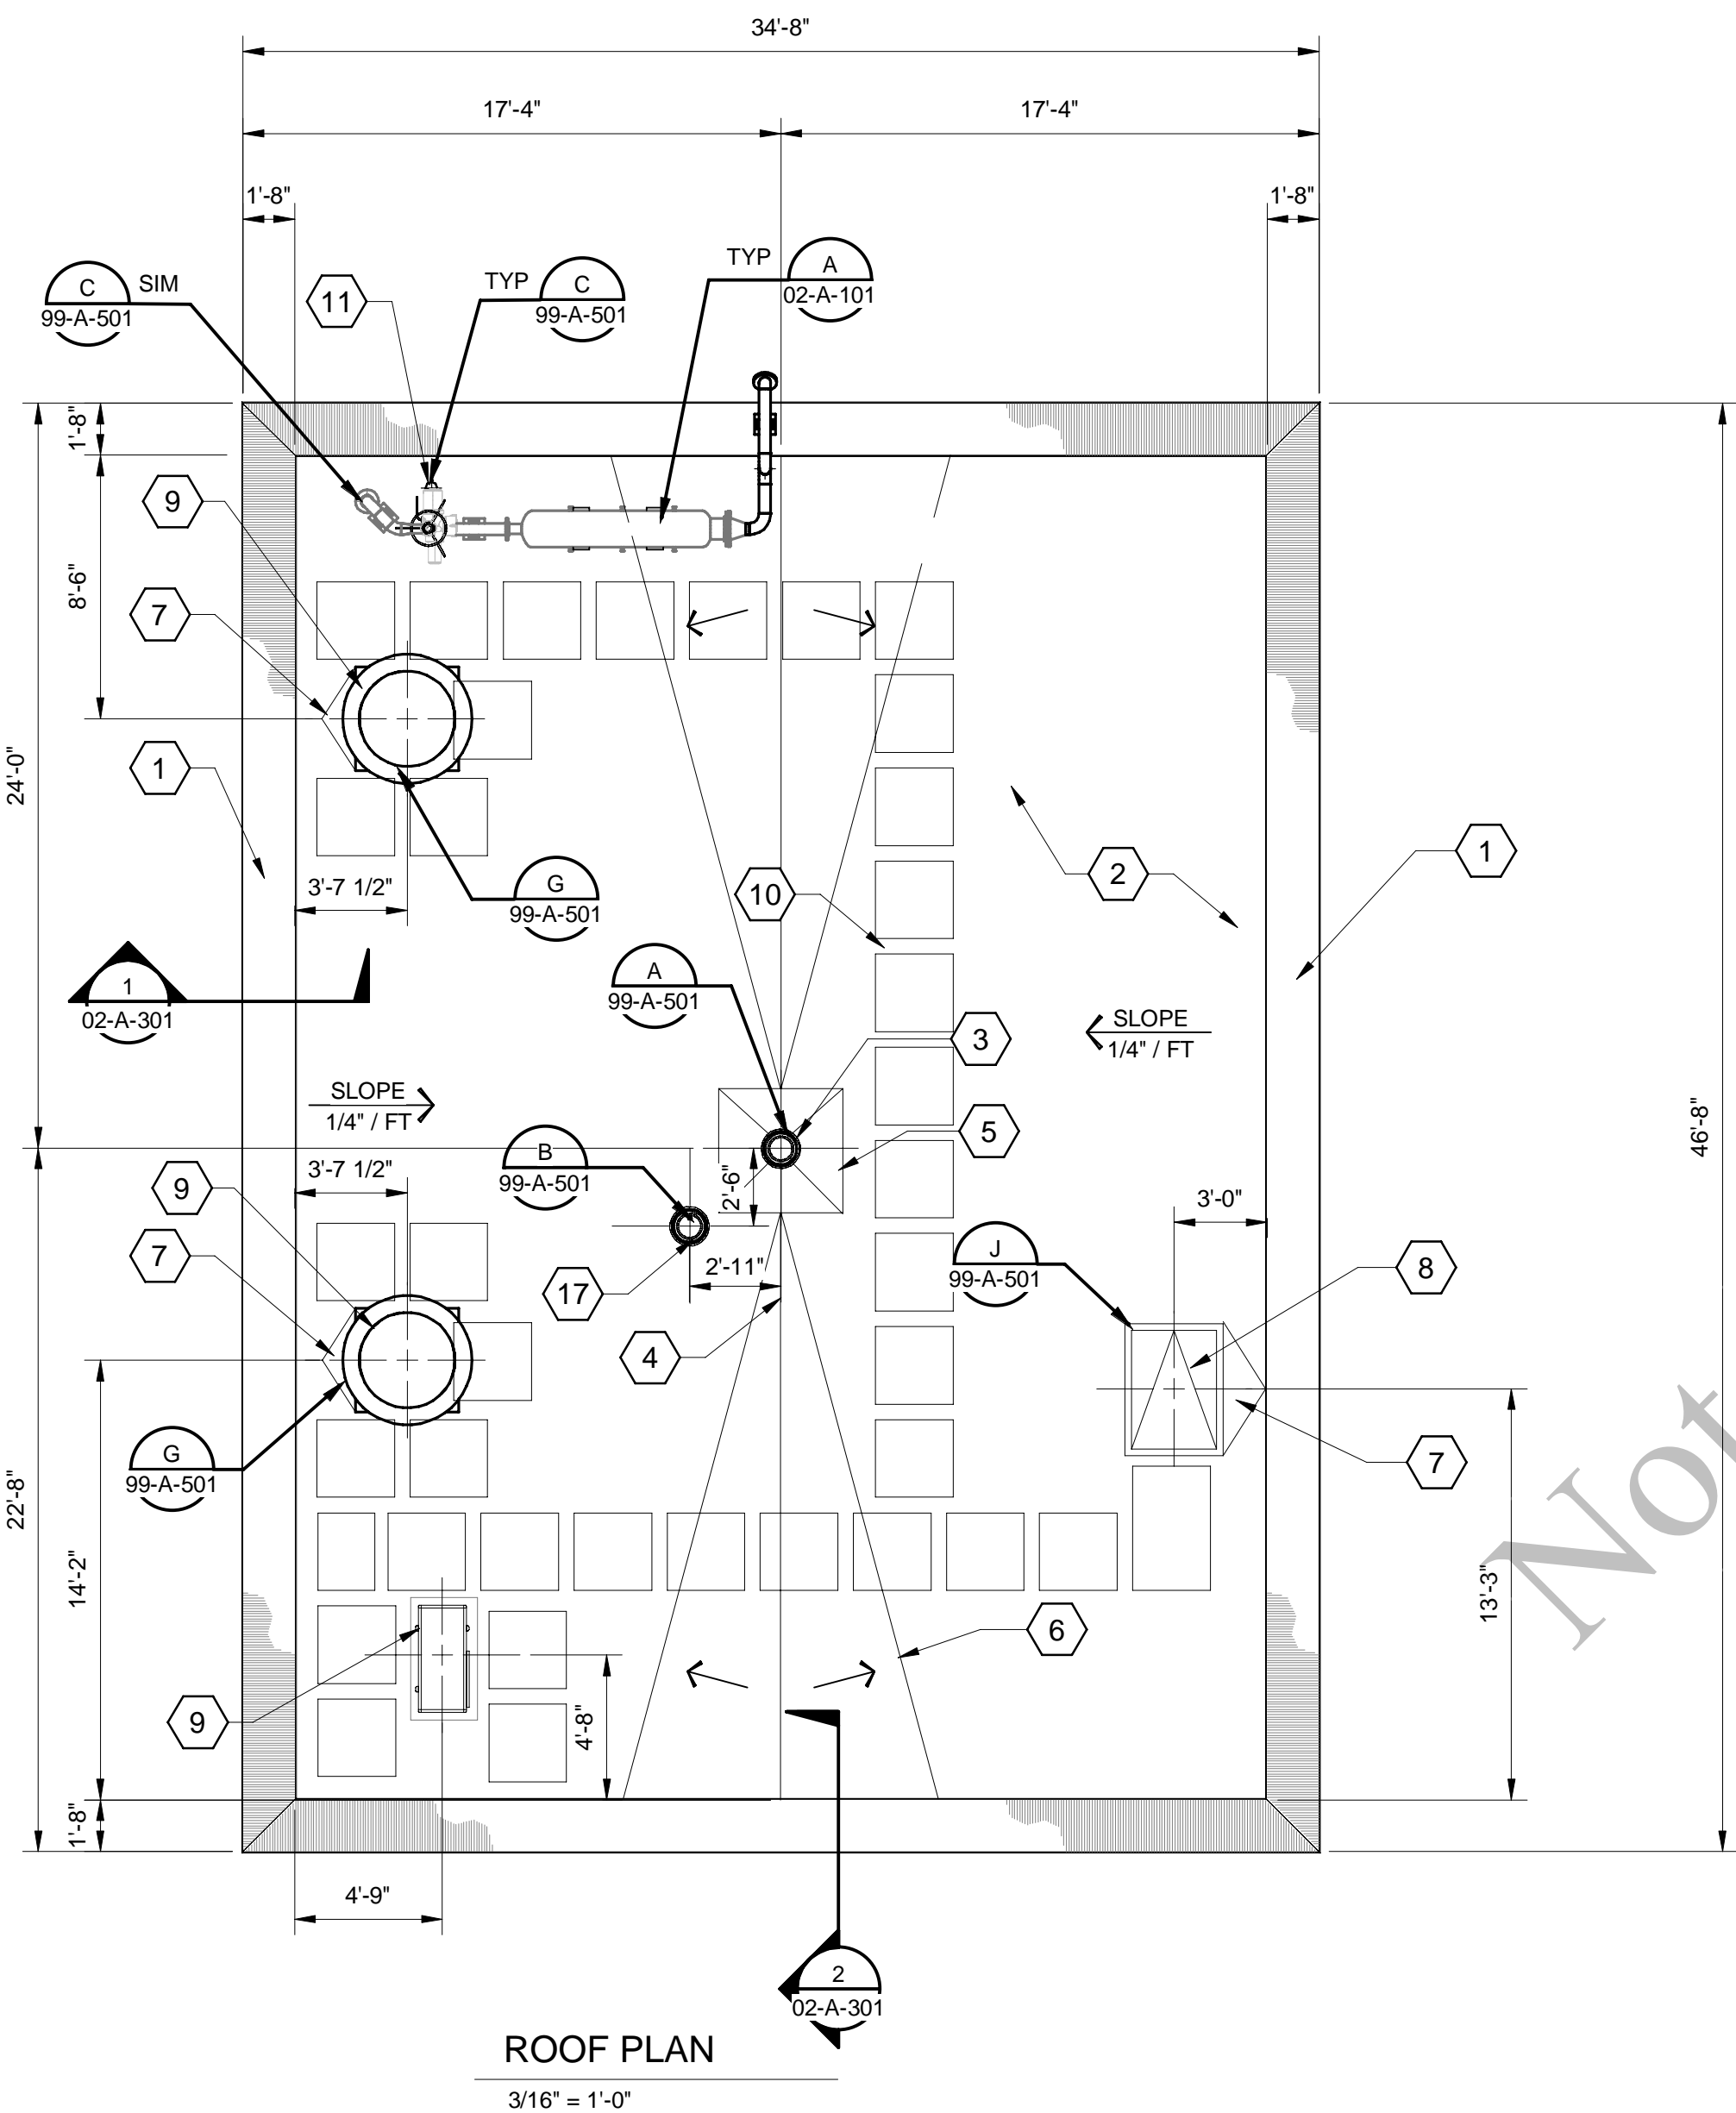

GENERAL NOTES		B&V Design, LLC Kansas City, Missouri ILLINOIS PROFESSIONAL DESIGN FIRM - 184007283																															
SHEET KEYNOTES																																	
<div>1. PREFINISHED METAL COPING.</div> <div>2. SINGLE-PLY ROOFING MEMBRANE OVER 1/2" COVER BOARD AND TAPERED INSULATION R-30.</div> <div>3. ROOF DRAIN</div> <div>4. TAPERED INSULATION VALLEY.</div> <div>5. 4'-0" x 4'-0" ROOF DRAIN SUMP - 2" INSULATION AT DRAIN AND 3" INSULATION AT UPSLOPE.</div> <div>6. CRICKET SYSTEM.</div> <div>7. PROVIDE CRICKET SYSTEM AT ROOF EQUIPMENT.</div> <div>8. ROOF SCUTTLE.</div> <div>9. HVAC EQUIPMENT - SEE HVAC DRAWINGS.</div> <div>10. ROOF WALK PADS.</div> <div>11. PLUMBING VENT.</div> <div>12. EQUIPMENT PADS - SEE STRUCTURAL DRAWINGS.</div> <div>13. LADDER TO ROOF ABOVE WITH SAFETY EXTENSION POST.</div> <div>14. BOLLARD - SEE CIVIL DRAWINGS.</div> <div>15. GUARDRAIL - SEE STRUCTURAL DRAWINGS.</div> <div>16. CONCRETE STAIRS - SEE STRUCTURAL DRAWINGS.</div> <div>17. OVERFLOW ROOF DRAIN.</div>																																	
		<div><div><div></div><div></div><div></div><div></div></div><div>Four Rivers Sanitation Authority</div></div>																															
		AEROBIC GRANULAR SLUDGE - PHASE 1																															
		<table><tr><td></td><td></td><td></td></tr><tr><td></td><td></td><td></td></tr><tr><td></td><td></td><td></td></tr><tr><td></td><td></td><td></td></tr><tr><td></td><td></td><td></td></tr><tr><td></td><td></td><td></td></tr><tr><td></td><td></td><td></td></tr><tr><td></td><td></td><td></td></tr><tr><td></td><td></td><td></td></tr><tr><td></td><td></td><td></td></tr></table>																															
		REVISIONS AND RECORD OF ISSUE																															
		DESIGNED: RAB																															
		DETAILED: TMB																															
		CHECKED: PDR																															
		APPROVED: PDR																															
		DATE: 12/20/2022																															
		PROJECT NO.: 411752																															
		AGS SUPPORT FACILITIES																															
		ARCHITECTURAL																															
		FLOOR AND ROOF PLANS																															
<div><div><div>6'</div><div>4'</div><div>2'</div><div>0'</div><div>5'</div><div>10'</div></div><div>3/16" = 1'-0"</div></div>		02-A-101																															
		90 OF 163																															

PLOTTED: 12/16/2022 11:47:04 AM
FILE: BIM 360/409469 - Aerobic Granular Sludge Phase 1/409469 - AGS.rvt
D11000

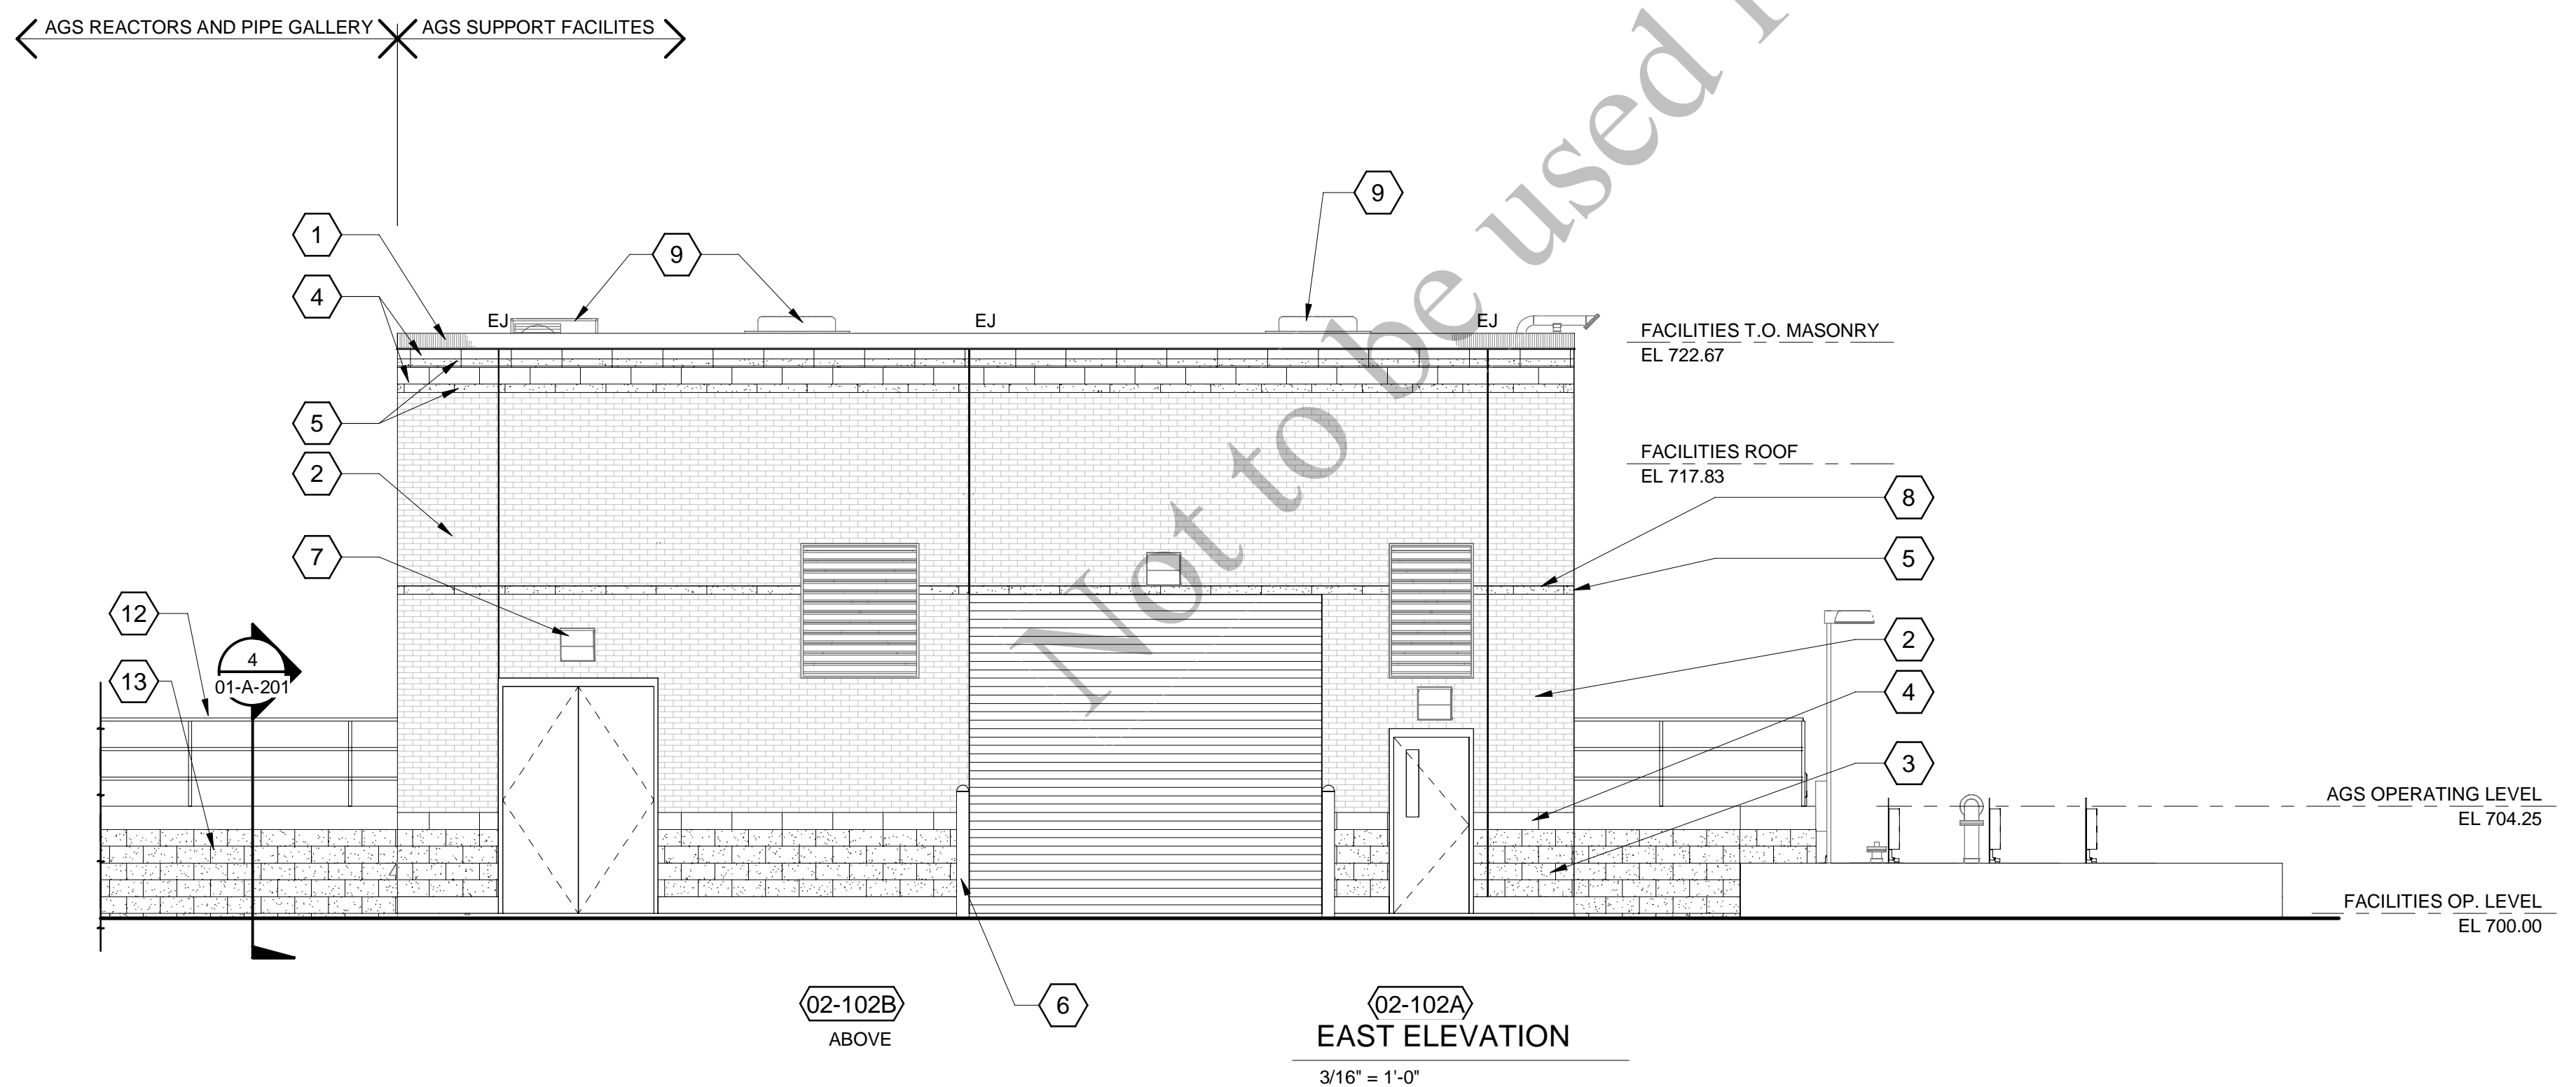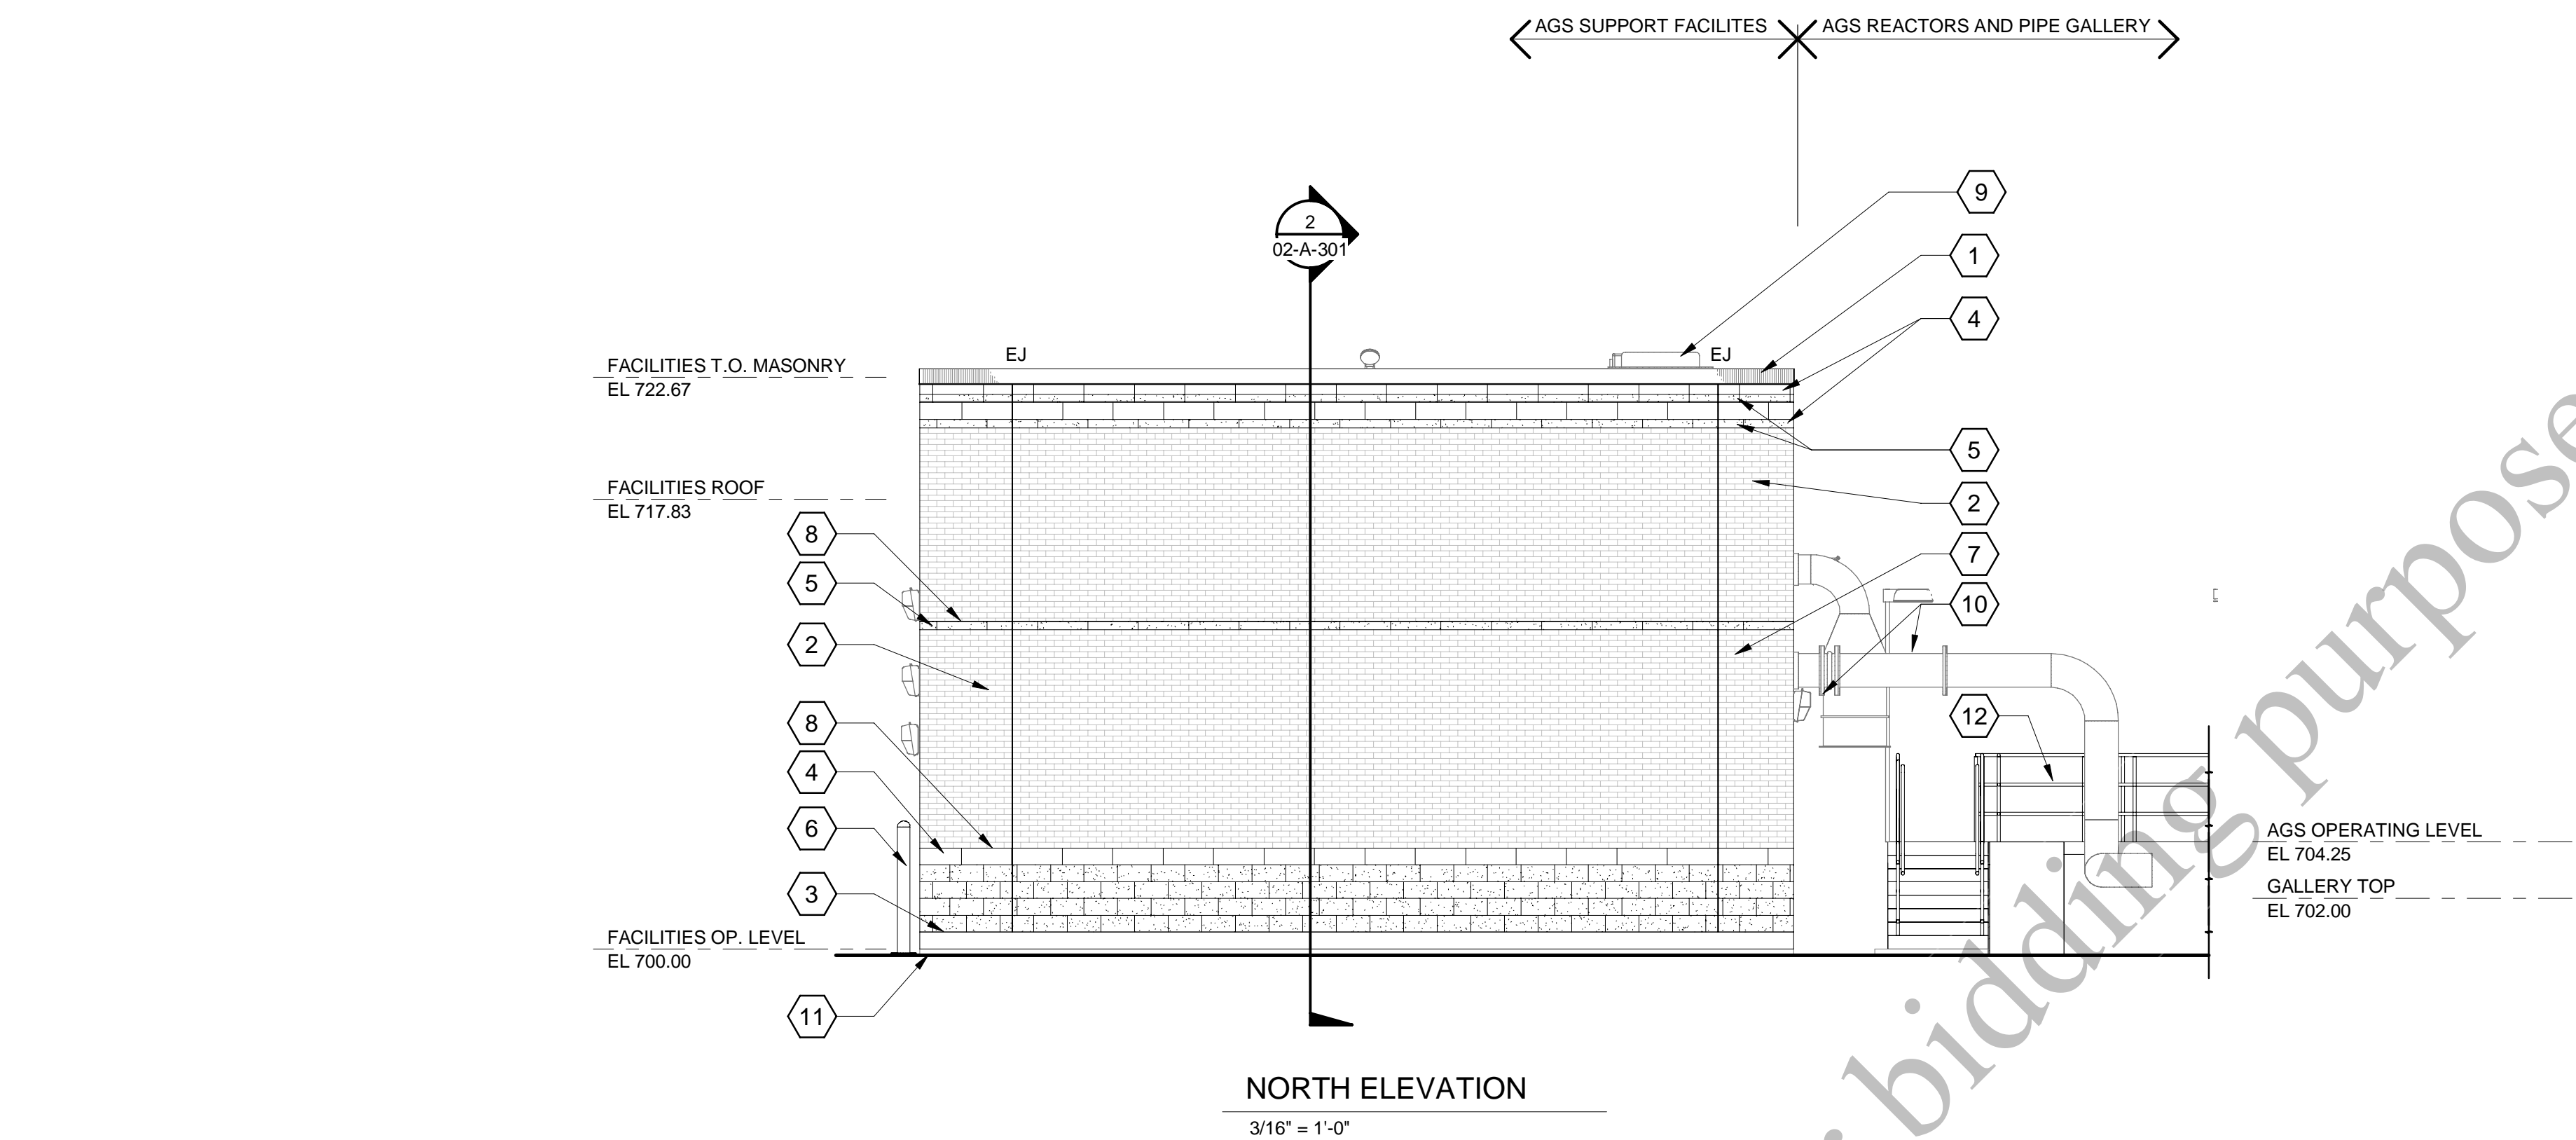

GENERAL SHEET NOTES

1. VENEER FACE BRICK EXPANSION JOINT (EJ). SEE STRUCTURAL DRAWINGS FOR BACKUP MASONRY UNITS (CMU) WALL CONTROL JOINT (CJ) WALL CONTROL JOINT LOCATIONS.
2. SHERWIN WILLIAMS STAIN COLORS:
ACCENT BANDS (4" 8", AND 12"); SW6107 NOMADIC DESERT
UPPER DARK COLOR: SW7675 SEAL SKIN

SHEET KEYNOTES

1. PREFINISHED METAL COPING - SIZE, PATTERN AND COLOR TO MATCH EXISTING PRIMARY FILTRATION FACILITY.
2. FACE BRICK - SIZE, PATTERN AND COLOR TO MATCH EXISTING PRIMARY FILTRATION FACILITY.
3. 8 x 16 ROCKFACE MASONRY UNITS - SIZE, PATTERN AND COLOR TO MATCH EXISTING PRIMARY FILTRATION FACILITY.
4. 8 x 24 SMOOTHFACE MASONRY UNITS - SIZE, PATTERN AND COLOR TO MATCH EXISTING PRIMARY FILTRATION FACILITY.
5. 4 x 24 ROCKFACE MASONRY UNITS - SIZE, PATTERN AND COLOR TO MATCH EXISTING PRIMARY FILTRATION FACILITY.
6. BOLLARD - SEE CIVIL DRAWINGS.
7. LIGHT FIXTURE (TYP) - SEE ELECTRICAL DRAWINGS.
8. BRICK SHELF ANGLE - SEE DETAIL D/99-A-501.
9. HVAC EQUIPMENT - SEE HVAC DRAWINGS.
10. MECHANICAL EQUIPMENT - SEE MECHANICAL DRAWINGS.
11. FINISHED GRADE - CIVIL DRAWINGS.
12. GUARDRAIL - SEE STRUCTURAL DRAWINGS.
13. CAST IN PLACE CONCRETE BASIN WALL W/ FORMLINER - SIZE, PATTERN AND COLOR TO MATCH EXISTING PRIMARY FILTRATION FACILITY.



AEROBIC GRANULAR
SLUDGE - PHASE 1

REVISIONS AND RECORD OF ISSUE

DESIGNED:	RAB
DETAILED:	TMB
CHECKED:	PDR
APPROVED:	PDR
DATE:	12/20/2022

PROJECT NO.: 411752


AGS SUPPORT FACILITIES

ARCHITECTURAL

NORTH AND EAST
ELEVATIONS


02-A-201

91
OF
163

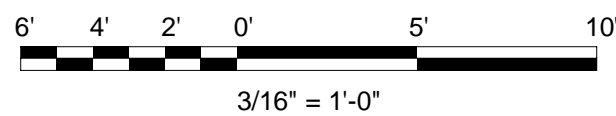

(SCALE BAR IS 4" AT FULL SCALE) 0 1/2 1 2 3 4

PLOTTED: 12/18/2022 11:53:46 AM
FILE: BIM 360/409469 - Aerobic Granular Sludge Phase 1/409469 - AGS.rvt
D11000

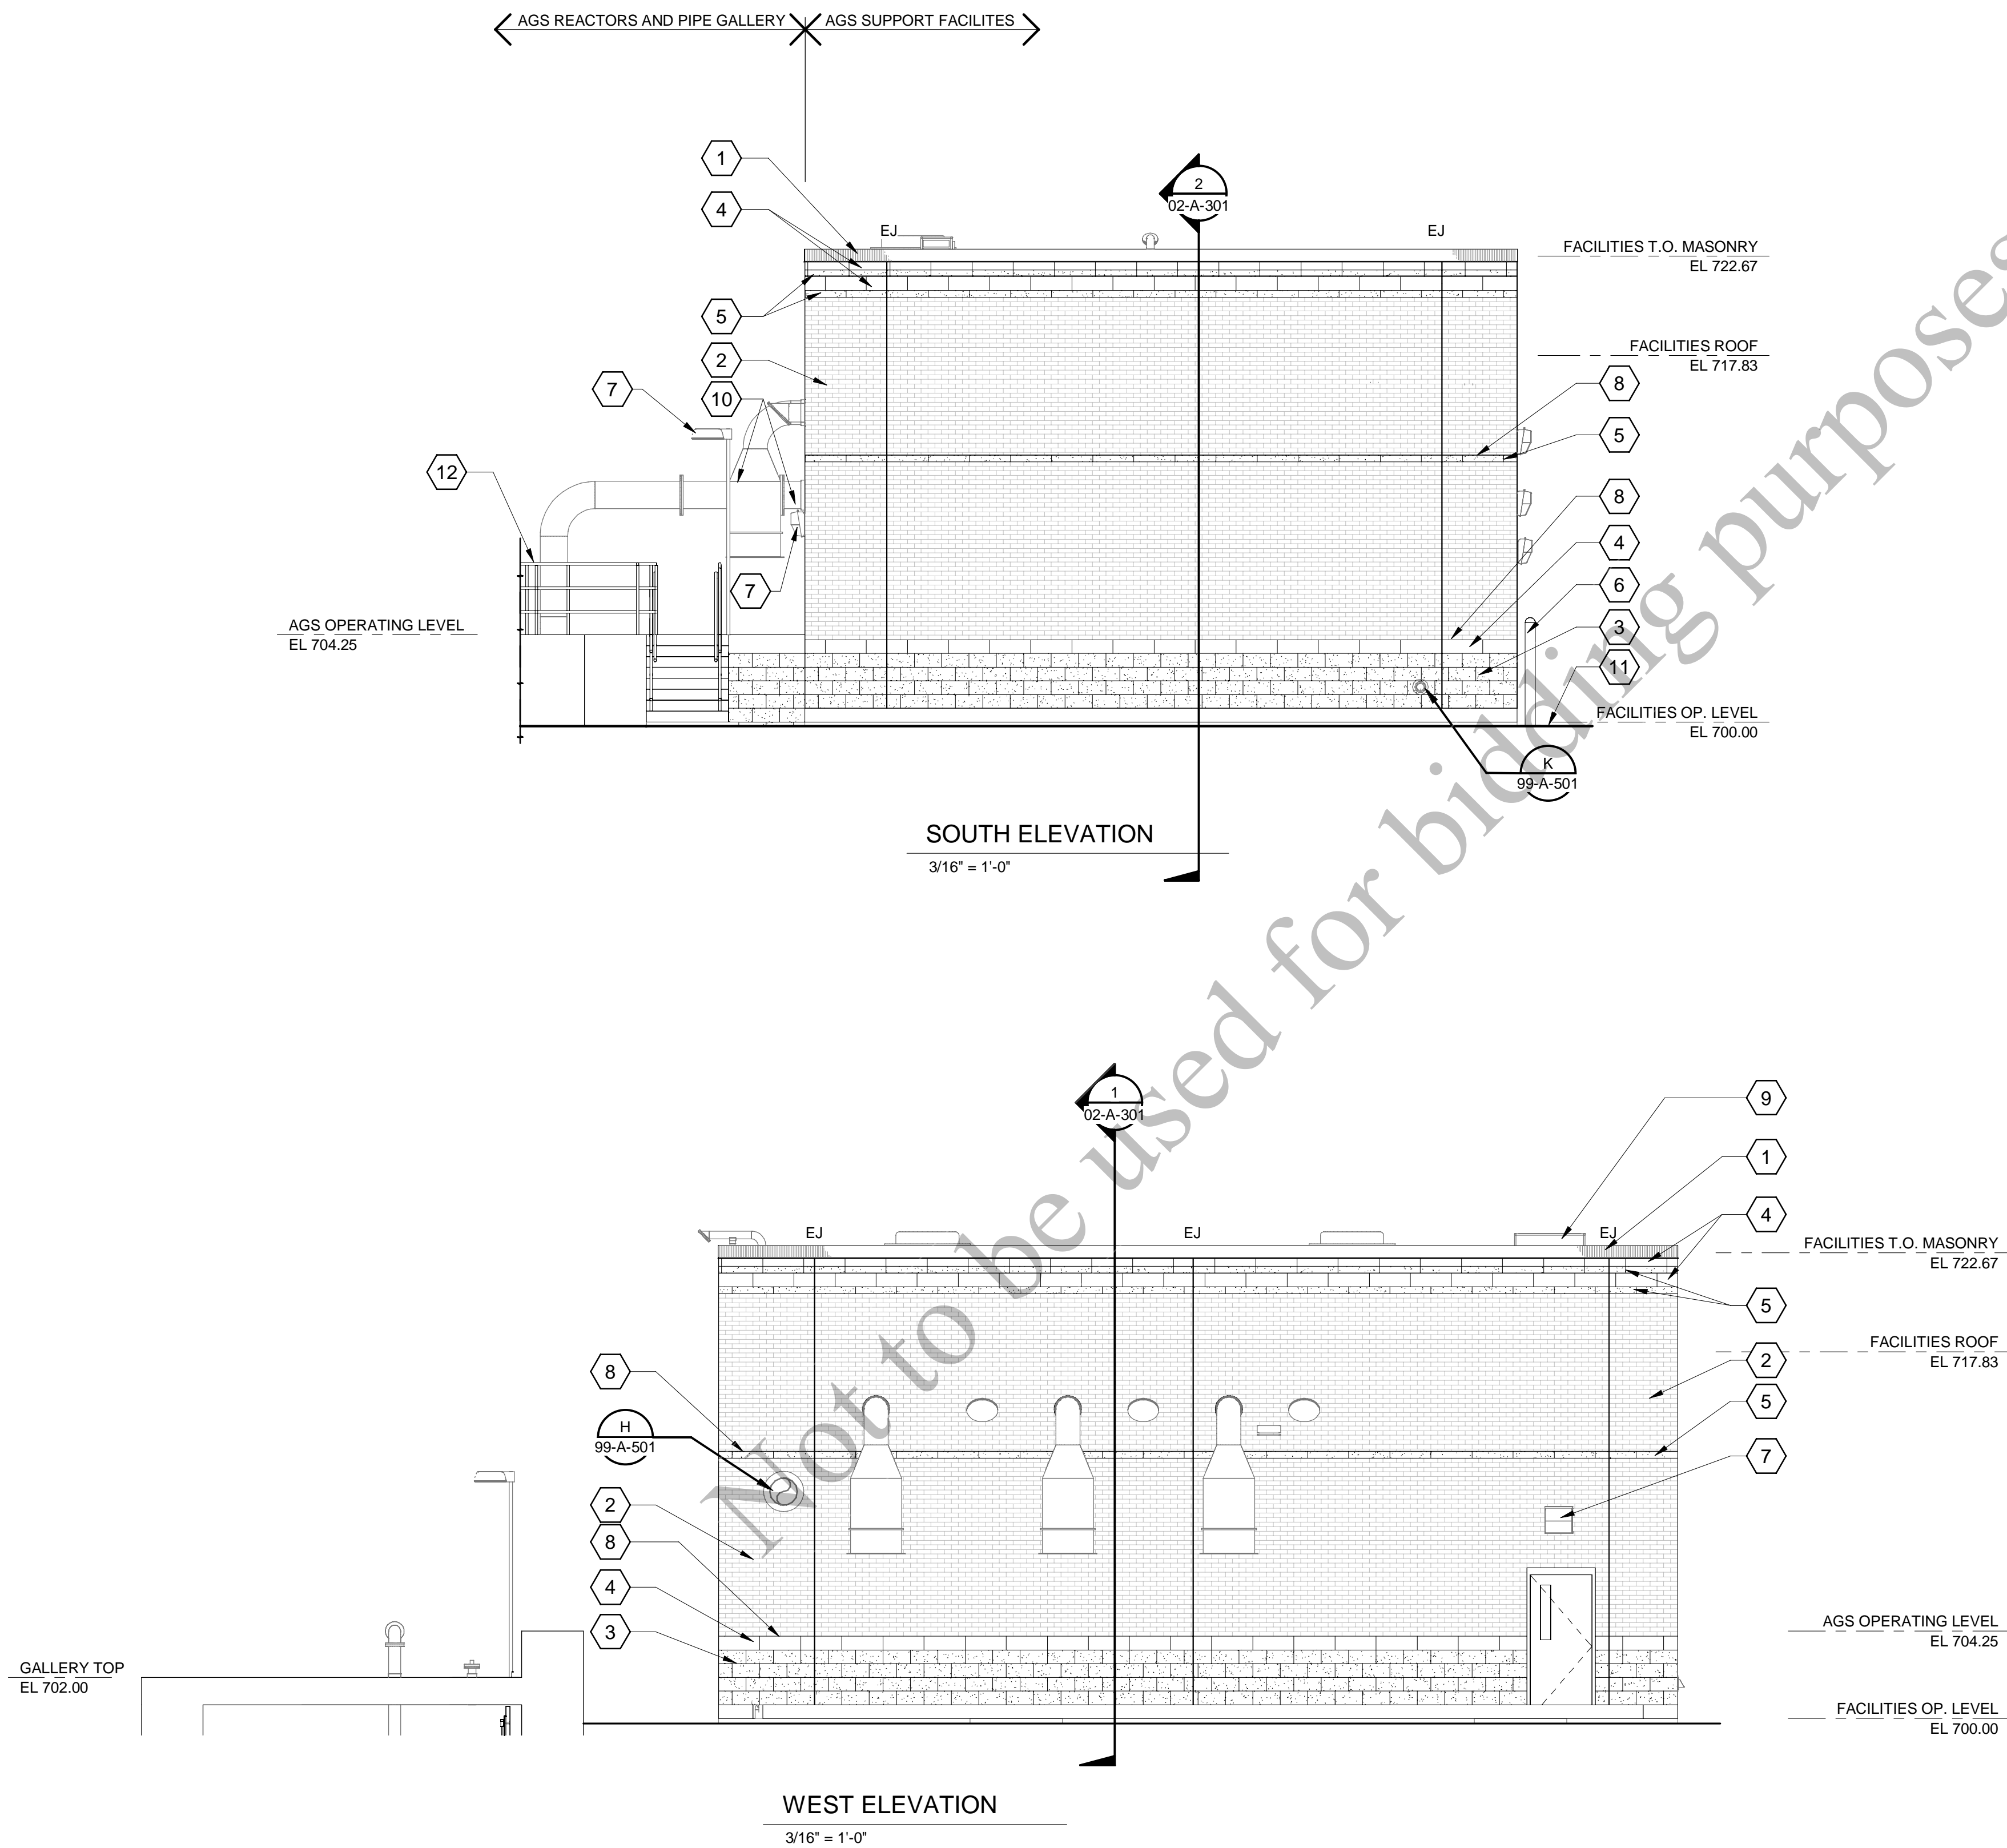

GENERAL SHEET NOTES

1. VENEER FACE BRICK EXPANSION JOINT (EJ). SEE STRUCTURAL DRAWINGS FOR BACKUP MASONRY UNITS (CMU) WALL CONTROL JOINT (CJ) WALL CONTROL JOINT LOCATIONS.
2. SHERWIN WILLIAMS STAIN COLORS:
ACCENT BANDS (4".8", AND 12"): SW6107 NOMADIC DESERT
UPPER DARK COLOR: SW7675 SEAL SKIN

SHEET KEYNOTES

1. PREFINISHED METAL COPING - SIZE, PATTERN AND COLOR TO MATCH EXISTING PRIMARY FILTRATION FACILITY.
2. FACE BRICK - SIZE, PATTERN AND COLOR TO MATCH EXISTING PRIMARY FILTRATION FACILITY.
3. 8 x 16 ROCKFACE MASONRY UNITS - SIZE, PATTERN AND COLOR TO MATCH EXISTING PRIMARY FILTRATION FACILITY.
4. 8 x 24 SMOOTHFACE MASONRY UNITS - SIZE, PATTERN AND COLOR TO MATCH EXISTING PRIMARY FILTRATION FACILITY.
5. 4 x 24 ROCKFACE MASONRY UNITS - SIZE, PATTERN AND COLOR TO MATCH EXISTING PRIMARY FILTRATION FACILITY.
6. BOLLARD - SEE CIVIL DRAWINGS.
7. LIGHT FIXTURE (TYP) - SEE ELECTRICAL DRAWINGS.
8. BRICK SHELF ANGLE - SEE DETAIL D/99-A-501.
9. HVAC EQUIPMENT - SEE HVAC DRAWINGS.
10. MECHANICAL EQUIPMENT - SEE MECHANICAL DRAWINGS.
11. FINISHED GRADE - CIVIL DRAWINGS.
12. GUARDRAIL - SEE STRUCTURAL DRAWINGS.
13. CAST IN PLACE CONCRETE BASIN WALL W/ FORMLINER - SIZE, PATTERN AND COLOR TO MATCH EXISTING PRIMARY FILTRATION FACILITY.



AEROBIC GRANULAR
SLUDGE - PHASE 1

REVISIONS AND RECORD OF ISSUE

DESIGNED:	RAB
DETAILED:	TMB
CHECKED:	PDR
APPROVED:	PDR
DATE:	12/20/2022

PROJECT NO.: 411752


AGS SUPPORT FACILITIES

ARCHITECTURAL

SOUTH AND WEST
ELEVATIONS




02-A-202

92
OF
163

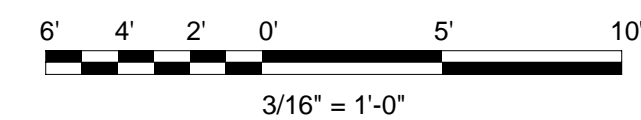

(SCALE BAR IS 4" AT FULL SCALE)

PLOTTED: 12/16/2022 11:46:53 AM
 FILE: BIM 360/409469 - Aerobic Granular Sludge Phase 1/409469 - AGS.rvt
 D11000

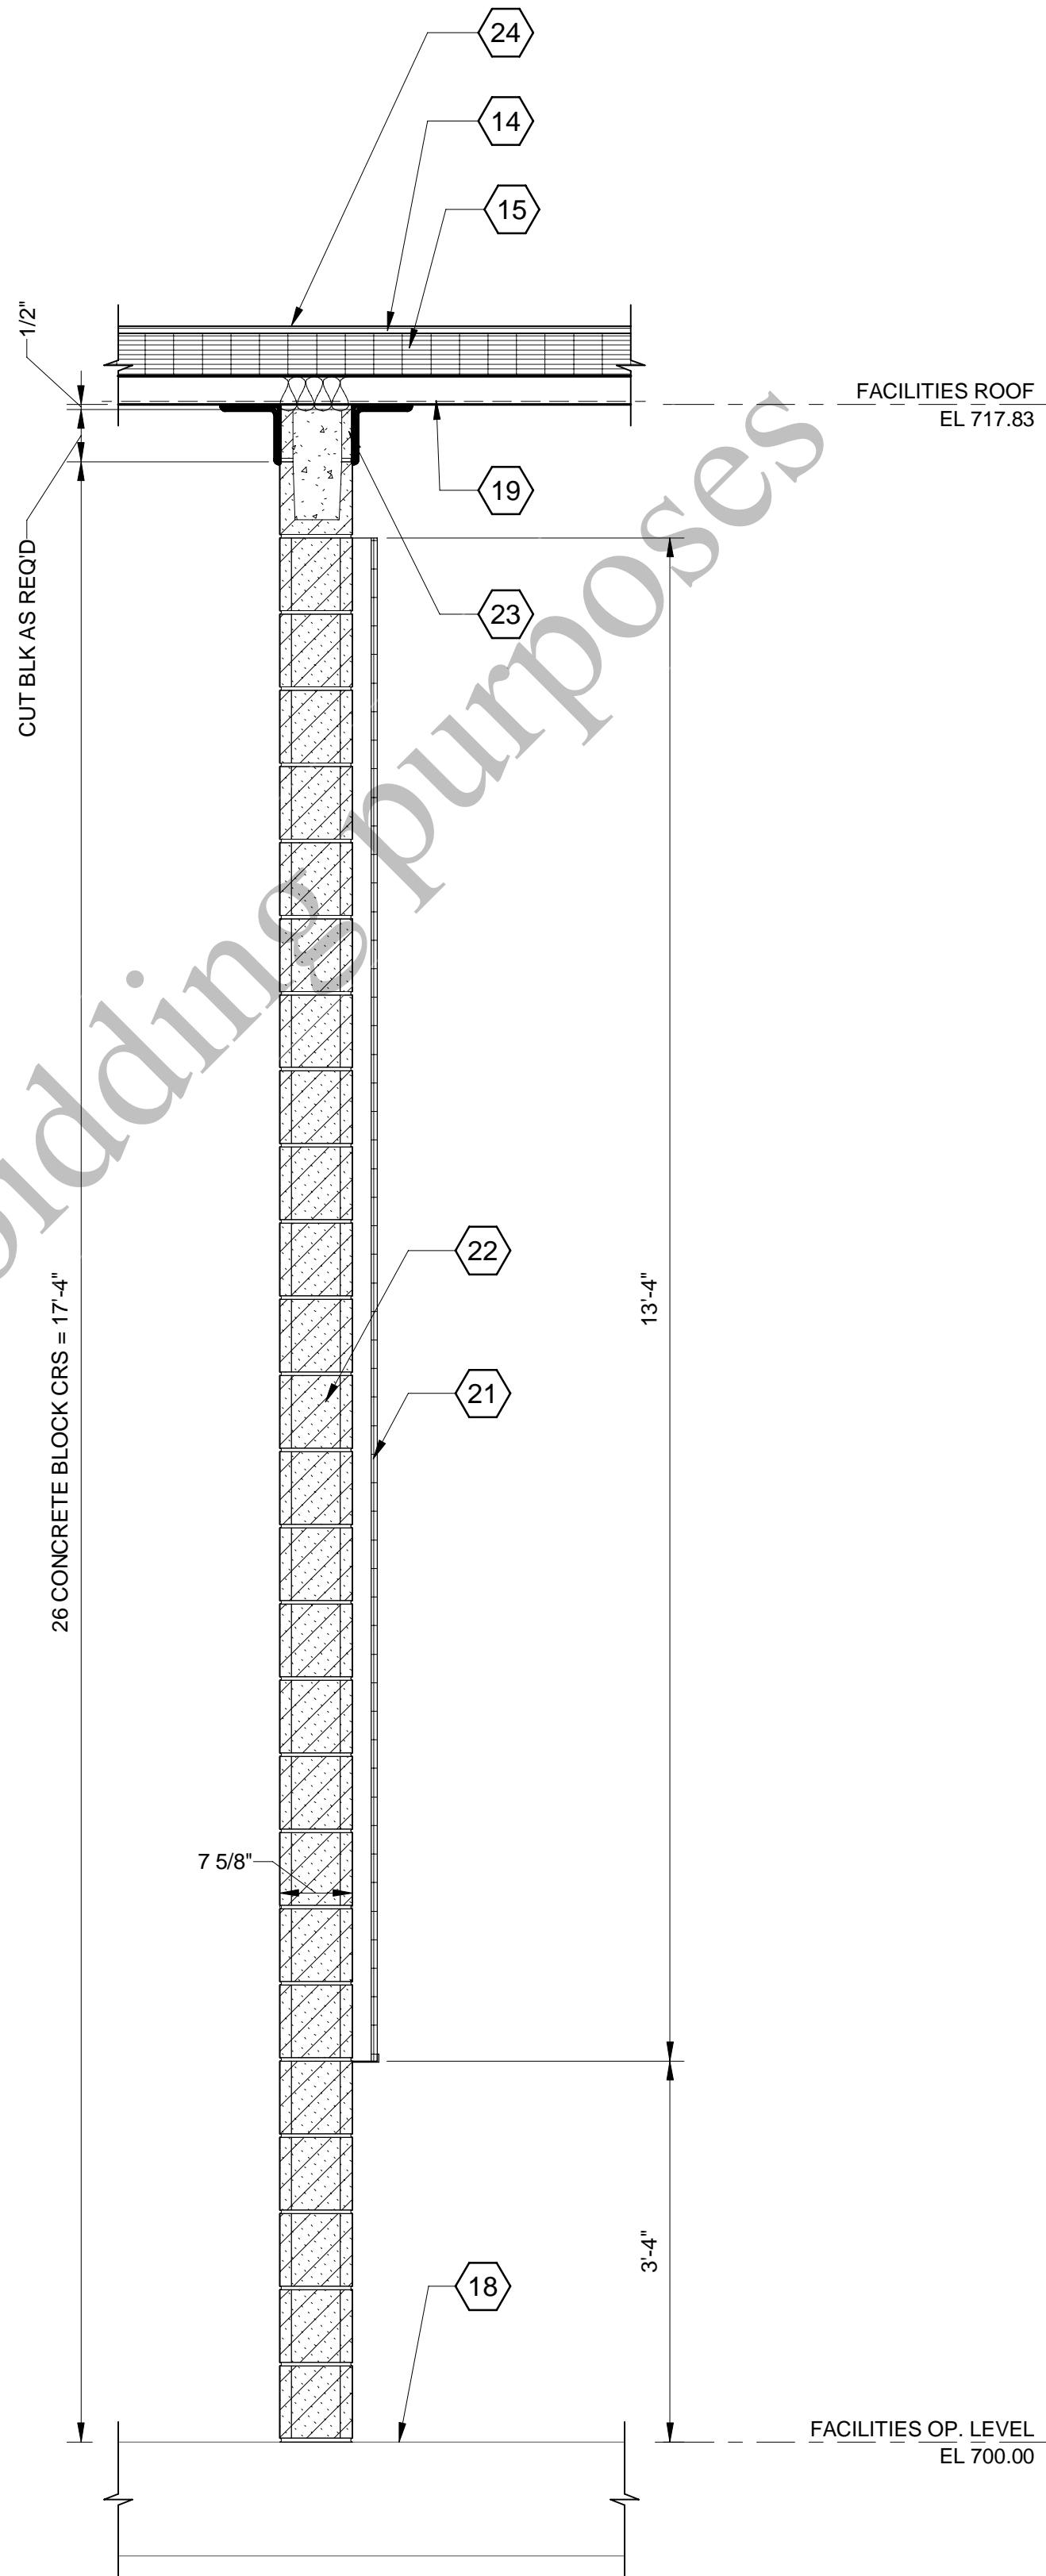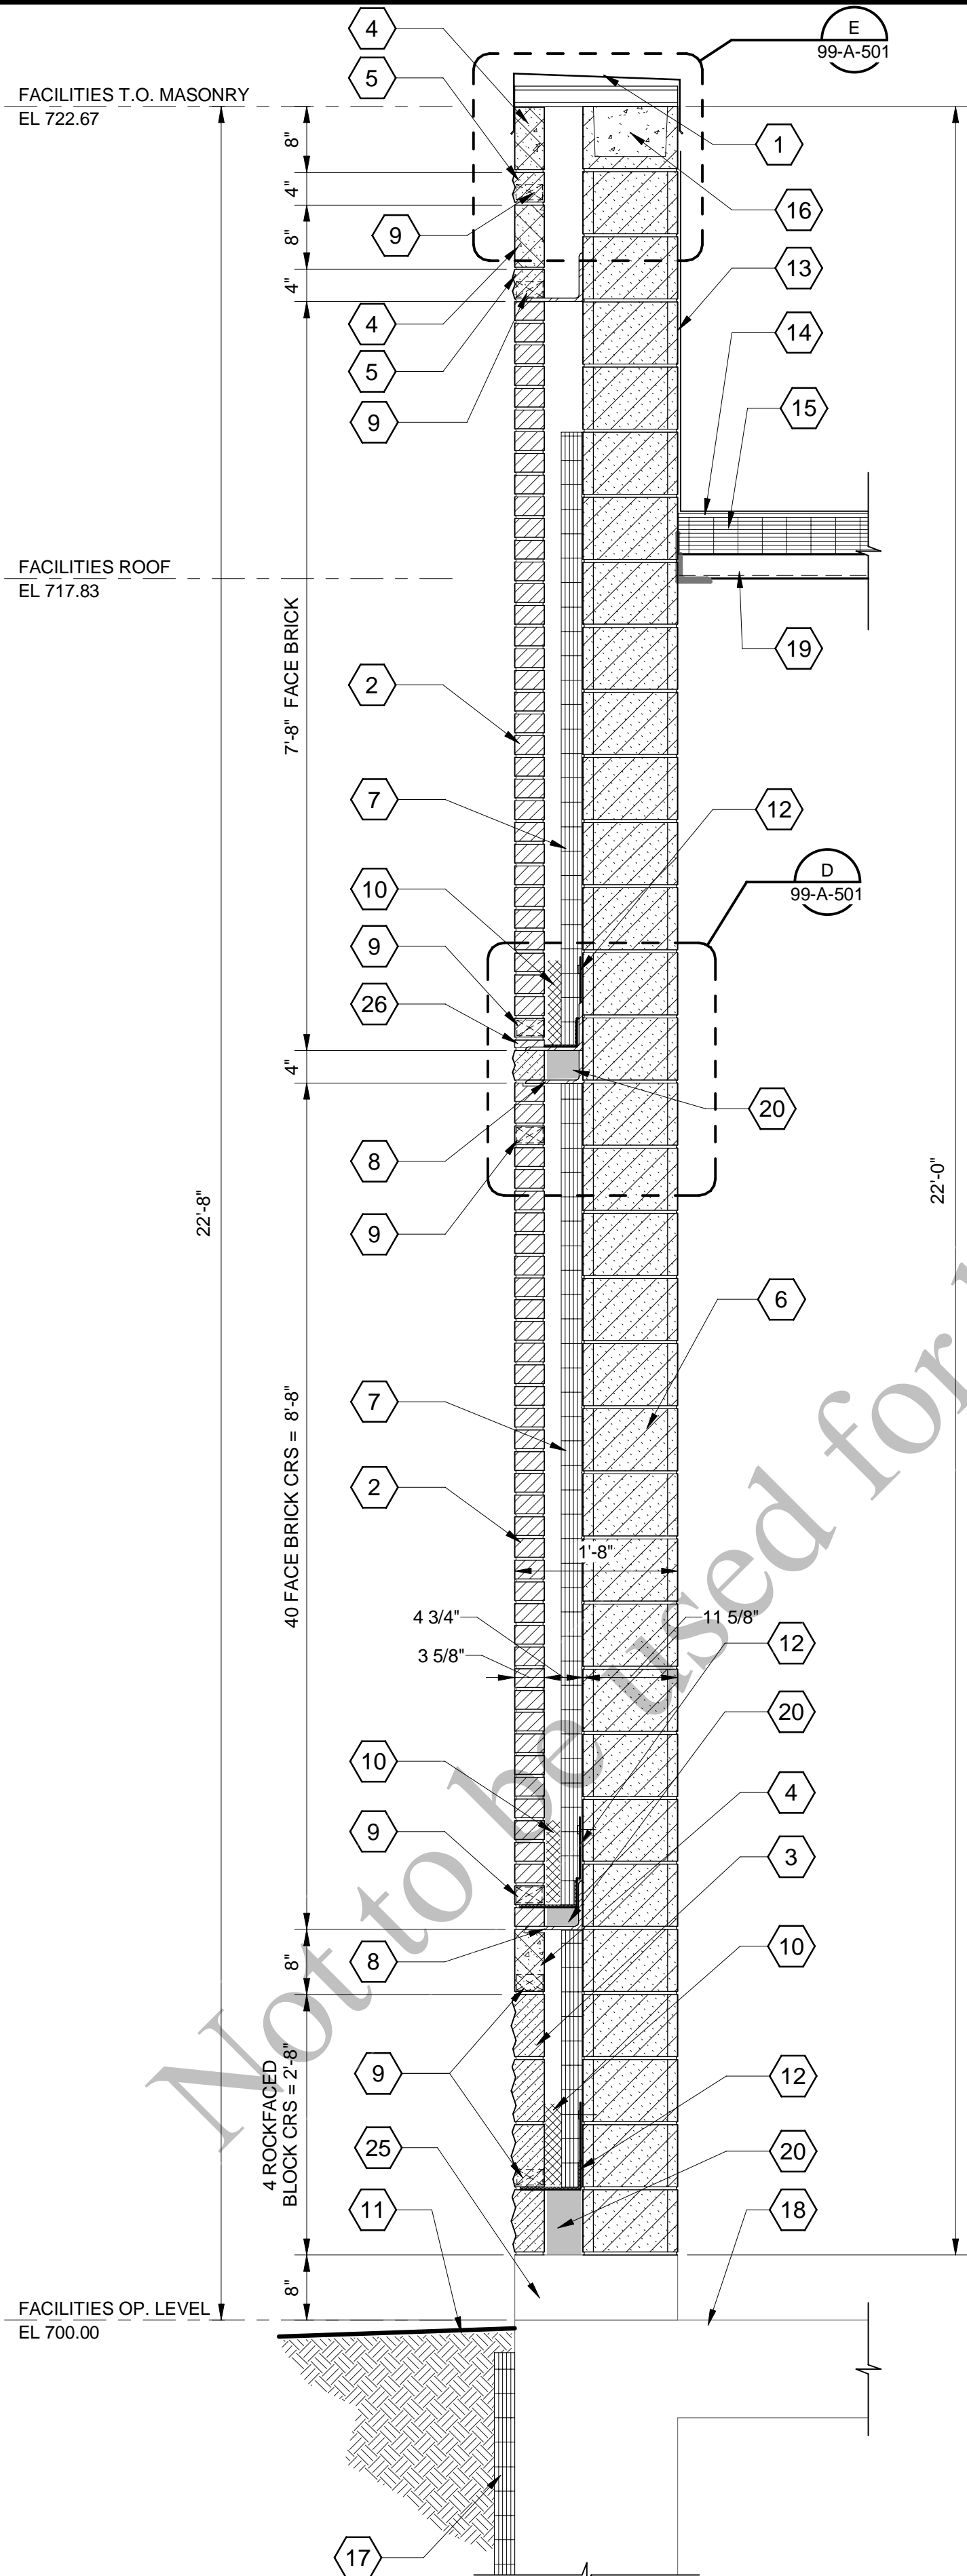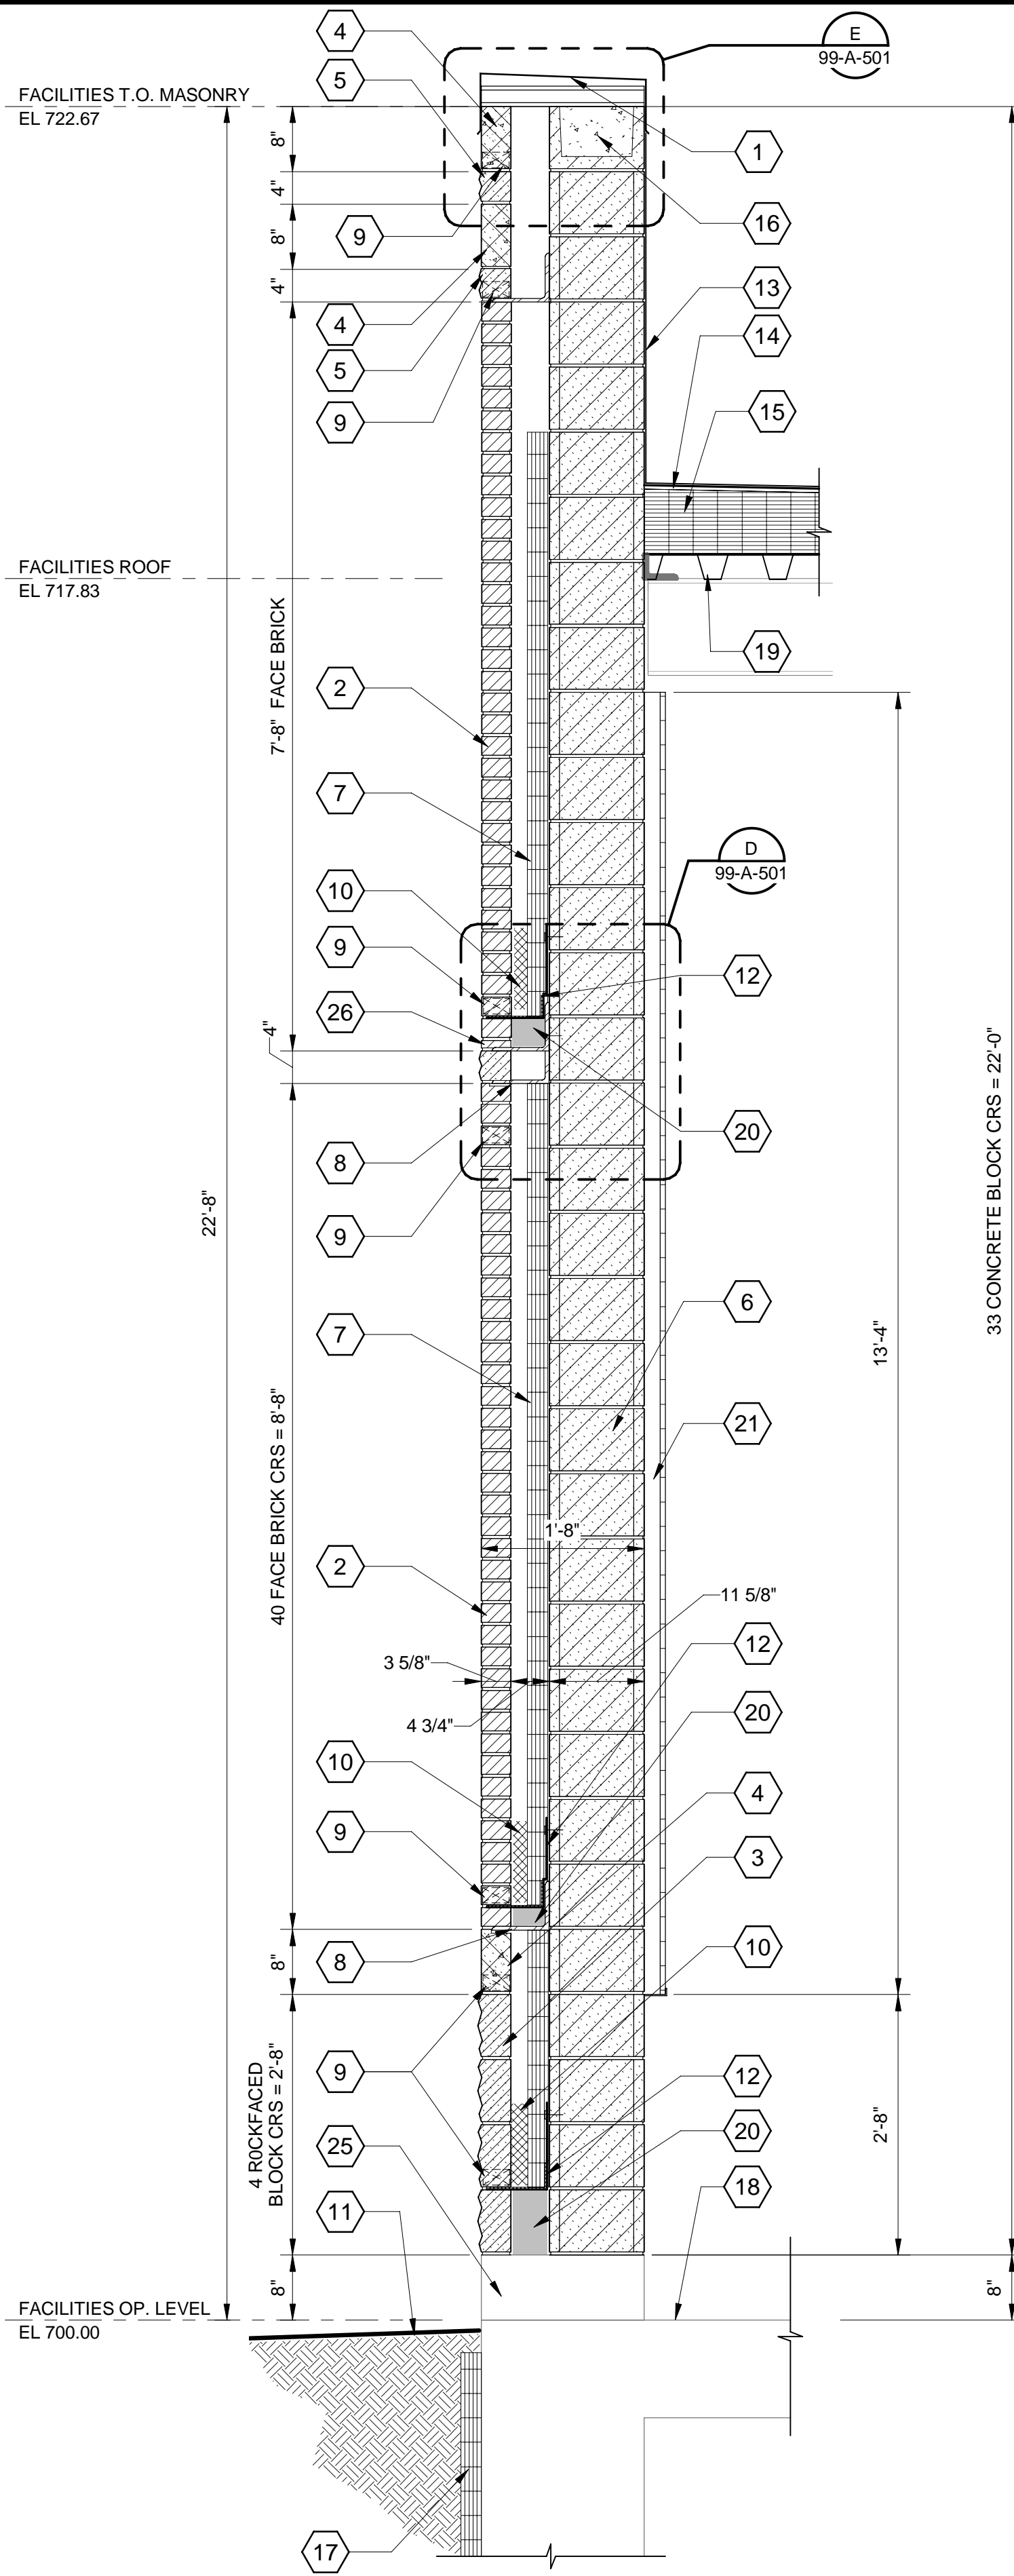

GENERAL SHEET NOTES

- FOR VERTICAL REINFORCING AND BOND BEAMS IN MASONRY DESIGN - SEE STRUCTURAL DRAWINGS.
- FOR HORIZONTAL JOINT REINFORCING - SEE SPECIFICATION SECTION 042000.

SHEET KEYNOTES

- PREFINISHED METAL COPING - SIZE, PATTERN AND COLOR TO MATCH EXISTING PRIMARY FILTRATION FACILITY.
- FACE BRICK - SIZE, PATTERN AND COLOR TO MATCH EXISTING PRIMARY FILTRATION FACILITY.
- 8 x 16 ROCKFACE MASONRY UNITS - SIZE, PATTERN AND COLOR TO MATCH EXISTING PRIMARY FILTRATION FACILITY.
- 8 x 24 SMOOTHFACE MASONRY UNITS - SIZE, PATTERN AND COLOR TO MATCH EXISTING PRIMARY FILTRATION FACILITY.
- 4 x 24 ROCKFACE MASONRY UNITS - SIZE, PATTERN AND COLOR TO MATCH EXISTING PRIMARY FILTRATION FACILITY.
- 12" CONCRETE MASONRY UNIT.
- 2 1/2" RIGID INSULATION R-12.
- BRICK SHELF ANGLE - SEE DETAIL D/99-A-501.
- WEEP VENTS @ 24" O.C.
- 10" HIGH x 2" THICK MORTAR NET.
- FINISHED GRADE - CIVIL DRAWINGS.
- TOTALFLASH CAVITY-WALL DRAINAGE SYSTEM.
- SINGLE-PLY ROOFING MEMBRANE EXTEND OVER PARAPET WALL.
- 1/2" COVER BOARD.
- TAPERED INSULATION R-30.
- BOND BEAM - SEE STRUCTURAL DRAWINGS.
- FOUNDATION INSULATION R-10.
- FINISHED FLOOR AS SCHEDULED.
- METAL DECK - SEE STRUCTURAL DRAWINGS.
- MORTAR FILL UNDER THE TOTALFLASH CAVITY-WALL DRAINAGE SYSTEM.
- ACOUSTICAL WALL PANEL SYSTEM WITH METAL BOTTOM TRIM.
- 8" CONCRETE MASONRY UNIT.
- SEE STRUCTURAL DRAWINGS FOR CONNECTION.
- SINGLE-PLY ROOFING MEMBRANE.
- 8" x 1'-8" CONCRETE CURB - SEE STRUCTURAL DRAWINGS.
- CUT FACE BRICK AS REQUIRED.

B&V Design, LLC
 Kansas City, Missouri
 ILLINOIS PROFESSIONAL
 DESIGN FIRM - 184007283



AEROBIC GRANULAR
 SLUDGE - PHASE 1

REVISIONS AND RECORD OF ISSUE	
DESIGNED:	RAB
DETAILED:	TMB
CHECKED:	PDR
APPROVED:	PDR
DATE:	12/20/2022
PROJECT NO.:	411752


AGS SUPPORT FACILITIES

ARCHITECTURAL

WALL SECTIONS


02-A-301

93
 OF
 163

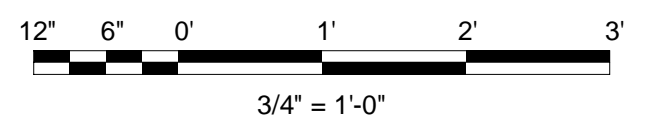


(SCALE BAR IS 4" AT FULL SCALE) 0 1/2 1 2 3 4

PLOTTED: 12/19/2022 5:10:45 PM
 FILE: BIM 360/1409469 - Aerobic Granular Sludge Phase 1/409469 - AGS.rvt
 D11000

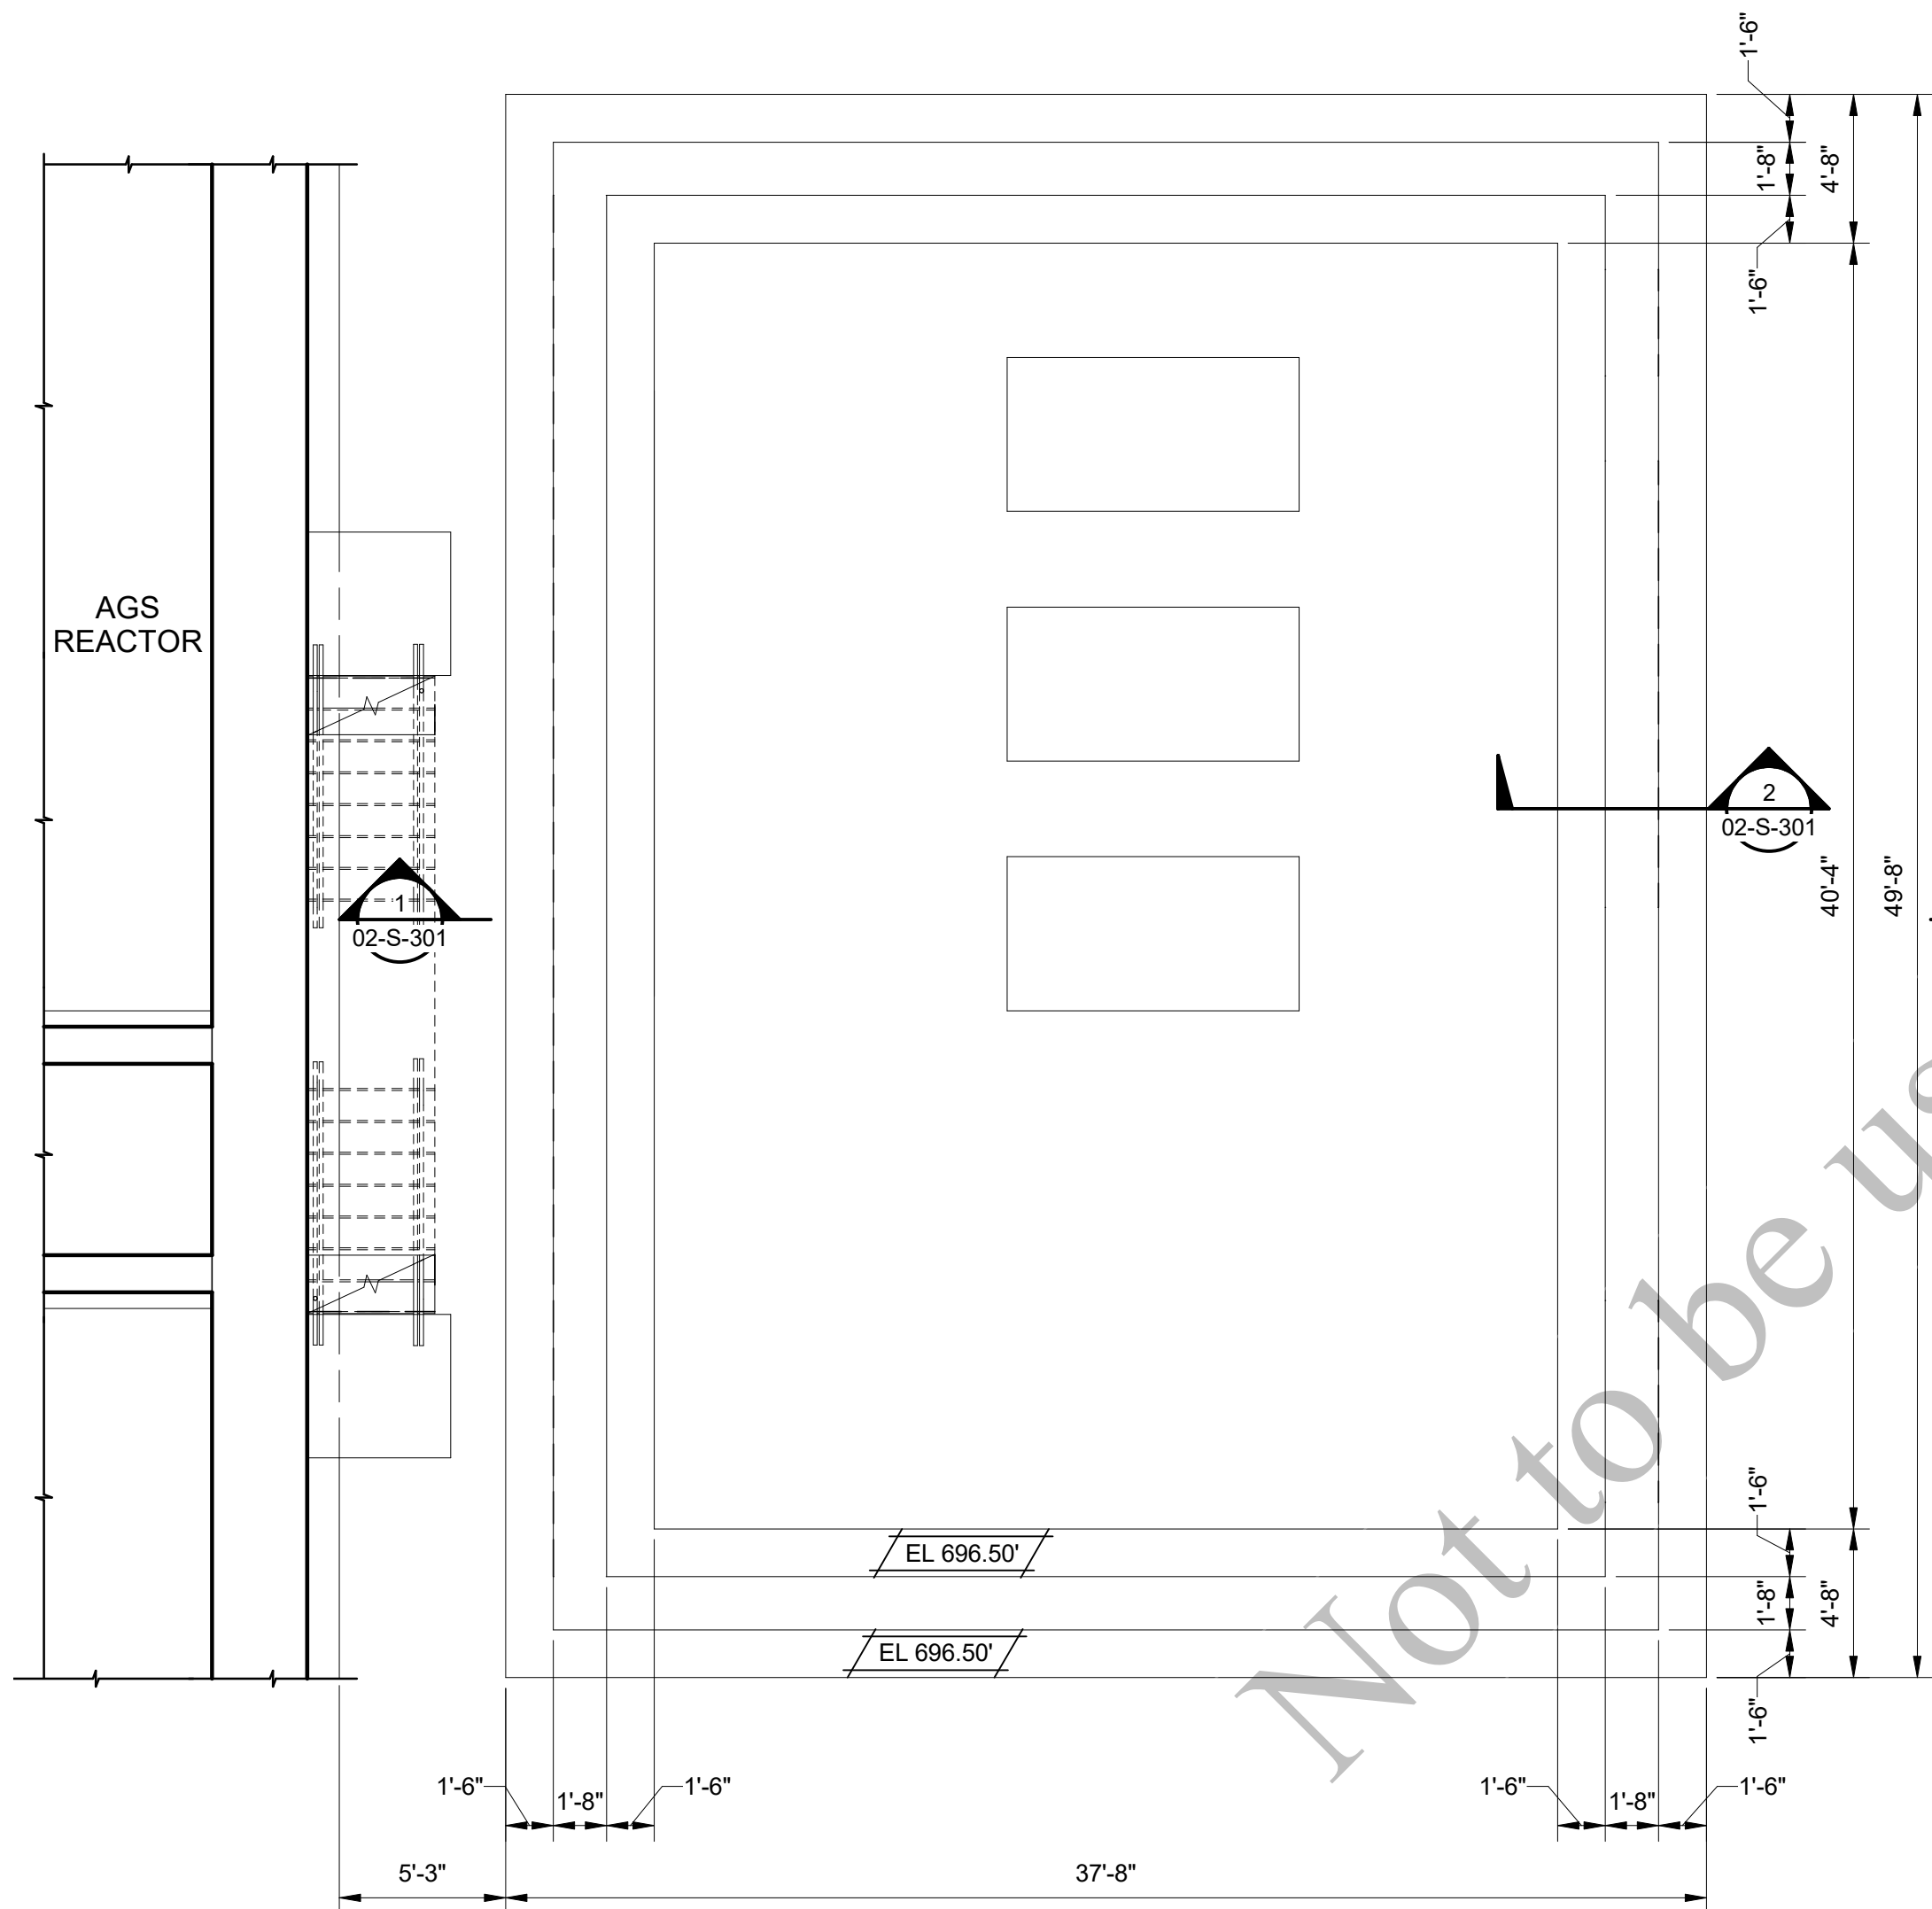

FOUNDATION LEVEL PLAN
 3/16" = 1'-0"

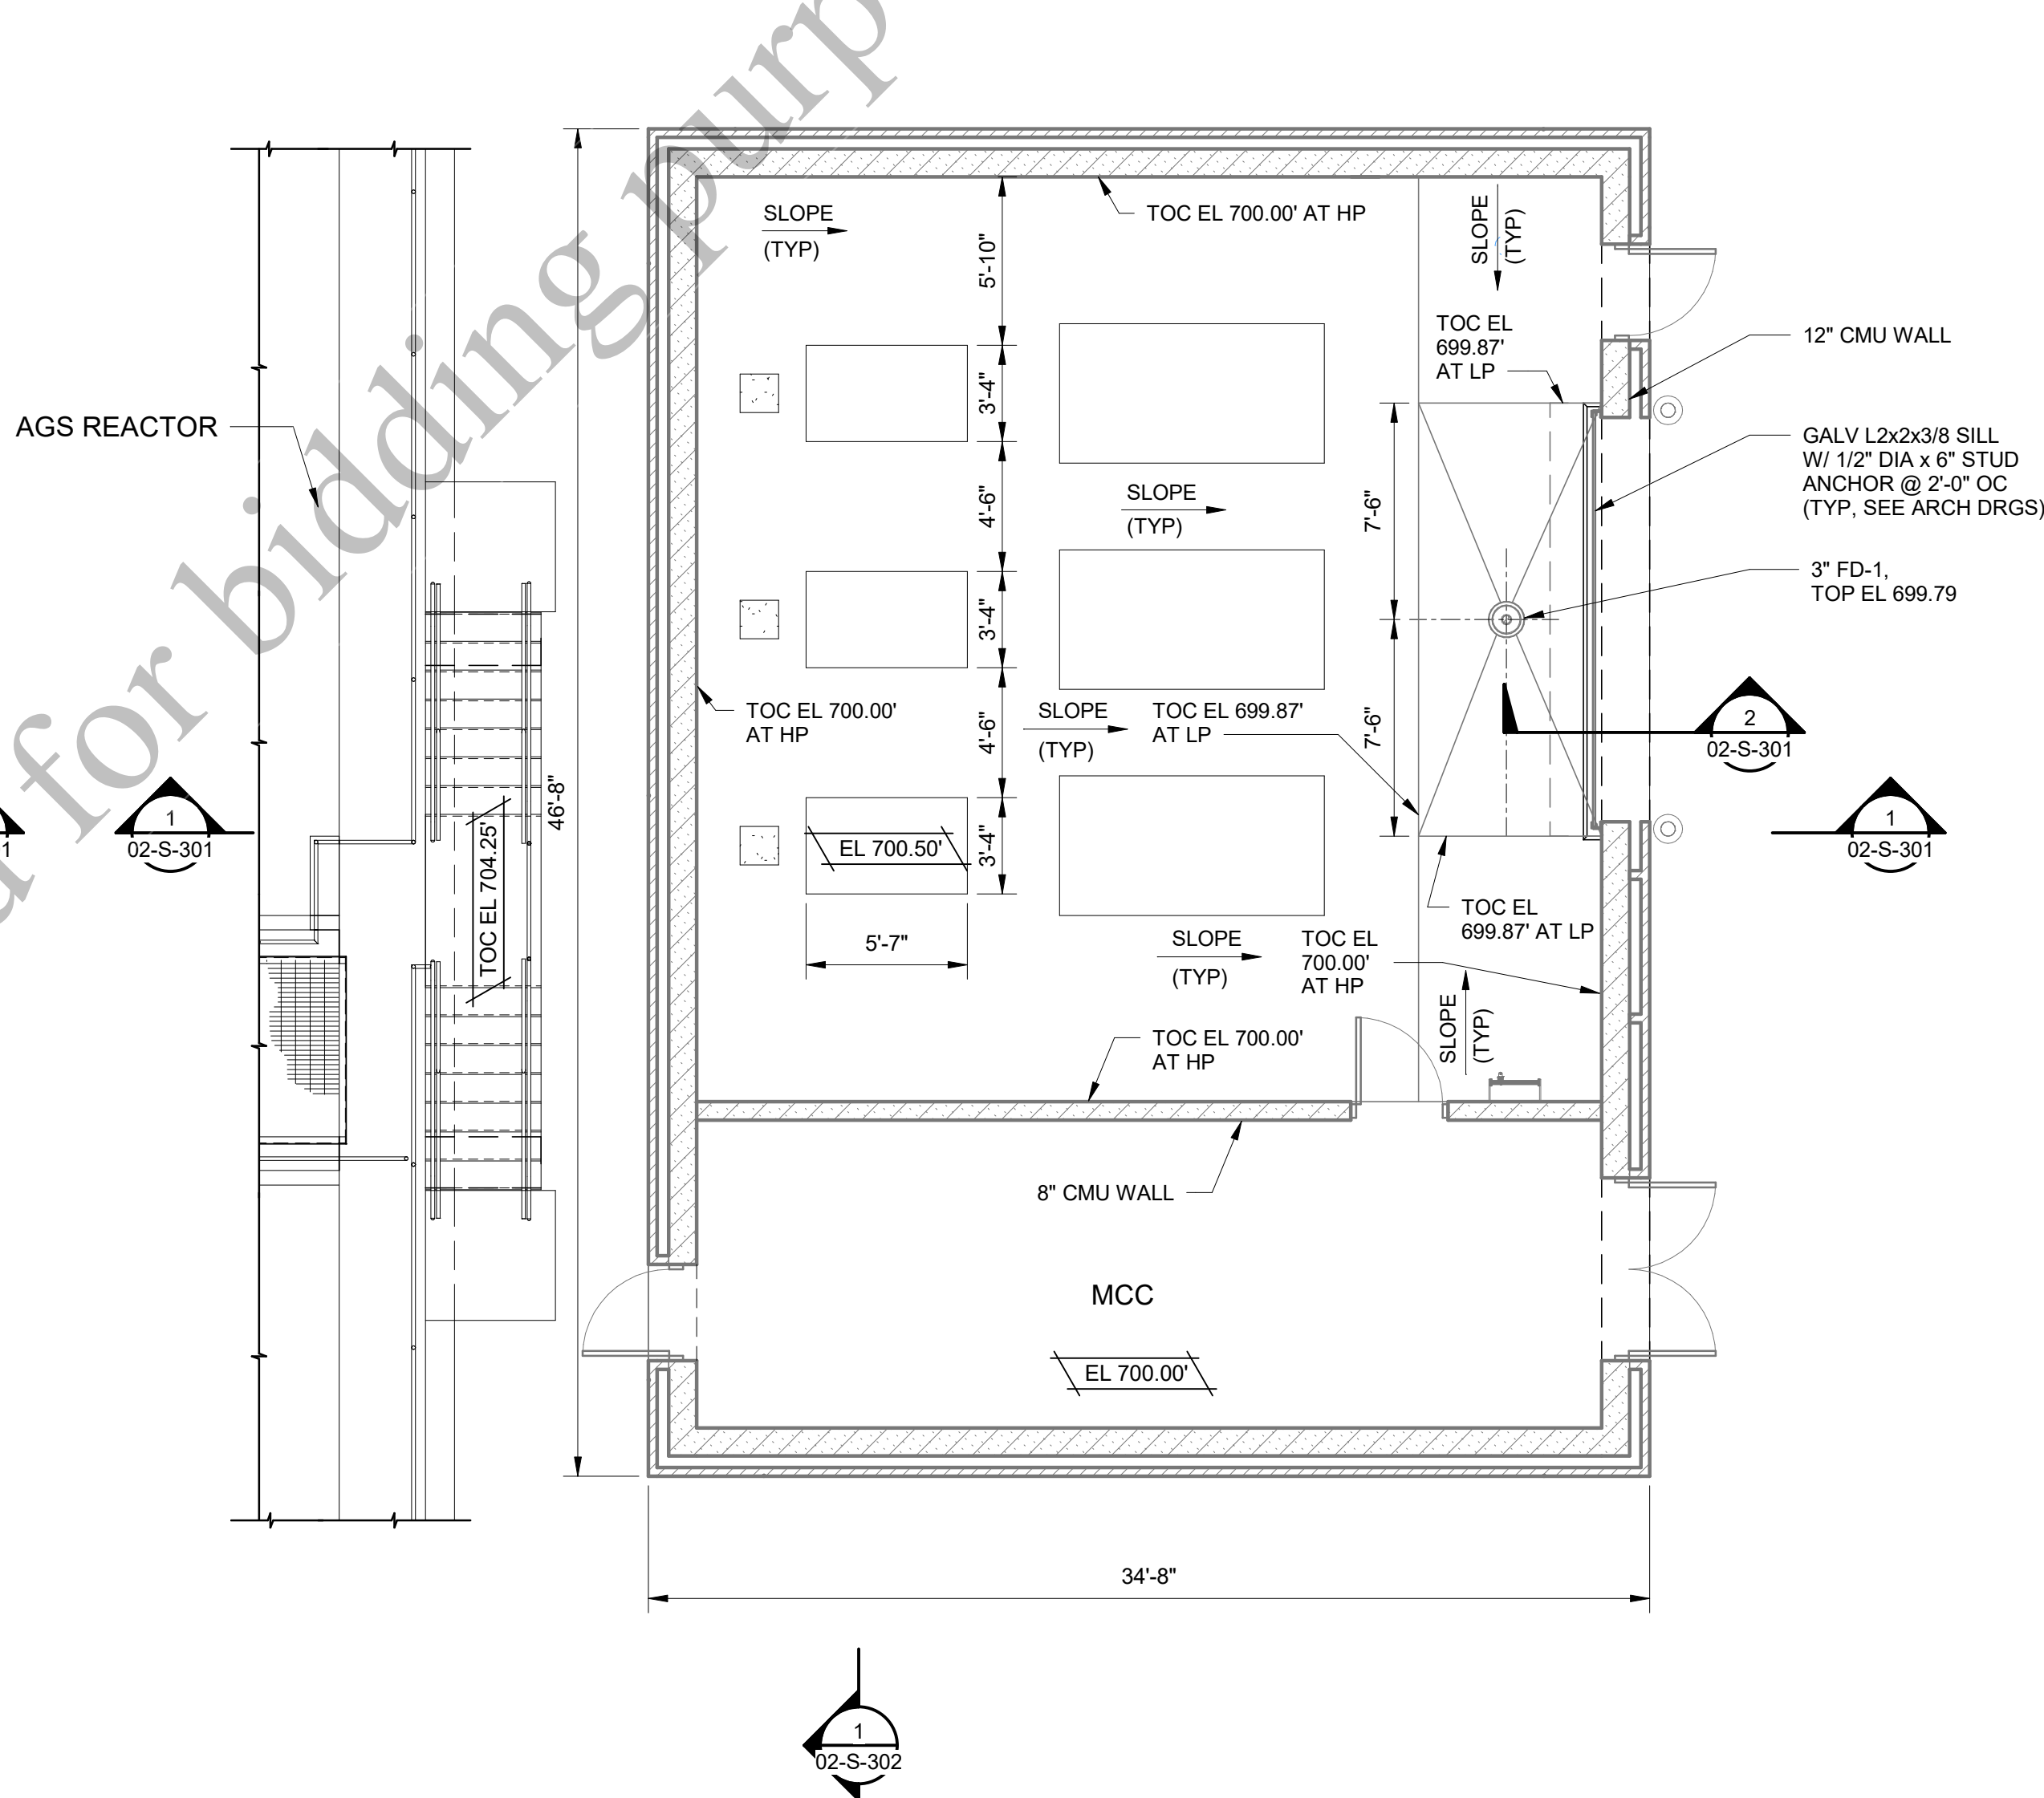

OPERATING FLOOR PLAN
 3/16" = 1'-0"

GENERAL SHEET NOTES:

1. FINAL DIMENSION OF ELECTRICAL AND MECHANICAL EQUIPMENT BASE SHALL BE DETERMINED DURING CONSTRUCTION AFTER RECEIPT OF SUBMITTAL AND COORDINATED BETWEEN MANUFACTURER AND GENERAL CONTRACTOR AFTER COMPLETION OF REVIEW PROCESS. SIZE MAY BE INCREASED IF STRUCTURALLY REQUIRED TO MAINTAIN ADEQUATE CONCRETE EDGE DISTANCE FROM CENTERLINE OF ANCHOR BOLTS TO EDGE OF CONCRETE. ELECTRICAL EQUIPMENT BASES NOT SHOWN, SEE SHEET 99-E-502.
2. CONCRETE PAN METAL STAIR AND GUARDRAIL ARE DELEGATED DESIGN ITEMS UNDER CONTRACTOR SCOPE OF WORK. DELEGATED ENGINEER, WHO UNDERTAKES SPECIALTY DESIGN SERVICE REGARDING A PORTION OF THE ENGINEERING, SHALL CONSIDER GIVEN DESIGN CRITERIA AND COEFFICIENTS PROVIDED ON DRAWING 00-S-001 AND 00-S-002 OF TECHNICAL SPECIFICATIONS AS A MINIMUM DESIGN LOADING CRITERIA.
3. 12" CMU WALL THIS LOCATION IS CONSIDERED AS ORDINARY MASONRY SHEAR WALL AND IT IS PART OF LATERAL FORCE RESISTING SYSTEM OF FACILITY.
4. GRANULAR FILL AS PER SPECIFICATION 31 23 11. SEE SECTION 1 ON SHEET 02-S-301 FOR FILL LIMITS.
5. FOR AGS REACTORS REFER TO SHEETS 01-S-101 TO 01-S-104.
6. FOR STRUCTURAL ABBREVIATIONS, REFER TO SHEET 00-S-002.
7. CONCRETE SHALL BE SLOPED AS SHOWN IN THE PLAN, ELEVATIONS INDICATED ARE NOMINAL AND THICKNESSES SHOWN ARE MINIMUM THICKNESS, CONTRACTOR TO COORDINATE SLOPES, MINIMUM 1/4" PER FOOT.


BLACK & VEATCH
 Black & Veatch Corporation
 Chicago, Illinois
 ILLINOIS PROFESSIONAL
 DESIGN FIRM - 184.002143-0006


Four Rivers
 Sanitation Authority


AEROBIC GRANULAR
 SLUDGE - PHASE 1

REVISIONS AND RECORD OF ISSUE	
DESIGNED:	SKA
DETAILED:	UBS
CHECKED:	CG
APPROVED:	TNG
DATE:	12/20/2022
PROJECT NO.:	411752

AGS SUPPORT FACILITY

STRUCTURAL

FOUNDATION AND
 OPERATING FLOOR PLAN

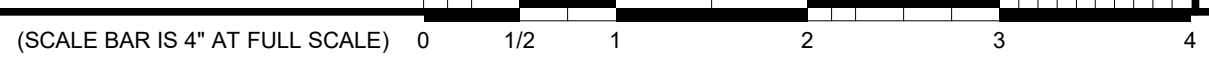



GENERAL SHEET NOTES:

1. FOR GENERAL NOTES, REFER TO SHEET 01-S-101.
2. FOR STRUCTURAL ABBREVIATIONS, REFER TO SHEET 00-S-002.
3. FOR OTHER NOTES, REFER TO SHEET 01-S-103.
4. FOR ROOF SLOPE AND DRAIN LOCATION, SEE MECH AND ARCH DRAWINGS.



Black & Veatch Corporation
Chicago, Illinois
ILLINOIS PROFESSIONAL
DESIGN FIRM - 184.002143-0006



AEROBIC GRANULAR
SLUDGE - PHASE 1

REVISIONS AND RECORD OF ISSUE	
DESIGNED:	SKA
DETAILED:	UBS
CHECKED:	CG
APPROVED:	TNG
DATE:	12/20/2022
PROJECT NO.:	411752


AGS SUPPORT FACILITY

STRUCTURAL


ROOF PLAN

02-S-102

95
OF
163

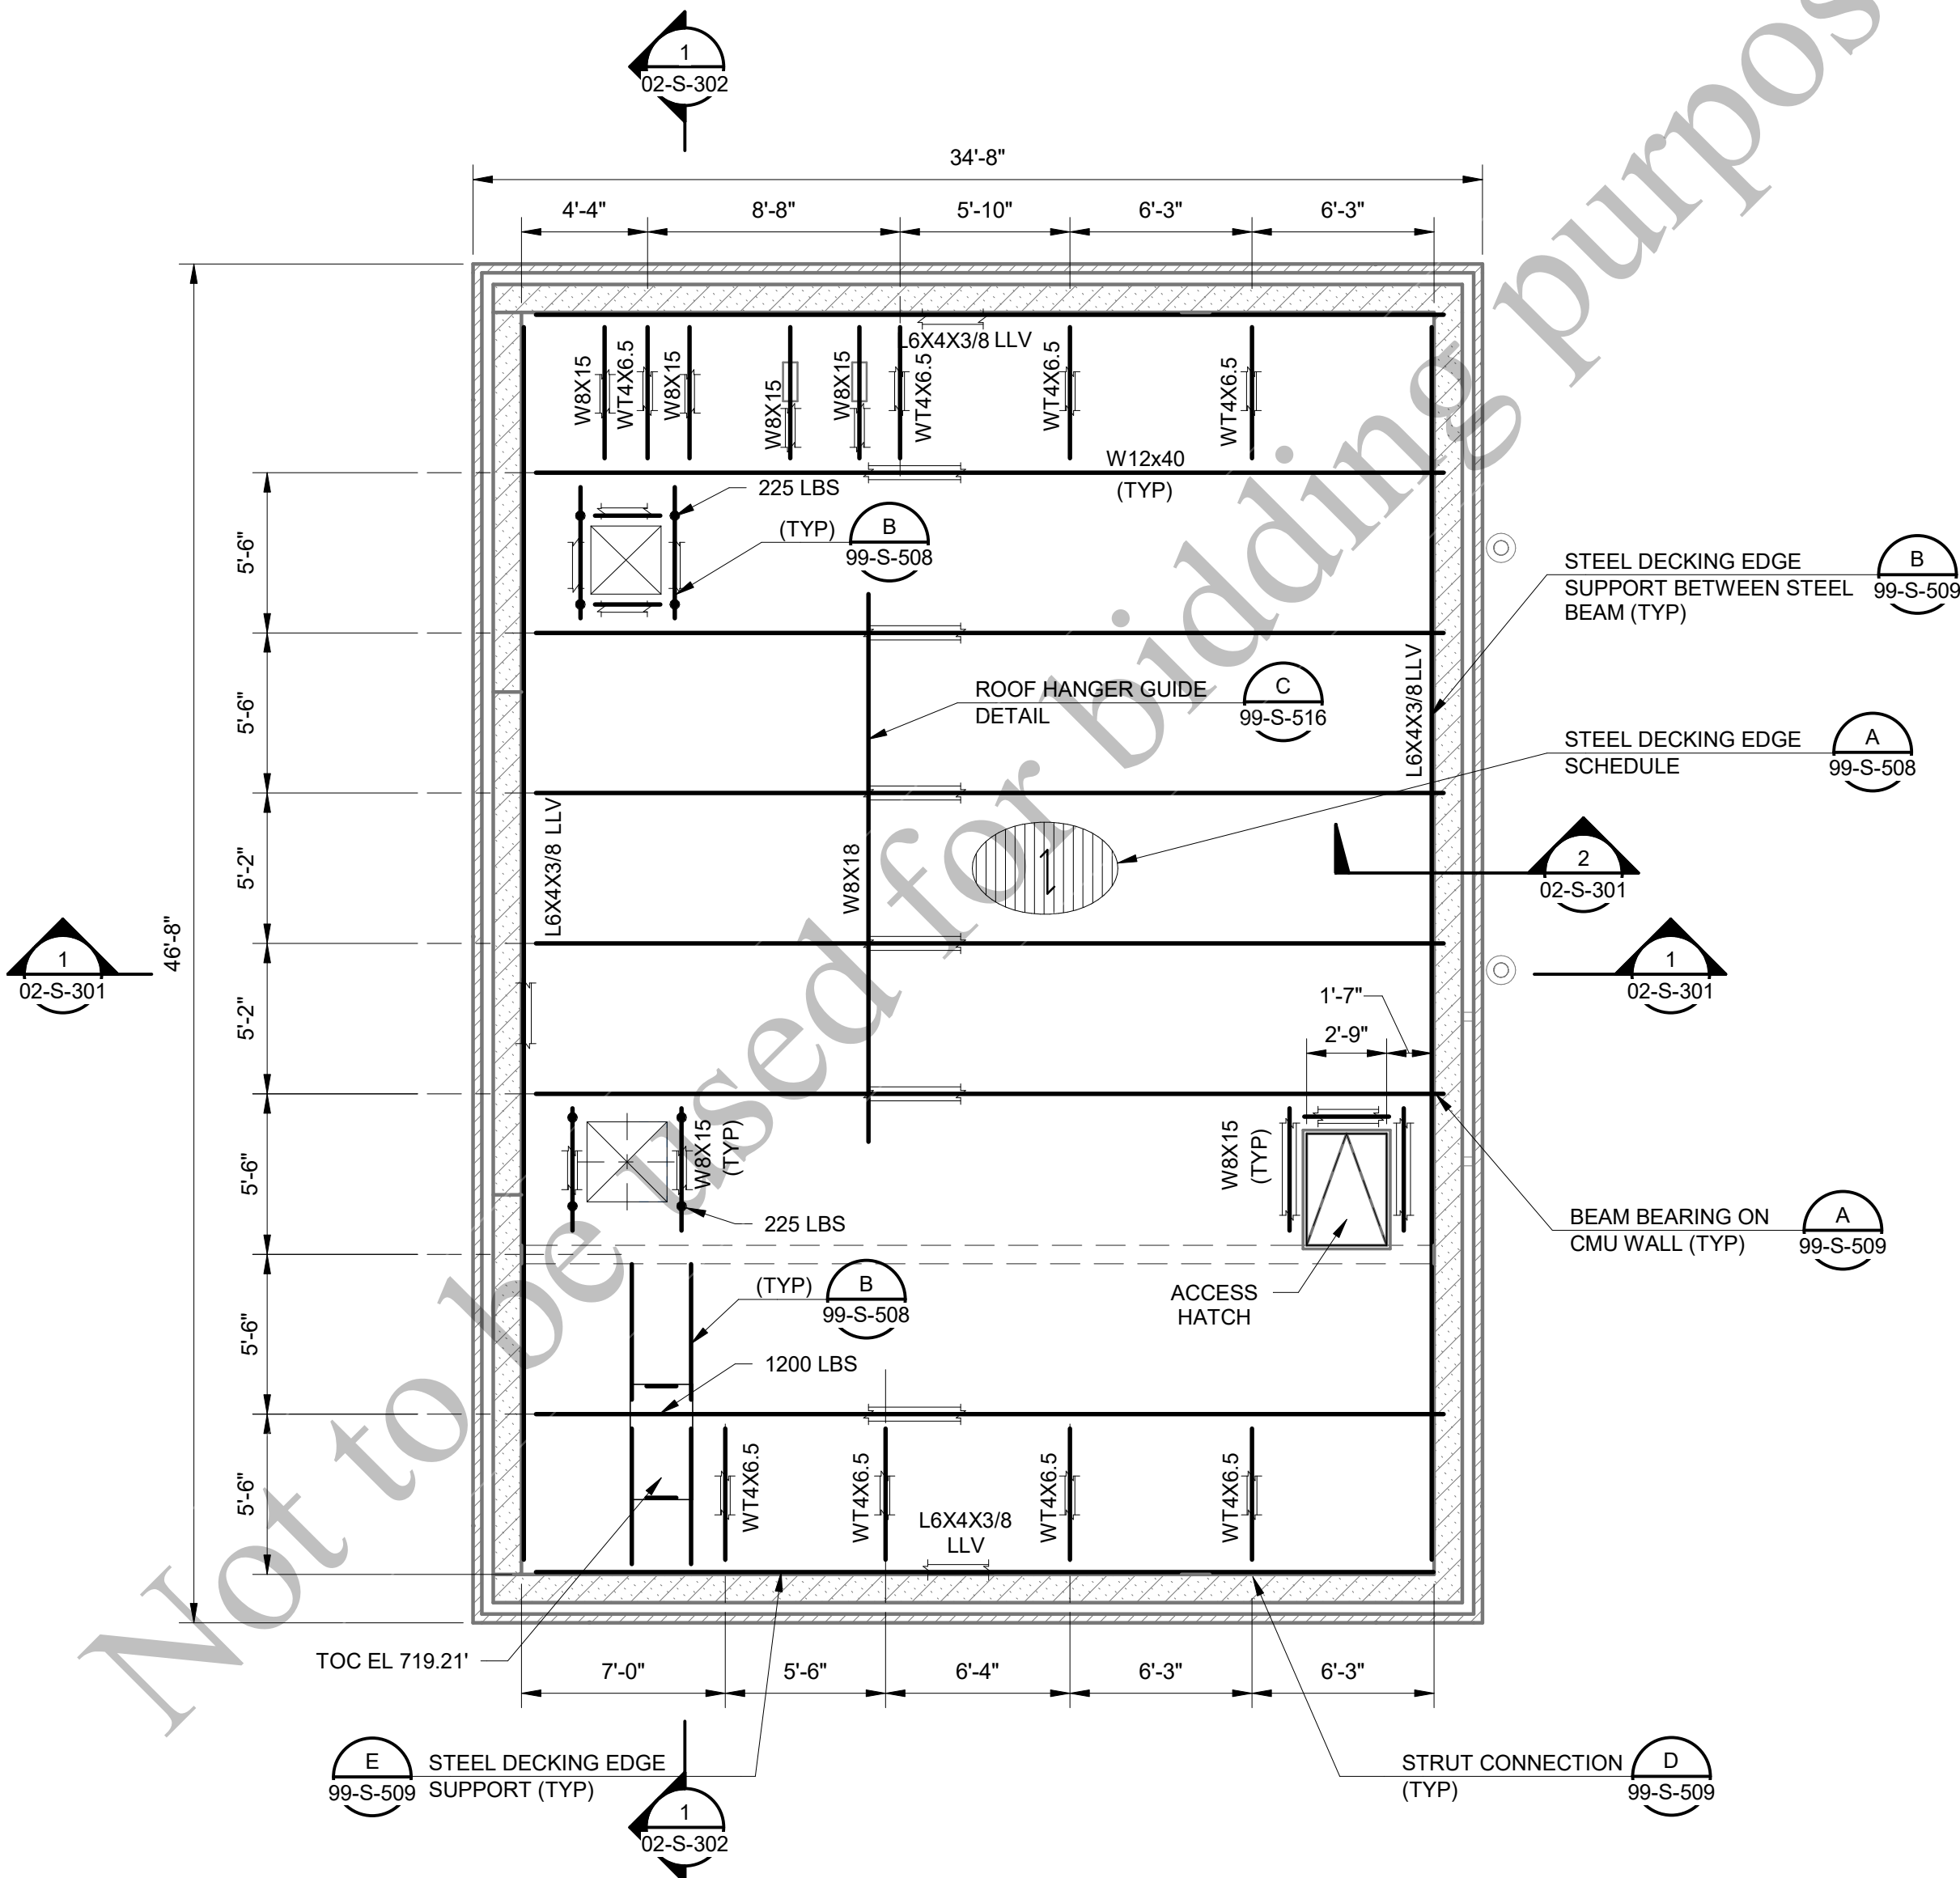


ROOF PLAN
3/16" = 1'-0"

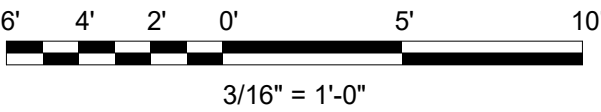


(SCALE BAR IS 4" AT FULL SCALE)

PLOTTED: 12/19/2022 4:26:13 PM
FILE: BIM 360/1409469 - Aerobic Granular Sludge Phase 1/409469 - AGS.rvt
D11000

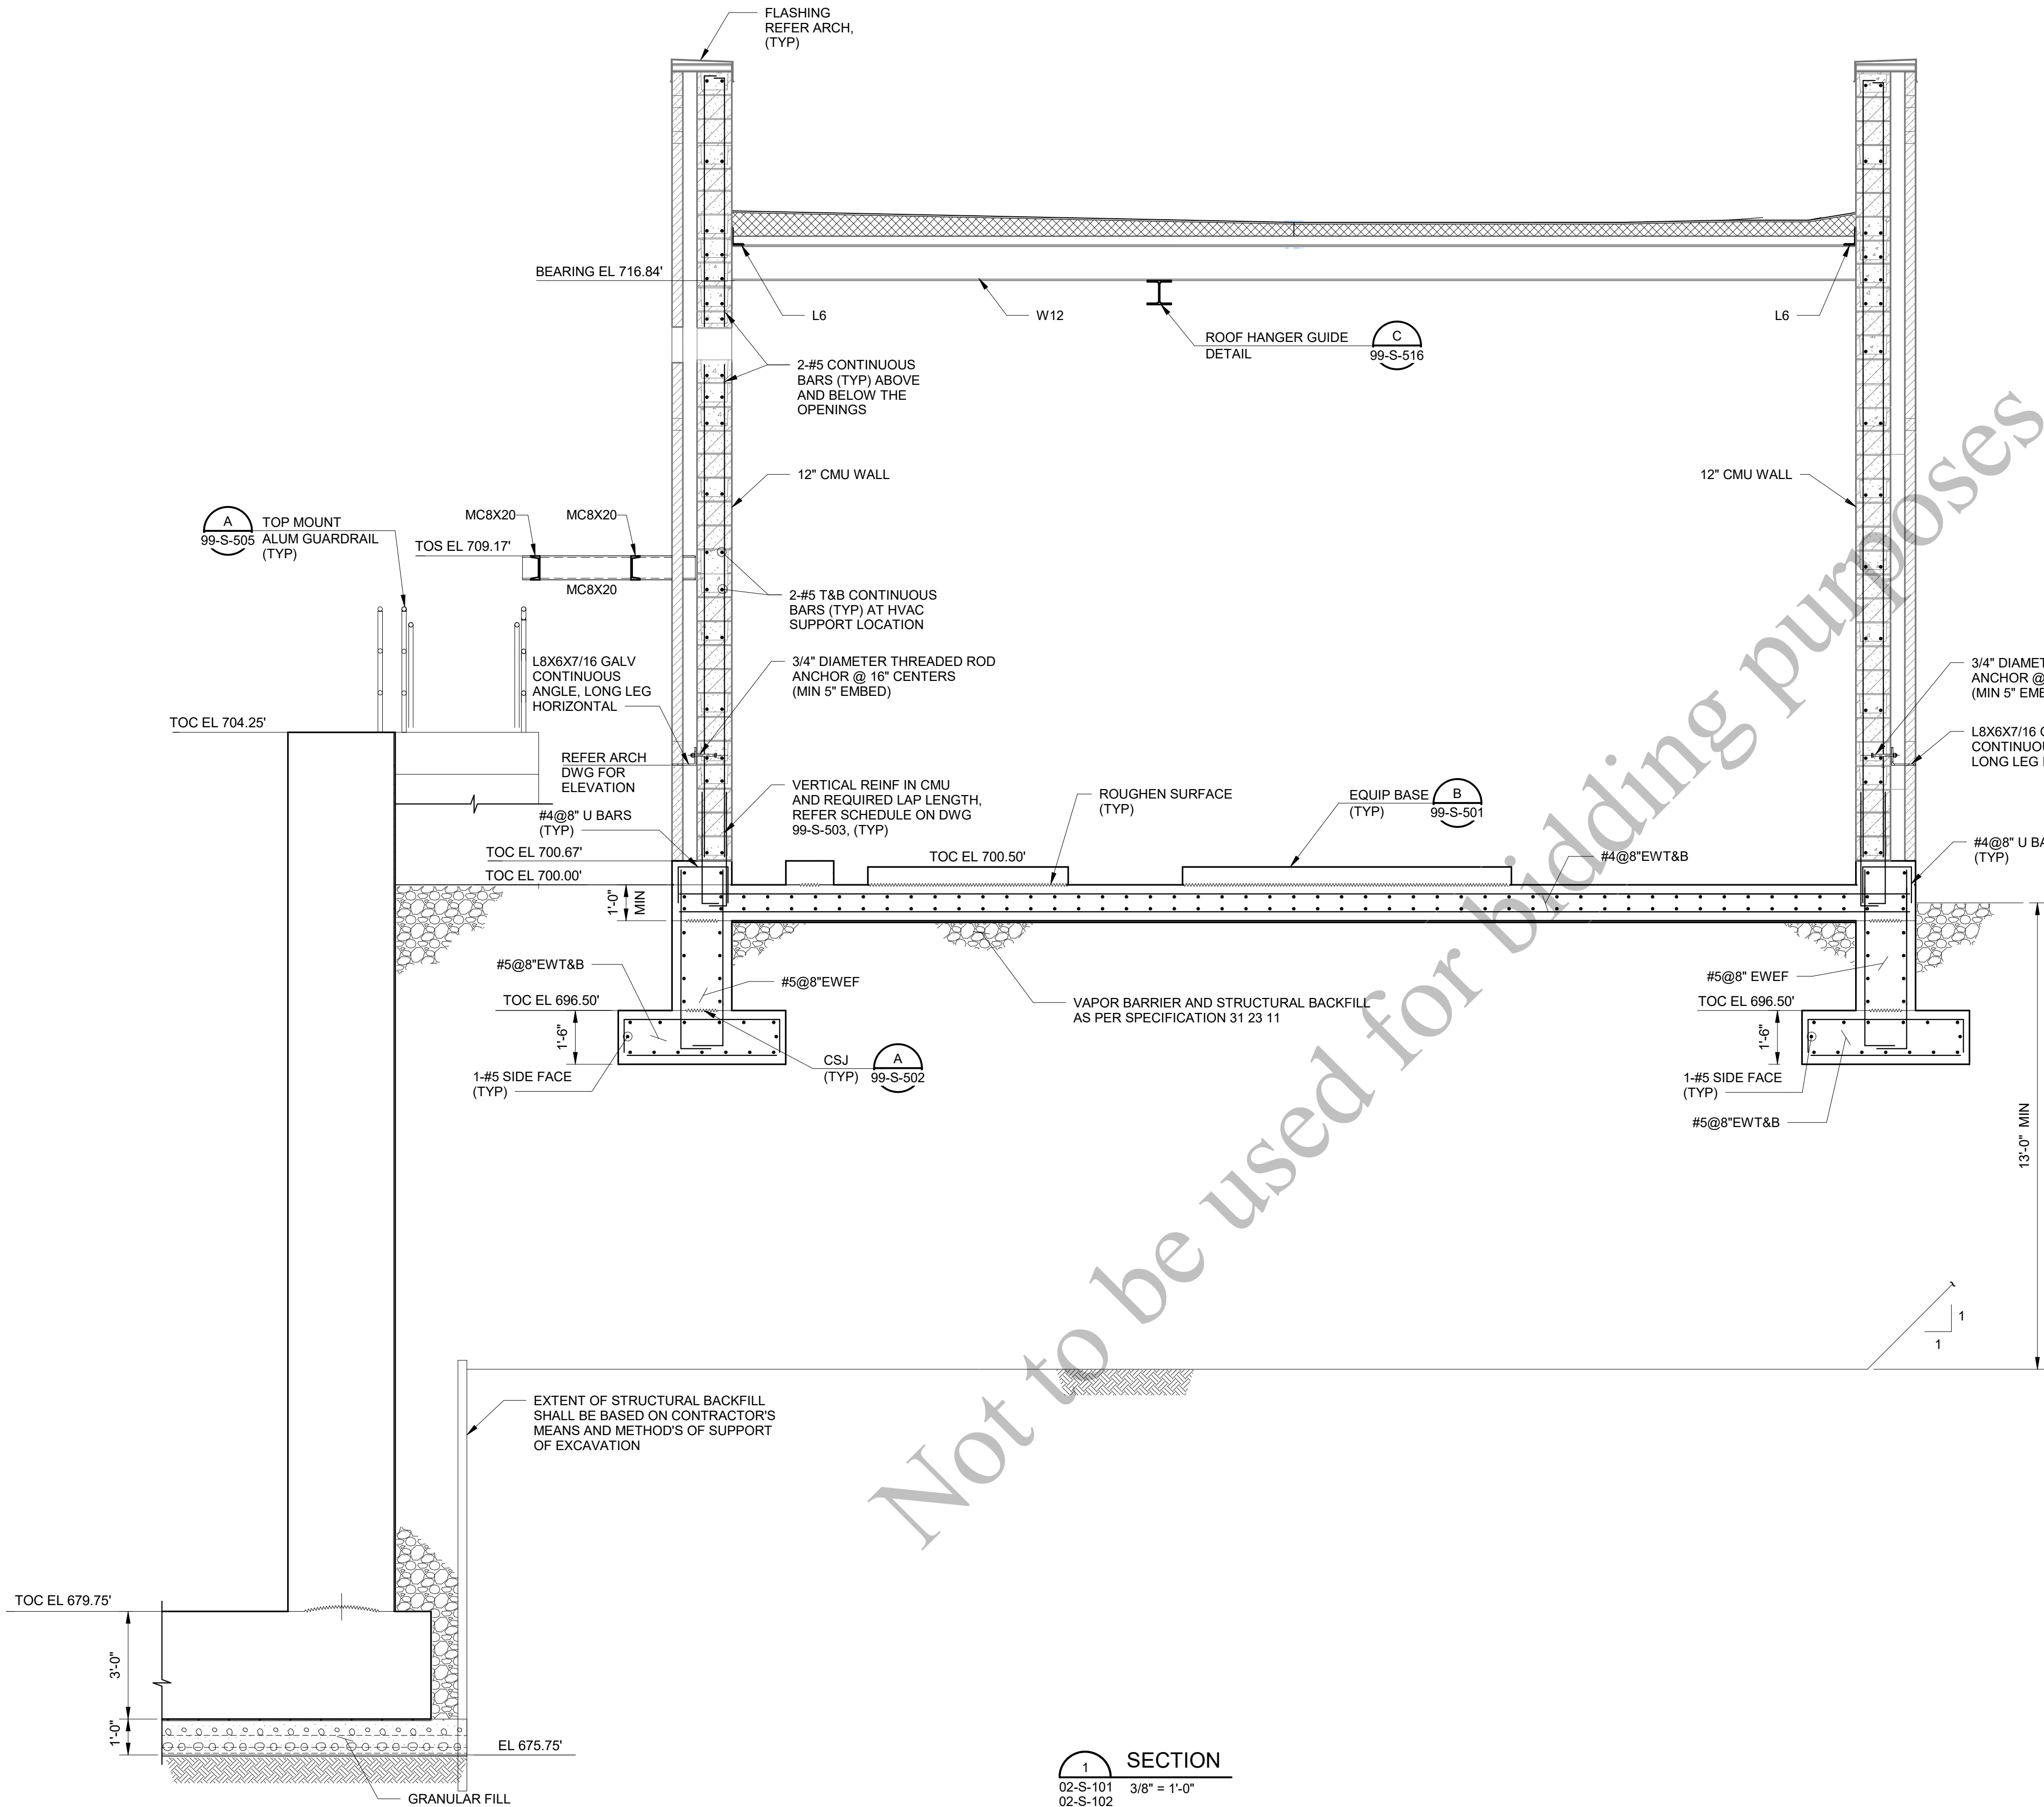


GENERAL SHEET NOTES:

1. FINISHED GRADE ELEVATION SHOWN IS APPROXIMATE. SEE CIVIL SITE PLAN FOR REQUIRED GRADE ELEVATION OF THIS LOCATION.
2. FOR AGS REACTORS, REFER TO SHEET 01-S-101 TO 01-S-104.
3. FOR GENERAL STRUCTURAL NOTES, REFER TO SHEET 00-S-001.
4. FOR STRUCTURAL ABBREVIATIONS, REFER TO SHEET 00-S-002.
5. FOR OTHER NOTES, REFER TO SHEET 01-S-103.

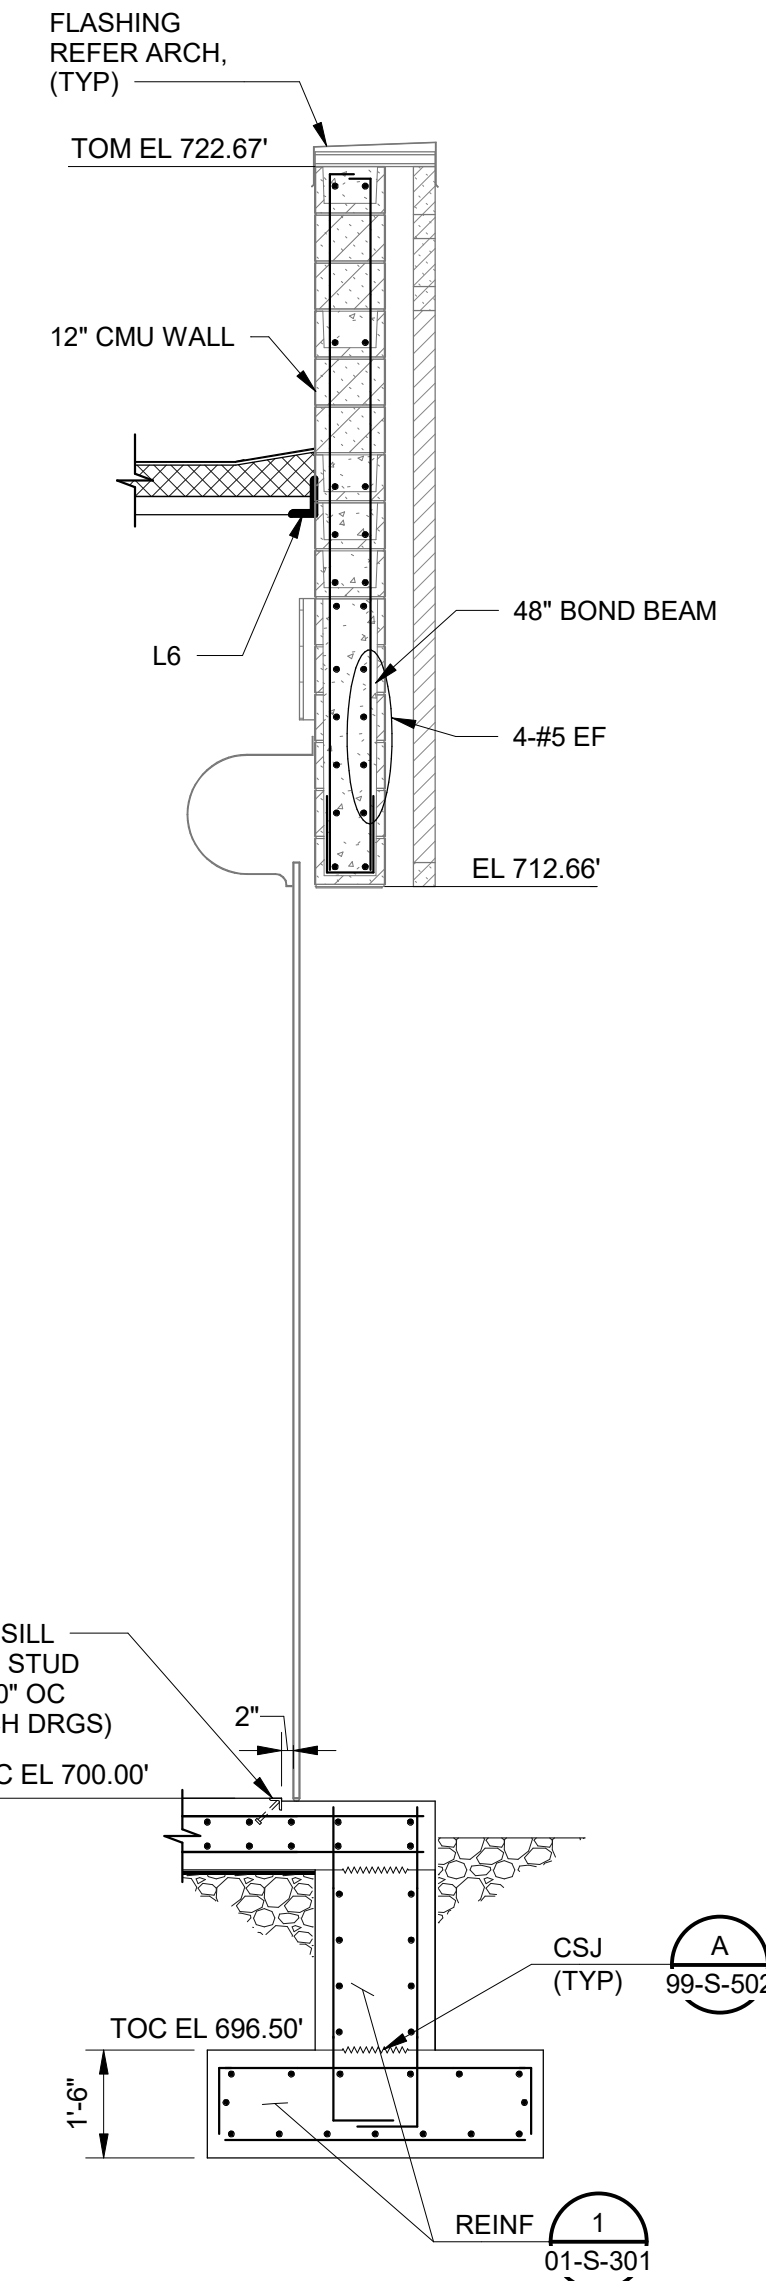

SECTION
02-S-101 3/8" = 1'-0"
02-S-102

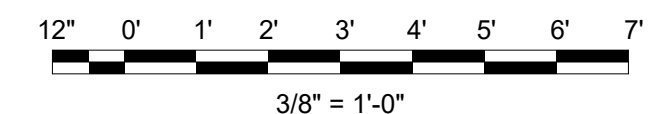

(SCALE BAR IS 4" AT FULL SCALE) 0 1/2 1 2 3 4



Black & Veatch Corporation
Chicago, Illinois
ILLINOIS PROFESSIONAL
DESIGN FIRM - 184.002143-0006



**AEROBIC GRANULAR
SLUDGE - PHASE 1**

REVISIONS AND RECORD OF ISSUE	
DESIGNED:	SKA
DETAILED:	UBS
CHECKED:	CG
APPROVED:	TNG
DATE:	12/20/2022
PROJECT NO.:	411752

AGS SUPPORT FACILITY


STRUCTURAL

**SECTIONS AND DETAILS
1 OF 2**

02-S-301

96
OF
163

PLOTTED: 12/19/2022 5:10:45 PM
FILE: BIM 360/1409469 - Aerobic Granular Sludge Phase 1/409469 - AGS.rvt
D11000

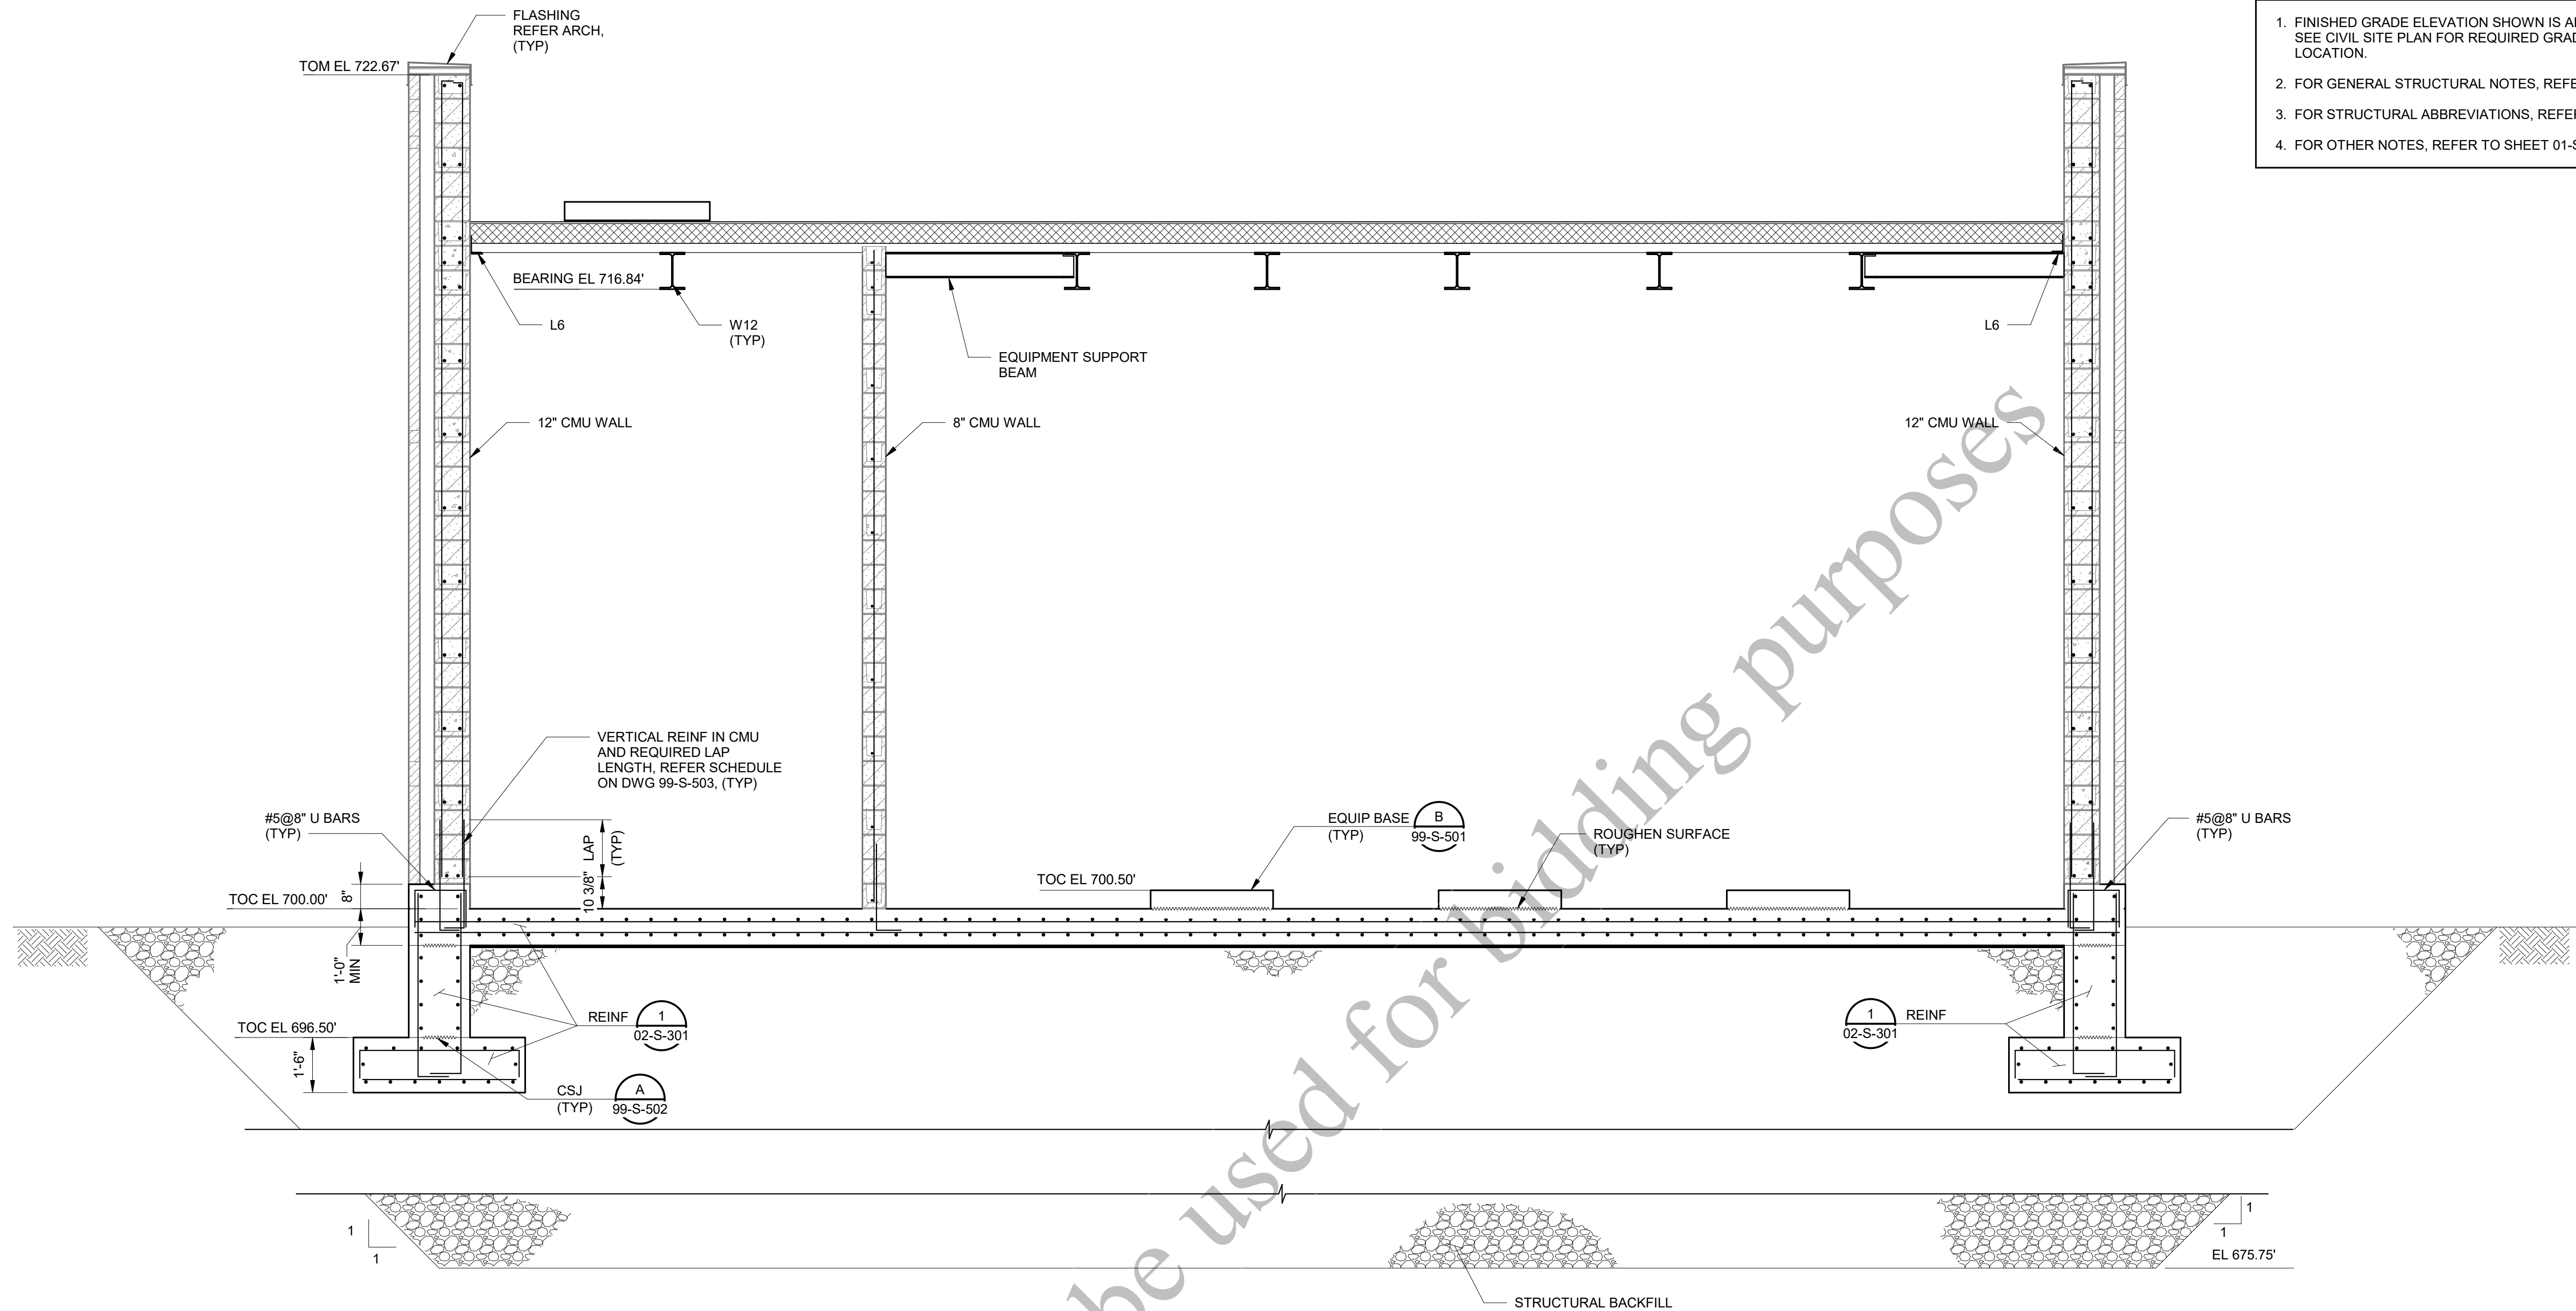

SECTION
02-S-101
02-S-102
3/8\" = 1'-0"

GENERAL SHEET NOTES:

1. FINISHED GRADE ELEVATION SHOWN IS APPROXIMATE. SEE CIVIL SITE PLAN FOR REQUIRED GRADE ELEVATION OF THIS LOCATION.
2. FOR GENERAL STRUCTURAL NOTES, REFER TO SHEET 00-S-001.
3. FOR STRUCTURAL ABBREVIATIONS, REFER TO SHEET 00-S-002.
4. FOR OTHER NOTES, REFER TO SHEET 01-S-103.



Black & Veatch Corporation
Chicago, Illinois
ILLINOIS PROFESSIONAL
DESIGN FIRM - 184.002143-0006



AEROBIC GRANULAR
SLUDGE - PHASE 1

REVISIONS AND RECORD OF ISSUE	
DESIGNED:	SKA
DETAILED:	UBS
CHECKED:	CG
APPROVED:	TNG
DATE:	12/20/2022
PROJECT NO.:	411752


AGS SUPPORT FACILITY

STRUCTURAL

SECTIONS AND DETAILS
2 OF 2

02-S-302


97
OF
163

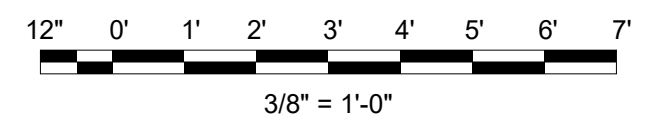

(SCALE BAR IS 4\" AT FULL SCALE) 0 1/2 1 2 3 4



02-M-101

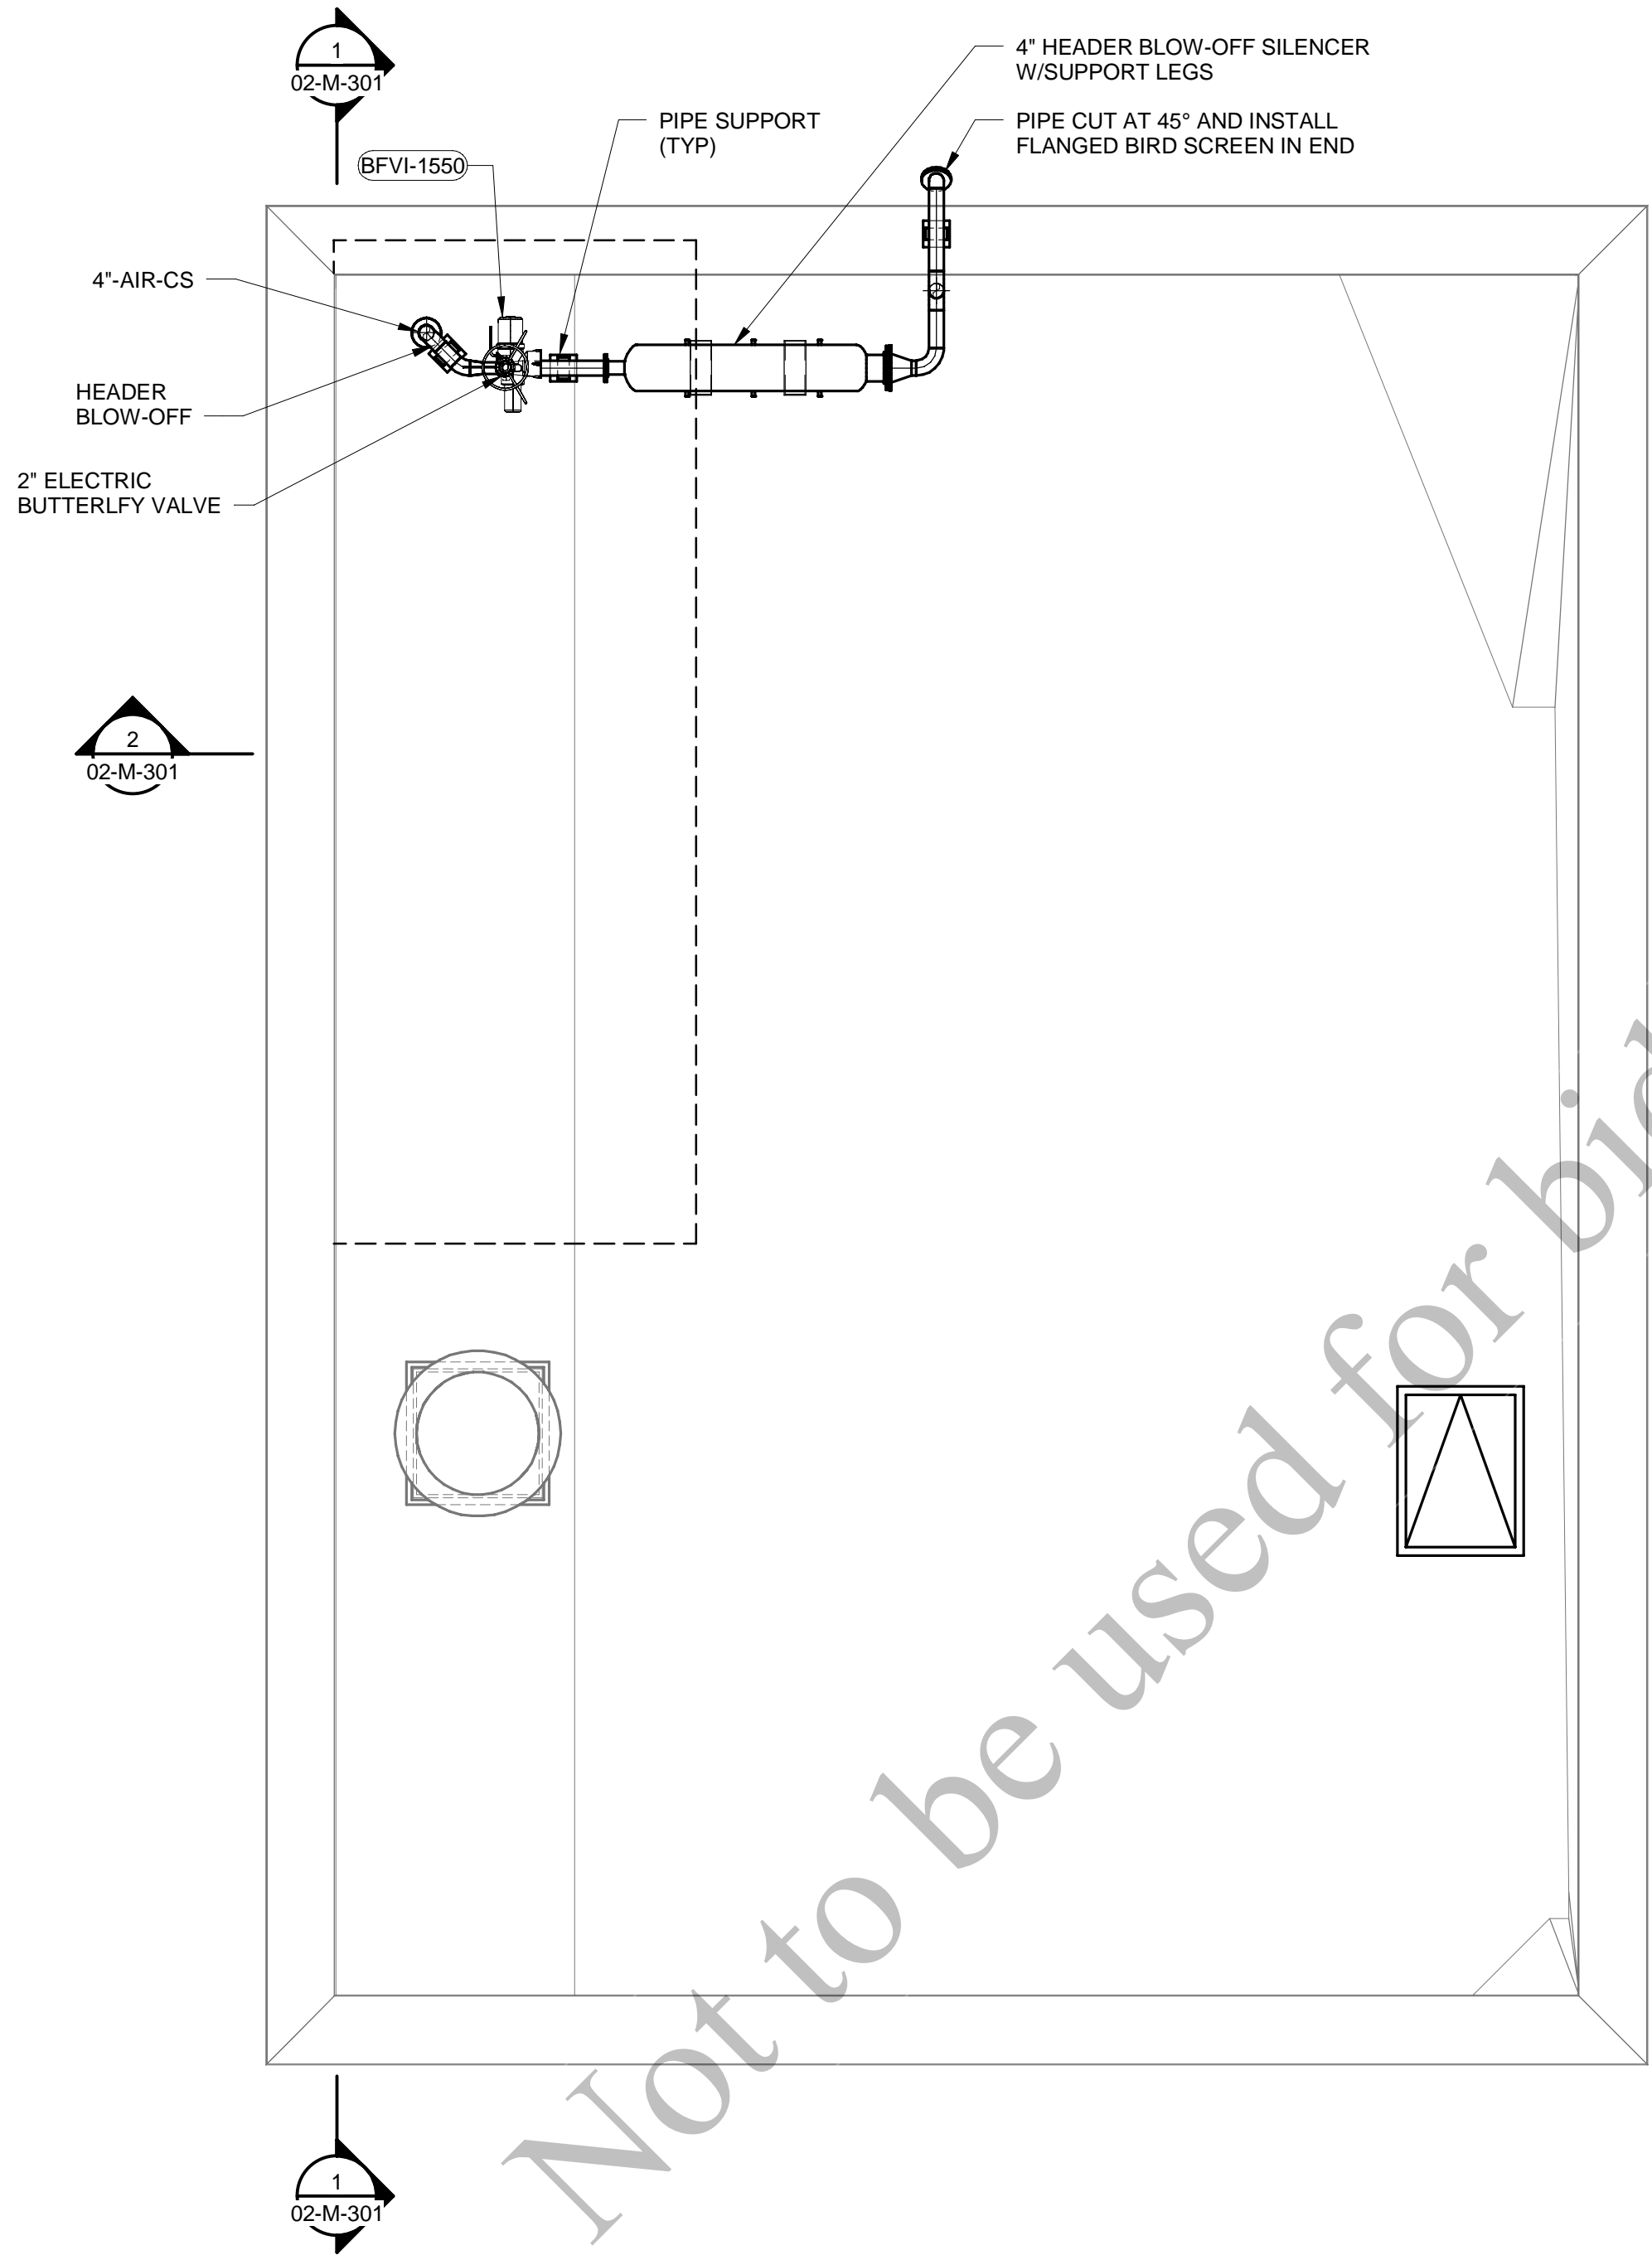

ROOF PLAN
1/4" = 1'-0"

GENERAL SHEET NOTES

1. PS-X REPRESENTS PIPE SUPPORT TYPE. SEE PIPE SUPPORT SCHEDULE ON SHEET 99-M-502.
- AIR PIPING SUPPORT TYPES ARE IDENTIFIED USING THE FOLLOWING DESIGNATIONS:
- (G) : GUIDE SUPPORT
(A) : AXIAL STOP
(V) : VERTICAL SUPPORT
(SPR) : SPRING HANGER SUPPORT
2. ALL BLOWER INLET, BLOW-OFF AND DISCHARGE PIPING SHALL BE INSULATED AND JACKETED. REFER TO SECTION 40 42 11 - MECHANICAL INSULATION FOR REQUIREMENTS.



Black & Veatch Corporation
Chicago, Illinois
ILLINOIS PROFESSIONAL
DESIGN FIRM - 184.002143-0006



AEROBIC GRANULAR
SLUDGE - PHASE 1

1	Date 1	Description1

REVISIONS AND RECORD OF ISSUE	
DESIGNED:	JL
DETAILED:	RMR
CHECKED:	AM/JH
APPROVED:	MR
DATE:	12/20/2022
PROJECT NO.:	411752


AGS SUPPORT FACILITIES

PROCESS MECHANICAL

BLOWERS
ROOF PLAN



02-M-102

99
OF
163

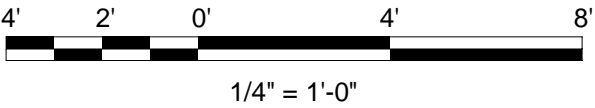

(SCALE BAR IS 4" AT FULL SCALE)

PLOTTED: 12/18/2022 11:55:47 AM
 FILE: BIM 360/409469 - Aerobic Granular Sludge Phase 1/409469 - AGS.rvt
 D11000

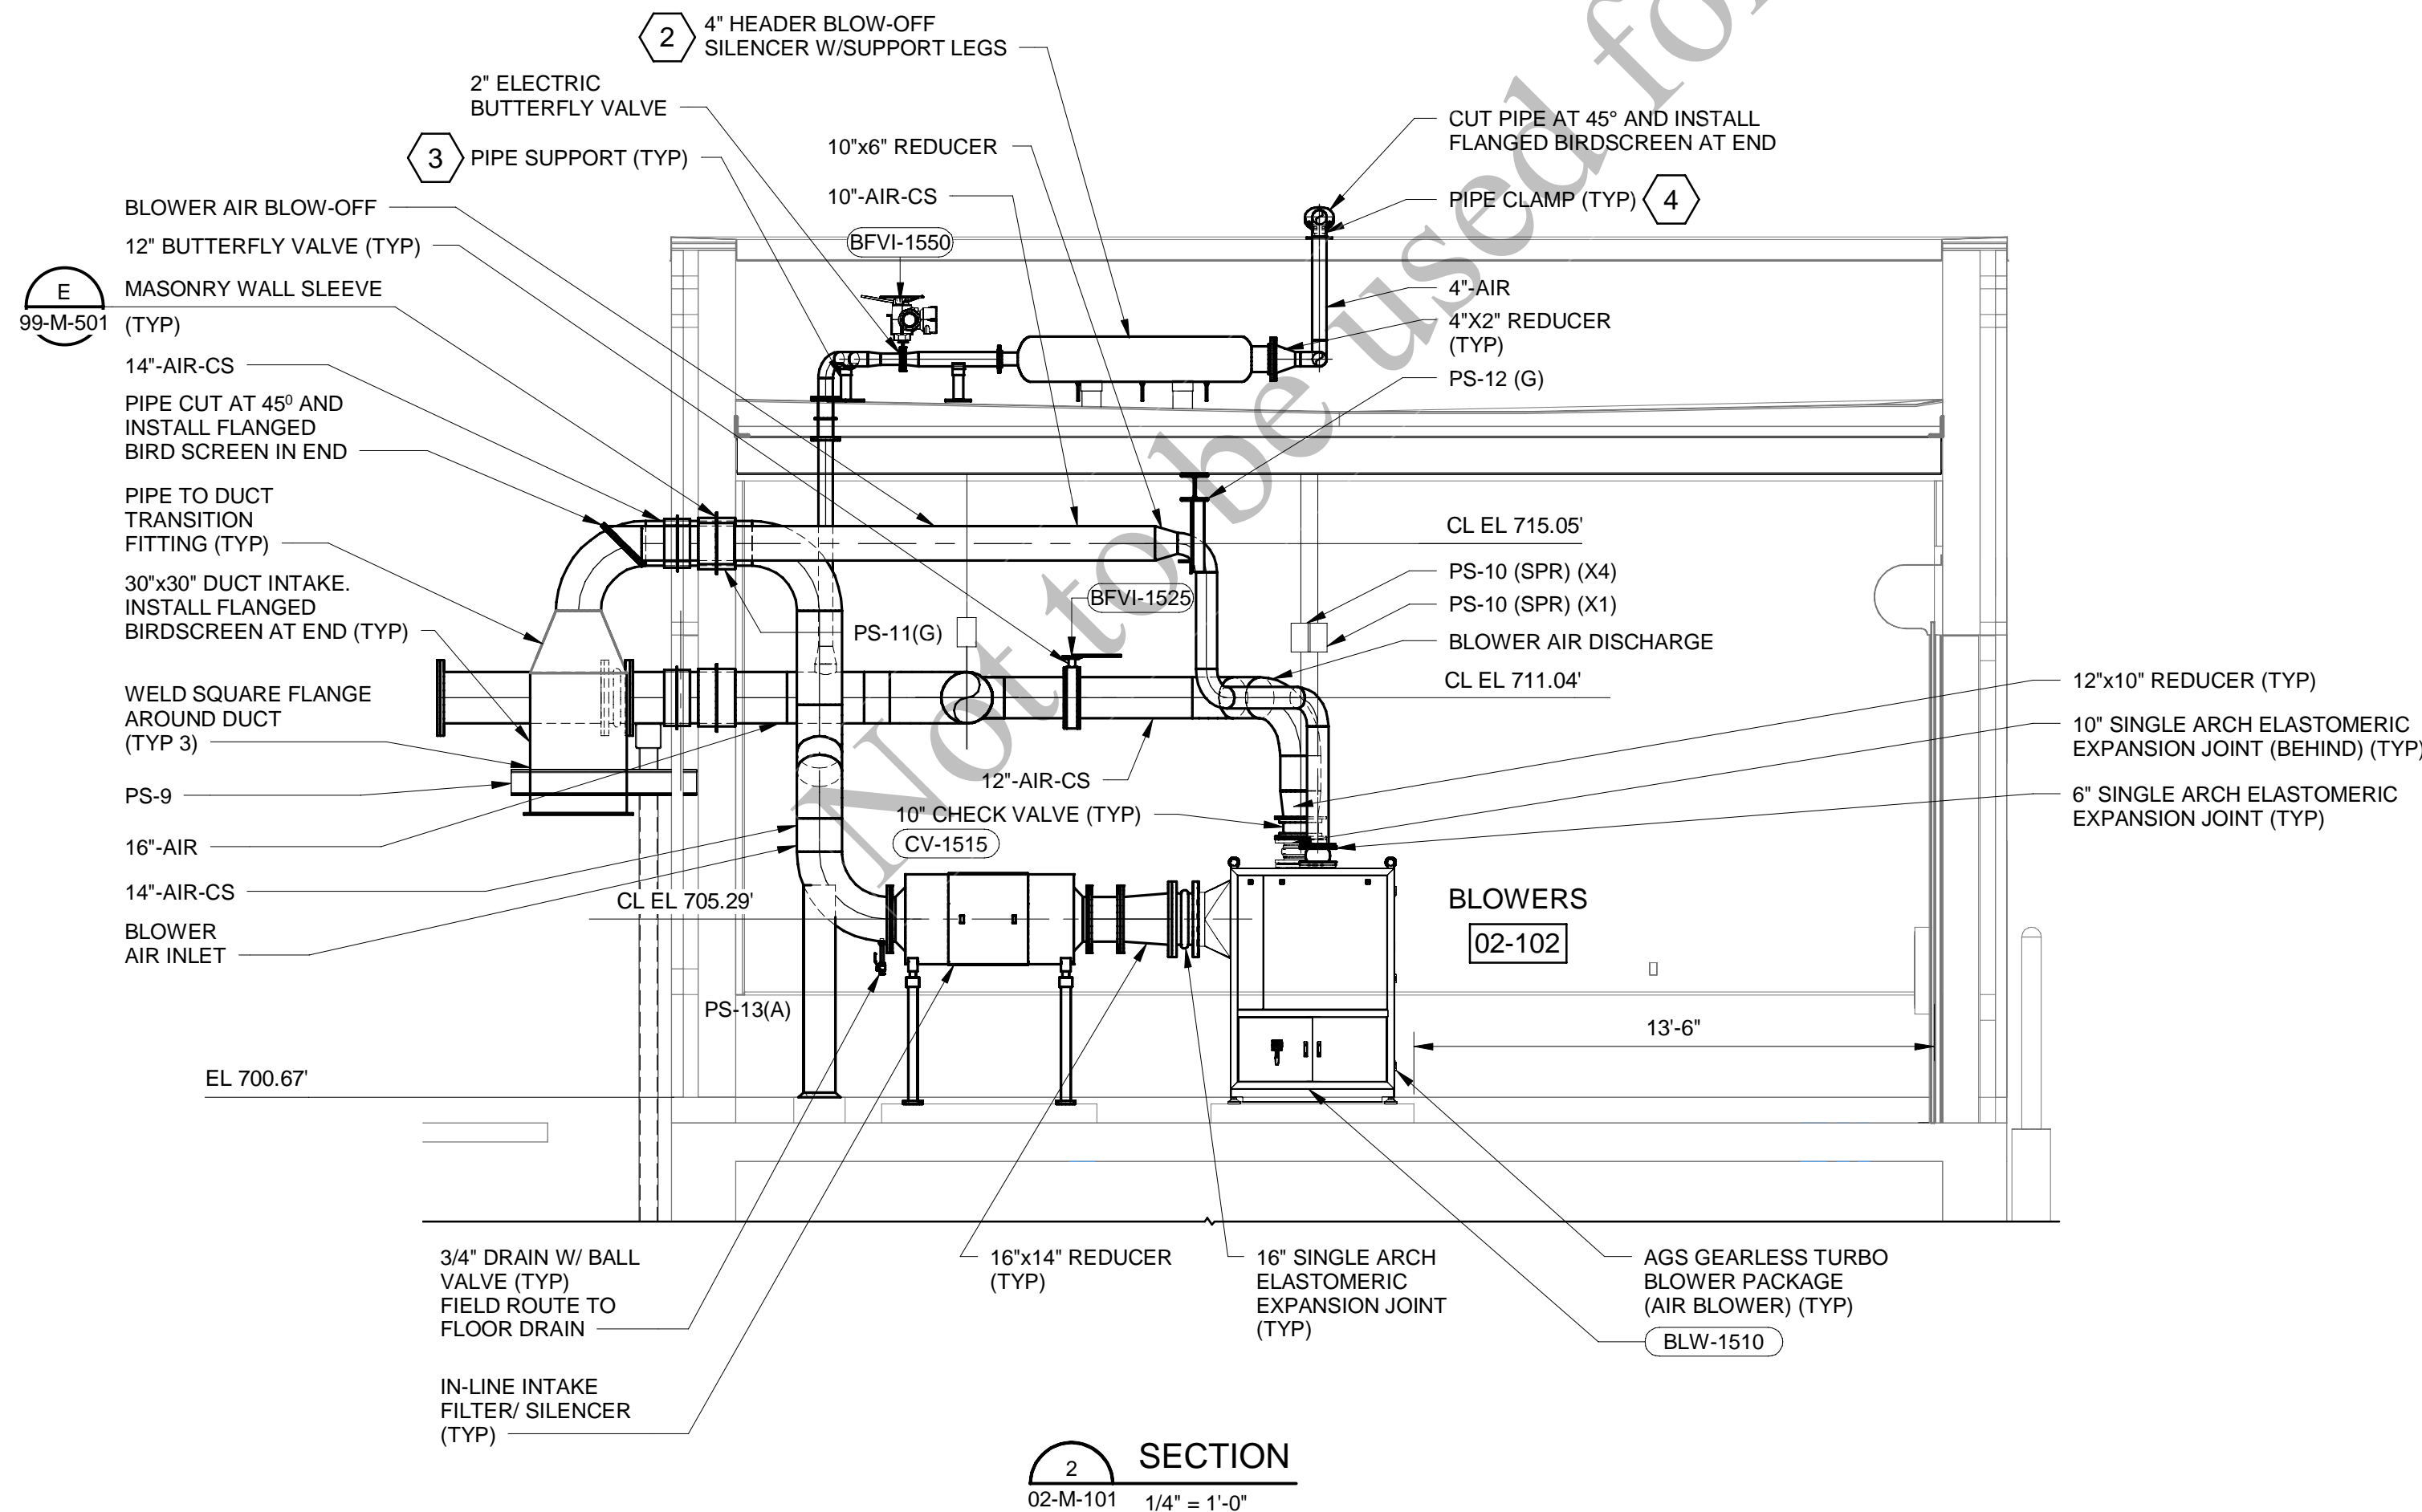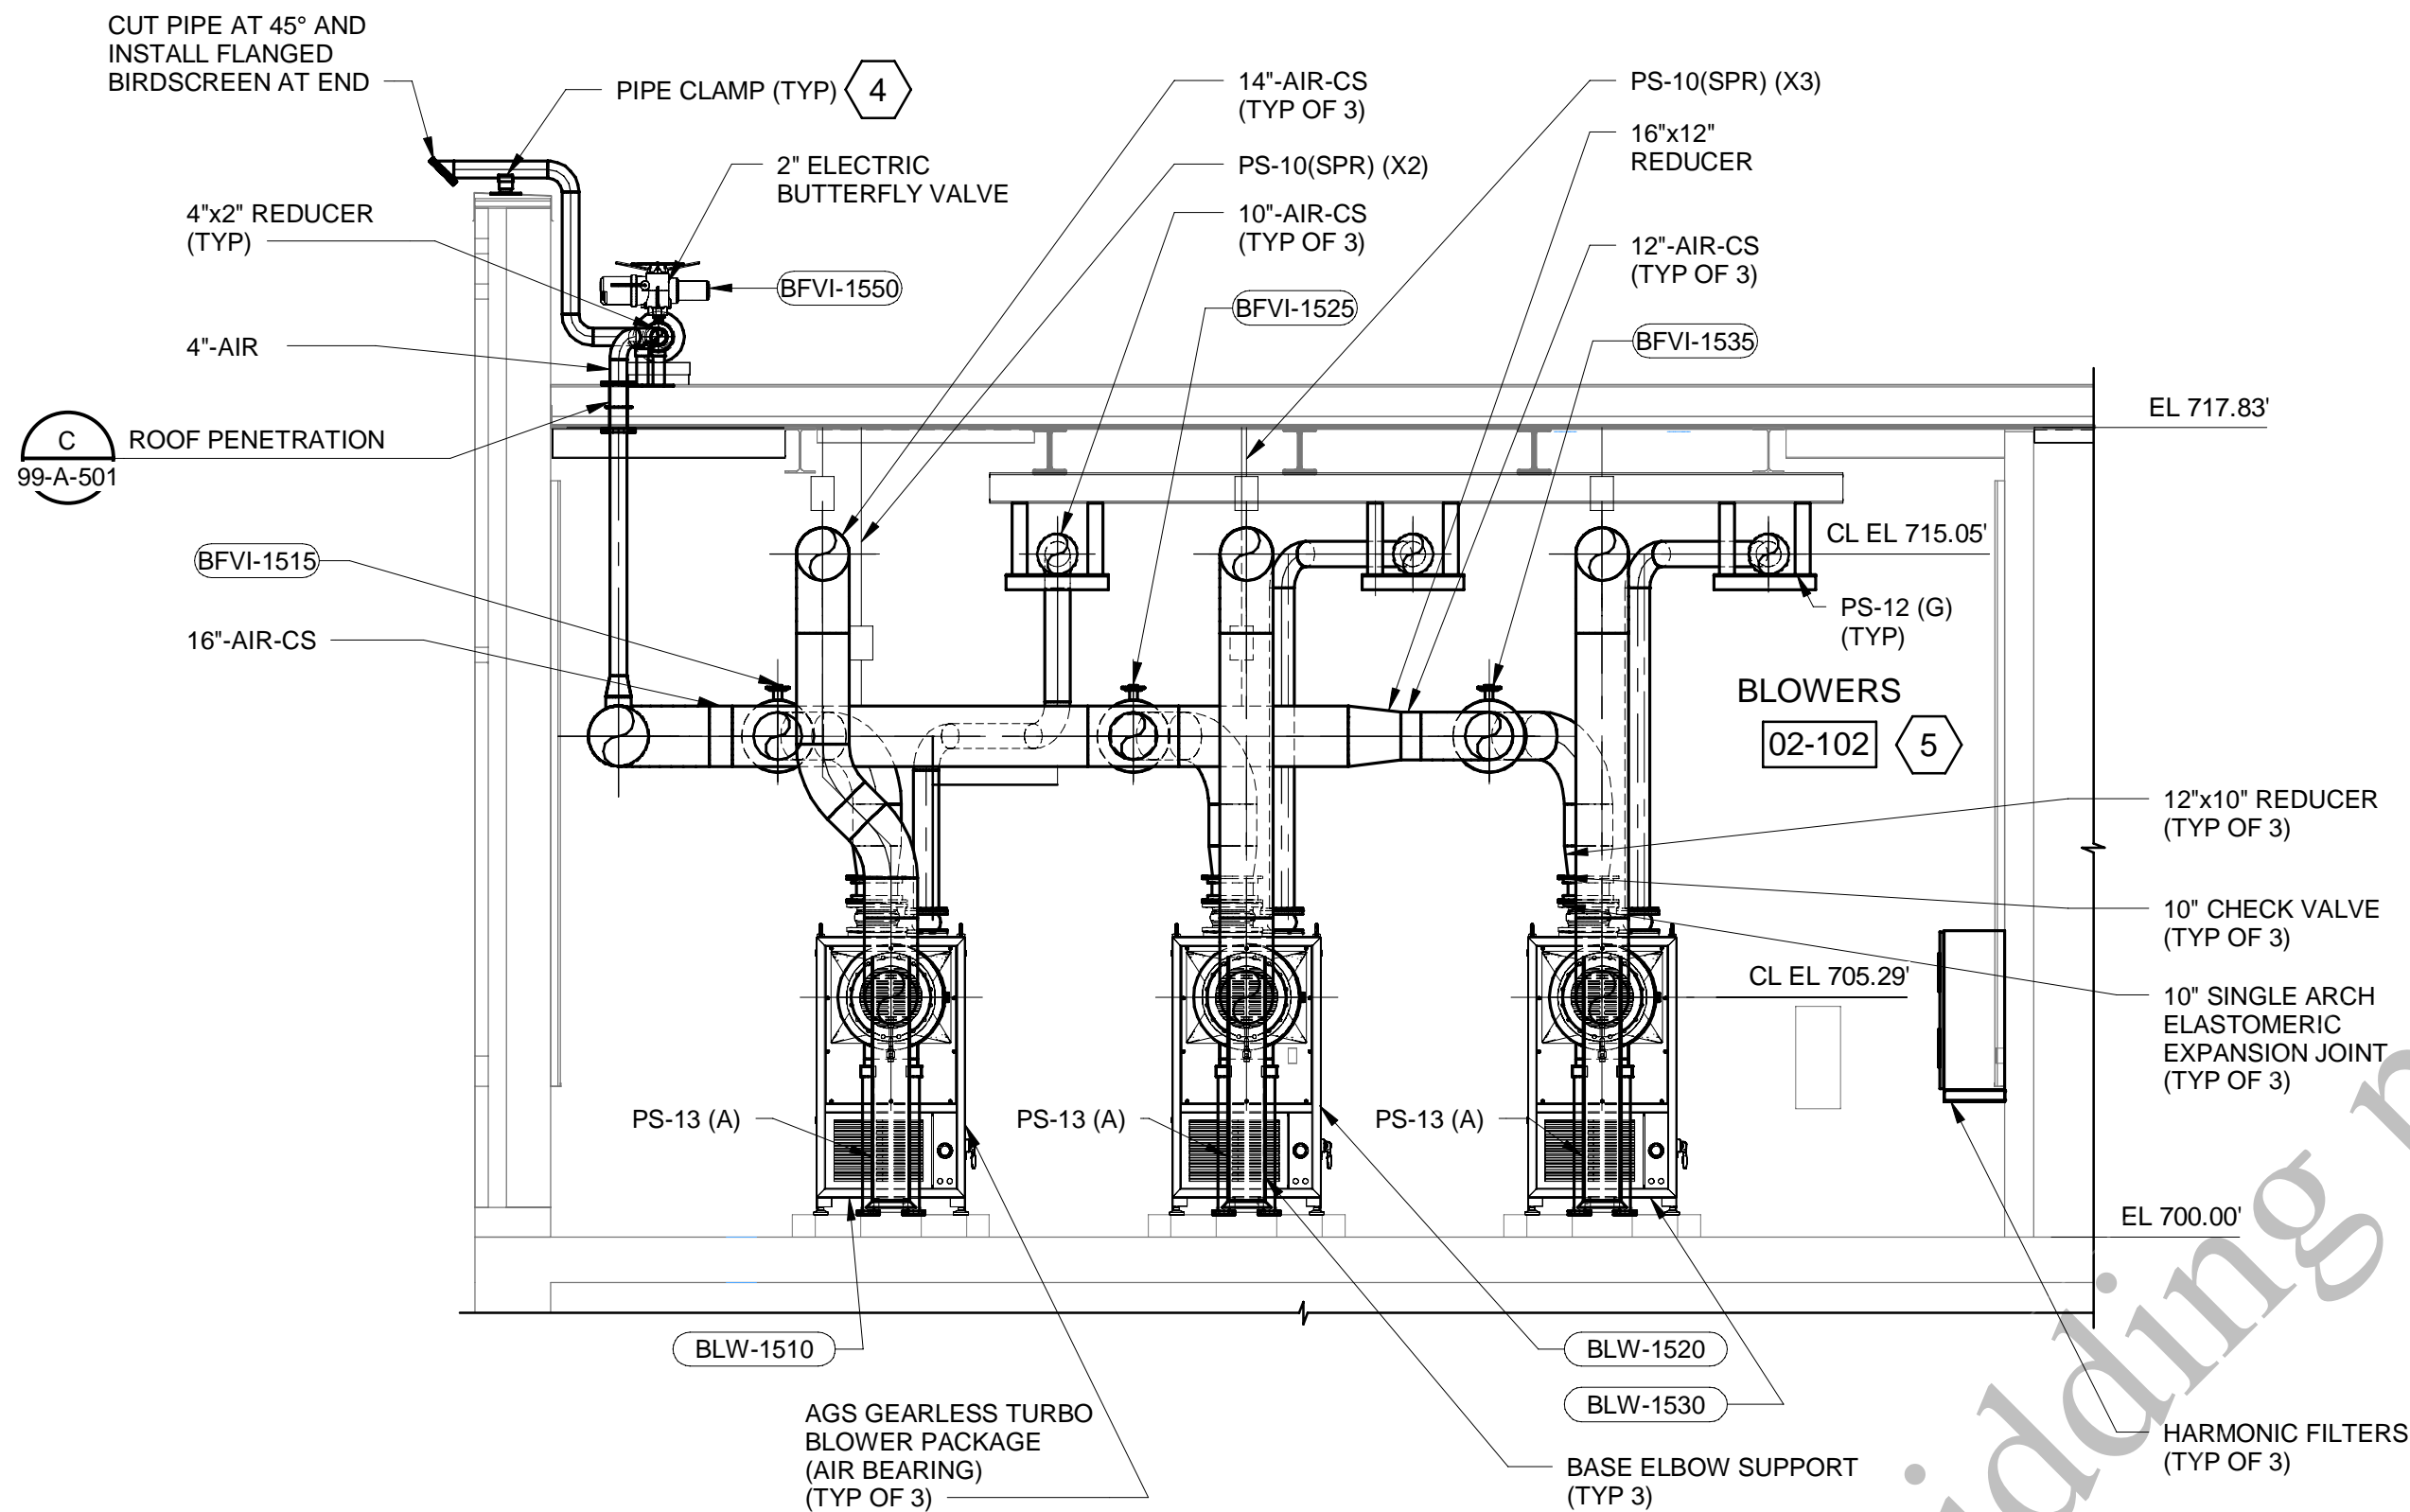

GENERAL SHEET NOTES

- PS-X REPRESENTS PIPE SUPPORT TYPE. SEE PIPE SUPPORT SCHEDULE ON SHEET 99-M-502.
- PIPE SUPPORT TYPES ARE IDENTIFIED USING THE FOLLOWING DESIGNATIONS:
- | | |
|-------|-------------------------|
| (G) | : GUIDE SUPPORT |
| (A) | : AXIAL STOP |
| (V) | : VERTICAL SUPPORT |
| (SPR) | : SPRING HANGER SUPPORT |



Black & Veatch Corporation
Chicago, Illinois
ILLINOIS PROFESSIONAL
DESIGN FIRM - 184.002143-0006

SHEET KEYNOTES

- CL ELEVATION OF THE PIPE SHALL MATCH THE CL ELEVATION OF THE HEADER BLOW-OFF SILENCER INLET FLANGE CONNECTION.
- AIR HEADER BLOW-OFF SILENCER OVERALL DIMENSIONS ARE BASED ON STODDARD. DIMENSIONS MAY VARY BASED ON THE MANUFACTURER SELECTED.
- PROVIDE PIPE SUPPORTS B-LINE "B3090" OR EQUAL PER THE PIPE SUPPORTS SPECIFICATION. PROVIDE 1/4" GAP BETWEEN U-BOLT AND PIPE.
- PROVIDE PIPE CLAMPS PER THE PIPE SUPPORTS SPECIFICATION. PROVIDE 1/4" GAP BETWEEN CLAMP AND PIPE.



AEROBIC GRANULAR
SLUDGE - PHASE 1

REVISIONS AND RECORD OF ISSUE

DESIGNED:	JL
DETAILED:	VP
CHECKED:	AM/JH
APPROVED:	MR
DATE:	12/20/2022
PROJECT NO.:	411752

AGS SUPPORT FACILITIES

PROCESS MECHANICAL

BLOWERS
SECTIONS


02-M-301

100
OF
163

(SCALE BAR IS 4" AT FULL SCALE) 0 1/2 1 2 3 4



PLOTTED: 12/16/2022 11:50:15 AM
FILE: BIM 360/409469 - Aerobic Granular Sludge Phase 1/409469 - AGS.rvt
D11000

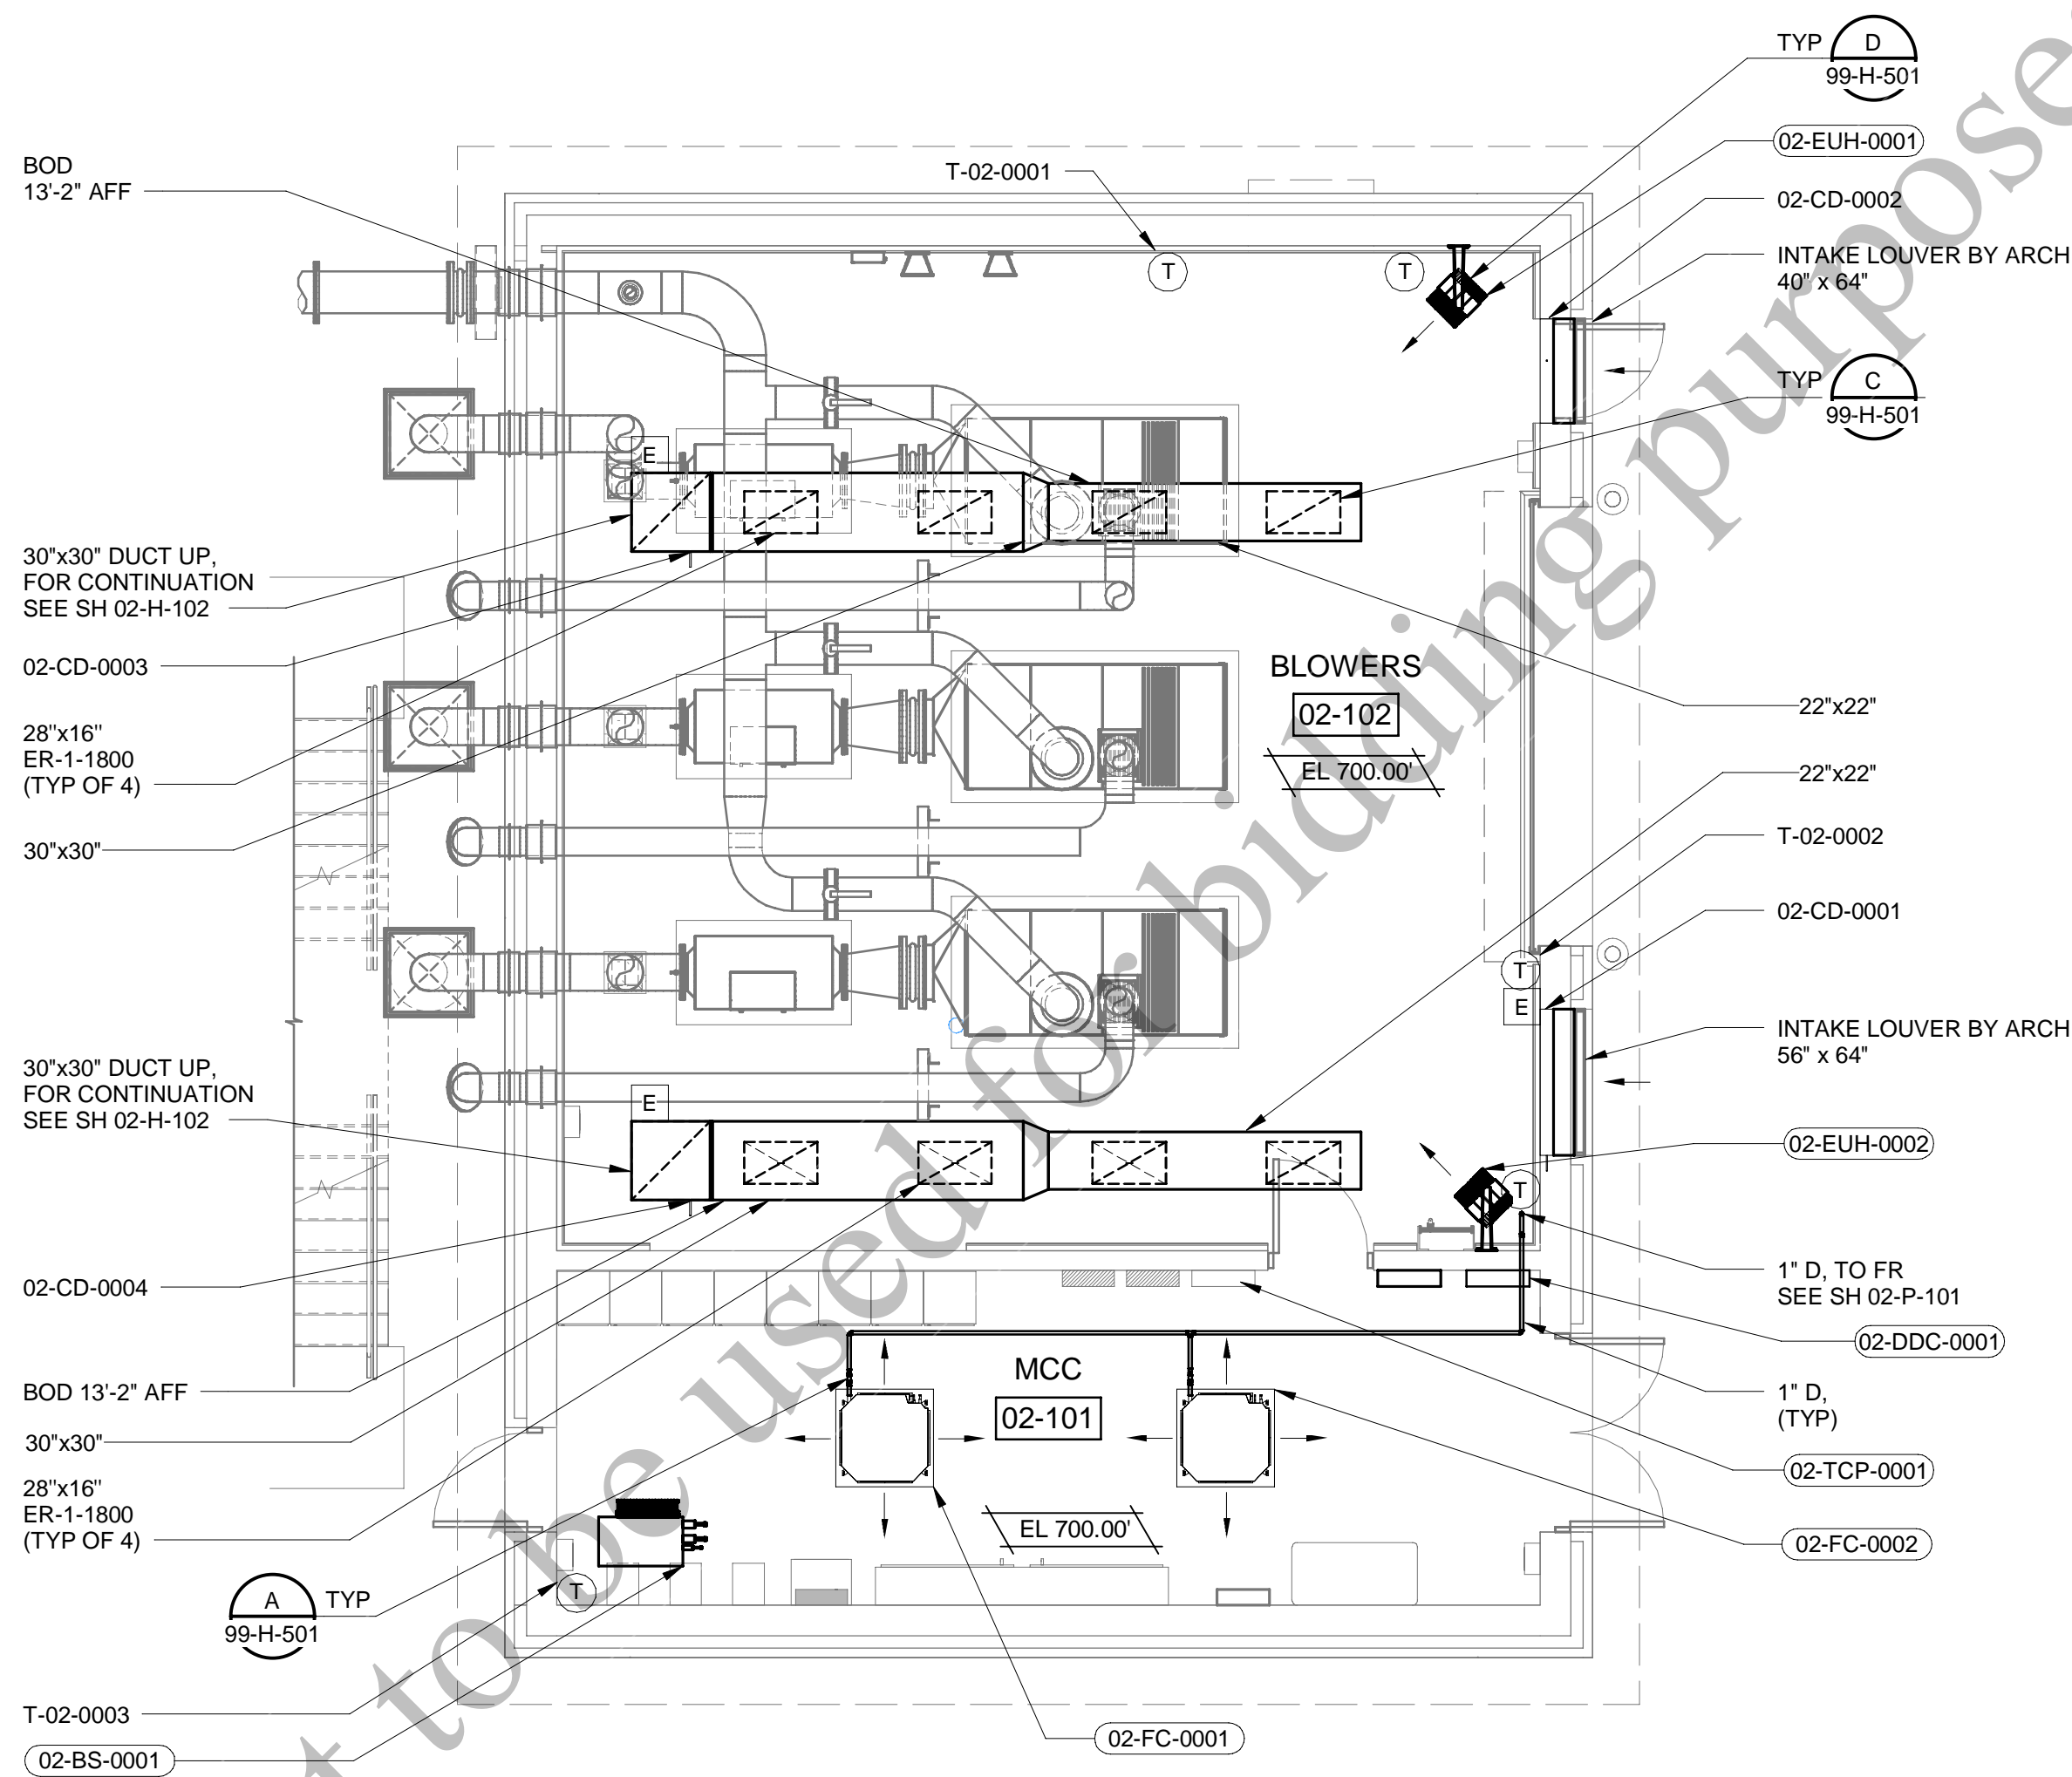

OPERATING FLOOR
3/16" = 1'-0"

GENERAL SHEET NOTES

- SEE DRAWING 00-H-001 FOR LEGENDS, ABBREVIATIONS AND GENERAL NOTES.
- REFRIGERANT PIPING IS NOT SHOWN FOR CLARITY. SIZE AND ROUTE REFRIGERANT PIPING PER MANUFACTURER RECOMMENDATIONS.
- HVAC SYSTEM IS DESIGNED BASED ON ATLAS COPCO MAGNETIC BEARING BLOWERS WHICH CAN SATISFY AERZEN BLOWER'S VENTILATION DESIGN REQUIREMENTS.



Black & Veatch Corporation
Chicago, Illinois
ILLINOIS PROFESSIONAL
DESIGN FIRM - 184.002143-0006



AEROBIC GRANULAR
SLUDGE - PHASE 1

REVISIONS AND RECORD OF ISSUE

DESIGNED:	VSS
DETAILED:	AJP
CHECKED:	KMC
APPROVED:	SP
DATE:	12/20/2022
PROJECT NO.:	411752


AGS SUPPORT FACILITIES

HVAC


BLOWERS FLOOR PLAN

02-H-101

101
OF
163

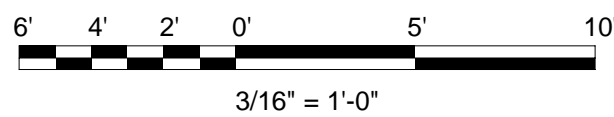

(SCALE BAR IS 4" AT FULL SCALE)

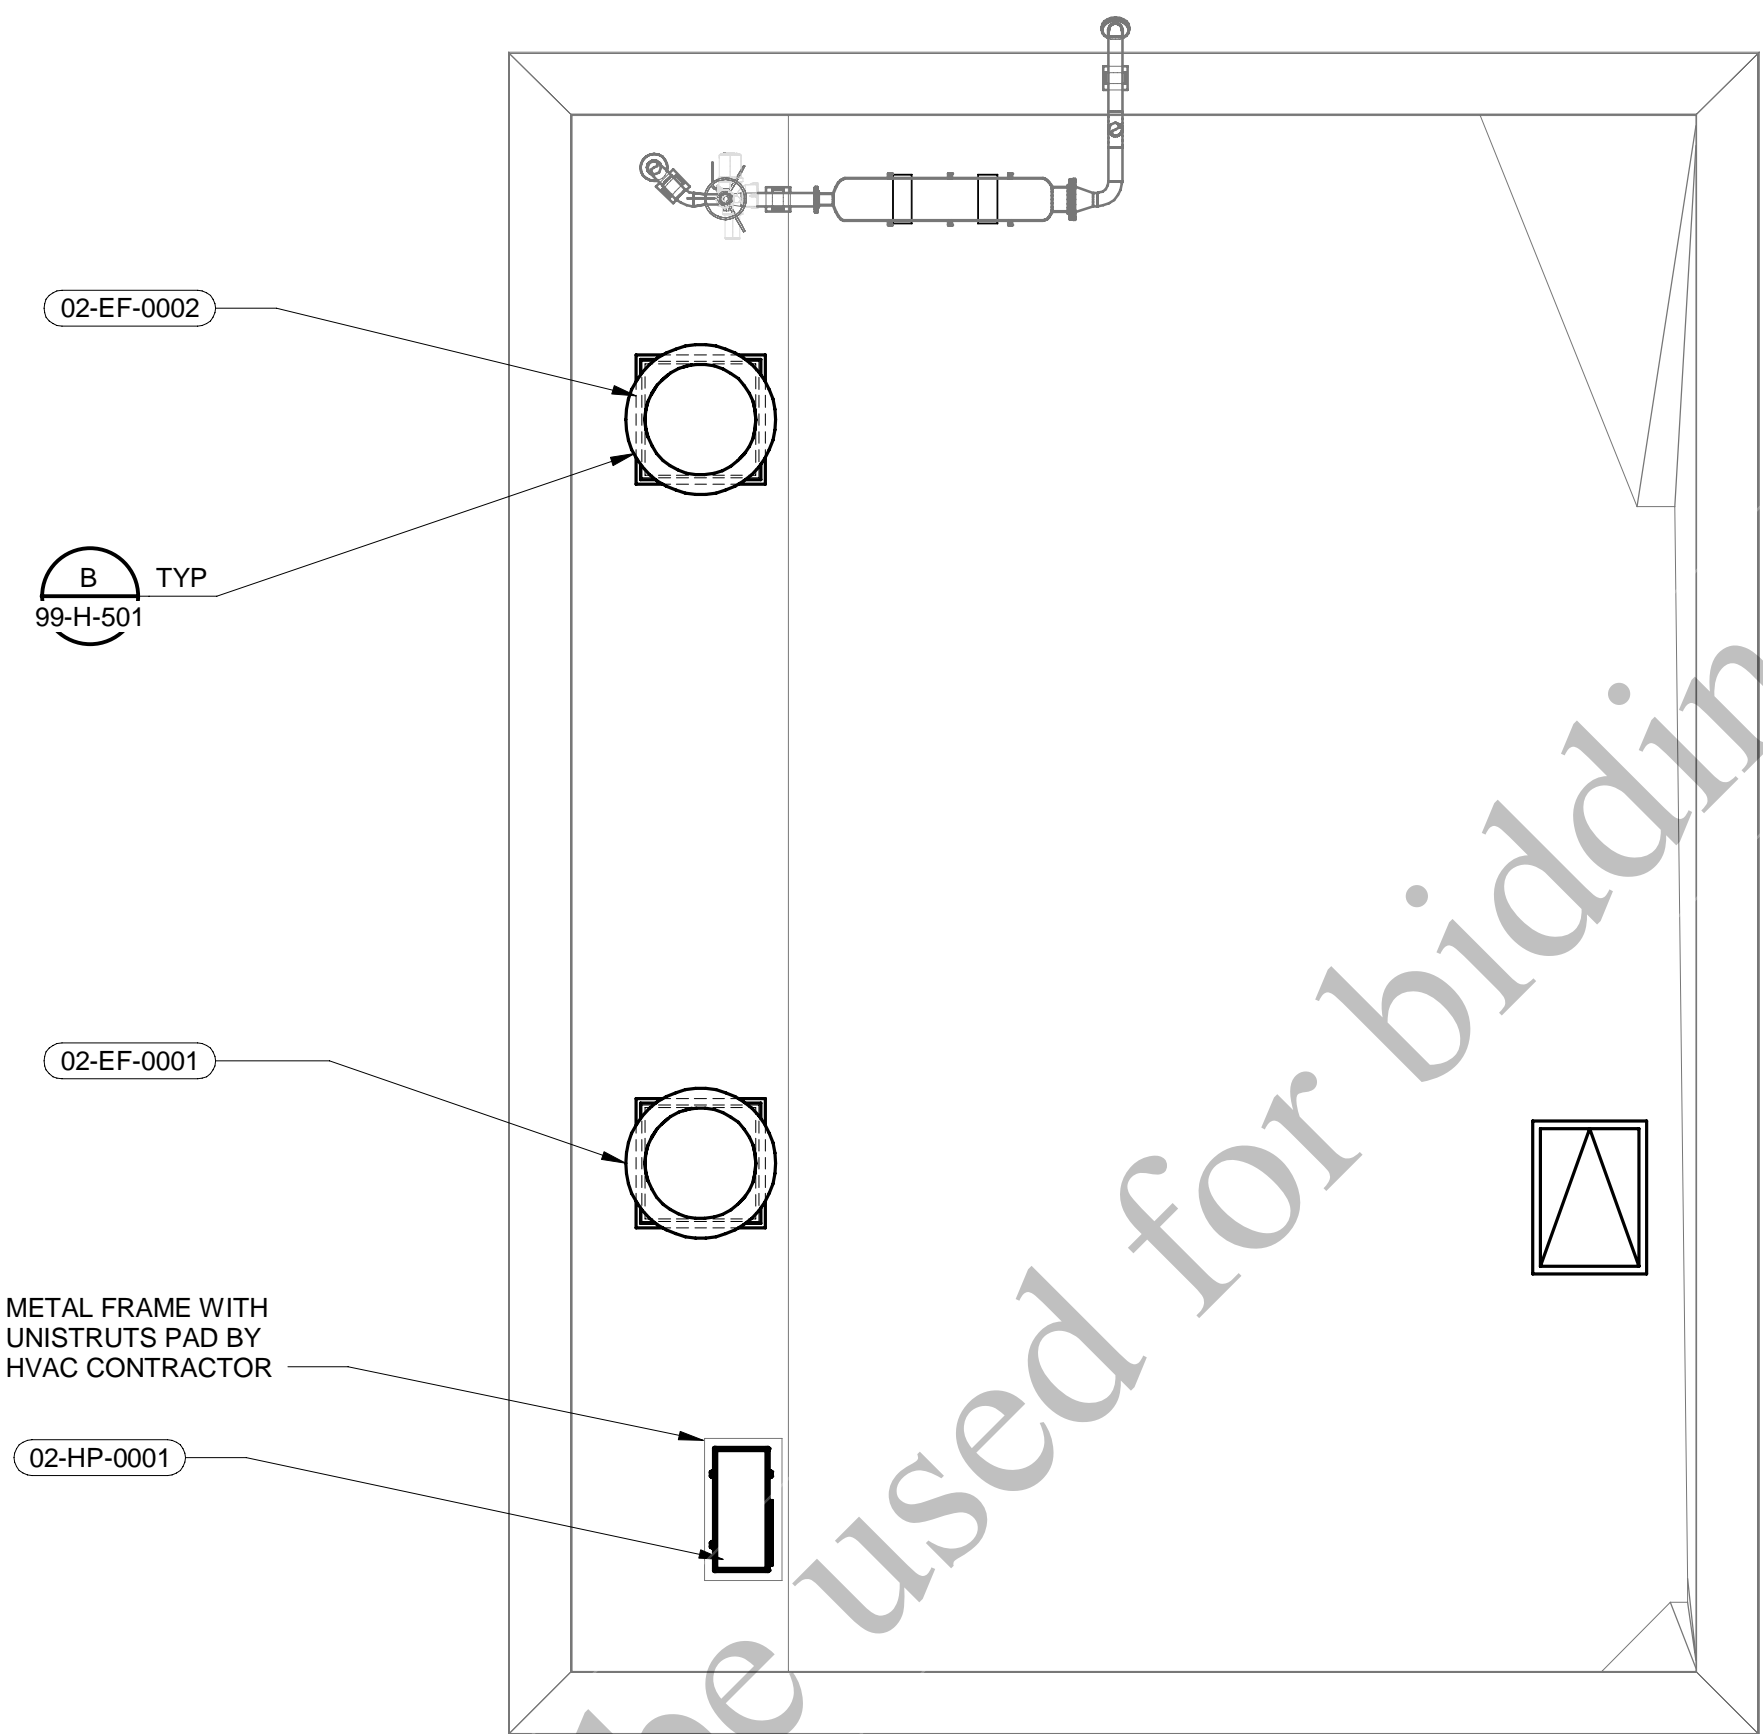

ROOF PLAN
3/16" = 1'-0"

GENERAL SHEET NOTES

- 1. SEE DRAWING 00-H-001 FOR LEGENDS, ABBREVIATIONS AND GENERAL NOTES.
- 2. REFRIGERANT PIPING IS NOT SHOWN FOR CLARITY. SIZE AND ROUTE REFRIGERANT PIPING PER MANUFACTURER RECOMMENDATIONS.



Black & Veatch Corporation
Chicago, Illinois
ILLINOIS PROFESSIONAL
DESIGN FIRM - 184.002143-0006



AEROBIC GRANULAR
SLUDGE - PHASE 1

REVISIONS AND RECORD OF ISSUE	
DESIGNED:	VSS
DETAILED:	AJP
CHECKED:	KMC
APPROVED:	SP
DATE:	12/20/2022
PROJECT NO.:	411752


AGS SUPPORT FACILITIES

HVAC

BLOWERS ROOF PLAN

02-H-102

102
OF
163

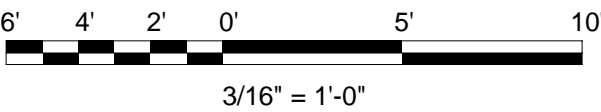

(SCALE BAR IS 4" AT FULL SCALE)



GENERAL SHEET NOTES

1. SEE DRAWING 00-P-001 FOR LEGENDS, ABBREVIATIONS AND GENERAL NOTES.

SHEET KEYNOTES

1. LEAVE 2" D LINE WITH 1" AIR GAP ABOVE FUNNEL RECEPTOR.



Black & Veatch Corporation
Chicago, Illinois
ILLINOIS PROFESSIONAL
DESIGN FIRM - 184.002143-0006



AEROBIC GRANULAR
SLUDGE - PHASE 1

REVISIONS AND RECORD OF ISSUE	
DESIGNED:	SAM
DETAILED:	AJP
CHECKED:	DAV
APPROVED:	SP
DATE:	12/20/2022
PROJECT NO.:	411752



AGS REACTORS AND PIPE
GALLERY

PLUMBING

BLOWERS FLOOR PLAN
AND DETAIL

02-P-101

103
OF
163

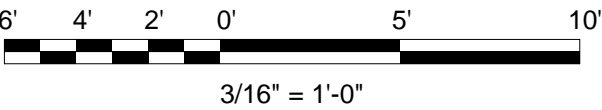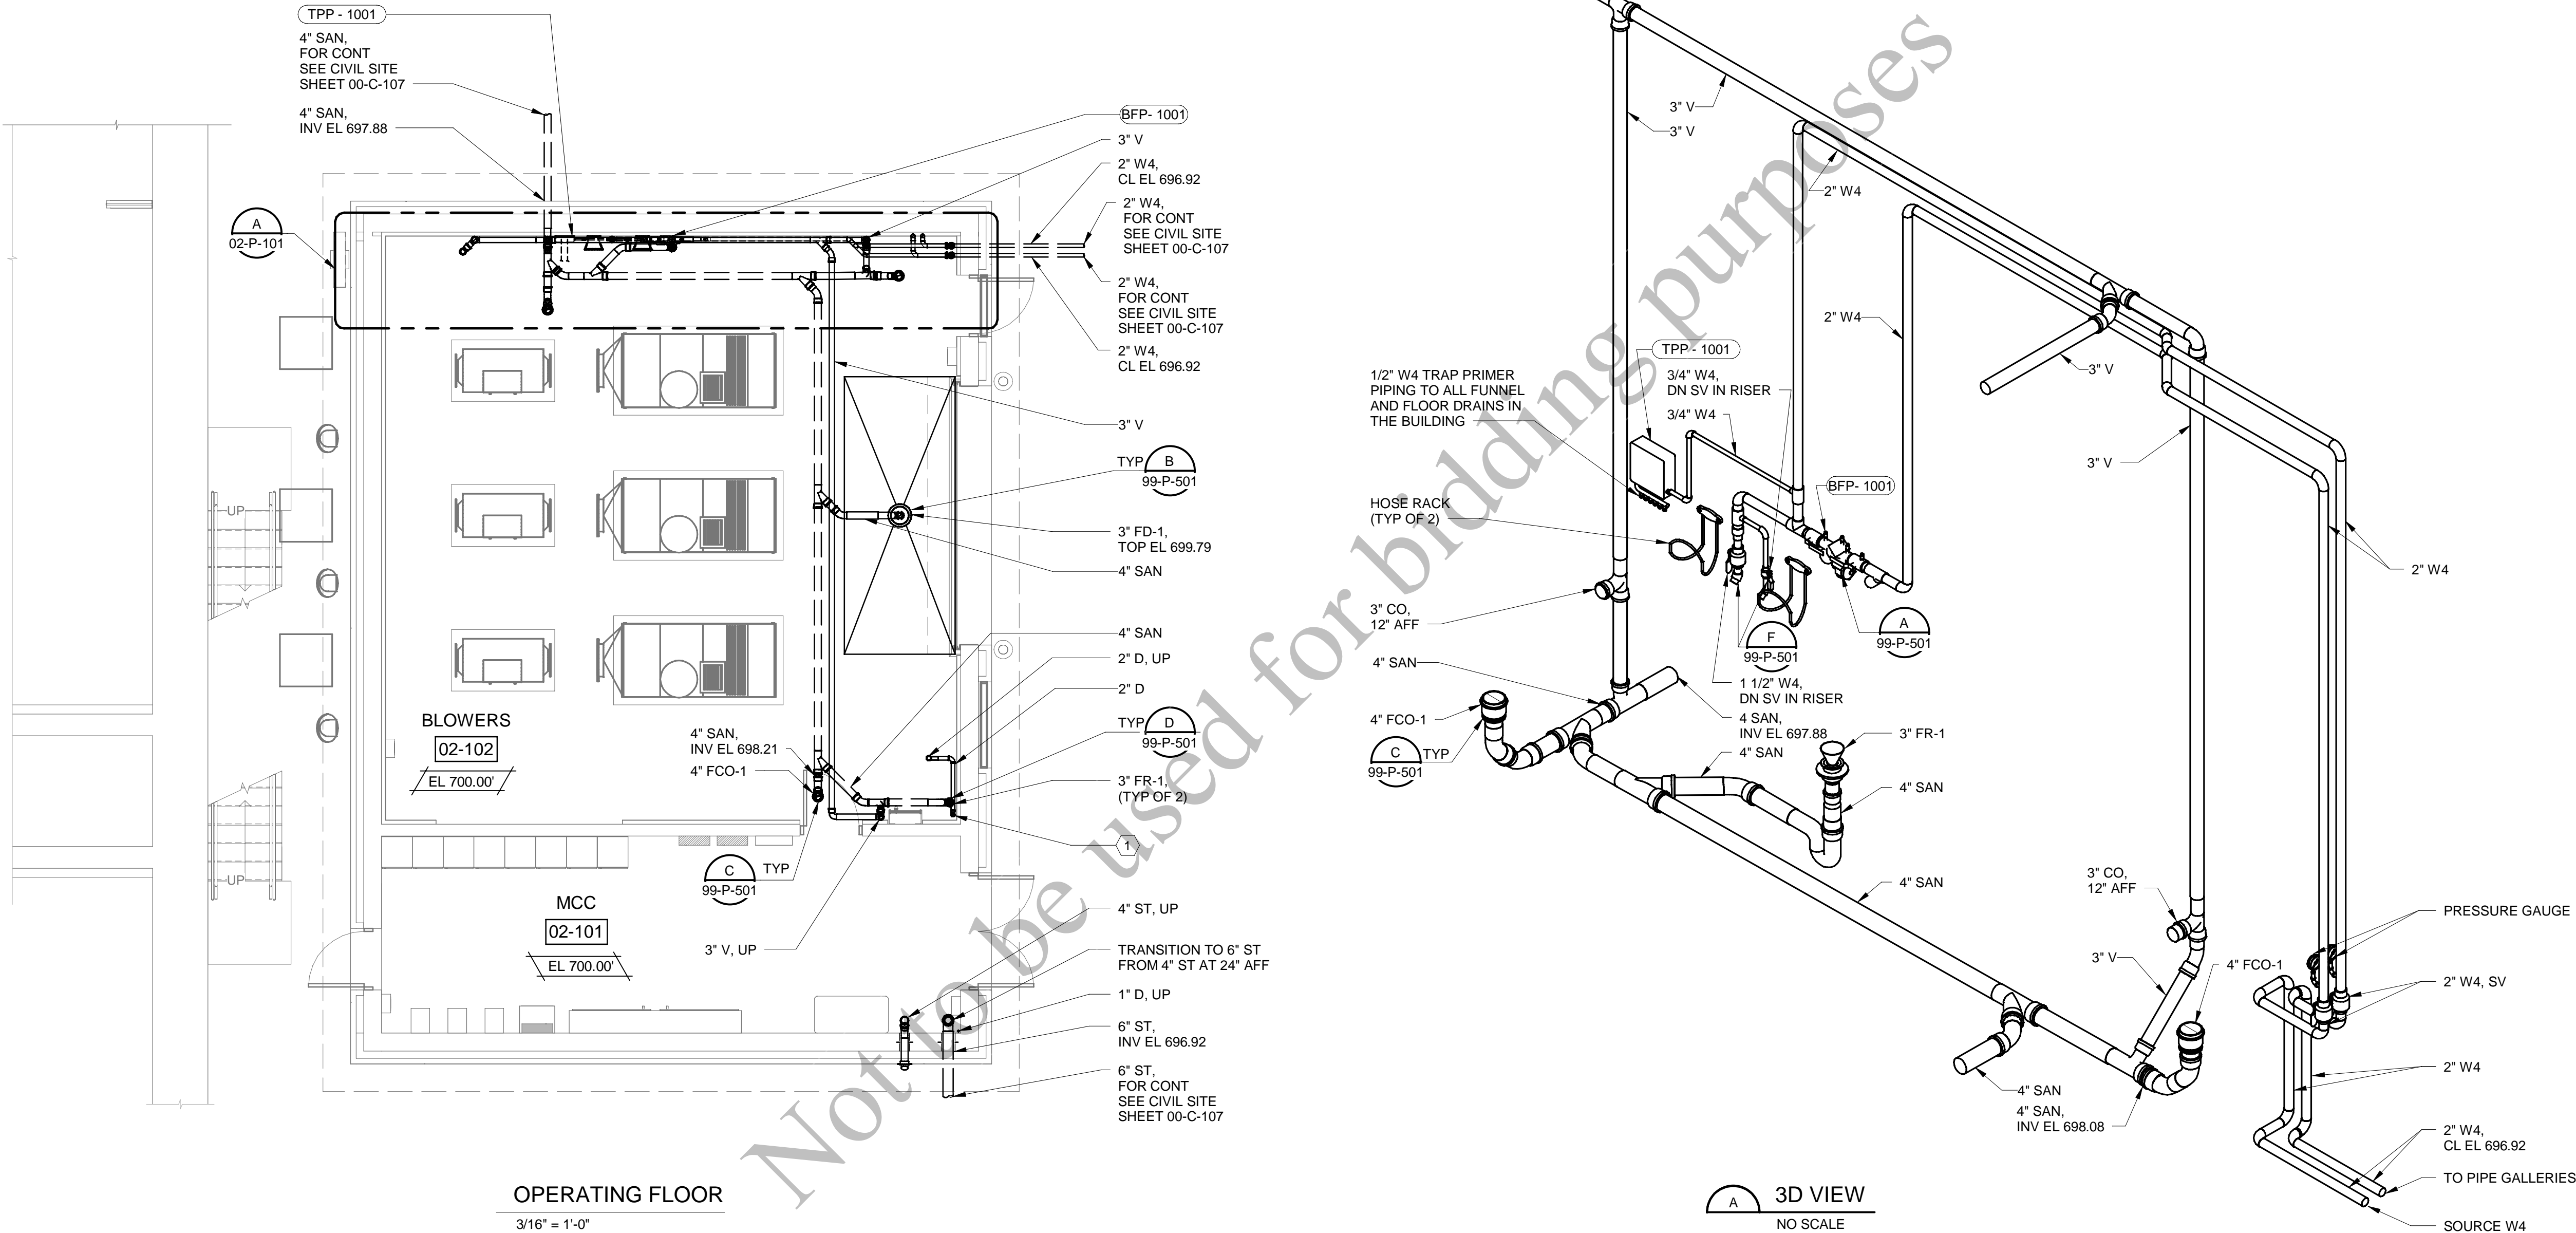

(SCALE BAR IS 4\"/>



GENERAL SHEET NOTES

1. SEE DRAWING 00-P-001 FOR LEGENDS, ABBREVIATIONS AND GENERAL NOTES.

SHEET KEYNOTES

1. DRAIN LINE TO CONNECT WITH DRIP TRAY.



Black & Veatch Corporation
Chicago, Illinois
ILLINOIS PROFESSIONAL
DESIGN FIRM - 184.002143-0006



AEROBIC GRANULAR
SLUDGE - PHASE 1

REVISIONS AND RECORD OF ISSUE	
DESIGNED:	SAM
DETAILED:	AJP
CHECKED:	DAV
APPROVED:	SP
DATE:	12/20/2022

PROJECT NO.: 411752


AGS REACTORS AND PIPE
GALLERY

PLUMBING

BLOWERS ROOF PLAN


02-P-102

104
OF
163

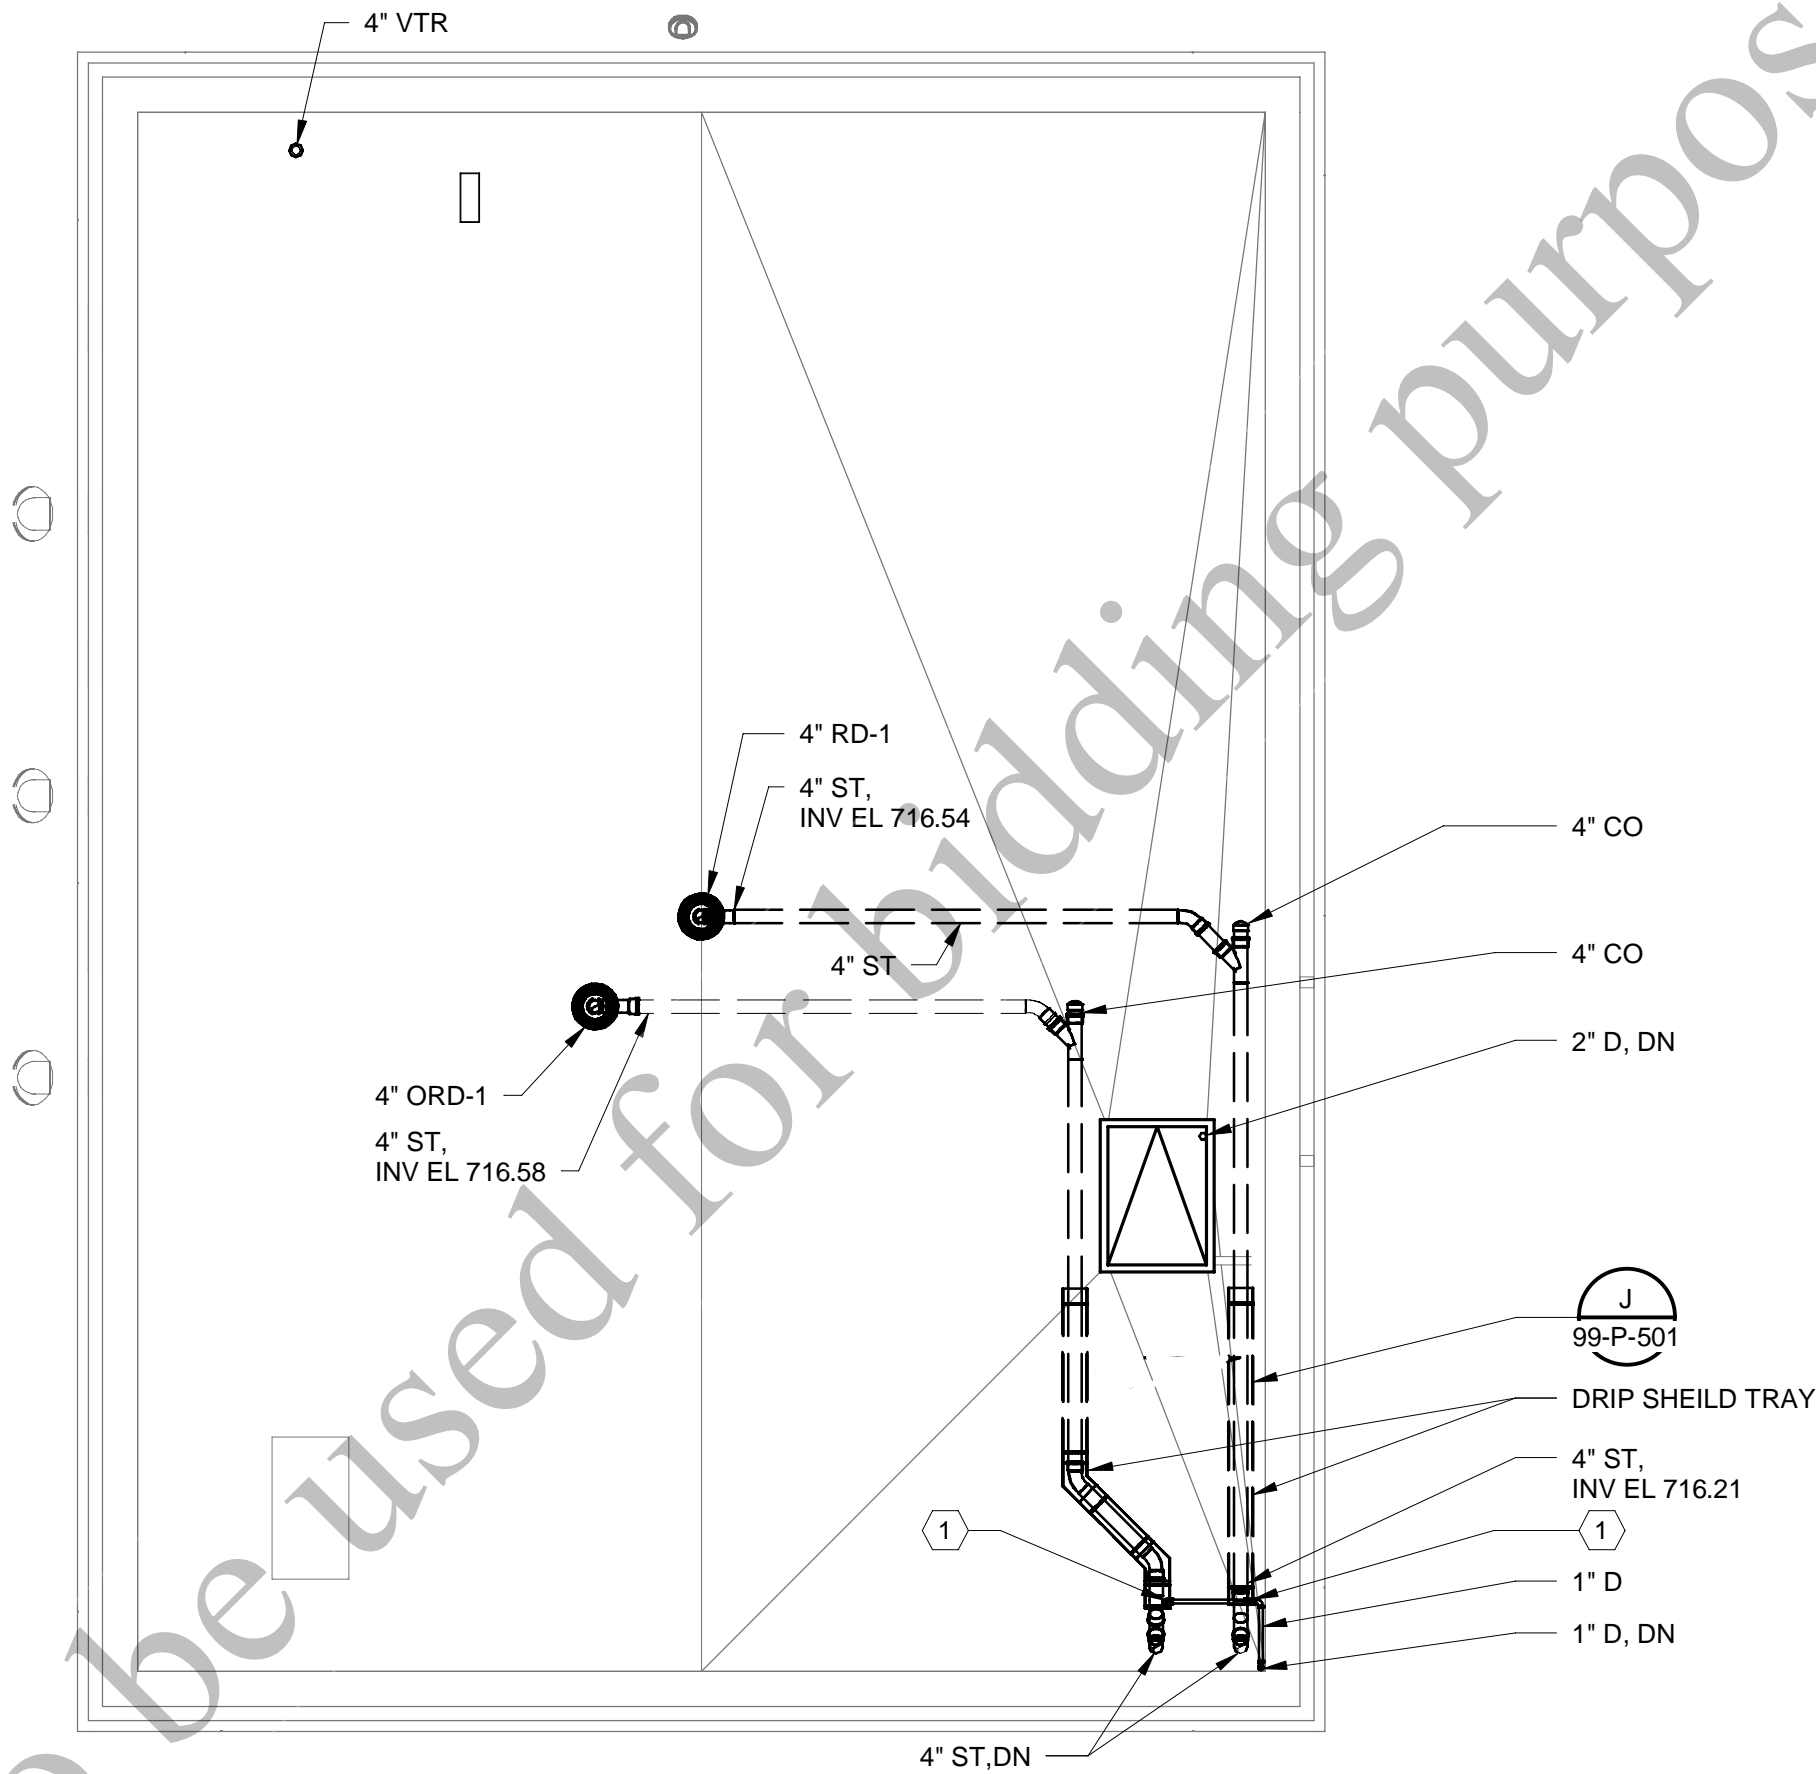


ROOF PLAN

3/16" = 1'-0"

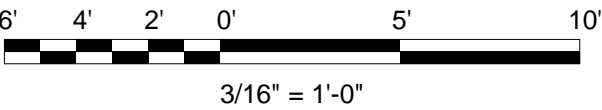

(SCALE BAR IS 4" AT FULL SCALE)

PLOTTED: 12/16/2022 11:48:14 AM
FILE: BIM 360/409469 - Aerobic Granular Sludge Phase 1/409469 - AGS.rvt
D11000

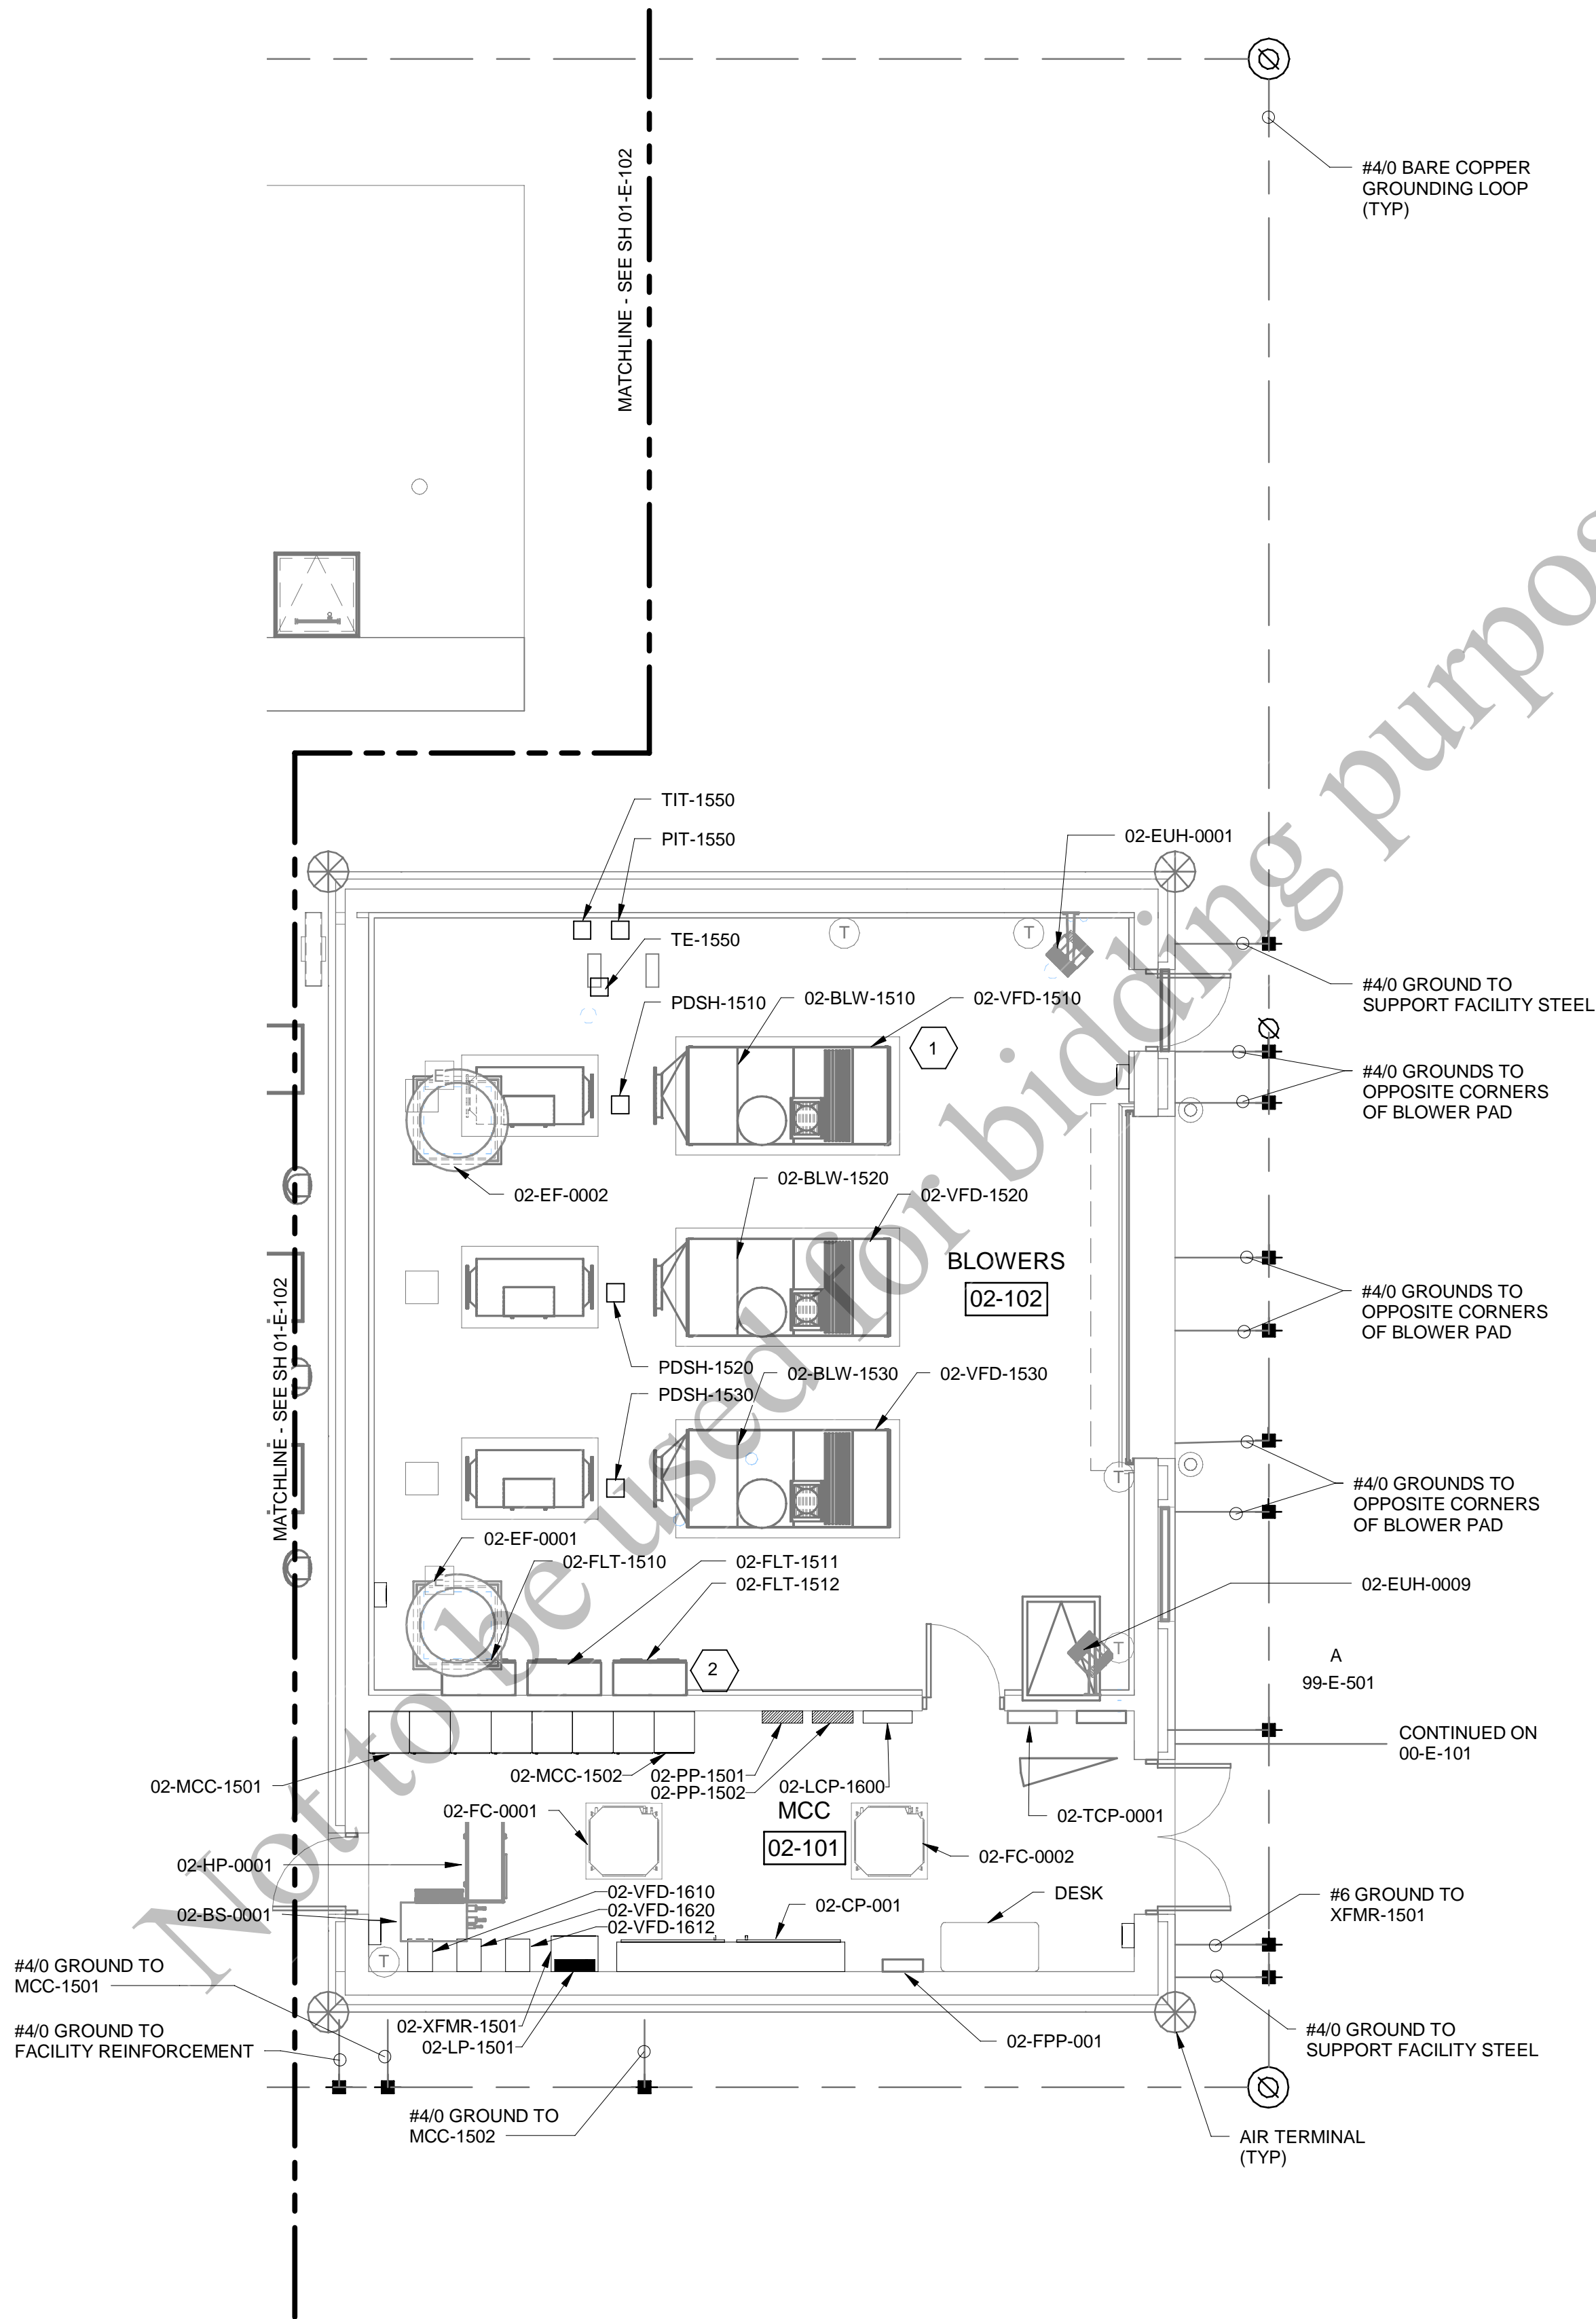

ELECTRICAL POWER AND GROUNDING PLAN
3/16" = 1'-0"

GENERAL NOTES

- SEE DRAWINGS 00-E-001 AND 00-E-002 DOR LEGENDS, ABBREVIATIONS AND NOTES.

SHEET KEYNOTES

- VARIABLE FREQUENCY DRIVES SUPPLIED AS PACKAGED UNIT WITH BLOWER BY BLOWER VENDOR. TYPICAL OF THREE BLOWERS.
- HARMONIC FILTERS SUPPLIED BY BLOWER VENDOR BUT SHIPPED LOOSE. TYPICAL OF THREE BLOWERS.



Black & Veatch Corporation
Chicago, Illinois
ILLINOIS PROFESSIONAL
DESIGN FIRM - 184.002143-0006



AEROBIC GRANULAR
SLUDGE - PHASE 1

REVISIONS AND RECORD OF ISSUE

DESIGNED:	EJB
DETAILED:	SFR
CHECKED:	SDS
APPROVED:	EJB
DATE:	12/20/2022

PROJECT NO.: 411752

AGS SUPPORT FACILITIES

ELECTRICAL

FACILITIES POWER &
GROUNDING PLAN


02-E-101

105
OF
163

(SCALE BAR IS 4" AT FULL SCALE) 0 1/2 1 2 3 4



106
OF
163

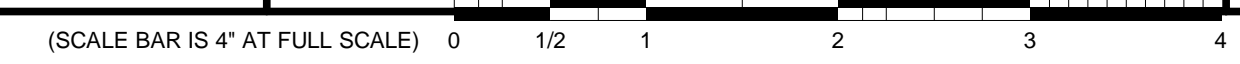

PLOTTED: 12/16/2022 11:09 AM
 FILE: C:\pw_working\bwv_america\id1495380\02-E-601.dwg
 PLOTTED: 12/16/2022 11:09 AM
 FILE: C:\pw_working\bwv_america\id1495380\02-E-601.dwg

PHASE			PANELBOARD: 02-LP-1501				BUS: COPPER RATING: 100A				MAINS: 3P-100A MAIN BREAKER				PHASE		
"A"	"B"	"C"	SERVICE: 120/208V, 3PH, 4W, 5N								LOCATION: AGS SUPPORT FACILITIES						
V.A.	V.A.	V.A.	MOUNTING: SURFACE												"A"	"B"	"C"
			LOAD	P	BKR	CKT #	CKT #	BKR	P	LOAD					V.A.	V.A.	V.A.
50			PRI FLT EFF DISCH FLW -FIT-1000	1	20	1	2	20	1	AGS SUPPLIER PLC-CP-001					500		
	50		AGS REACTOR NO.1 INFLUENT FLOW -FIT-1100	1	20	3	4	20	1	AGS REACTOR NO.1 ANALYZER -AIT-1100					50		
		50	WAGS/WLC PUMP COMMON DISCH FLW FIT-1650	1	20	5	6	20	1	AGS REACTOR NO.2 ANALYZER -AIT-1200						50	
50			AGS REACTOR NO.2 INFLURNT FLOW -FIT-1200	1	20	7	8	45	2	MCC HEAT PUMP -HP-0001 NOTE 1				4500			
	50		AGS REACTOR NO.3 INFLURNT FLOW -FIT-1300	1	20	9	10	-	-	-					4500		
		50	AGS REACTOR NO.4 INFLURNT FLOW -FIT-1400	1	20	11	12	20	1	AGS REACTOR NO.3 ANALYZER -AIT-1300						50	
511			MCC ROOM 02-101 LIGHTING	1	20	13	14	20	1	AGS REACTOR NO.4 ANALYZER -AIT-1400				50			
	1150		BLOWER ROOM 02-102 LIGHTING	1	20	15	16	20	1	BLOWER ROOM 02-102 RECEPTACLES					540		
		116	SUPPORT FACILITIES EXTERIOR LIGHTING	1	20	17	18	20	1	MCC ROOM 02-101 RECEPTACLES						360	
333			PIPE GALLERY 01-001 - LIGHTING	1	20	19	20	20	2	STAIRWELL NO.1 EXHAUST FAN 01-EF-0003 NOTE 1				250			
	167		PIPE GALLERY 01-001 - LIGHTING	1	20	21	22	-	-	-					250		
		50	WAGS/WLC WETWELL CNTL PNL - LCP-1600	1	20	23	24	20	1	WAGS/WLC WETWELL INFLUENT TOTAL SUSPENDED SOLIDS AIT-1601						50	
222			PIPE GALLERY 01-001 - LIGHTING	1	20	25	26	20	1	PIPE GALLERY 01-001 - RECEPTACLES				900			
	222		PIPE GALLERY 01-001 - LIGHTING	1	20	27	28	20	1	PIPE GALLERY 01-001 - RECEPTACLES					720		
		222	PIPE GALLERY 01-001 - LIGHTING	1	20	29	30	20	1	GALLERY TOP - EXTERIOR LIGHTING						228	
167			PIPE GALLERY 01-001 - LIGHTING	1	20	31	32	20	1	GALLERY TOP - EXTERIOR LIGHTING				380			
	333		GALLERY STAIR NO.2 01-002 - LIGHTING	1	20	33	34	20	1	GALLERY TOP - EXTERIOR LIGHTING					343		
		167	GALLERY STAIR NO.1 01-001 - LIGHTING	1	20	35	36	20	1	GALLERY TOP - EXTERIOR LIGHTING						609	
167			GALLERY STAIR NO.1 01-001 - LIGHTING	1	20	37	38	20	1	GALLERY TOP - RECEPTACLES				720			
	250		STAIRWELL NO.2 EXHAUST FAN - 01-EF-0004 NOTE 1	2	20	39	40	20	1	GALLERY TOP - RECEPTACLES					900		
		250	-	-	20	41	42	20	1	EFFLUENT CHANNEL PHOSPHATE ANALYZER AT-1005						50	
0			SPARE	1	20	43	44	20	1	SPARE				0			
	0		SPARE	1	20	45	46	20	1	SPARE					0		
		0	SPARE	1	20	47	48	20	1	SPARE						0	
0			SPARE	1	20	49	50	20	1	SPARE				0			
	0		SPARE	1	20	51	52	20	1	SPARE					0		
		0	SPARE	1	20	53	54	20	1	SPARE						0	
1500			TOTAL "A"			8800				TOTAL "A"			7300				
	2222		TOTAL "B"			9525				TOTAL "B"				7303			
		905	TOTAL "C"			2302				TOTAL "C"						1397	
			TOTAL	=		20627											

LIGHTING FIXTURE SCHEDULE				
SYMBOL	LAMP	MTG HGT	DESCRIPTION	MANUFACTURER
1	LED 6096 LUMENS 50W	AS NOTED ON PLANS	RAB LED 1X4' 50 WATT WHITE FINISH	RAB SHARK 4 50 W/D10
1E	LED 6096 LUMENS 50W	AS NOTED ON PLANS	RAB LED 1X4' 50 WATT WHITE FINISH BATTERY BACKUP	RAB SHARK 4 50 W/D10 /E2
2	LED 3851 LUMENS 26W	AS NOTED ON PLANS	LED OUTDOOR WALLPACK WITH PHOTOCELL/MOTION SENSOR	RAB WPLED26
3	LED 4340 LUMENS 38W	AS NOTED ON PLANS	LED TYPE 2 DISTRIBUTION, 4,500 LUMENS, SLIPFITTER STYLE MOUNT, 5000K, BRONZE FINISH, 120-277V, 8FT LENS WATTSTOPPER	RAB IVAT2-45LSF750ZU/WS
			10'-0" BRONZE SQUARE POLE	RAB PS4-11-10WT
EXIT	LED .71W	1' ABOVE DOORWAYS	LITHONIA LQM EXIT SIGN, STENCIL, WHITE, SINGLE FACE, 120/277 DUAL VOLTAGE, NICKLE CADMIUM BATTERY BACKUP	LITHONIA LQM S W 3 R 120/277 EL N

GENERAL SHEET NOTES

- SEE SPECIFICATION SECTION 23 09 11 FOR COMPLETE HVAC CONTROL SYSTEM CABLES, INTERCONNECTIONS, AND REQUIREMENTS.
- ALL TAGS ARE PREFACED BY "02" UNLESS OTHERWISE SHOWN.



Black & Veatch Corporation
 Chicago, Illinois
 ILLINOIS PROFESSIONAL
 DESIGN FIRM - 184.002143 -0006



AEROBIC GRANULAR
 SLUDGE - PHASE 1

REVISIONS AND RECORD OF ISSUE	
DESIGNED:	EJB
DETAILED:	SFR
CHECKED:	SDS
APPROVED:	EJB
DATE:	12/20/2022
PROJECT NO.:	411752


AGS SUPPORT FACILITIES

ELECTRICAL

LIGHTING PANEL AND
 FIXTURE SCHEDULE

02-E-601

107
 OF
 163

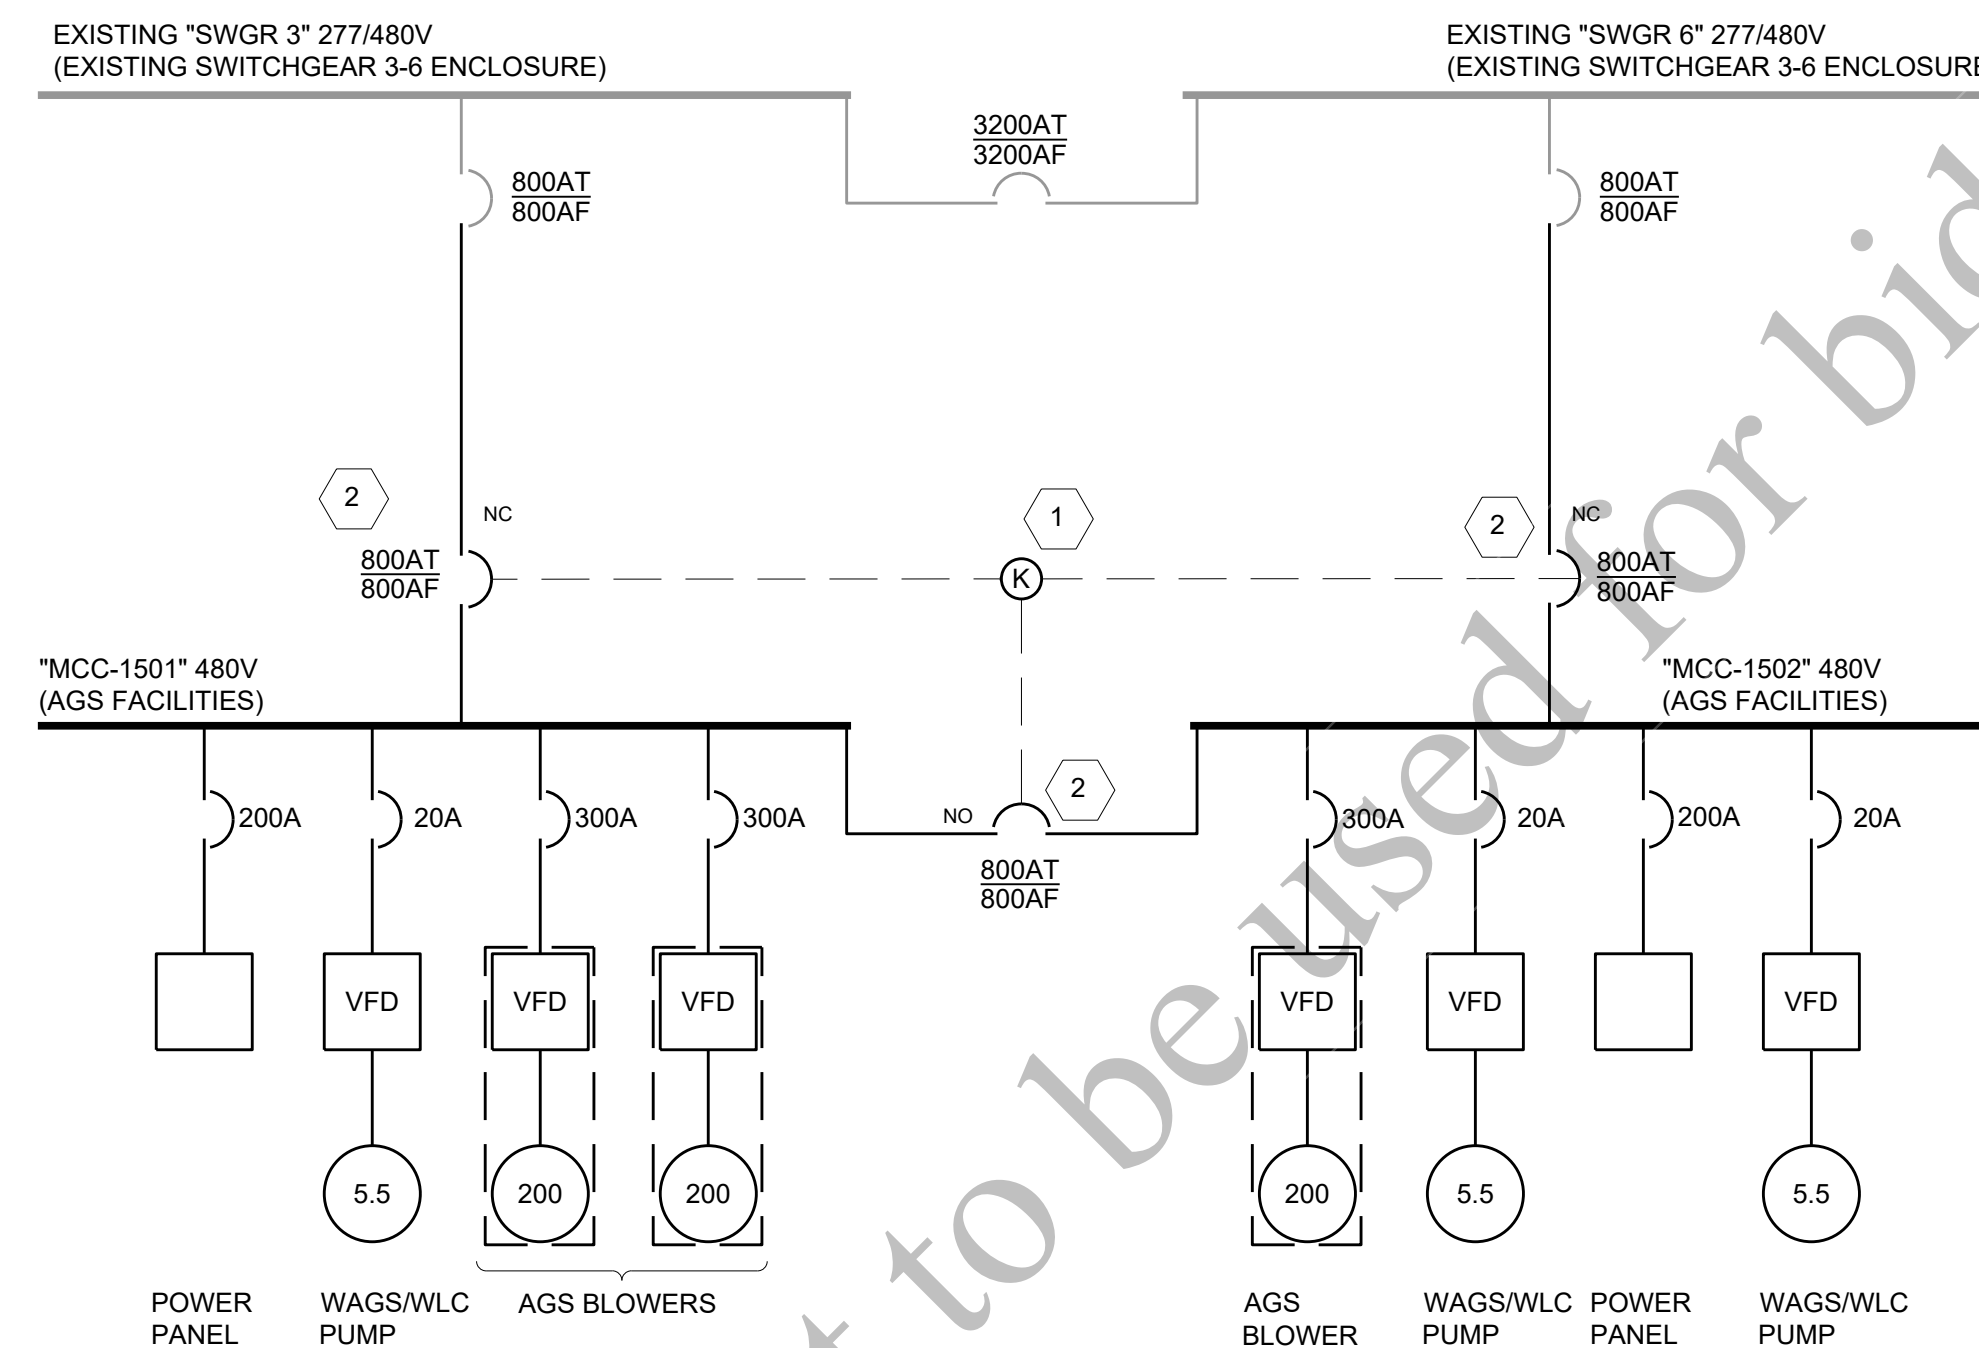

GENERAL SHEET NOTES

1. SEE DRAWINGS 00-E-001 AND 00-E-002 FOR LEGENDS, ABBREVIATIONS AND NOTES.



Black & Veatch Corporation
Chicago, Illinois
ILLINOIS PROFESSIONAL
DESIGN FIRM - 184.002143 -0006

 SHEET KEYNOTES

1. MAIN-TIE-MAIN KIRK KEY INTERLOCK SCHEME SUCH THAT ONLY TWO BREAKERS CAN BE CLOSED AT ANY TIME.
2. MCC MAIN AND TIE BREAKERS SHALL BE RATED TO OPERATE AT 800 AMPS CONTINUOUSLY.



AEROBIC GRANULAR
SLUDGE - PHASE 1

REVISIONS AND RECORD OF ISSUE

DESIGNED:	EJB
DETAILED:	SFR
CHECKED:	SDS
APPROVED:	EJB
DATE:	12/20/2022

PROJECT NO.: 411752

AGS SUPPORT FACILITIES



ELECTRICAL

POWER DISTRIBUTION FUNCTIONAL DIAGRAM

02-E-701

108
OF
163

(SCALE BAR IS 4" AT FULL SCALE) 0 1/2 1 2 3 4

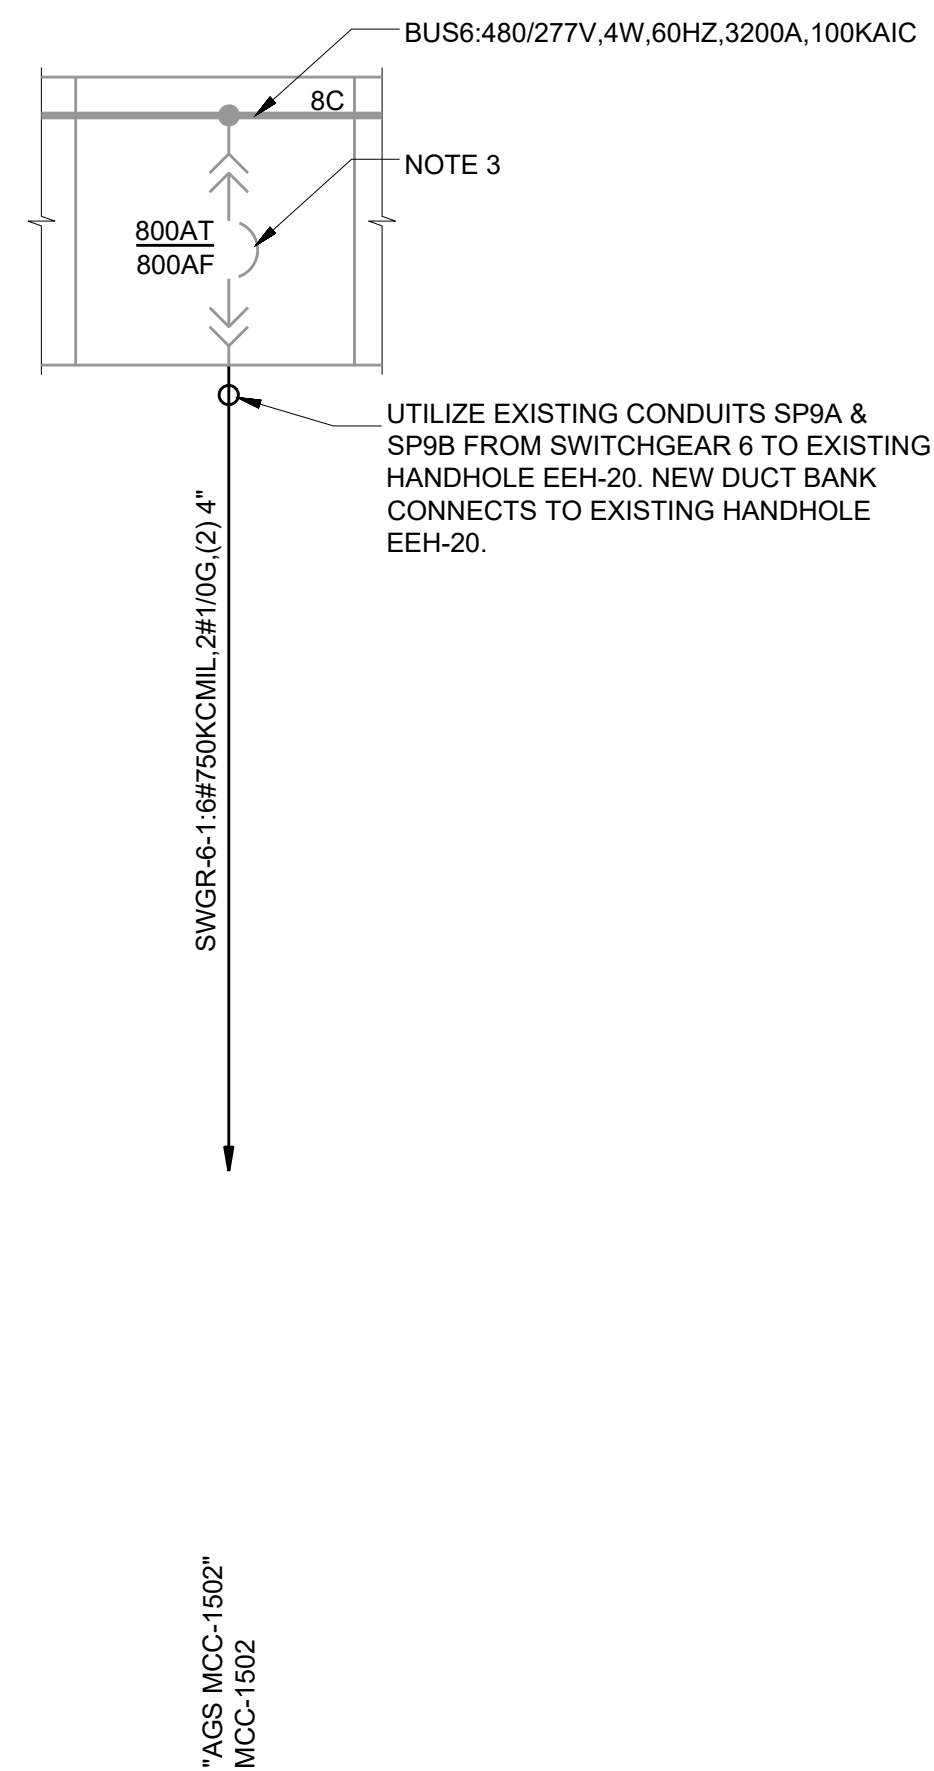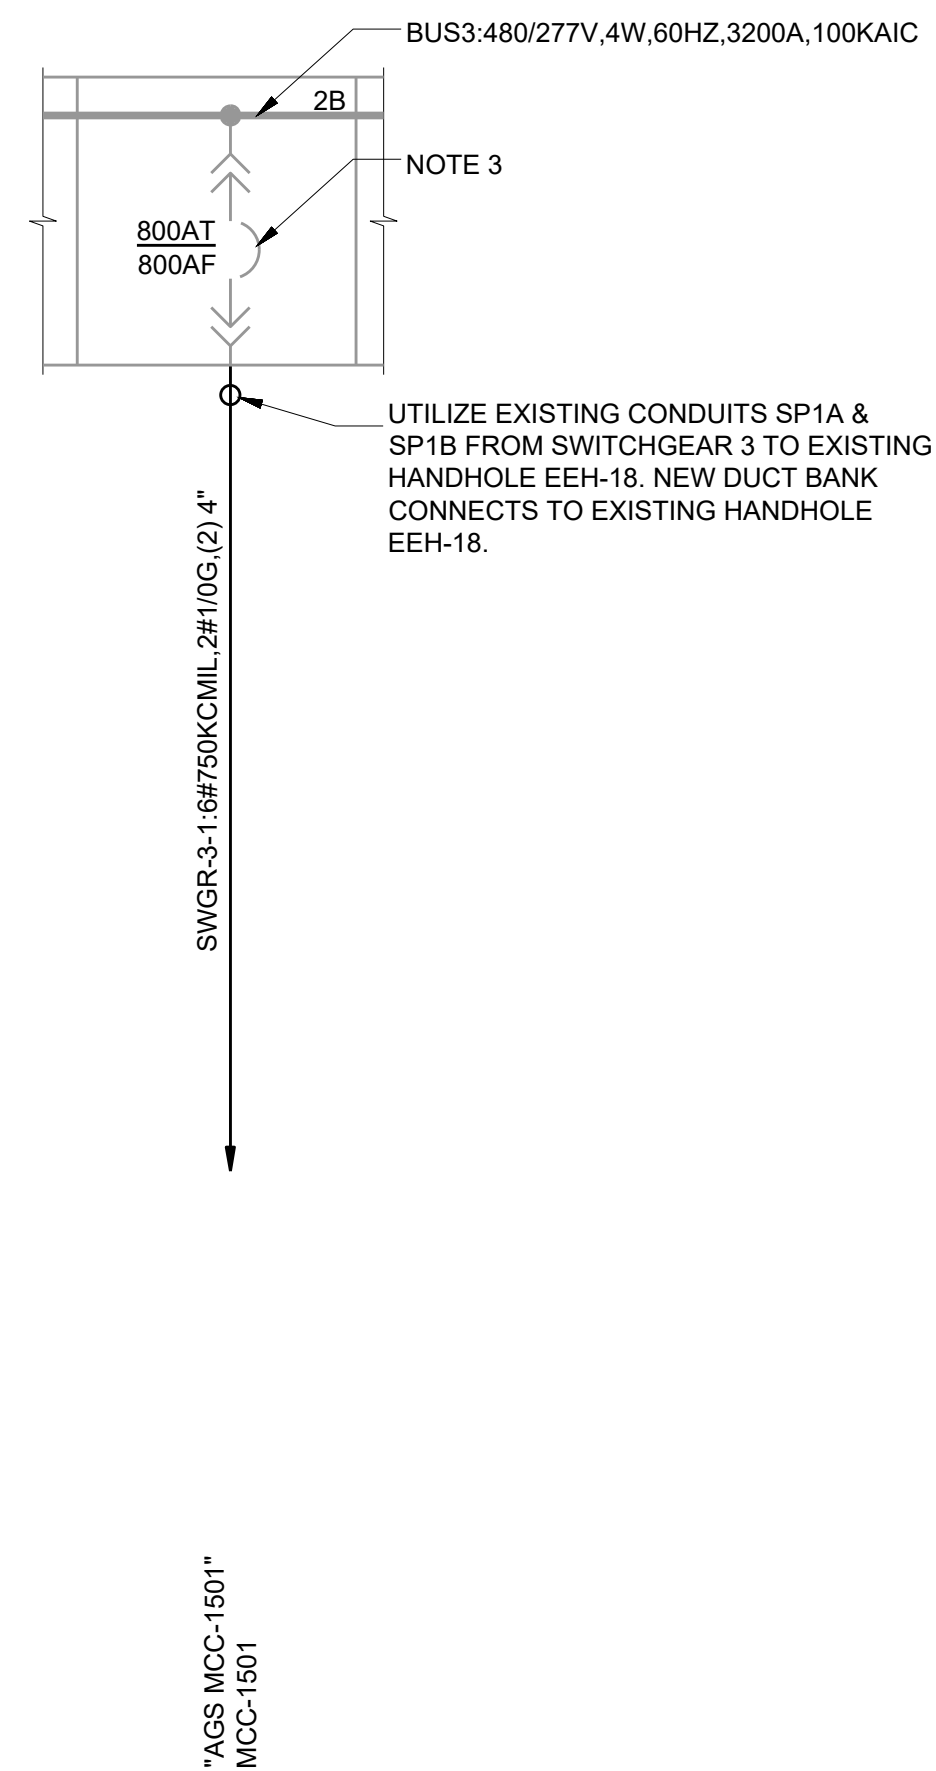

GENERAL SHEET NOTES

1. SEE DRAWINGS 00-E-001 AND 00-E-002 FOR LEGENDS, ABBREVIATIONS AND NOTES.
2. SWITCHGEAR NAMEPLATE WORDING IS SHOWN IN QUOTATION MARKS (") ON THE ONE-LINE DIAGRAM.
3. CONTRACTOR SHALL ADJUST TRIP SETTINGS FOR NEW BREAKERS PER THE POWER SYSTEMS STUDY RECOMMENDATIONS.



Black & Veatch Corporation
Chicago, Illinois
ILLINOIS PROFESSIONAL
DESIGN FIRM - 184.002143 -0006



AEROBIC GRANULAR
SLUDGE - PHASE 1

REVISIONS AND RECORD OF ISSUE

DESIGNED:	EJB
DETAILED:	SFR
CHECKED:	SDS
APPROVED:	EJB
DATE:	12/20/2022

PROJECT NO.: 411752

AGS SUPPORT FACILITIES


ELECTRICAL

SWITCHGEAR PARTIAL ONE-LINE DIAGRAMS


02-E-702

109
OF
163

PLOTTED: 12/16/2022 11:16 AM FILE: C:\pw_working\bwv_america\sd1495380\02-E-703.dwg
 PLOTTED: 12/16/2022 11:16 AM FILE: C:\pw_working\bwv_america\sd1495380\02-E-703.dwg

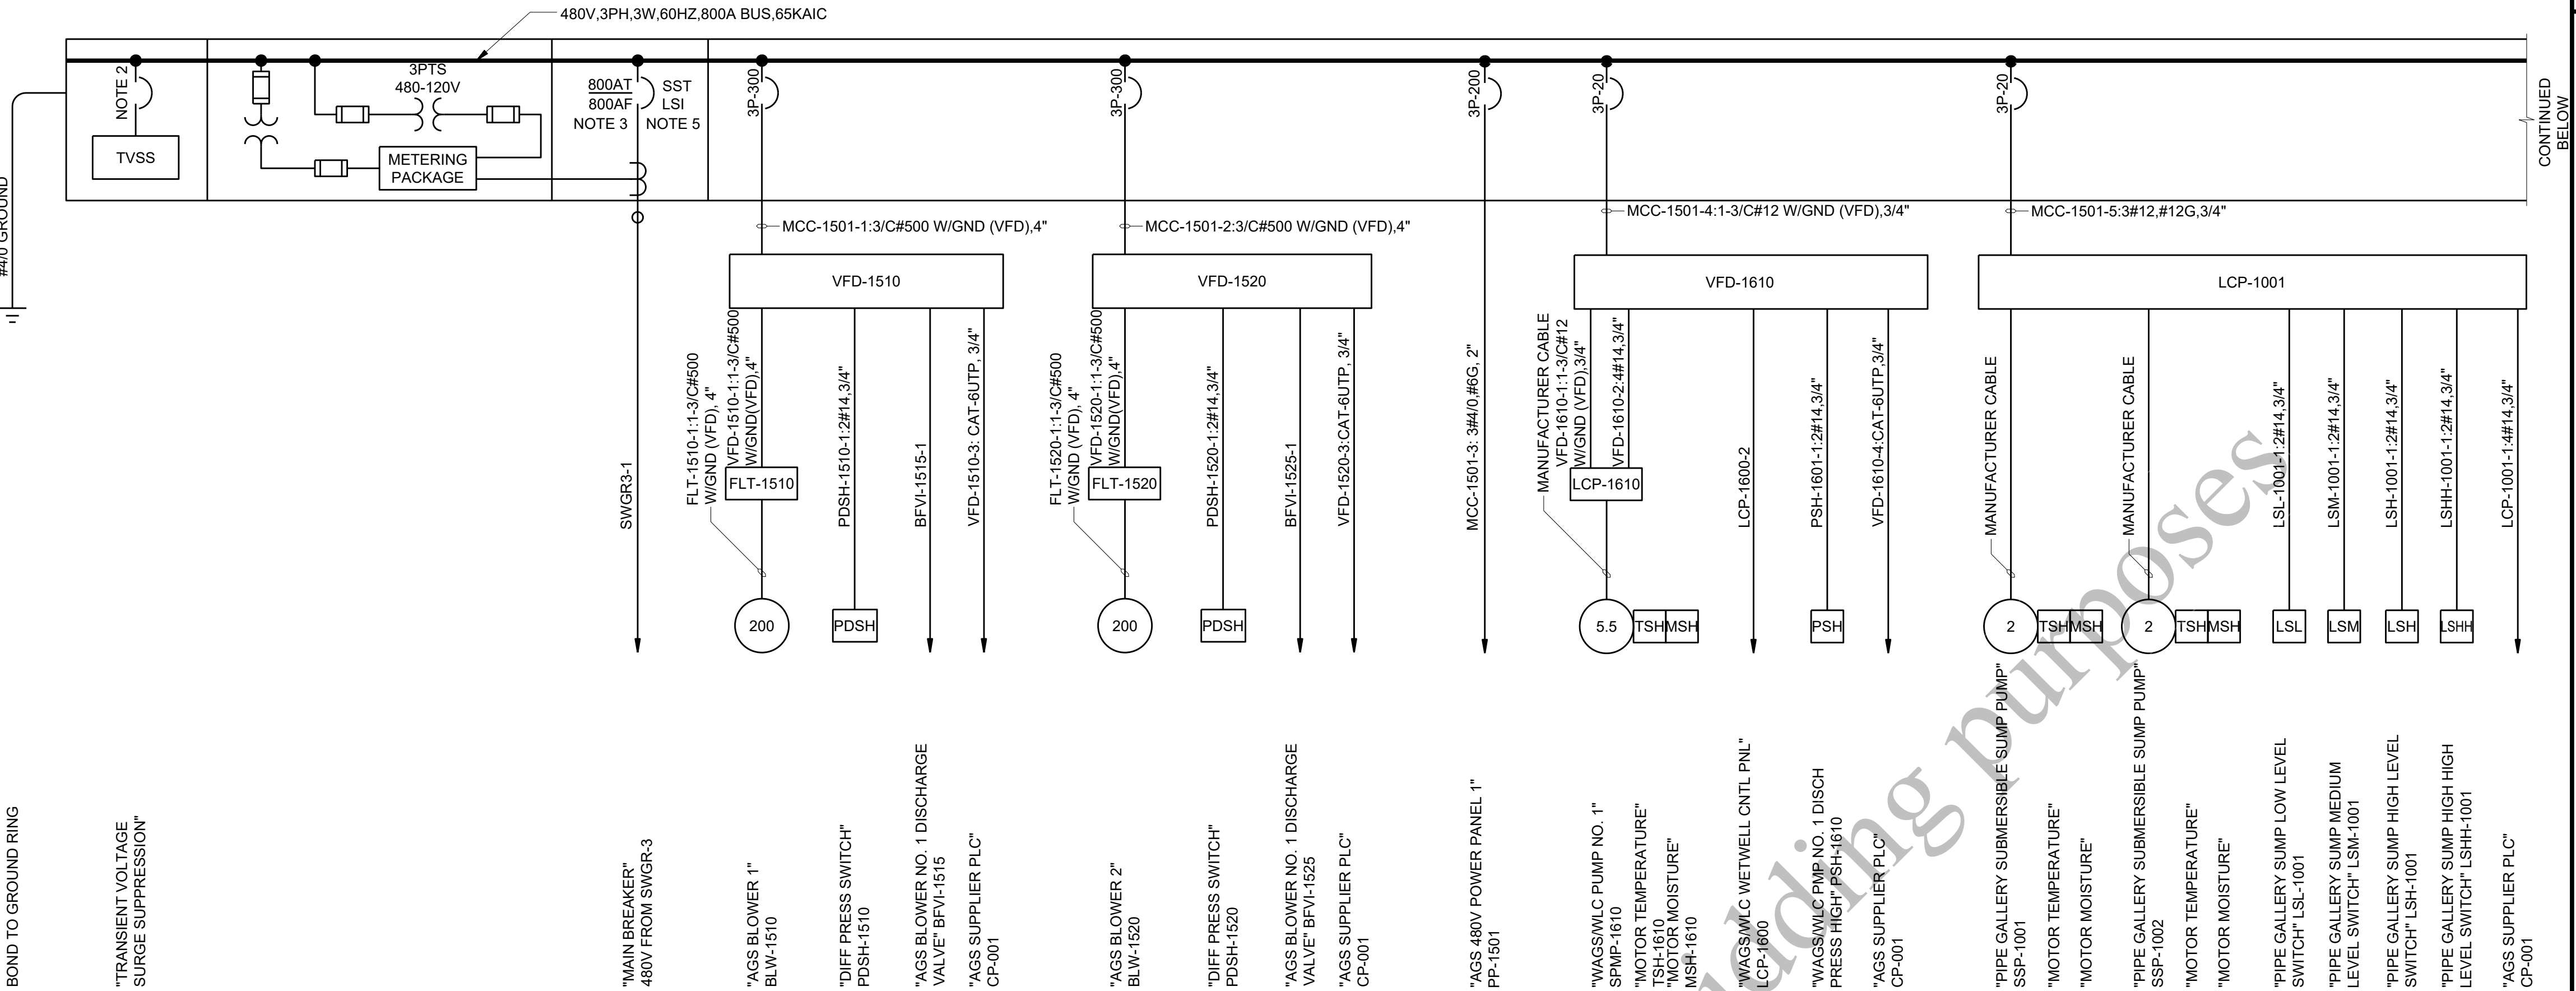

MCC-1501 ONE-LINE DIAGRAM
AGS SUPPORT FACILITIES

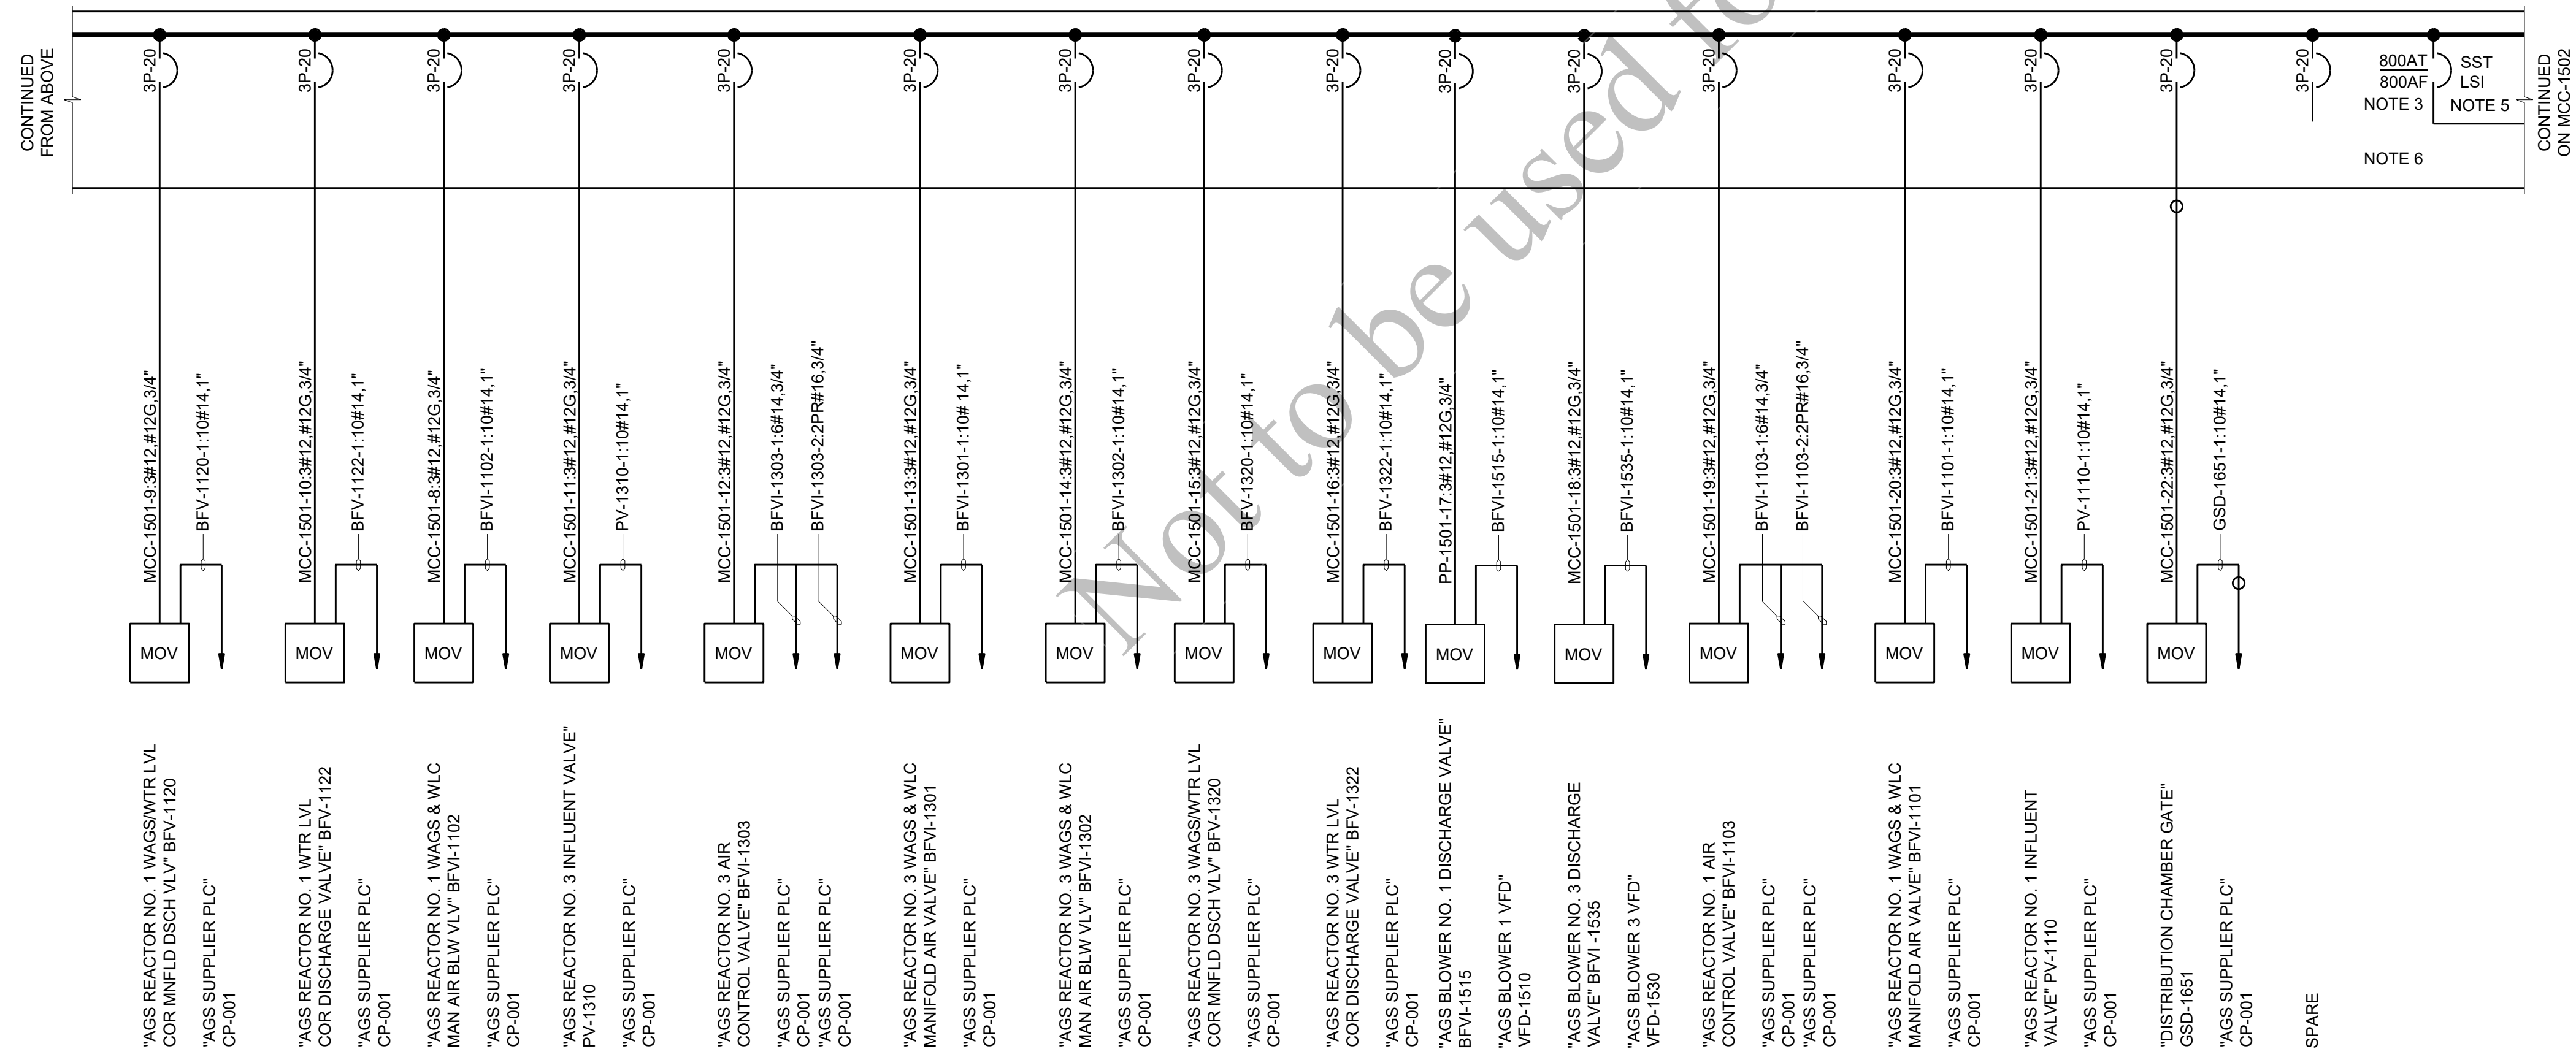

MCC-1501 ONE-LINE DIAGRAM
AGS ELECTRICAL ROOM

GENERAL SHEET NOTES

- SEE DRAWINGS 00-E-001 AND 00-E-002 FOR LEGENDS, ABBREVIATIONS AND NOTES.
- MCC NAMEPLATE WORDING IS SHOWN IN QUOTATION MARKS (" ") ON THE ONE-LINE DIAGRAM
- MCC MAIN AND TIE BREAKERS SHALL BE RATED TO OPERATE AT 800 AMPS CONTINUOUSLY.
- ALL TAGS ARE PREFACED BY "02" UNLESS OTHERWISE SHOWN.
- THE MAIN AND TIE BREAKER INSTANTANEOUS OVER CURRENT PICKUPS MUST COORDINATE WITH ALL FEEDER AND STARTER BREAKERS.
- SPARE SPACES SHALL BE PROCURED TO ACCOMMODATE 4 SIZE 2 MOTOR STARTERS.



Black & Veatch Corporation
Chicago, Illinois
ILLINOIS PROFESSIONAL
DESIGN FIRM - 184.002143 -0006



AEROBIC GRANULAR
SLUDGE - PHASE 1

REVISIONS AND RECORD OF ISSUE

DESIGNED:	EJB
DETAILED:	SFR
CHECKED:	SDS
APPROVED:	EJB
DATE:	12/20/2022

PROJECT NO.: 411752

AGS SUPPORT FACILITIES

ELECTRICAL


AGS MCC ONE-LINE
DIAGRAM

02-E-703


110
OF
163

(SCALE BAR IS 4" AT FULL SCALE) 0 1/2 1 2 3 4

PLOTTED: 12/16/2022 11:32 AM FILE: C:\pw_working\bw_america\id1495380\02-E-704.dwg
 PLOT FILE: 02-E-704.dwg

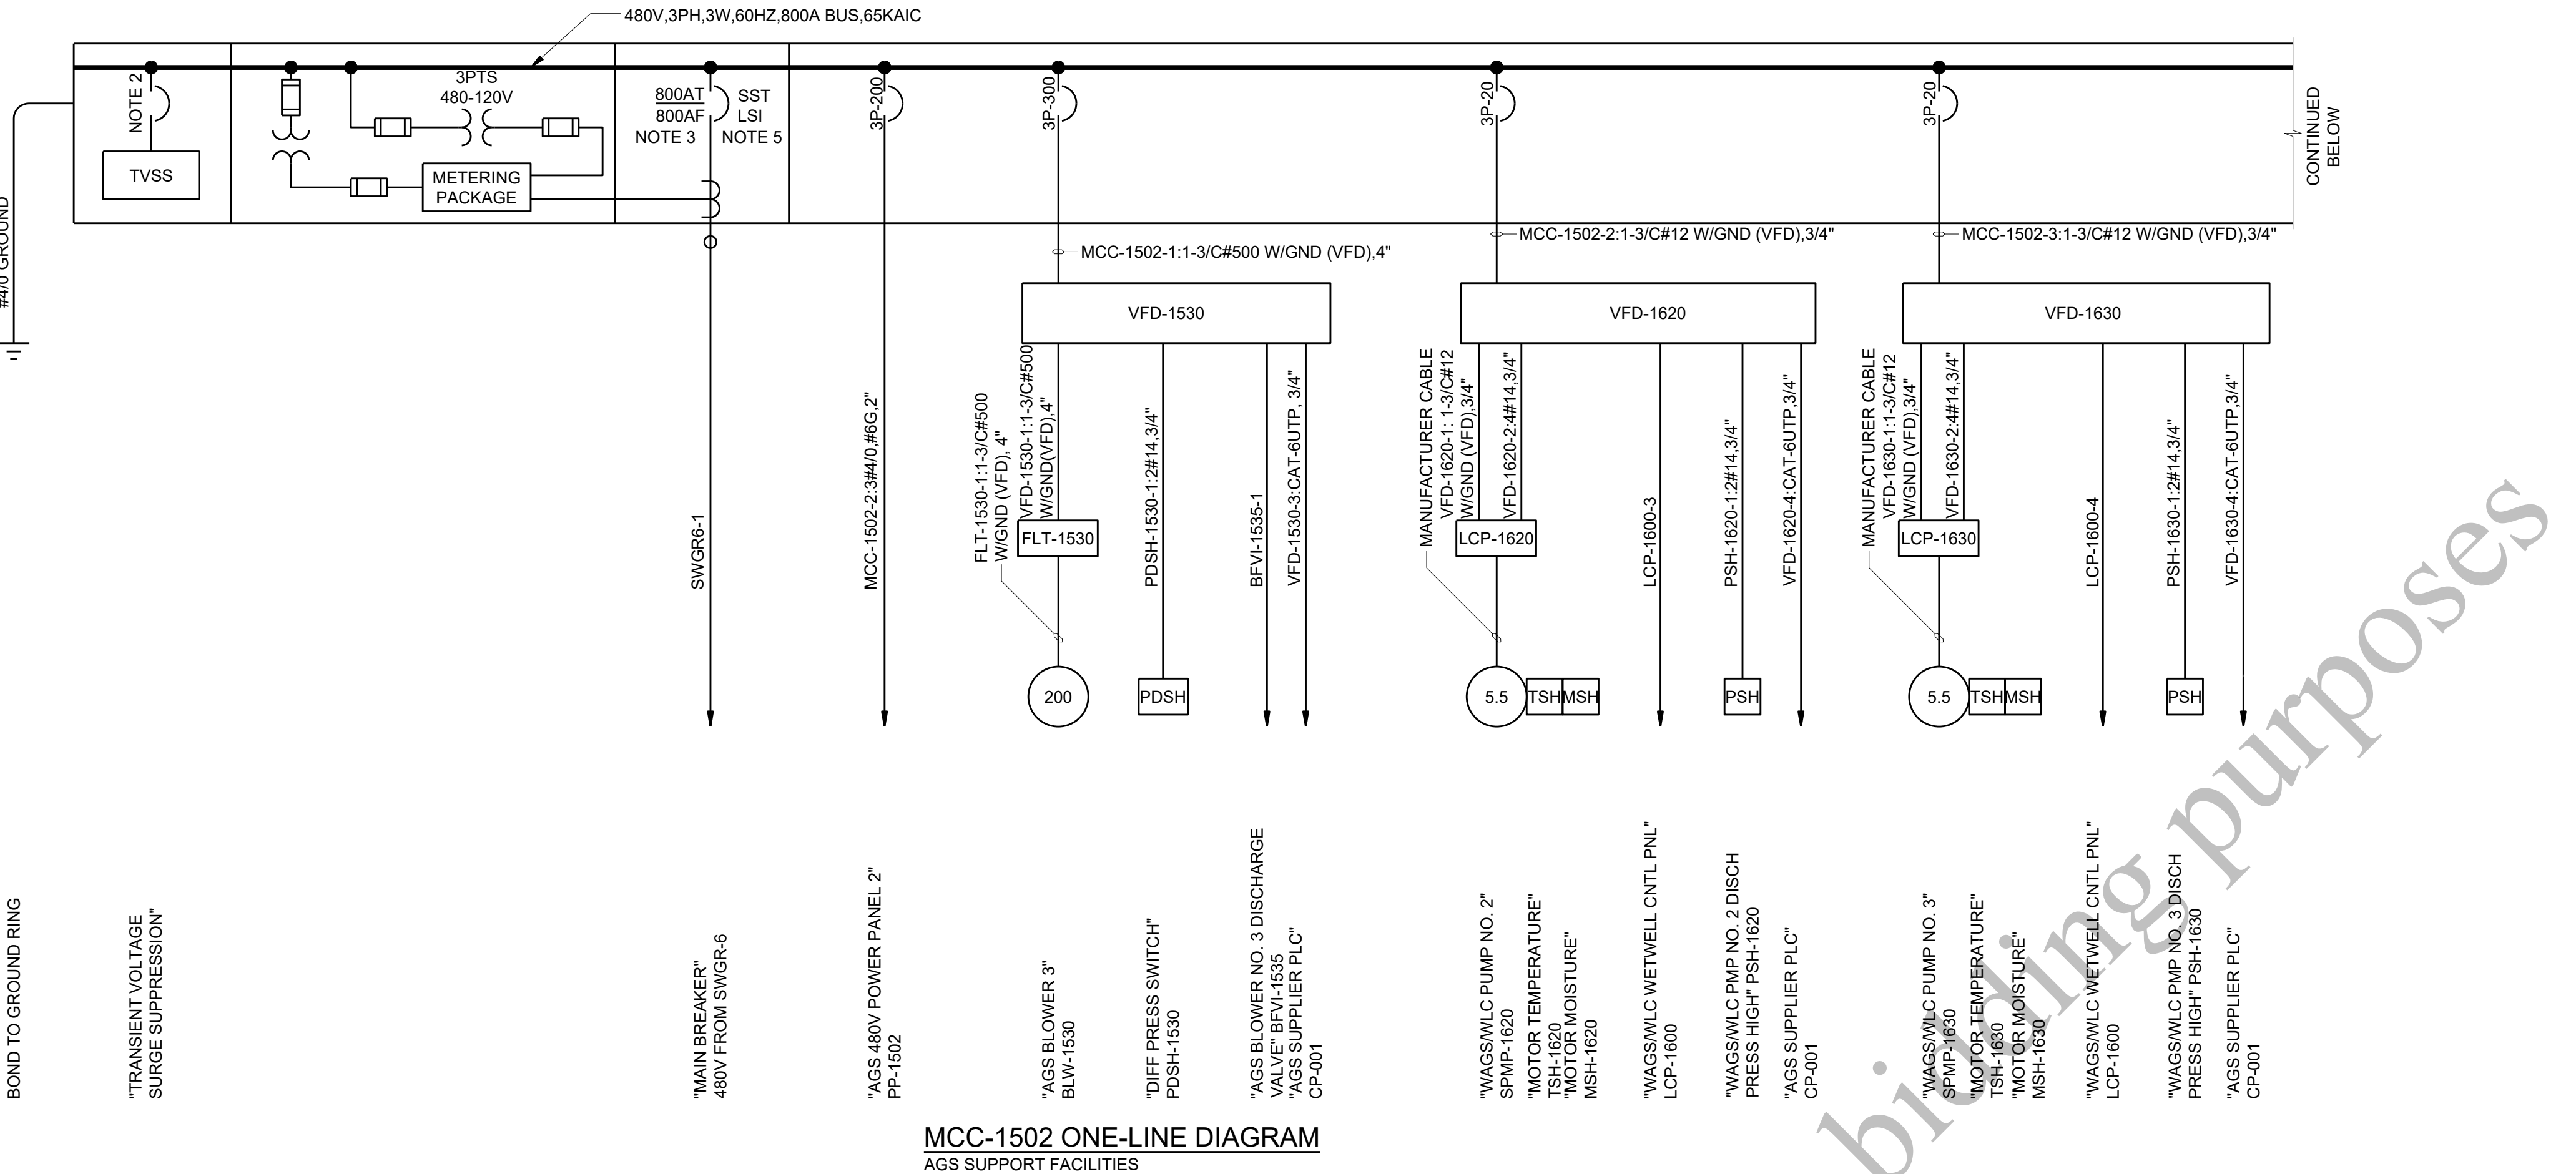

MCC-1502 ONE-LINE DIAGRAM
AGS SUPPORT FACILITIES

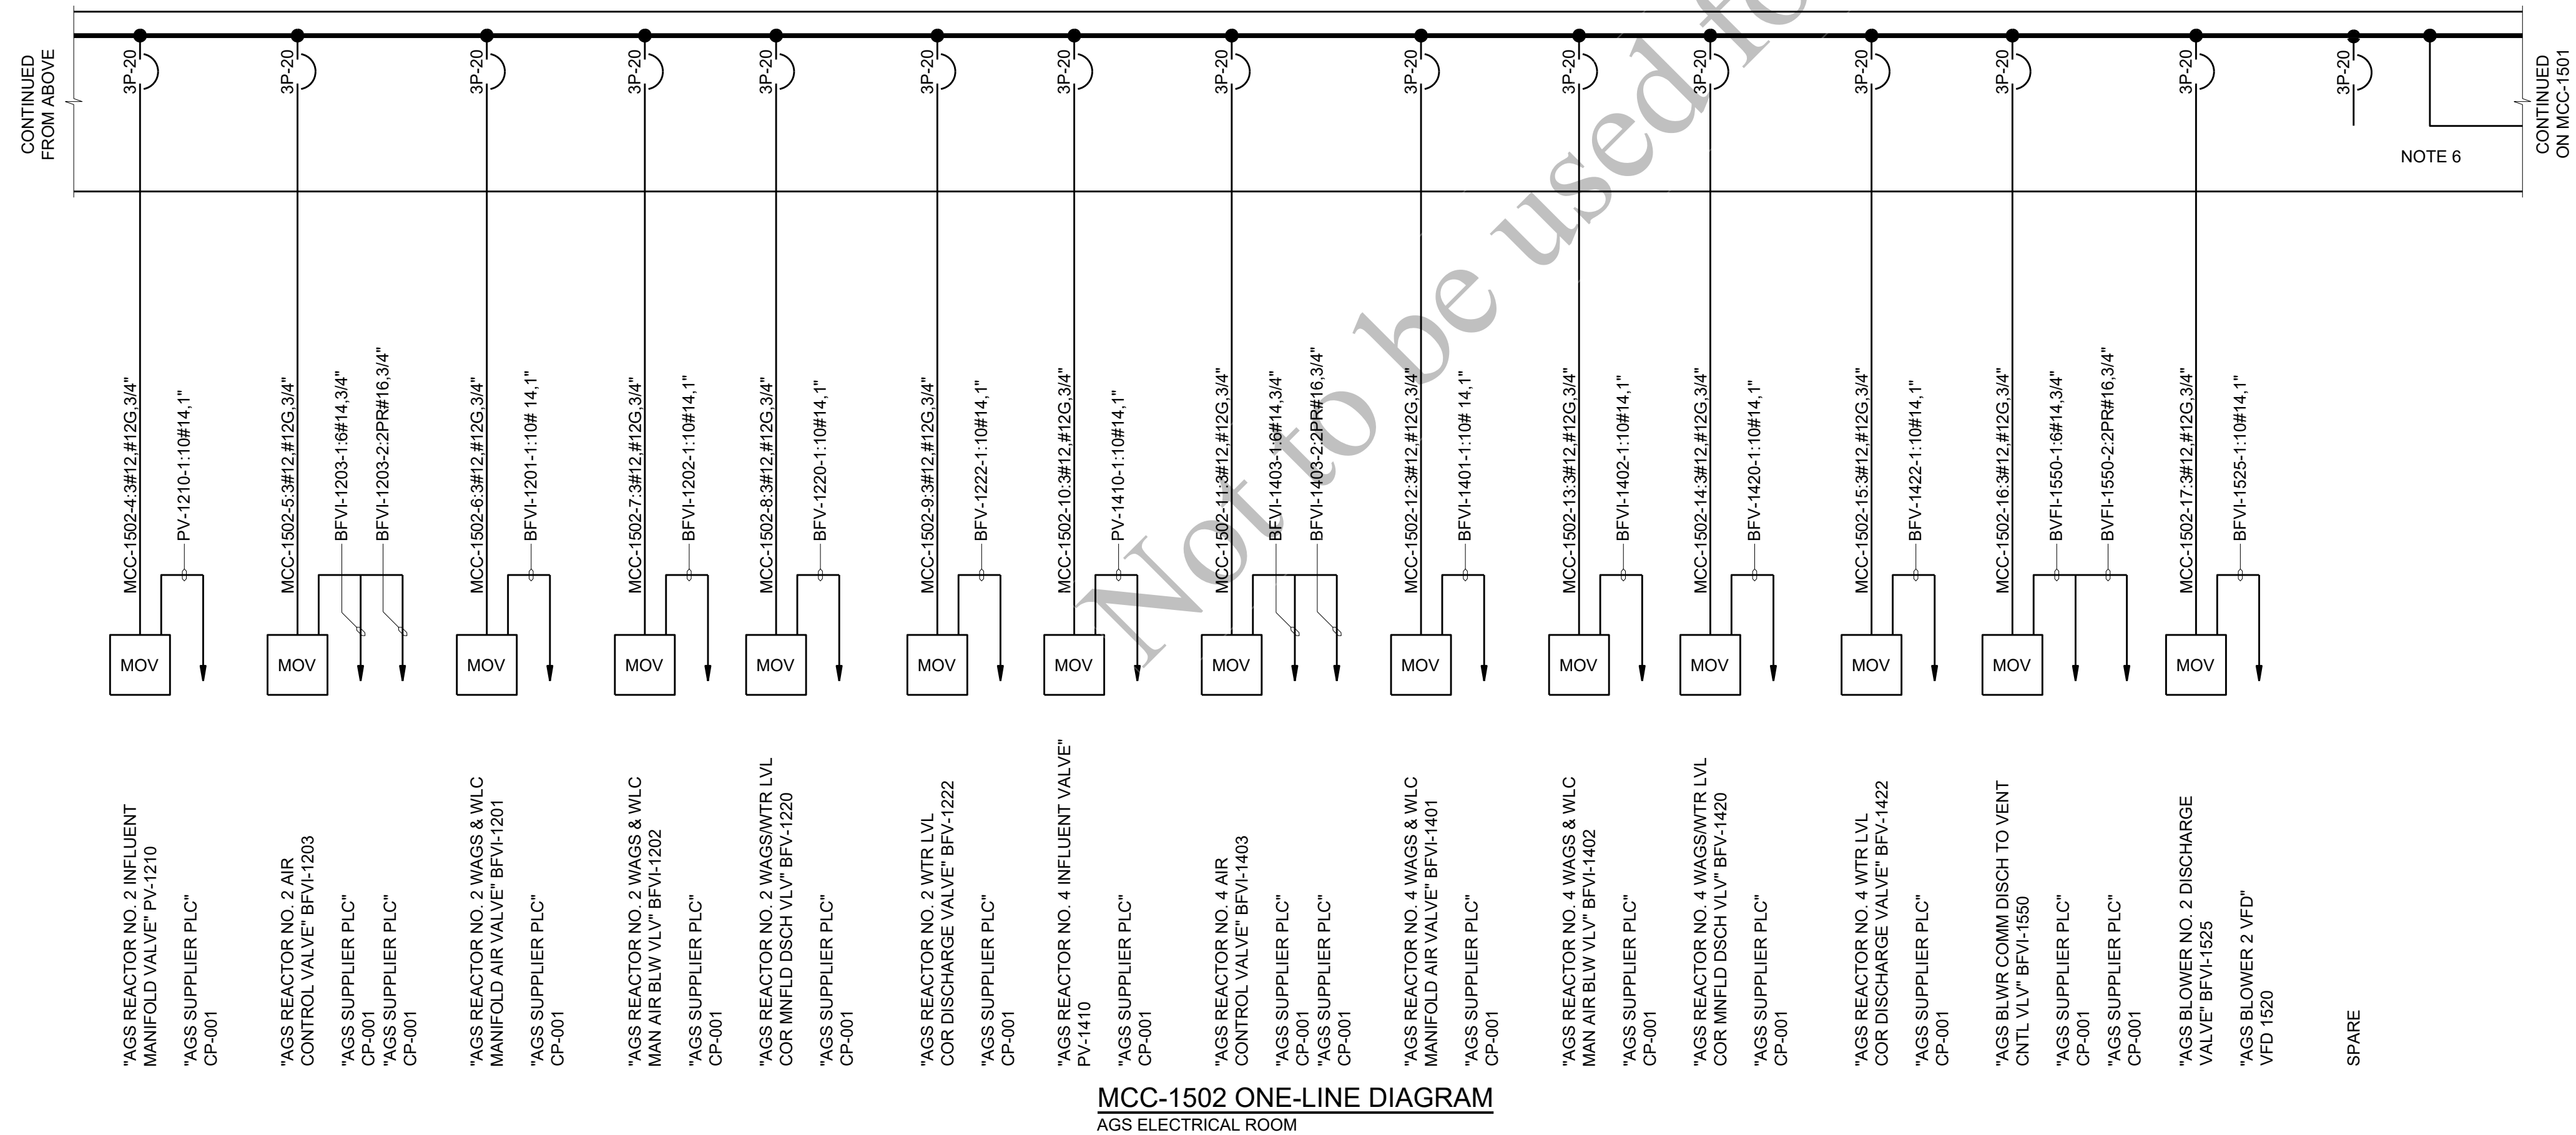

MCC-1502 ONE-LINE DIAGRAM
AGS ELECTRICAL ROOM

GENERAL SHEET NOTES

- SEE DRAWINGS 00-E-001 AND 00-E-002 FOR LEGENDS, ABBREVIATIONS AND NOTES.
- MCC NAMEPLATE WORDING IS SHOWN IN QUOTATION MARKS (" ") ON THE ONE-LINE DIAGRAM
- MCC MAIN AND TIE BREAKERS SHALL BE RATED TO OPERATE AT 800 AMPS CONTINUOUSLY.
- ALL TAGS ARE PREFACED BY "02" UNLESS OTHERWISE SHOWN.
- THE MAIN AND TIE BREAKER INSTANTANEOUS OVER CURRENT PICKUPS MUST COORDINATE WITH ALL FEEDER AND STARTER BREAKERS.
- SPARE SPACES SHALL BE PROCURED TO ACCOMMODATE 3 SIZE 2 MOTOR STARTERS.



Black & Veatch Corporation
Chicago, Illinois
ILLINOIS PROFESSIONAL
DESIGN FIRM - 184.002143 -0006



AEROBIC GRANULAR
SLUDGE - PHASE 1

REVISIONS AND RECORD OF ISSUE	
DESIGNED:	EJB
DETAILED:	SFR
CHECKED:	SDS
APPROVED:	EJB
DATE:	12/20/2022

PROJECT NO.: 411752

AGS SUPPORT FACILITIES

ELECTRICAL



AGS MCC ONE-LINE
DIAGRAM

02-E-704

111
OF
163

(SCALE BAR IS 4" AT FULL SCALE) 0 1/2 1 2 3 4

PLOTTED

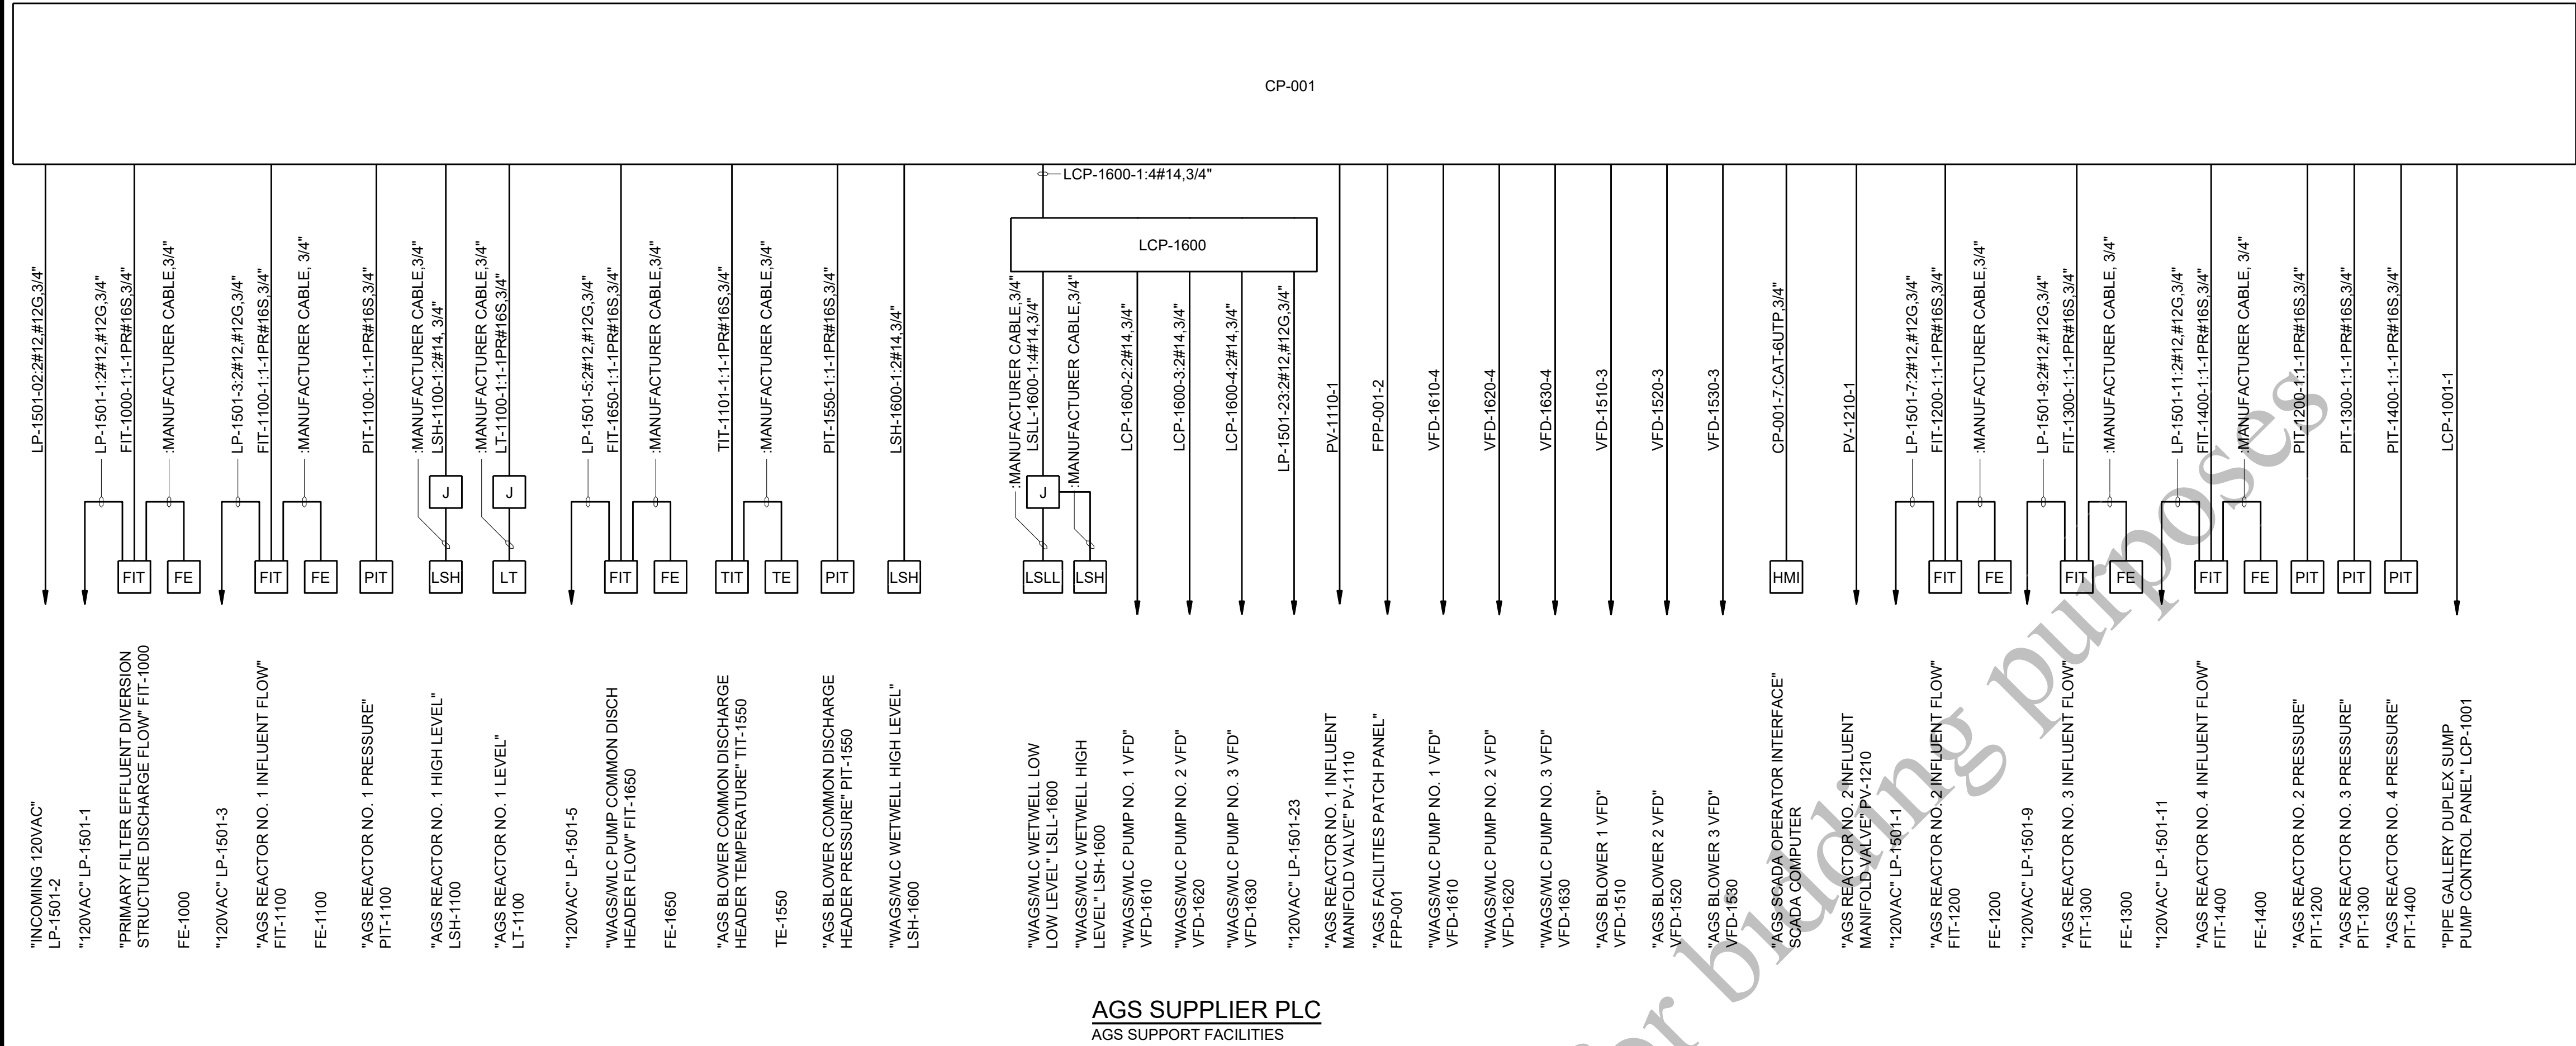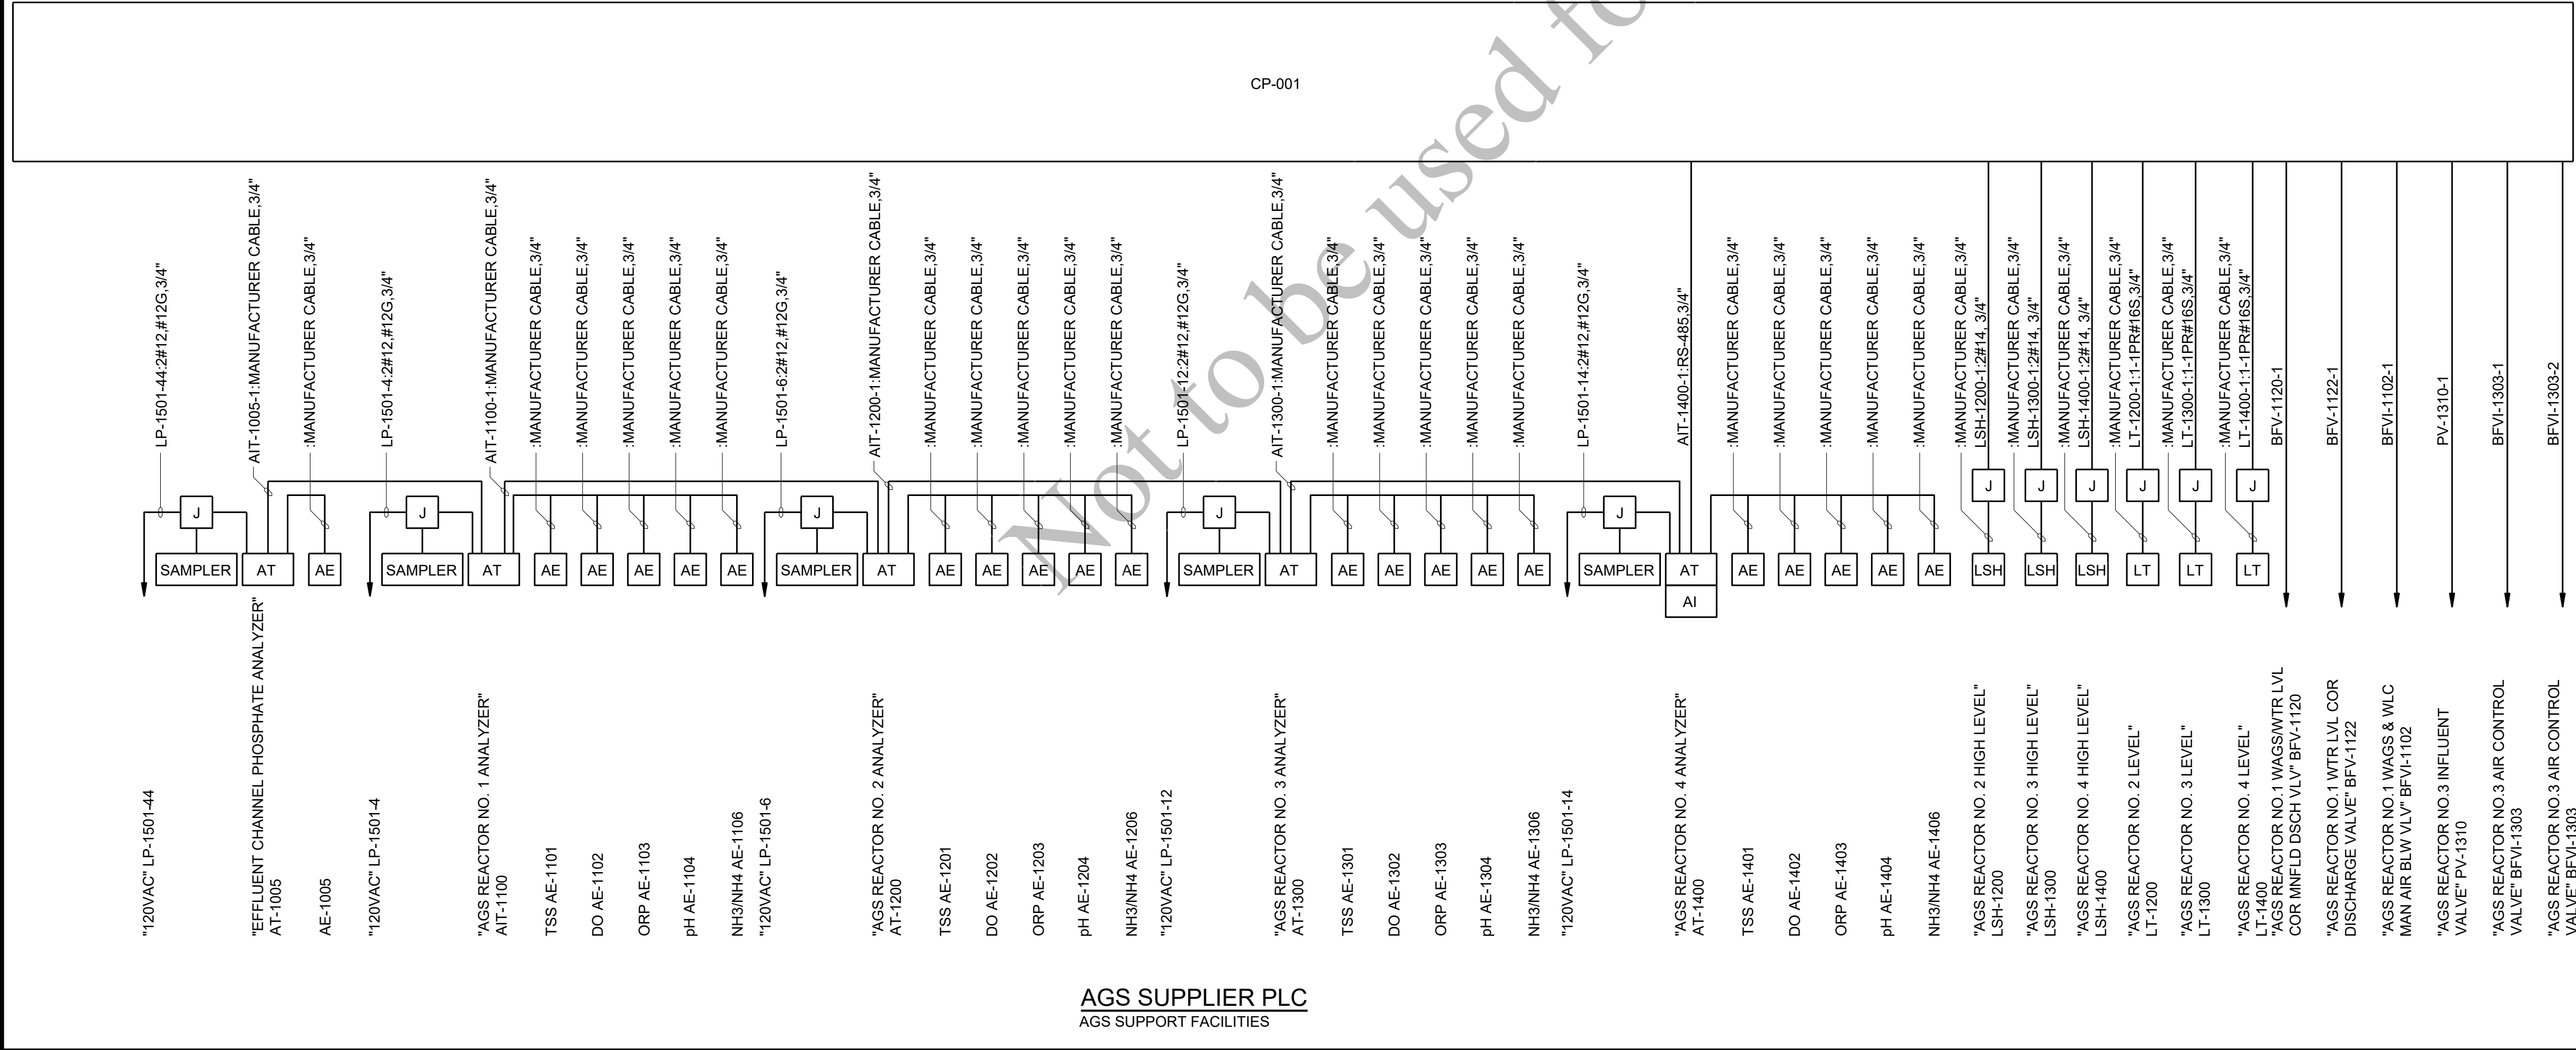

GENERAL SHEET NOTES

1. SEE SPECIFICATION SECTION 23 09 11 FOR COMPLETE HVAC CONTROL SYSTEM CABLES, INTERCONNECTIONS, AND REQUIREMENTS.
2. ALL TAGS ARE PREFACED BY "02" UNLESS OTHERWISE SHOWN.



Black & Veatch Corporation
Chicago, Illinois
ILLINOIS PROFESSIONAL
DESIGN FIRM - 184.002143 -0006



AEROBIC GRANULAR SLUDGE - PHASE 1

[illegible]

AGS SUPPORT FACILITIES

ELECTRICAL

AGS PLC ONE-LINE DIAGRAM

02-E-705

112
OF
163





1. SEE SPECIFICATION SECTION 23 09 11 FOR COMPLETE HVAC CONTROL SYSTEM CABLES, INTERCONNECTIONS, AND REQUIREMENTS.
2. ALL TAGS ARE PREFACED BY "02" UNLESS OTHERWISE SHOWN.
3. FIBER PATCH PANEL IN "FIBER MANHOLE 30", FURNISHED AND INSTALLED BY OTHERS.



Black & Veatch Corporation
Chicago, Illinois
ILLINOIS PROFESSIONAL
DESIGN FIRM - 184.002143 -0006



AEROBIC GRANULAR SLUDGE - PHASE 1

REVISIONS AND RECORD OF ISSUE

DESIGNED:	EJB
DETAILED:	SFR
CHECKED:	SDS
APPROVED:	EJB
DATE:	12/20/2022
PROJECT NO.:	411752

PROJECT NO.: 411752

AGS SUPPORT FACILITIES


ELECTRICAL

AGS PLC ONE-LINE DIAGRAMS


02-E-706

113
OF
163

PLOTTED: 12/16/2022 11:39 AM FILE: C:\pw_working\bwv_america\sl495380\02-E-707.dwg
 PLOTTED: 12/16/2022 11:39 AM FILE: C:\pw_working\bwv_america\sl495380\02-E-707.dwg

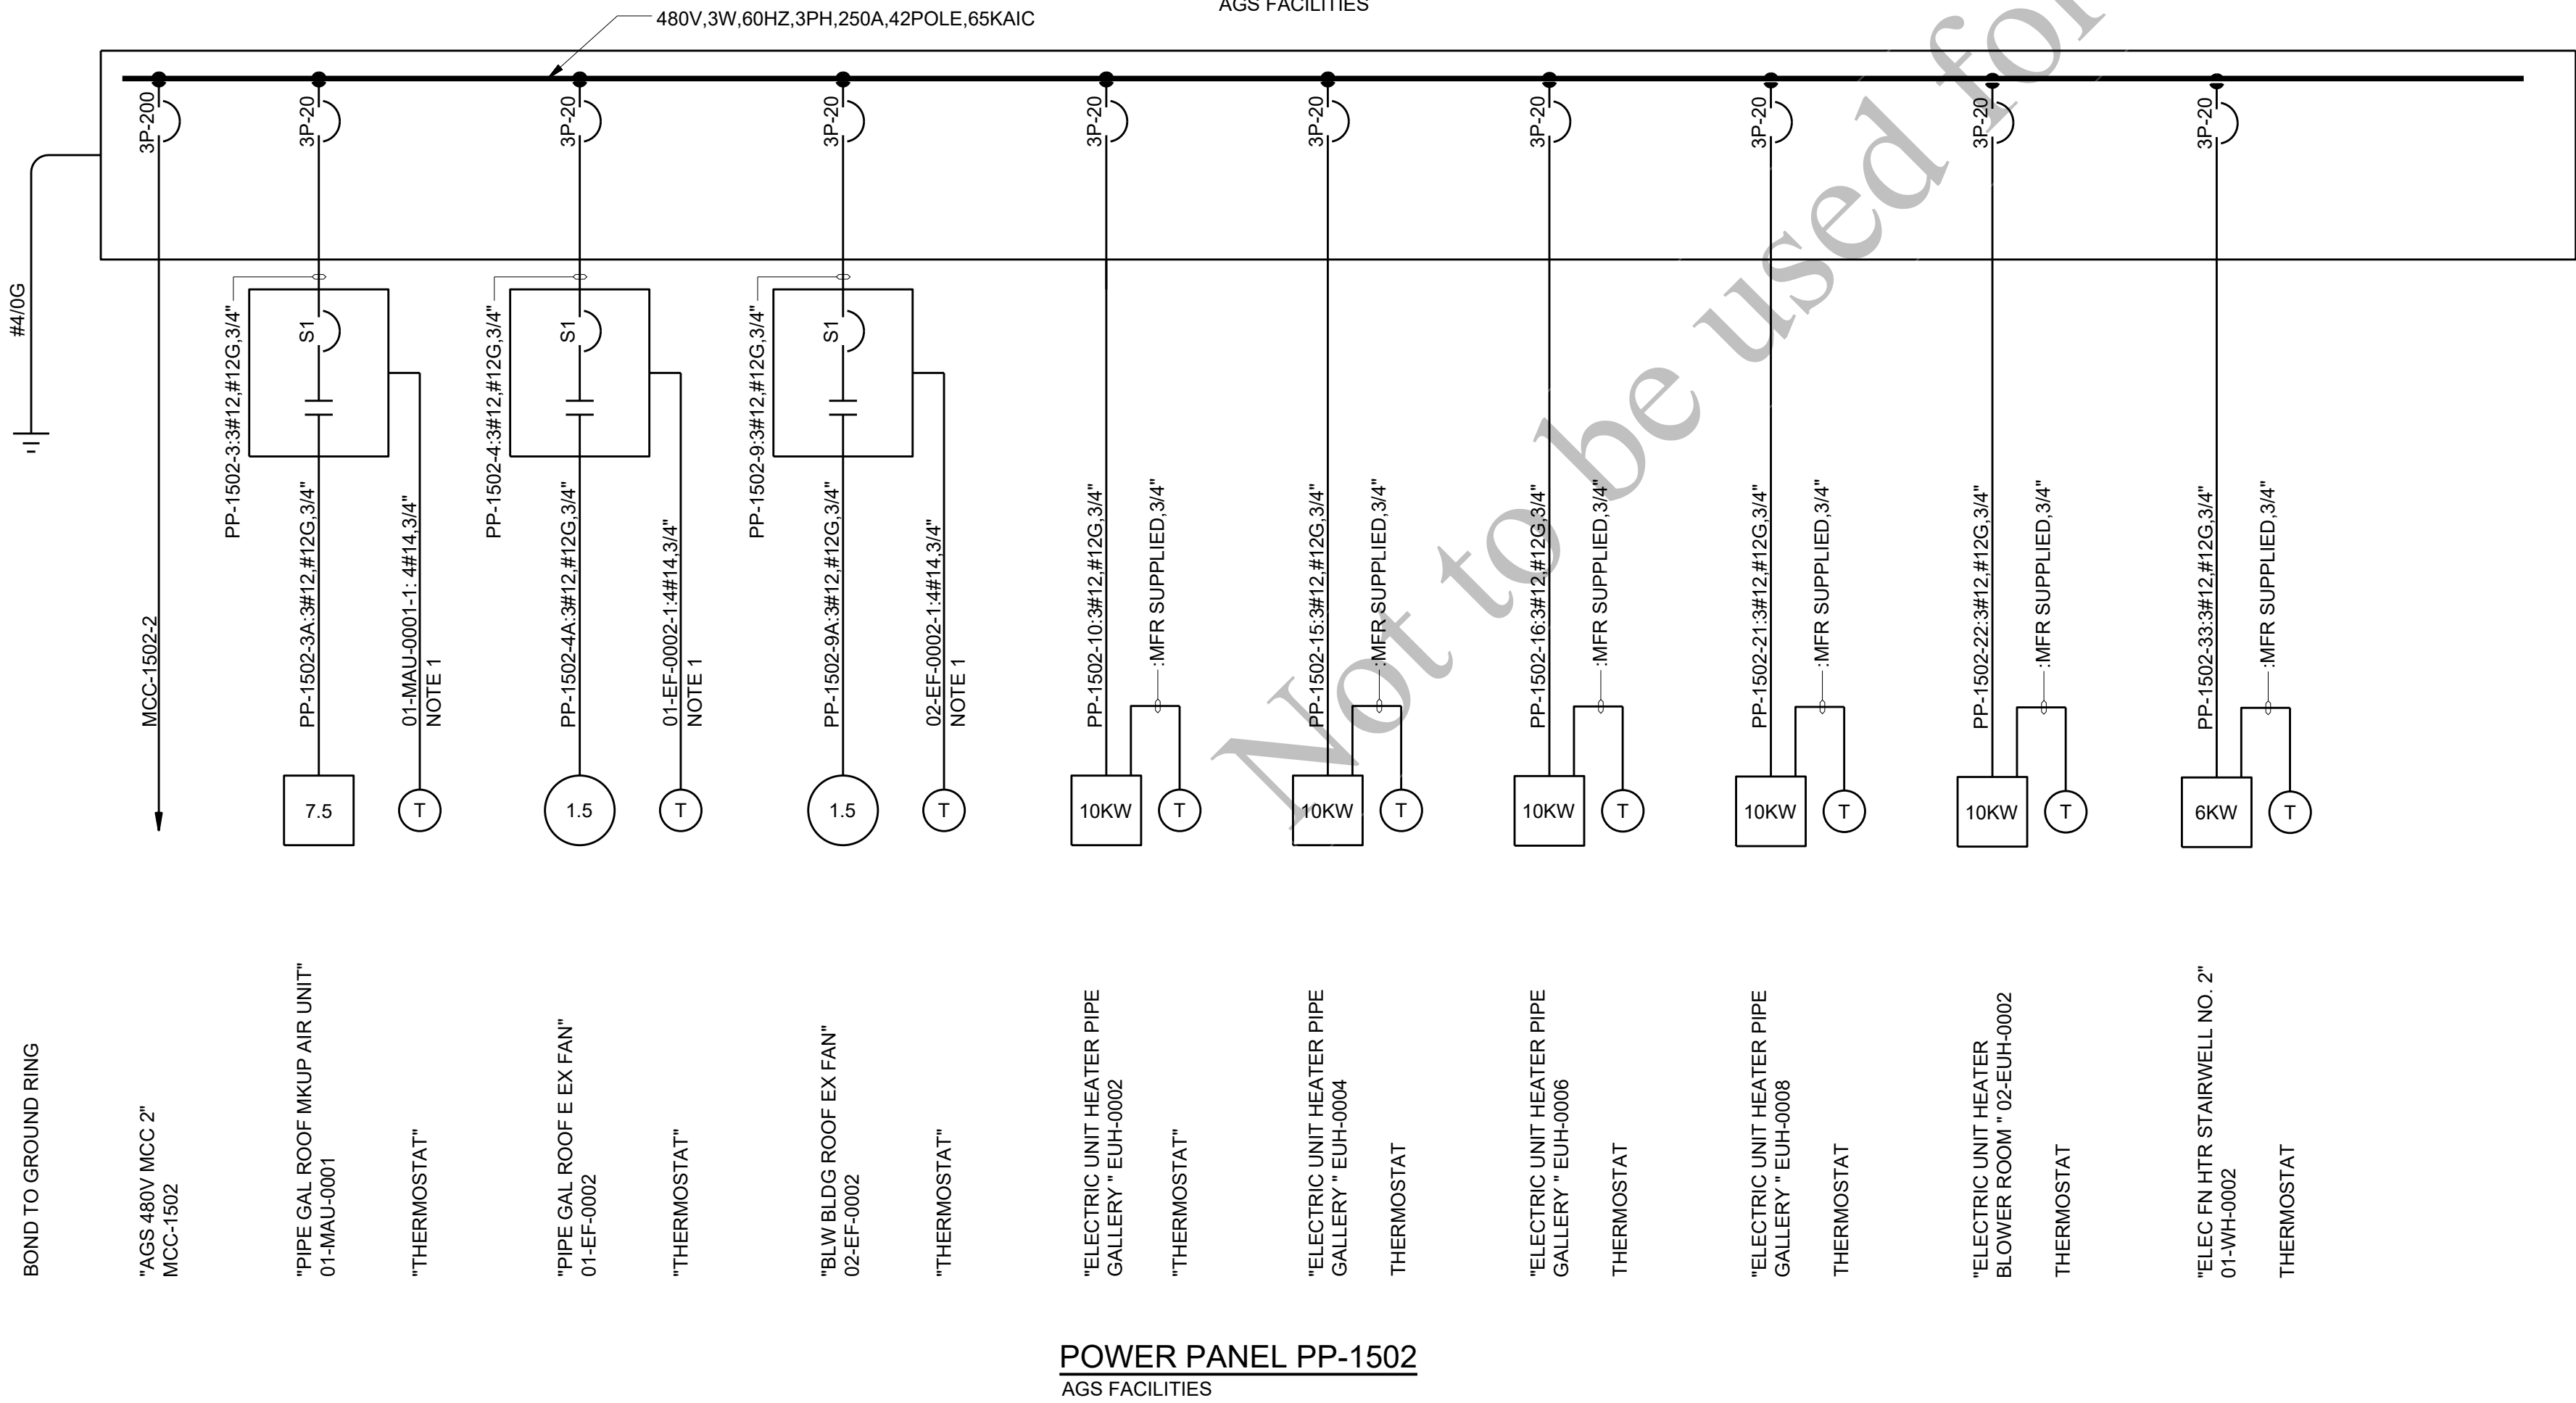

POWER PANEL PP-1502
AGS FACILITIES

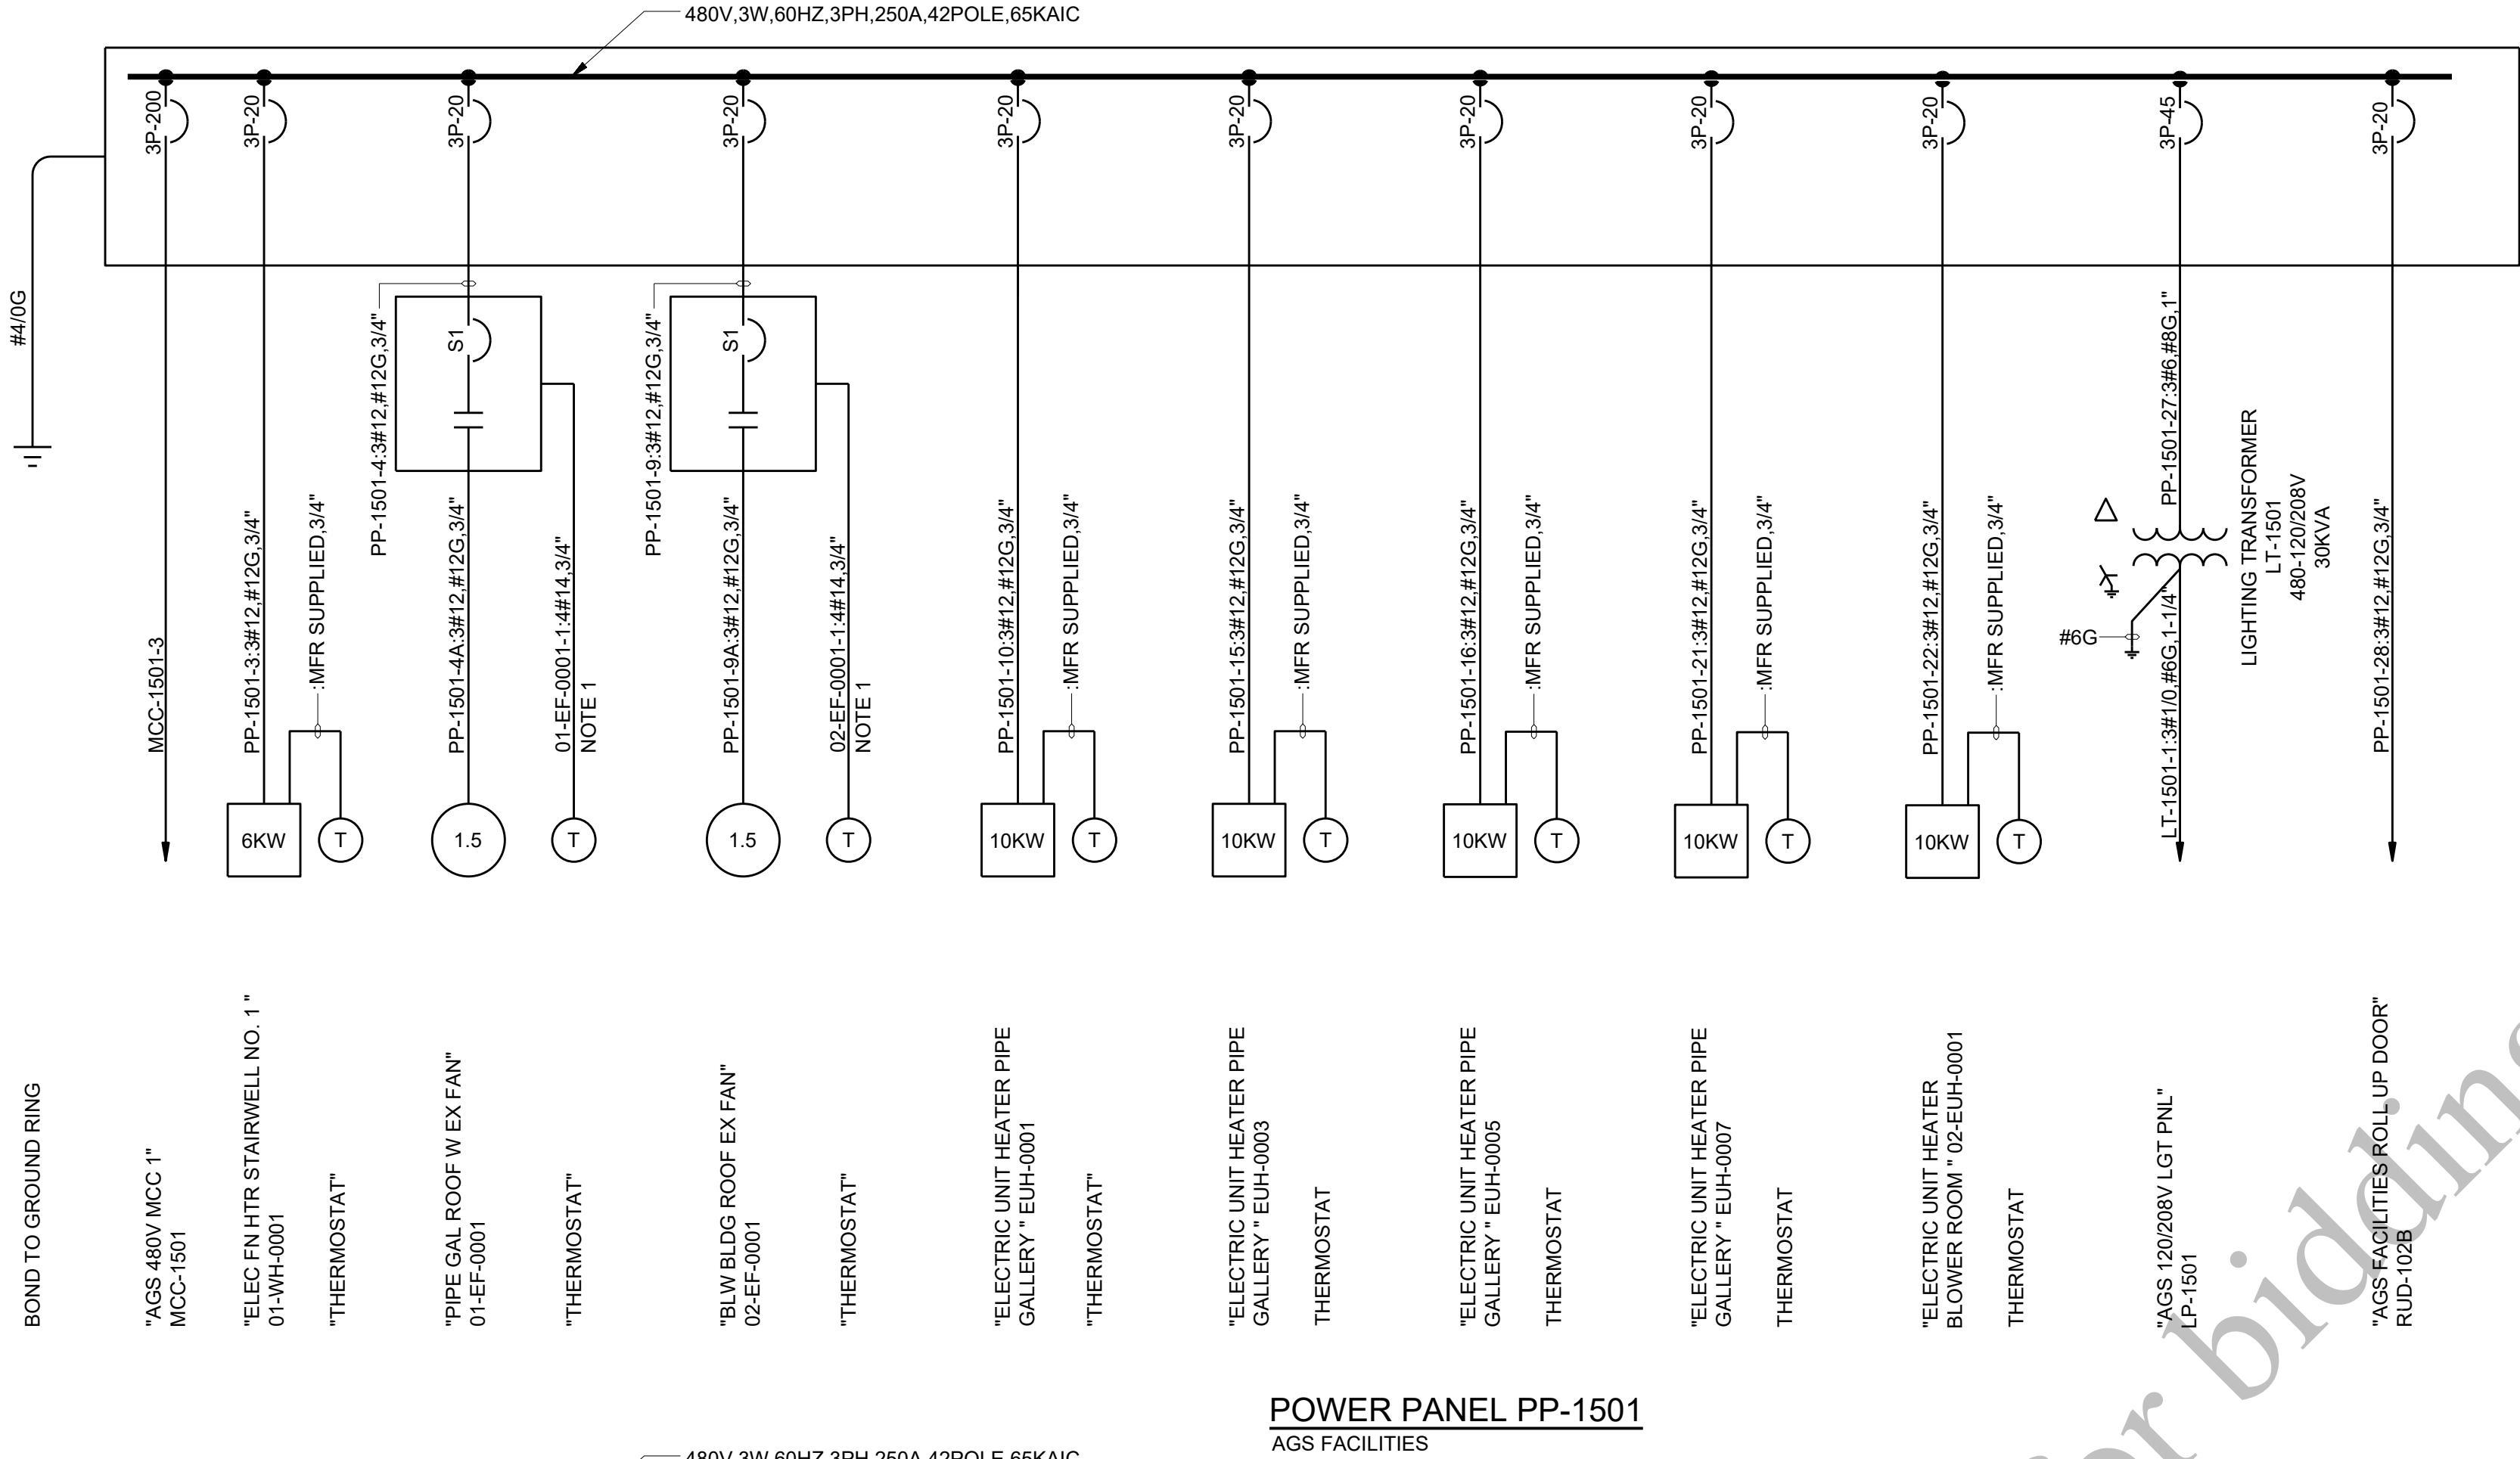

POWER PANEL PP-1501
AGS FACILITIES

GENERAL SHEET NOTES

- SEE SPECIFICATION SECTION 23 09 11 FOR COMPLETE HVAC CONTROL SYSTEM CABLES, INTERCONNECTIONS, AND REQUIREMENTS.
- ALL TAGS ARE PREFACED BY "02" UNLESS OTHERWISE SHOWN.



Black & Veatch Corporation
Chicago, Illinois
ILLINOIS PROFESSIONAL
DESIGN FIRM - 184.002143 -0006



AEROBIC GRANULAR
SLUDGE - PHASE 1

REVISIONS AND RECORD OF ISSUE	
DESIGNED:	EJB
DETAILED:	SFR
CHECKED:	SDS
APPROVED:	EJB
DATE:	12/20/2022

PROJECT NO.: 411752

AGS SUPPORT FACILITIES


ELECTRICAL

AGS POWER PANEL
ONE-LINE DIAGRAM

02-E-707

114
OF
163

PLOTTED: 12/16/2022 12:01 PM
 FILE: C:\pw_working\bwv_america\495380\02-E-708.dwg
 PLOTTED: 12/16/2022 12:01 PM
 FILE: C:\pw_working\bwv_america\495380\02-E-708.dwg

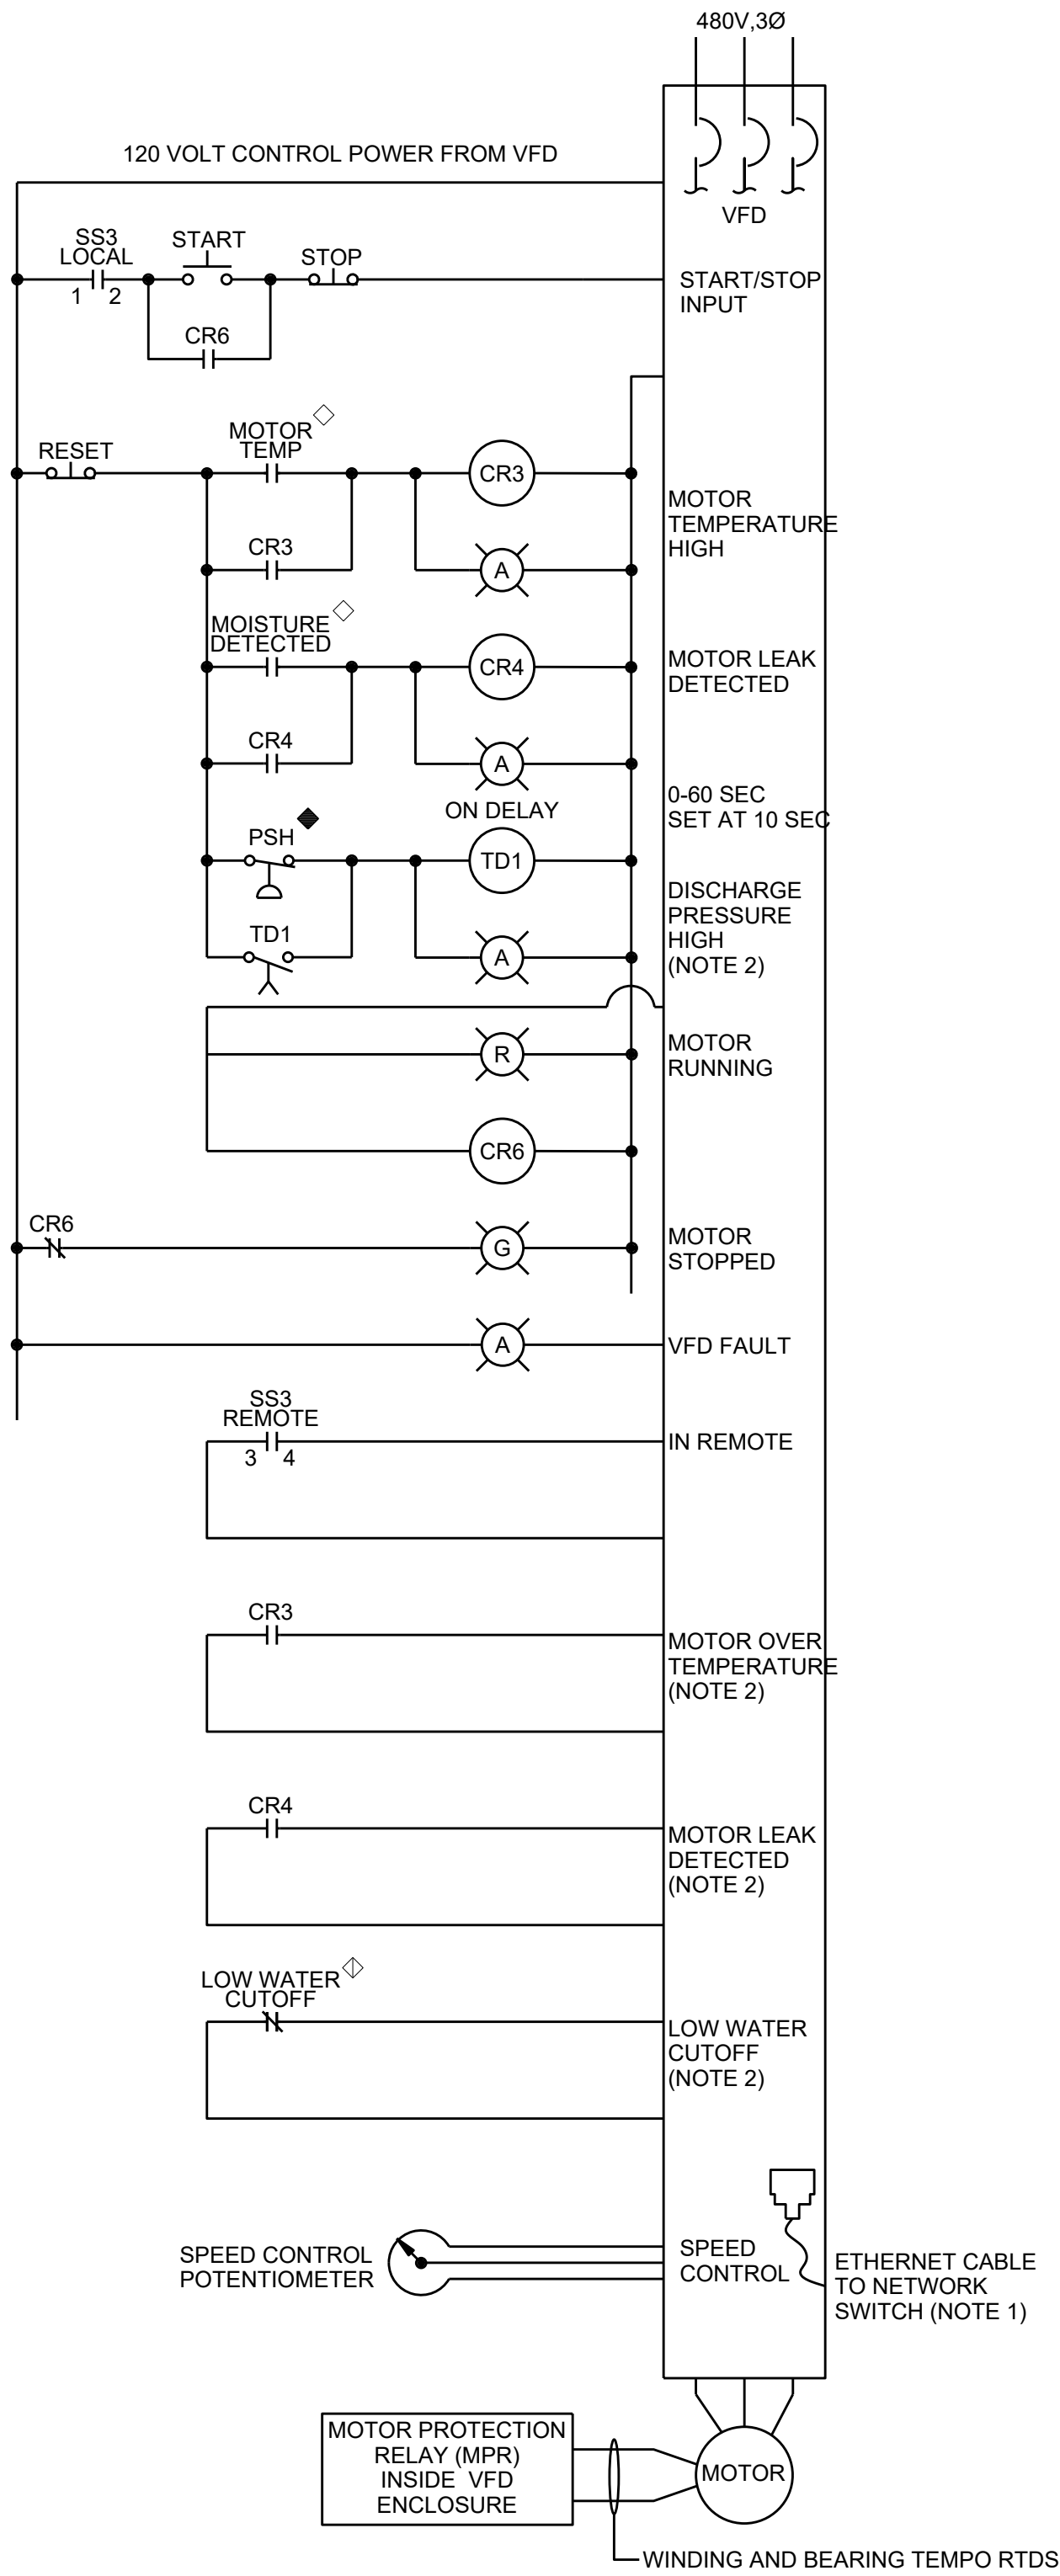


WAGS/WLC WETWELL PUMP 02-VFD-1610
SIMILAR FOR VFD-1620 AND VFD-1630


SWITCH DEVELOPEMENT:

SS3		POSITION		
CONTACTS		LOCAL	OFF	REMOTE
1-2		X		
3-4				X


SS1 & SS2		POSITION		
CONTACTS		TEST	OFF	AUTO
1-2		X		
3-4				X
5-6			X	

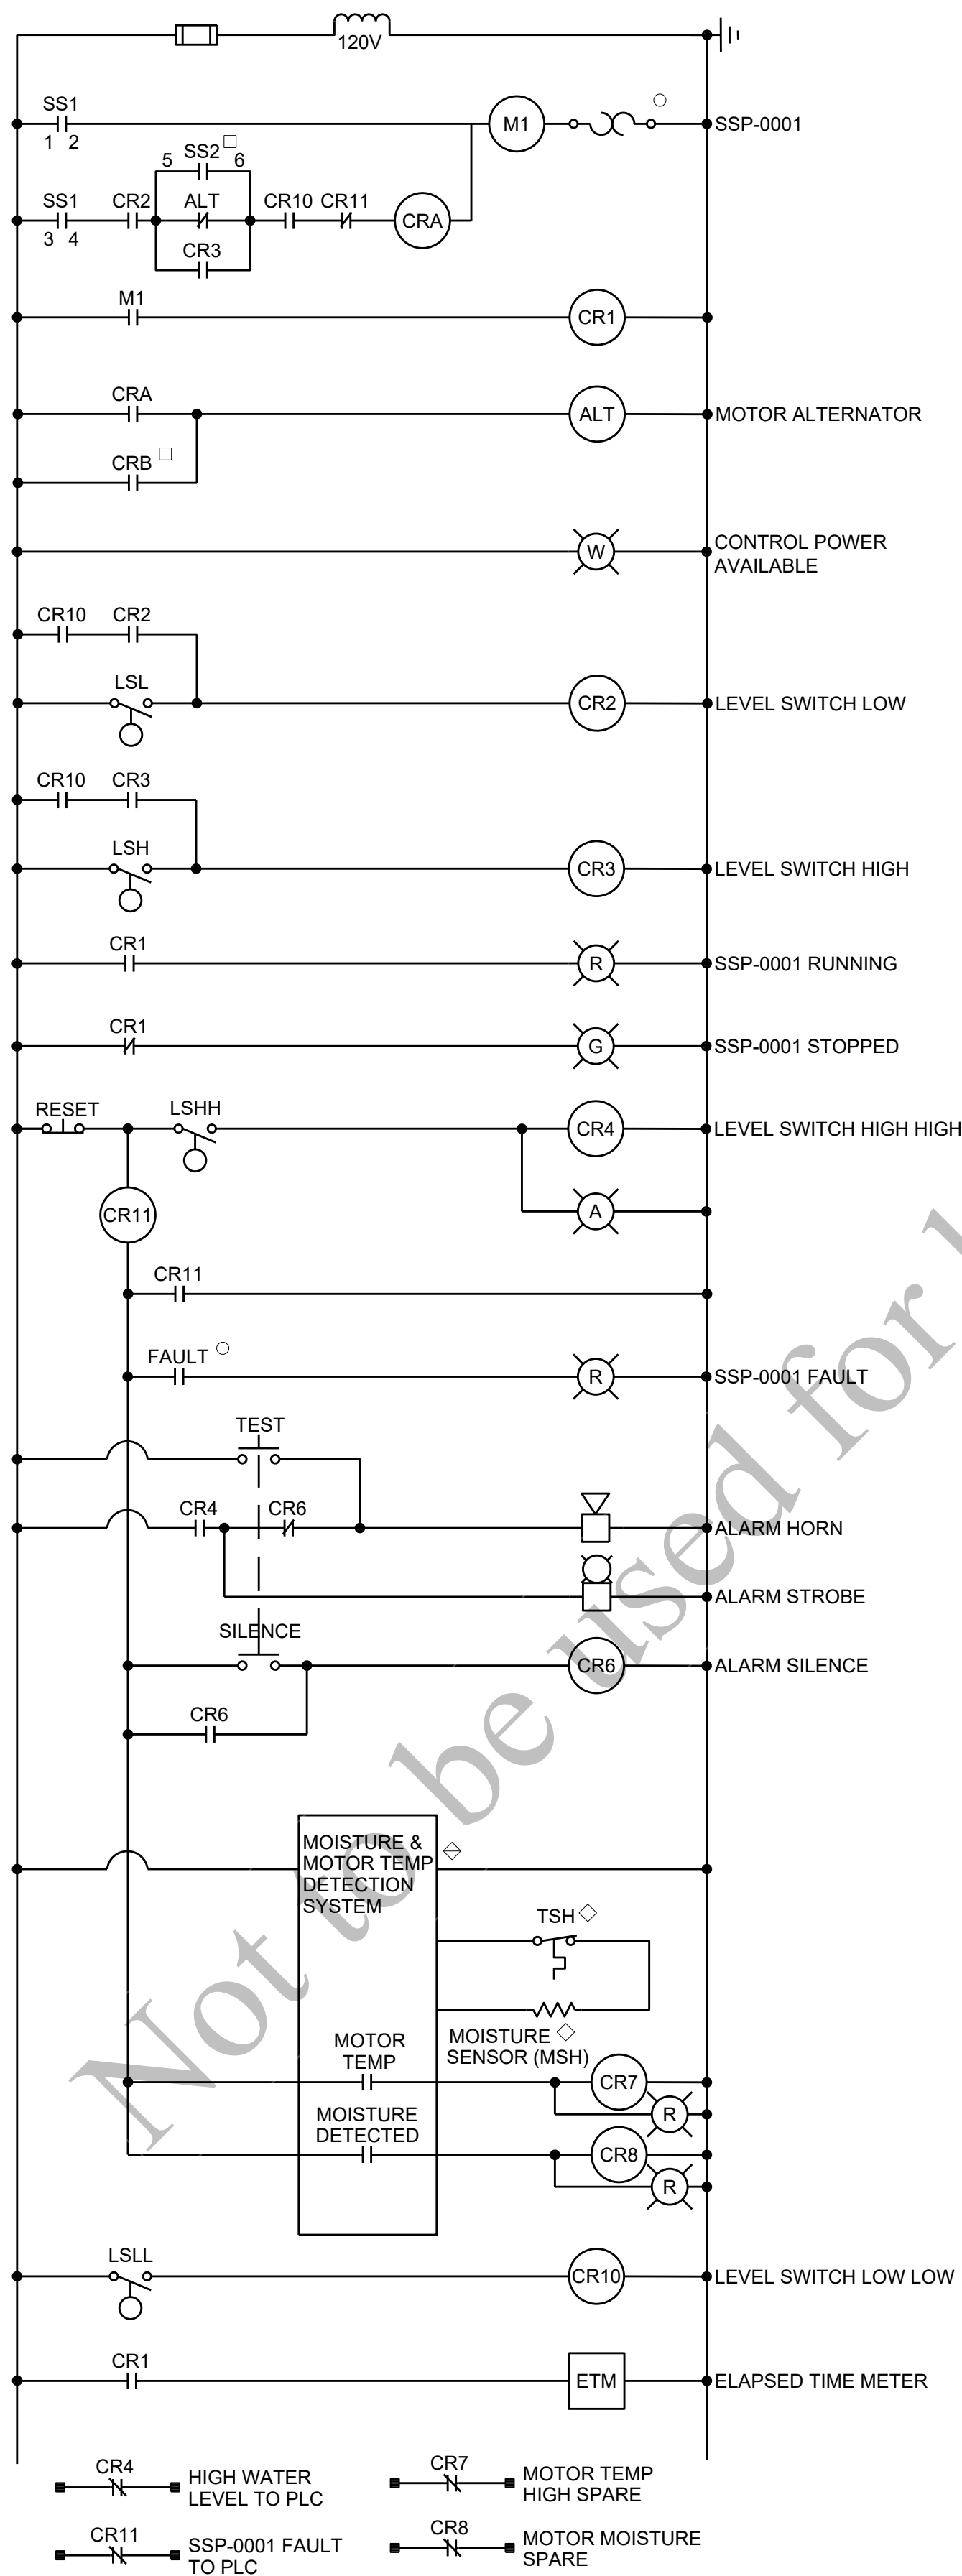


PIPE GALLERY DUPLEX SUMP PUMP CONTROL PANEL 02-LCP-1001
SIMILAR FOR SSP-0002 (SSP-0001 AND SSP-0002 CONTROLS IN SAME ENCLOSURE)

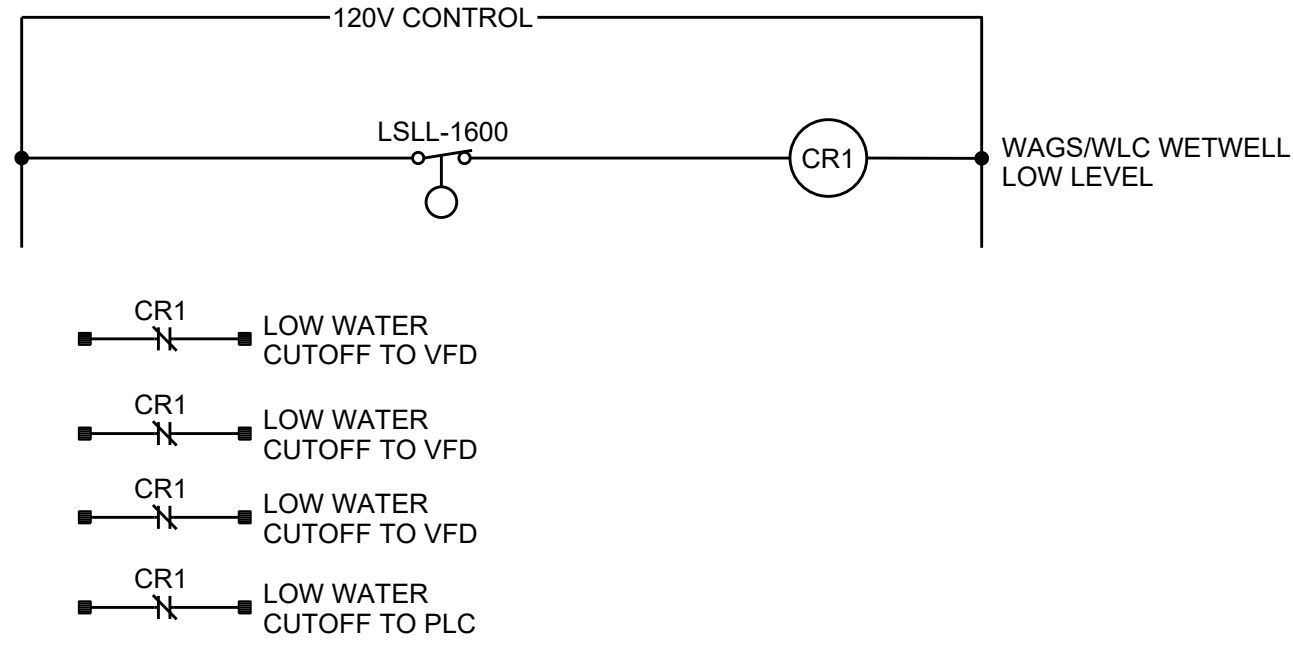

LOW WATER CUTOFF PANEL 02-LCP-1600

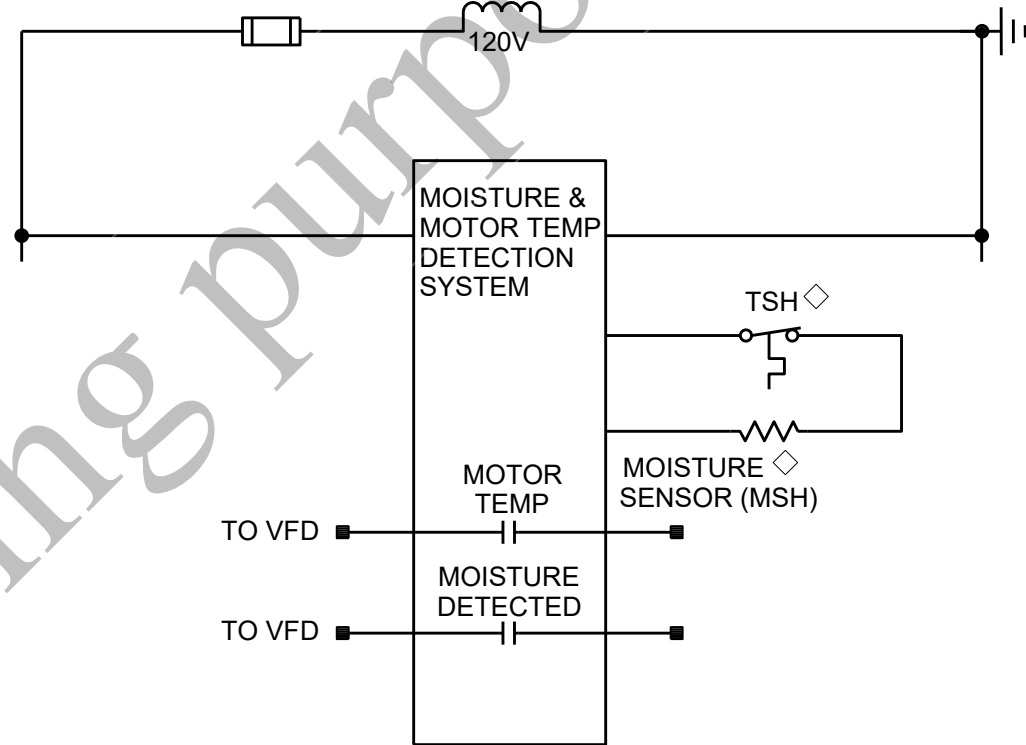

WAGS/WLC WETWELL CONTROL PANEL 02-LCP-1610
SIMILAR FOR LCP-1620 AND LCP-1630

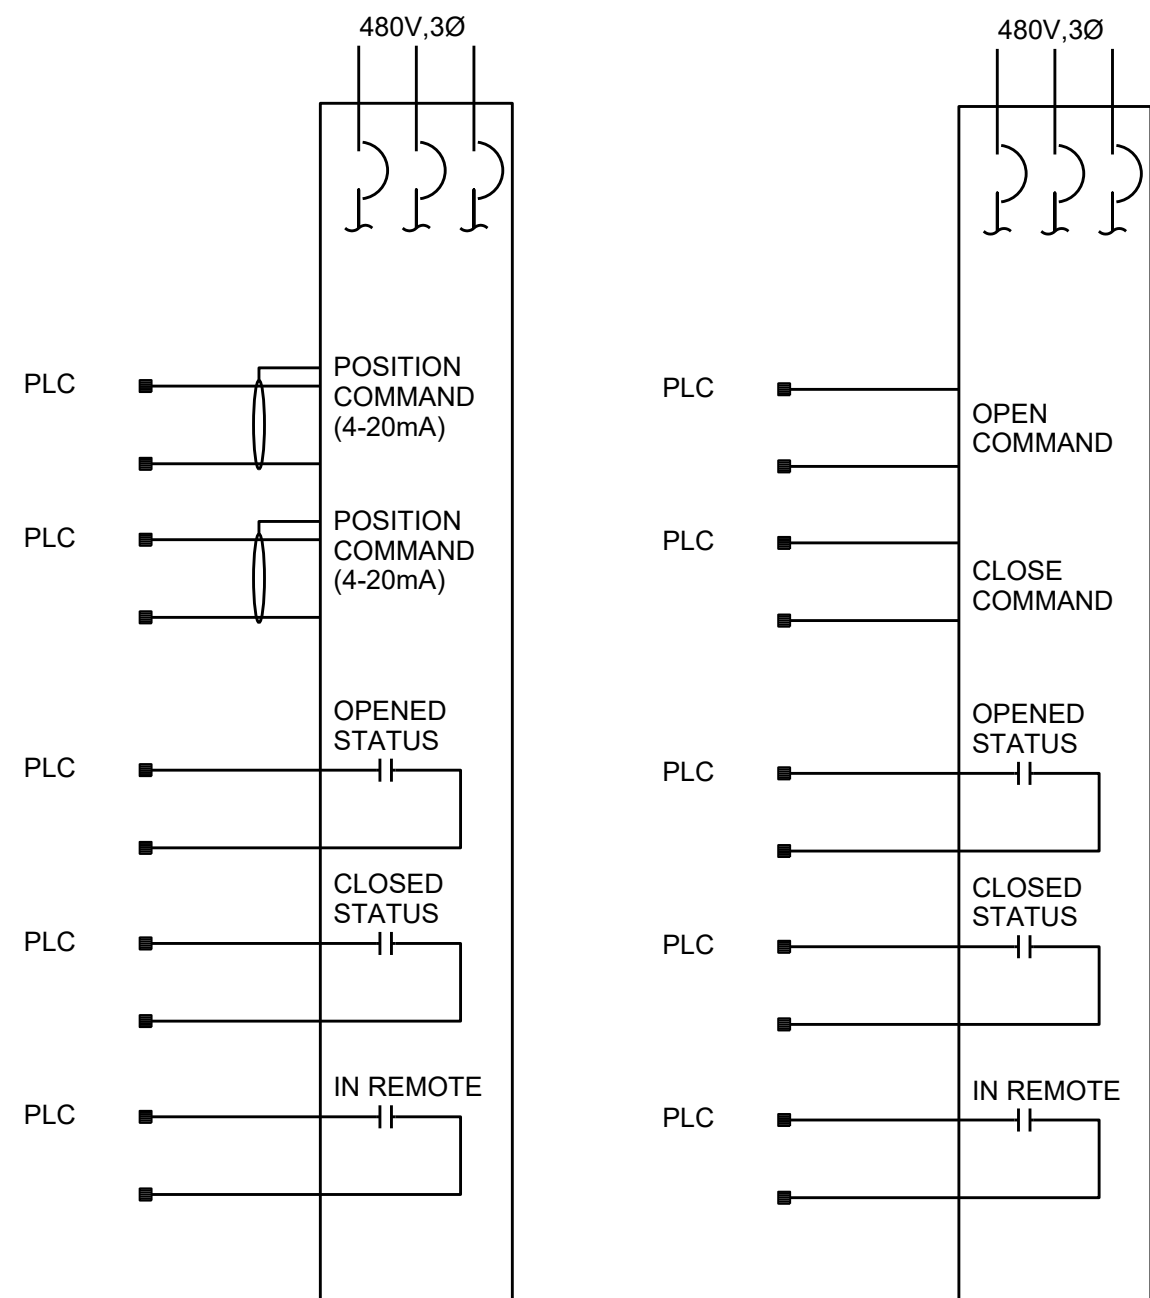

TYPICAL MODULATING
VALVE ACTUATOR

TYPICAL OPEN/CLOSE
VALVE ACTUATOR

GENERAL SHEET NOTES

1. ALL ALARM CONDITIONS, PUMP CONTROL, AND MONITORING SIGNALS SHALL BE TRANSMITTED OVER NETWORK CONNECTION.
2. ALL ALARM INPUTS SHALL STOP THE PUMP IN ALL CONTROL MODES.

LEGEND:

- ◇ AT VALVE
- ◇ AT DRIVEN EQUIPMENT
- ◇ ON LOCAL CONTROL PANEL AT DRIVEN EQUIPMENT
- ◆ REMOTE FROM STARTER AND DRIVEN EQUIPMENT
- MOTOR PROTECTION DEVICE
- DEVICE LOCATED IN SIMILAR EQUIPMENT CONTROL SYSTEM



Black & Veatch Corporation
Chicago, Illinois
ILLINOIS PROFESSIONAL
DESIGN FIRM - 184.002143 -0006



AEROBIC GRANULAR
SLUDGE - PHASE 1

REVISIONS AND RECORD OF ISSUE	
DESIGNED:	EJB
DETAILED:	SFR
CHECKED:	SDS
APPROVED:	EJB
DATE:	12/20/2022
PROJECT NO.:	411752


AGS SUPPORT FACILITIES

ELECTRICAL


SCHEMATICS

02-E-708


115
OF
163

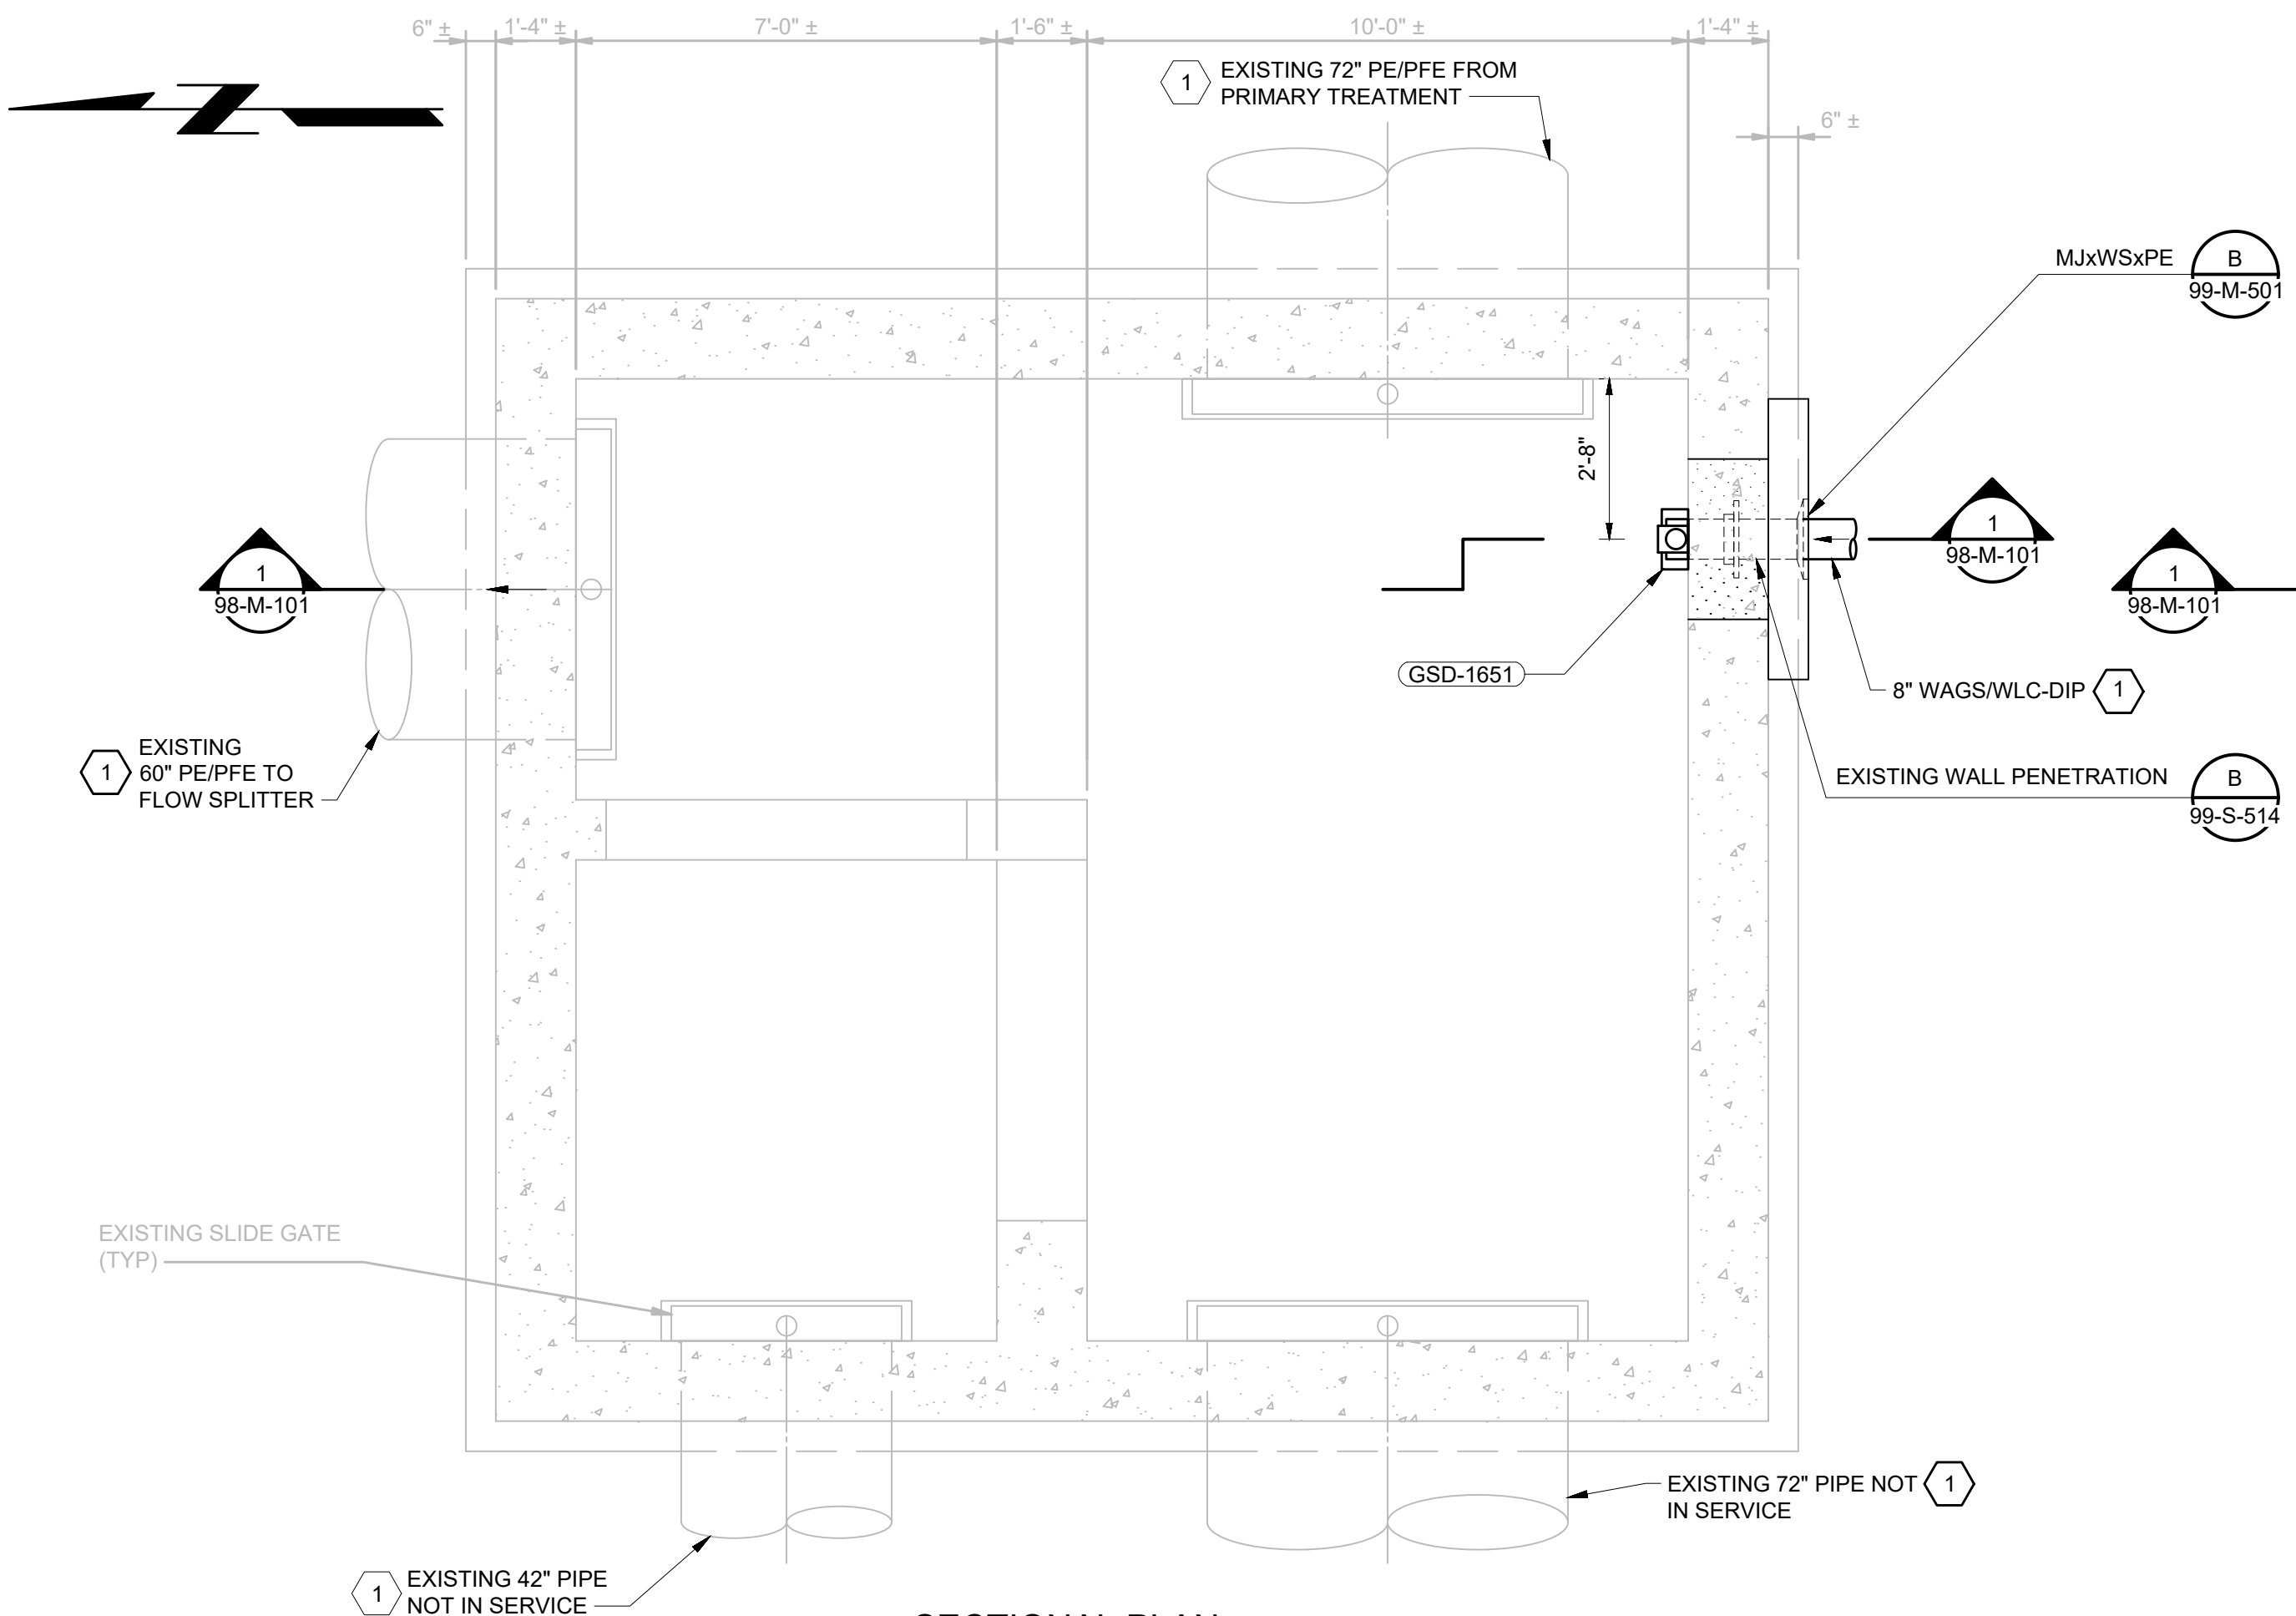

SECTIONAL PLAN
3/8" = 1'-0"

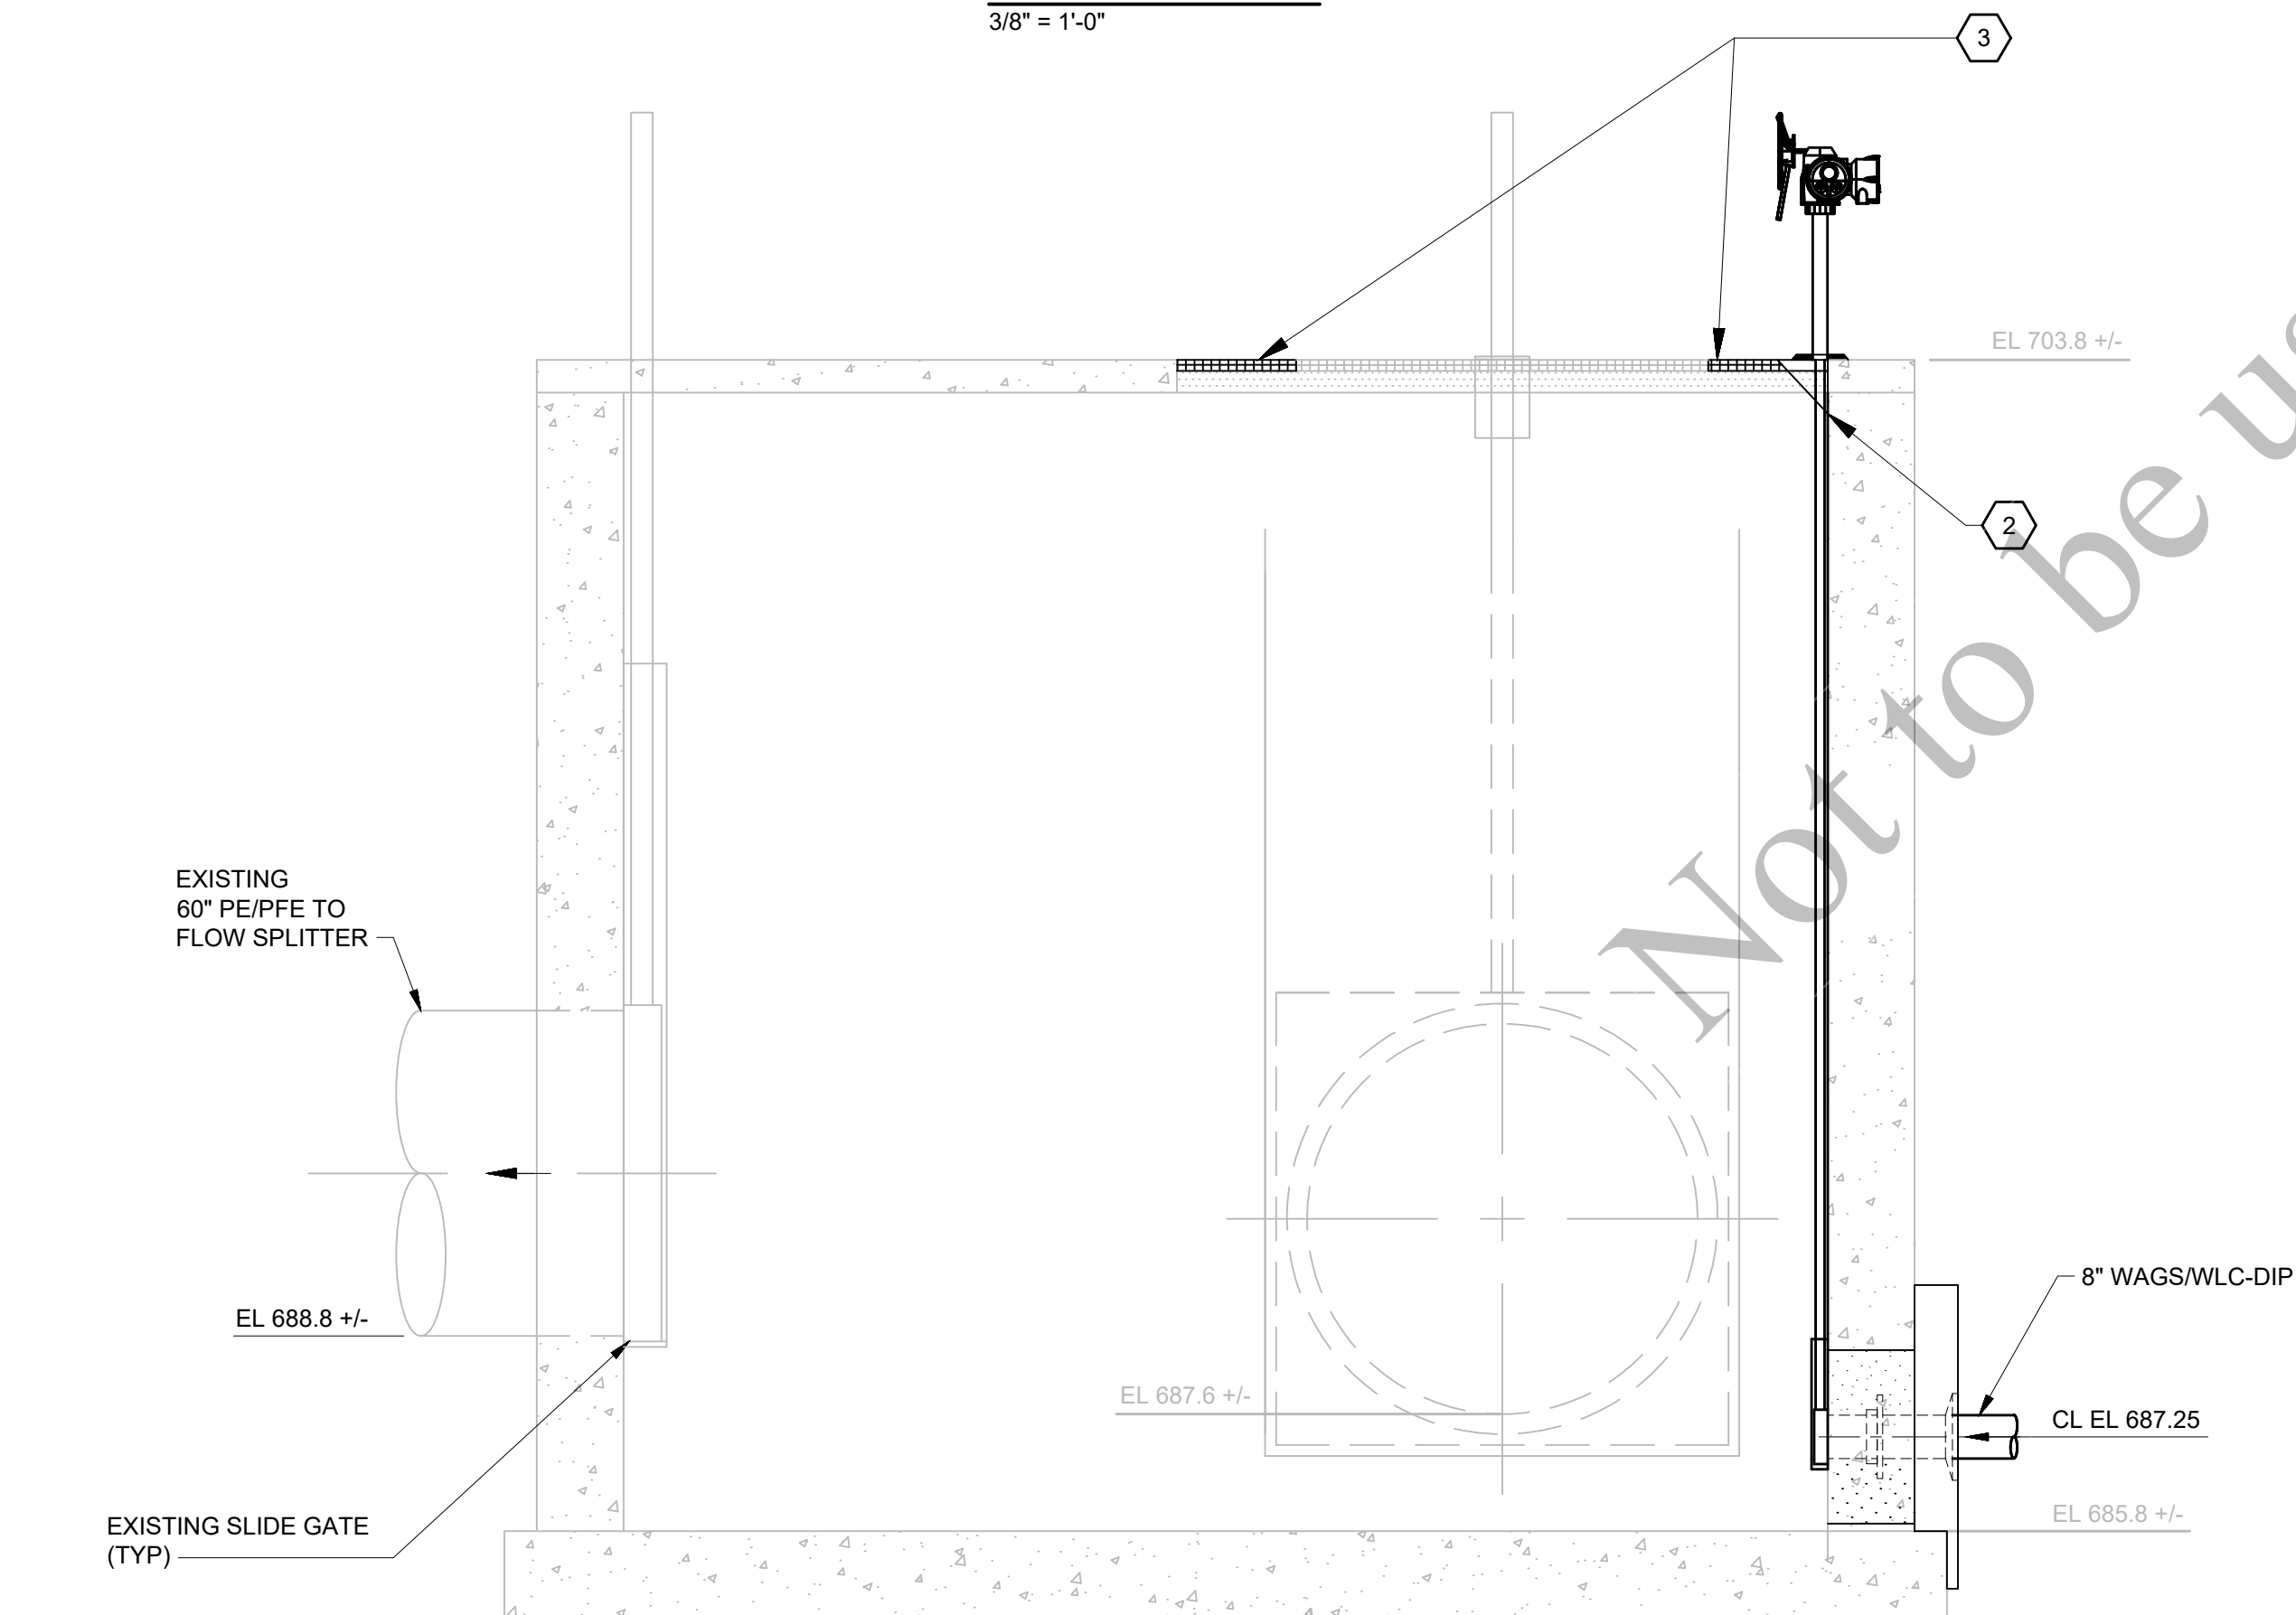

SECTION
98-M-101 3/8" = 1'-0"

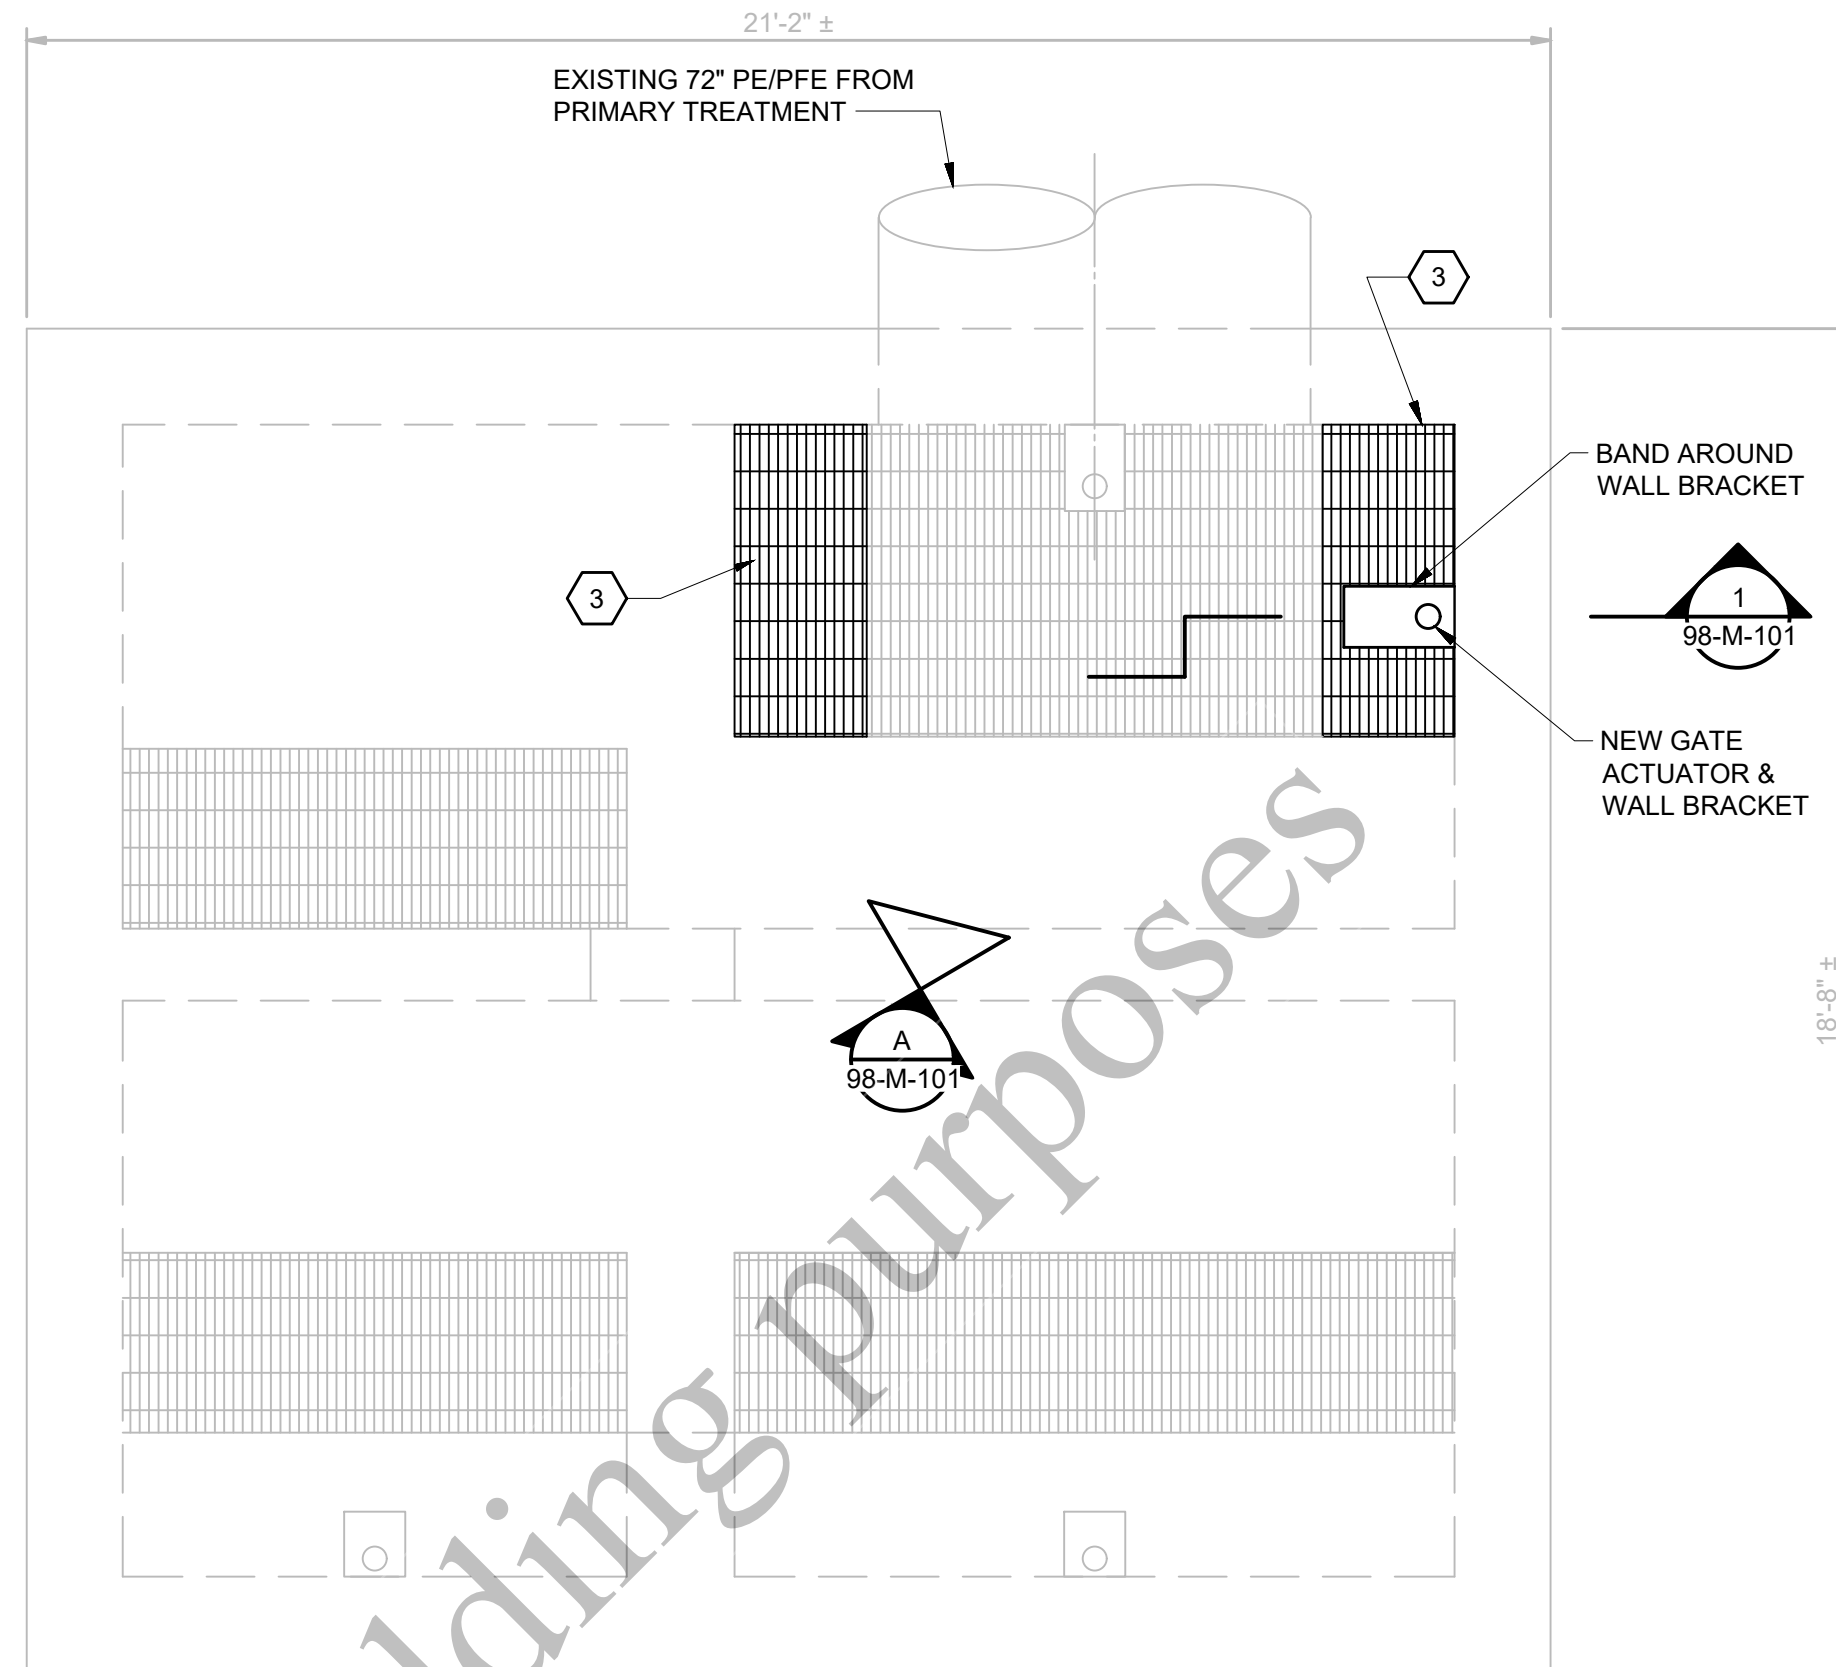

PLAN
3/8" = 1'-0"



EXISTING DISTRIBUTION CHAMBER GRATING AT 72" PE GATE OPERATOR
98-M-101 NO SCALE

GENERAL SHEET NOTES

- SEE EXISTING STRUCTURE NOTES ON SHEET 00-S-001.
- LOCATIONS AND ELEVATIONS OF ALL EXISTING PIPING, STRUCTURES, AND EQUIPMENT ARE BASED ON RECORD DRAWINGS. CONTRACTOR SHALL VERIFY ELEVATIONS AND LOCATIONS OF EXISTING PIPING, STRUCTURES, AND EQUIPMENT.

SHEET KEY NOTES:

- SEE YARD PIPING DRAWING 00-C-109 FOR CONTINUATION.
- GATE MANUFACTURER SHALL DESIGN AND FURNISH WALL BRACKET FOR SUPPORT OF GATE ACTUATOR.
- NEW GALVANIZED STEEL GRATING. NEW GRATING THICKNESS SHALL MATCH EXISTING GRATING THICKNESS. BAND AROUND THE NEW WALL BRACKET AS SHOWN WITH 1" CLEAR GAP BETWEEN EDGE OF WALL BRACKET AND GRATING BANDING.



Black & Veatch Corporation
Chicago, Illinois
ILLINOIS PROFESSIONAL
DESIGN FIRM - 184.002143 -0006



AEROBIC GRANULAR
SLUDGE - PHASE 1

REVISIONS AND RECORD OF ISSUE

DESIGNED:	JL
DETAILED:	VP
CHECKED:	AM/JH
APPROVED:	MR
DATE:	12/20/2022
PROJECT NO.:	411752


YARD

PROCESS MECHANICAL


DISTRIBUTION CHAMBER
PLANS AND SECTION

98-M-101


116
OF
163

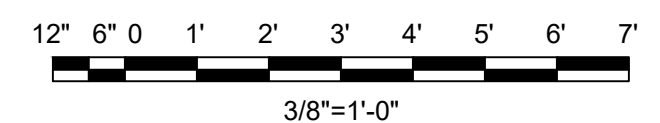


(SCALE BAR IS 4" AT FULL SCALE) 0 1/2 1 2 3 4

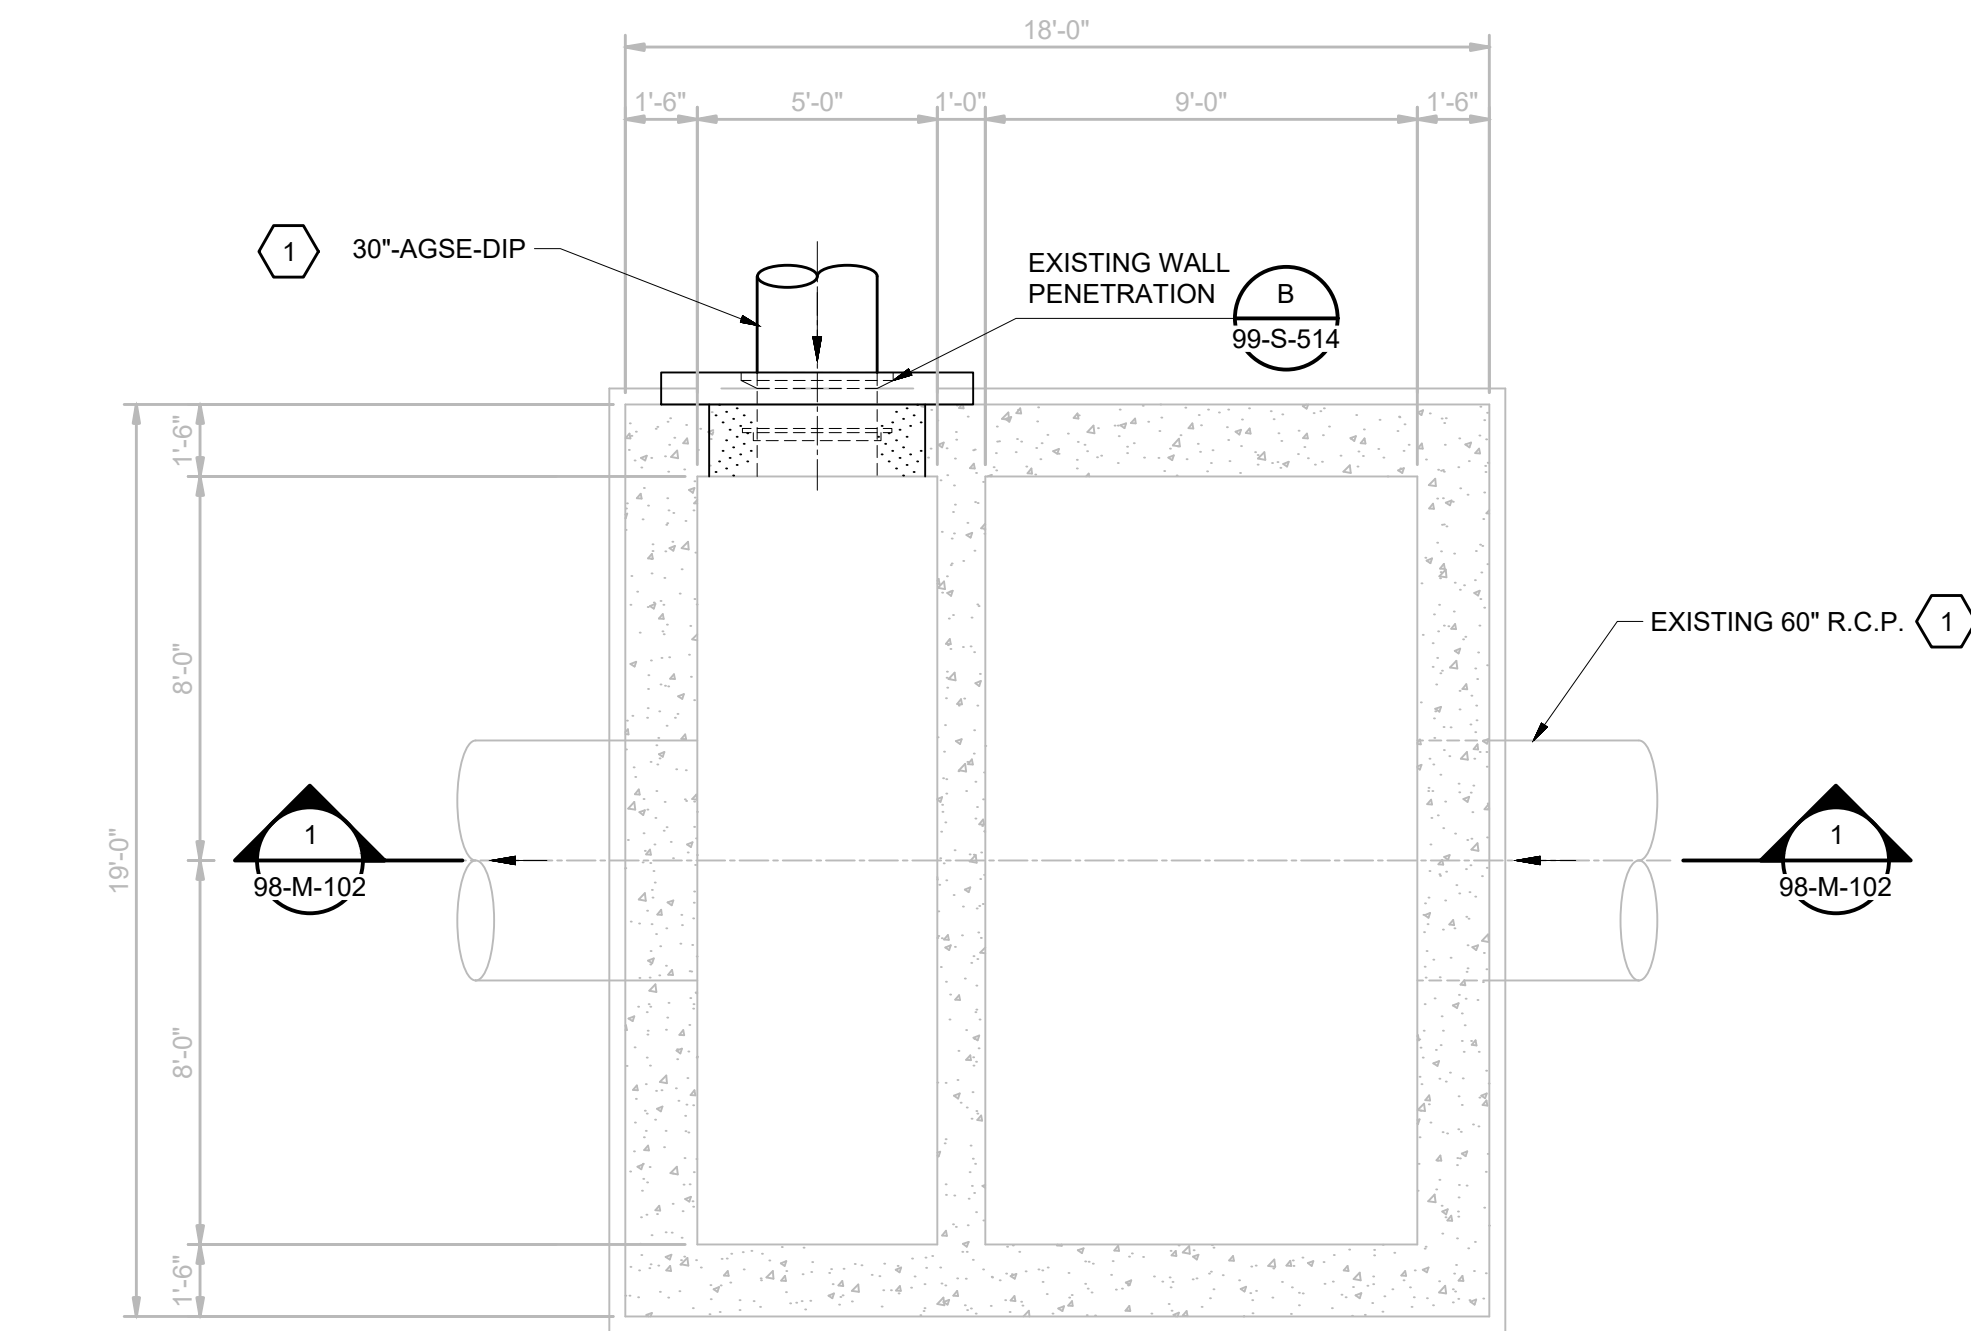

SECTIONAL PLAN
1/4" = 1'-0"

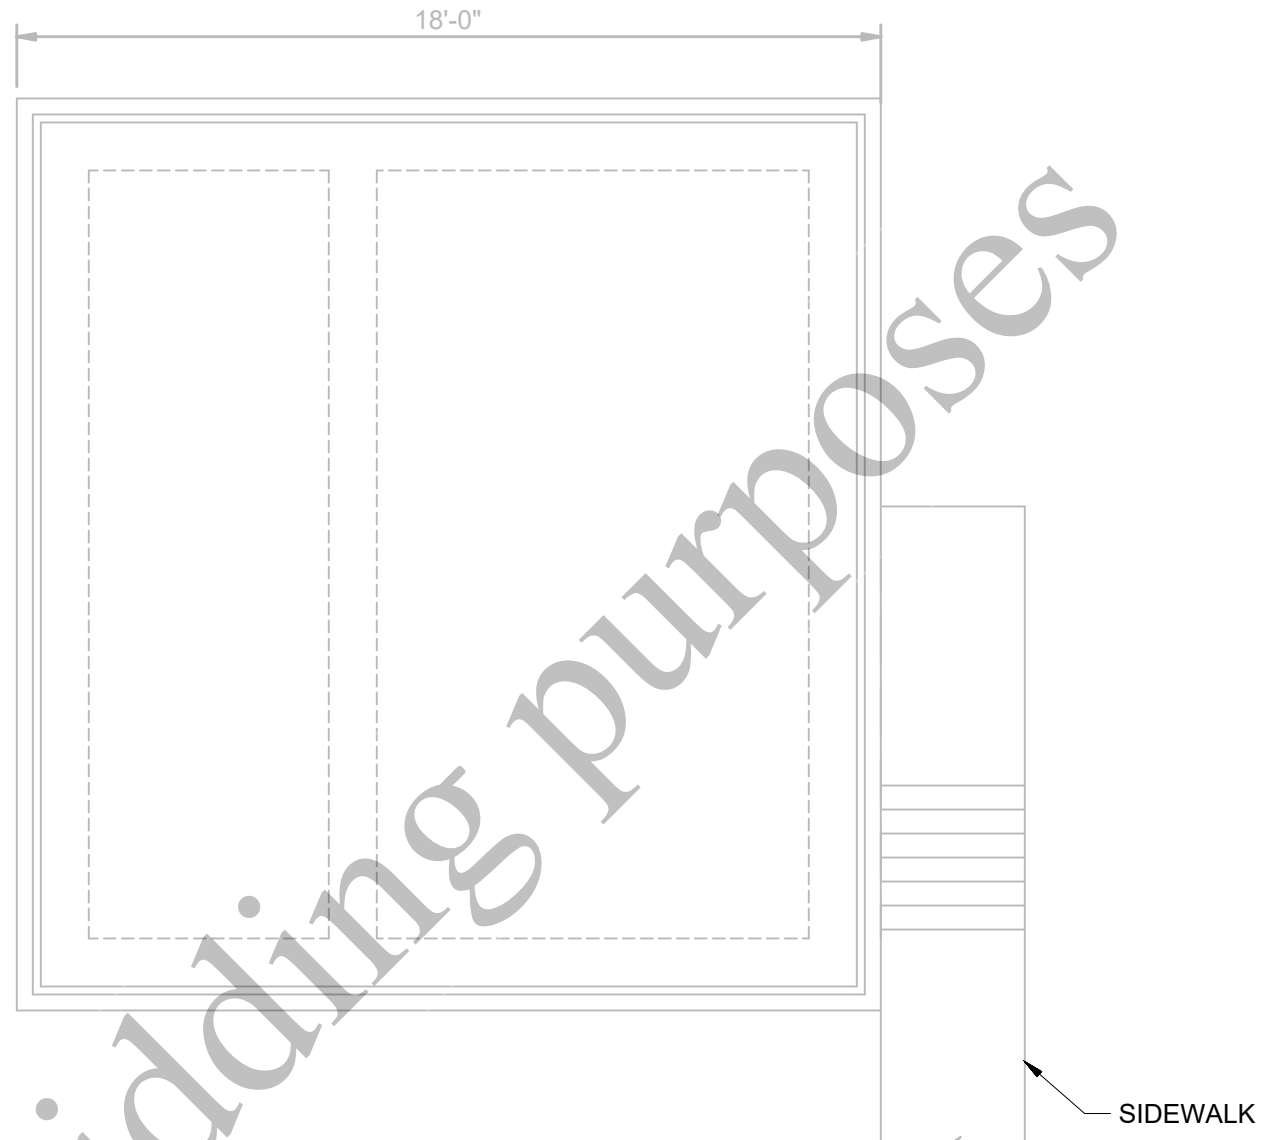

PLAN
1/4" = 1'-0"

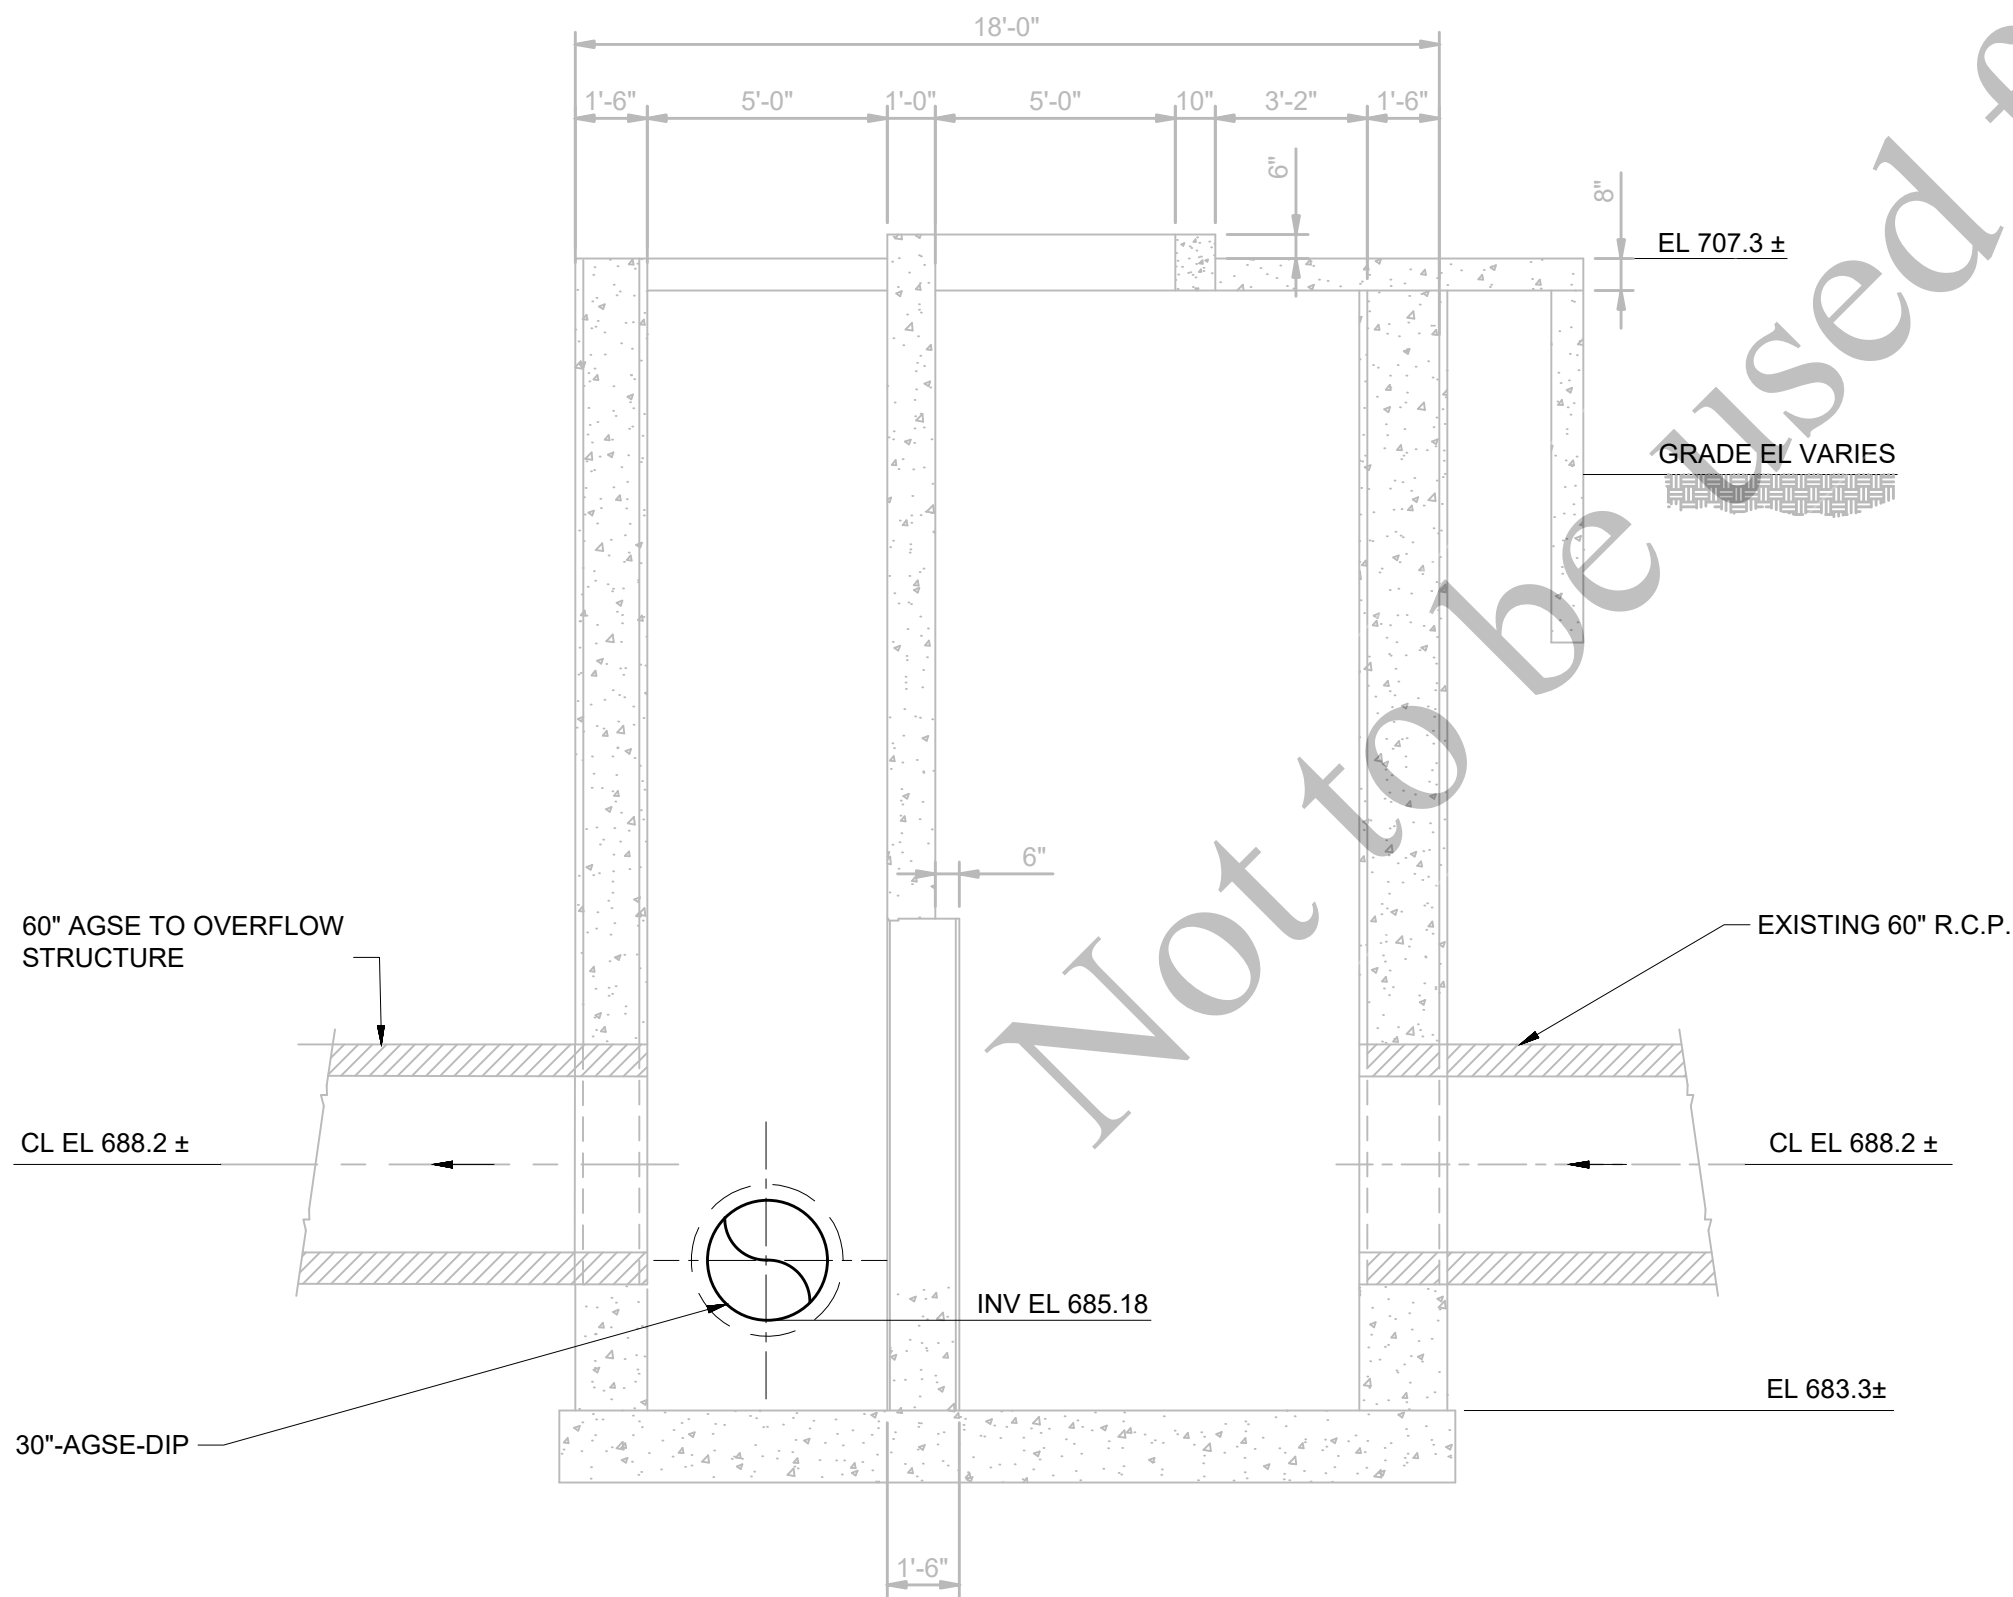

SECTION
1
98-M-102
1/4" = 1'-0"

GENERAL SHEET NOTES

- SEE EXISTING STRUCTURE NOTES ON SHEET 00-S-001.
- LOCATIONS AND ELEVATIONS OF ALL EXISTING PIPING, STRUCTURES, AND EQUIPMENT ARE BASED ON RECORD DRAWINGS. CONTRACTOR SHALL VERIFY ELEVATIONS AND LOCATIONS OF EXISTING PIPING, STRUCTURES, AND EQUIPMENT.

SHEET KEY NOTES:

- SEE YARD PIPING DRAWING 00-C-110 FOR CONTINUATION.



Black & Veatch Corporation
Chicago, Illinois
ILLINOIS PROFESSIONAL
DESIGN FIRM - 184.002143 -0006



AEROBIC GRANULAR
SLUDGE - PHASE 1

REVISIONS AND RECORD OF ISSUE	
DESIGNED:	JL
DETAILED:	VP
CHECKED:	AM/JH
APPROVED:	MR
DATE:	12/20/2022
PROJECT NO.:	411752


YARD

PROCESS MECHANICAL

FILTER EFFLUENT
PUMPING STATION PLAN
AND SECTION

98-M-102

117
OF
163

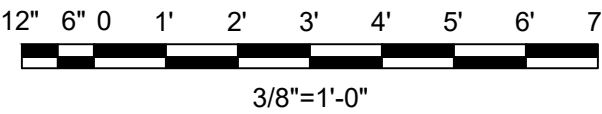

(SCALE BAR IS 4" AT FULL SCALE)

AEROBIC GRANULAR
SLUDGE - PHASE 1


REVISIONS AND RECORD OF ISSUE	
DESIGNED:	JL
DETAILED:	VP
CHECKED:	AM/JH
APPROVED:	MR
DATE:	12/20/2022
PROJECT NO.:	411752

YARD

PROCESS MECHANICAL

OVERFLOW STRUCTURE
PLANS AND SECTIONS

98-M-103

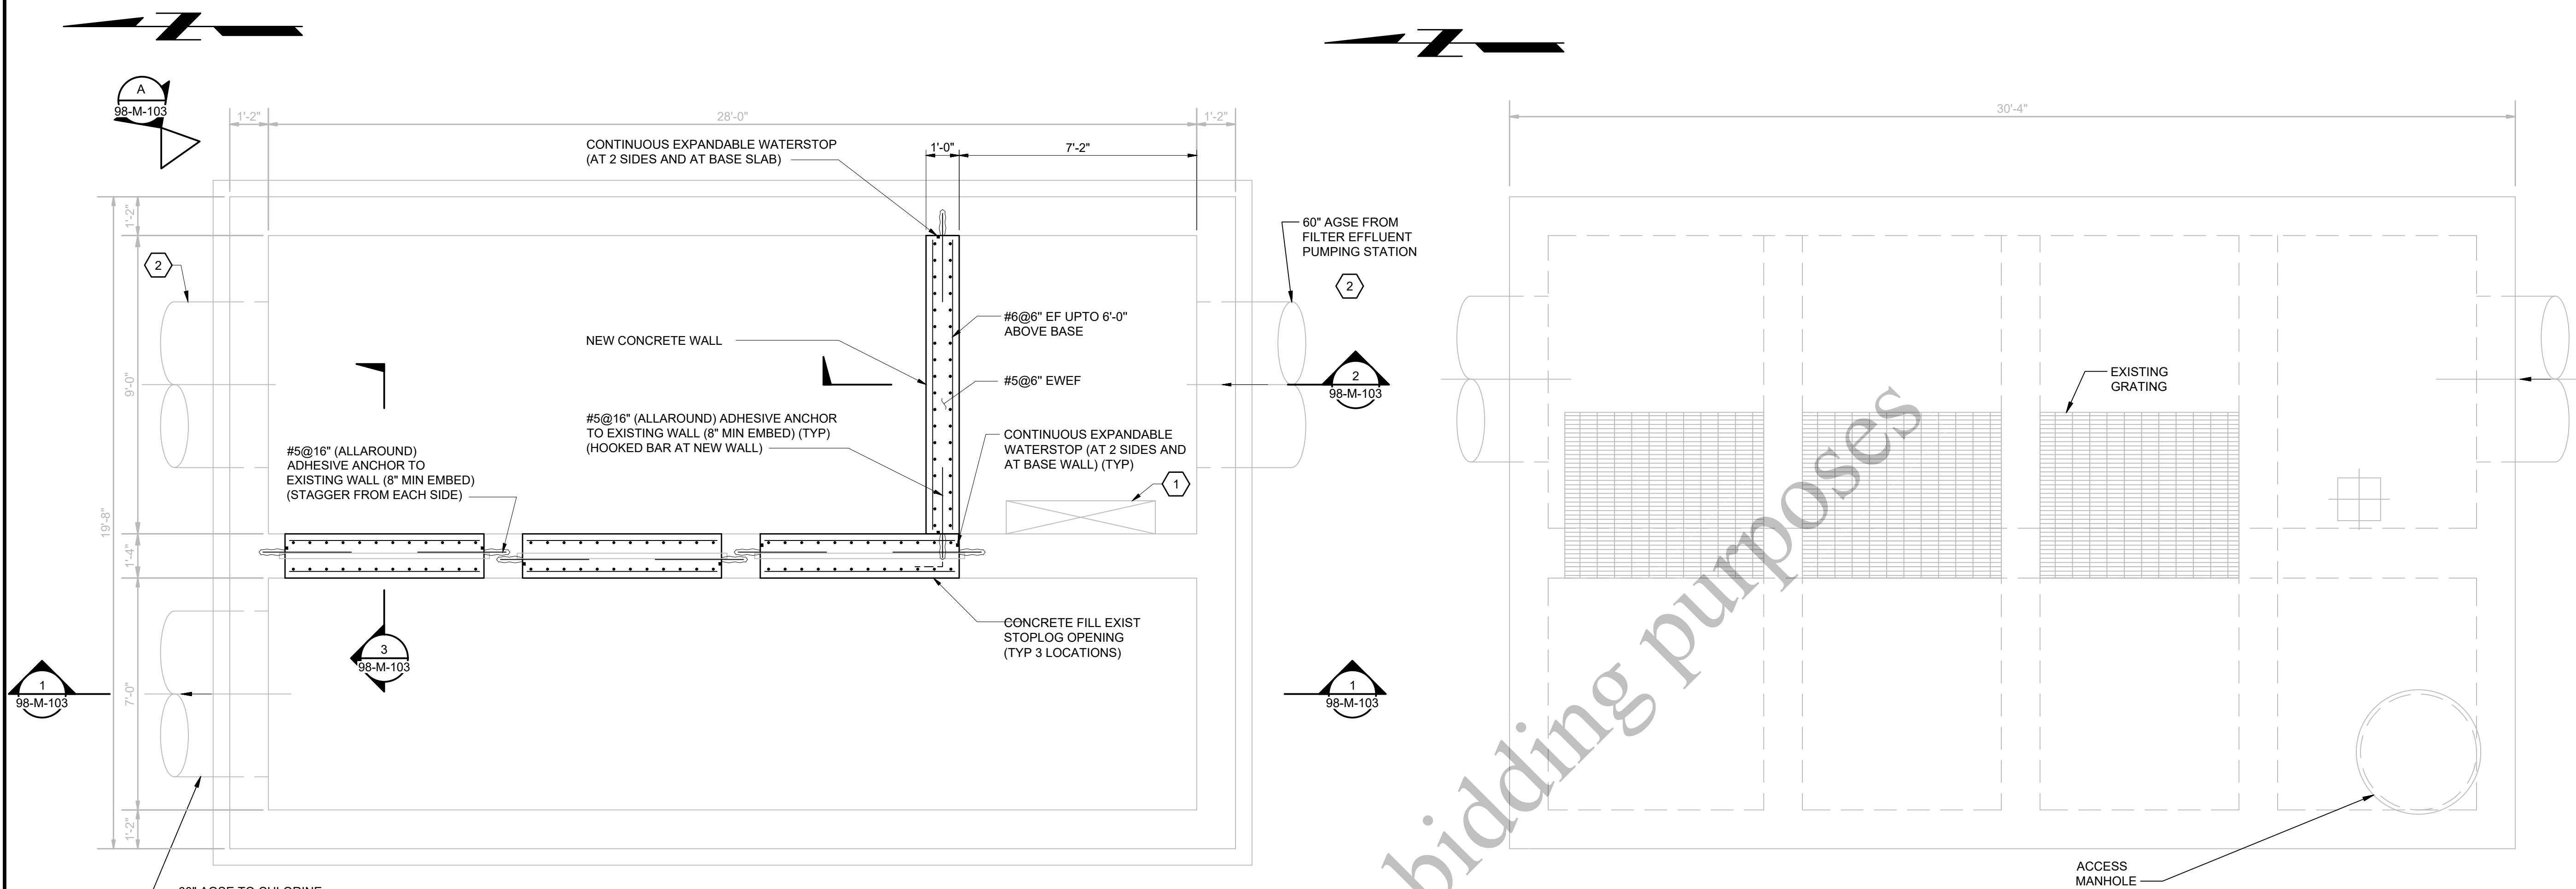
118
OF
163SECTIONAL PLAN
3/8" = 1'-0"PLAN
3/8" = 1'-0"A EXISTING OVERFLOW STRUCTURE
98-M-103 NO SCALE

GENERAL NOTES:

- SEE EXISTING STRUCTURE NOTES ON SHEET 00-S-001.
- LOCATIONS AND ELEVATIONS OF ALL EXISTING PIPING, STRUCTURES, AND EQUIPMENT ARE BASED ON RECORD DRAWINGS. CONTRACTOR SHALL VERIFY ELEVATIONS AND LOCATIONS OF EXISTING PIPING, STRUCTURES, AND EQUIPMENT.

SHEET KEY NOTES:





- CONTRACTOR SHALL FIELD VERIFY CONDITION OF EXISTING GATE AND SERVICE AS NEEDED TO ENSURE FUNCTIONALITY.
- SEE YARD PIPING DRAWING 00-C-108 FOR CONTINUATION.
- EXISTING PUMPS AT OVERFLOW STRUCTURE SHALL BE PROTECTED-IN-PLACE DURING CONSTRUCTION. ANY OUTAGES SHALL BE COORDINATED WITH OWNER. CONTRACTOR SHALL PROVIDE AT LEAST 7 DAYS NOTICE PRIOR TO PROJECTED START DATE OF OUTAGE. SEE SPECIFICATION SECTION 00 00 08 AGREEMENT, MILESTONE NO. 1 FOR DETAILS ON OUTAGE LIMITS AND LIQUIDATED DAMAGES.

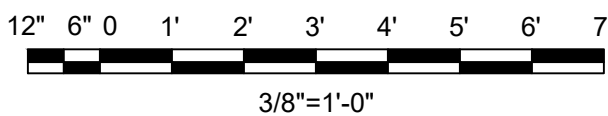

(SCALE BAR IS 4" AT FULL SCALE)

1 SECTION
98-M-103 3/8" = 1'-0"2 SECTION
98-M-103 3/8" = 1'-0"

PLOTTED: 1/11/2022 9:32:56 PM
 FILE: C:\PW\WORKING\BW\AMERICAS\01495355\98-M-104.DWG
 D:\1000

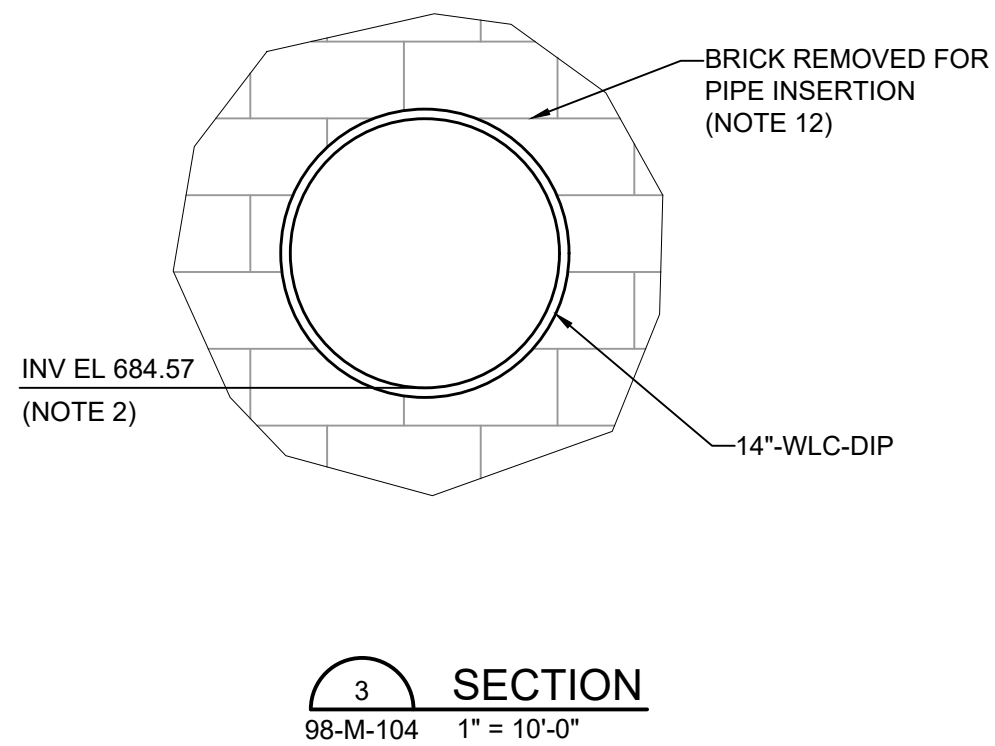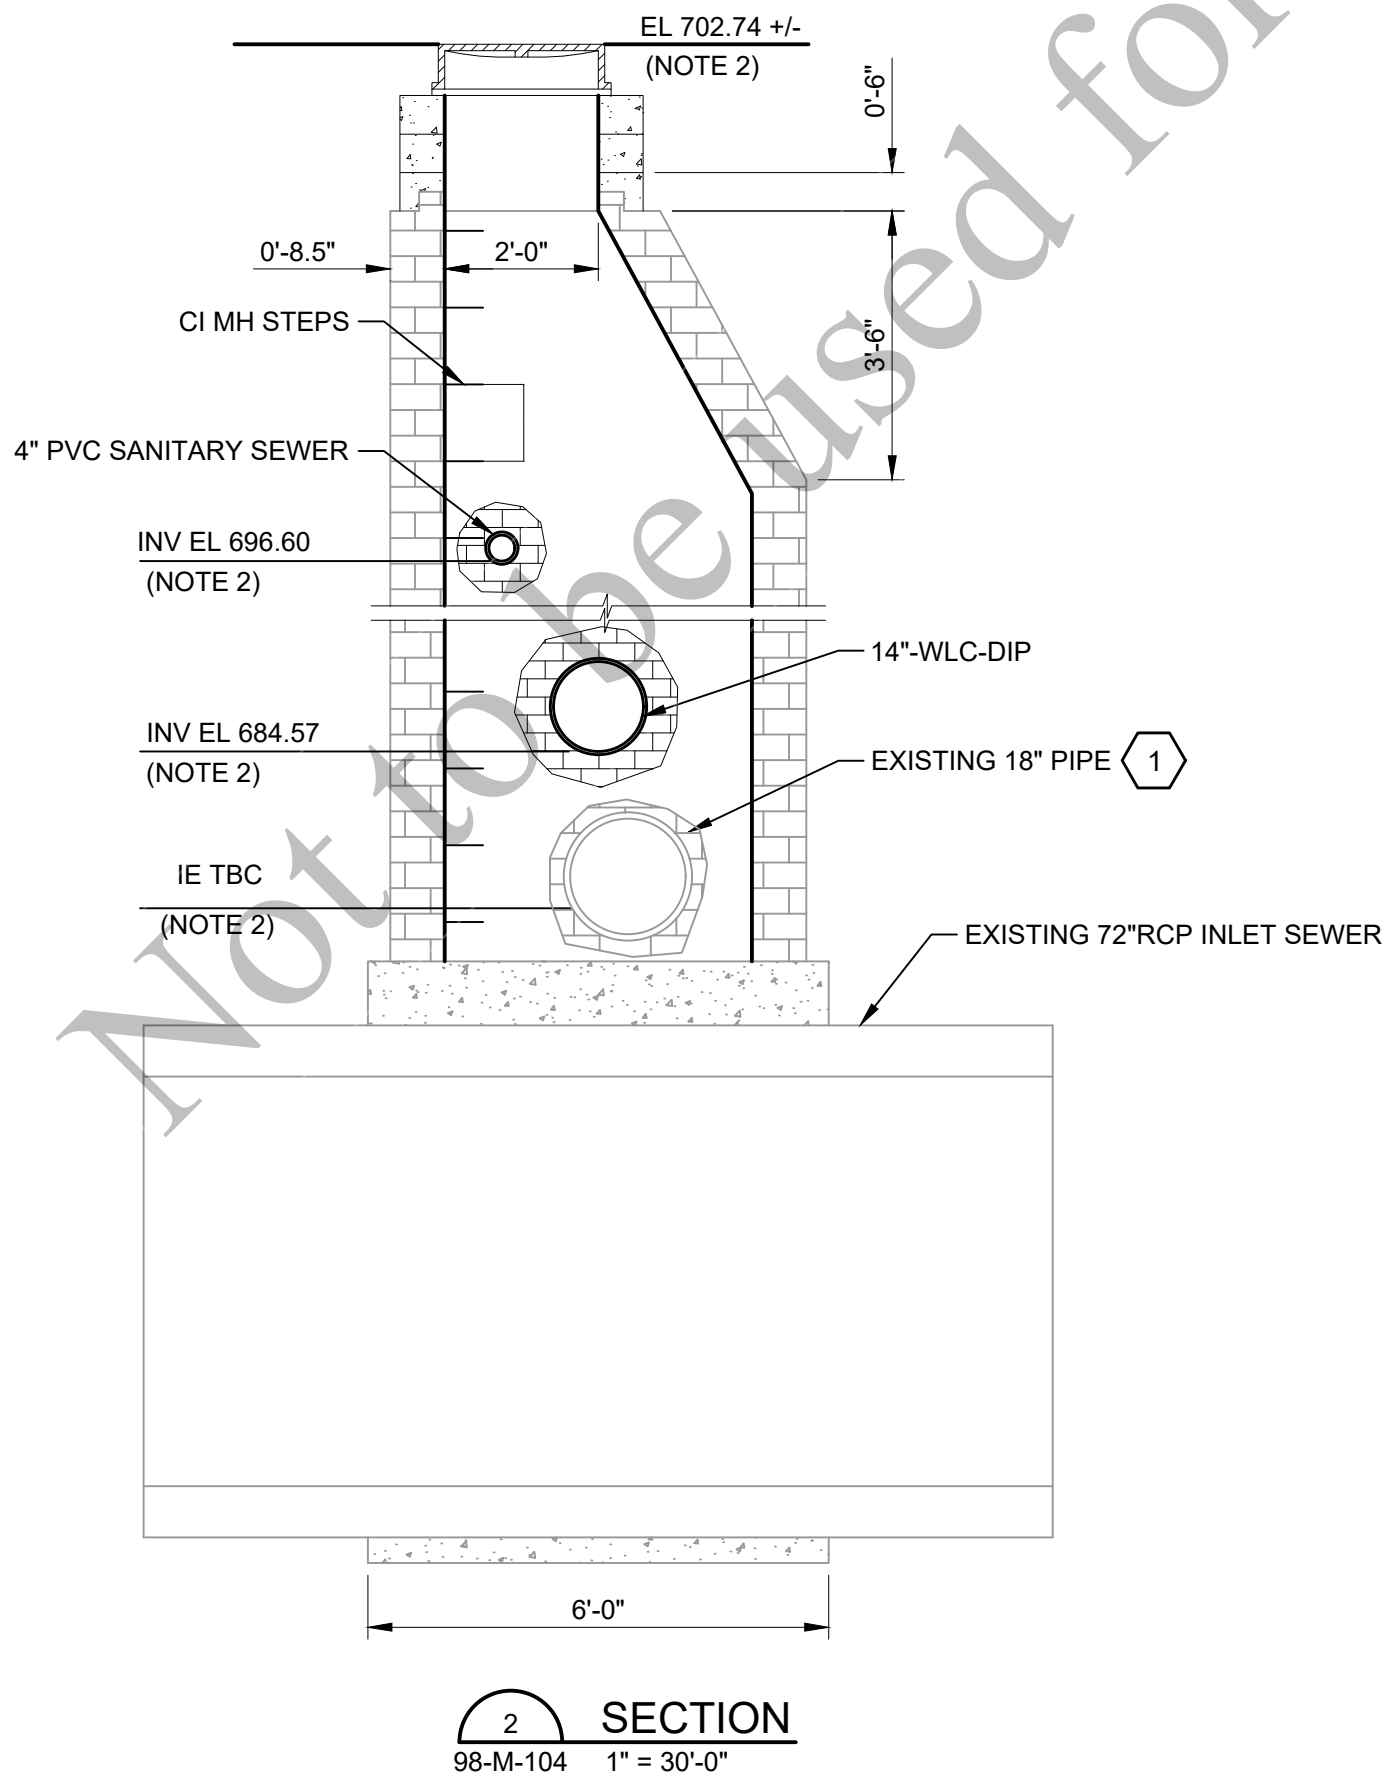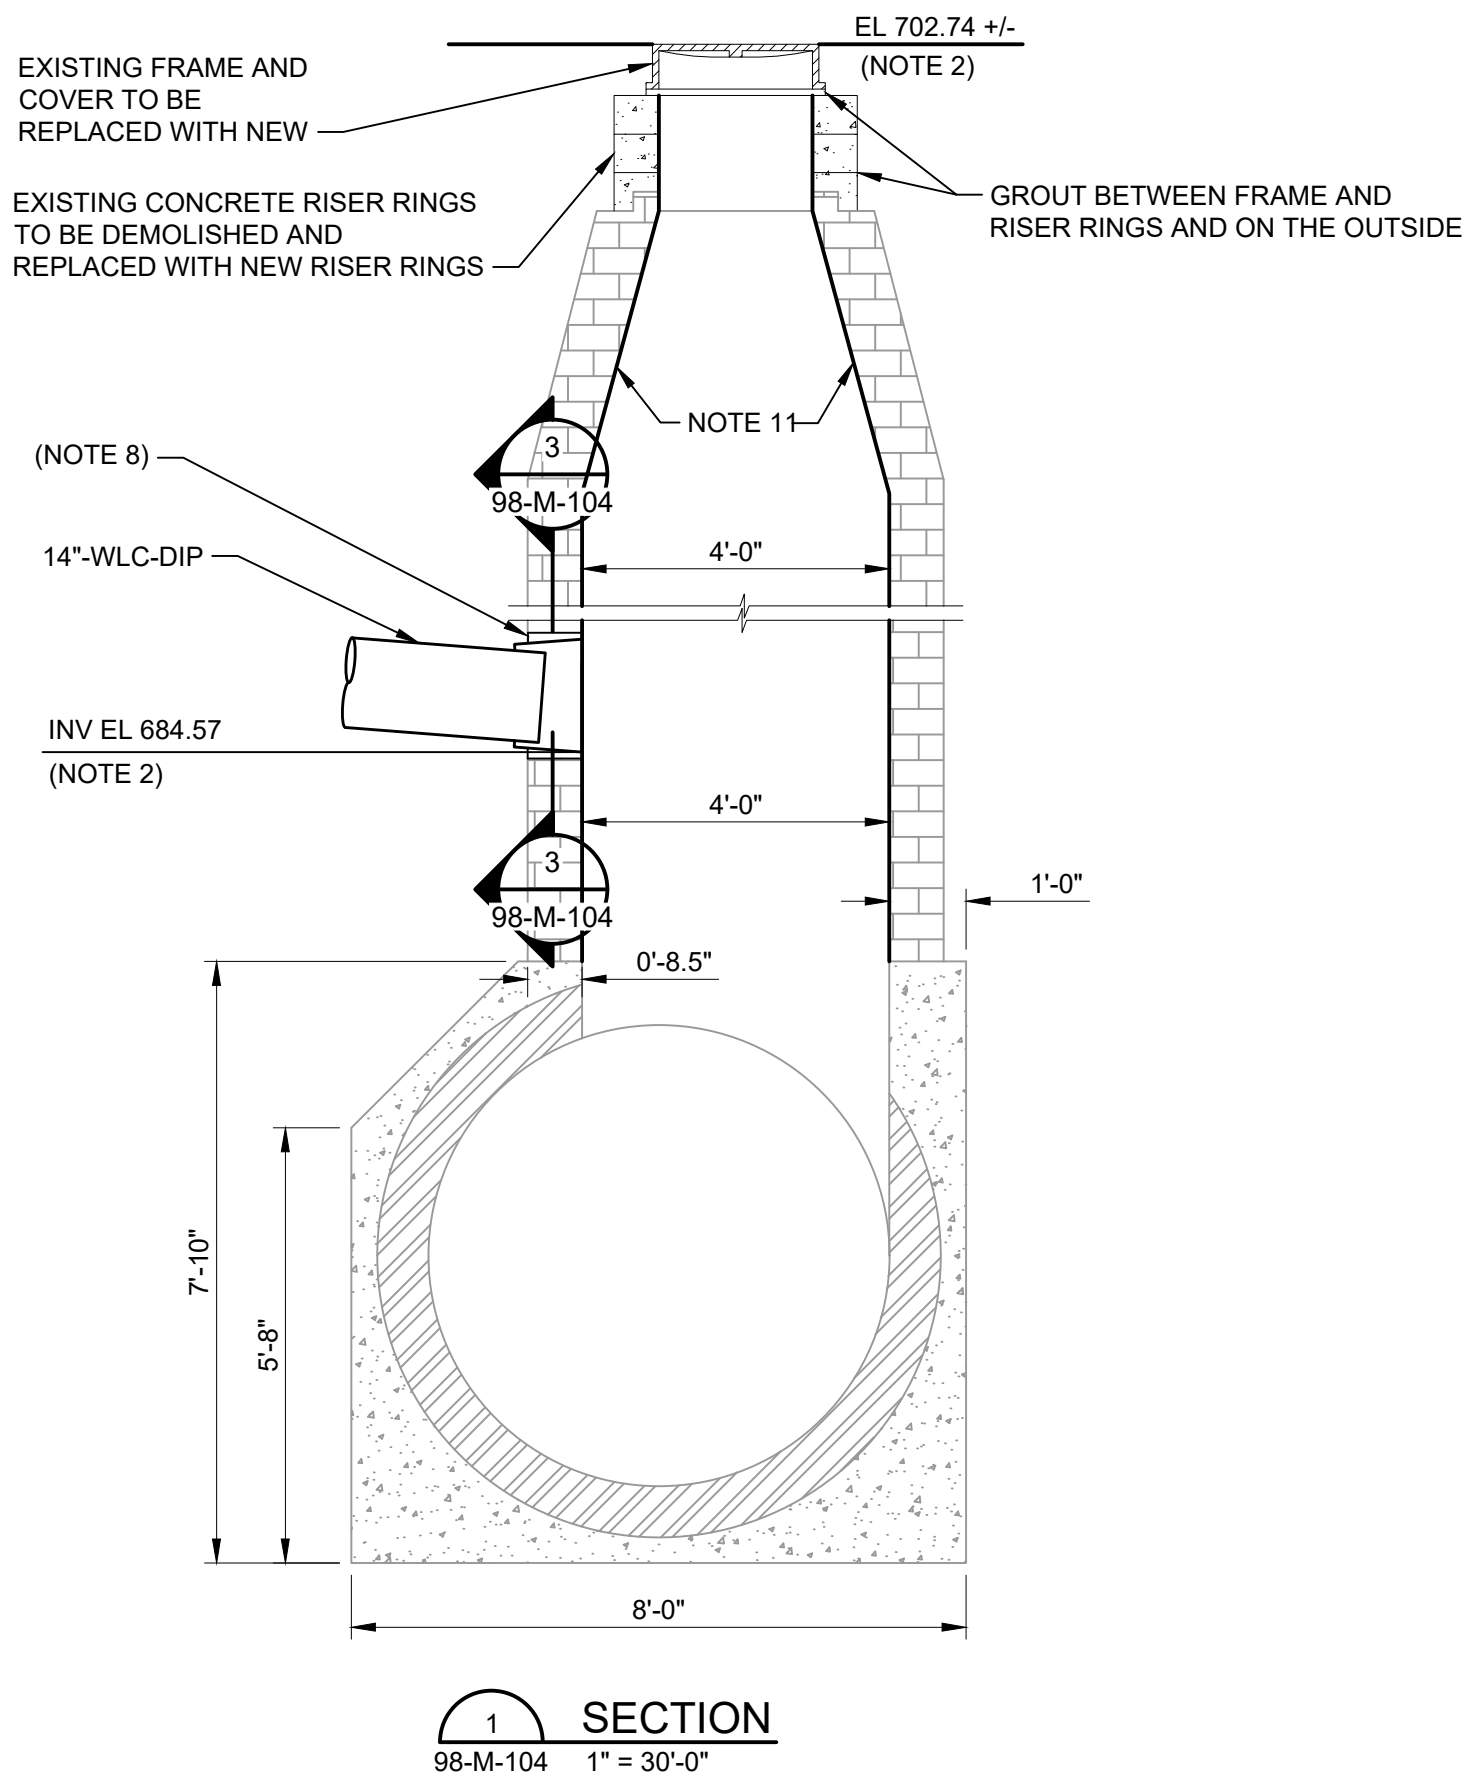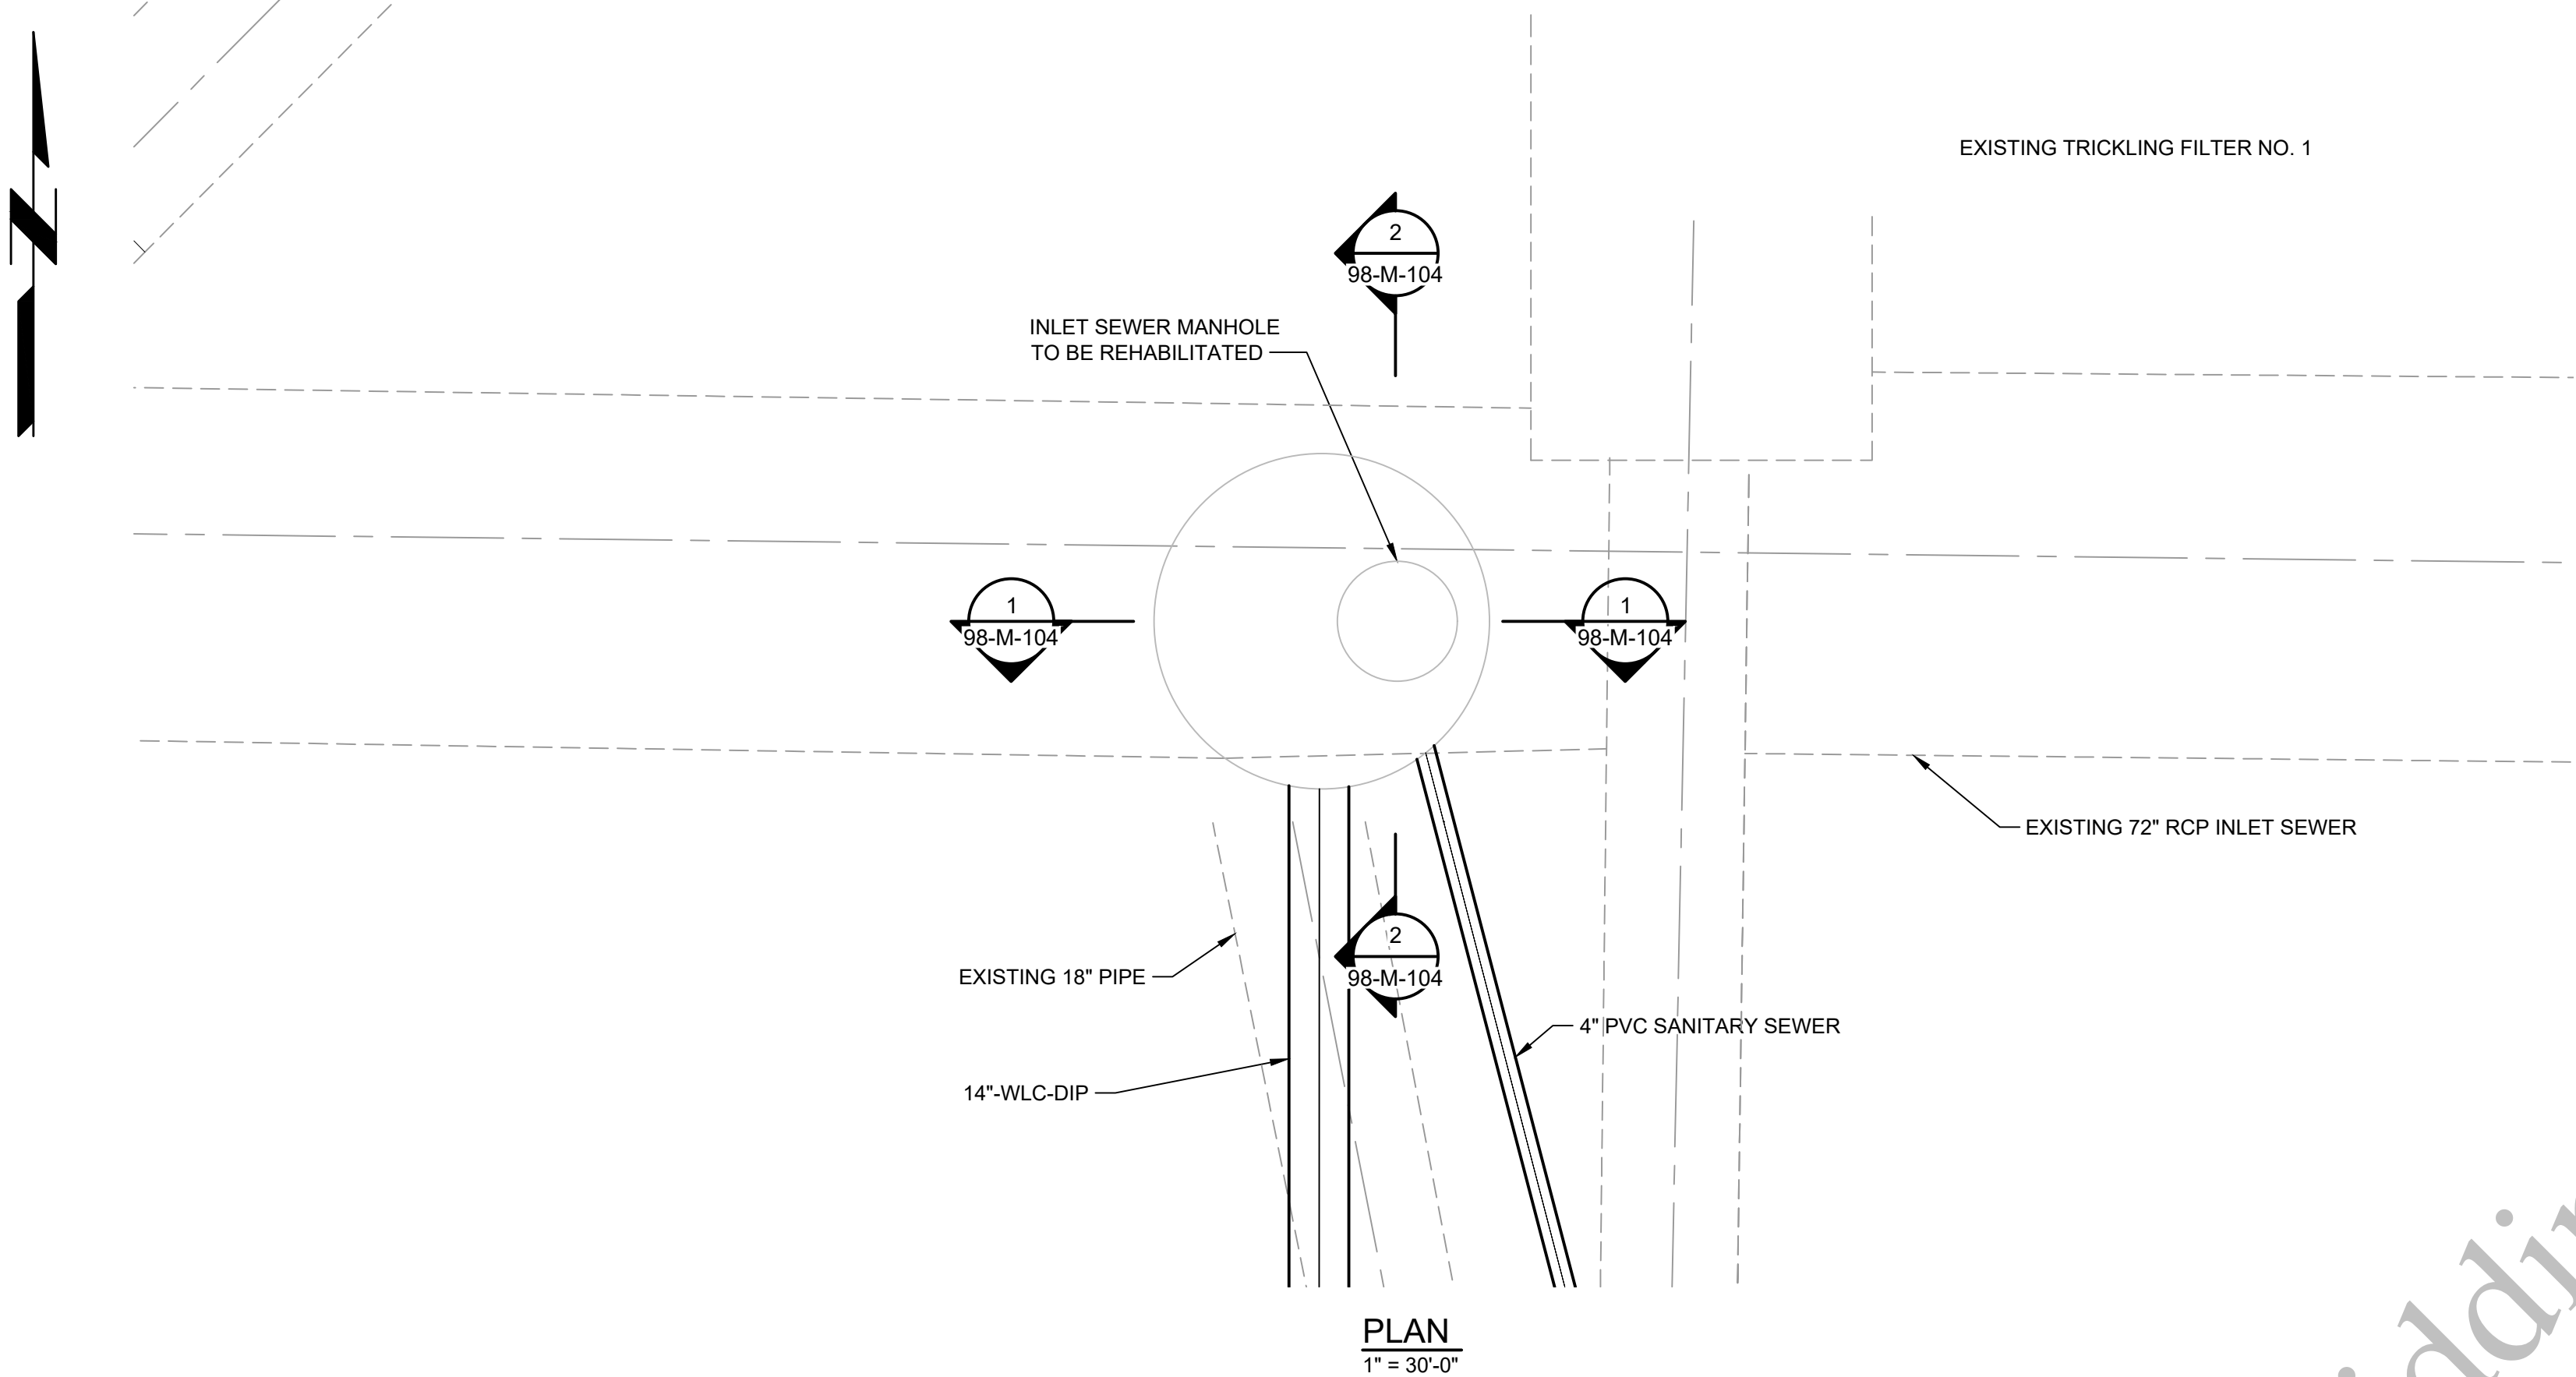

GENERAL SHEET NOTES

- SEE EXISTING STRUCTURE NOTES ON SHEET 00-S-001.
- LOCATIONS AND ELEVATIONS OF ALL EXISTING PIPING, STRUCTURES, AND EQUIPMENT ARE BASED ON RECORD DRAWINGS. CONTRACTOR SHALL VERIFY ELEVATIONS AND LOCATIONS OF EXISTING PIPING, STRUCTURES, AND EQUIPMENT.
- ALL DIMENSIONS ARE IN INCHES UNLESS OTHERWISE SPECIFIED.
- ALL CONNECTIONS MUST BE WATERTIGHT AND ANNULAR SPACE BETWEEN PIPE AND MANHOLE SHALL BE SEALED WITH NON-SHRINK GROUT. EXTRA ATTENTION SHALL BE PAID TO THE PENETRATION TO THE MANHOLE DUE TO AGE, CONSTRUCTION AND GROUNDWATER INTRUSION.
- RECORD DRAWINGS WERE USED TO OBTAIN THE DIMENSIONS OF THIS MANHOLE. CONTRACTOR IS RESPONSIBLE TO VERIFY THE INFORMATION PROVIDED PRIOR TO BEGINNING ANY WORK ON OR AROUND THE STRUCTURE.
- THE CONTRACTOR SHALL COMPLY WITH OSHA STANDARDS FOR WORK IN CONFINED SPACES. DANGEROUS LEVEL OF HYDROGEN SULFIDE MAY BE PRESENT AT WORK LOCATION AT ANY TIME. CONTRACTOR SHALL SUBMIT PRE-CONSTRUCTION AND POST-REHABILITATION VIDEO AND PHOTO DOCUMENTATION OF WORK.
- WORK ON REHABILITATION TO BE PERFORMED DURING LOW FLOW CONDITIONS. CONTRACTOR TO COORDINATE THESE TIMES WITH THE FACILITY OWNER. FLOW BYPASS IS NOT ALLOWED.
- ACCESS PROJECT AREA AND PROVIDE RESILIENT MANHOLE CONNECTOR ACCORDING TO ASTM C 923.
- EXISTING STEPS IN THE MANHOLE SHALL NOT BE USED FOR ACCESS. APPROPRIATE ARRANGEMENT SHALL BE MADE BY THE CONTRACTOR FOR ACCESSING THE MANHOLE.
- REMOVE ALL LOOSE MATERIAL AND DEBRIS OF THE MANHOLE'S EXISTING INTERNAL SURFACE IN ORDER TO INSPECT THE DEGREE OF RESTORATION REQUIRED (STRUCTURAL OR NON-STRUCTURAL DAMAGE) AND PERFORM MANHOLE SEALING.
- MANHOLE STRUCTURE SEALING INCLUDES SEALING OF BARREL JOINTS, WALLS, CORBEL/CONE AND CHIMNEY USING CHEMICAL OR CEMENT GROUTING. THE CONTRACTOR SHALL PROVIDE APPROPRIATE SEALING MATERIAL SUCH AS AVANTI AV-275 SOILGROUT WITH AV-219 FIBROTITE OR MAINSTAY ML-72 SPRAYABLE MICROSILICA RESTORATION MORTAR WITH DS-5 100% SOLID EPOXY COATING OR ANY SIMILAR SYSTEM BY RAVEN. THICKNESS OF THE LINER SHALL BE AS PER MANUFACTURER'S RECOMMENDATION.
- 14" & 4" PIPE CONNECTION: BRICKS TO BE BROKEN OUT TO MAKE AND PROVIDE AN OPENING 6 INCHES LARGER THAN THE OUTSIDE DIAMETER OF THE NEW PIPE. INSTALL WATERSTOP AROUND NEW PIPE AND FILL WITH NON SHRINK GROUT.
- THE ABOVE RECOMMENDATIONS ARE BASED ON THE ANTICIPATED INTERNAL CONDITIONS AND NEEDS FOR PIPE CONNECTIONS, REPAIR, AND REHABILITATION OF THE INLET SEWER MANHOLE. THE CONTRACTOR MAY RECOMMEND OTHER MEASURES TO ENSURE COMPLETE REHABILITATION OF THE MANHOLE. THE CONTRACTOR SHALL PROVIDE SUBMITTAL INFORMATION ON PROPOSED MATERIALS AND METHODS FOR REVIEW AND APPROVAL.

SHEET KEY NOTES:

- EXISTING 18" PIPE SHALL BE CONCRETE SEALED. ANNULAR SPACE AROUND THE PIPE AND MANHOLE SHALL BE SEALED WITH NON SHRINK GROUT APPROVED BY THE ENGINEER.



Black & Veatch Corporation
 Chicago, Illinois
 ILLINOIS PROFESSIONAL
 DESIGN FIRM - 184.002143 -0006



AEROBIC GRANULAR SLUDGE - PHASE 1

REVISIONS AND RECORD OF ISSUE

DESIGNED:	SM
DETAILED:	AB
CHECKED:	AM/JH
APPROVED:	MR
DATE:	12/20/2022
PROJECT NO.:	411752

YARD


PROCESS MECHANICAL

INLET SEWER MANHOLE PLAN AND SECTIONS


98-M-104

119
OF
163


(SCALE BAR IS 4" AT FULL SCALE)

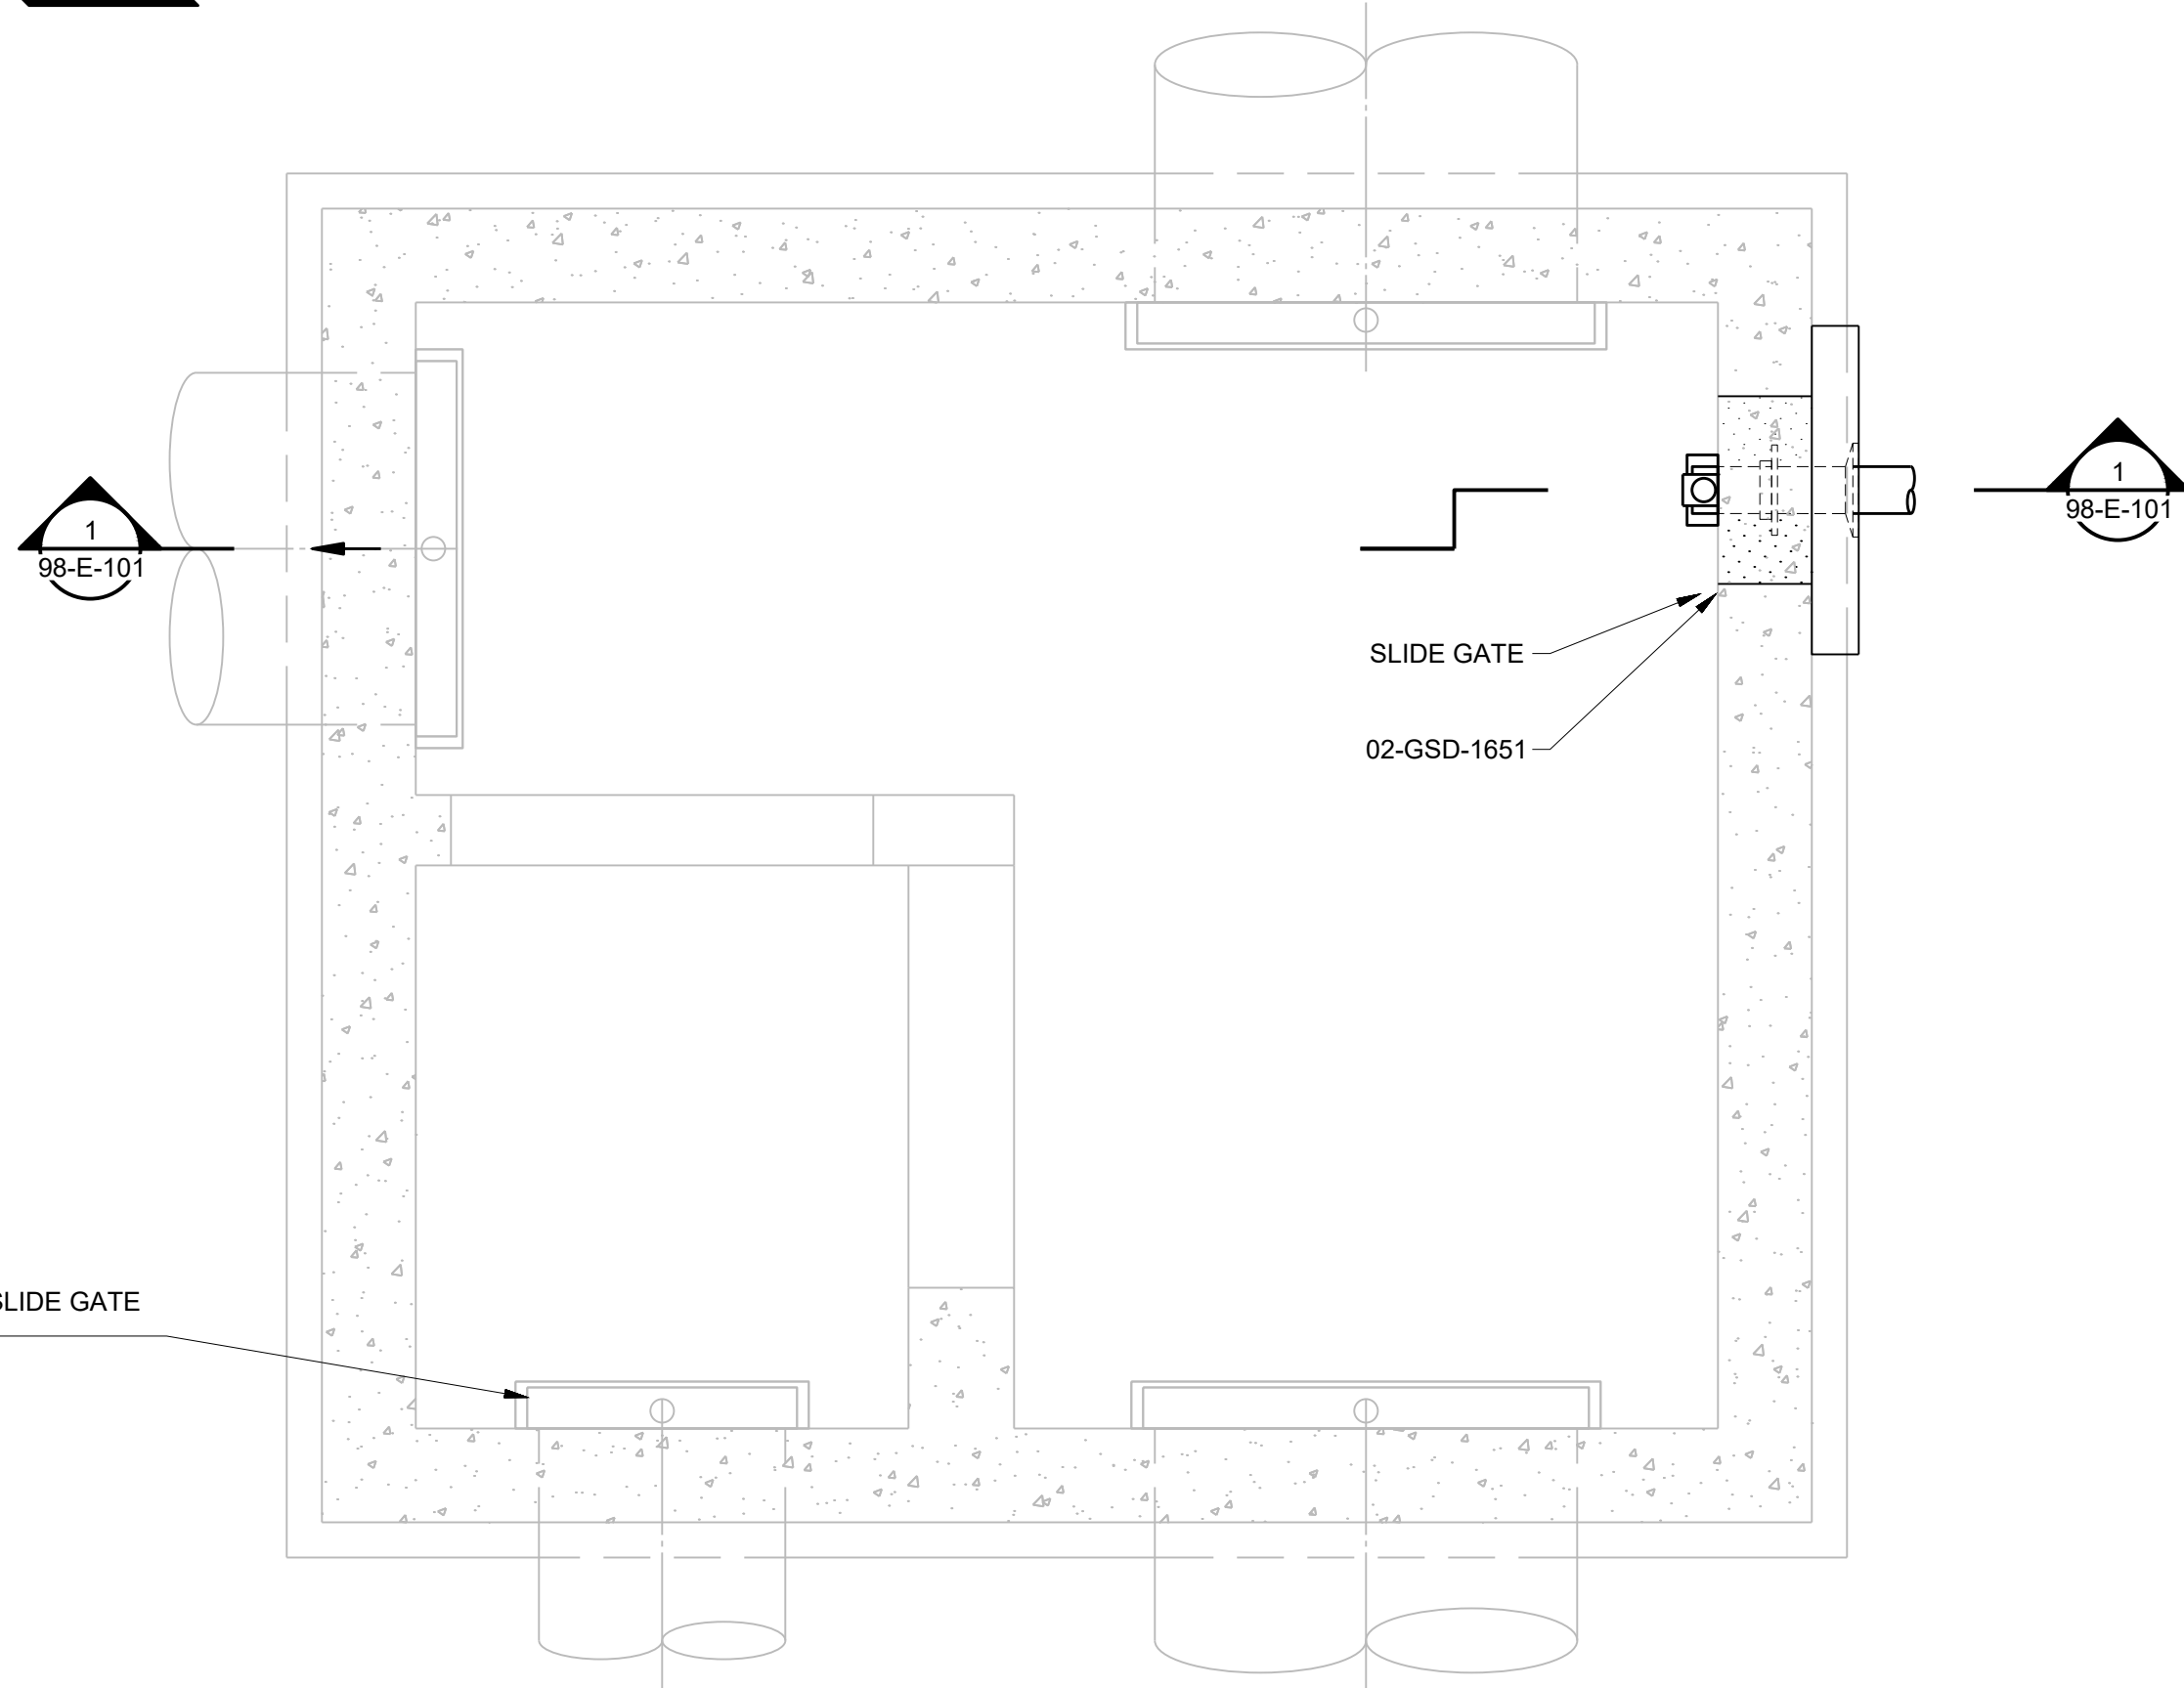


SECTIONAL PLAN
3/8" = 1'-0"

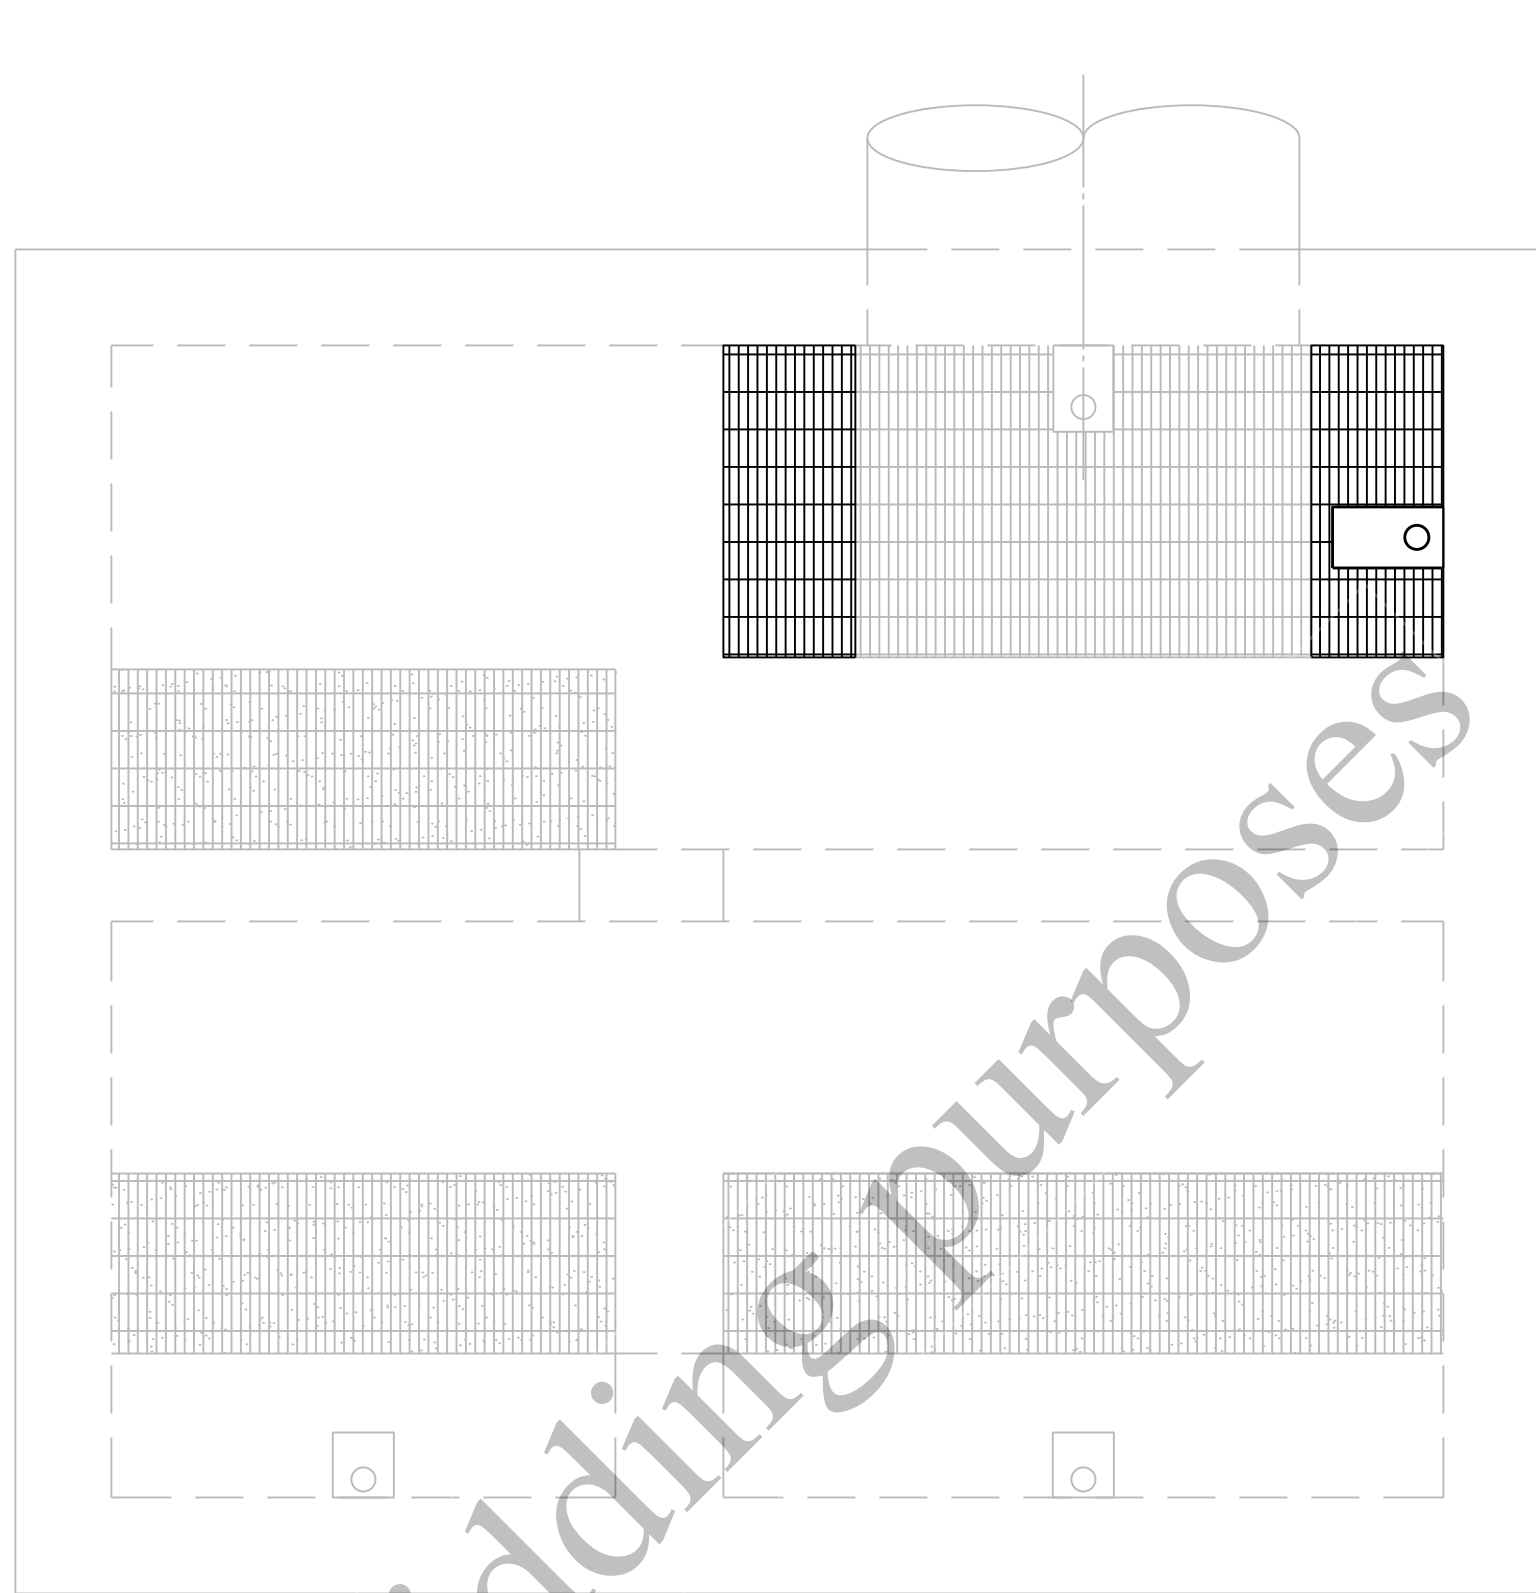

PLAN
3/8" = 1'-0"

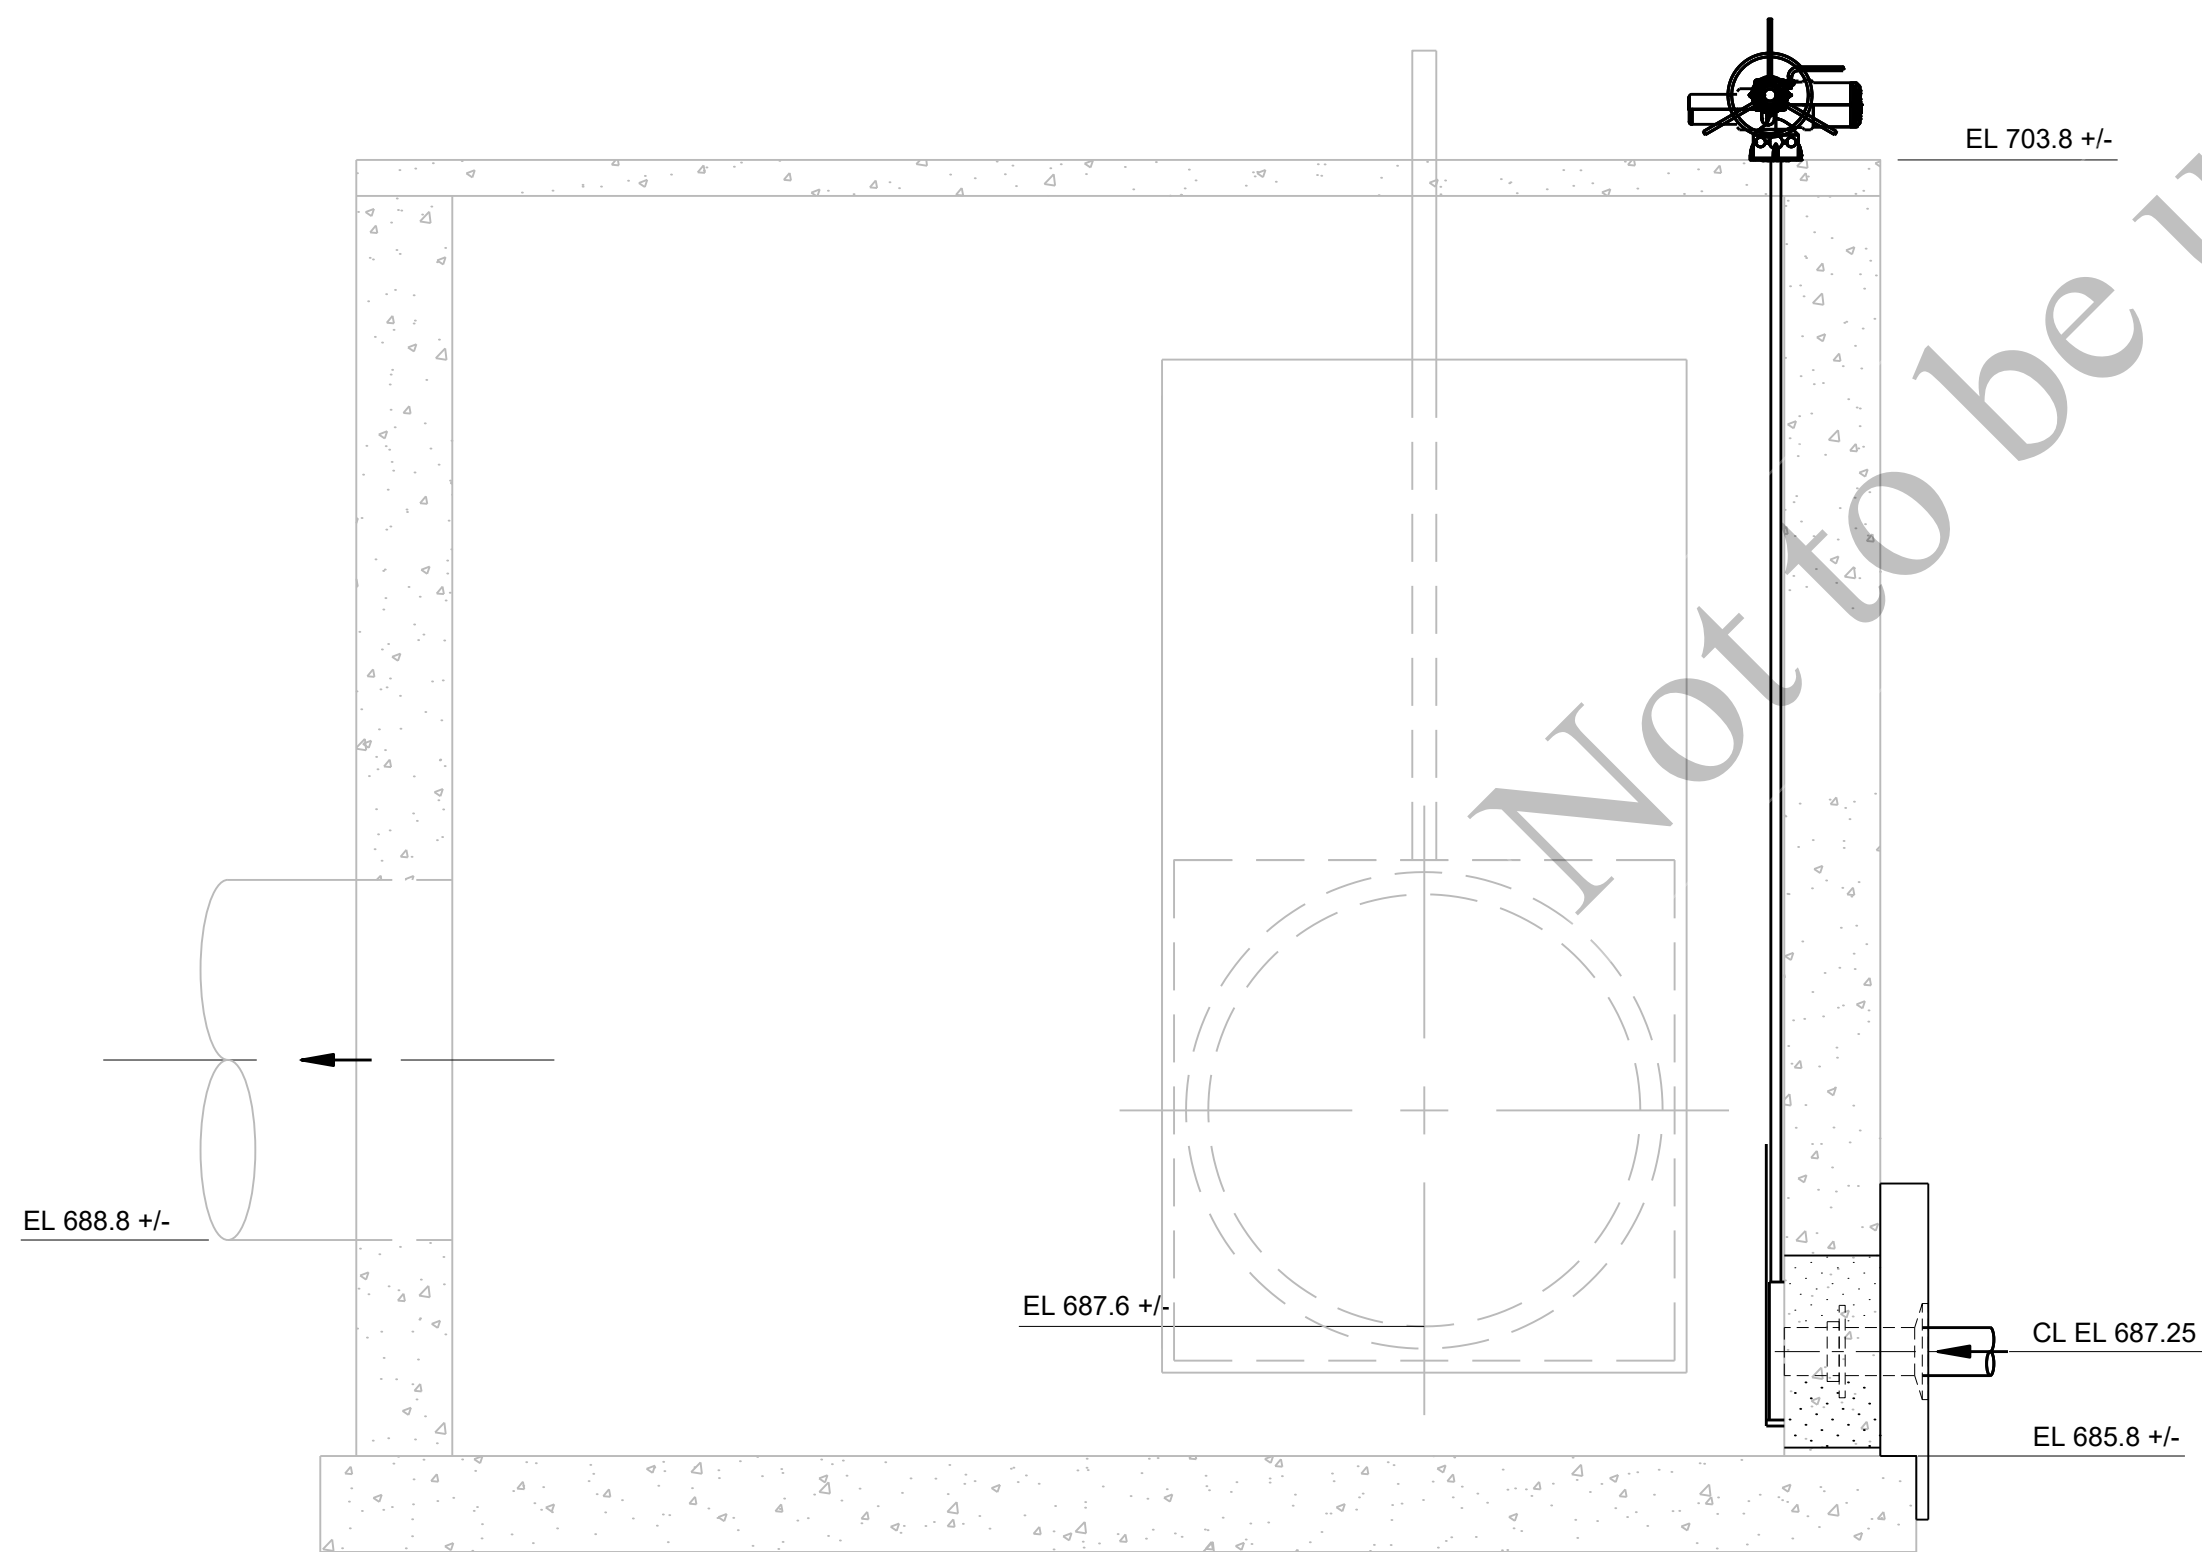

SECTION
98-M-101 3/8" = 1'-0"

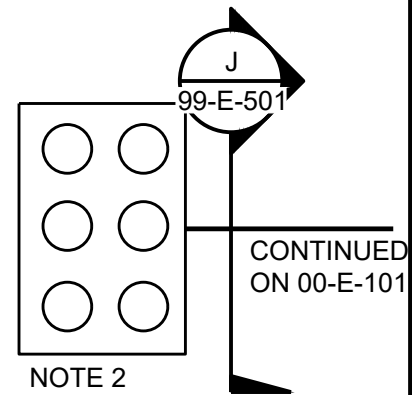

GENERAL SHEET NOTES

- SEE DRAWINGS 0-E-001 AND 00-E-002 FOR LEGENDS, ABBREVIATIONS AND NOTES.
- STUB UP DUCT BANK AND TERMINATE ALL DUCTS INTO A STAINLESS STEEL JUNCTION BOX.



Black & Veatch Corporation
Chicago, Illinois
ILLINOIS PROFESSIONAL
DESIGN FIRM - 184.002143 -0006

SHEET KEY NOTES:



AEROBIC GRANULAR
SLUDGE - PHASE 1

REVISIONS AND RECORD OF ISSUE	
DESIGNED:	EJB
DETAILED:	SFR
CHECKED:	SDS
APPROVED:	EJB
DATE:	12/20/2022

PROJECT NO.: 411752


YARD

ELECTRICAL


DISTRIBUTION CHAMBER
PLANS AND SECTIONS

98-E-101


120
OF
163

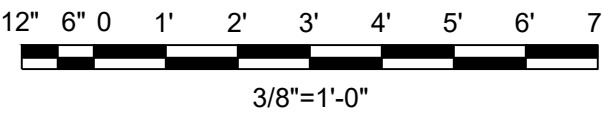

(SCALE BAR IS 4" AT FULL SCALE) 0 1/2 1 2 3 4

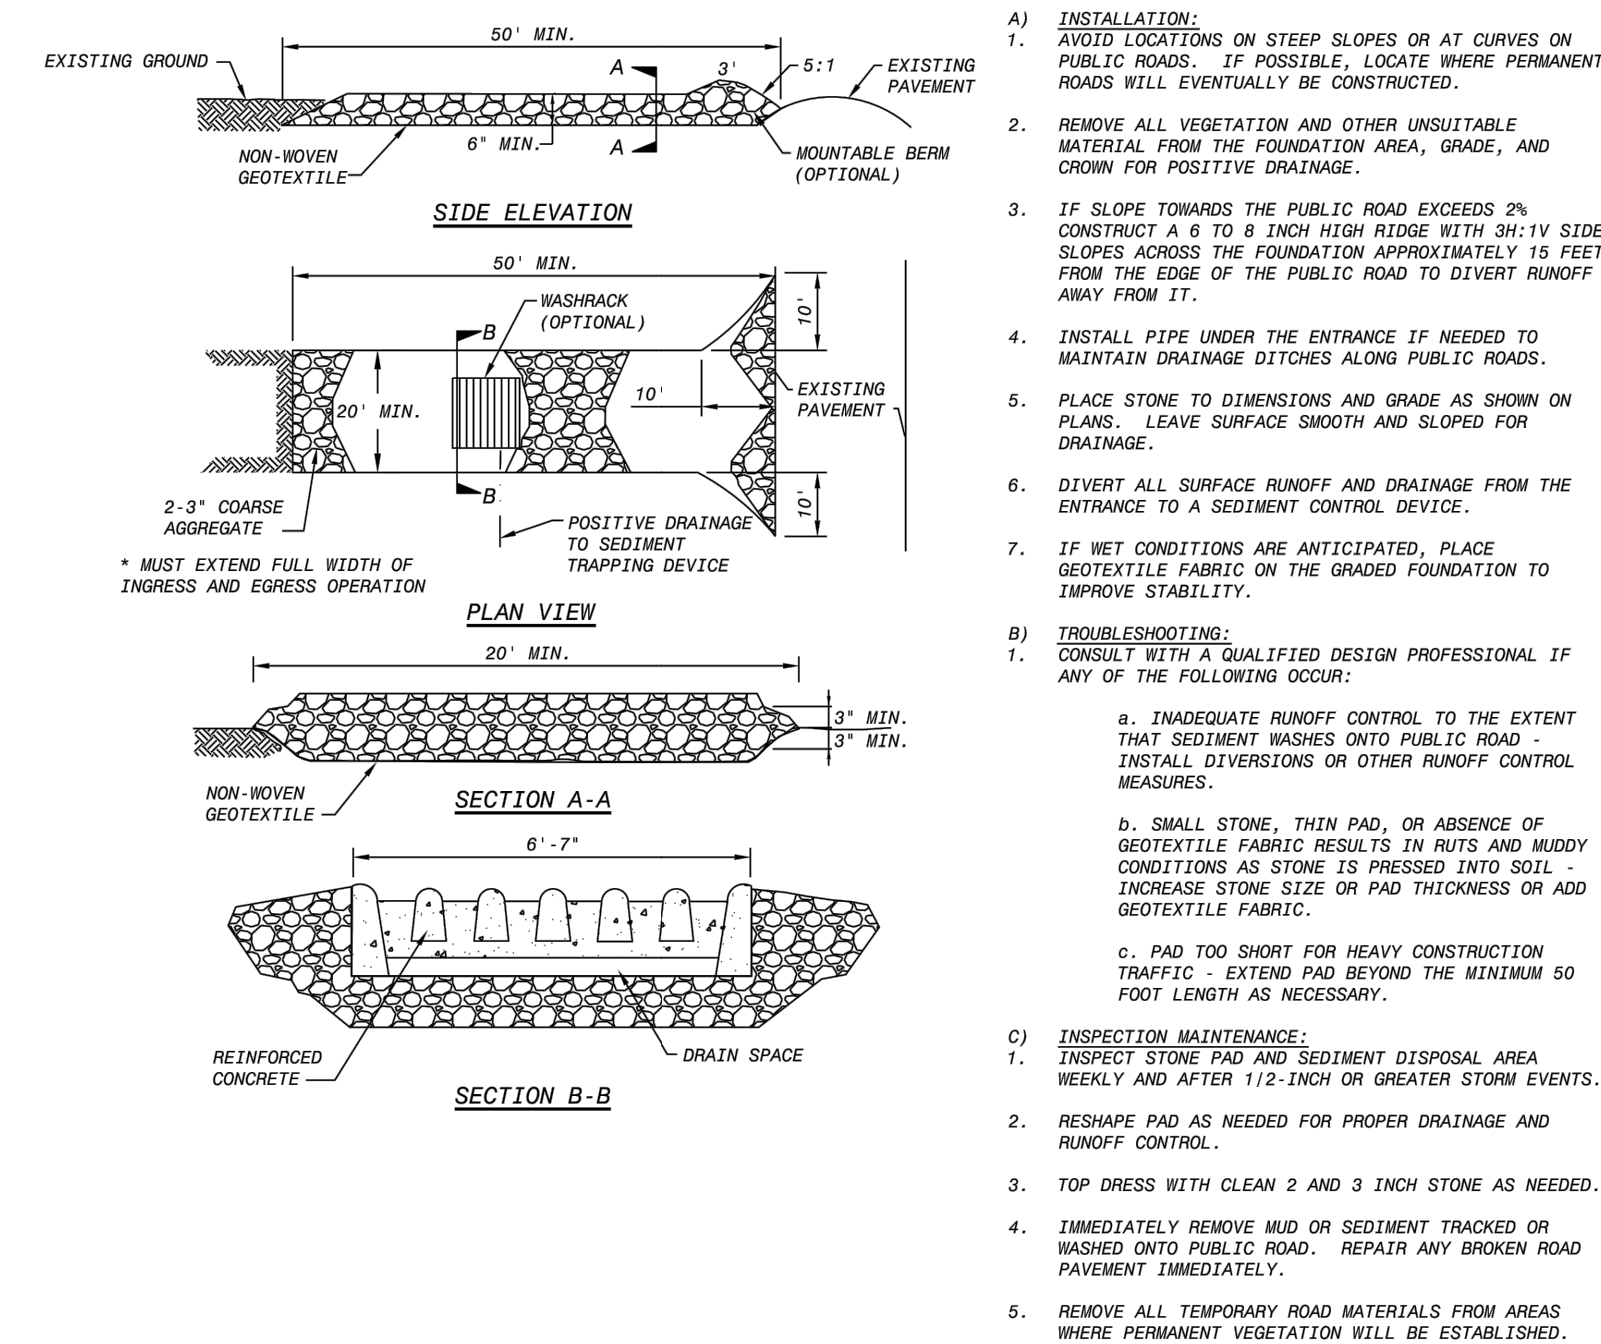

TEMPORARY CONSTRUCTION ENTRANCE
00-C-102 NO SCALE

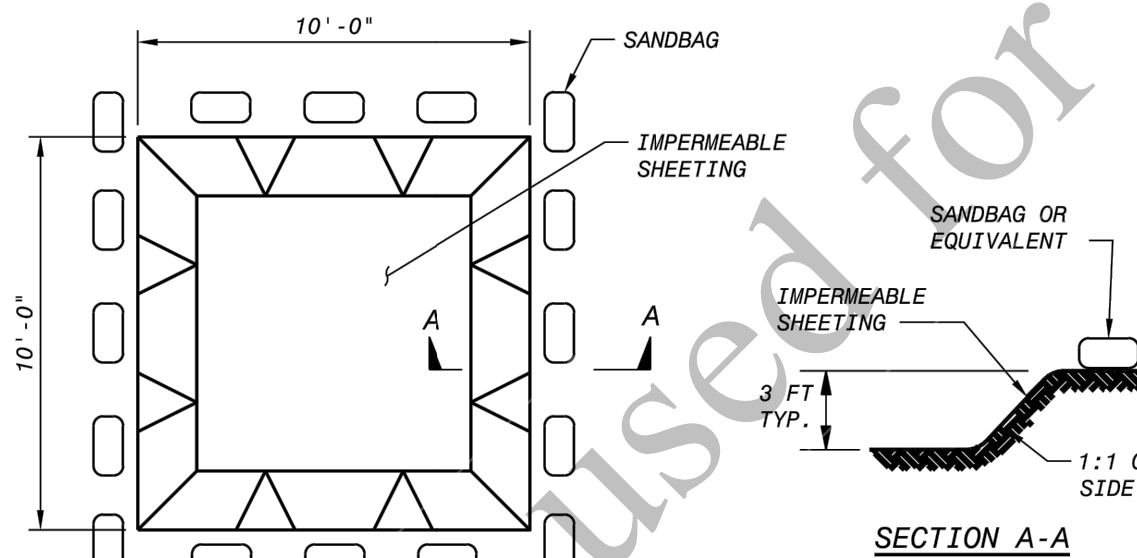

CONCRETE WASHOUT
00-C-102 NO SCALE

STORM WATER POLLUTION PREVENTION PLAN
NO SCALE

GENERAL NOTES

1. THE ESTIMATED AREA OF DISTURBANCE FOR THIS PROJECT EXCEEDS 1 ACRE.
2. A NOTICE OF INTENT (N.O.I.) WILL BE FILLED.
3. A STORM WATER POLLUTION PREVENTION PLAN (S.W.P.P.P) HAS BEEN PREPARED FOR THIS PROJECT.
4. THE CONTRACTOR SHALL INSTALL A SWPPP MAILBOX IN AN ACCESSIBLE LOCATION ONSITE THAT SHALL CONTAIN THE SWPPP PLAN, ANY CHANGES TO THE SWPPP PLAN, INSPECTION REPORTS, AND ALL OTHER RELEVANT DOCUMENTS.
5. THE CONTRACTOR SHALL COMPLY WITH ALL APPLICABLE REQUIREMENT OF THE ILLINOIS URBAN MANUAL, CURRENT EDITION, I.D.O.T. STANDARD SPECIFICATIONS FOR ROAD AND BRIDGE CONSTRUCTION, CURRENT EDITION, AND THE PROJECT SPECIFICATIONS AND DETAILS.
6. THE EROSION CONTROL DEVICES, MATERIALS AND PROCEDURES SHOWN IN THESE PLANS ARE TO BE CONSIDERED A MINIMUM. ADDITIONAL DEVICES OR MATERIALS MAY BE REQUIRED BASED ON EXISTING SITE CONDITIONS, AT THE DIRECTION OF THE ENGINEER. ANY DEVICES, MATERIALS, OR PROCEDURES REQUIRED BY THE ENGINEER DUE TO THE CONTRACTOR'S ACTIONS OR NEGLIGENCE WILL BE AT NO ADDITIONAL COST TO THE DISTRICT.
7. ALL DISTURBED AREAS SHALL BE SEEDED UNLESS AGRICULTURAL OR OTHERWISE NOTED ON THE PLANS.
8. THE CONTRACTOR IS RESTRICTED TO WORK IN TEMPORARY EASEMENTS OR WORK AREAS DELINEATED ON PLANS.
9. THE CONTRACTOR SHALL TAKE WHATEVER ACTIONS AND MEASURES ARE DEEMED NECESSARY BY THE AUTHORITY OR AUTHORIZED AGENCY TO ELIMINATE EXCESSIVE SILTATION OR EROSION AND TO STABILIZE THE PROJECT AREA.
10. DISCHARGE OF HAZARDOUS SUBSTANCES INTO STORM WATER IS SUBJECT TO IEPA REPORTING AND CLEANUP REQUIREMENTS.

CONTROL MEASURES

1. EROSION AND SEDIMENT CONTROL MEASURES SHALL BE IN PLACE BEFORE CONSTRUCTION IN EACH AREA, AS DETERMINED BY THE ENGINEER, AND SHALL BE MAINTAINED THROUGHOUT CONSTRUCTION.
2. CONSTRUCTION ACTIVITIES SHALL ENSURE THAT EXISTING VEGETATION IS PRESERVED WHERE PRACTICAL.
3. THE FOLLOWING CONTROLS WILL BE PROVIDED AS A MINIMUM FOR THE DURATION OF THIS PROJECT:
 - SEDIMENT CONTROL SHALL BE PROVIDED DOWNSLOPE OF ALL STOCKPILE AREAS.
 - STABILIZED CONSTRUCTION ENTRANCES MUST BE INSTALLED AS DETAILED AND WHERE REQUIRED BY THE ROADWAY AUTHORITY OR DISTRICT.
 - INLET PROTECTION MUST BE INSTALLED FOR ALL INLETS THAT COULD BE SUBJECT TO SILTATION, AS DETERMINED BY THE ENGINEER.
 - ALL ROADWAYS SHALL BE KEPT CLEAN OF DEBRIS, MUD, SOIL, AND CONSTRUCTION MATERIALS AND SHALL BE INSPECTED AT THE END OF EACH DAY AND CLEANED AS NECESSARY.
 - ALL DISTURBED AREAS MUST BE STABILIZED WITHIN 7 DAYS IF THEY ARE TO REMAIN DISTURBED FOR MORE THAN 14 DAYS.

INSPECTIONS

1. INSPECTIONS MUST BE COMPLETED BY A QUALIFIED PERSON EVERY 7 DAYS AND WITHIN 24 HOURS OF EACH RAIN EVENT WITH OVER 0.5" OF RAIN OR SNOWFALL EQUIVALENT.
2. EROSION AND SEDIMENT CONTROL MEASURES SHALL BE REPAIRED AND MODIFIED AS NEEDED TO BE EFFECTIVE AND TO PREVENT EROSION AND POLLUTANTS FROM DISCHARGING FROM SITE.
3. A REPORT SHALL BE COMPLETED WITH EACH INSPECTION, AND SHALL BE KEPT ACCESSIBLE ONSITE WITH THE SWPPP.

MAINTENANCE

1. CONTRACTOR SHALL BE RESPONSIBLE FOR MAINTENANCE AND REPAIR OF ALL EROSION AND SEDIMENT CONTROL DEVICES AND PROTECTIVE MEASURES AS REQUIRED TO MAINTAIN THE INTENDED FUNCTION.
2. SEDIMENT COLLECTED FROM THE CONSTRUCTION SITE SHALL BE DISPOSAL OF ON THE SITE ON A REGULAR BASIS AS NEEDED.
3. ANY DEBRIS OR SILT DEPOSITED IN THE FLOW LINE OF DRAINAGE STRUCTURE, DITCHES, ETC. THAT COULD OBSTRUCT FLOW SHALL BE REMOVED AT THE CLOSE OF EACH WORKING DAY.
4. ALL DRAINAGE STRUCTURES SHALL BE FREE OF DIRT AND DEBRIS. THE CONTRACTOR SHALL REMOVE AND DISPOSAL OF ALL TEMPORARY EROSION CONTROL DEVICES WITHIN 30 DAYS OF FINAL SITE STABILIZATION APPROVAL BY THE AUTHORITY.
5. THE SITE SHALL HAVE MIN. OF 70% VEGETATIVE COVER TO BE CONSIDERED STABILIZED.

OTHER DISCHARGES

1. NON STORM WATER DISCHARGES INCLUDING WASHING OF VEHICLES, CONCRETE WASH-OUT, WATER FOR DUST CONTROL, AND TRENCH DEWATERING DISCHARGES SHALL BE DIRECTED AWAY FROM UNPROTECTED, BARE, OR UNSTABILIZED SOIL AND APPROPRIATE MEASURES SHALL BE IMPLEMENT TO PREVENT EROSION OR DEGRADATION OF RUNOFF FROM THE SITE.
2. DEWATERING DISCHARGE MUST BE INTO SILT CONTAINMENT BAGS WITH PROPERLY ENGINEERED ANIONIC POLYMER AND FABRIC PORE SIZE.
3. UNDER NO CIRCUMSTANCE SHALL DEWATERING DISCHARGE BE ALLOWED TO FLOW DIRECTLY INTO WATERWAYS.
4. A DEWATERING DISCHARGE PLAN BE SUBMITTED TO THE AUTHORITY FOR APPROVAL.

REVISIONS AND RECORD OF ISSUE	
DESIGNED:	SM
DETAILED:	AB
CHECKED:	AM/JH
APPROVED:	MR
DATE:	12/20/2022


PROJECT NO.: 411752

DETAILS


CIVIL

**EROSION CONTROL
DETAILS**


PLOTTED: 12/12/2022 10:16:01 PM
 FILE: C:\PW\WORKING\BWV_AMERICAS\01495388\09-C-502.DWG
 FDI1000
 D11000

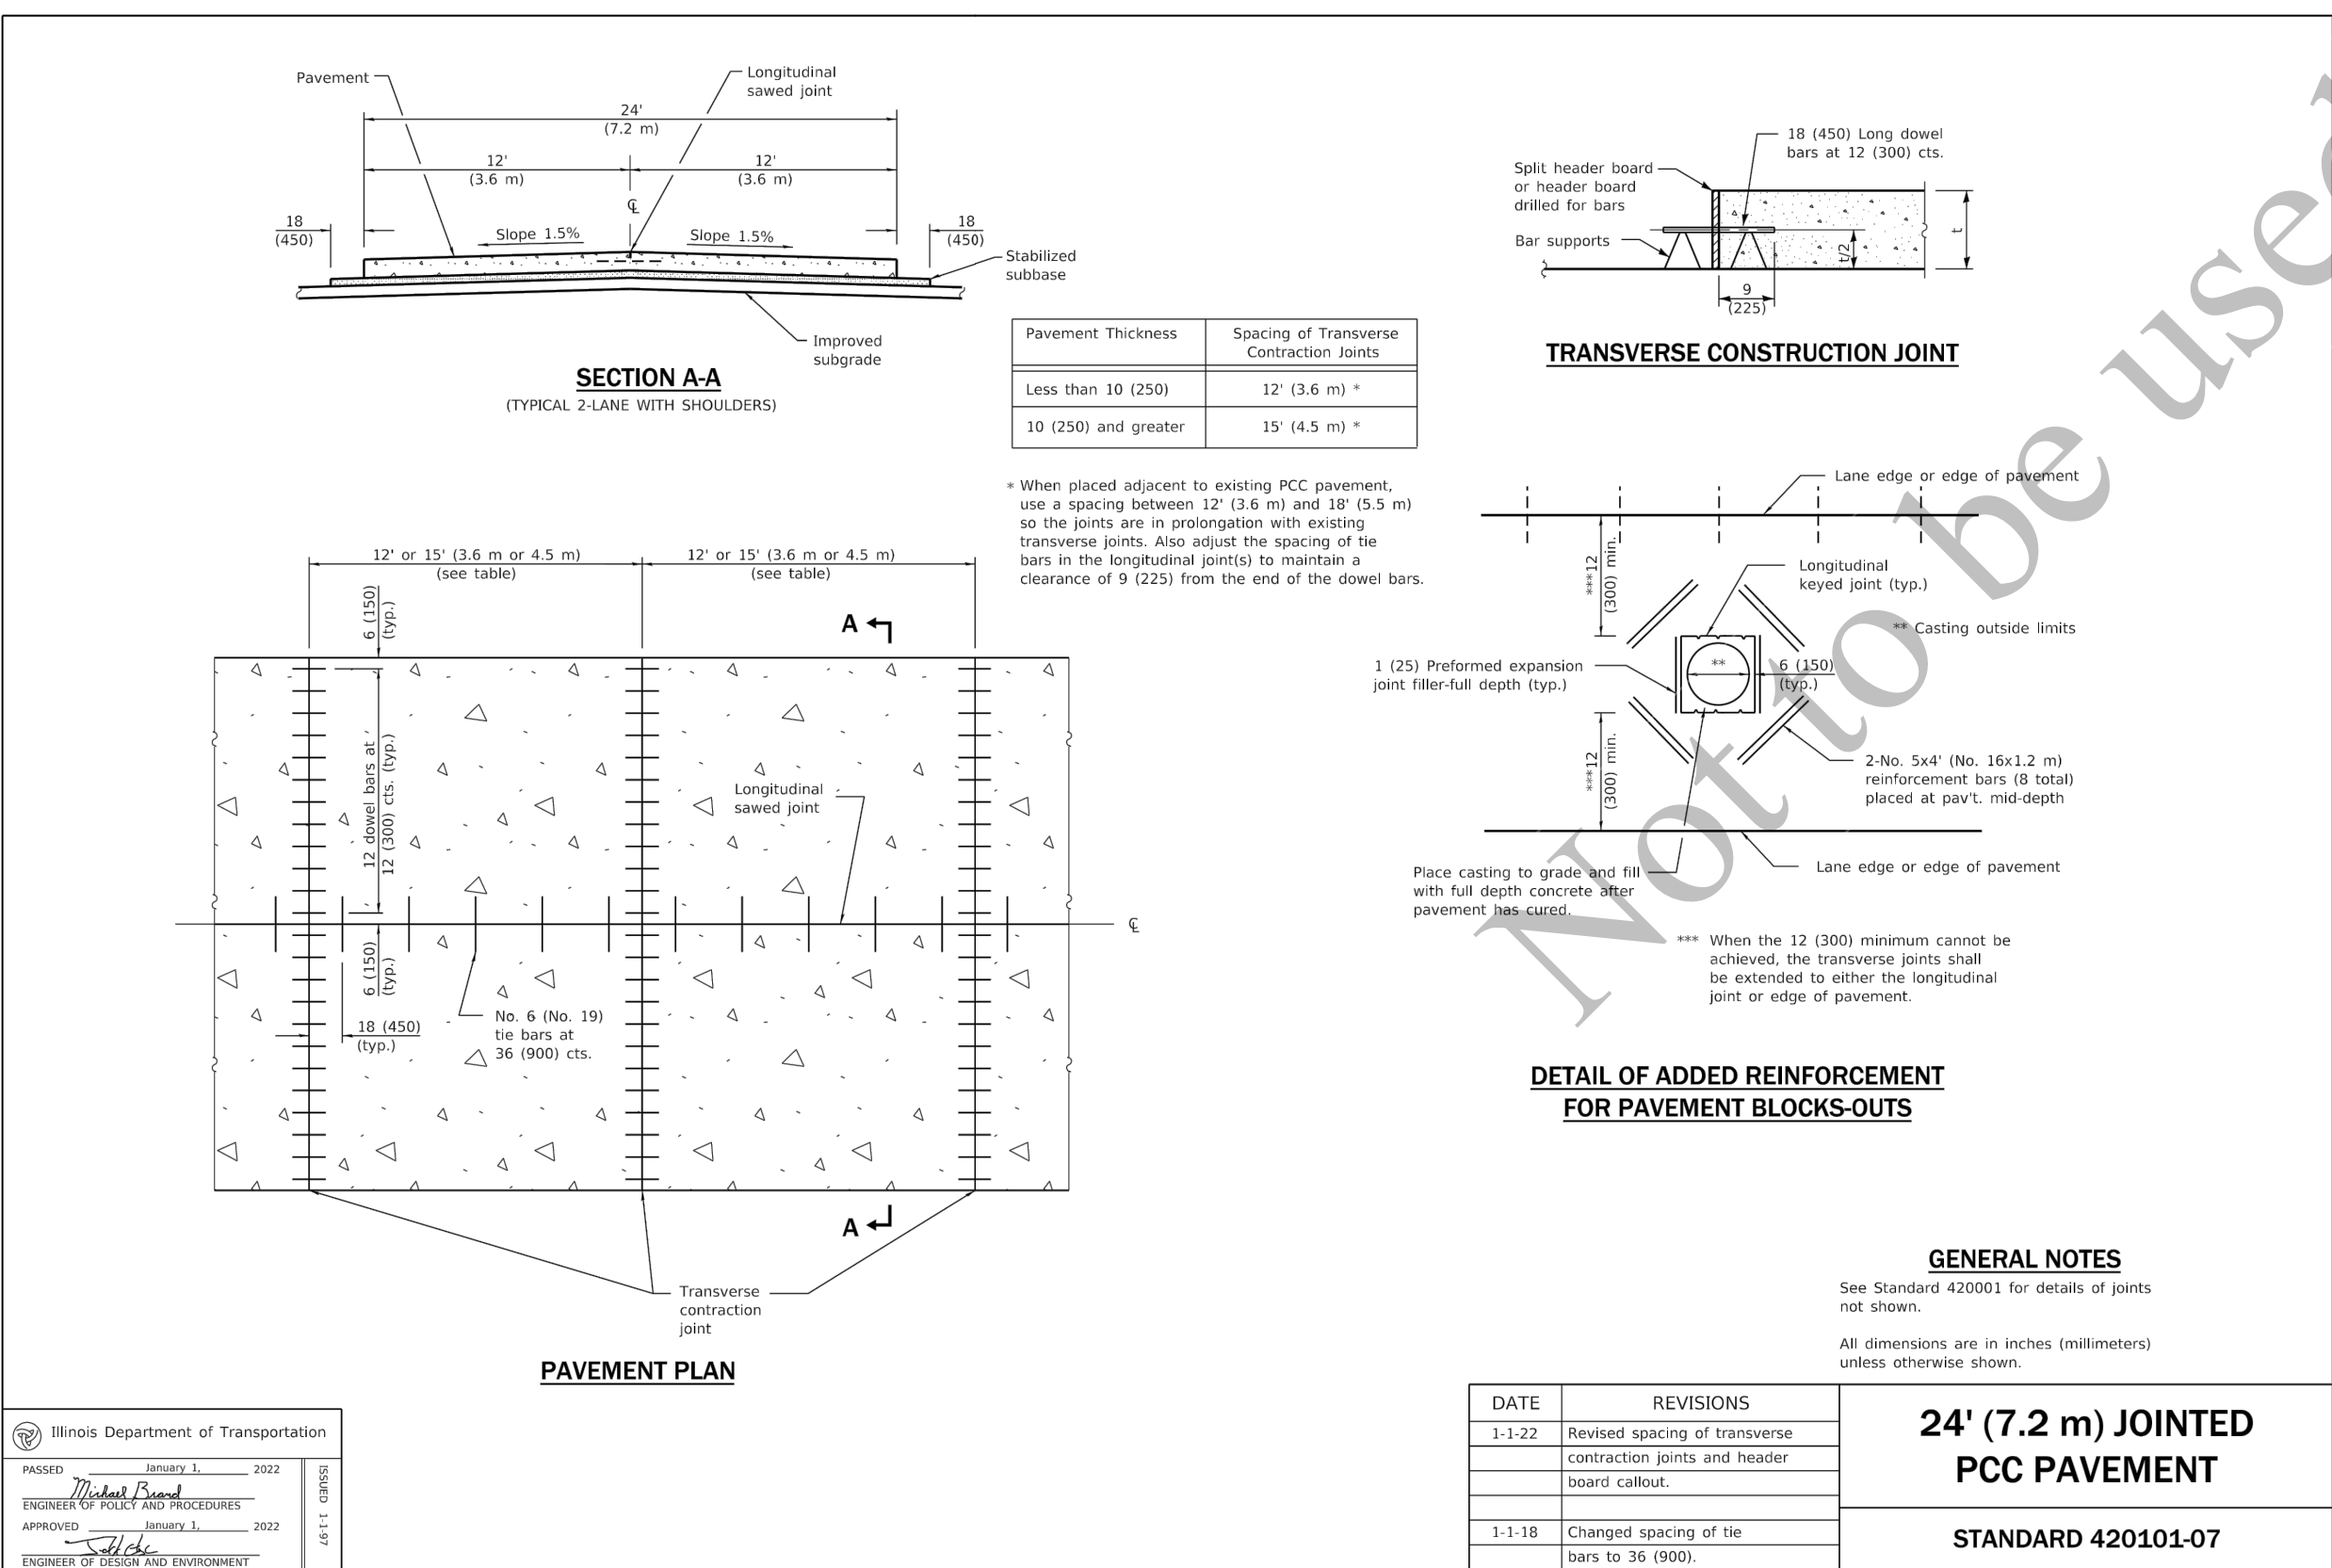

B
 CONCRETE PAVEMENT
 NO SCALE

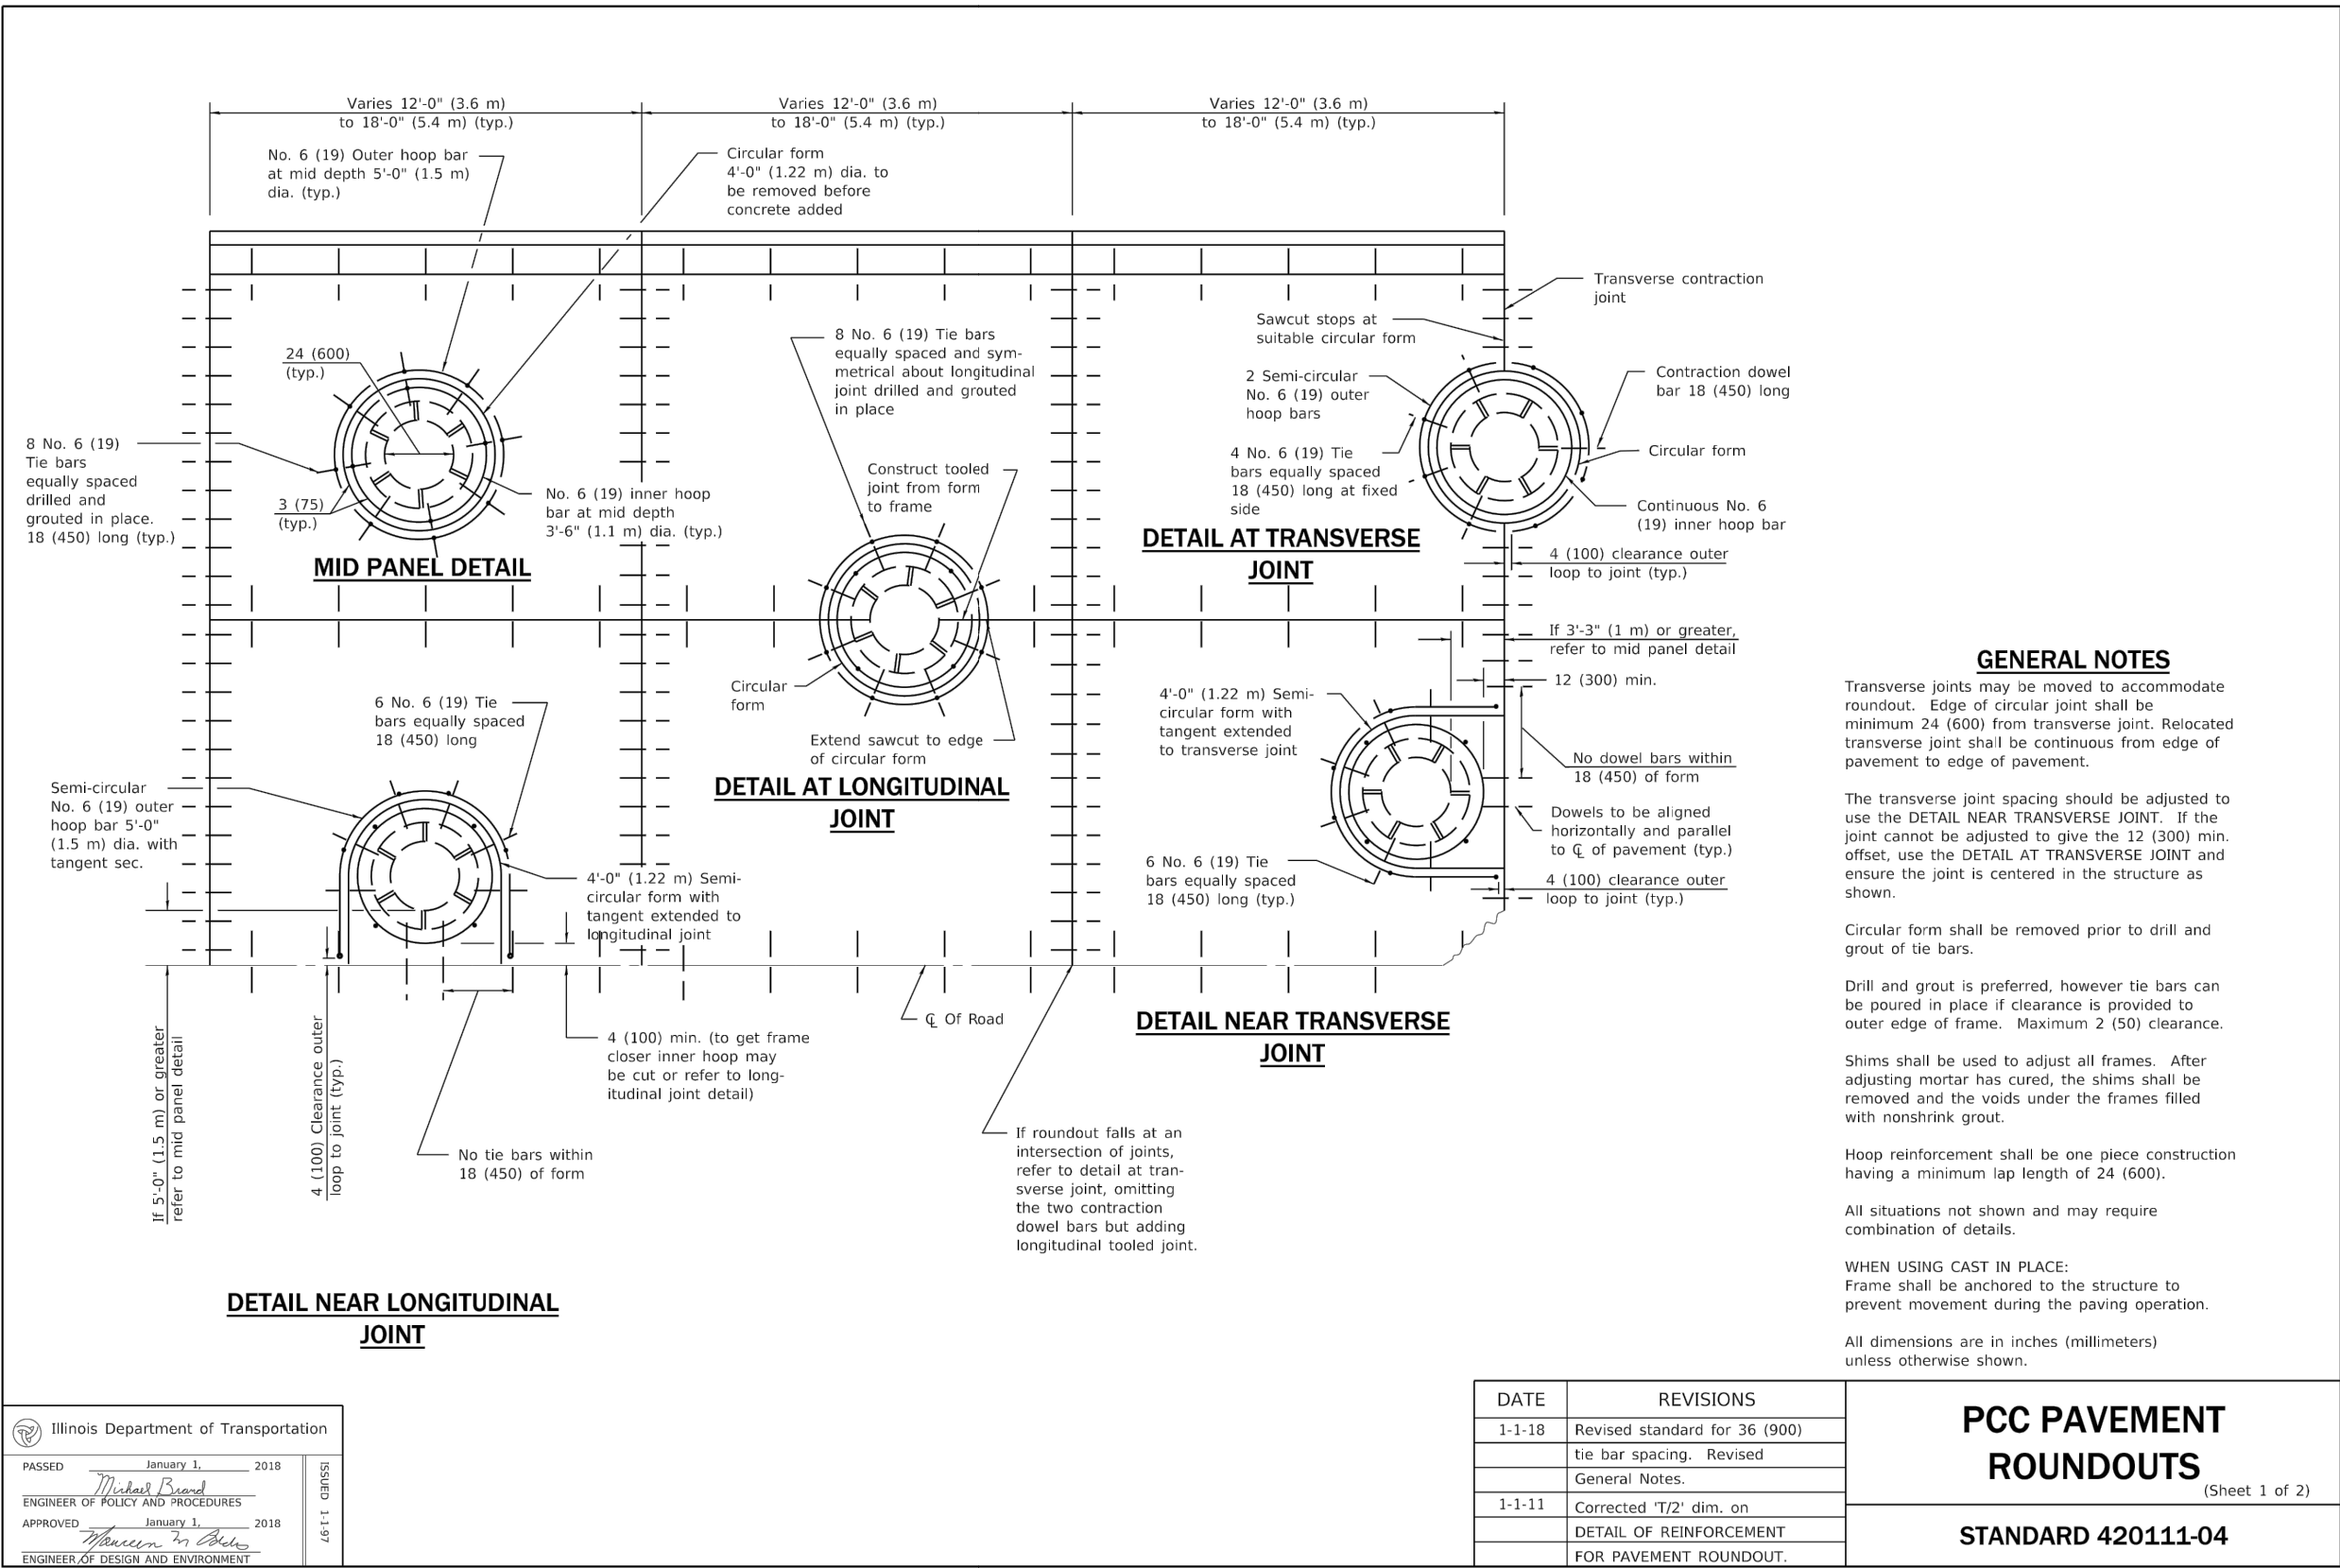

A
 PAVEMENT ROUNDOUTS
 NO SCALE

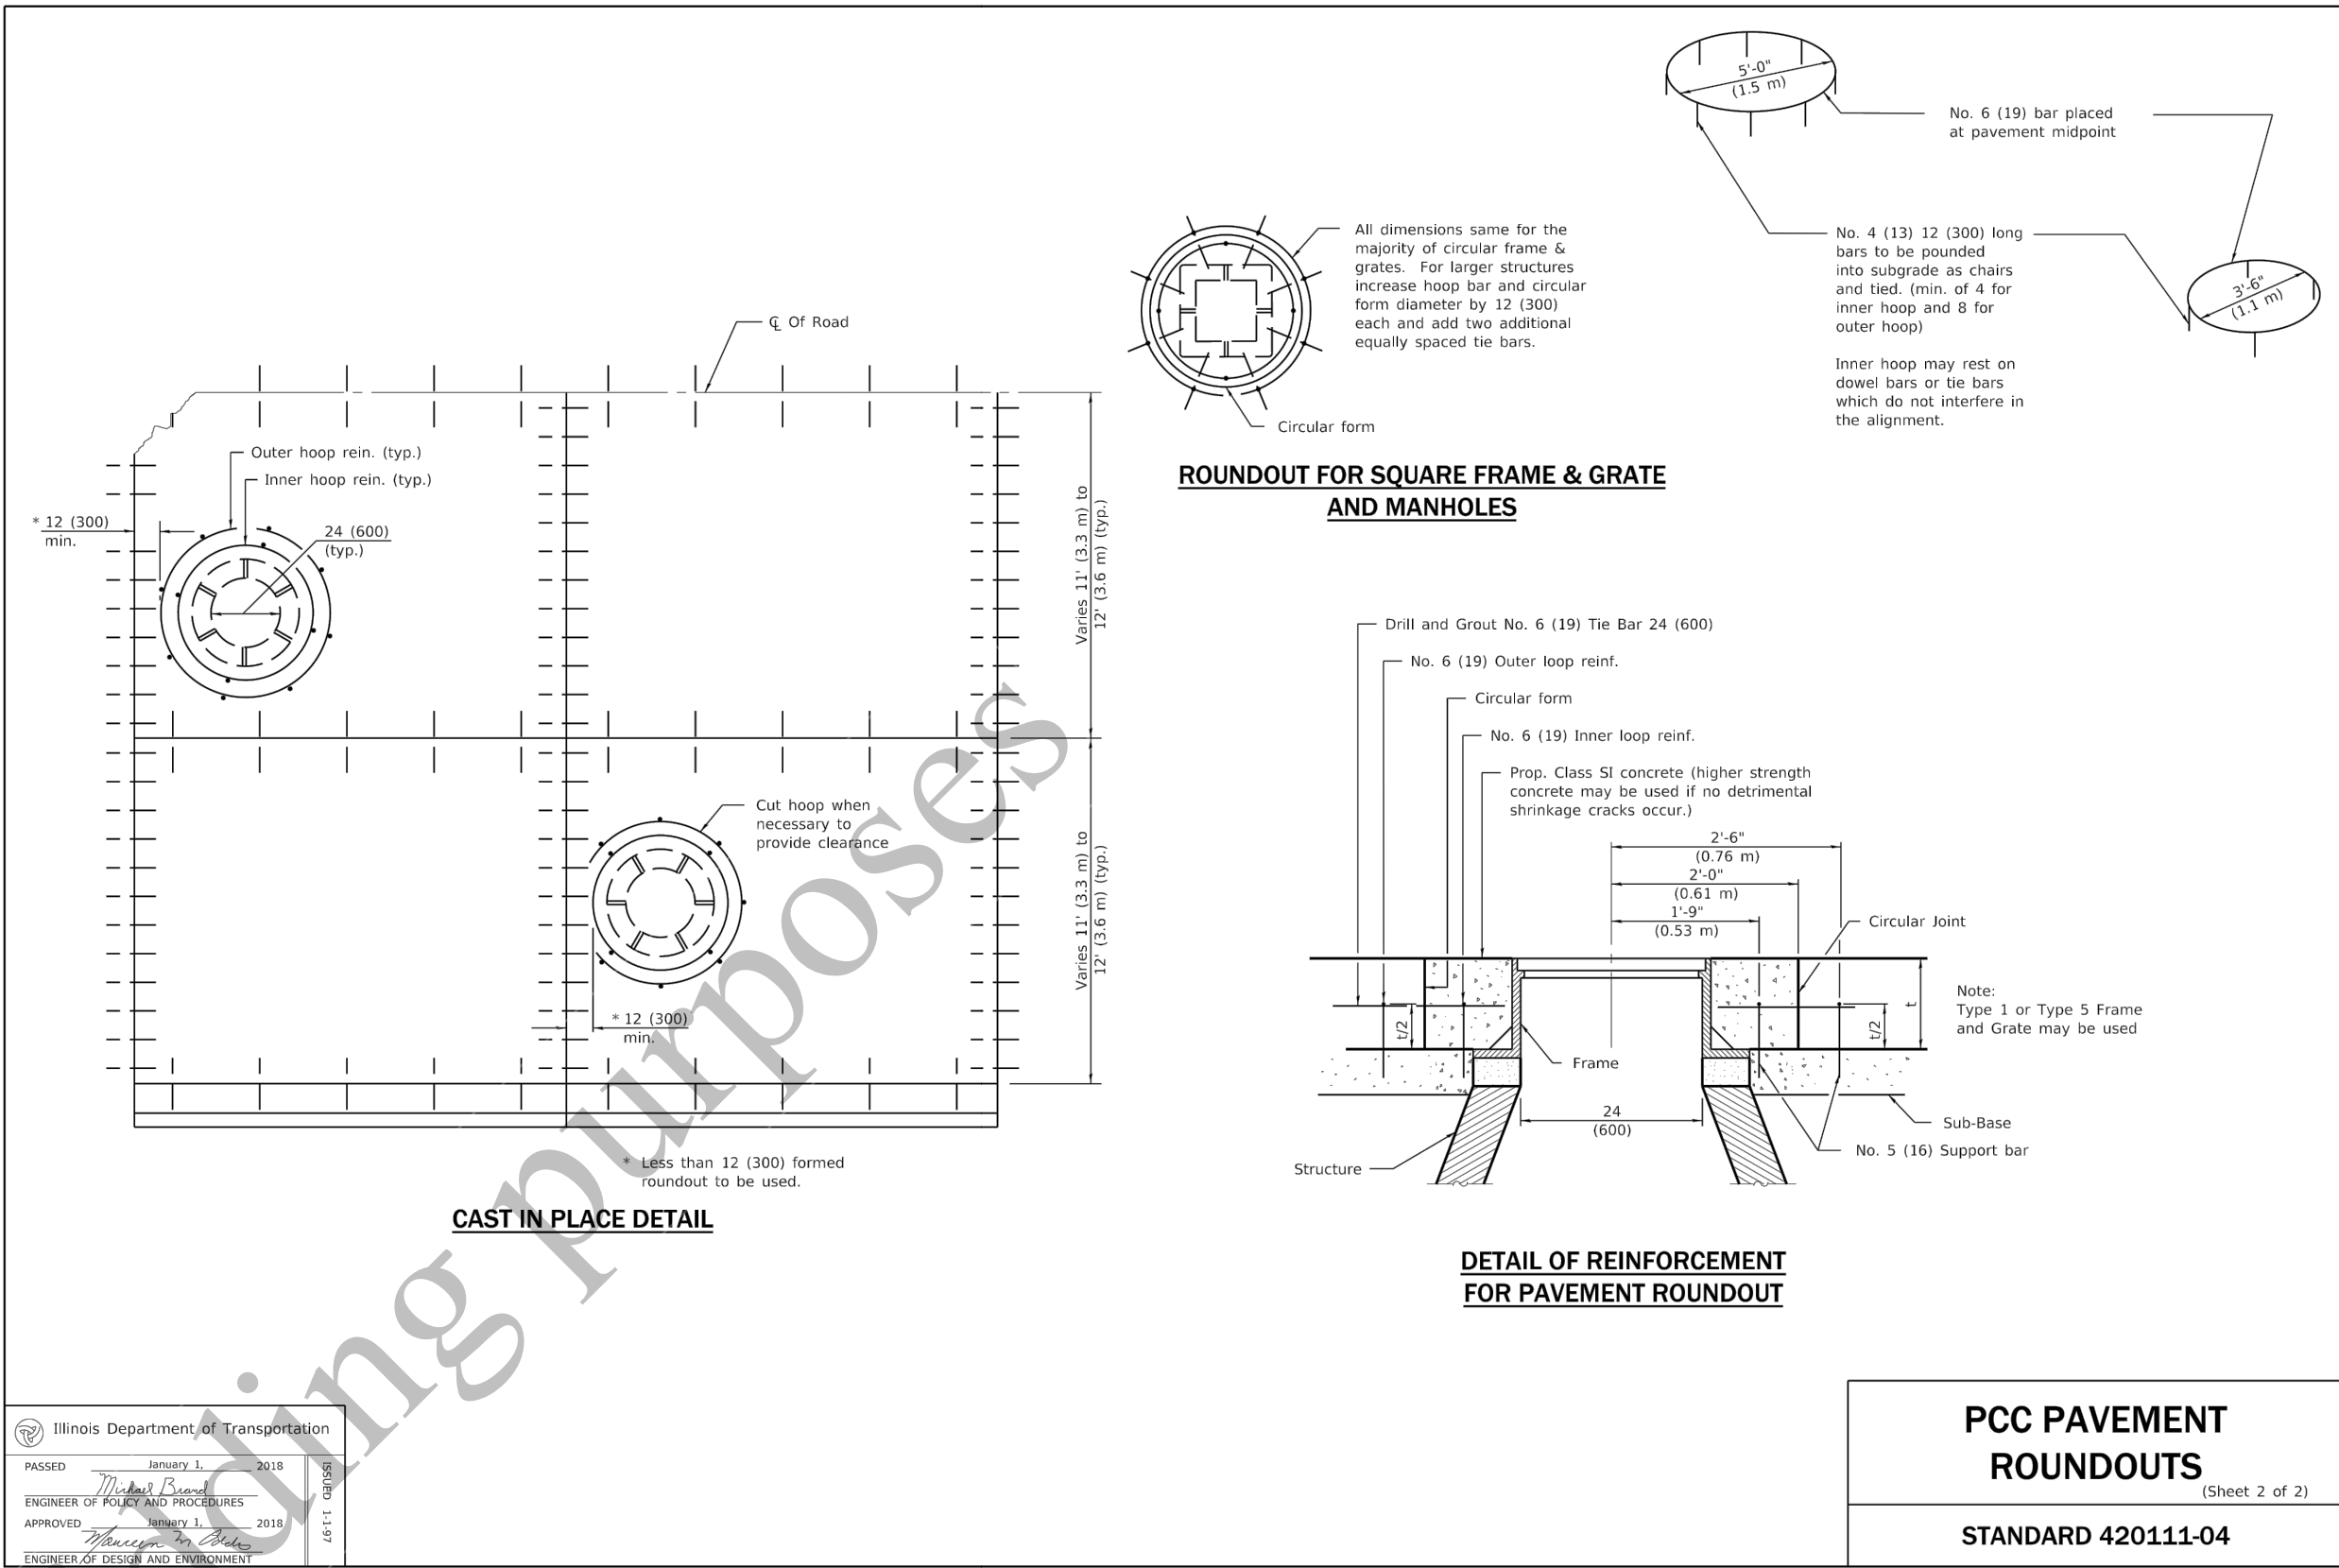

REVISIONS AND RECORD OF ISSUE	
DESIGNED:	SM
DETAILED:	AB
CHECKED:	AM/JH
APPROVED:	MR
DATE:	12/20/2022
PROJECT NO.:	411752




DETAILS

CIVIL


CIVIL DETAILS 1 OF 6

99-C-502

122
 OF
 163

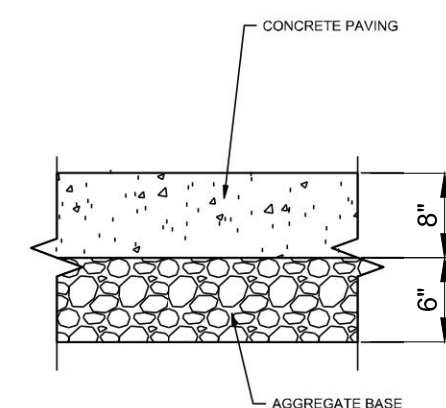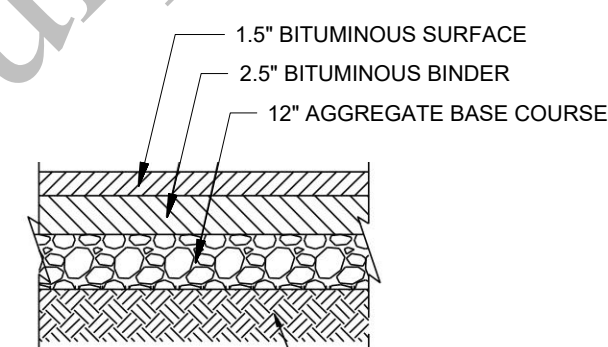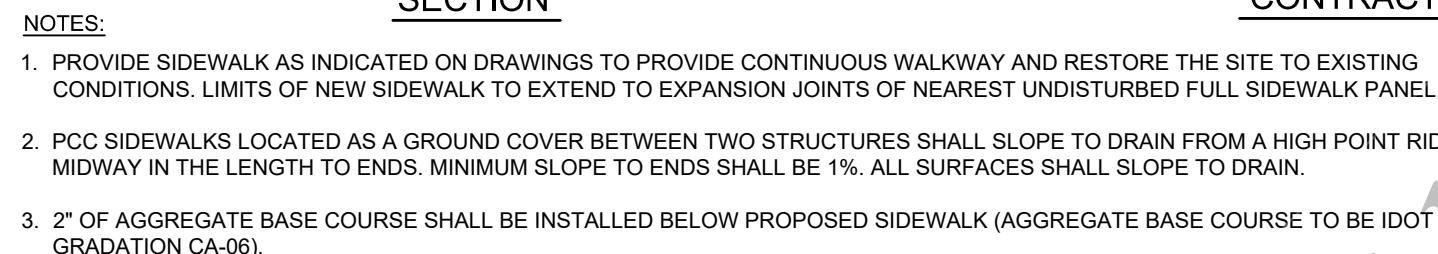


NOTES:
AGGREGATE BASE COURSE UNDER THE PCC PAVEMENT SHALL BE 8" IN THICKNESS (6" LIFT OF CA-02 CAPPED WITH A 2" LIFT OF CA-06

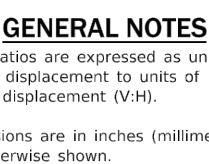

DATE	REVISIONS
1-1-22	Revised DOWEL BAR TABLE on Sheet 2.
1-1-18	Changed tie bar spacing to 36 (900) cts. Revised DOWEL BAR TABLE

PAVEMENT JOINTS

STANDARD 420001-10

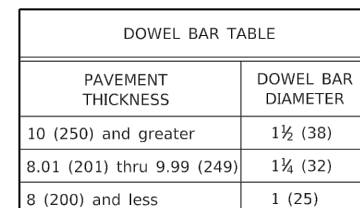

PAVEMENT JOINTS

(Sheet 2 of 2)

REVISIONS AND RECORD OF ISSUE	
DESIGNED:	SM
DETAILED:	AB
CHECKED:	AM/JH
APPROVED:	MR
DATE:	12/20/2022
PROJECT NO.:	411752



DETAILS




CIVIL

CIVIL DETAILS 3 OF 6



99-C-504

124
OF
163










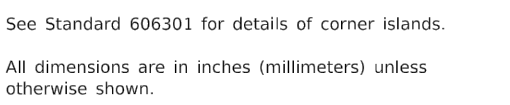
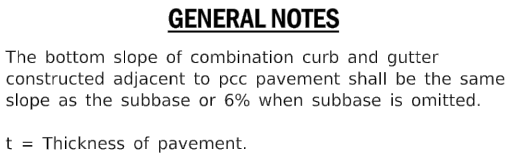


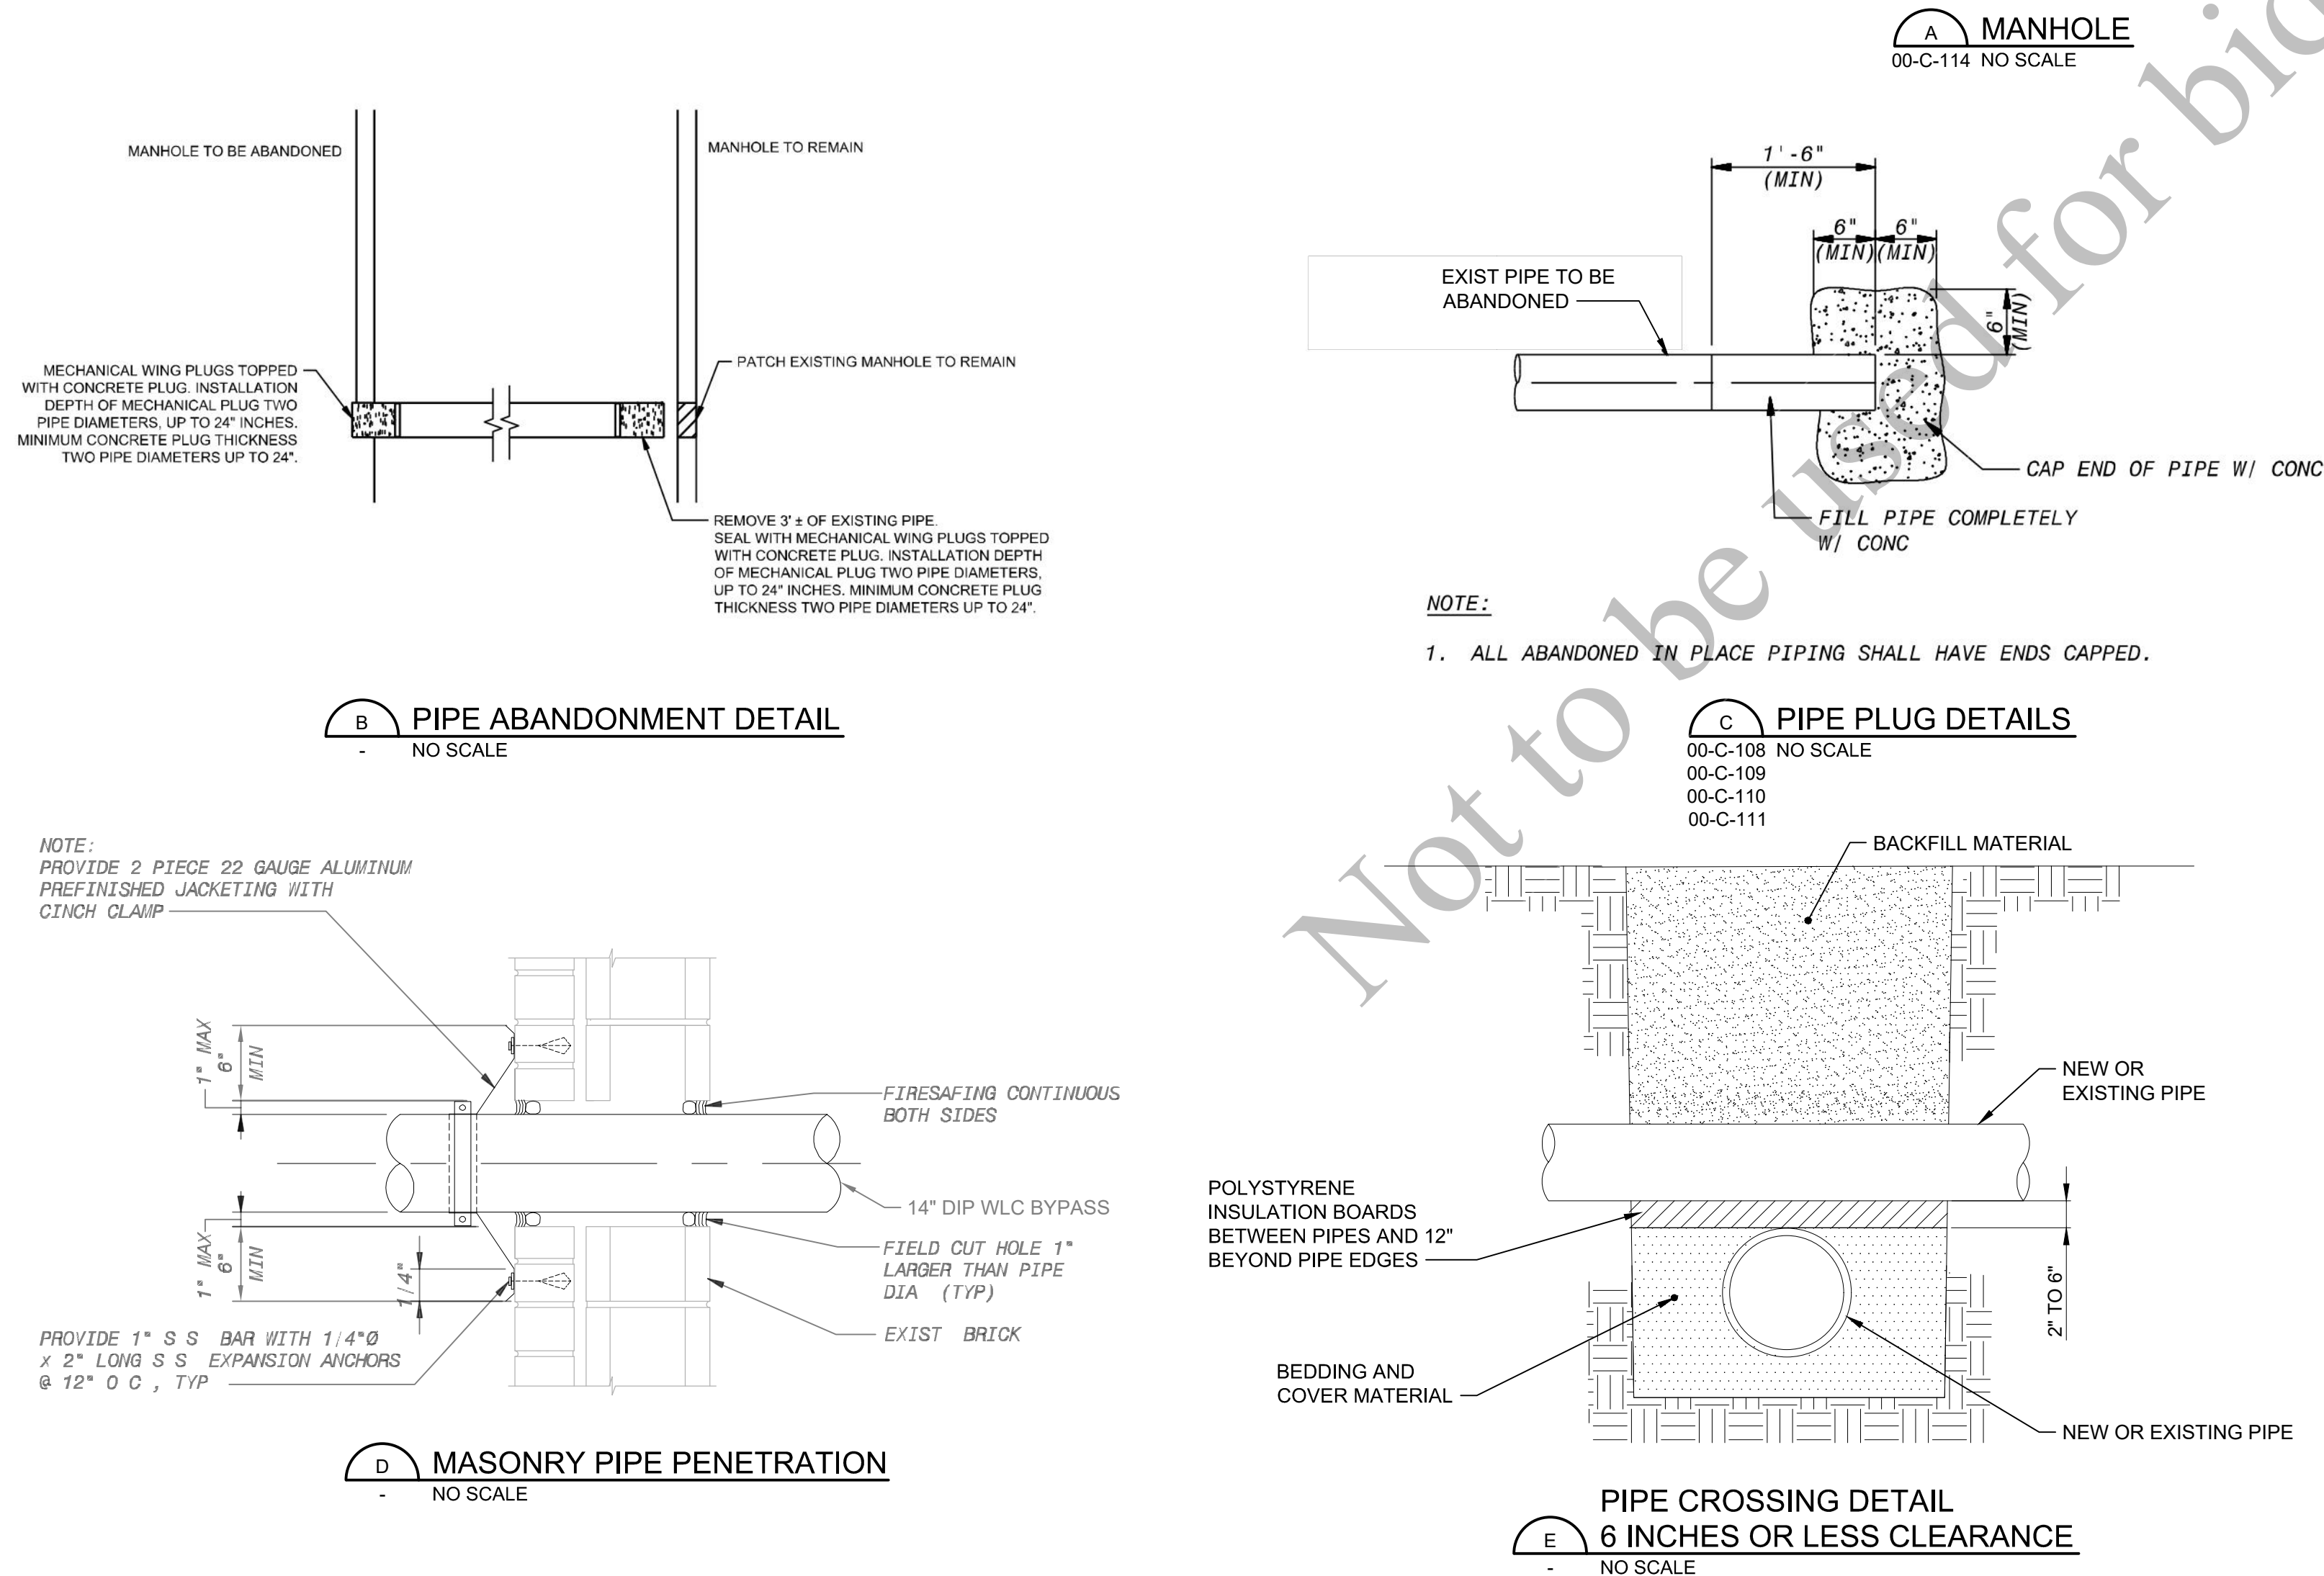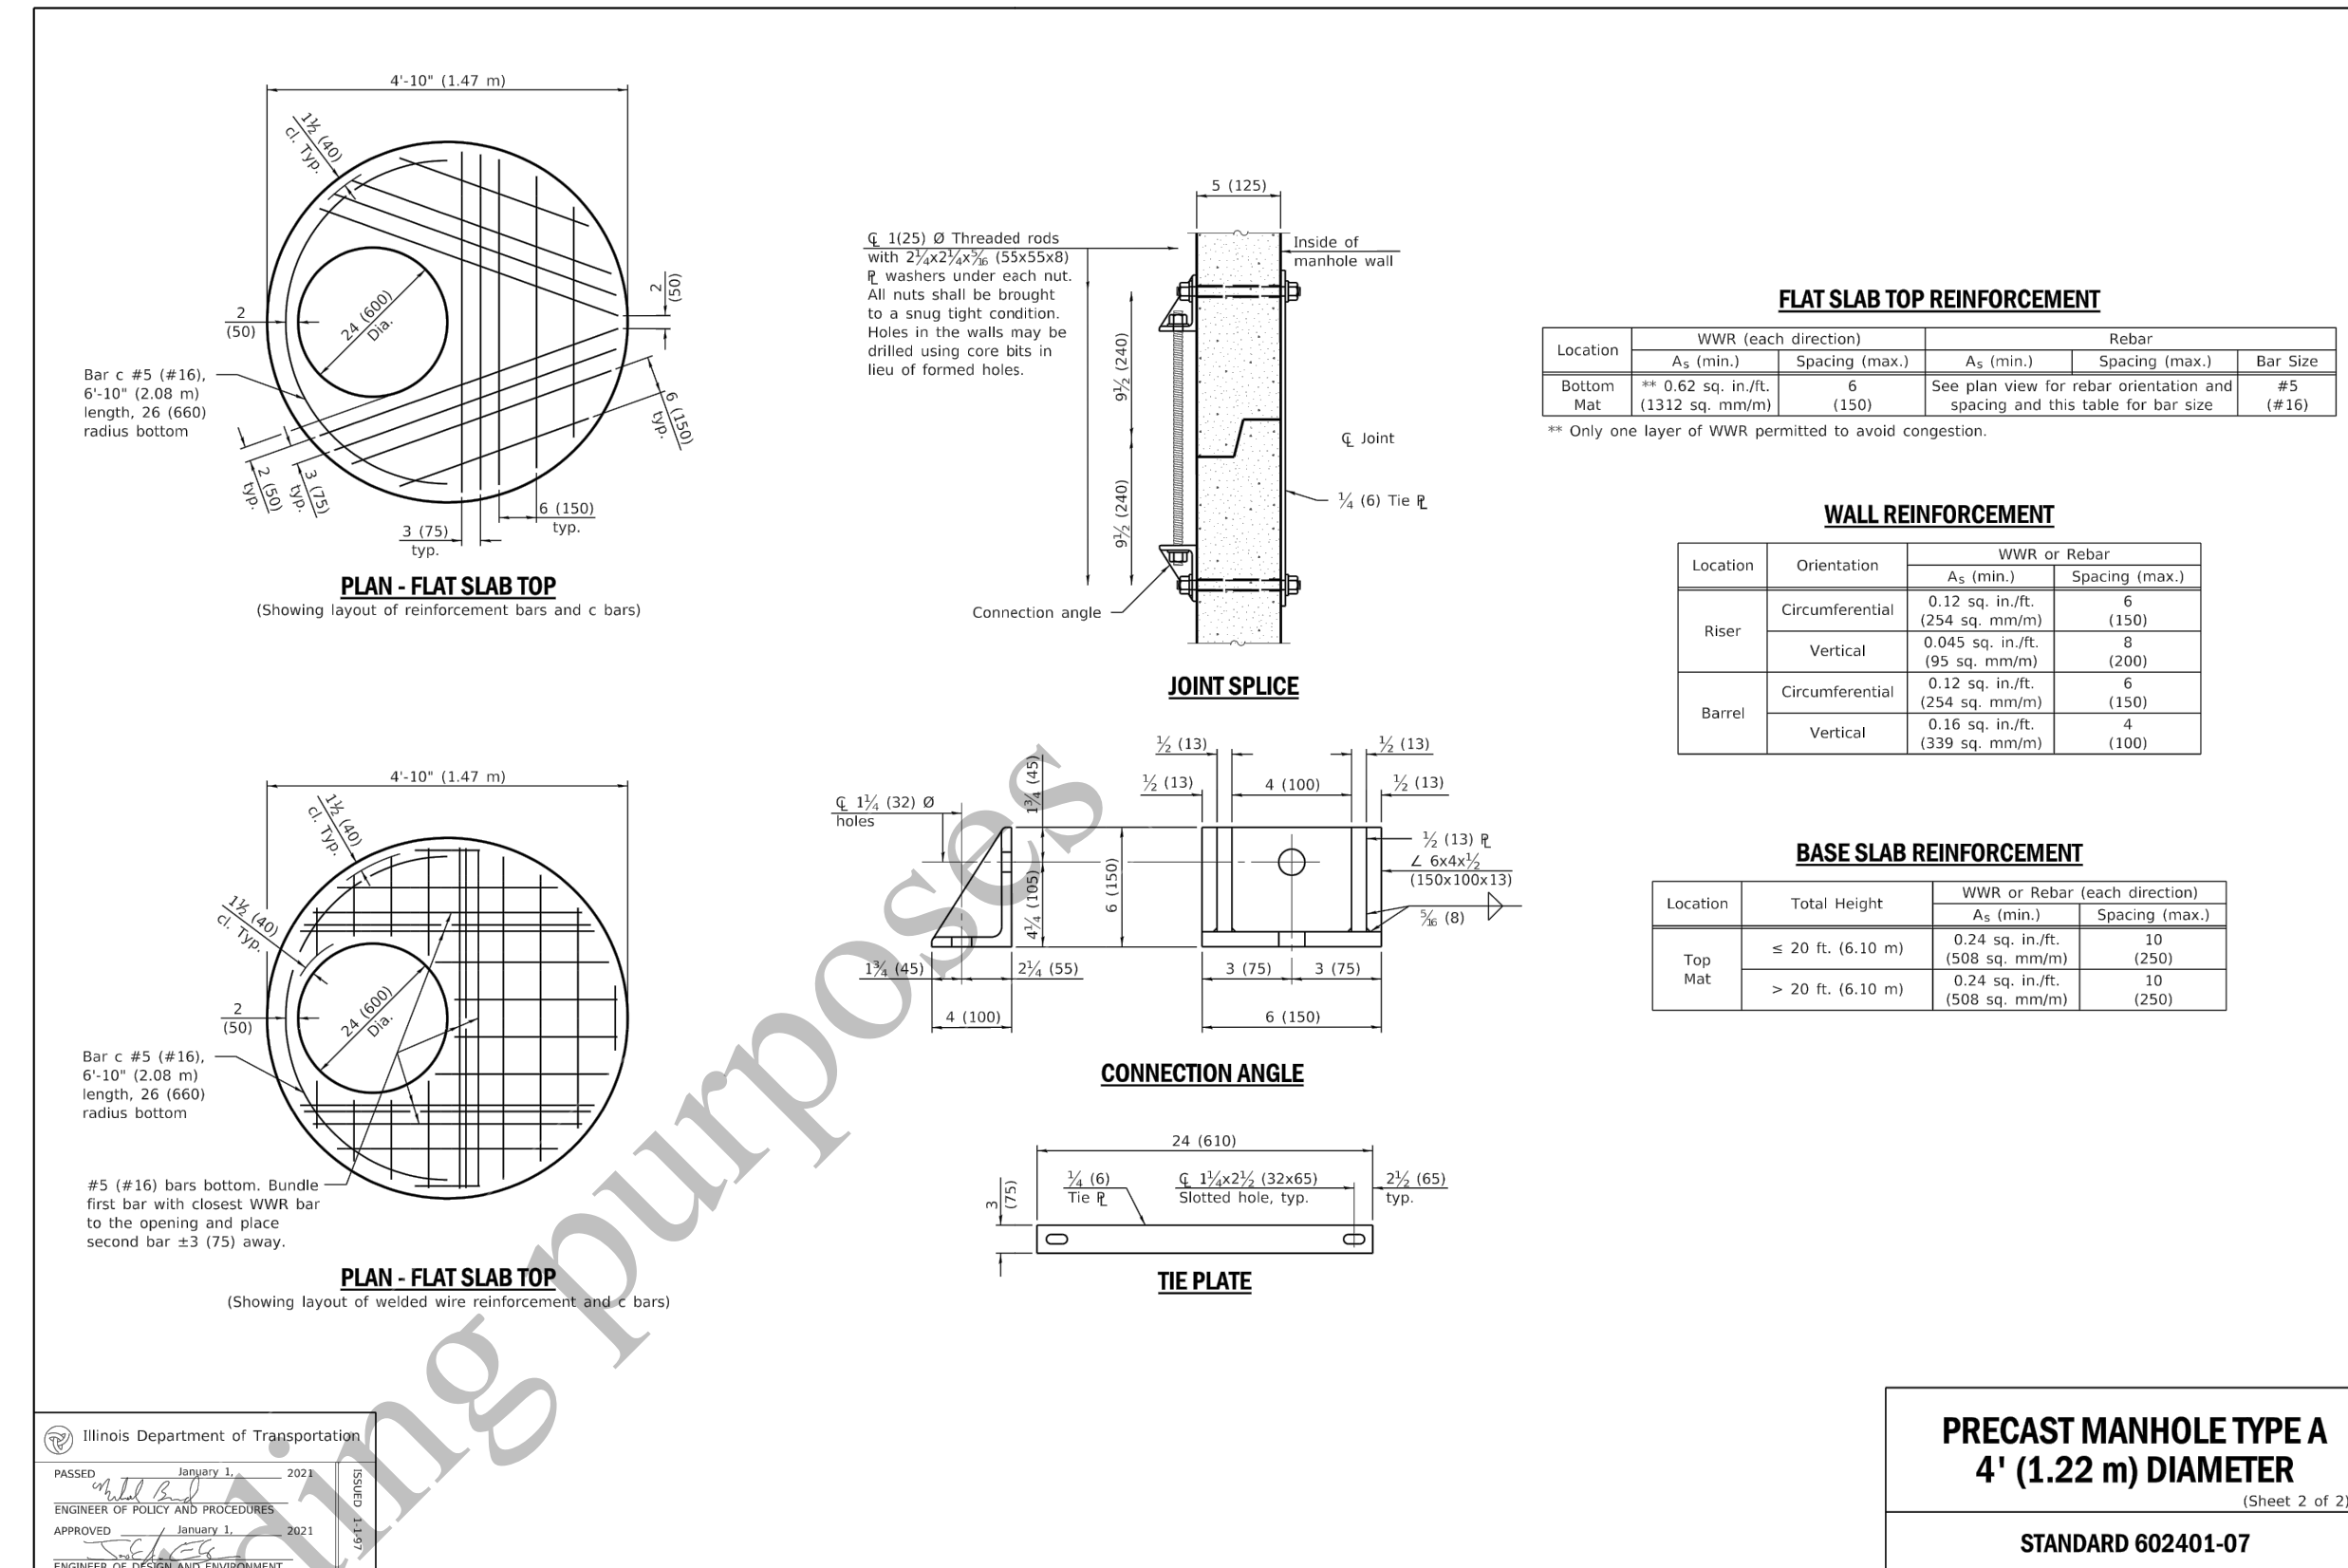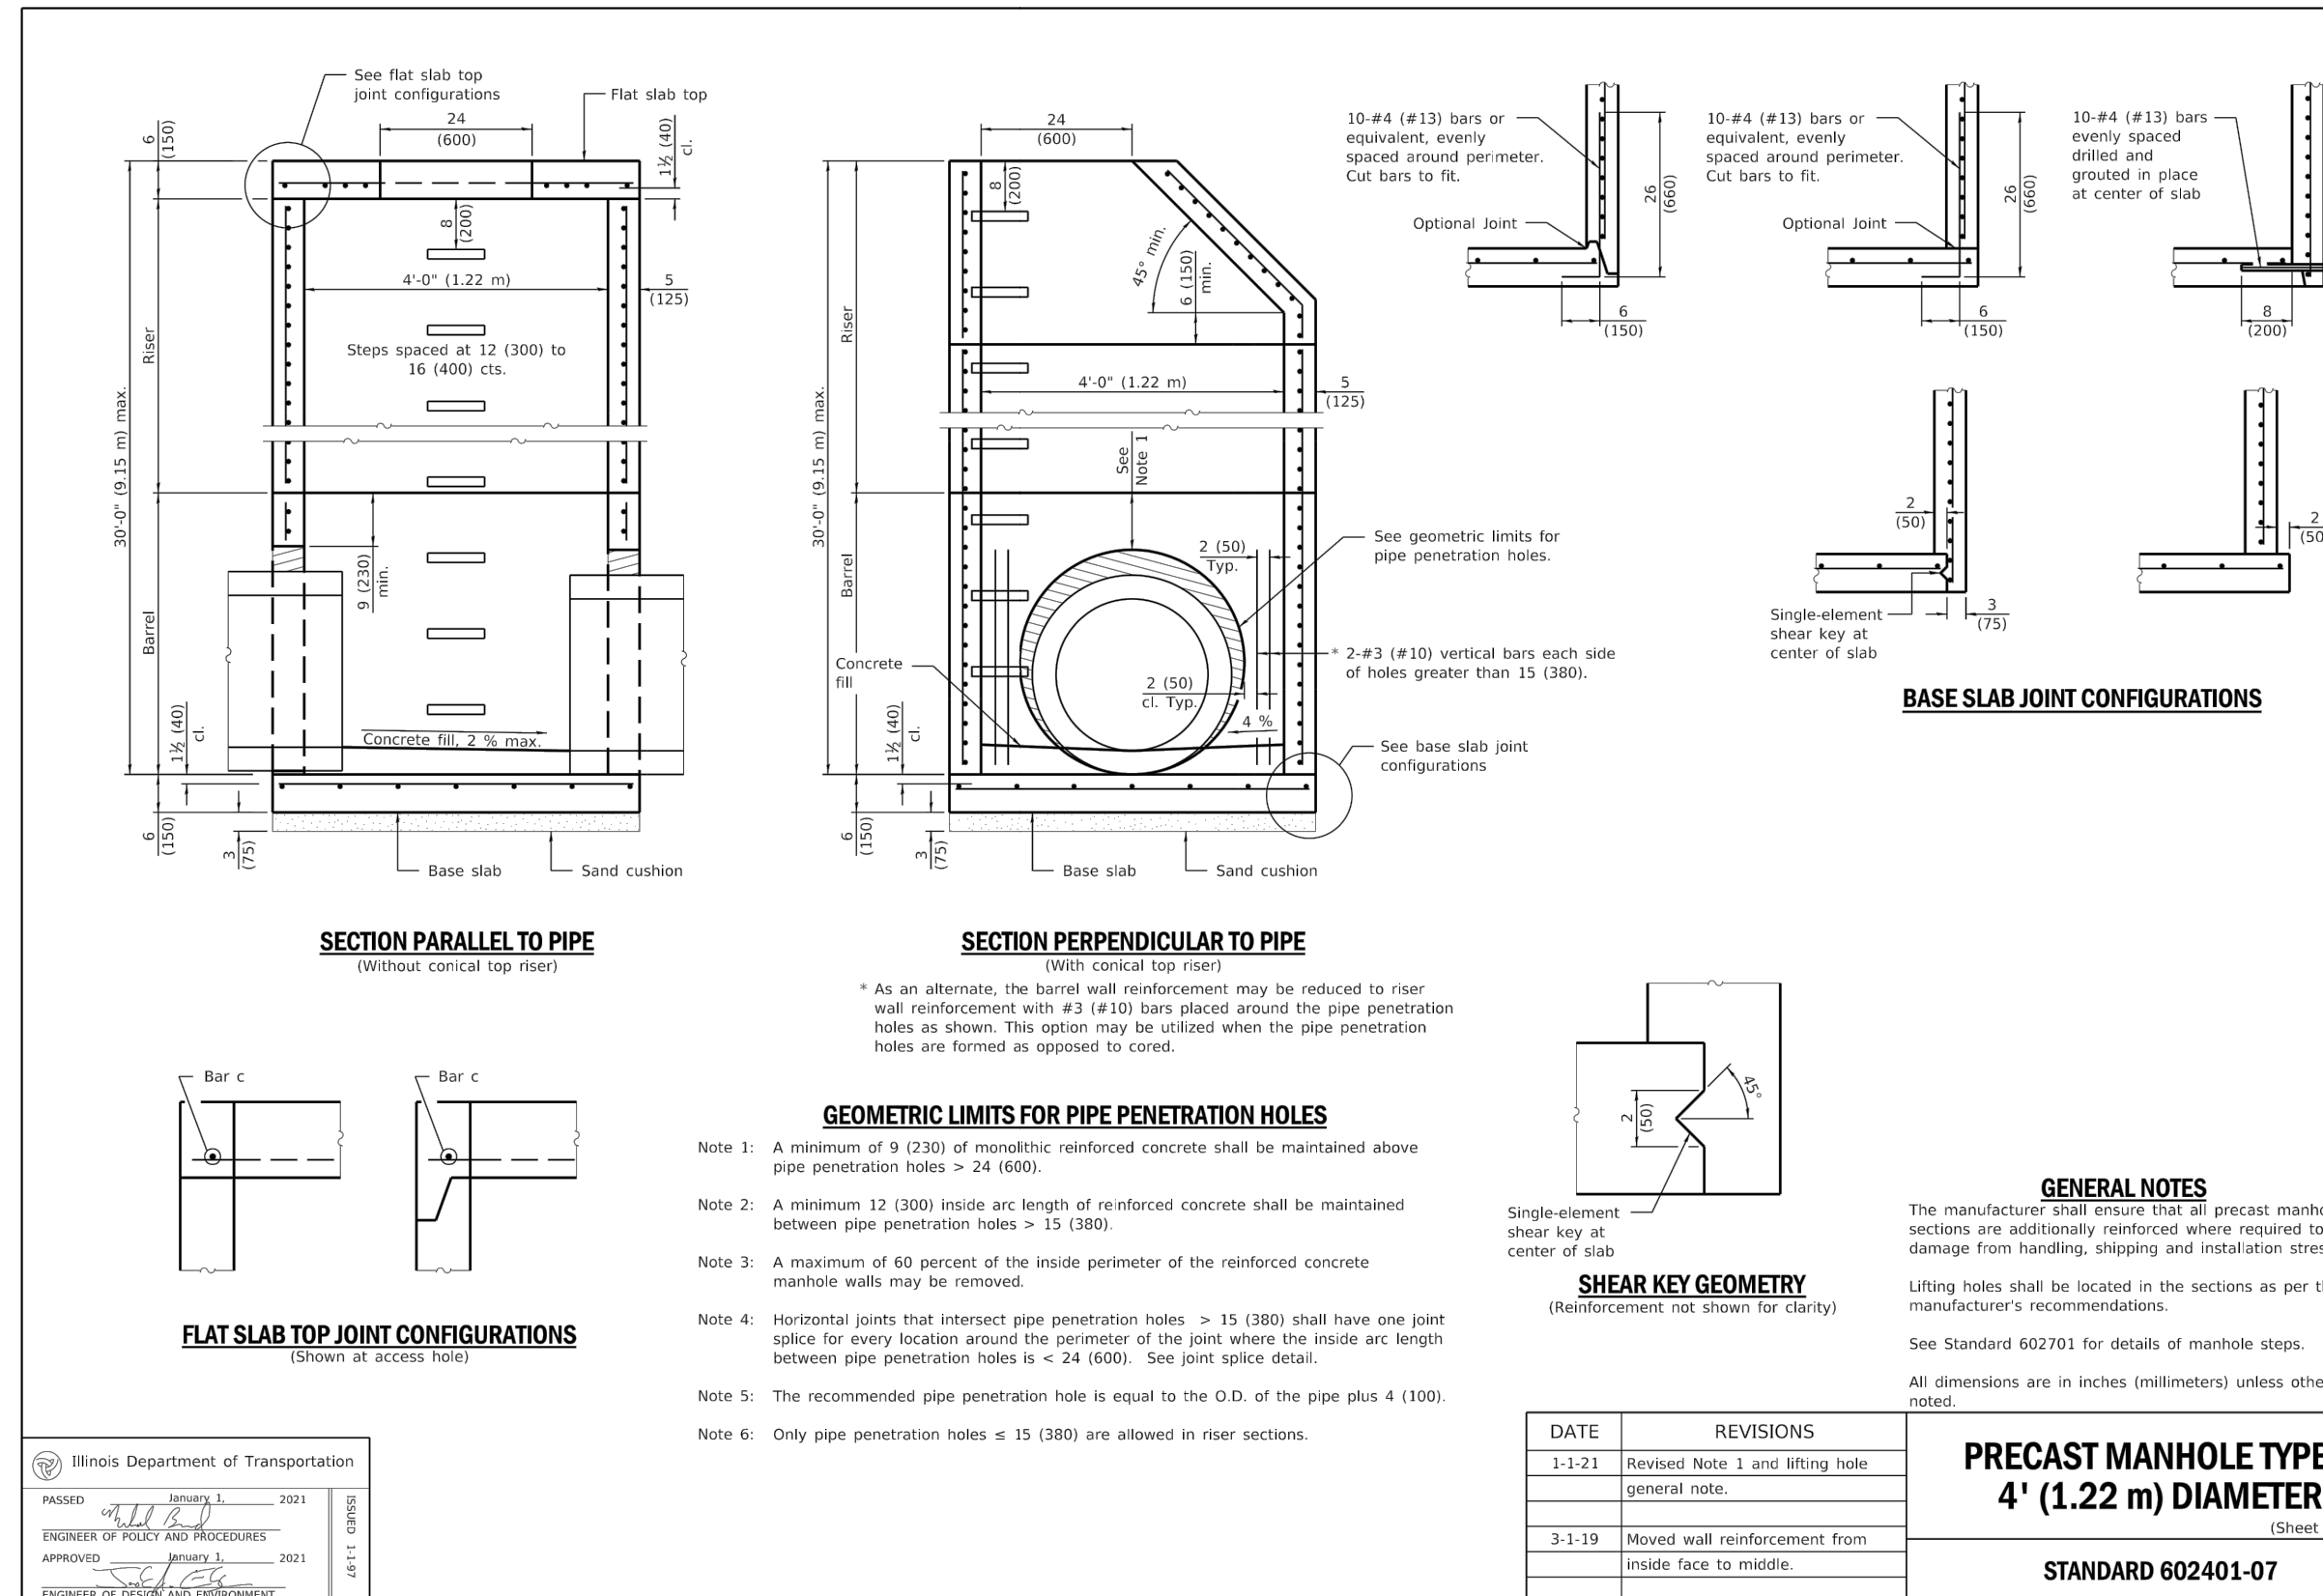

PLOTTED: 12/12/2022 10:18:27 PM
FILE: C:\PW\WORKING\BWV_AMERICAS\01495388-09-C-507.DWG
FDI1000
D11000

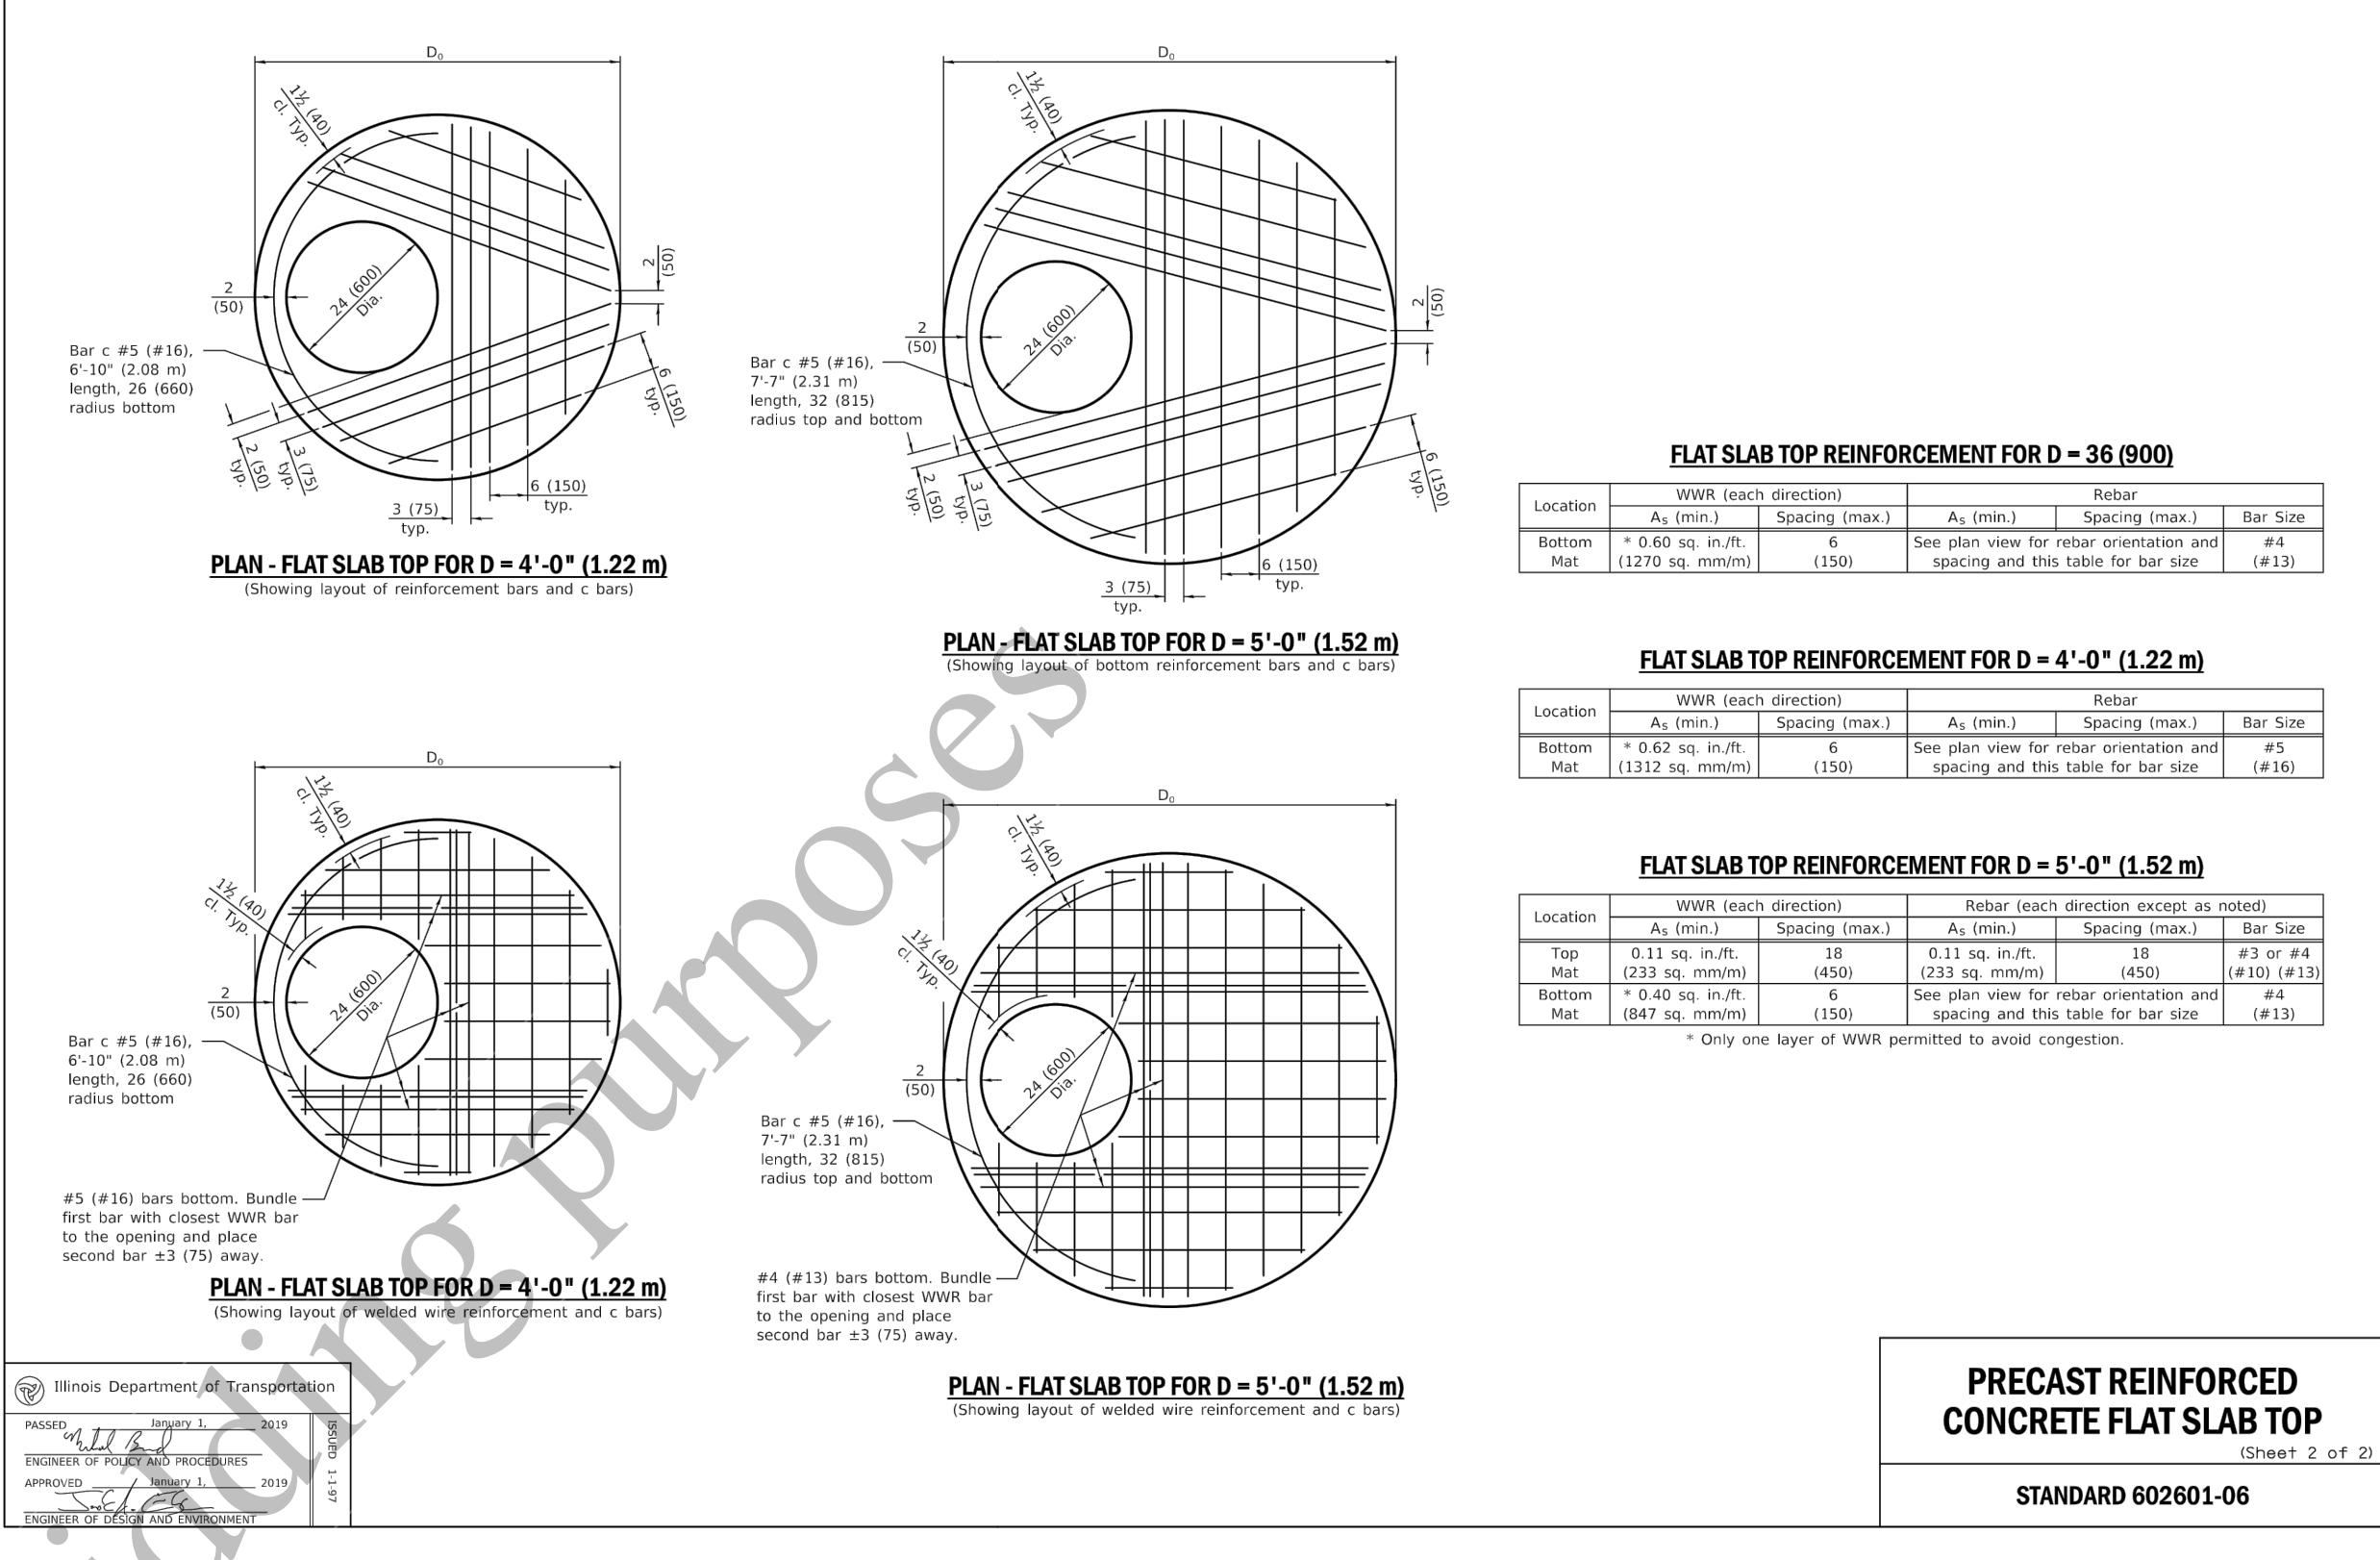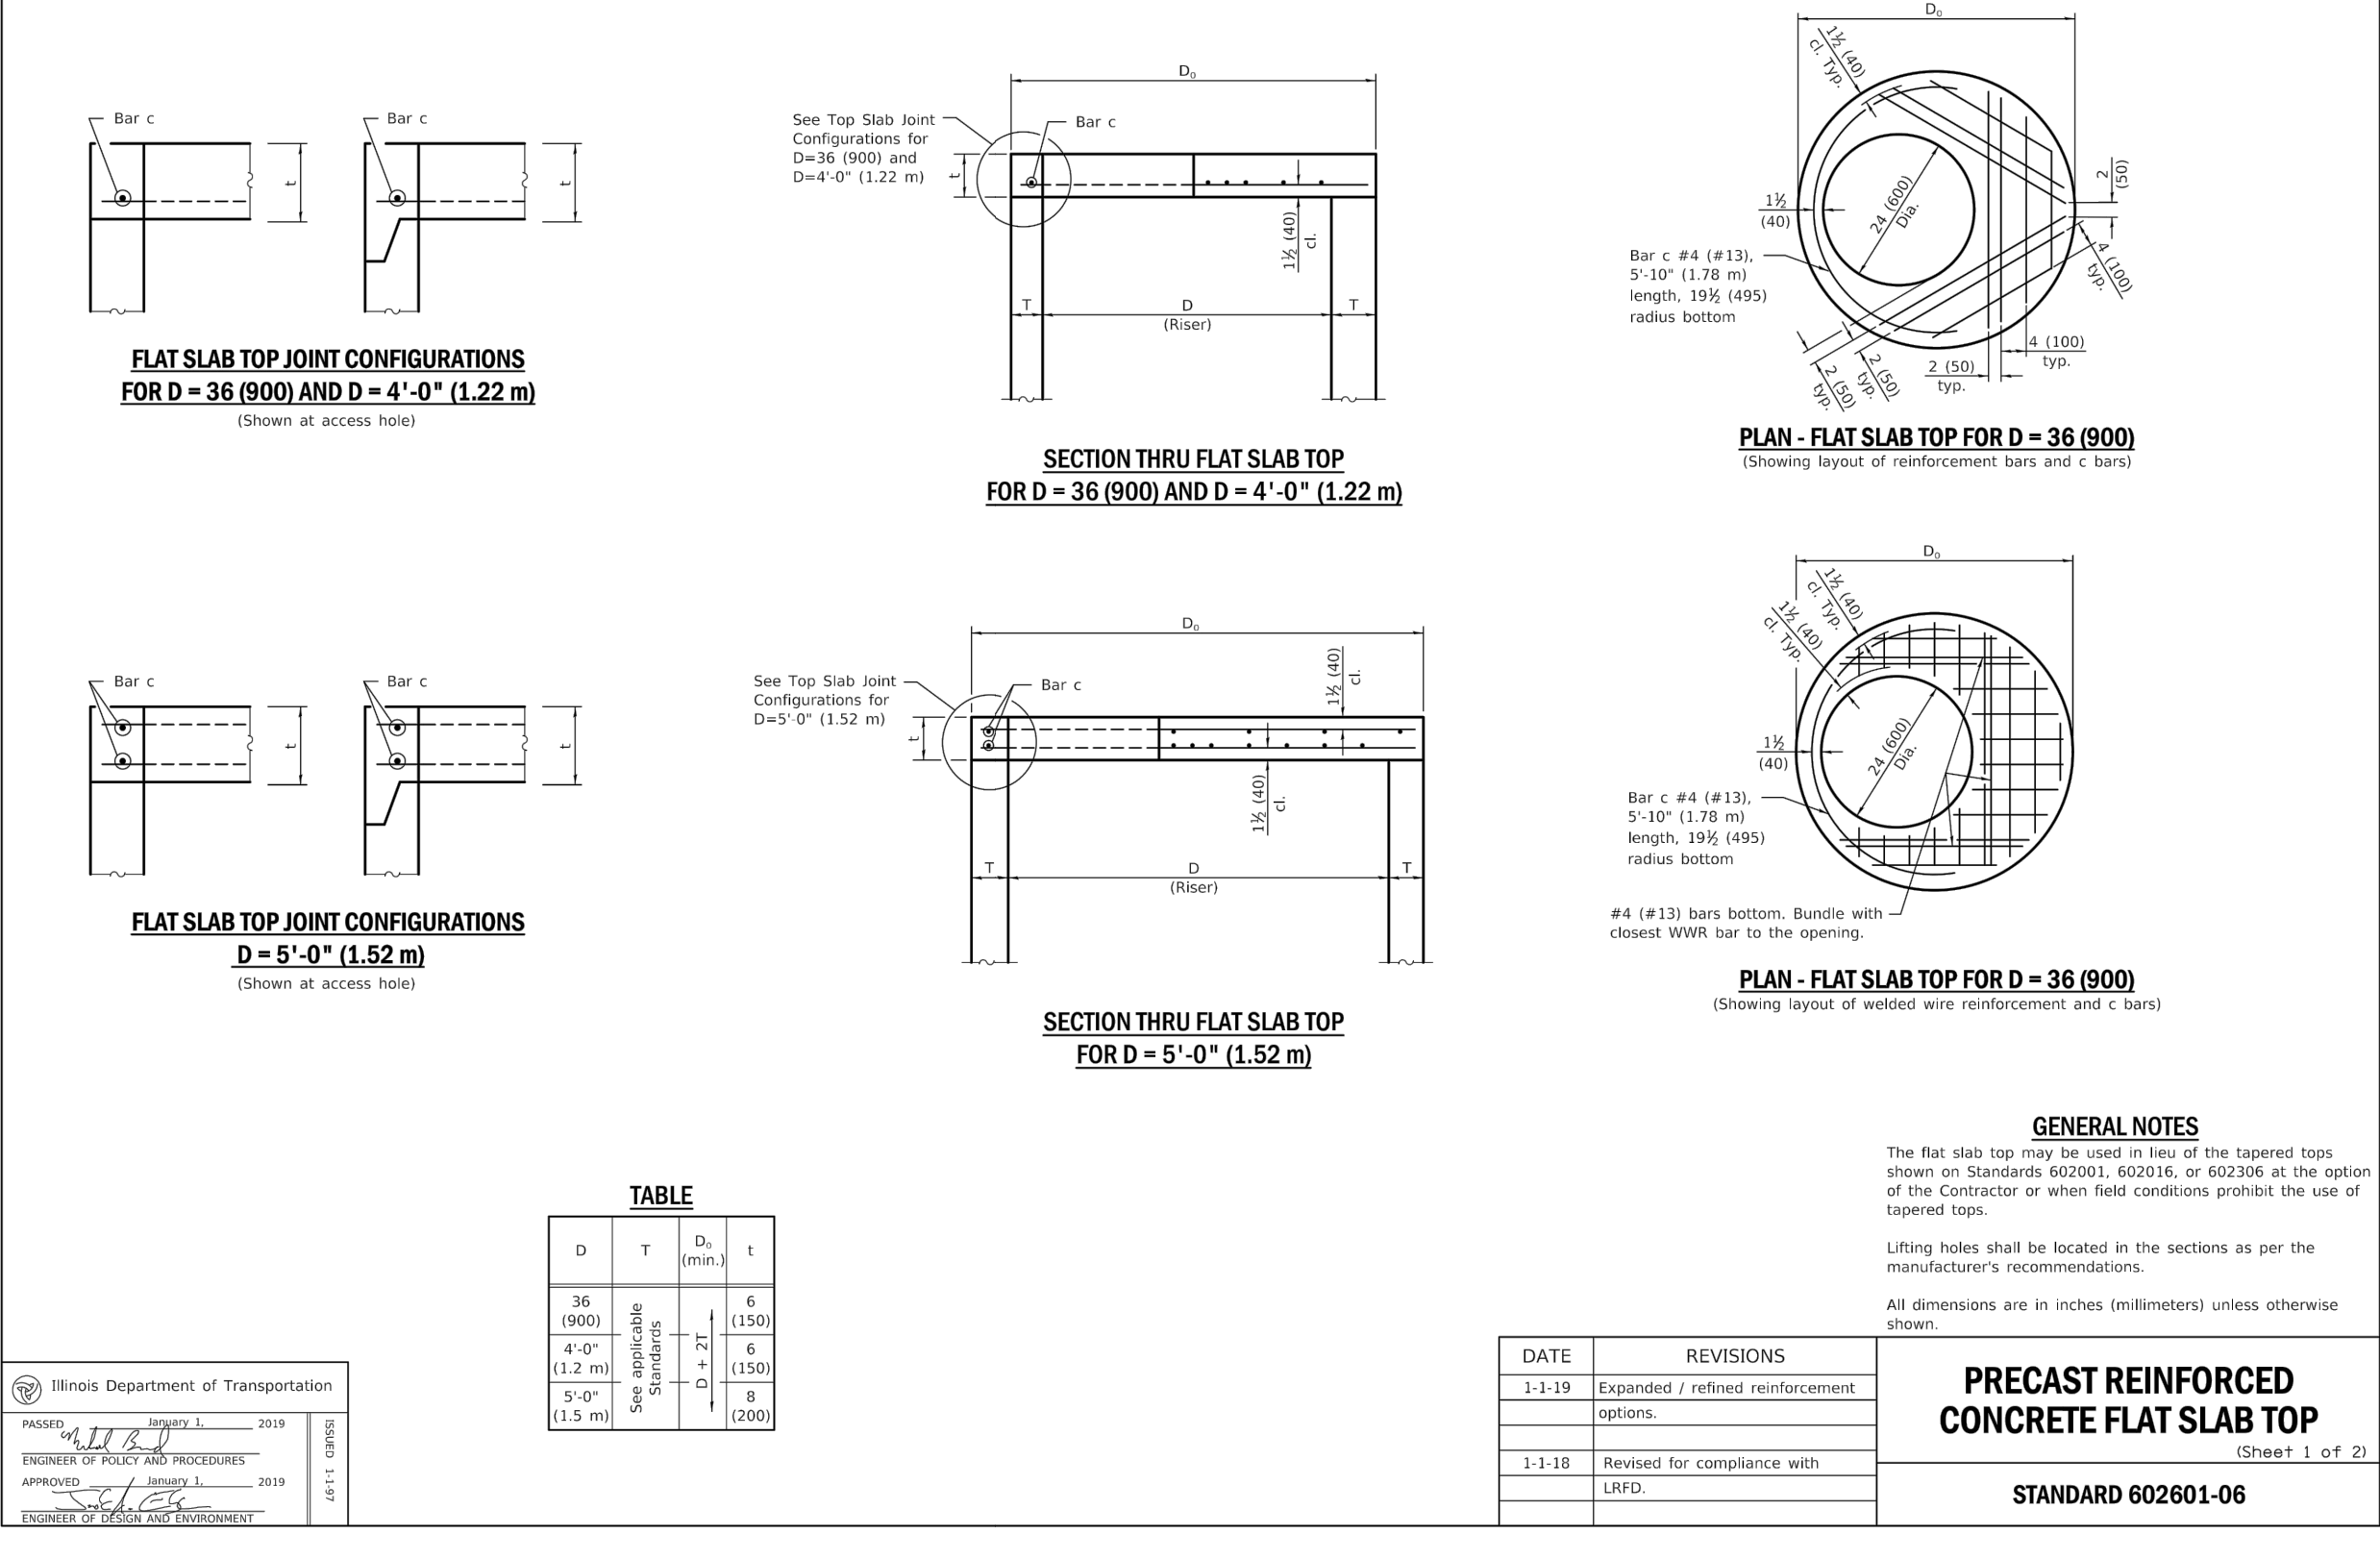

A CONCRETE FLAT SLAB TOP
- NO SCALE

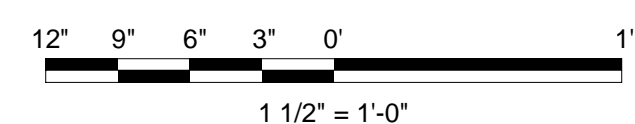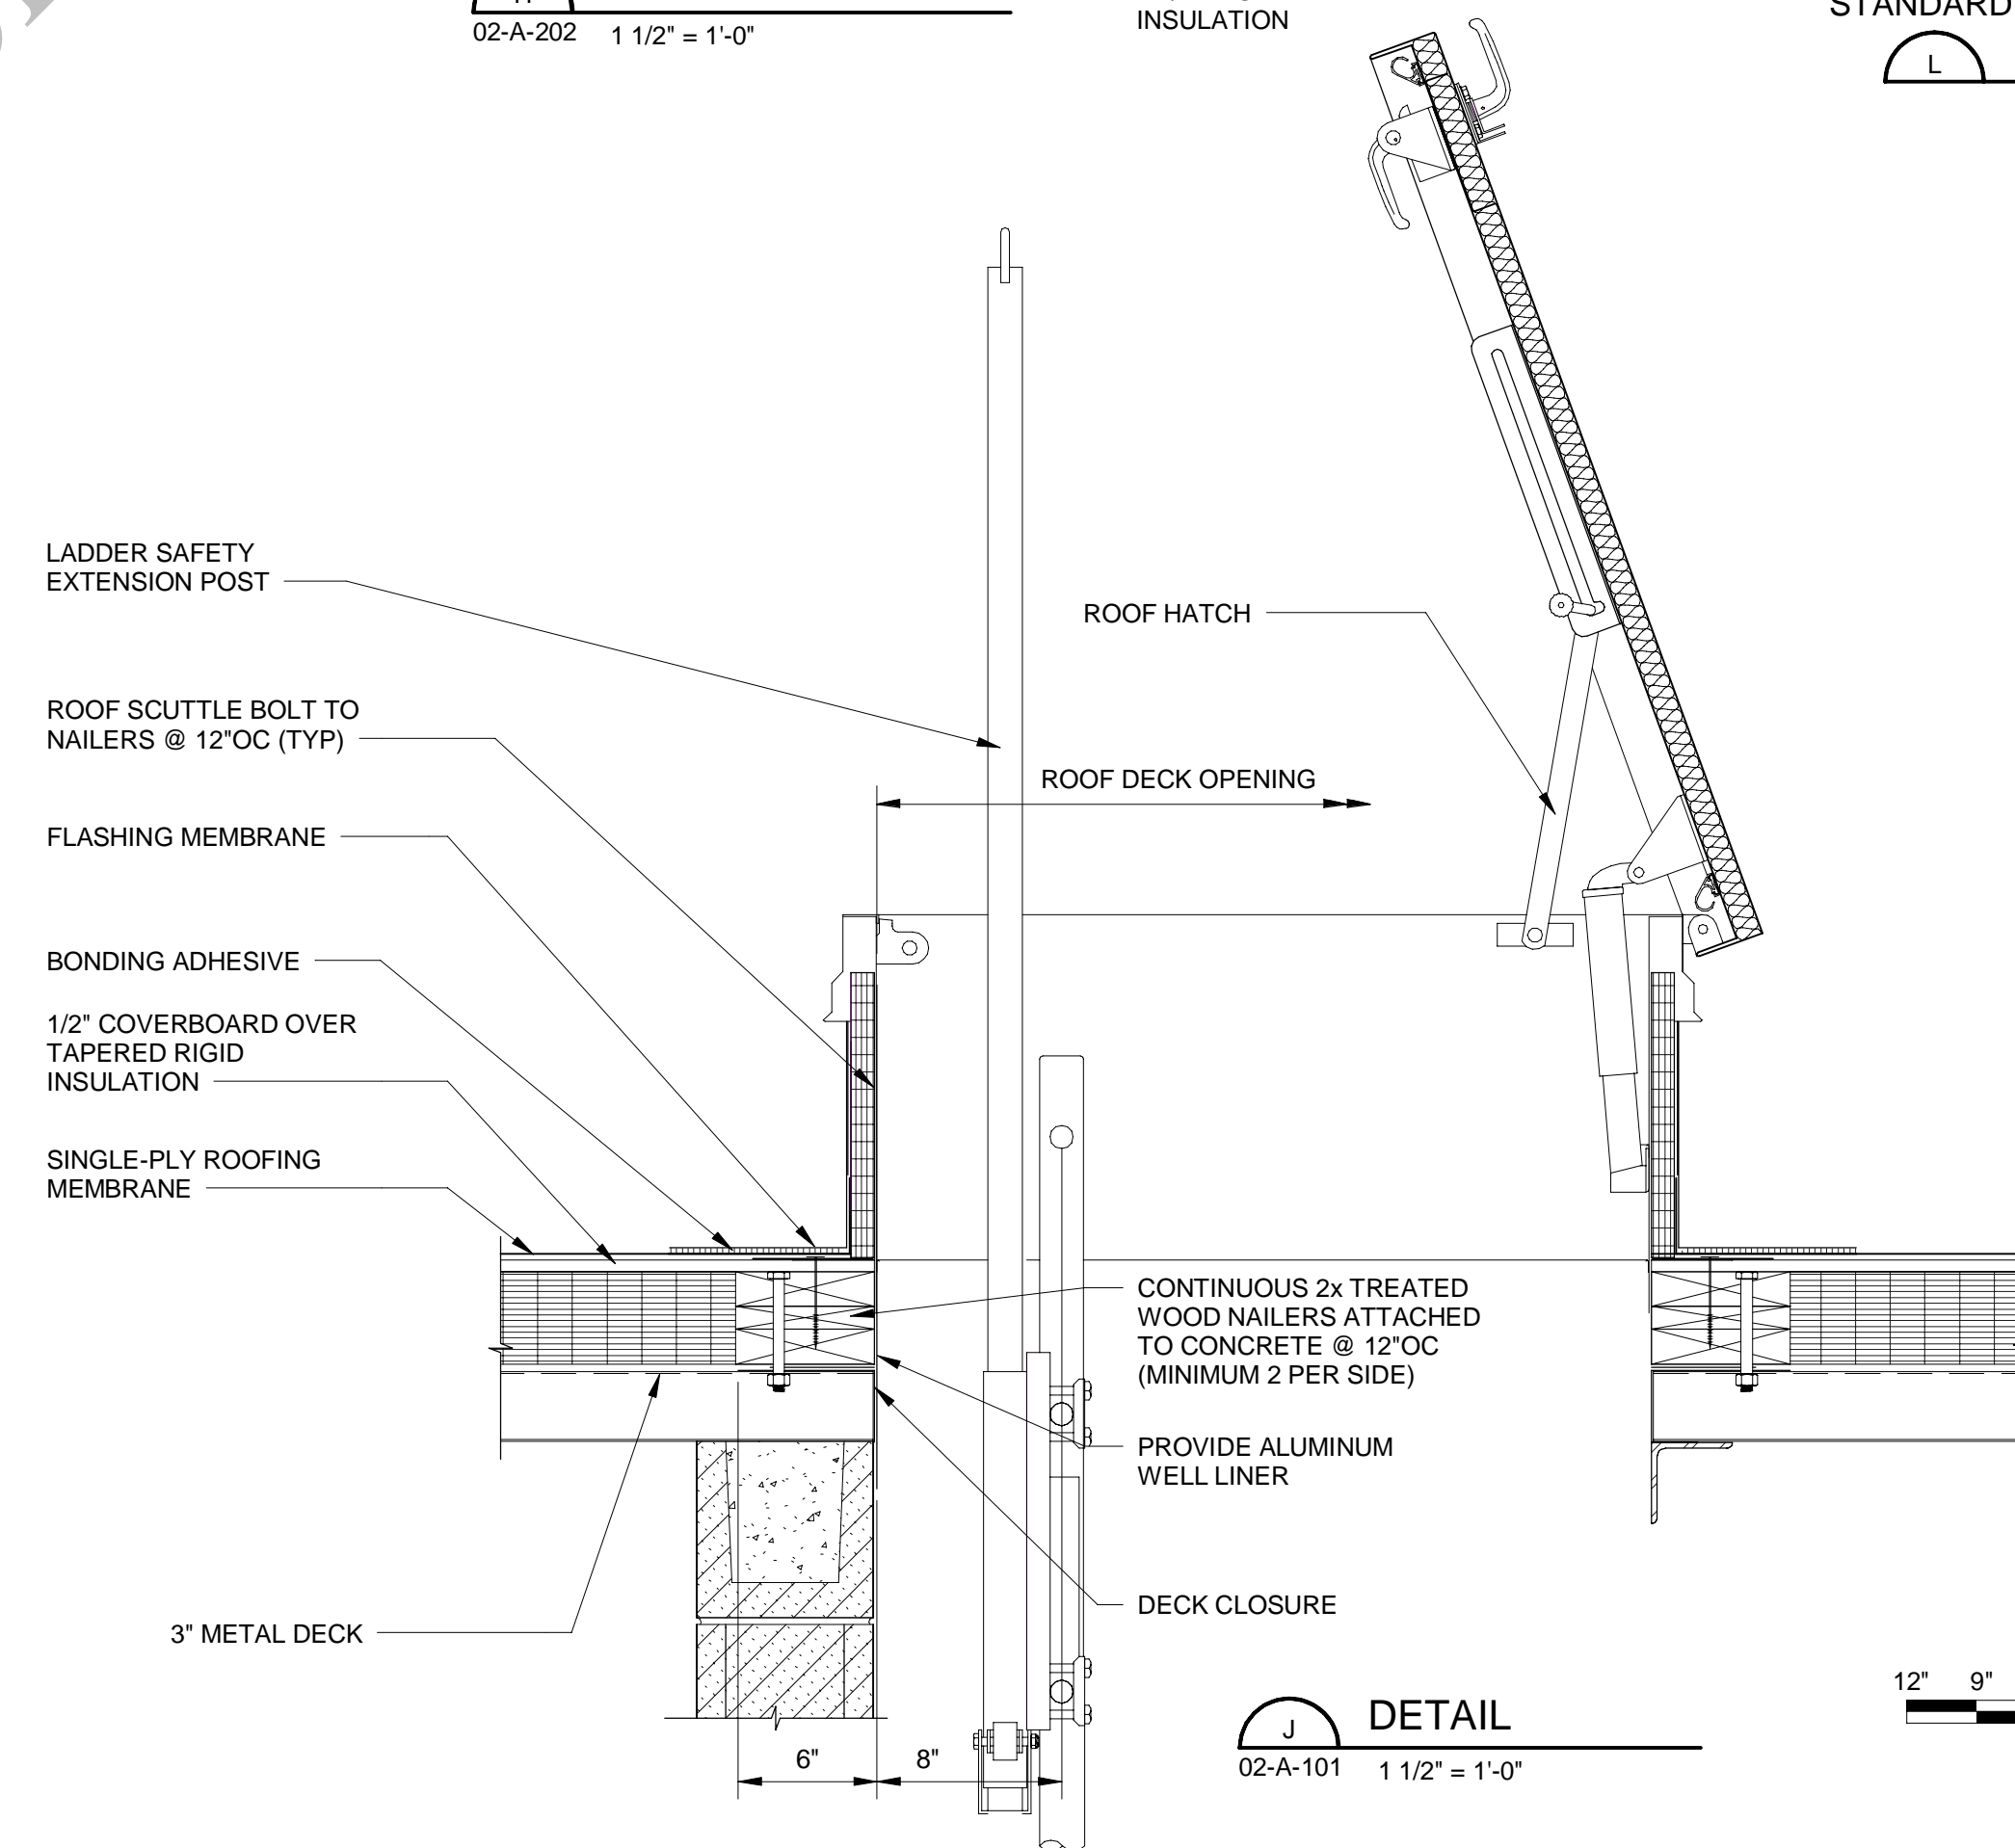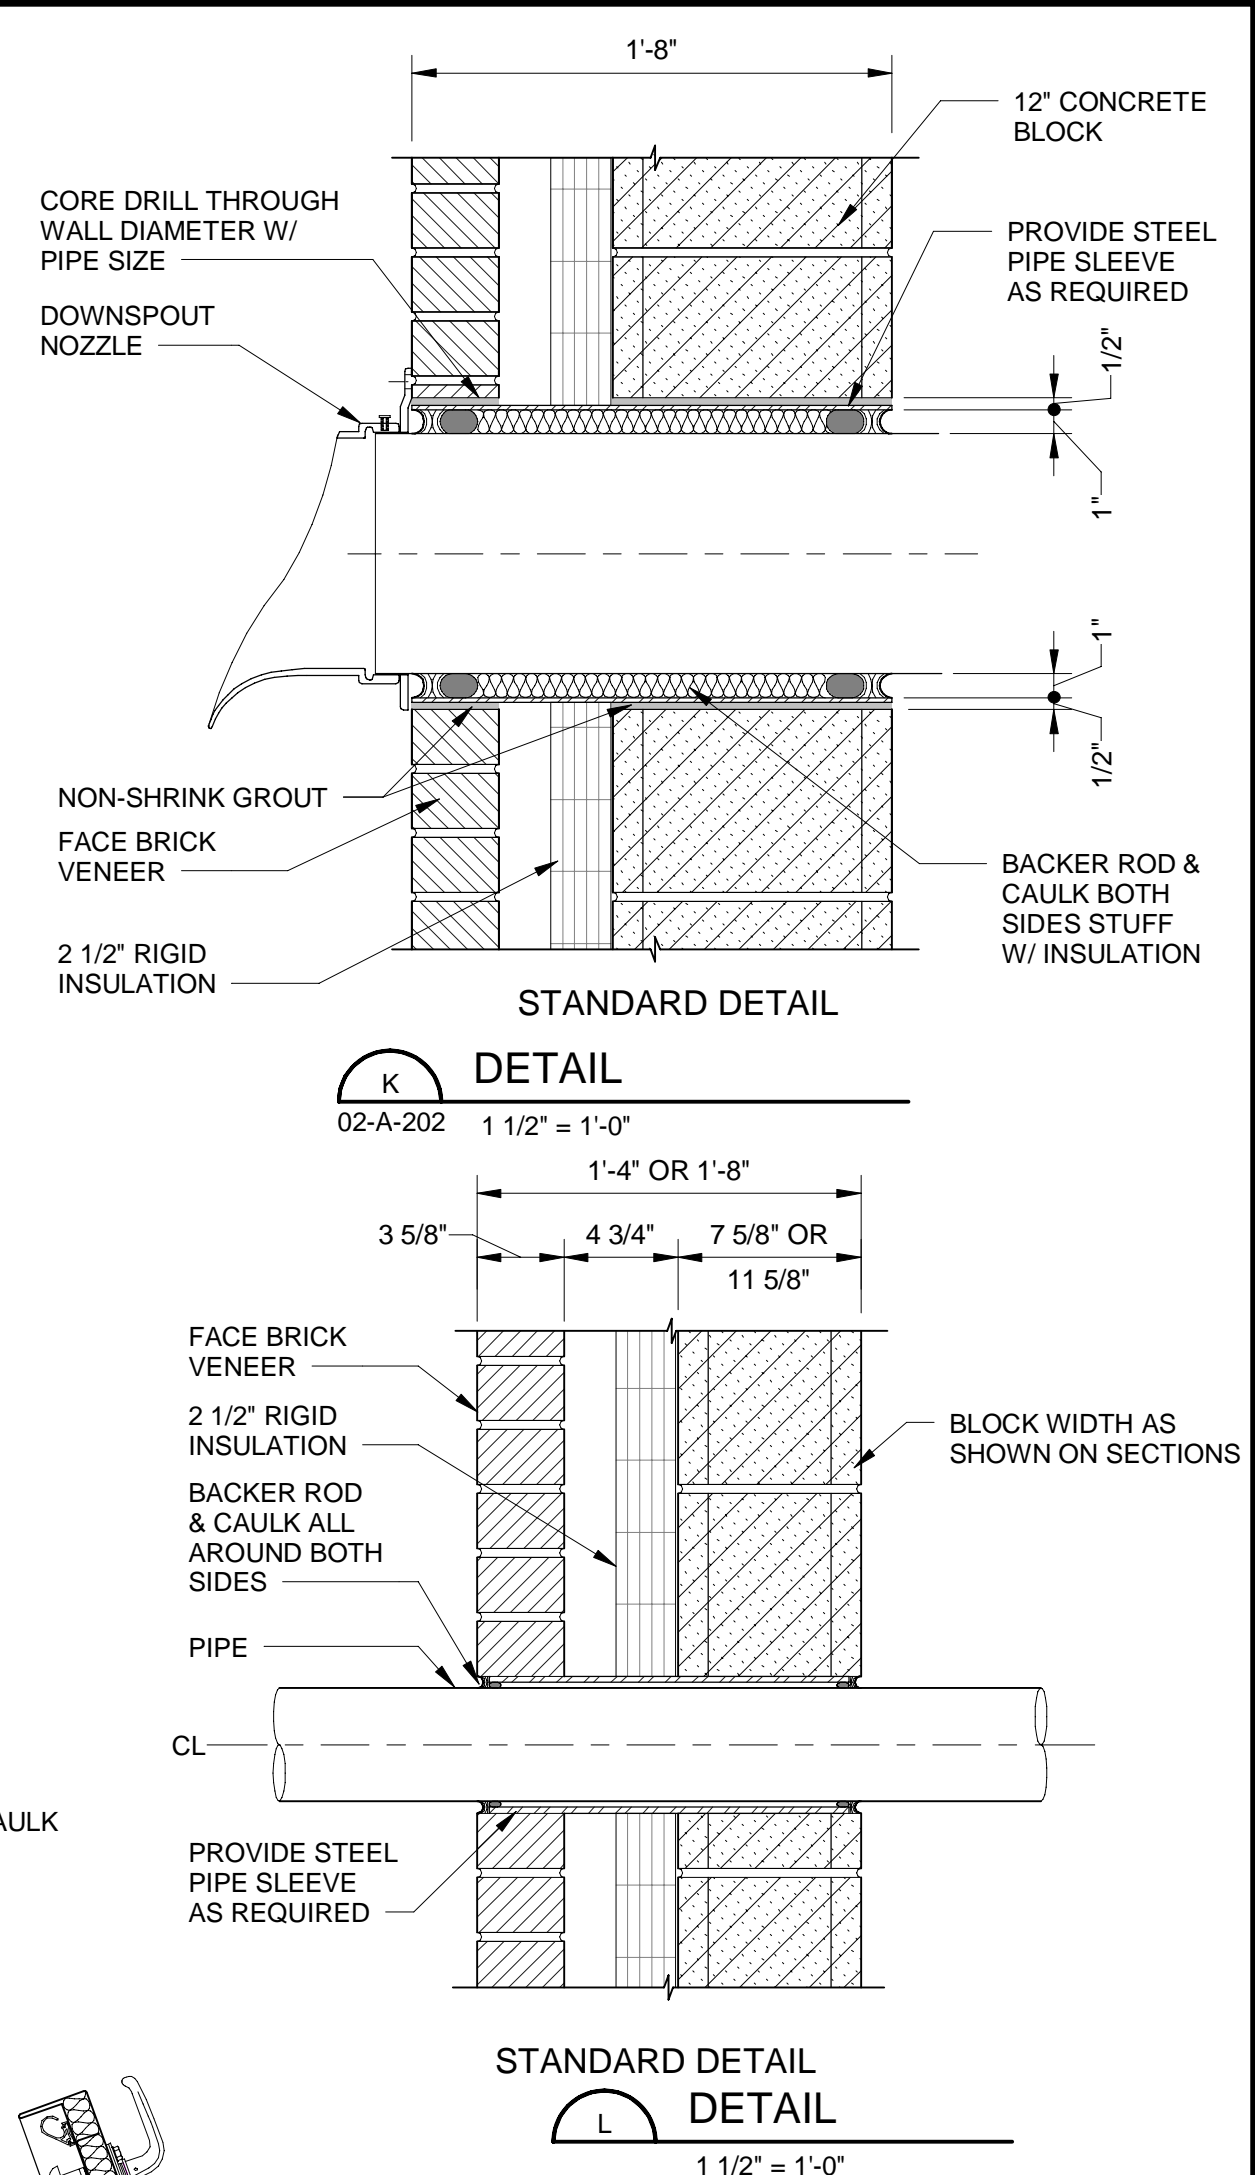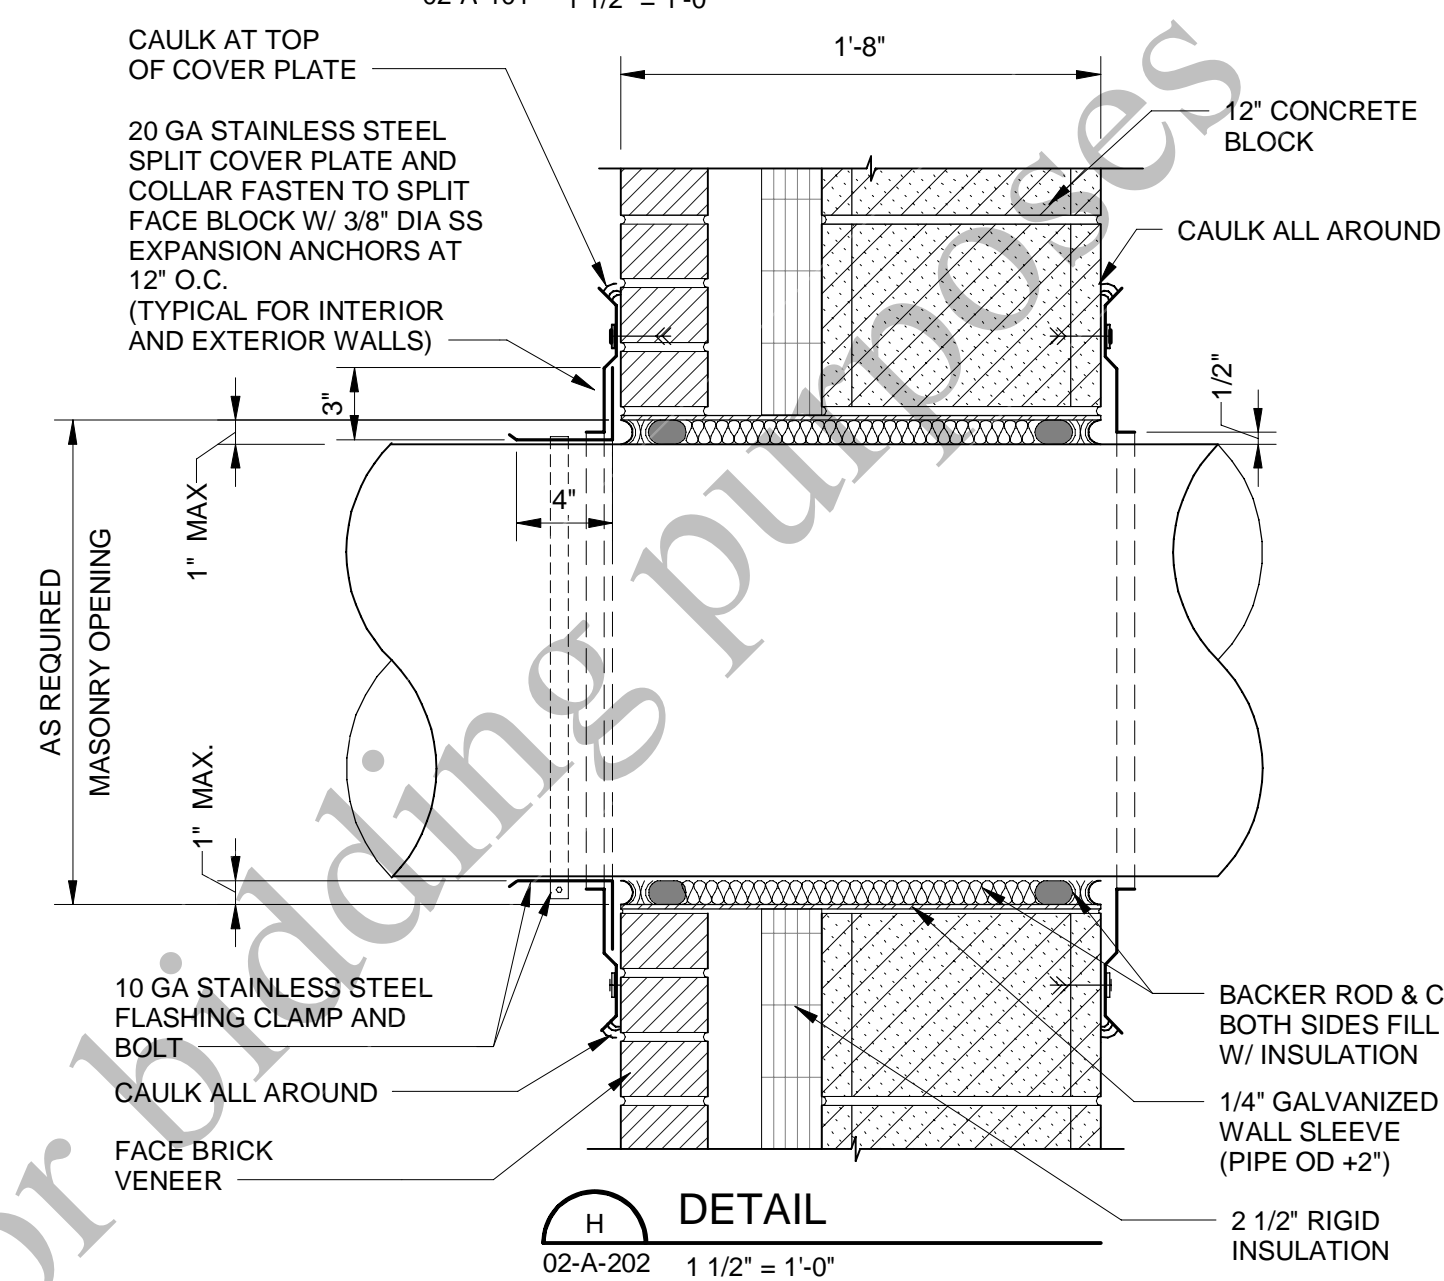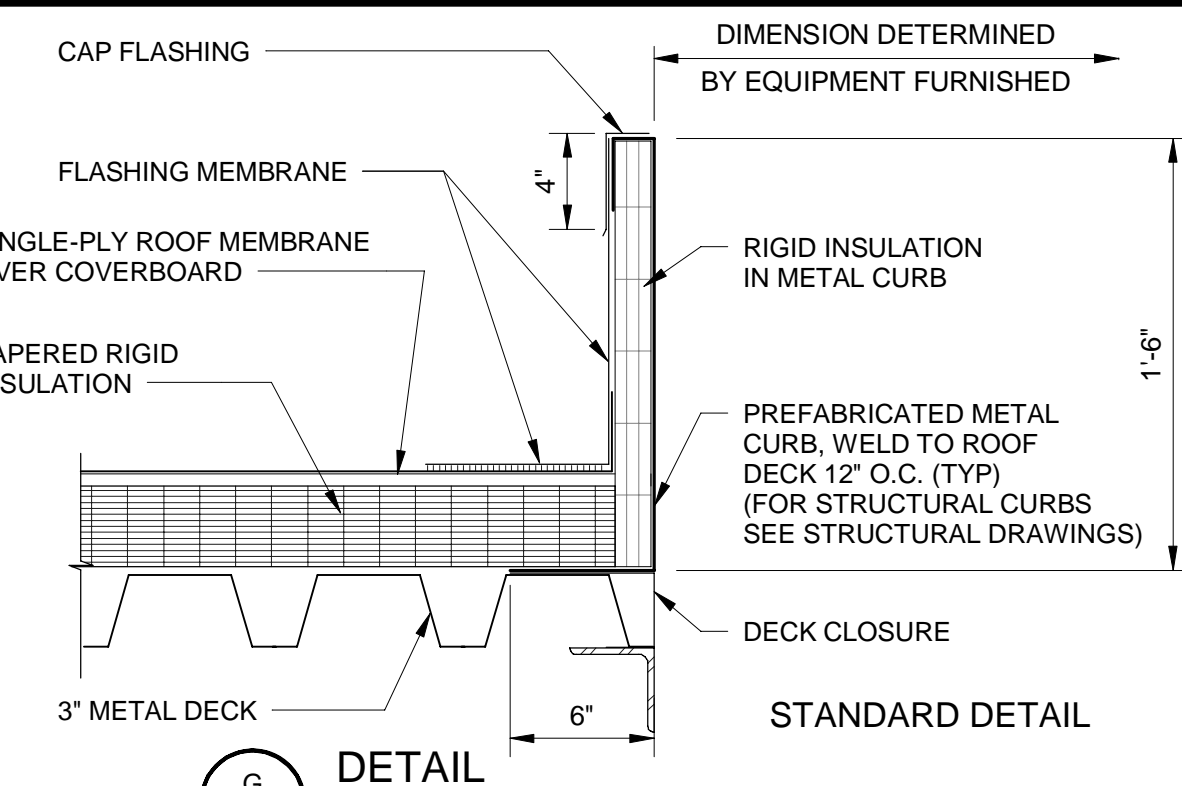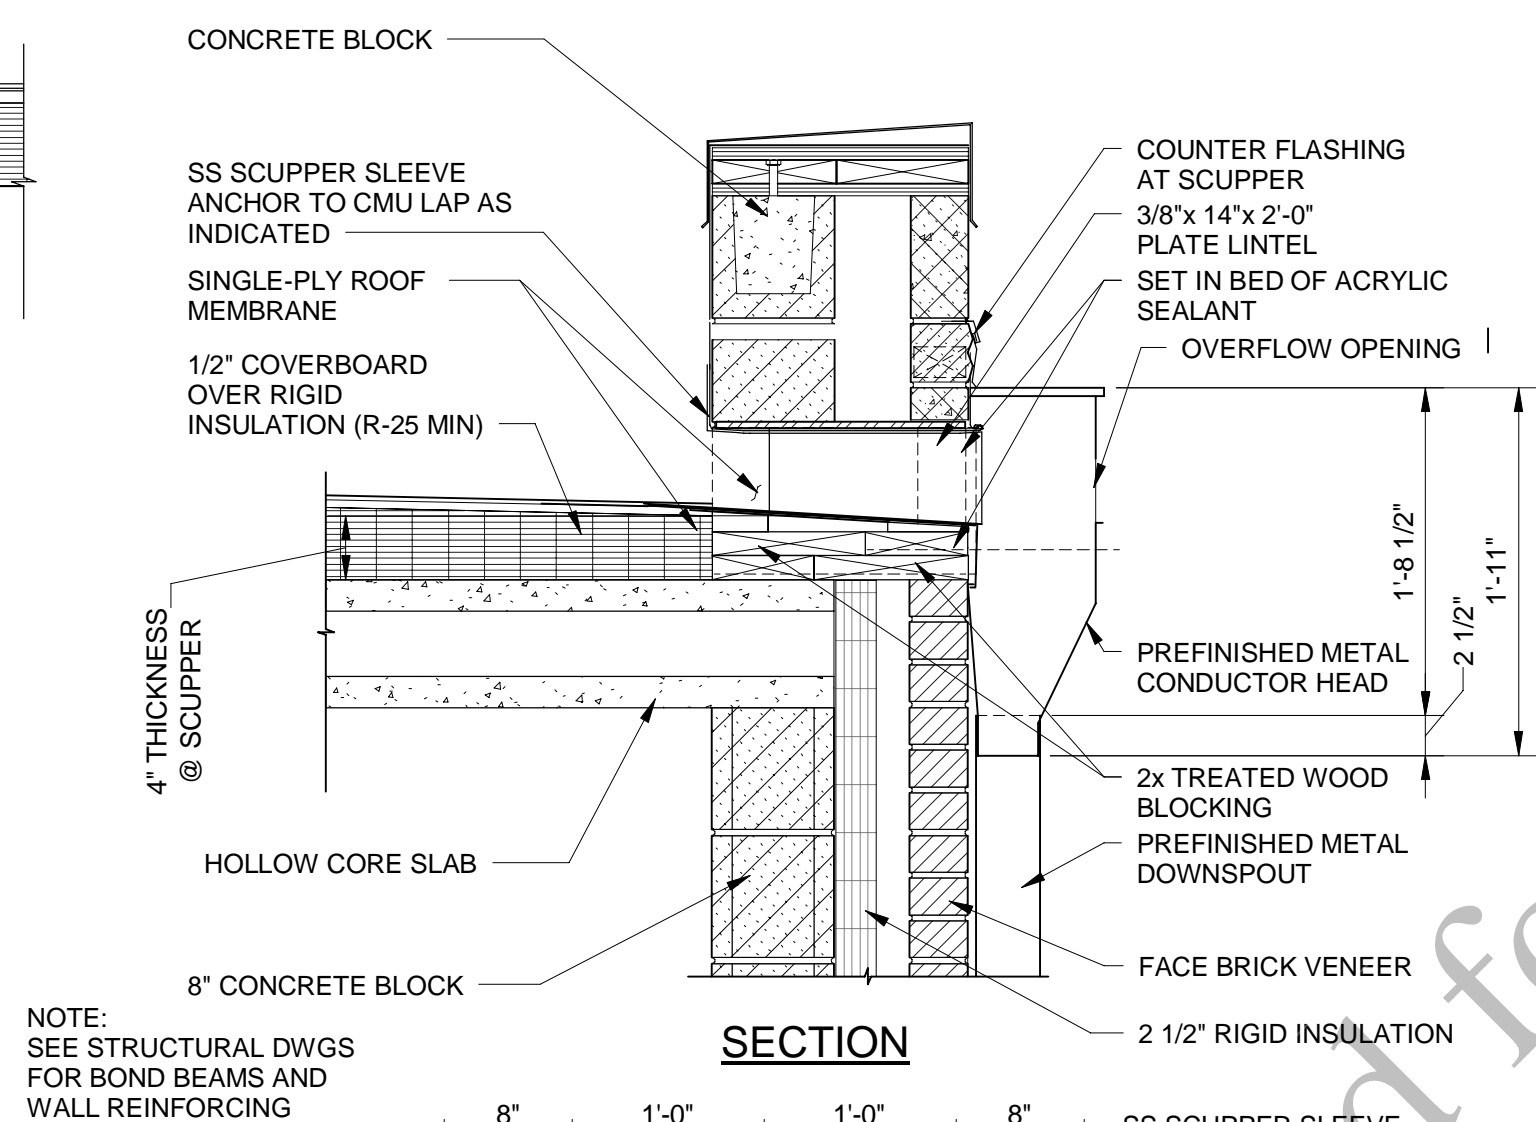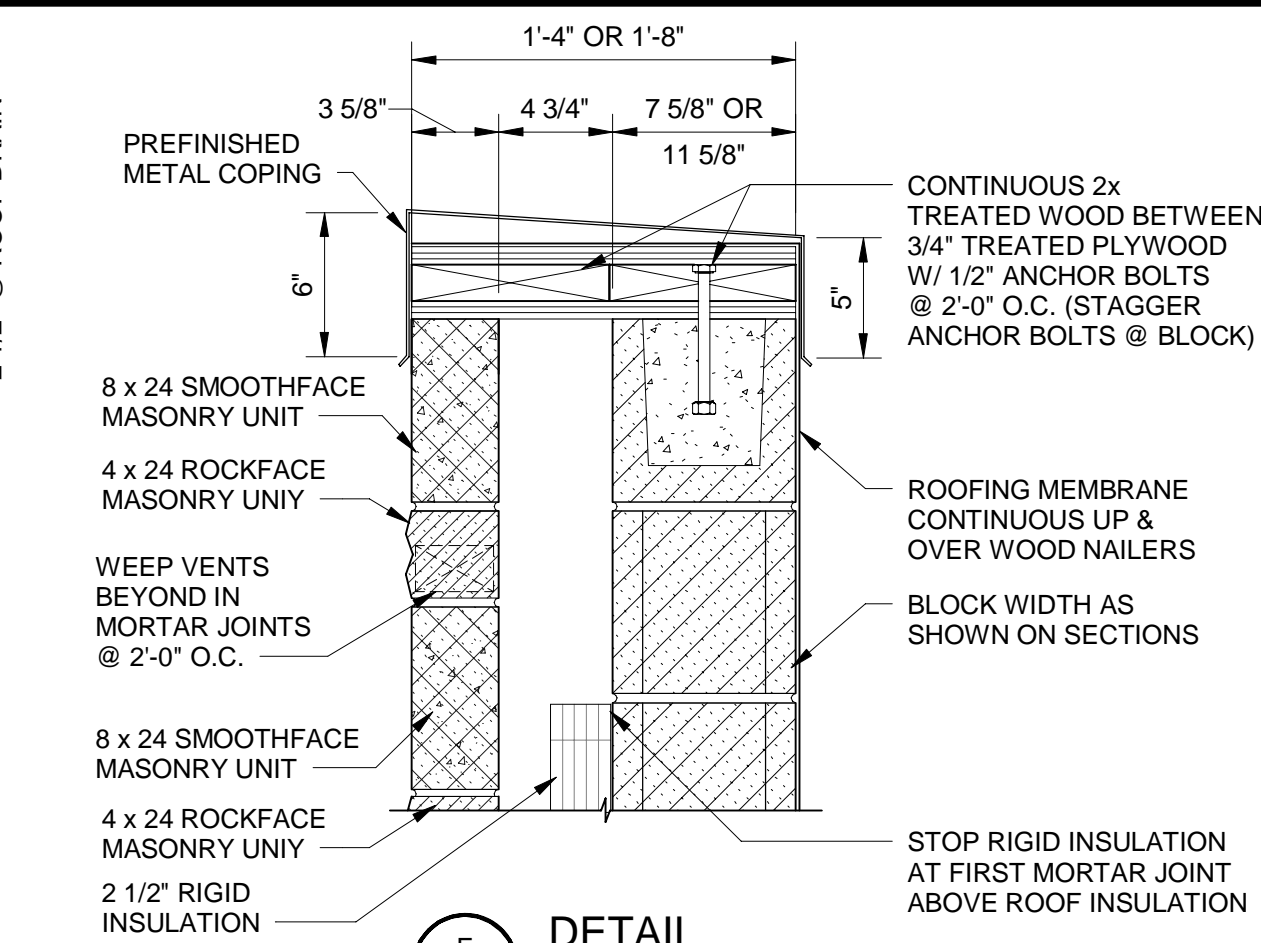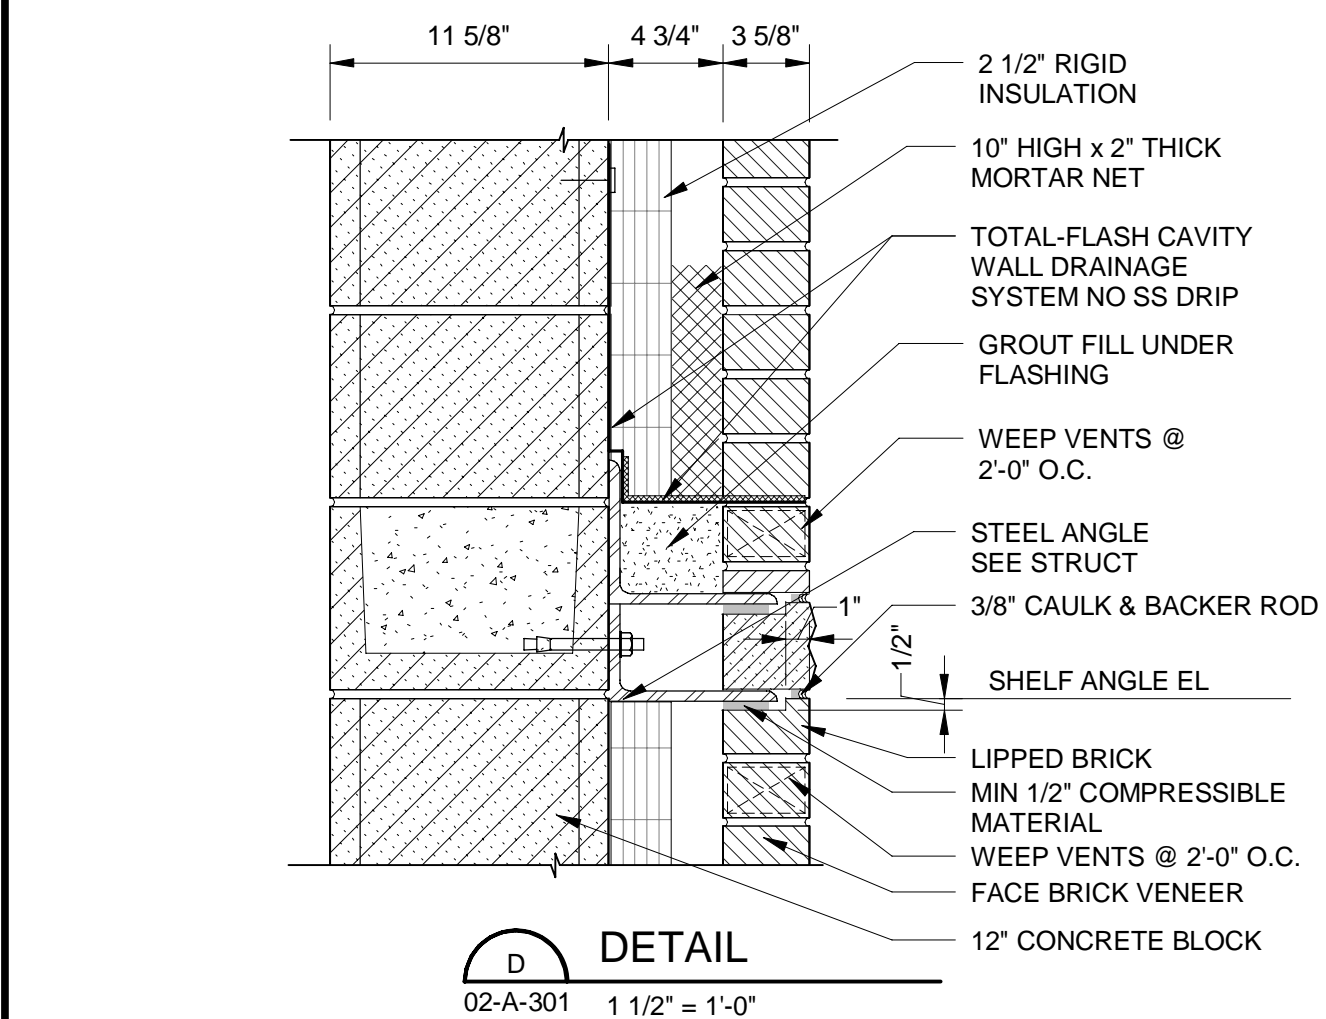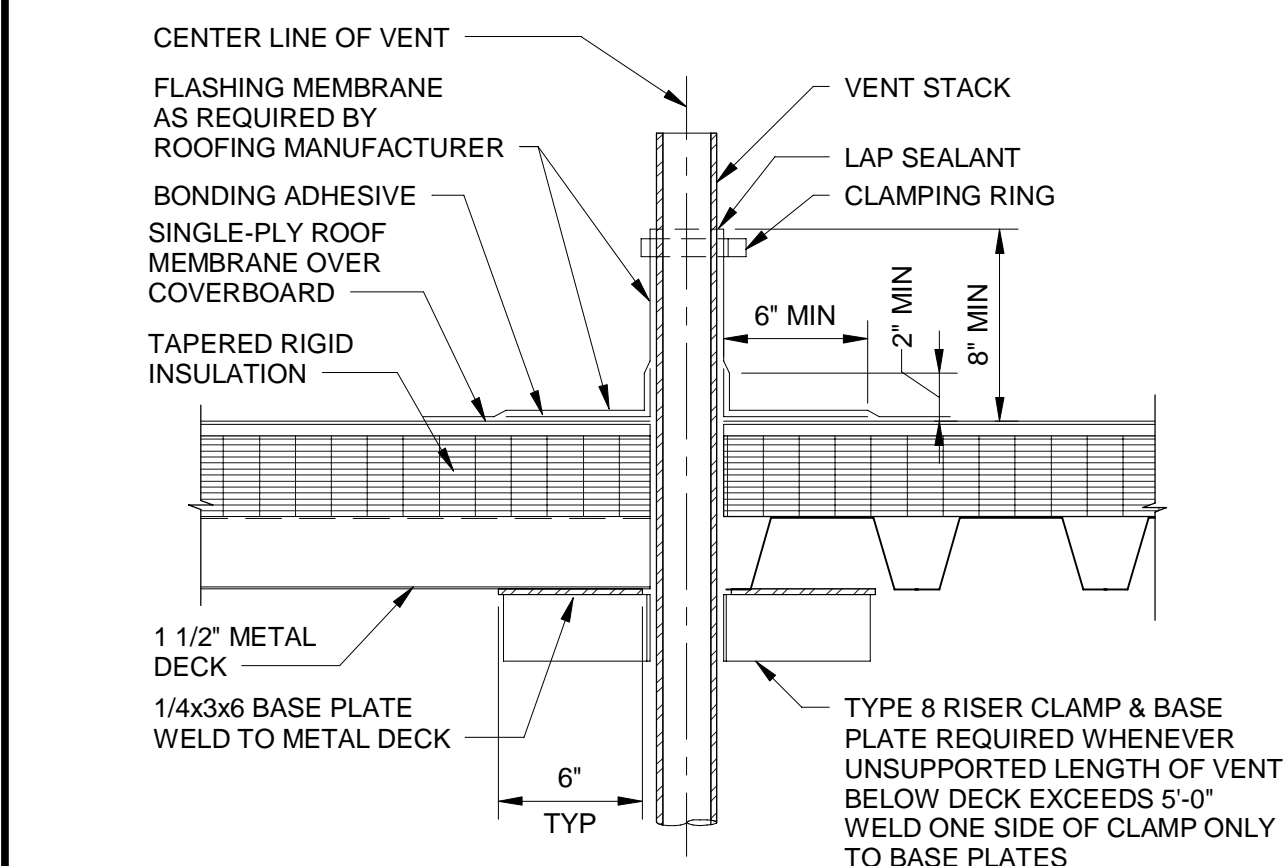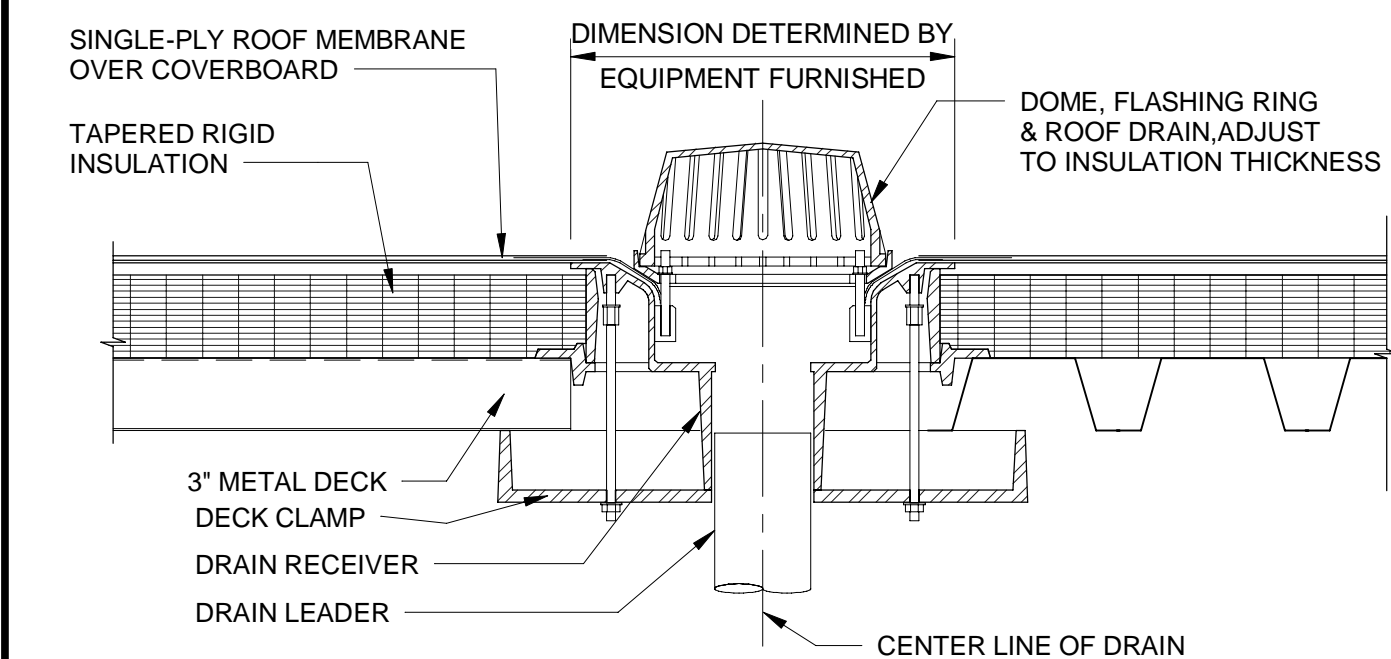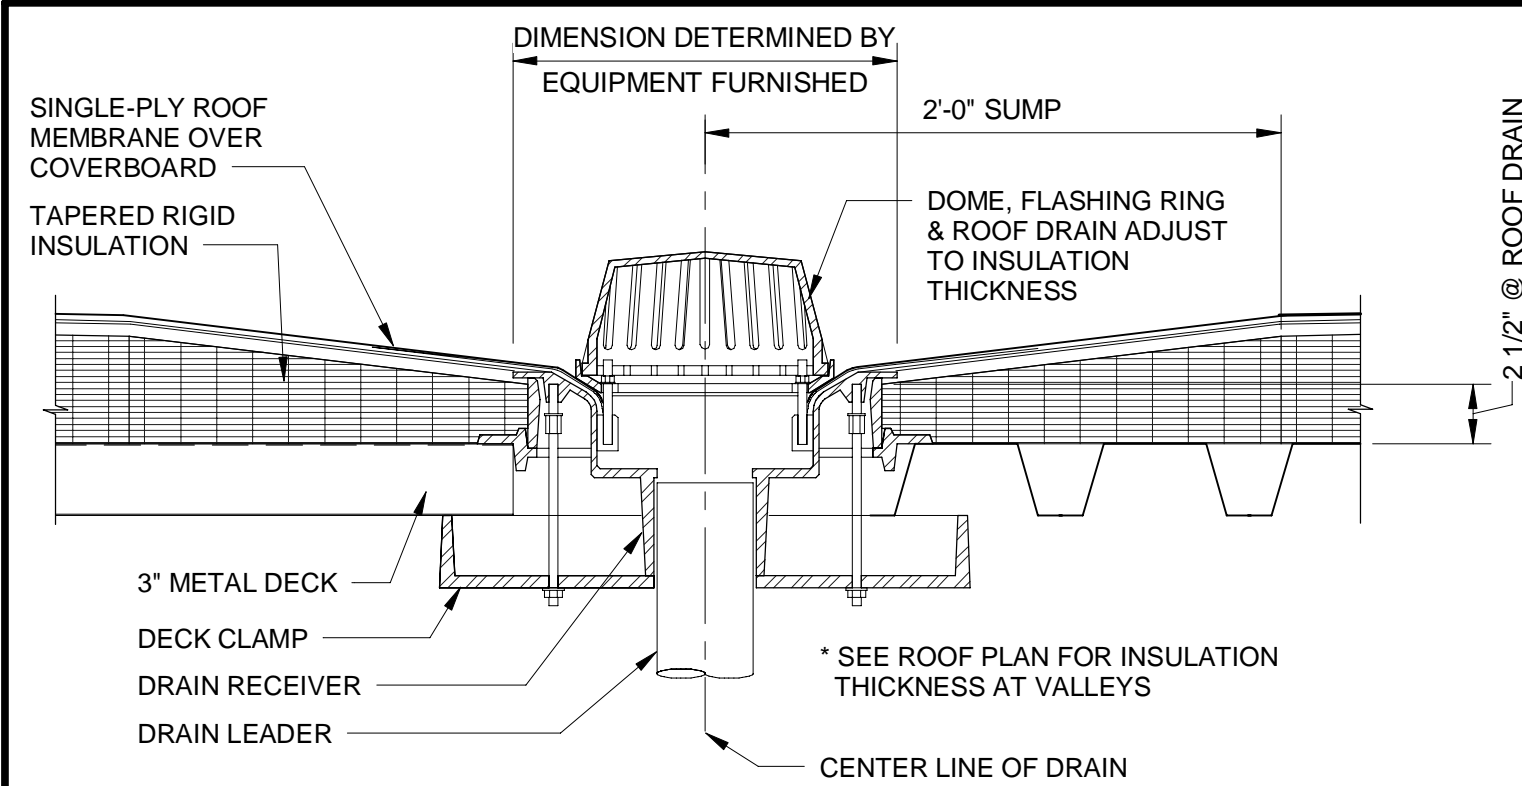

B&V Design, LLC
Kansas City, Missouri
ILLINOIS PROFESSIONAL
DESIGN FIRM - 184007283



AEROBIC GRANULAR SLUDGE - PHASE 1

[illegible]

GENERAL

ARCHITECTURAL

ROOF & MISCELLANEOUS DETAILS

99-A-501

128
OF
163

PLOTTED: 12/16/2022 11:54:42 AM
 FILE: BIM 360://409469 - Aerobic Granular Sludge Phase 1/409469 - AGS.rvt


FINISH SCHEDULE																			
NO.	NAME	FLOOR		WALLS												CEILING			REMARKS
		MATRL	FINISH	NORTH			EAST			SOUTH			WEST			MATRL	FINISH	HEIGHT	
				MATRL	FINISH	BASE	MATRL	FINISH	BASE	MATRL	FINISH	BASE	MATRL	FINISH	BASE				
AGS REACTORS AND PIPE GALLERY																			
01-001	STAIR NO.1	CO	FS	CO/CB	PT/PT	NO	CO/CB	PT/PT	NO	CO/CB	PT/PT	NO	CO/CB	PT/PT	NO	CO	PT	34'-4"	
01-002	STAIR NO.2	CO	FS	CO/CB	PT/PT	NO	CO/CB	PT/PT	NO	CO/CB	PT/PT	NO	CO/CB	PT/PT	NO	CO	PT	34'-4"	
01-003	PIPE GALLERY	CO	FS	CO	PT	NO	CO	PT	NO	CO	PT	NO	CO	PT	NO	CO	PT	21'-3"	
AGS SUPPORT FACILITIES																			
02-101	MCC	CO	FS	CB	PT	NO	CB	PT	NO	CB	PT	NO	CB	PT	NO	MD	PT	25'-10"	
02-102	BLOWERS	CO	FS	CB/AWPS	PT/FF	NO	CB/AWPS	PT/FF	NO	CB/AWPS	PT/FF	NO	CB/AWPS	PT/FF	NO	MD	PT	25'-10"	

SCHEDULE LEGEND

- AL
ALUM
AWPS
CB
CO
FF
FRP
FS
MD
NO
PT
- ACTIVE LEAF
- ALUMINUM
- ACOUSTICAL WALL PANEL SYSTEM
- CONCRETE BLOCK
- CONCRETE
- FACTORY FINISH
- FIBER REINFORCED PLASTIC
- FLOOR SEALER
- METAL DECK
- NONE
- PAINTED


DOOR SCHEDULE (D)																
DOOR No. (D)	DOOR SIZE		DOOR							FRAME					REMARKS	
	WIDTH	HEIGHT	TYPE (D)	MATERIAL	DETAILS			HDWR	RATING	TYPE (F)	MATERIAL	DIMENSIONS				
					HEAD	JAMB	SILL					HEAD	WIDTH	DEPTH		
AGS REACTORS AND PIPE GALLERY																
01-001A		3'-0"	7'-0"	B	FRP	1	2	3	3	45 MIN	A	FRP	2"	2"	5 3/4"	FIRE RATED GLASS
01-001B		3'-0"	7'-0"	B	FRP	1	2	3	3	45 MIN	A	FRP	2"	2"	5 3/4"	FIRE RATED GLASS
01-001C		3'-0"	7'-0"	B	FRP	6	5 SIM	7	1	-	A	FRP	4"	2"	5 3/4"	1" INSULATED GLASS
01-002A		3'-0"	7'-0"	B	FRP	1	2	3	3	45 MIN	A	FRP	2"	2"	5 3/4"	FIRE RATED GLASS
01-002B		3'-0"	7'-0"	B	FRP	1	2	3	3	45 MIN	A	FRP	2"	2"	5 3/4"	FIRE RATED GLASS
01-002C		3'-0"	7'-0"	B	FRP	6	5 SIM	7	1	-	A	FRP	4"	2"	5 3/4"	1" INSULATED GLASS
AGS SUPPORT FACILITIES																
02-101A	PR	3'-0"	7'-0"	B	FRP	4	5	7	1	-	A	FRP	4"	2"	5 3/4"	1" INSULATED GLASS
02-101B		3'-0"	9'-0"	A/A	FRP	4	5	7	2	-	A	FRP	4"	2"	5 3/4"	
02-101C		3'-0"	7'-0"	B	FRP	11	12	13	3	-	A	FRP	4"	2"	5 3/4"	1" INSULATED GLASS
02-102A		3'-0"	7'-0"	B	FRP	4	5	7	1	-	A	FRP	4"	2"	5 3/4"	1" INSULATED GLASS
02-102B		14'-0"	12'-8"	-	RA	8	9	10	-	-	-	RA			0"	MOTOR OPERATOR

LOUVER SCHEDULE (L)									
LEVEL	LOUVER No. (L)	OPENING		LOUVER					REMARKS
		WIDTH	HEIGHT	TYPE	HEAD	JAMB	SILL	TOP ELEV AFF	
AGS REACTORS AND PIPE GALLERY									
GALLERY TOP	01-001A	2'-0"	2'-0"	ALUM	14	15	16	10'-8"	
GALLERY TOP	01-001B	2'-0"	2'-0"	ALUM	14	15	16	4'-8"	
GALLERY TOP	01-002A	2'-0"	2'-0"	ALUM	14	15	16	4'-8"	
GALLERY TOP	01-002B	2'-0"	2'-0"	ALUM	14	15	16	10'-8"	
AGS SUPPORT FACILITIES									
FACILITIES OP. LEVEL	02-102A	3'-4"	5'-4"	ALUM	14	15	16	14'-8"	
FACILITIES OP. LEVEL	02-102B	4'-8"	5'-4"	ALUM	14	15	16	14'-8"	

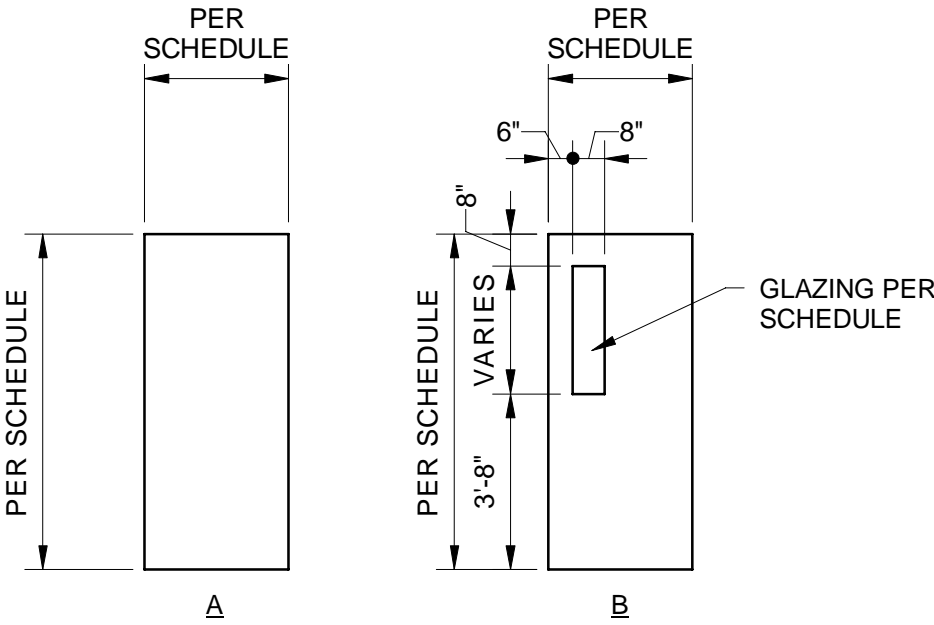


DOOR TYPES

1/4" = 1'-0"

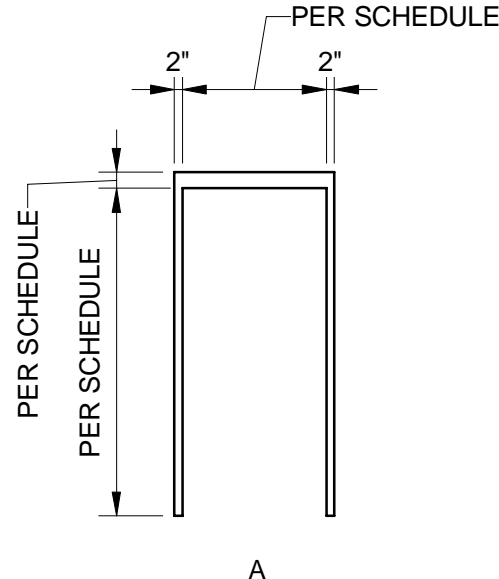


FRAME TYPES


1/4" = 1'-0"

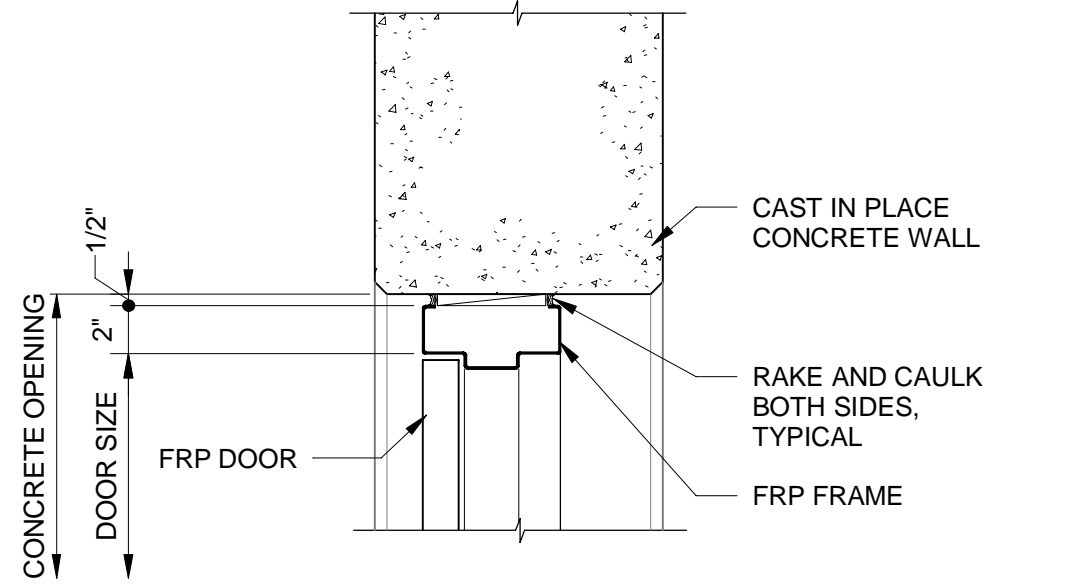


HEAD
1 1/2" = 1'-0"

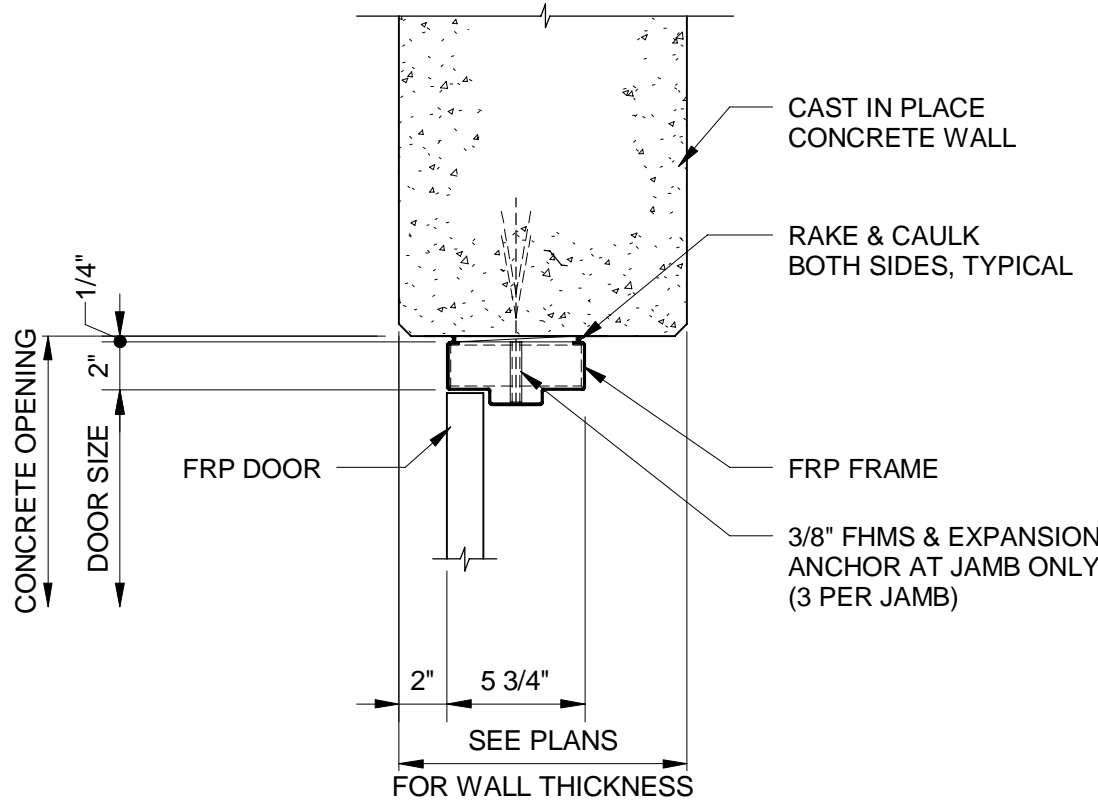

JAMB
1 1/2" = 1'-0"

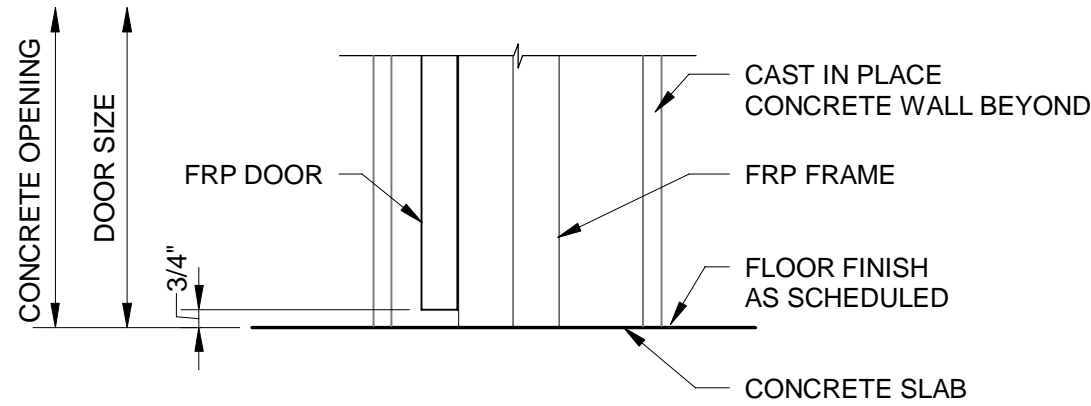

SILL
1 1/2" = 1'-0"

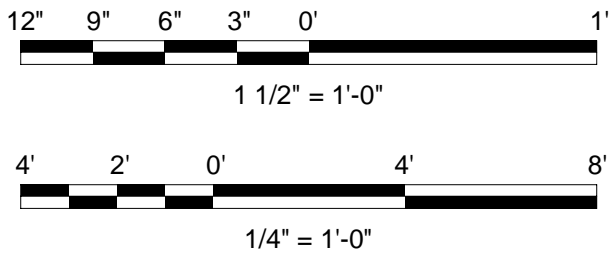

(SCALE BAR IS 4" AT FULL SCALE) 0 1/2 1 2 3 4

B&V Design, LLC
 Kansas City, Missouri
 ILLINOIS PROFESSIONAL
 DESIGN FIRM - 184007283



AEROBIC GRANULAR
 SLUDGE - PHASE 1

REVISIONS AND RECORD OF ISSUE	
DESIGNED:	RAB
DETAILED:	TMB, KMF
CHECKED:	PDR
APPROVED:	PDR
DATE:	12/20/2022
PROJECT NO.:	411752





GENERAL


ARCHITECTURAL


SCHEDULES & DOOR
 DETAILS

99-A-601

129
 OF
 163

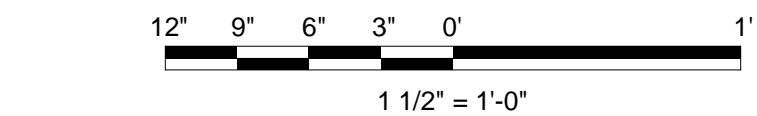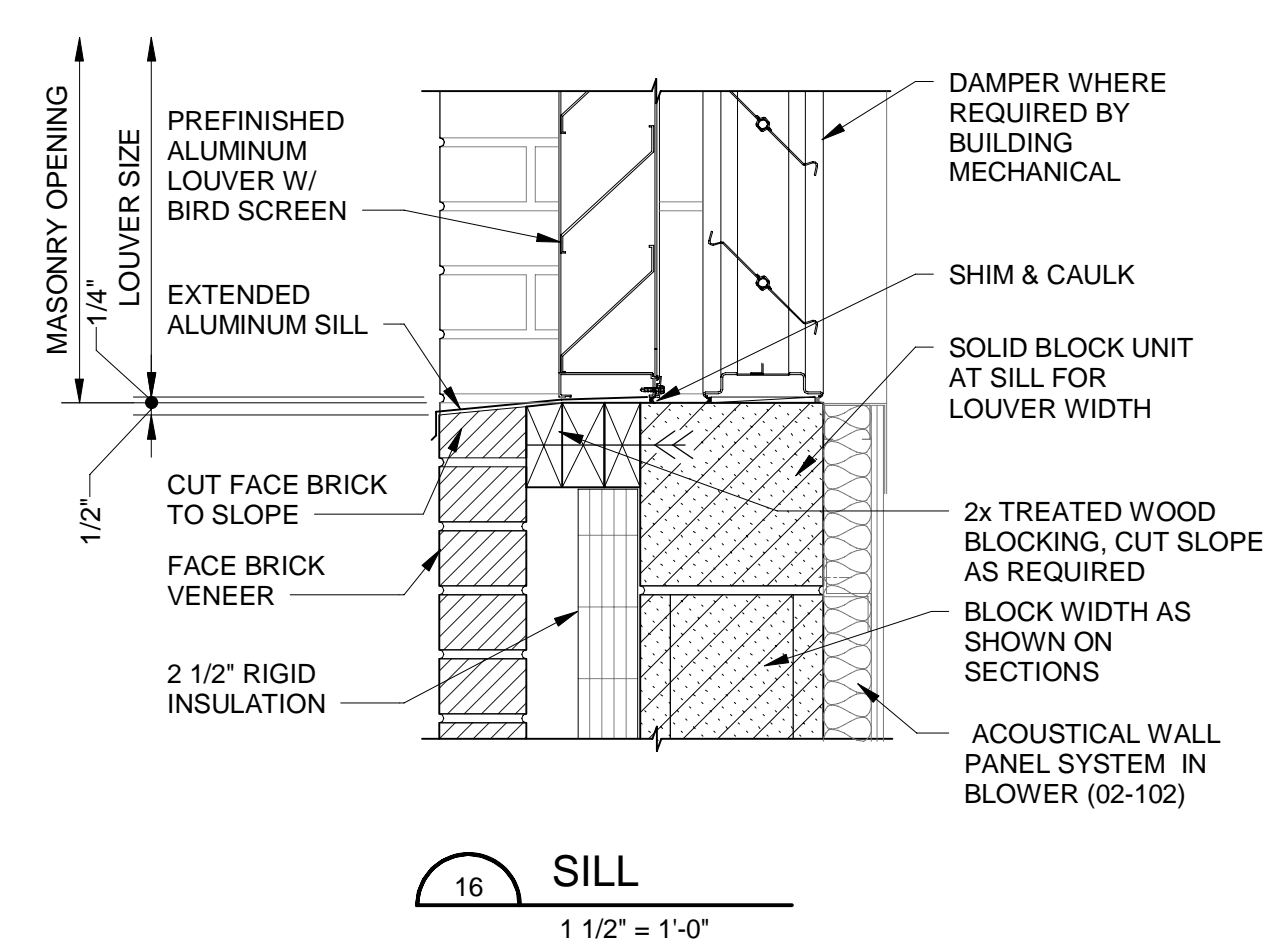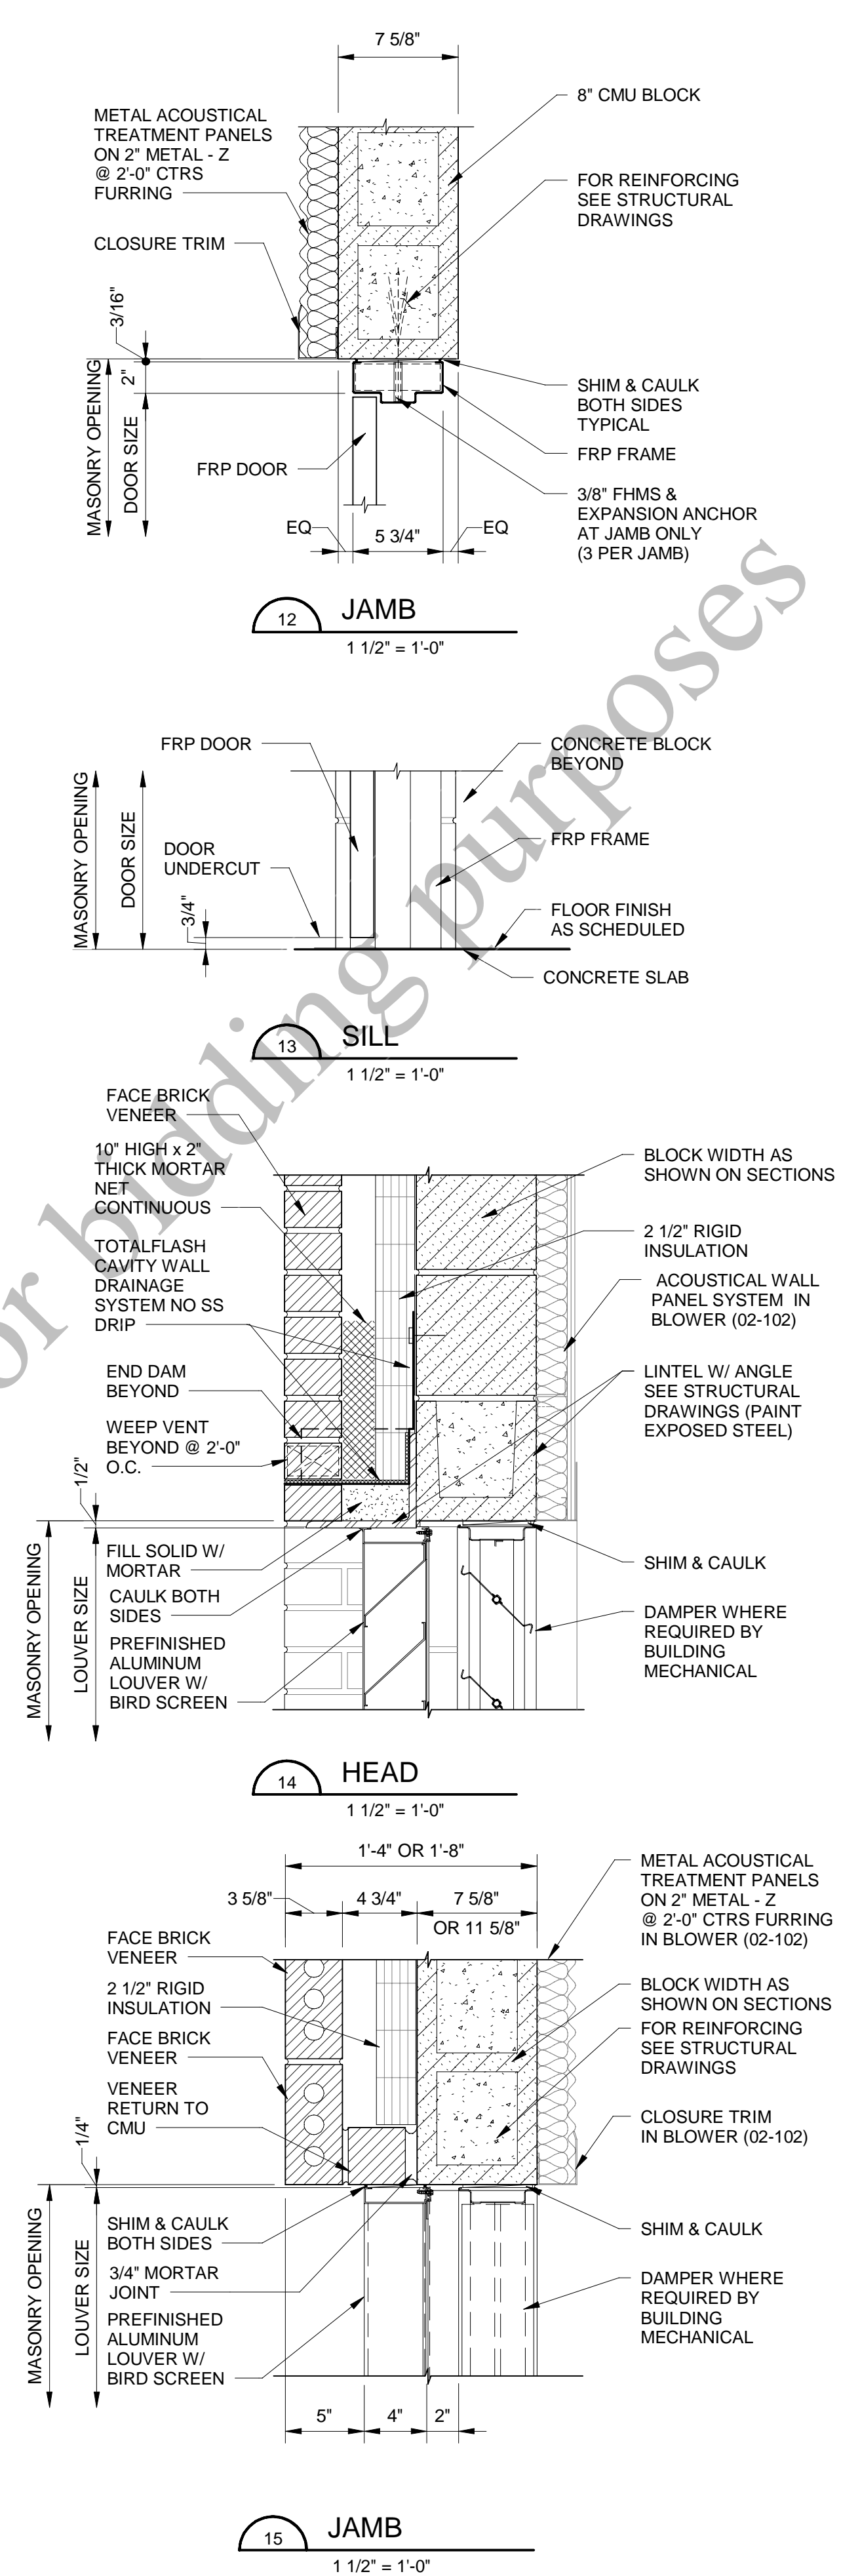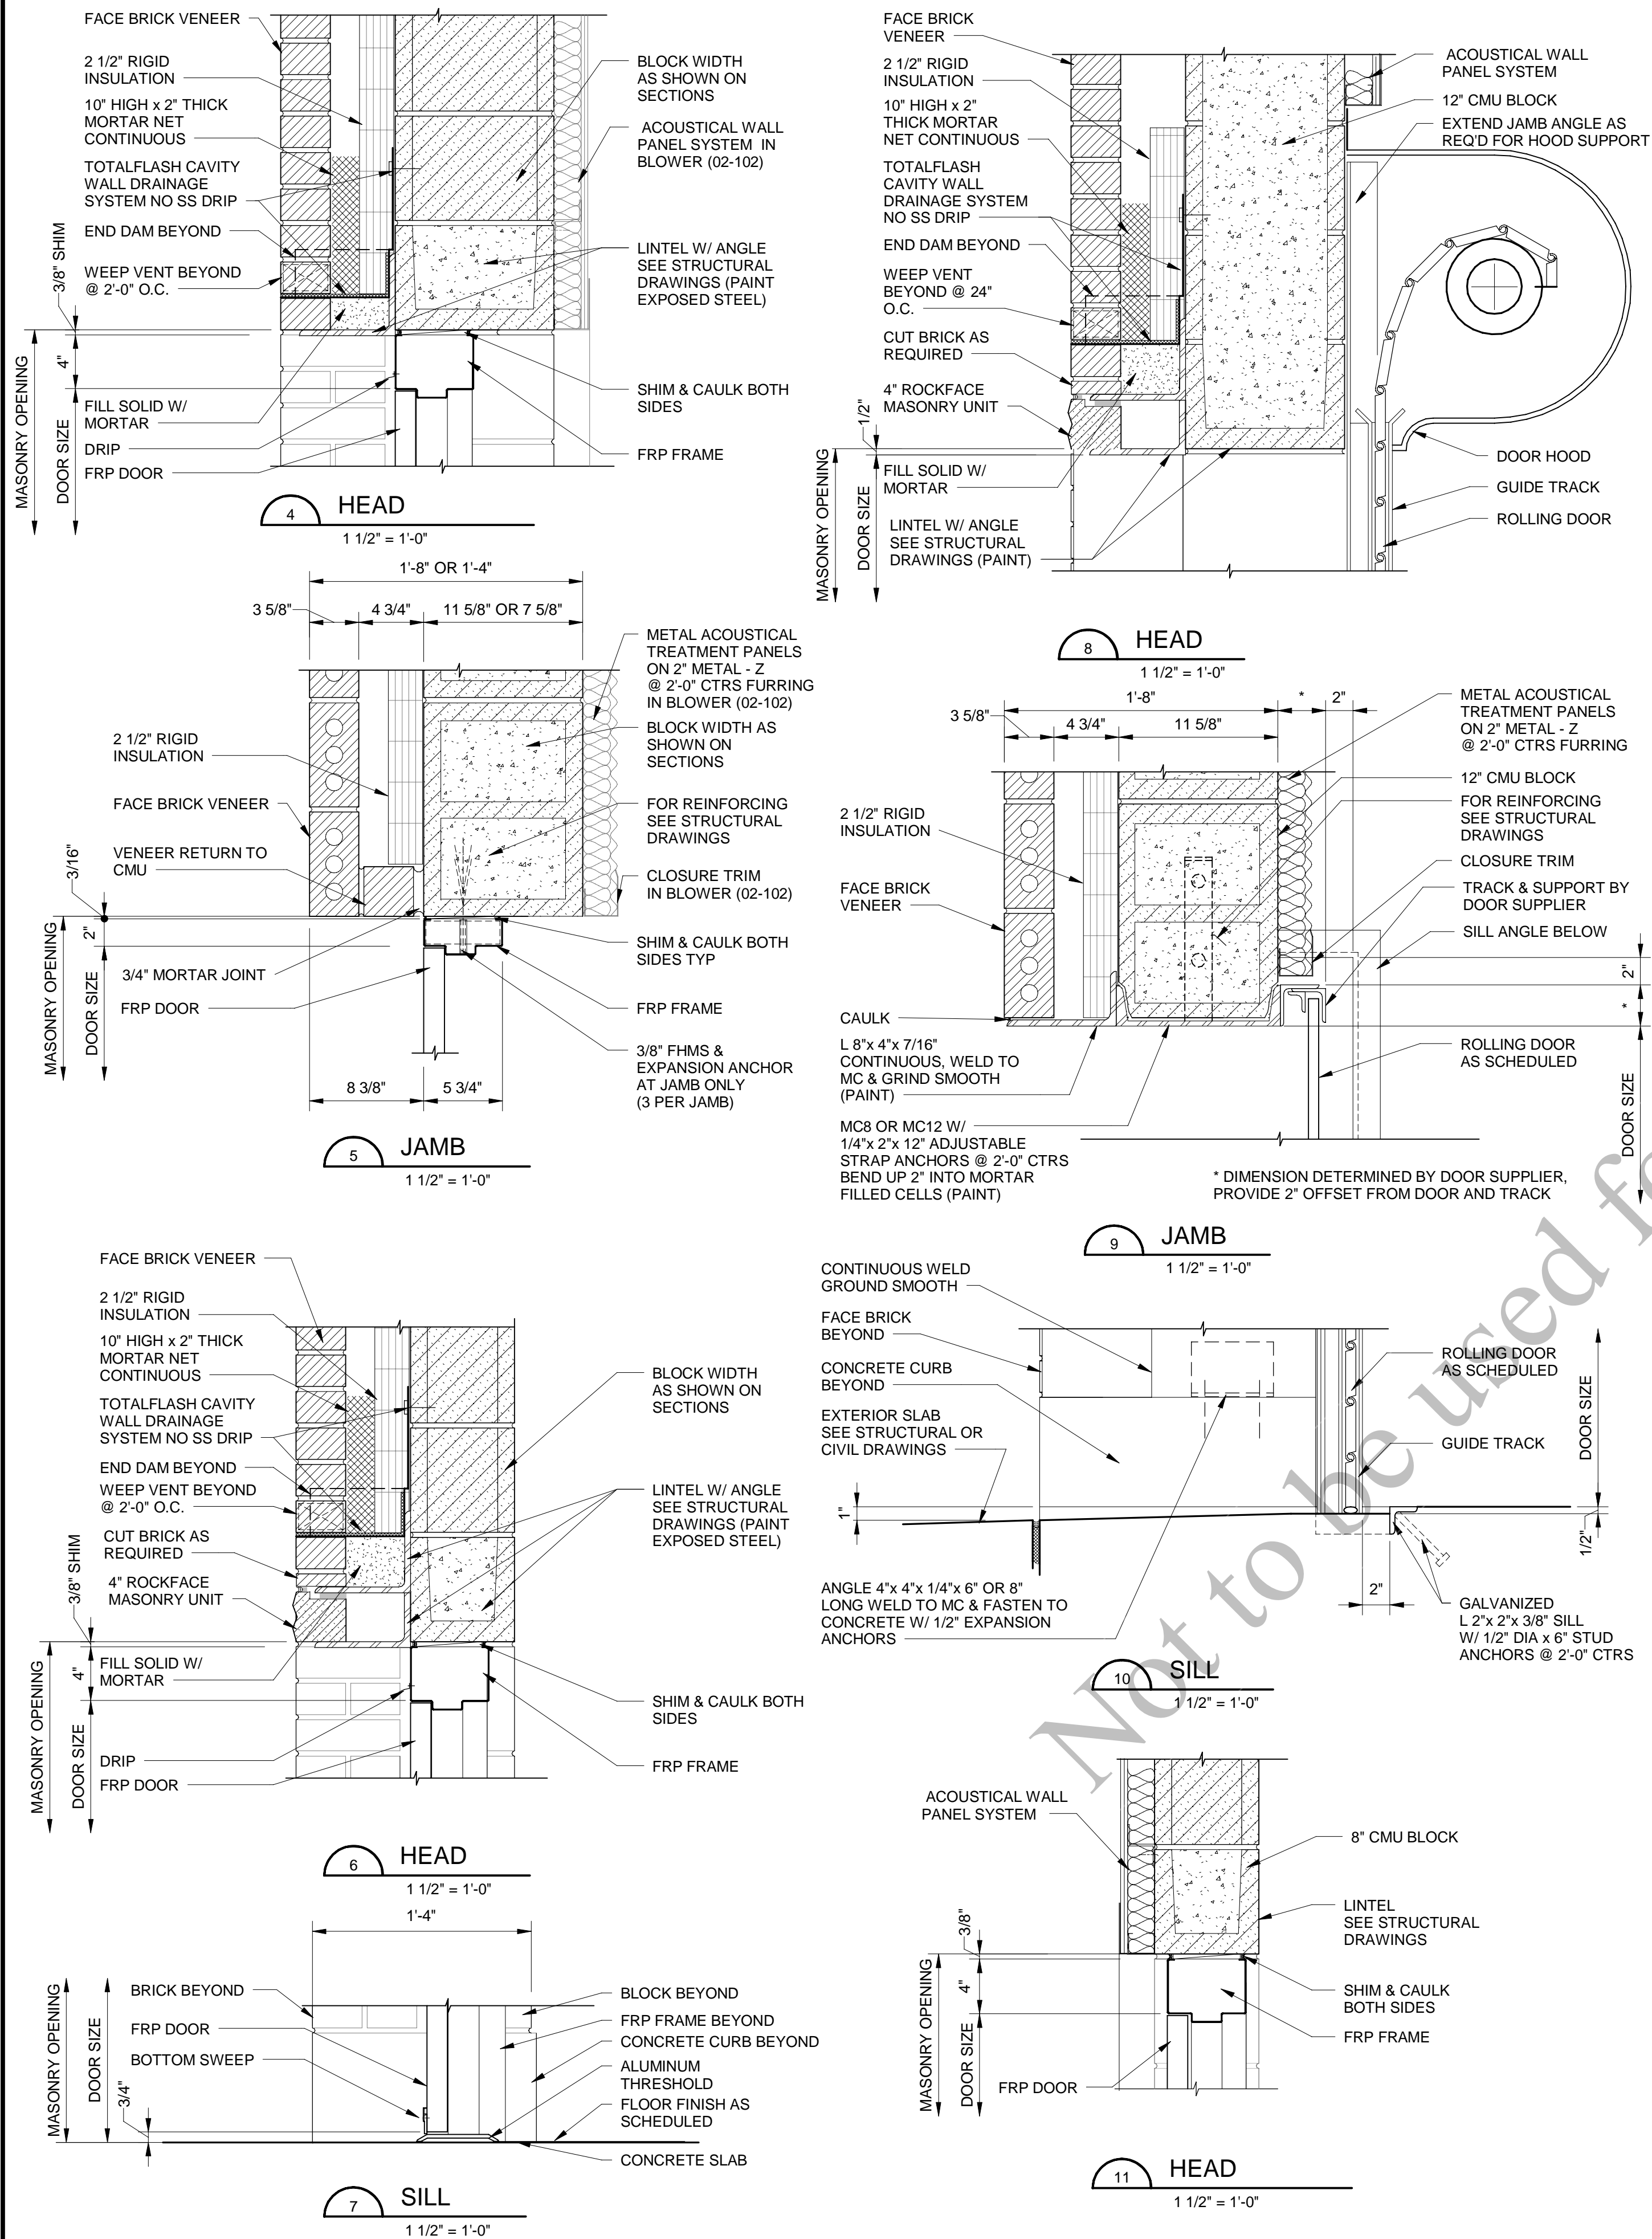

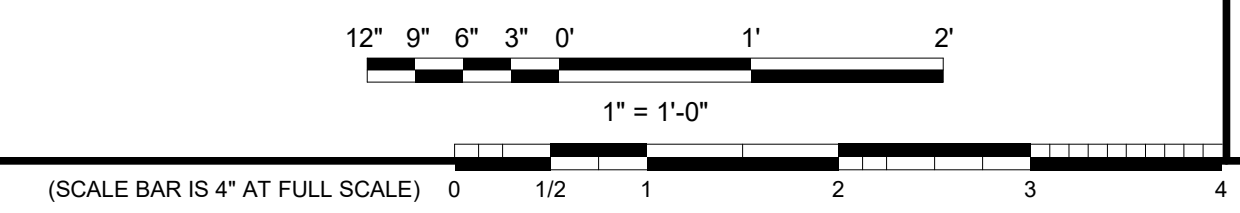

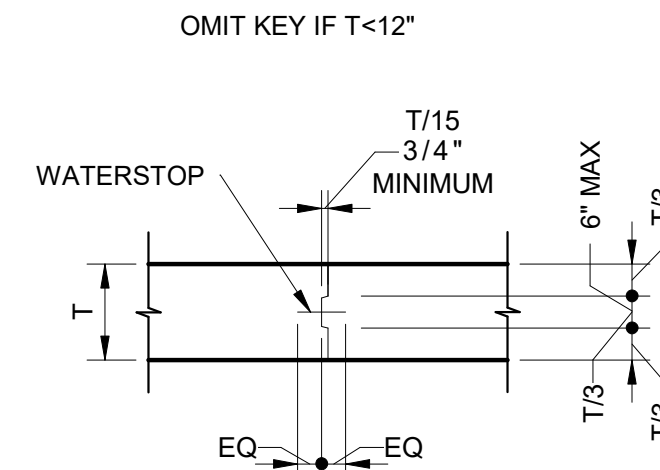


GENERAL SHEET NOTES:

1. DETAILS ON THIS DRAWING APPLY TO ALL DRAWINGS UNLESS NOTED OTHERWISE.
2. WORK THIS DRAWING WITH THE STANDARD CONCRETE REINFORCEMENT DETAILS.
3. AT WALL JOINTS AND AT WALL BASE JOINTS, SECURE ALL ELASTOMERIC WATERSTOPS IN THE CORRECT POSITION USING HOG RINGS OR GROMMETS SPACED AT 12 INCHES ALONG THE LENGTH OF THE WATERSTOP AND WIRE TIE TO ADJACENT REINFORCING STEEL.
4. AT SLAB JOINTS AND FOOTING JOINTS, ENSURE SPACE BENEATH AND AROUND WATERSTOP IS COMPLETELY FILLED WITH CONSOLIDATED CONCRETE. DURING OPERATION, MAKE VISUAL INSPECTION OF ENTIRE WATERSTOP AREA. LIMIT CONCRETE PLACEMENT TO ELEVATION OF WATERSTOP IN FIRST LIFT. RAISE ELASTOMERIC WATERSTOPS TO CONFIRM FULL CONSOLIDATION WITHOUT VOIDS. PLACE REMAINING CONCRETE TO FULL DEPTH OF SLAB.






Black & Veatch Corporation
Chicago, Illinois
ILLINOIS PROFESSIONAL
DESIGN FIRM - 184.002143-0006

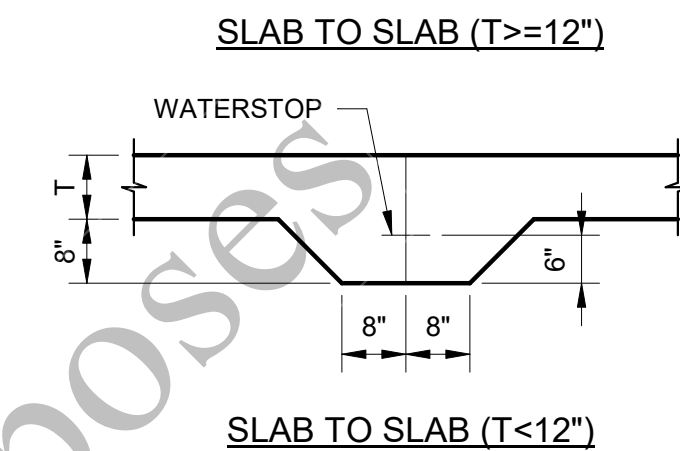SLAB TO BOTTOM OF WALLWALL TO WALLSLAB TO BOTTOM OF WALLWALL TO WALL

JOINTS WITHOUT WATERSTOPS




JOINTS WITH WATERSTOPS

- NOTES:**
1. REINFORCEMENT STEEL IS CONTINUOUS THROUGH ALL CONSTRUCTION JOINTS.
 2. "CSJ/W/WS" - CONSTRUCTION JOINT WITH WATERSTOP.
 3. "CSJ" - CONSTRUCTION JOINT WITHOUT WATERSTOP.
 4. UNLESS NOTED OTHERWISE, WATERSTOPS MAY BE STEEL OR PVC.
 5. WATERSTOP SIZE SHALL BE 6" FOR WALLS AND SLABS 18" OR LESS IN THICKNESS, AND SHALL BE 9" FOR WALLS AND SLABS THICKER THAN 18".

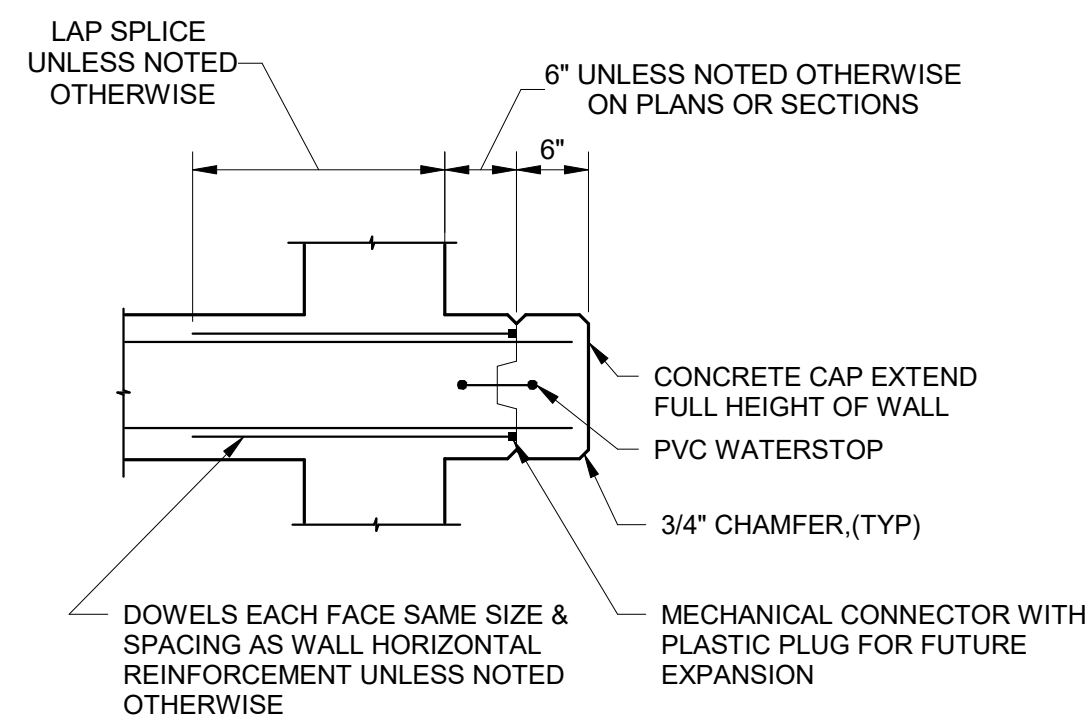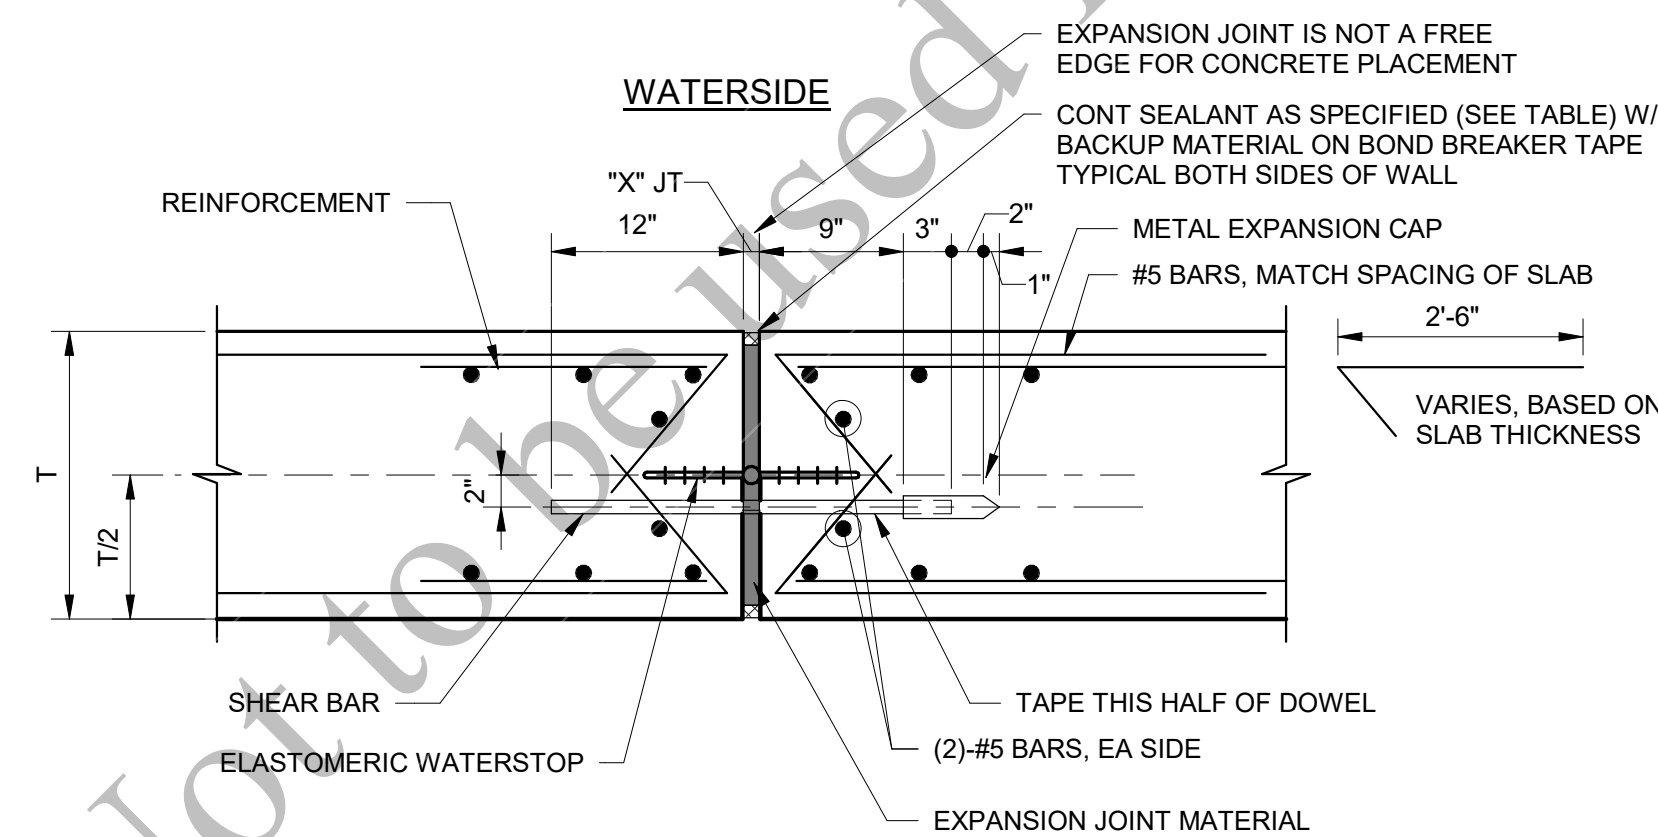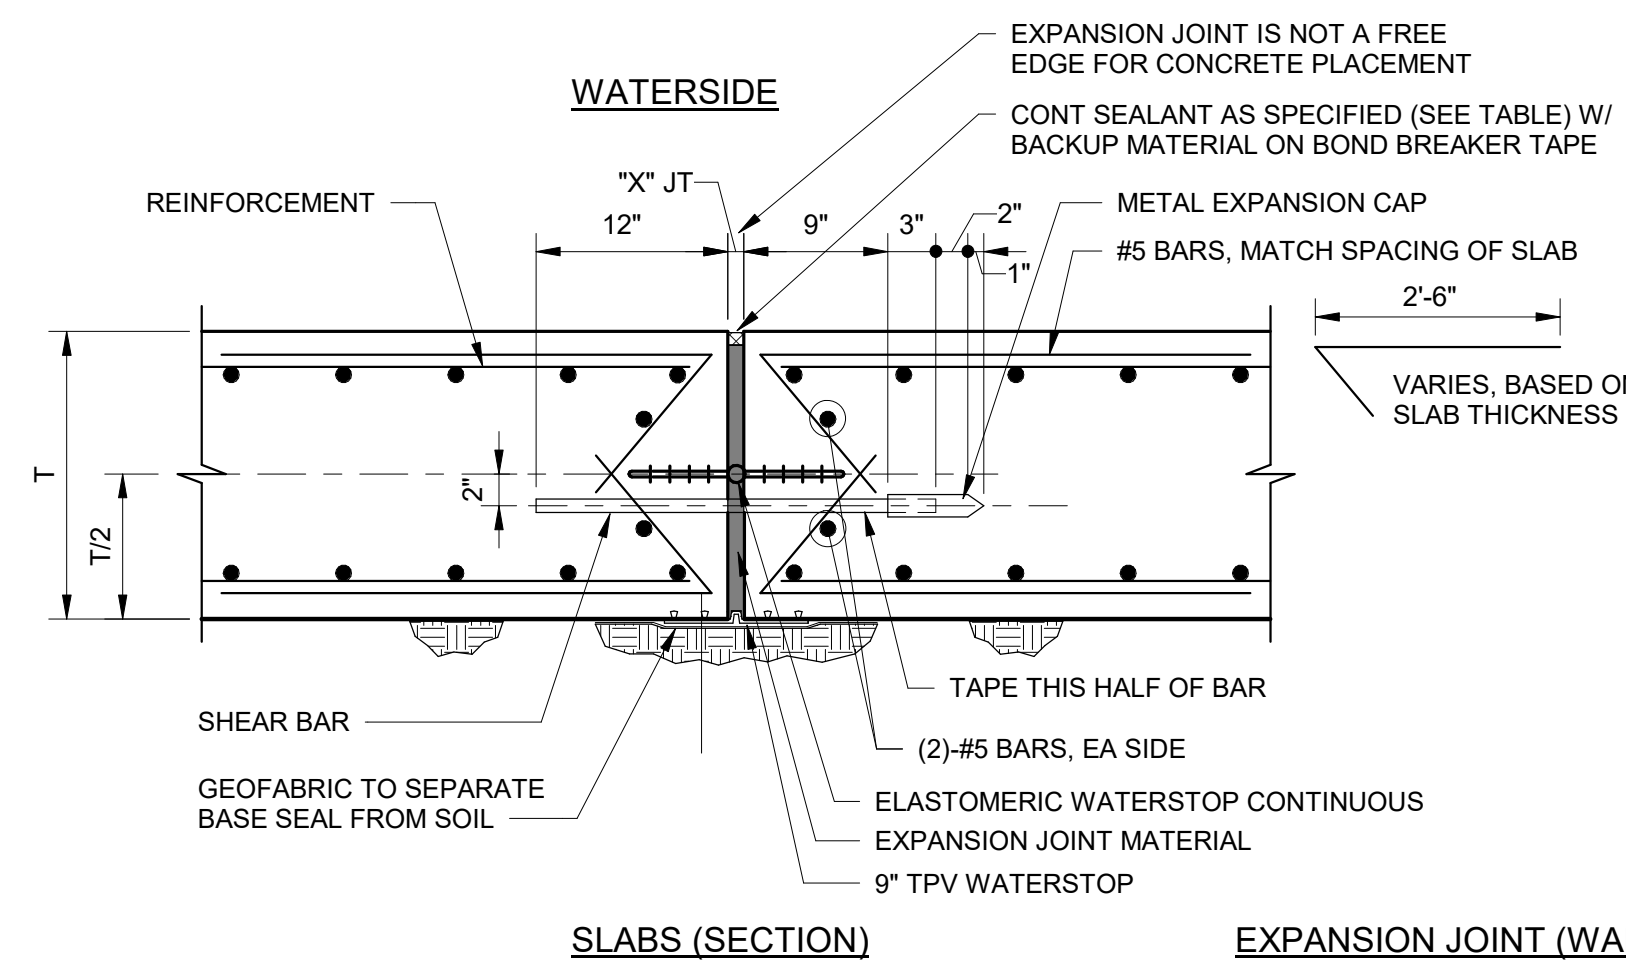

SEALANT TYPE	EJ SIZE "X"	SEALANT DEPTH
POLYURETHANE OR POLYSULFIDE	3/4"	3/8"
	1"	1/2"
	1 1/2"	3/4"

- NOTES:
1. PROVIDE 1" DIAMETER SHEAR BARS @ 6" CENTERS ACROSS JOINT UNLESS NOTED OTHERWISE.
 2. REINFORCING STEEL SHALL NOT BE EXTENDED ACROSS JOINT UNLESS NOTED OTHERWISE. SHEAR BARS SHALL BE SMOOTH FREE FROM RUST OR SCALE, AND GREASED TO PREVENT BOND (ONE HALF BAR ONLY).
 3. WATERSTOP SIZE SHALL BE 6" FOR WALLS AND SLABS LESS THAN 18" IN THICKNESS, AND SHALL BE 8" FOR WALLS AND SLABS THICKER THAN 18".
 4. "EJ W/ WS" - EXPANSION JOINT WITH ELASTOMERIC WATERSTOP
"EJ W/ WS" - EXPANSION JOINT WITHOUT WATERSTOP

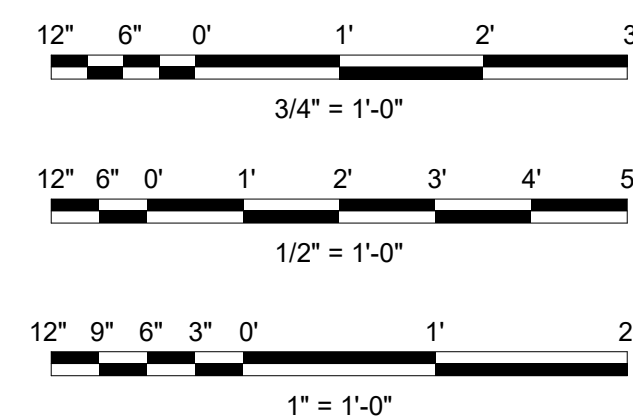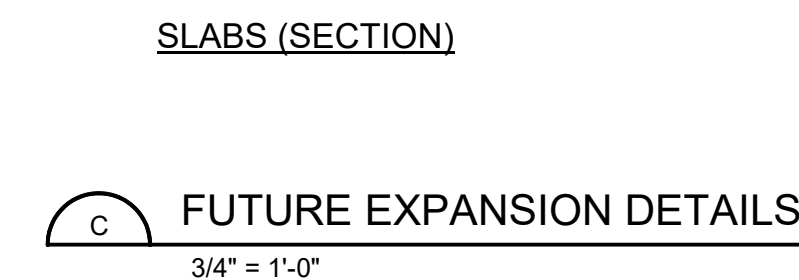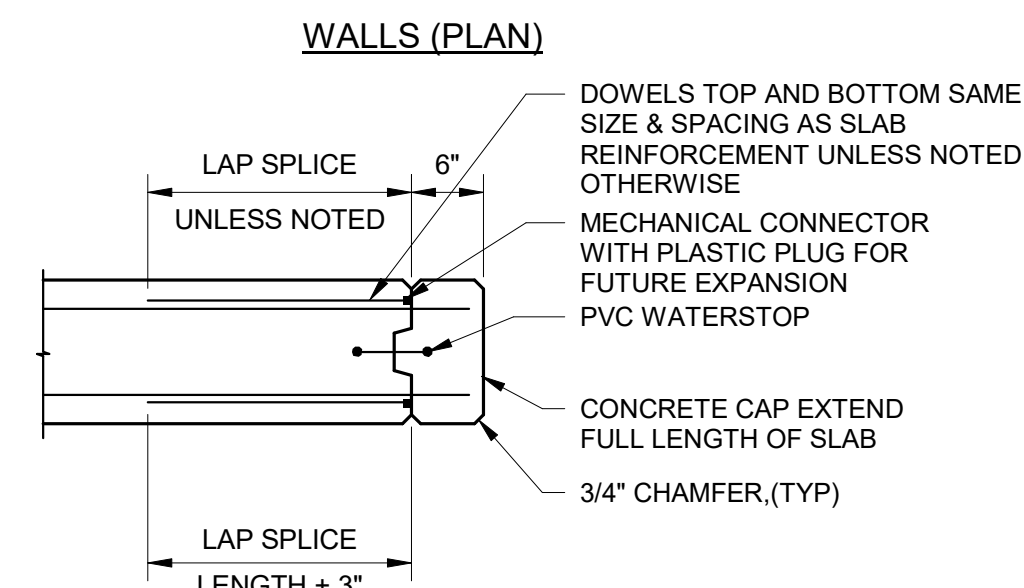

(SCALE BAR IS 4" AT FULL SCALE) 0 1/2 1 2 3 4

AEROBIC GRANULAR
SLUDGE - PHASE 1

REVISIONS AND RECORD OF ISSUE

DESIGNED:	SKA
DETAILED:	UBS
CHECKED:	CG
APPROVED:	TNG
DATE:	12/20/2022
PROJECT NO.:	411752

PROJECT NO.: 411752


DETAILS

STRUCTURAL

STANDARD CONCRETE JOINT DETAILS


99-S-502

132
OF
163

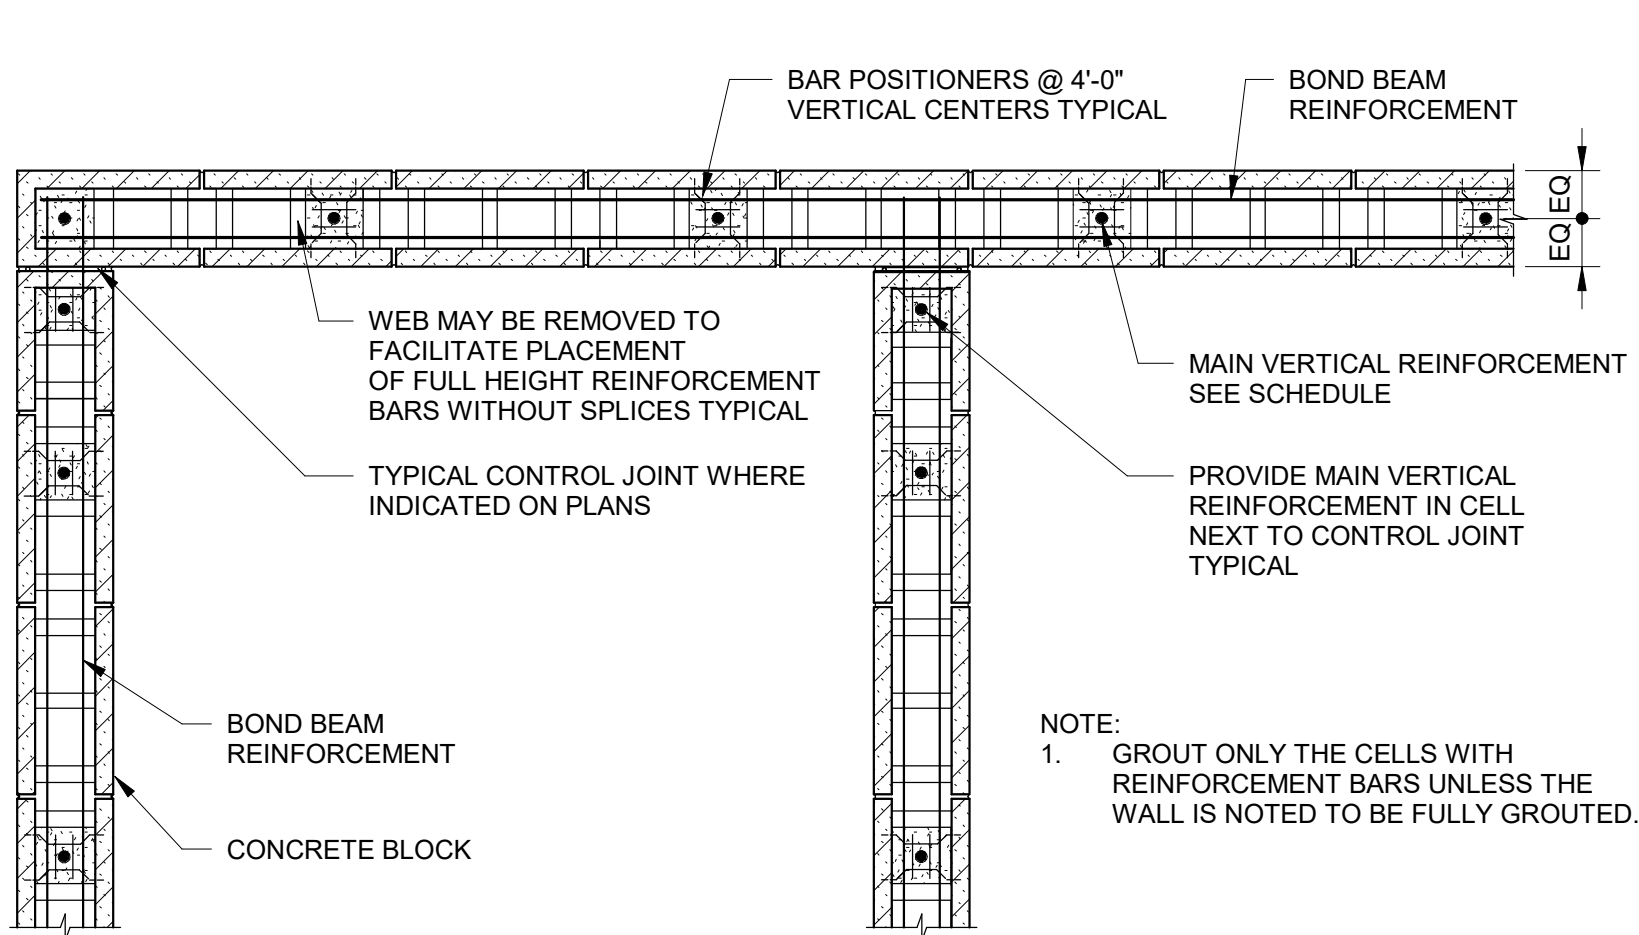

TYPICAL REINFORCEMENT WITH CORNER CONTROL JOINTS

SINGLE CURTAIN VERTICAL REINFORCEMENT SHOWN.
 DOUBLE CURTAIN SIMILAR EXCEPT BARS POSITIONED
 EACH FACE, SEE ADJACENT DETAIL.

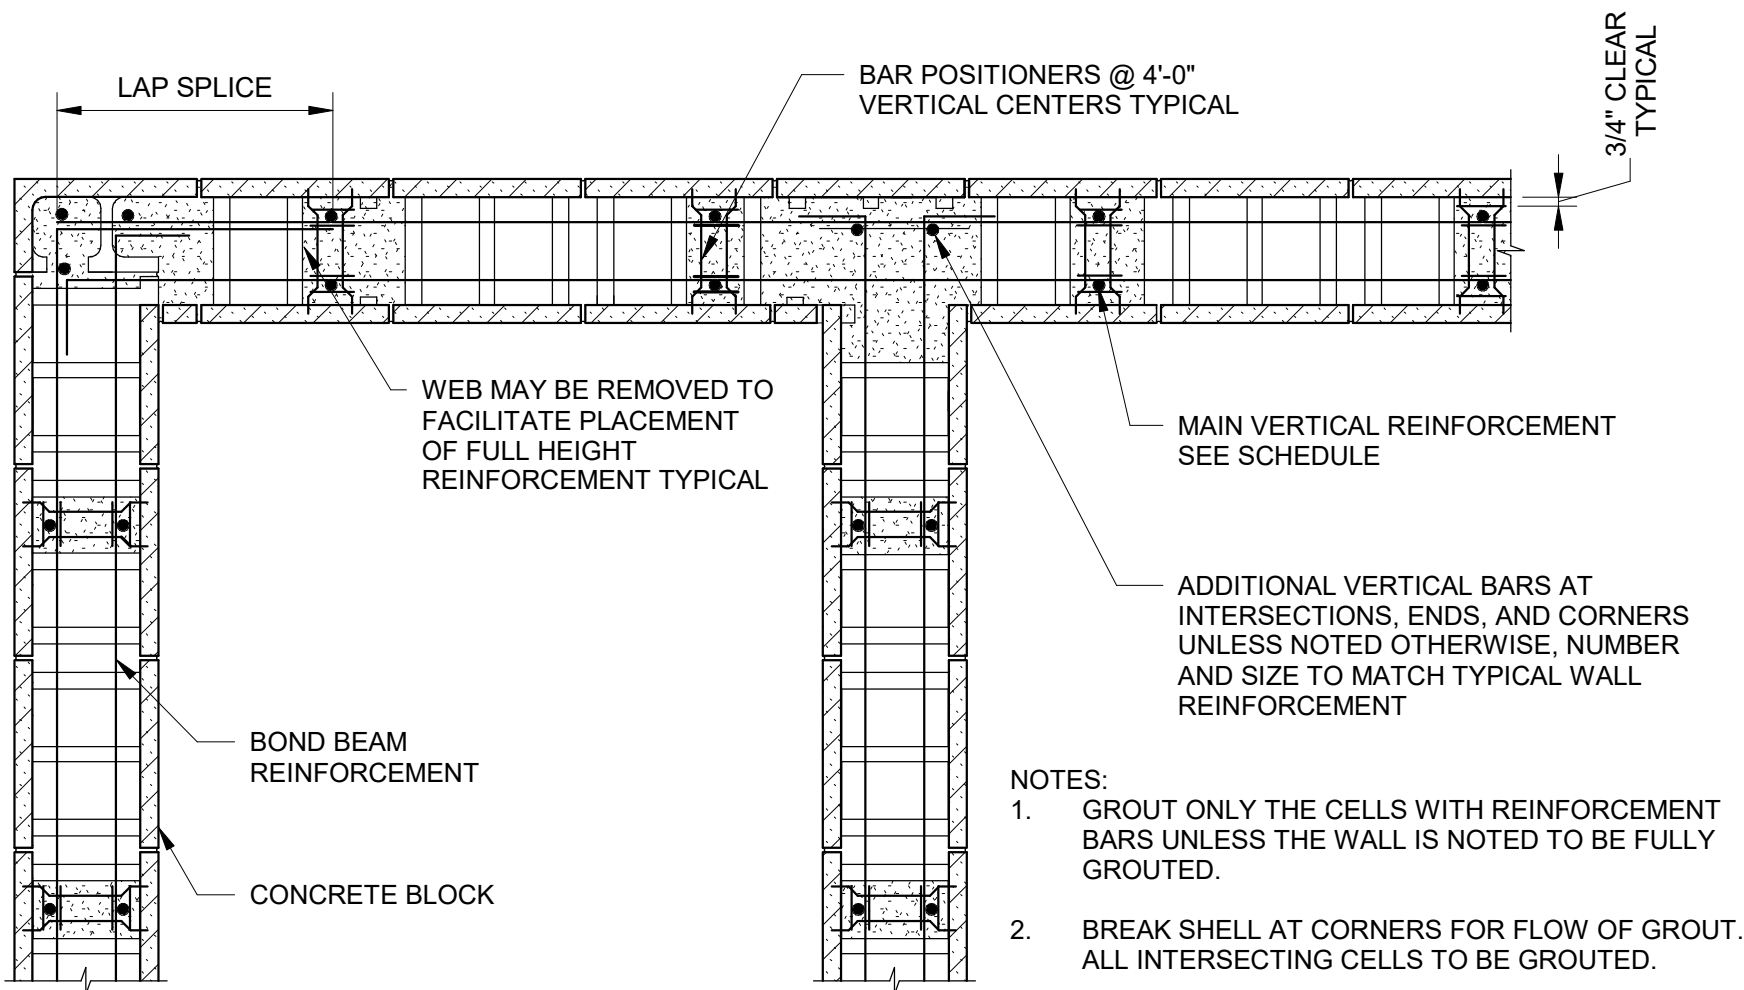


TYPICAL REINFORCEMENT WITHOUT CORNER CONTROL JOINTS

DOUBLE CURTAIN VERTICAL REINFORCEMENT SHOWN.
 SINGLE CURTAIN SIMILAR EXCEPT BARS CENTERED
 IN WALL, SEE ADJACENT DETAIL.


TYPICAL MASONRY REINFORCEMENT PLANS

3/4" = 1'-0"

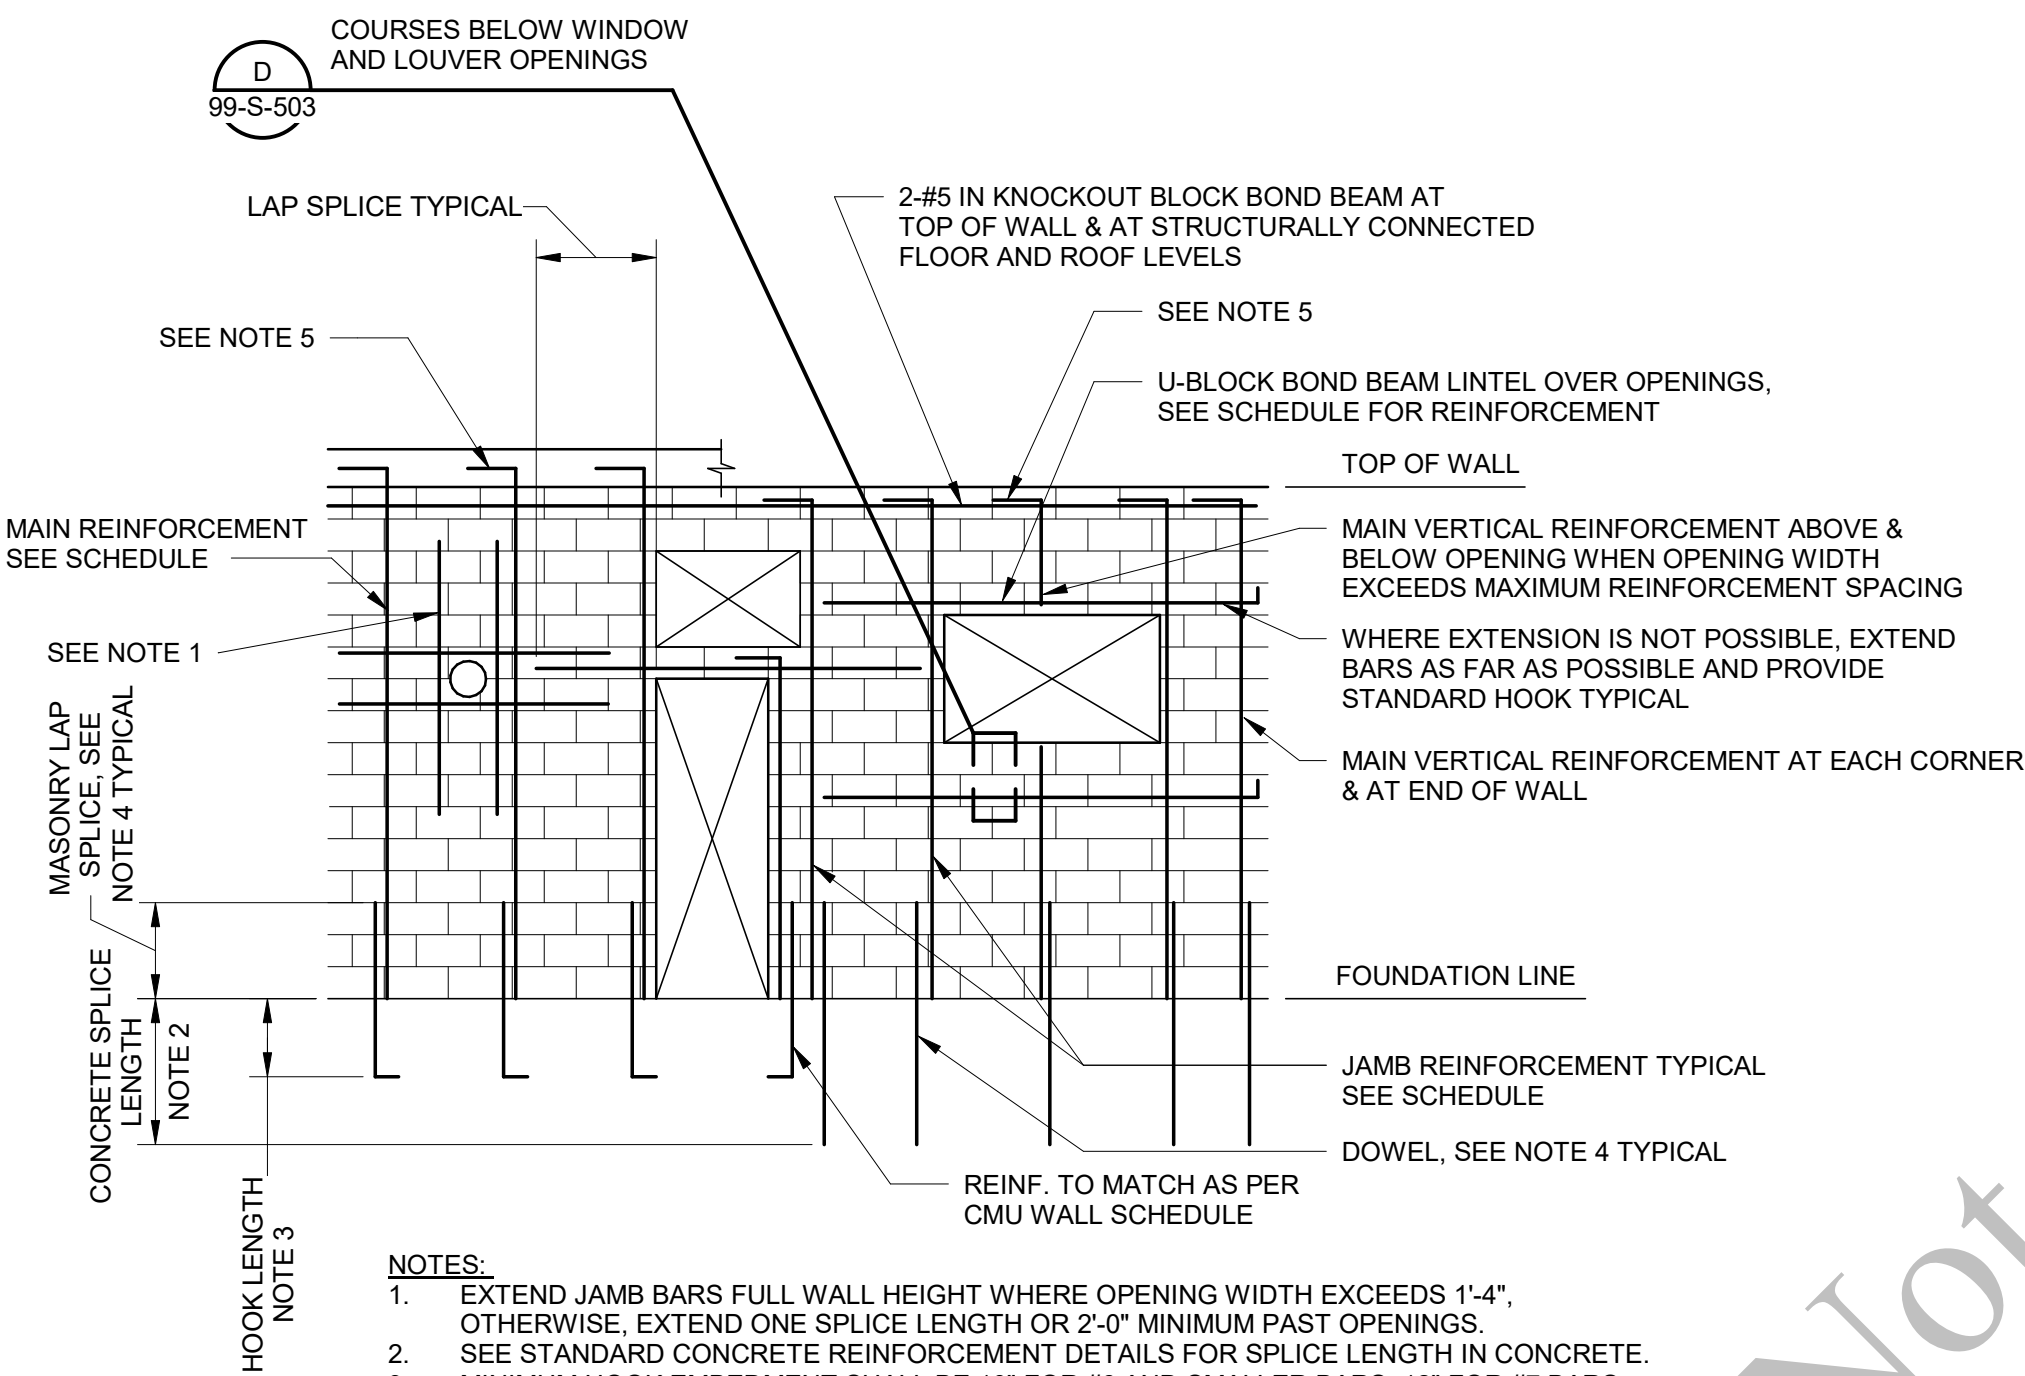


TYPICAL MASONRY REINFORCEMENT ELEVATION

1/4" = 1'-0"

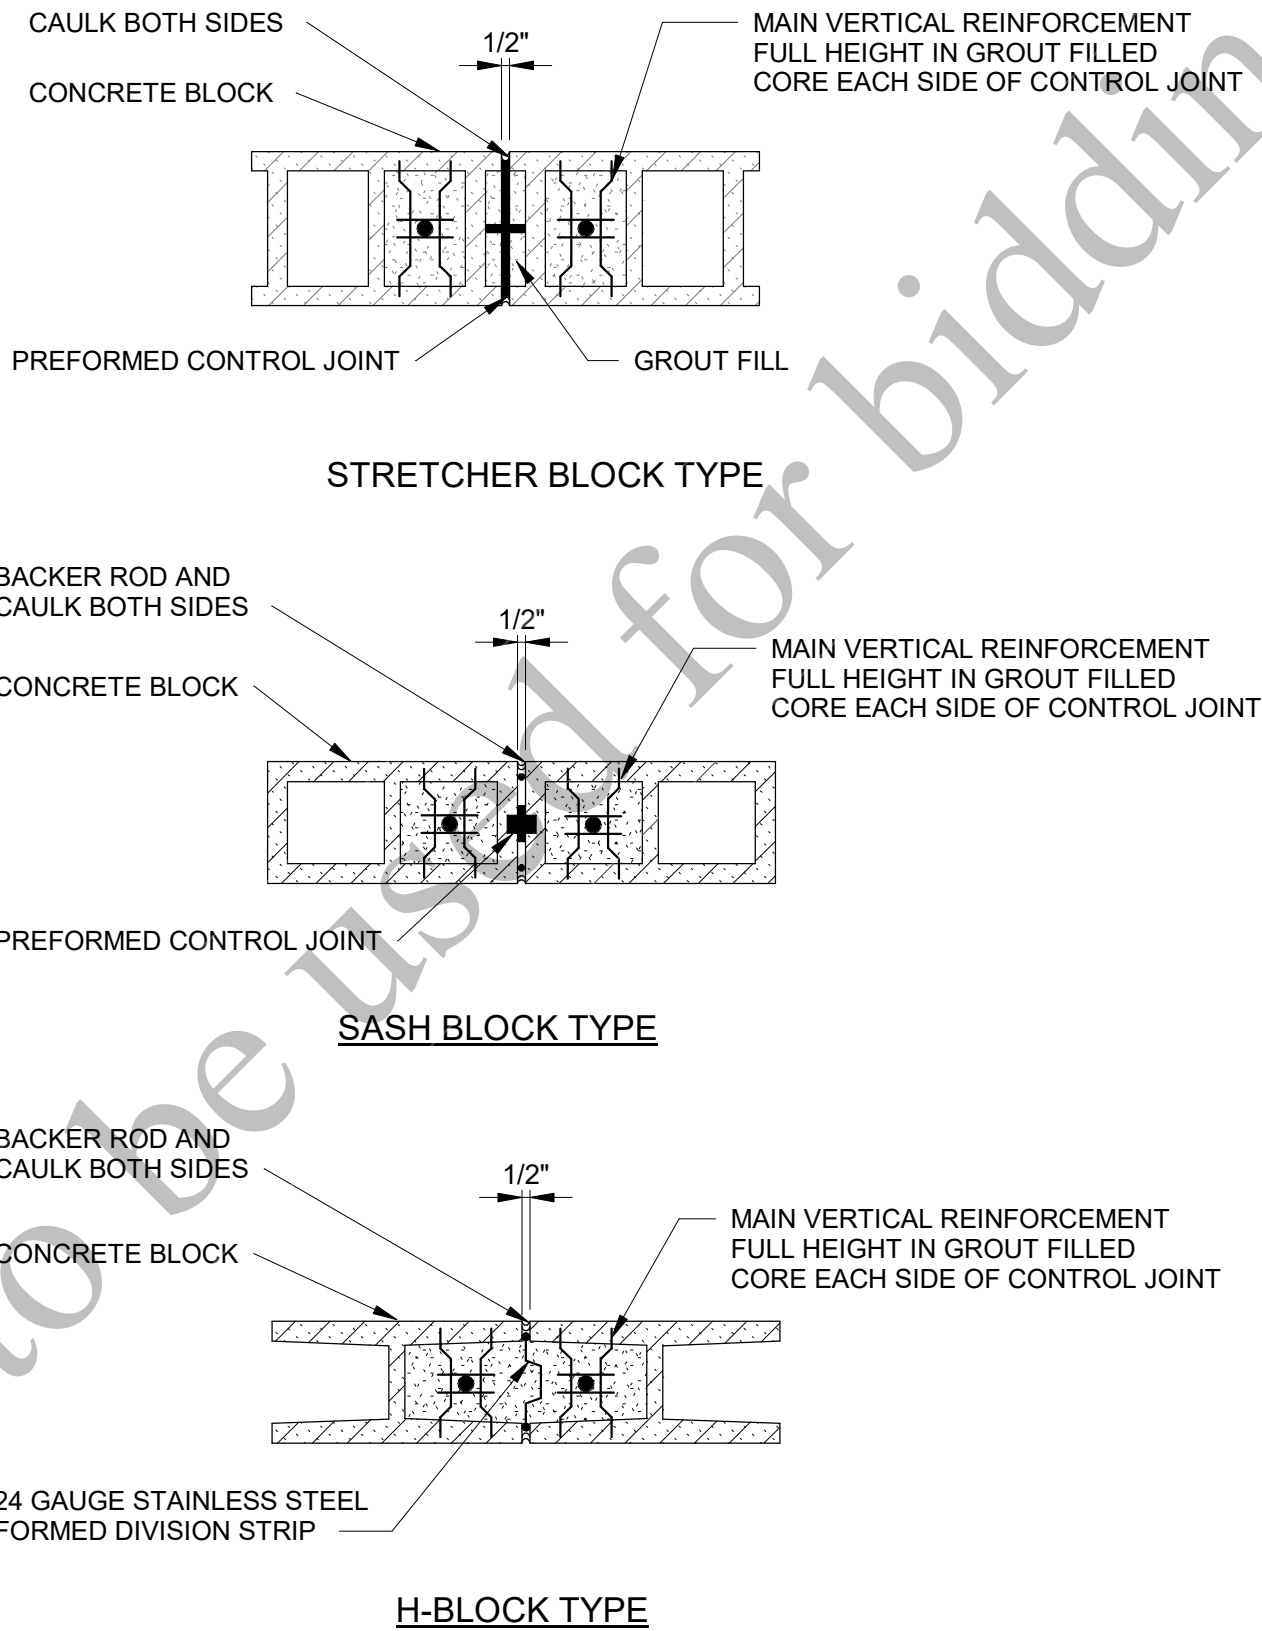

TYPICAL CMU CONTROL JOINT

1" = 1'-0"

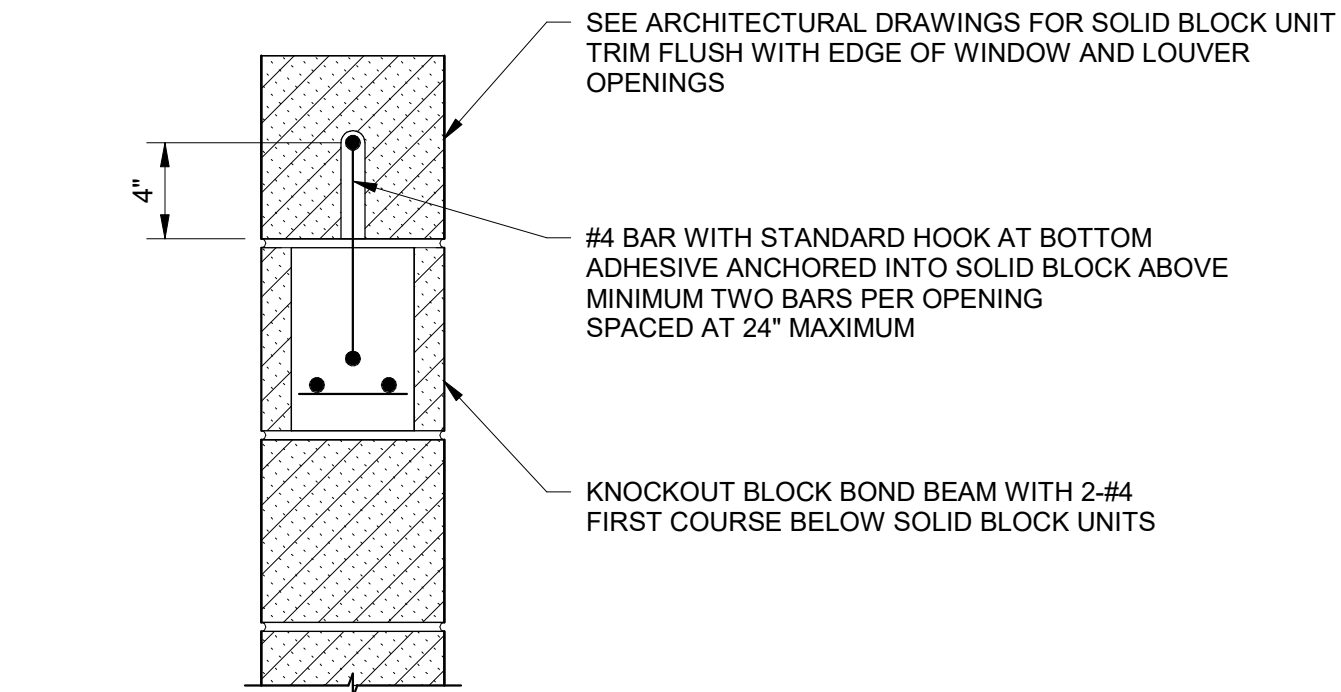

COURSES BELOW WINDOW AND LOUVER OPENING

1 1/2" = 1'-0"

GENERAL SHEET NOTES:

- THE DETAILS ON THIS SHEET ARE APPLICABLE TO ALL CONCRETE MASONRY CONSTRUCTION. SPECIAL NOTES, SECTIONS AND DETAILS SPECIFICALLY NOTED ON THE DESIGN DRAWINGS SHALL BE APPLICABLE IN LIEU OF THESE TYPICAL DETAILS.
- FOR MISCELLANEOUS APPURTENANCES INCLUDING EMBEDMENTS, BRACING, STEEL OR PRECAST LINTELS, VENEER, FLASHING, WEEPS, INSULATION, SEALING, CAULKING AND EMBEDDED PIPE AND ELECTRICAL CONDUIT, SEE THE DESIGN DRAWINGS.
- WORK THIS DRAWING WITH THE STANDARD CONCRETE MASONRY LINTEL & JAMB REINFORCEMENT DETAILS DRAWING.

CMU WALL AND MAIN REINFORCEMENT SCHEDULE

BUILDING	WALL	BLOCK THICKNESS	GROUTING (NOTE 1)	MAIN VERTICAL REINFORCEMENT			MAIN HORIZONTAL REINFORCEMENT	WALL CONTROL JOINTS
				BARS PER REINFORCED CELL (NOTE 2)	BAR SIZE	MAX SPACING OF VERTICAL REINFORCEMENT		
AGS REACTORS AND PIPE GALLERY (STAIR TOWER)	NORTH	8"	R	1 (CENTERED)	#4	48"	PROVIDE 8" BOND BEAM SPACED 2'-0" VERTICALLY WITH 1-#5 AT BOTTOM	
	SOUTH	8"	R	1 (CENTERED)	#4	48"		
	EAST	8"	R	1 (CENTERED)	#4	48"		
	WEST	8"	R	1 (CENTERED)	#4	48"		
	INTERIOR	8"	R	1 (CENTERED)	#4	48"		
AGS SUPPORT FACILITY	NORTH	12"	F	2 (ONE AT EF)	#5	48"	PROVIDE 8" BOND BEAM SPACED 2'-0" VERTICALLY WITH 2-#5 AT BOTTOM IN 12" CMU WALL AND 1-#5 AT BOTTOM IN 8" CMU WALL	
	SOUTH	12"	F	2 (ONE AT EF)	#5	48"		
	EAST	12"	F	2 (ONE AT EF)	#5	8"		
	WEST	12"	F	2 (ONE AT EF)	#5	48"		
	INTERIOR	8"	F	1 (CENTERED)	#5	48"		

- NOTES:
- "F" INDICATES A FULLY GROUTED WALL, "R" INDICATES TO GROUT ONLY THE REINFORCED CELLS.
 - "1" INDICATES A SINGLE BAR CENTERED IN WALL. "2" INDICATES DOUBLE CURTAIN REINFORCEMENT, WITH ONE BAR EACH FACE OF CELL.
 - SEE THE OTHER STRUCTURAL DRAWINGS FOR ADDITIONAL REINFORCEMENT DETAILS AT CONNECTIONS, TOPS OF WALLS, JAMBS, LINTELS, ETC.
 - CMU = CONCRETE MASONRY UNIT

LENGTH OF LAP SPLICES FOR REINFORCEMENT (INCHES)

(f_m 2500 PSI, IBC 2012, 2015 & 2018)

BAR SIZE	8" CONCRETE MASONRY UNIT		12" CONCRETE MASONRY UNIT	
	SINGLE REINFORCEMENT	DOUBLE REINFORCEMENT	SINGLE REINFORCEMENT	DOUBLE REINFORCEMENT
4	12	20	12	17
5	18	32	12	27
6	34	-	21	51
7	47	-	29	(71)
8	(71)	-	45	(110)

- NON-CONTACT LAP SPLICES SHALL NOT BE USED.
- () BRACKETED SPLICE LENGTHS NOT RECOMMENDED. USE MECHANICAL CONNECTORS OR A FULL HEIGHT REINFORCEMENT BAR.

REVISIONS AND RECORD OF ISSUE
DESIGNED: SKA
DETAILED: UBS
CHECKED: CG
APPROVED: TNG
DATE: 12/20/2022
PROJECT NO.: 411752


DETAILS

STRUCTURAL

TYPICAL CONCRETE
 MASONRY REINFORCING
 DETAILS

JAMB SCHEDULE							
BUILDING	WALL	BLOCK THICKNESS	OPENING SIZE	JAMBS			REMARKS
				NUMBER OF REINFORCED CELLS	BARS PER REINFORCED CELL	BAR SIZE	
AGS REACTORS AND PIPE GALLERY (STAIR TOWER)	NORTH	8"	<=4'-0"	2	1 (CENTERED)	#4	
	EAST	8"	<=4'-0"	2	1 (CENTERED)	#4	
	WEST	8"	<=4'-0"	2	1 (CENTERED)	#4	
AGS SUPPORT FACILITY	NORTH	12"	<=4'-0"	1	2 (ONE EACH FACE)	#5	
			<=4'-0"	1	2 (ONE EACH FACE)	#5	
	EAST	12"	4'-0" TO 6'-6"	1	2 (ONE EACH FACE)	#5	
			6'-6" TO 14'-0"	2	2 (ONE EACH FACE)	#5	
	WEST	12"	<=4'-0"	1	2 (ONE EACH FACE)	#5	
	INTERIOR	8"	<=4'-0"	2	1 (CENTERED)	#5	

- NOTES:
- AN INTERIOR WALL IS A WALL IN WHICH NO PORTION OF THE WALL IS EXPOSED TO THE EXTERIOR.
 - REINFORCE JAMBS AS INDICATED UNLESS NOTED OTHERWISE ON THE DRAWINGS.

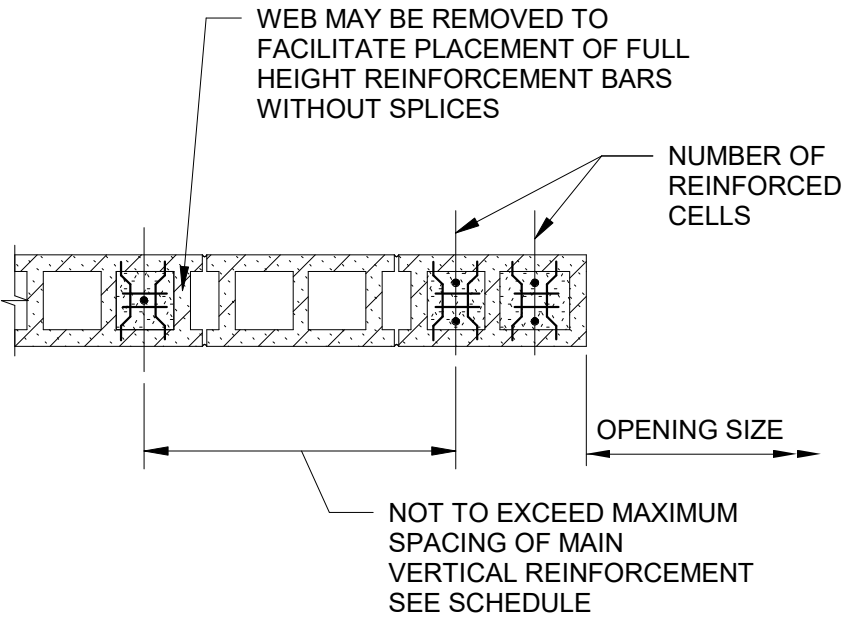


JAMB - PLAN

A TYPICAL MASONRY JAMB SCHEDULE AND PLAN
NO SCALE

LINTEL SCHEDULE							
BUILDING	WALL	BLOCK THICKNESS	OPENING SIZE	LINTELS			REMARKS
				DEPTH	BOTTOM REINFORCEMENT	TOP REINFORCEMENT	
AGS REACTORS AND PIPE GALLERY (STAIR TOWER)	NORTH	8"	<=4'-0"	16"	1-#4	1-#4	
	EAST	8"	<=4'-0"	16"	1-#4	1-#4	
	WEST	8"	<=4'-0"	16"	1-#4	1-#4	
AGS SUPPORT FACILITY	NORTH	12"	<=4'-0"	16"	2-#5	2-#5	
	EAST	12"	<=4'-0"	24"	2-#5	2-#5	
			4'-0" TO 6'-6"	32"	2-#5	2-#5	
			6'-6" TO 14'-0"	48"	2-#6	2-#6	
	WEST	12"	<=4'-0"	24"	2-#5	2-#5	
INTERIOR	8"	<=4'-0"	16"	1-#5	1-#5		


- NOTES:
- BEAR ALL LINTELS A MINIMUM 2'-0" AT EACH END.
 - REINFORCED LINTELS AS INDICATED UNLESS NOTED OTHERWISE ON THE DRAWINGS.

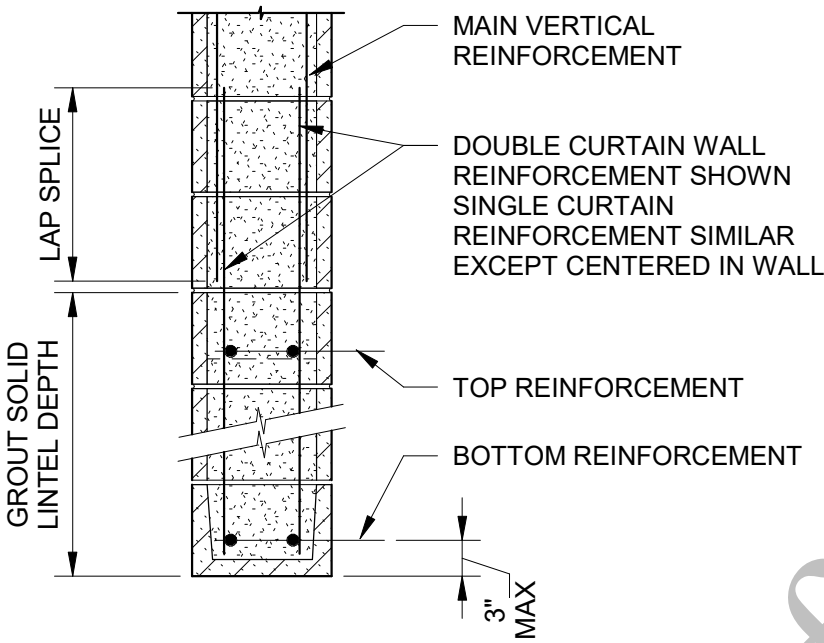


LINTEL - SECTION

B TYPICAL MASONRY LINTEL SCHEDULE AND SECTION
NO SCALE

C TYPICAL MASONRY ANCHOR BOLT DETAIL
3/4" = 1'-0"

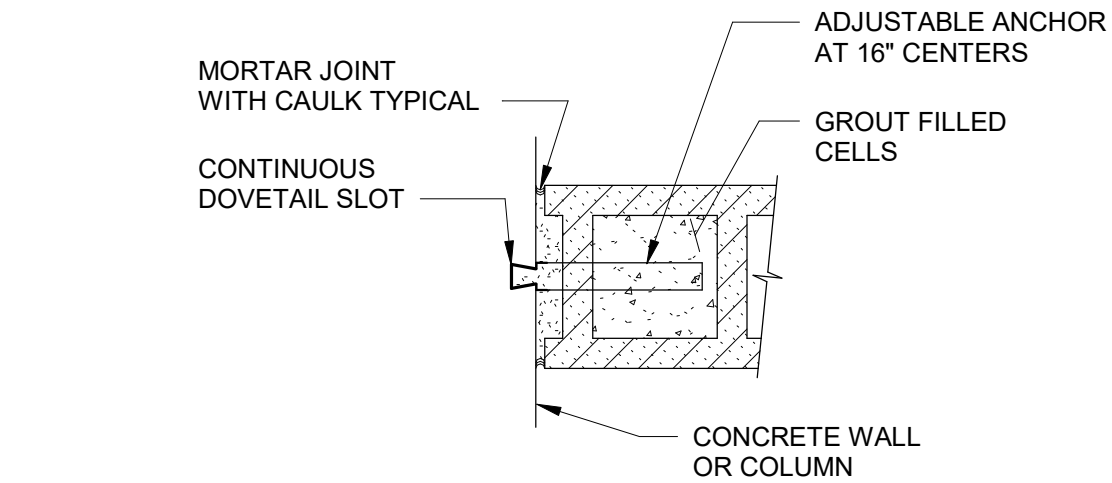

E TYPICAL MASONRY WALL AT CONCRETE WALL OR COLUMN
1 1/2" = 1'-0"

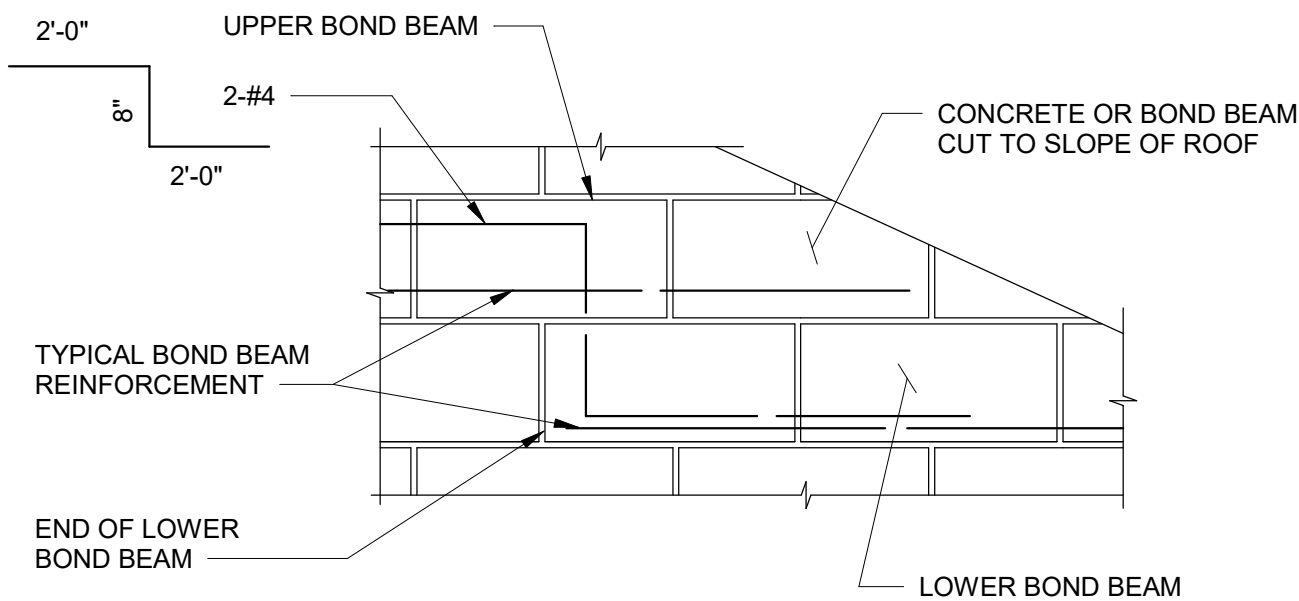

F BOND BEAM STEP DETAIL
1" = 1'-0"

GENERAL SHEET NOTES:

- THE DETAILS ON THIS SHEET ARE APPLICABLE TO ALL CONCRETE MASONRY CONSTRUCTION. SPECIAL NOTES, SECTIONS AND DETAILS SPECIFICALLY NOTED ON THE DESIGN DRAWINGS SHALL BE APPLICABLE IN LIEU OF THESE TYPICAL DETAILS.
- FOR MISCELLANEOUS APPURTENANCES INCLUDING EMBEDMENTS, BRACING, STEEL OR PRECAST LINTELS, VENEER, FLASHING, WEEPS, INSULATION, SEALING, CAULKING AND EMBEDDED PIPE AND ELECTRICAL CONDUIT, SEE THE DESIGN DRAWINGS.
- WORK THIS DRAWING WITH THE STANDARD CONCRETE MASONRY WALL REINFORCEMENT DETAILS.



Black & Veatch Corporation
Chicago, Illinois
ILLINOIS PROFESSIONAL
DESIGN FIRM - 184.002143-0006



AEROBIC GRANULAR
SLUDGE - PHASE 1

REVISIONS AND RECORD OF ISSUE

DESIGNED:	SKA
DETAILED:	UBS
CHECKED:	CG
APPROVED:	TNG
DATE:	12/20/2022
PROJECT NO.:	411752


DETAILS

STRUCTURAL

TYPICAL CONCRETE
MASONRY LINTEL AND
JAMB DETAILS

99-S-504

134
OF
163

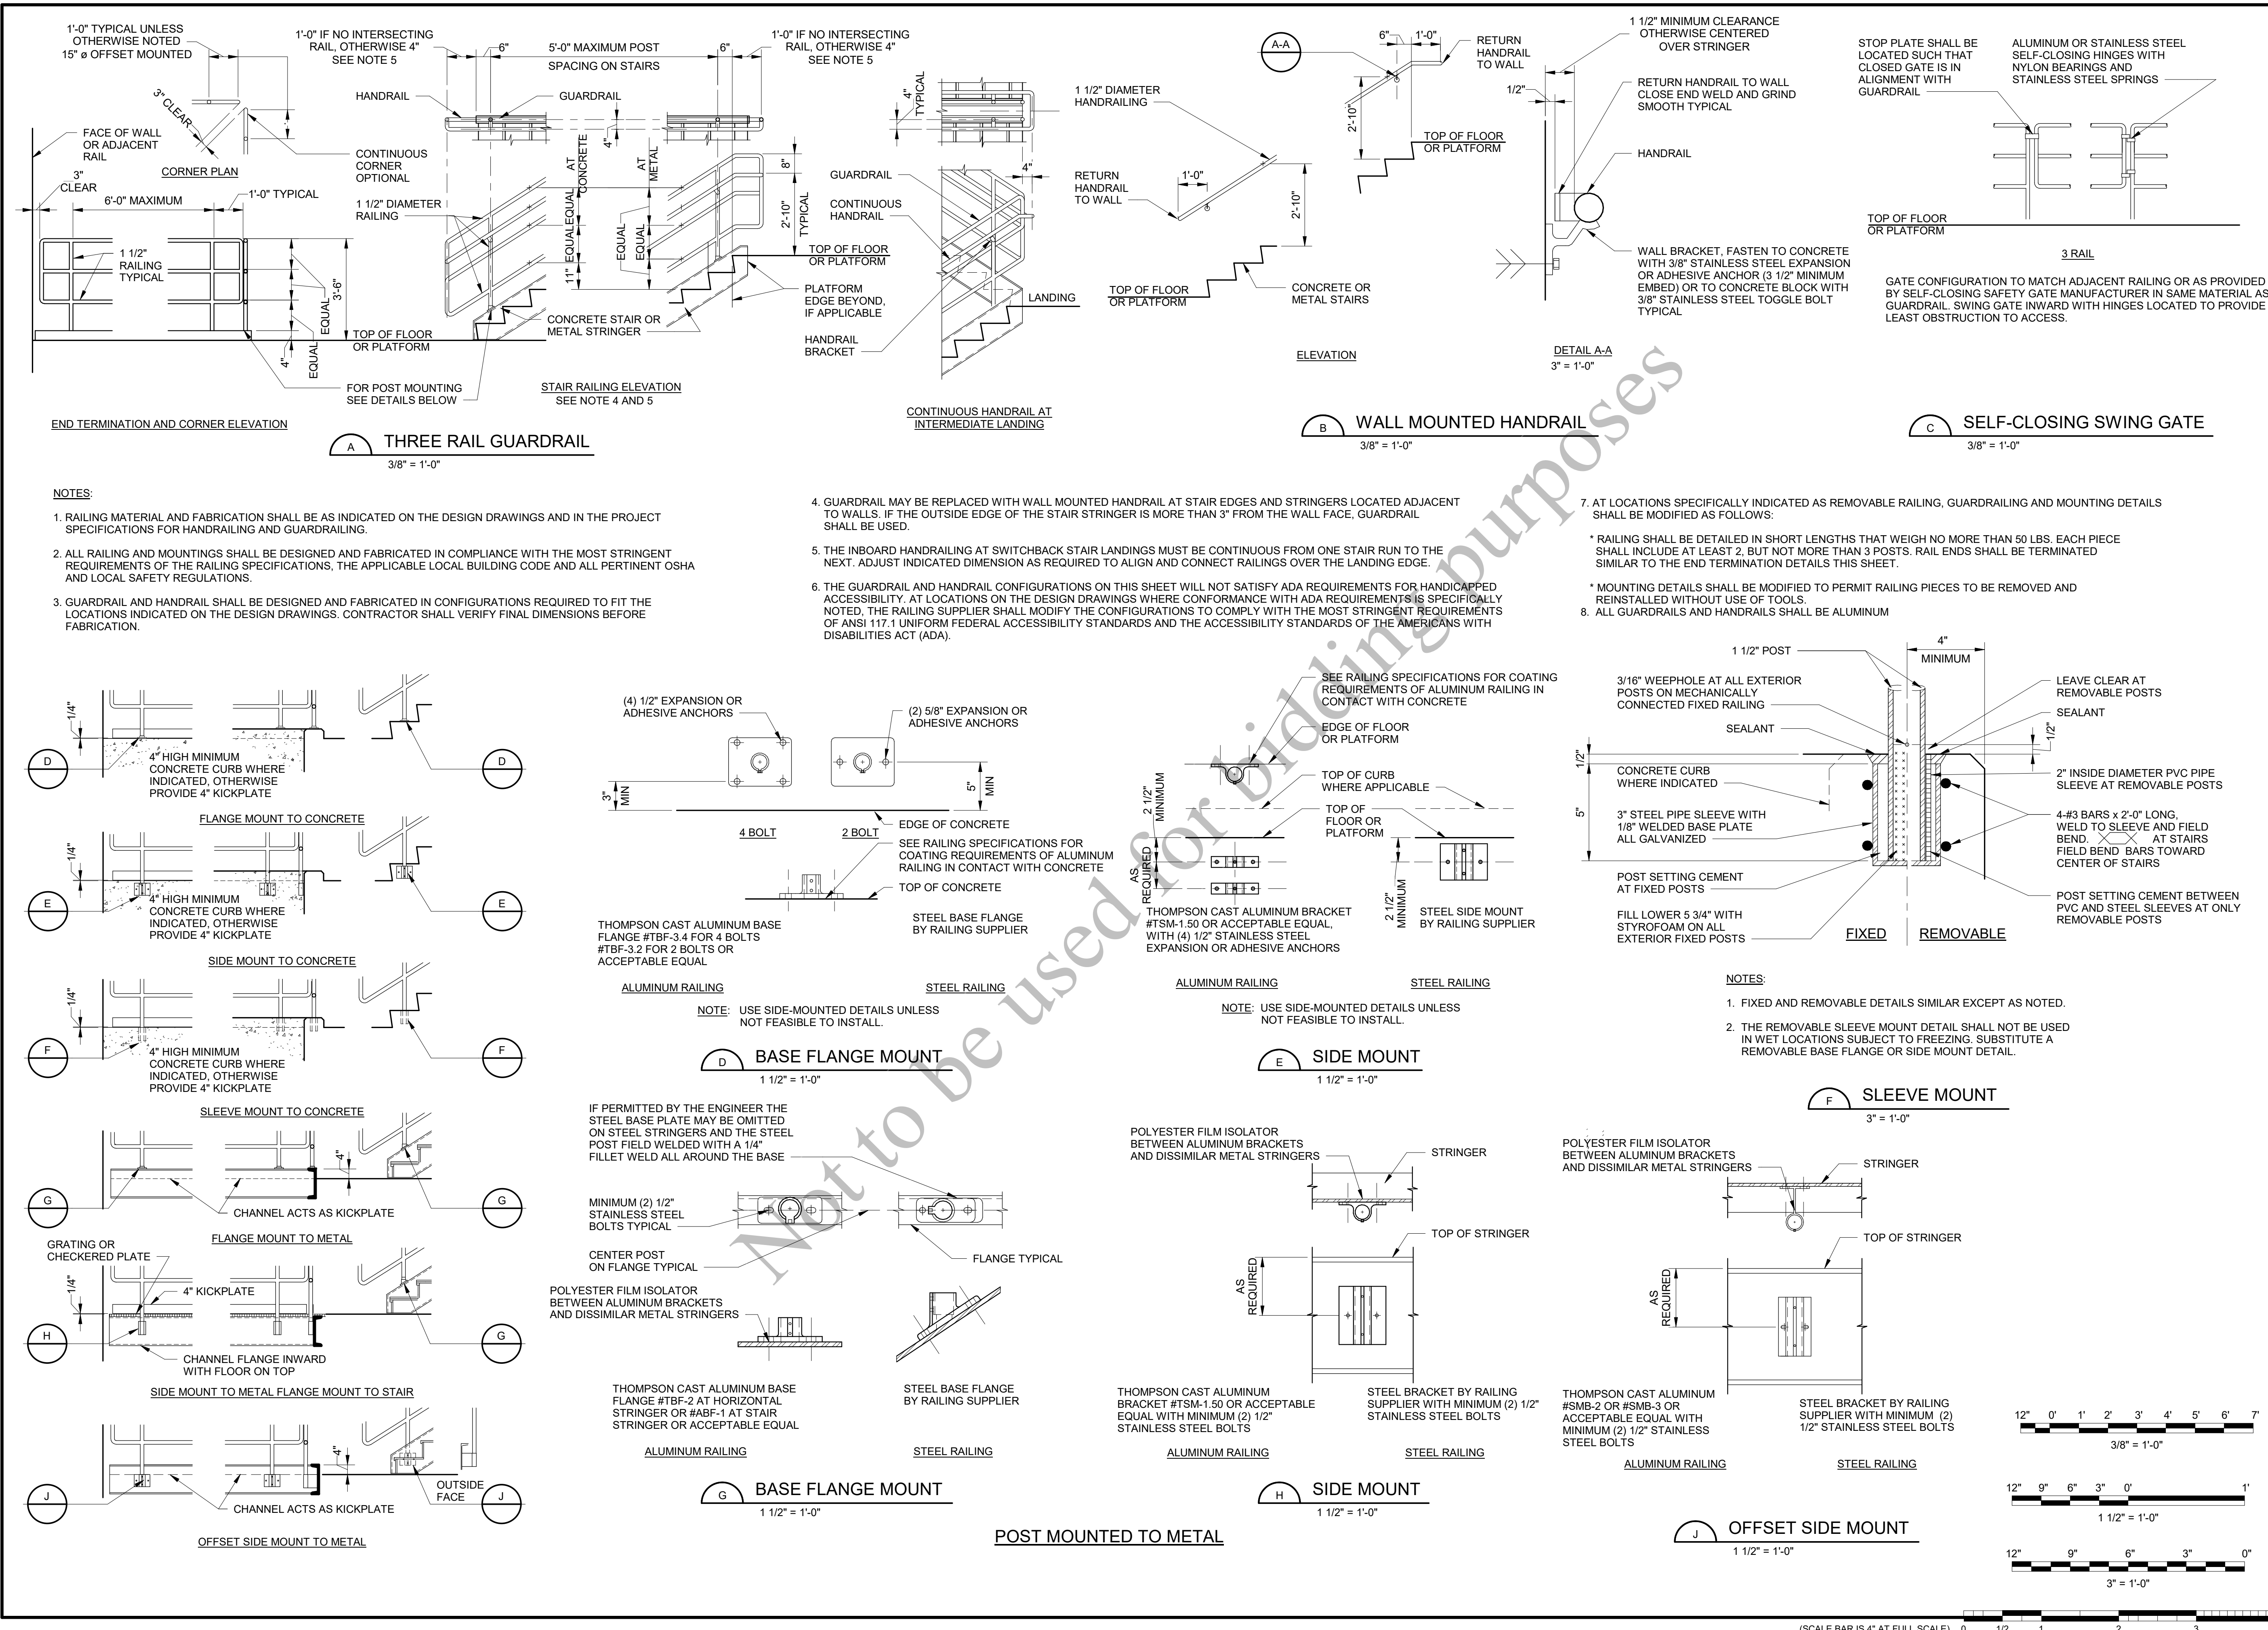

Black & Veatch Corporation
 Chicago, Illinois
 ILLINOIS PROFESSIONAL
 DESIGN FIRM - 184.002143-0006

Four Rivers
 Sanitation Authority

REVISIONS AND RECORD OF ISSUE	
DESIGNED:	SKA
DETAILED:	UBS
CHECKED:	CG
APPROVED:	TNG
DATE:	12/20/2022
PROJECT NO.:	411752


DETAILS

STRUCTURAL


STANDARD 3-RAIL GUARDRAIL AND HANDRAIL DETAILS

99-S-505


135 OF 163

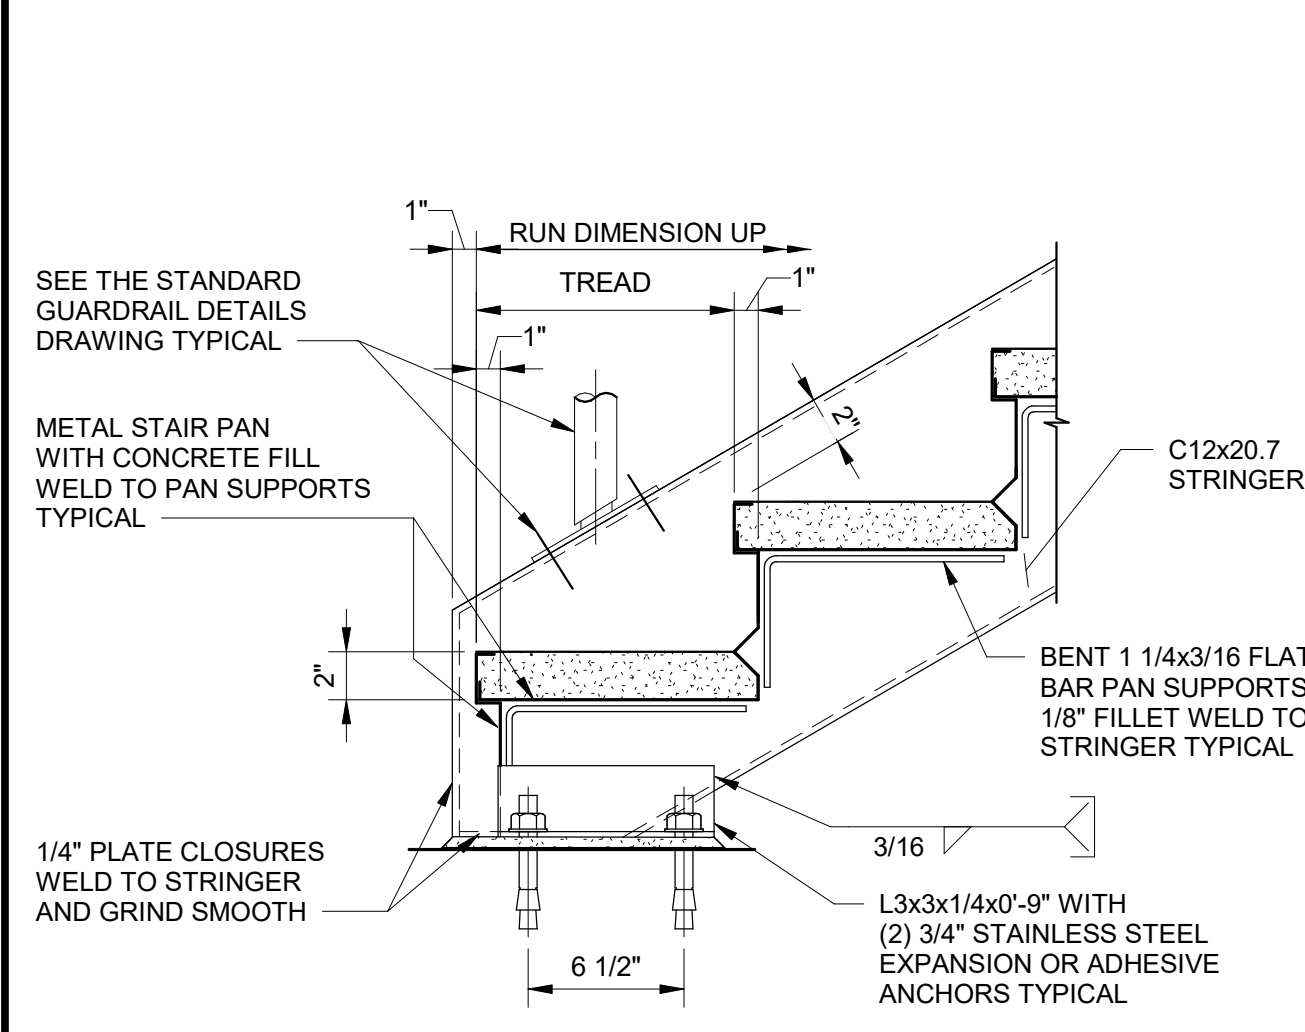


DETAIL A
1 1/2" = 1'-0"

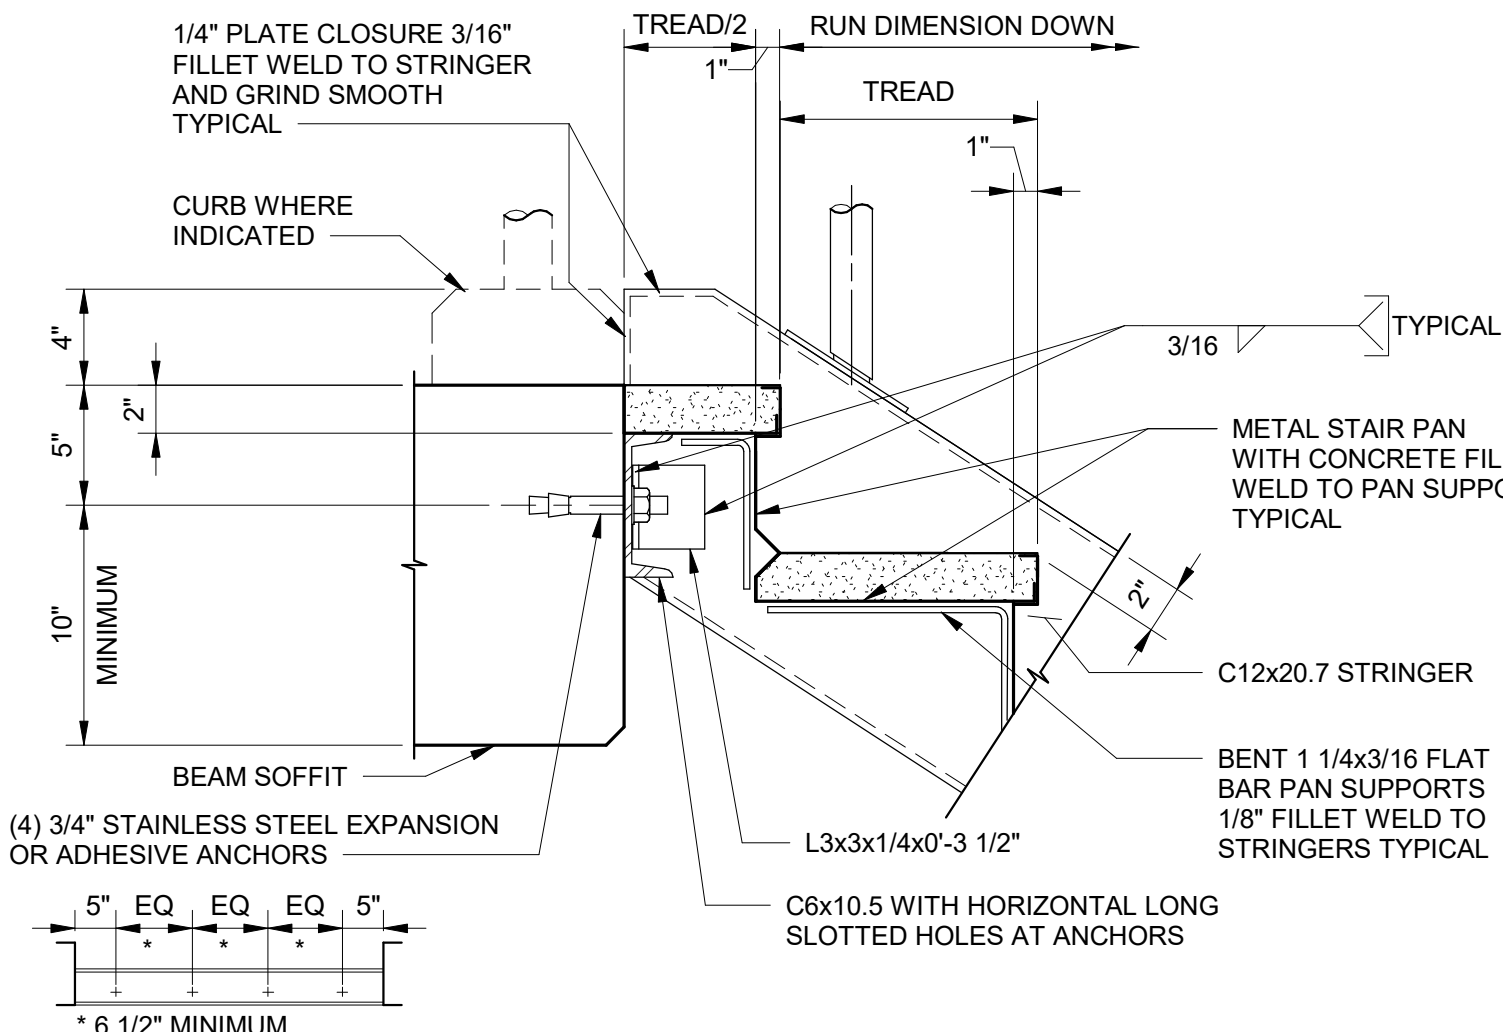


DETAIL B
1 1/2" = 1'-0"

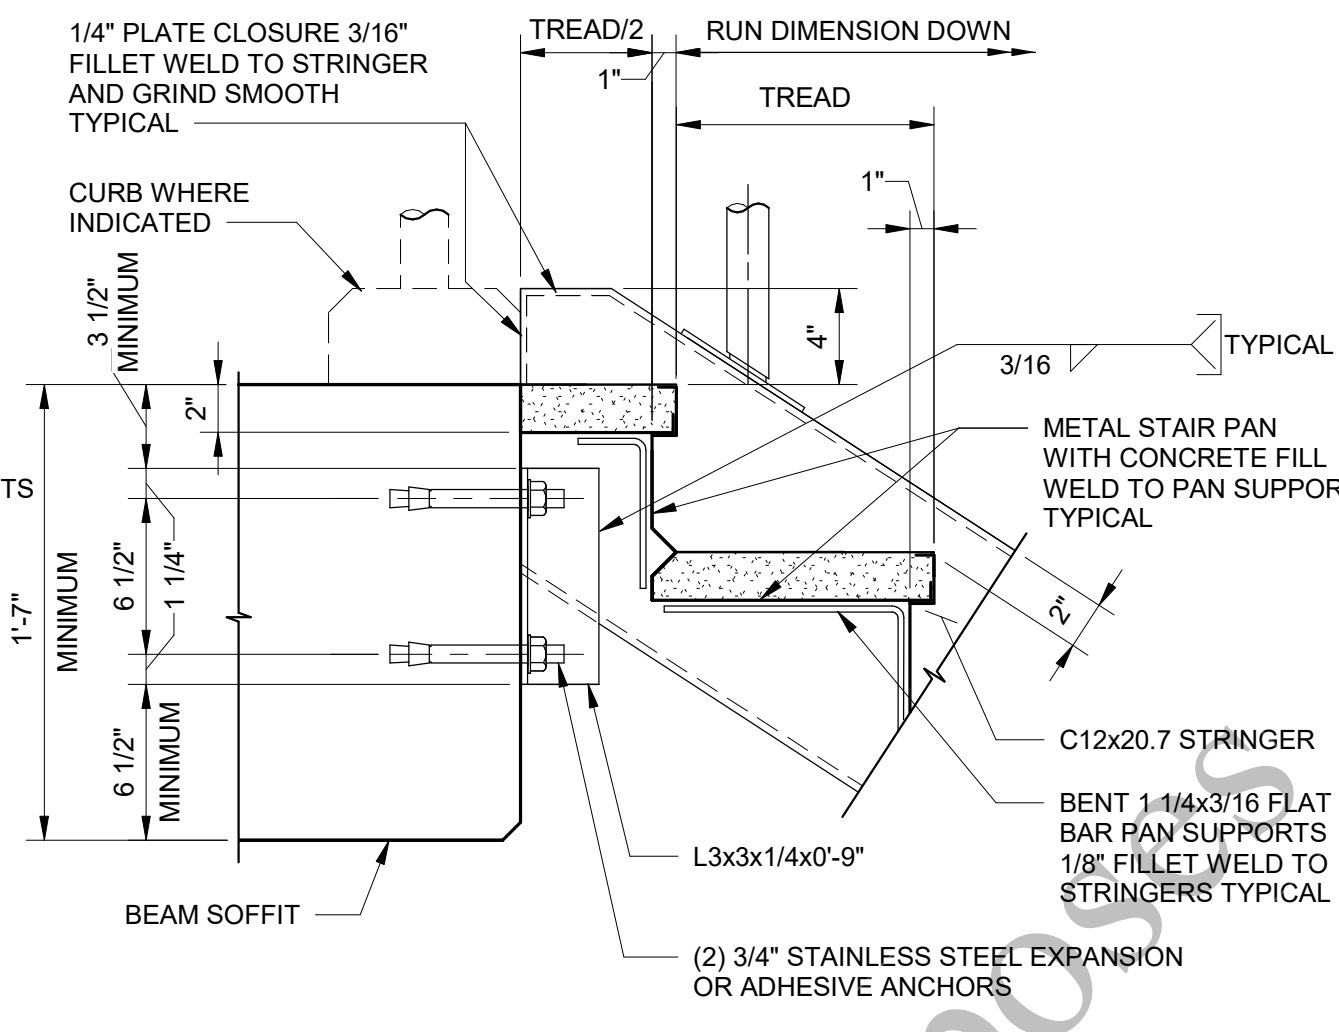


ALTERNATE DETAIL BB
1 1/2" = 1'-0"

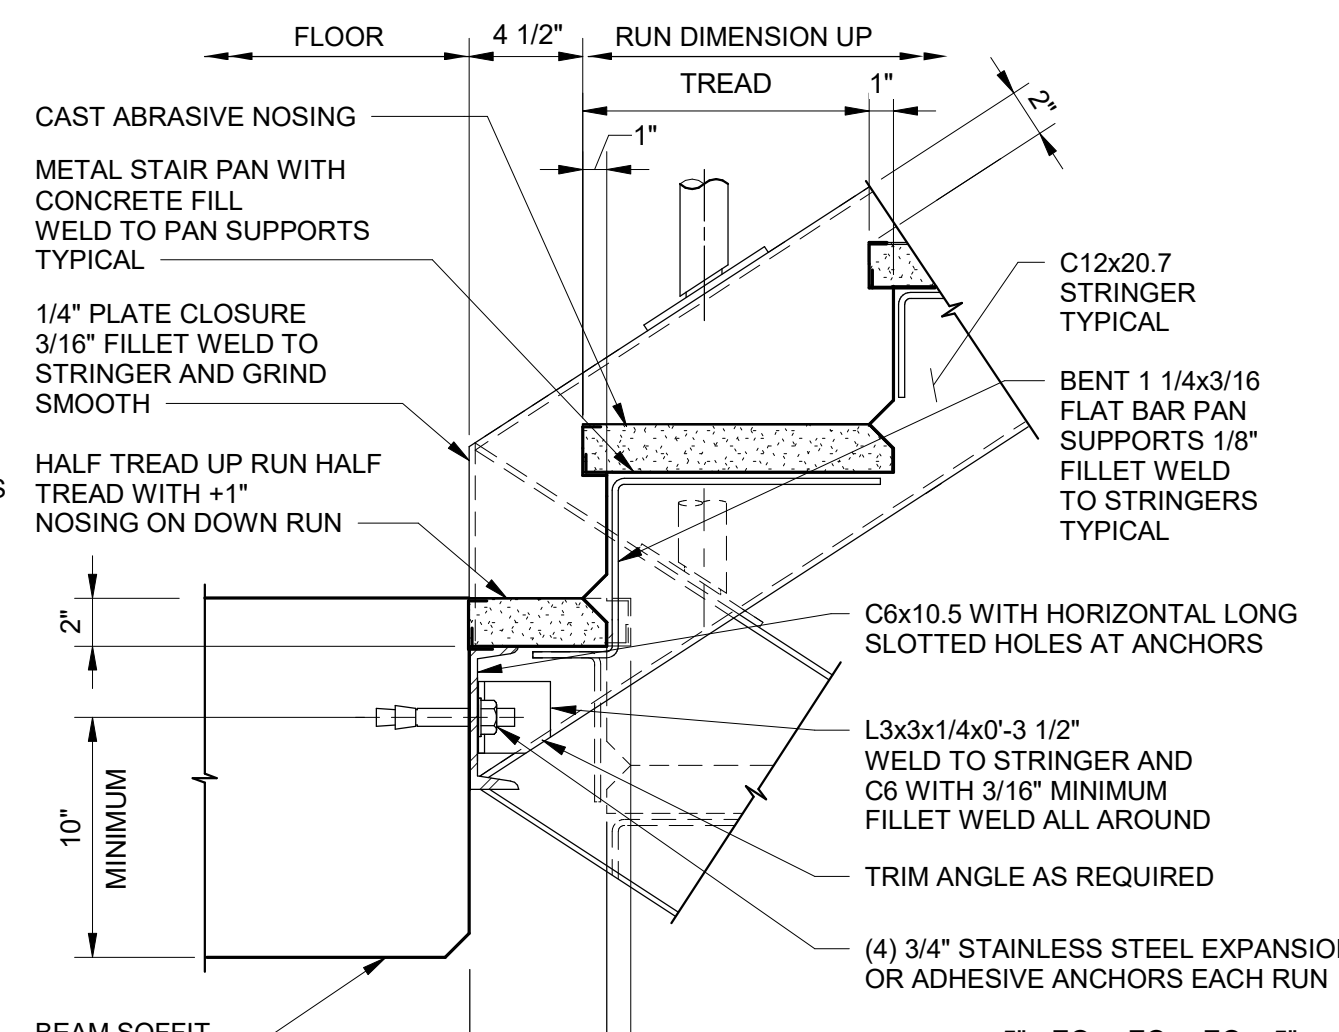


DETAIL C
1 1/2" = 1'-0"

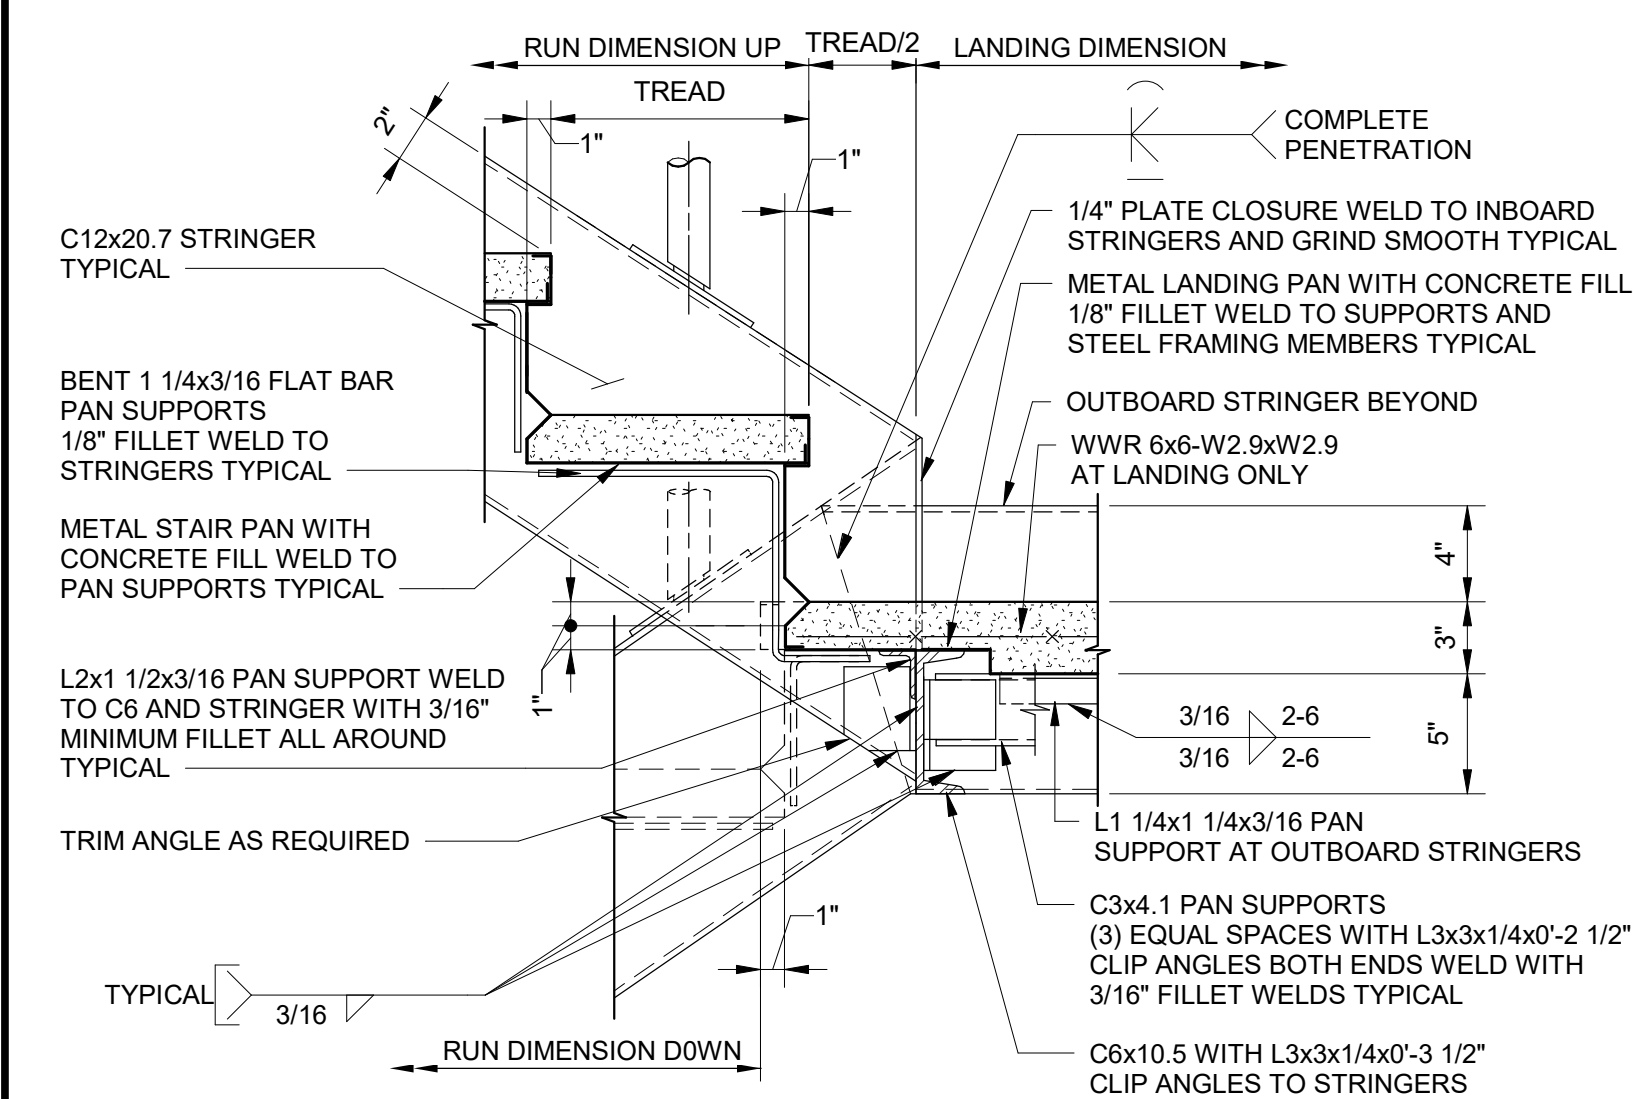


DETAIL D
1 1/2" = 1'-0"

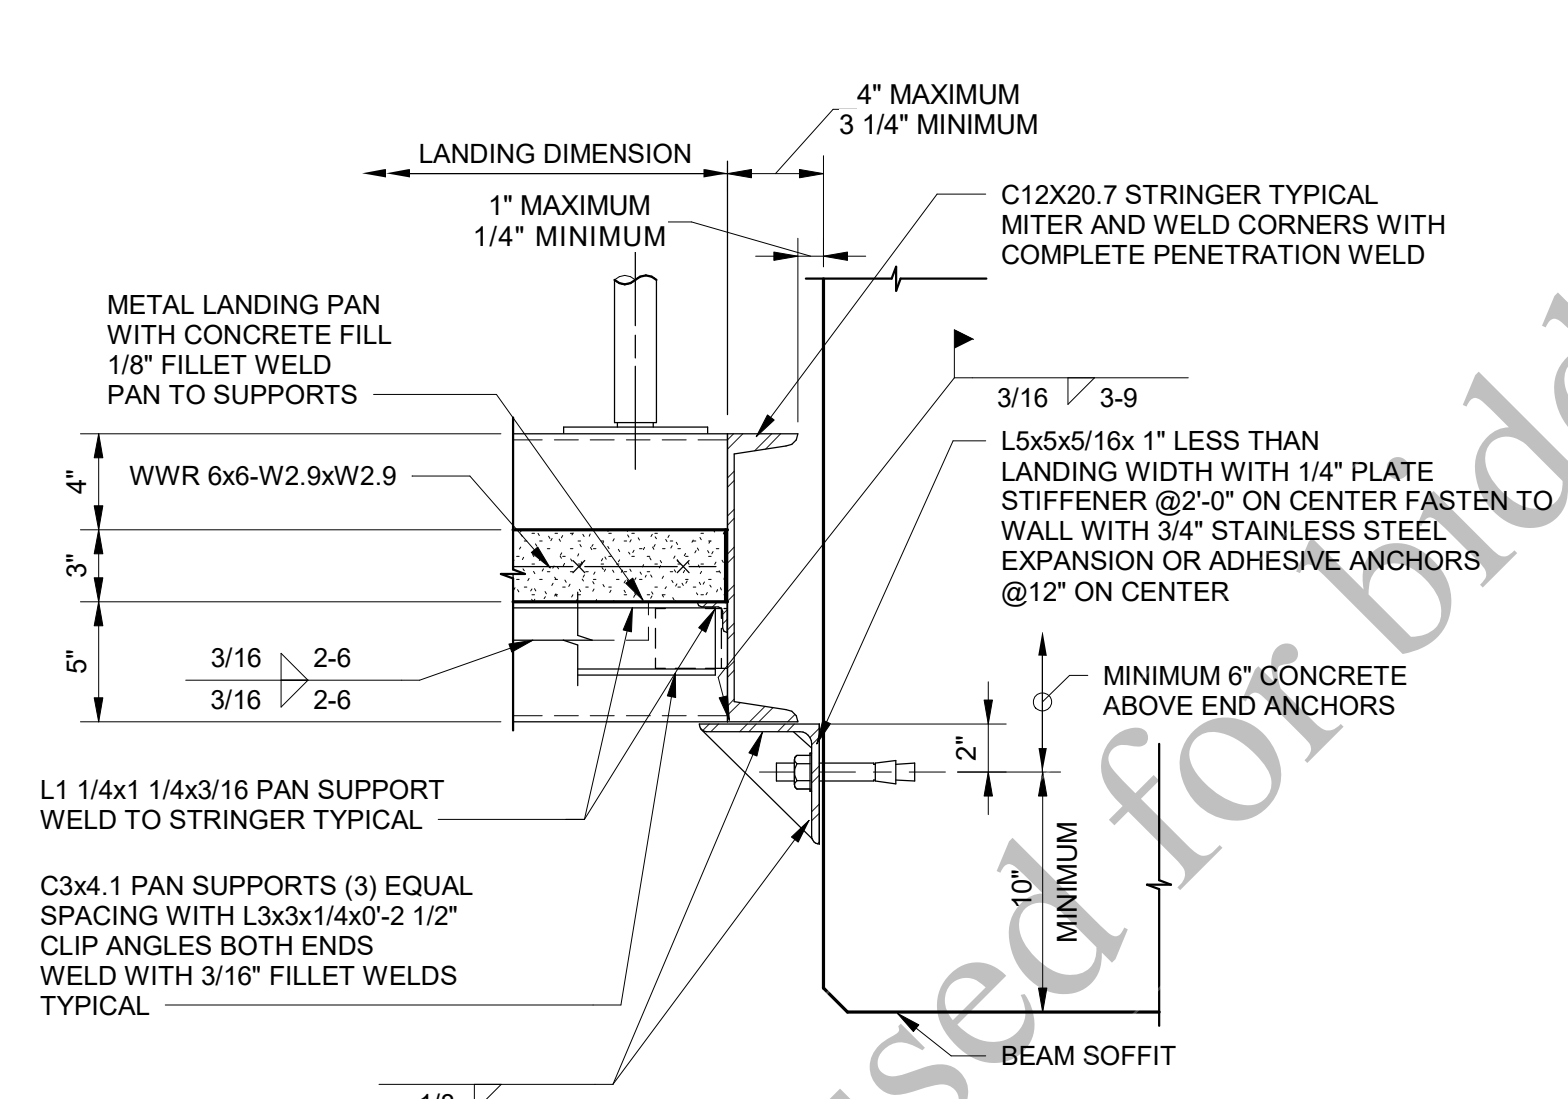


DETAIL E
1 1/2" = 1'-0"

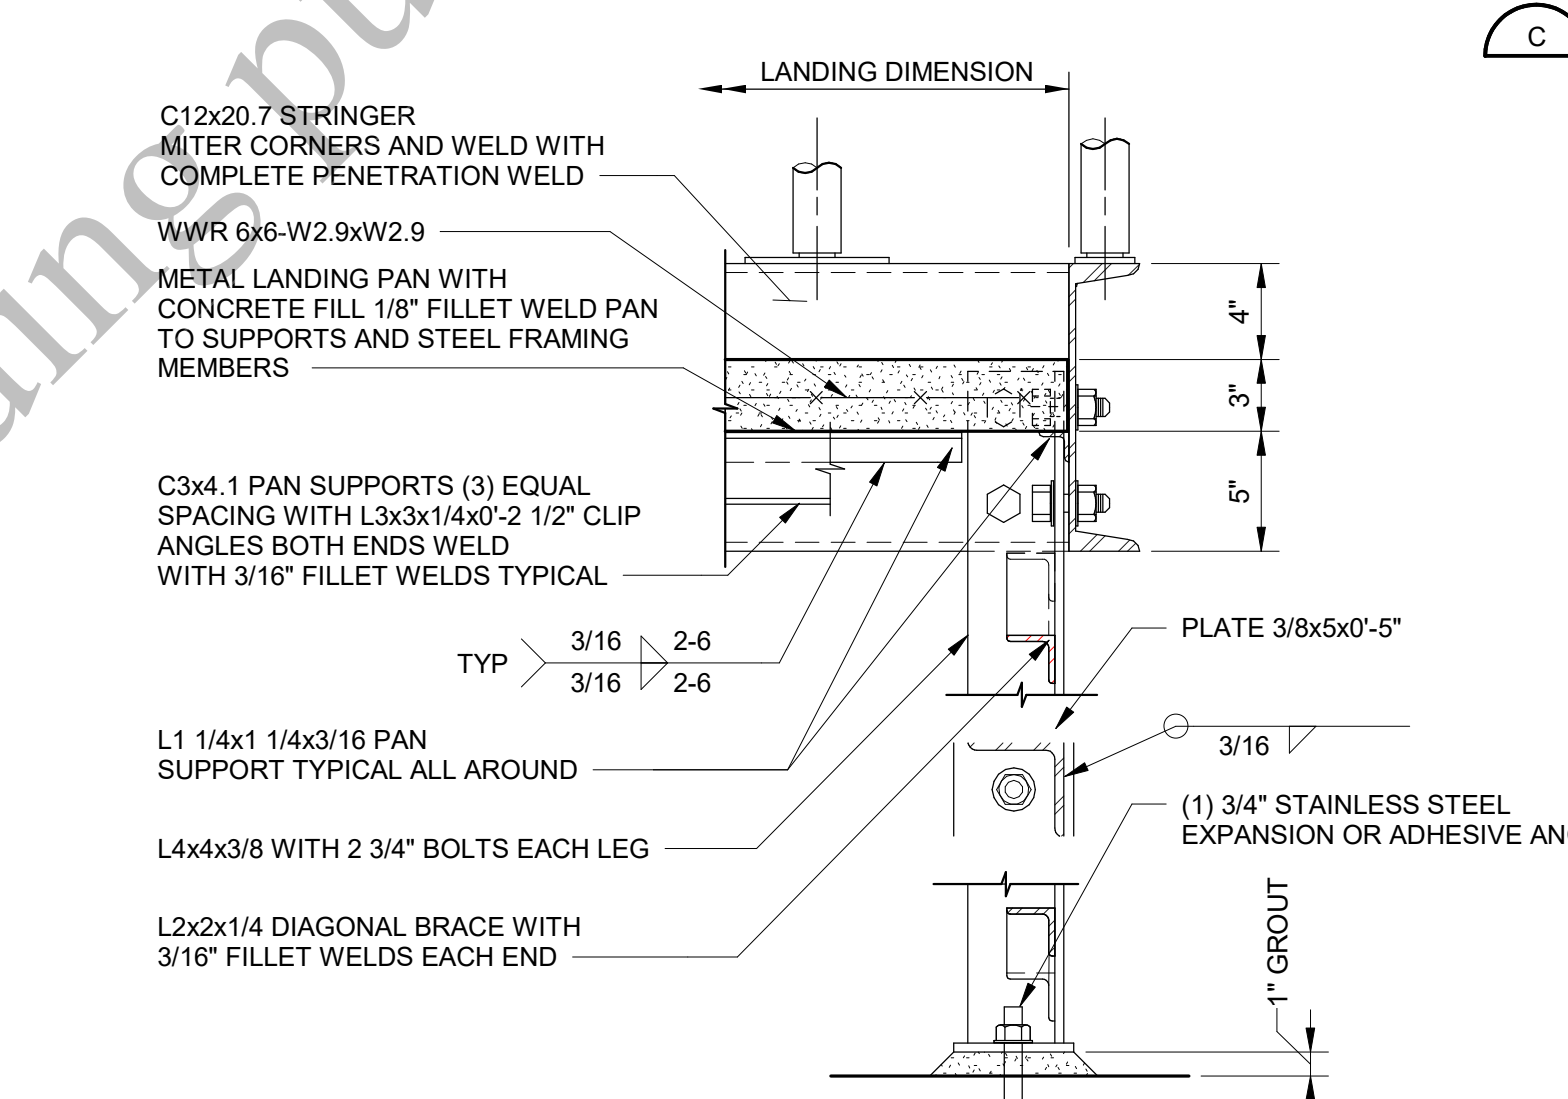

DETAIL F
1 1/2" = 1'-0"

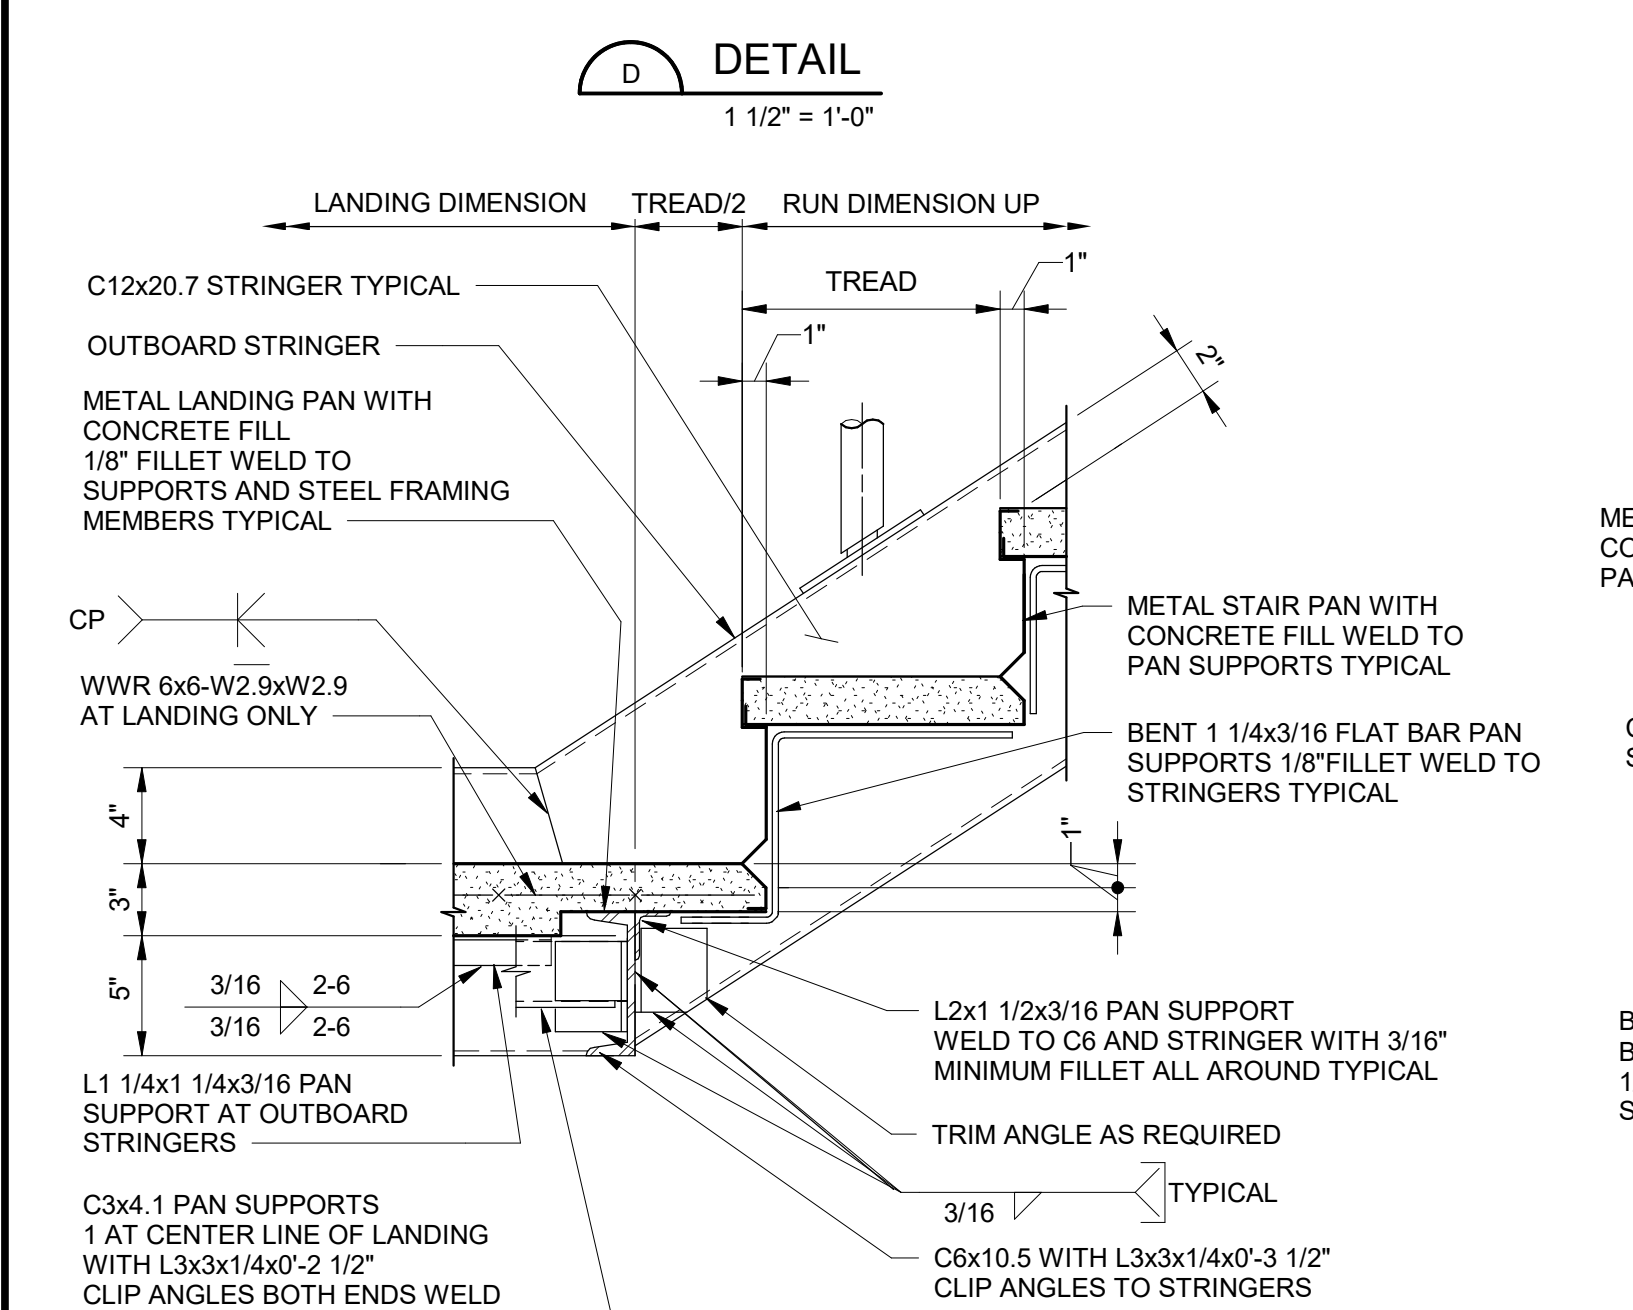


DETAIL G
1 1/2" = 1'-0"

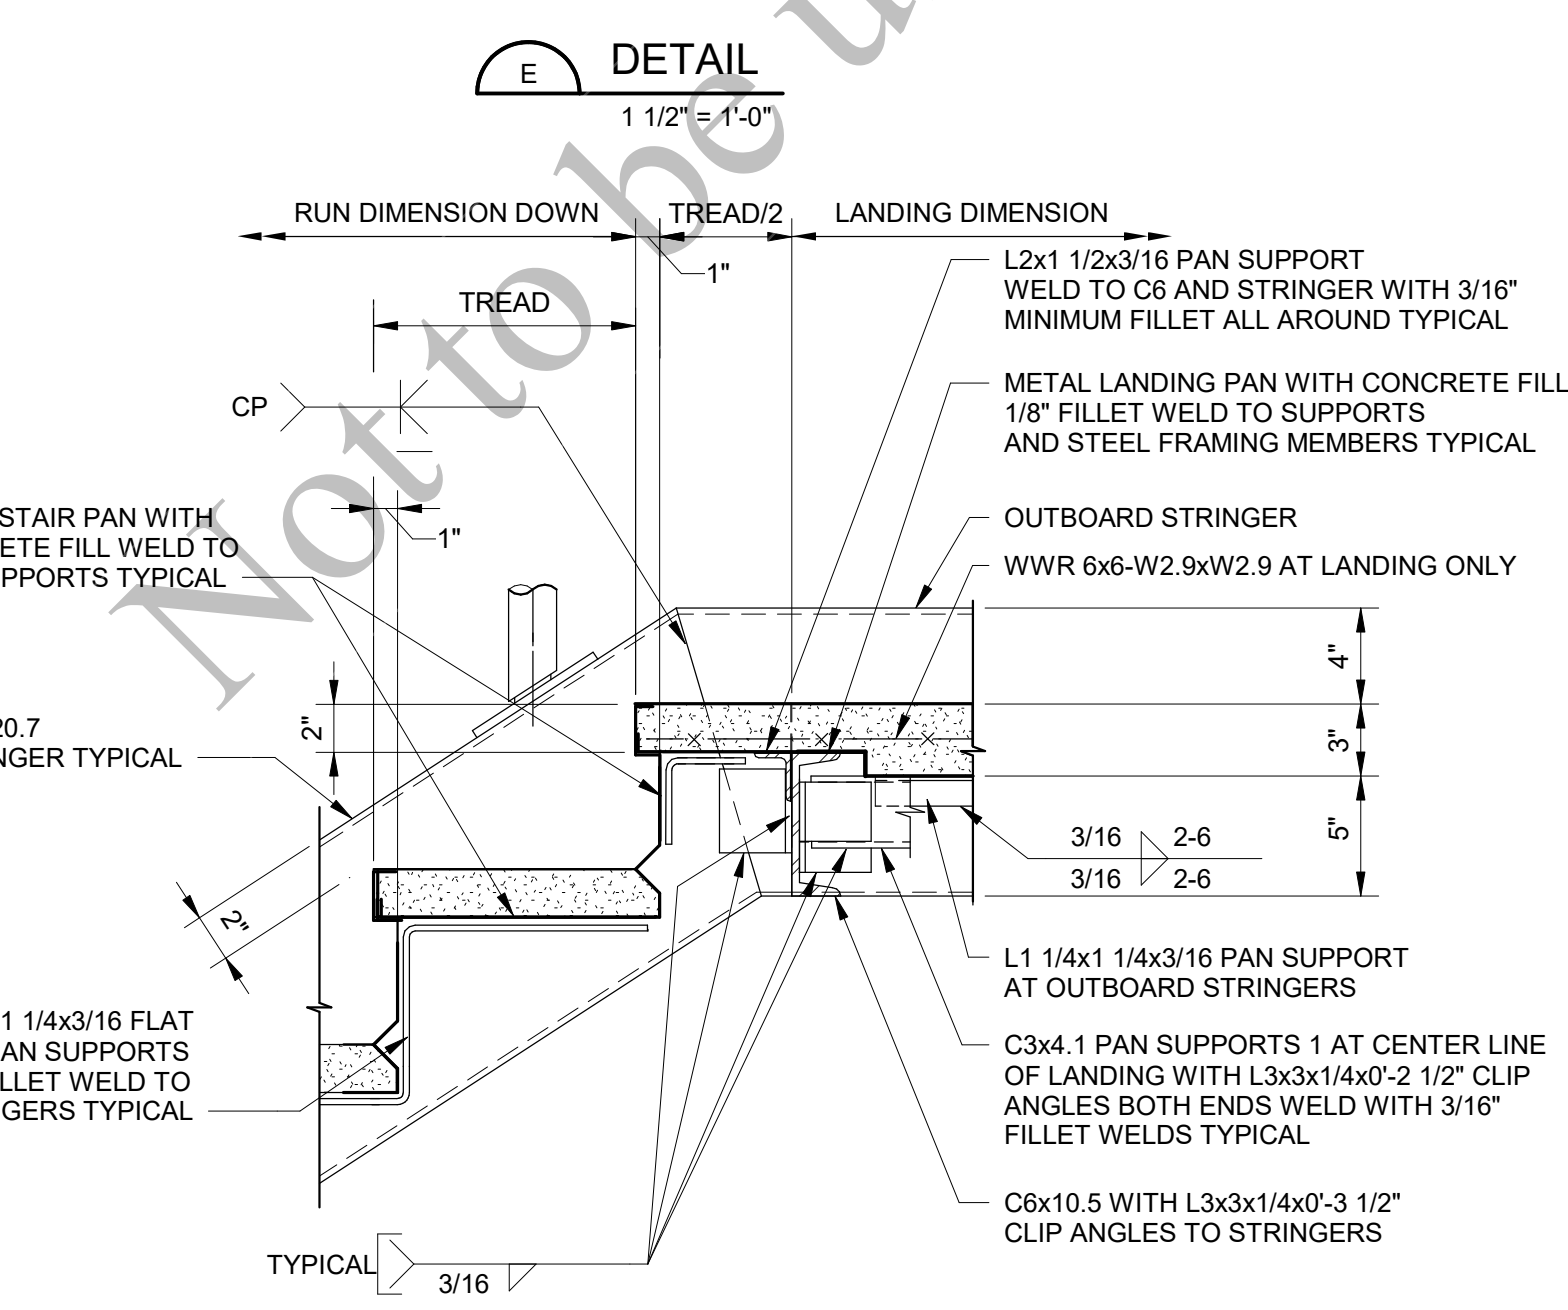

DETAIL H
1 1/2" = 1'-0"



STAIR DESIGN NOTES:

1. STAIRS SHALL BE DESIGNED BY THE SUPPLIER IN GENERAL ACCORDANCE WITH DETAILS INDICATED ON THESE DESIGN DRAWINGS. THE DESIGN SHALL COMPLY WITH ALL APPLICABLE PROVISIONS OF THE LOCAL BUILDING CODE, ANSI A117.1 AND OSHA.
2. THE DESIGN SHALL BE SEALED BY AN ENGINEER REGISTERED IN THE STATE OF THE PROJECT. IF REQUESTED, CALCULATIONS SHALL BE SUBMITTED FOR REVIEW.
3. THE COMPLETED FABRICATIONS SHALL SUPPORT THE LOADS AND DEFLECTION CRITERIA INDICATED IN THE STRUCTURAL METALS SPECIFICATION.
4. THE STAIR DESIGN AND DETAILS SHALL BE COORDINATED WITH THE HANDRAILING AND GUARDRAILING SUPPLIED. STAIR MEMBERS SHALL BE ADEQUATE TO ACCEPT LOADS FROM THE RAIL POSTS BASED UPON THE CRITERIA INDICATED IN THE RAILING SPECIFICATIONS.
5. CONNECTIONS TO THE SUPPORTING STRUCTURE SHALL BE ADEQUATE TO TRANSFER ALL LOADINGS, AND SHALL BE DESIGNED IN ACCORDANCE WITH ALL APPLICABLE PROVISIONS OF THE AISC MANUAL AND ACI 318. THE NUMBER AND TYPE OF CONNECTIONS SHALL COMPLY AT A MINIMUM, WITH THESE DESIGN DRAWINGS. ALL NECESSARY BRACKETS, BOLTS, AND ANCHORS SHALL BE PROVIDED.

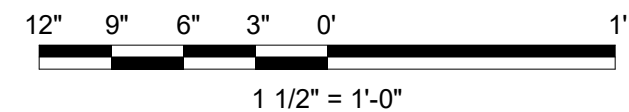




PLOTTED: 12/19/2022 4:26:24 PM
FILE: BIM 360/1409469- Aerobic Granular Sludge Phase 1409469 - AGS.rvt
D11000

05-S400_USA

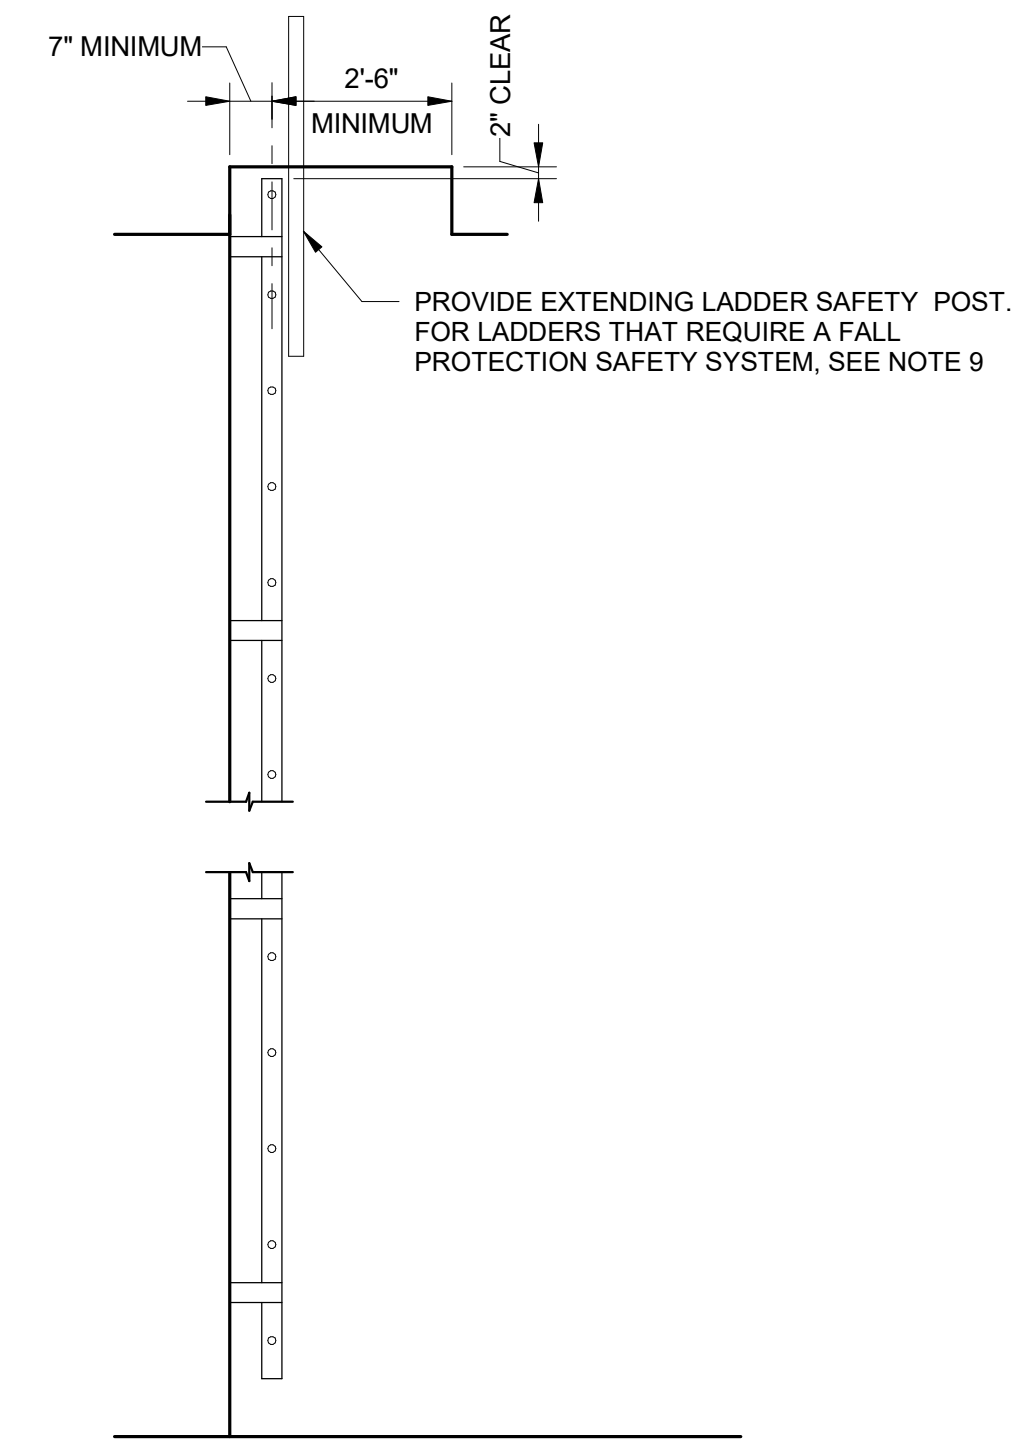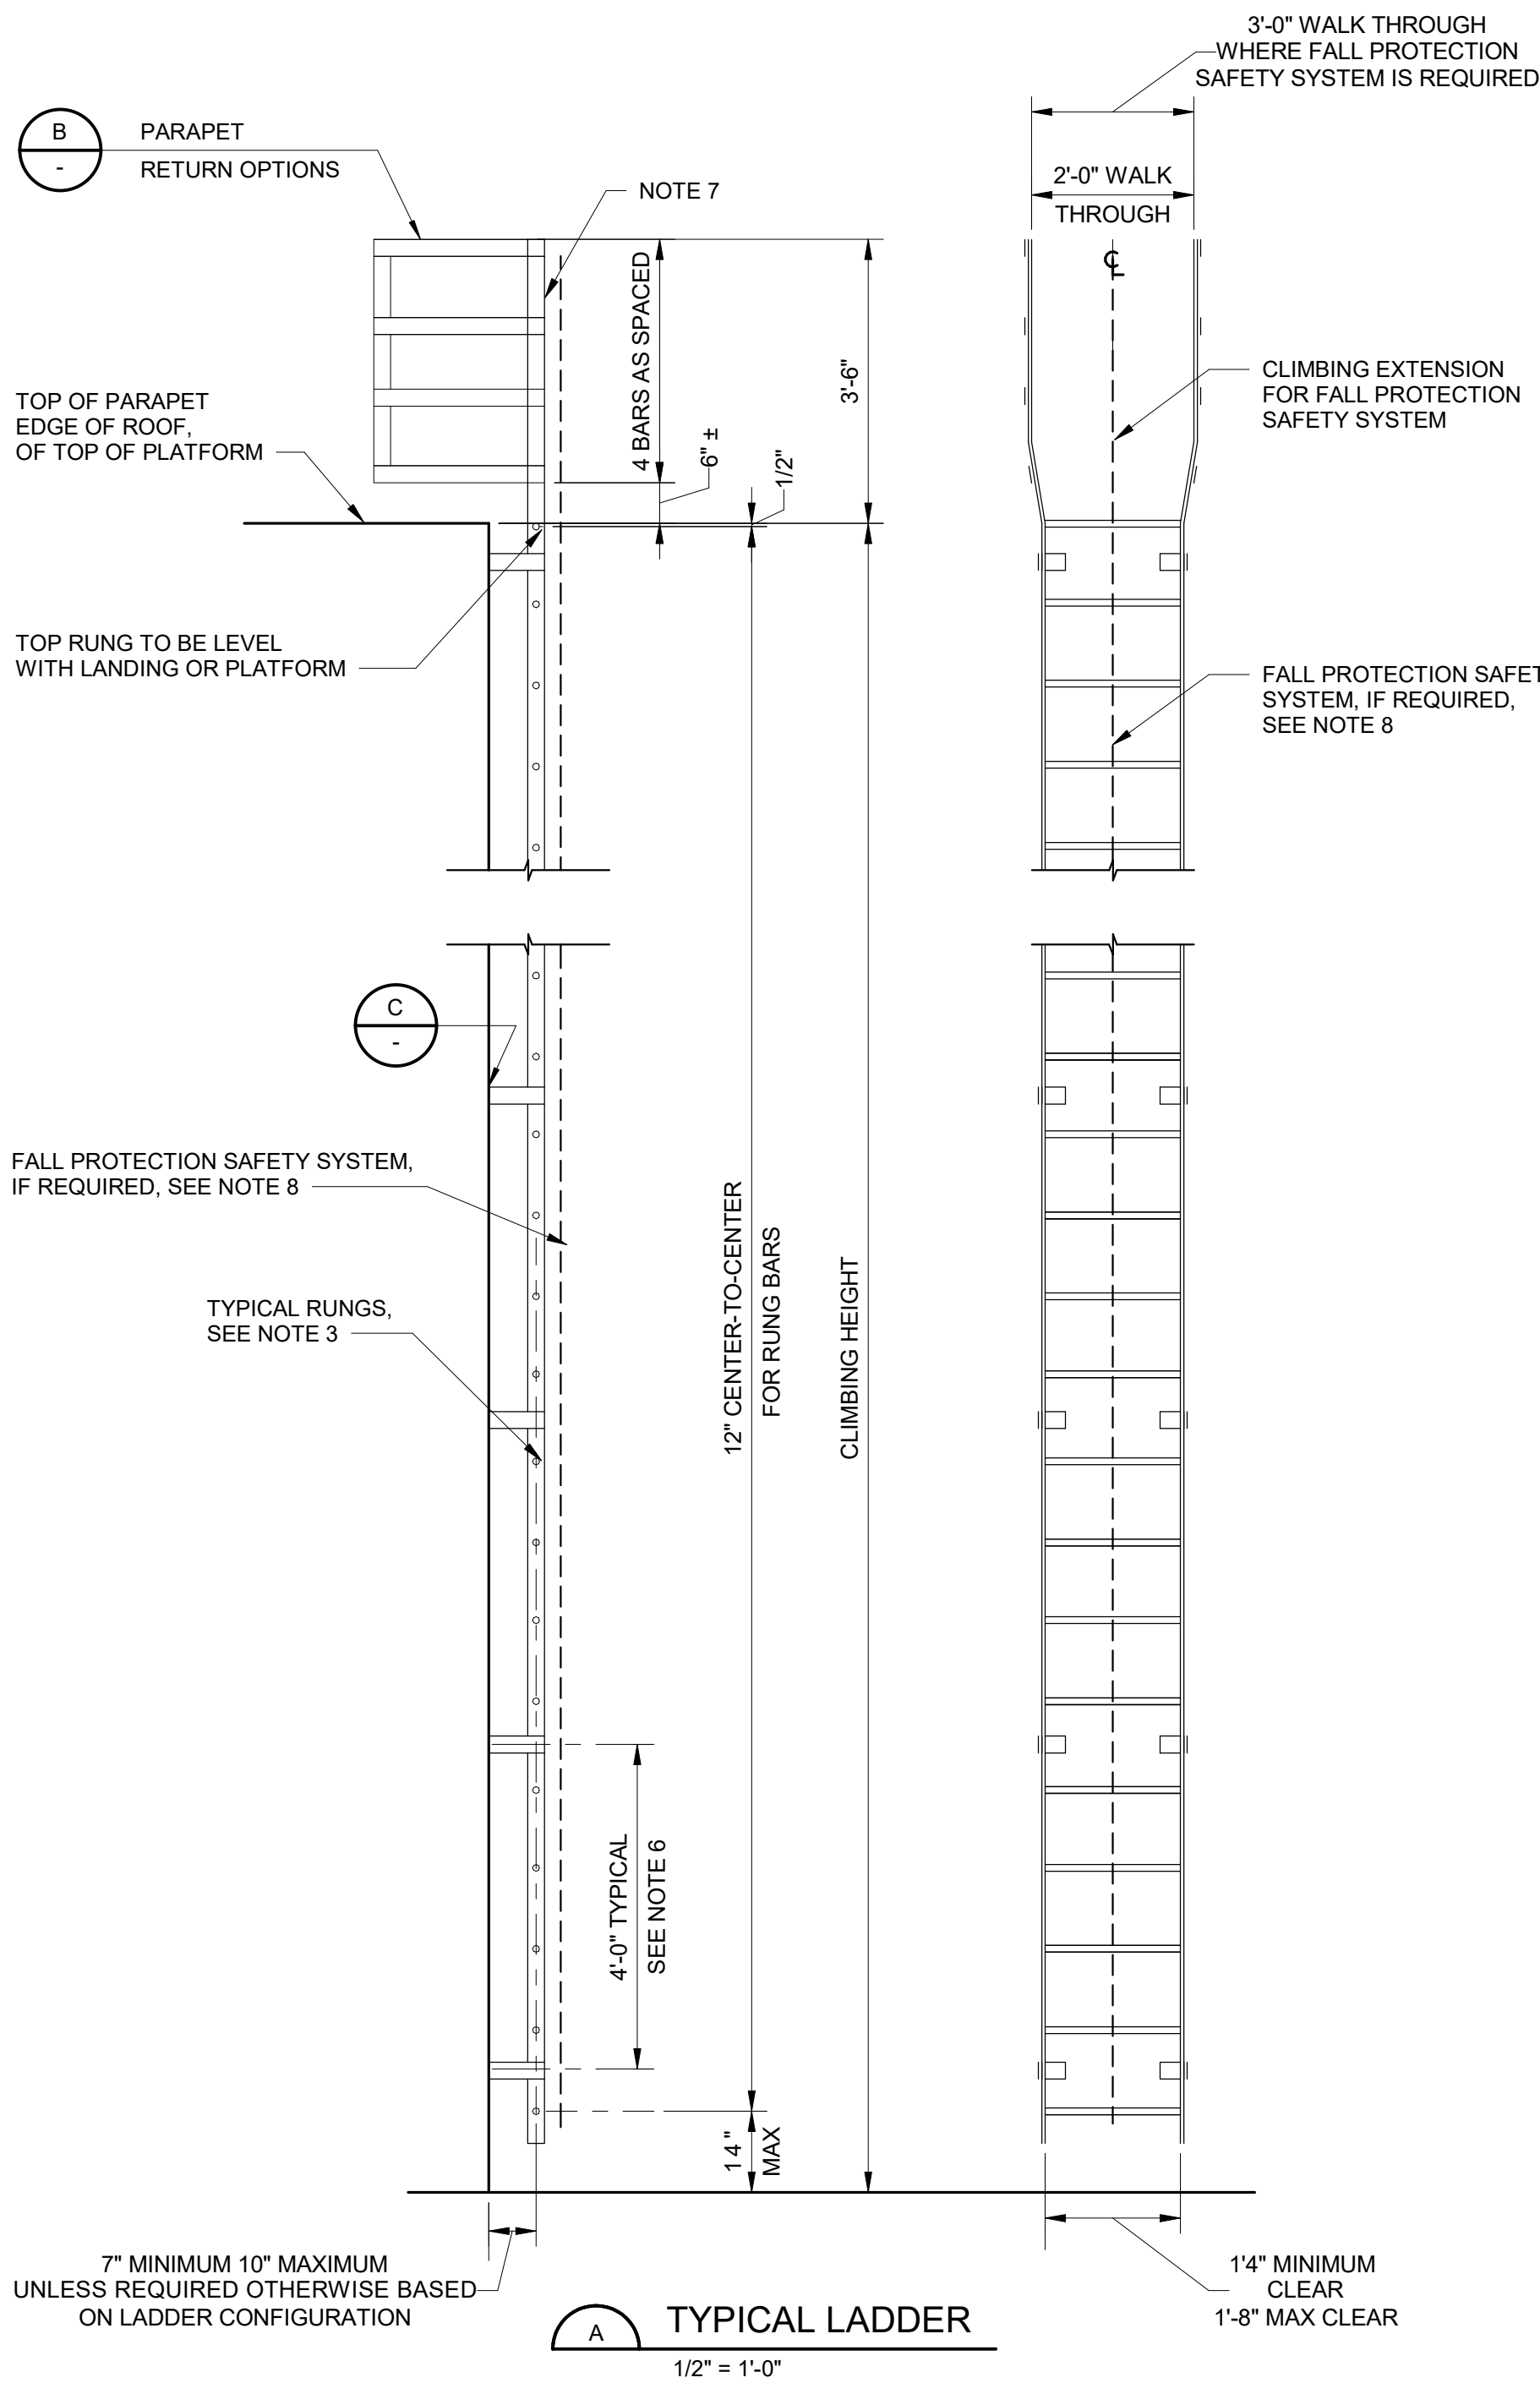

UNDER HATCH


3/8" = 1'-0"

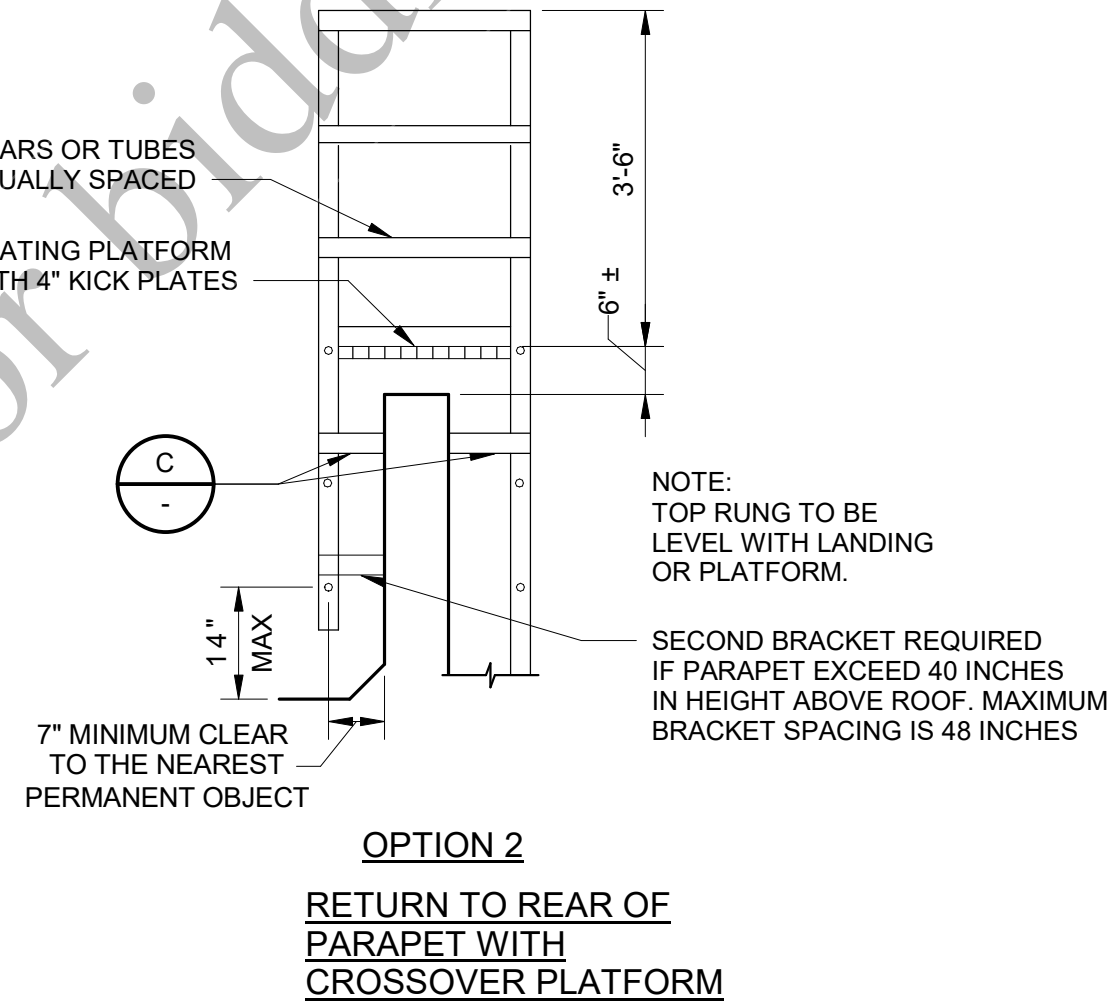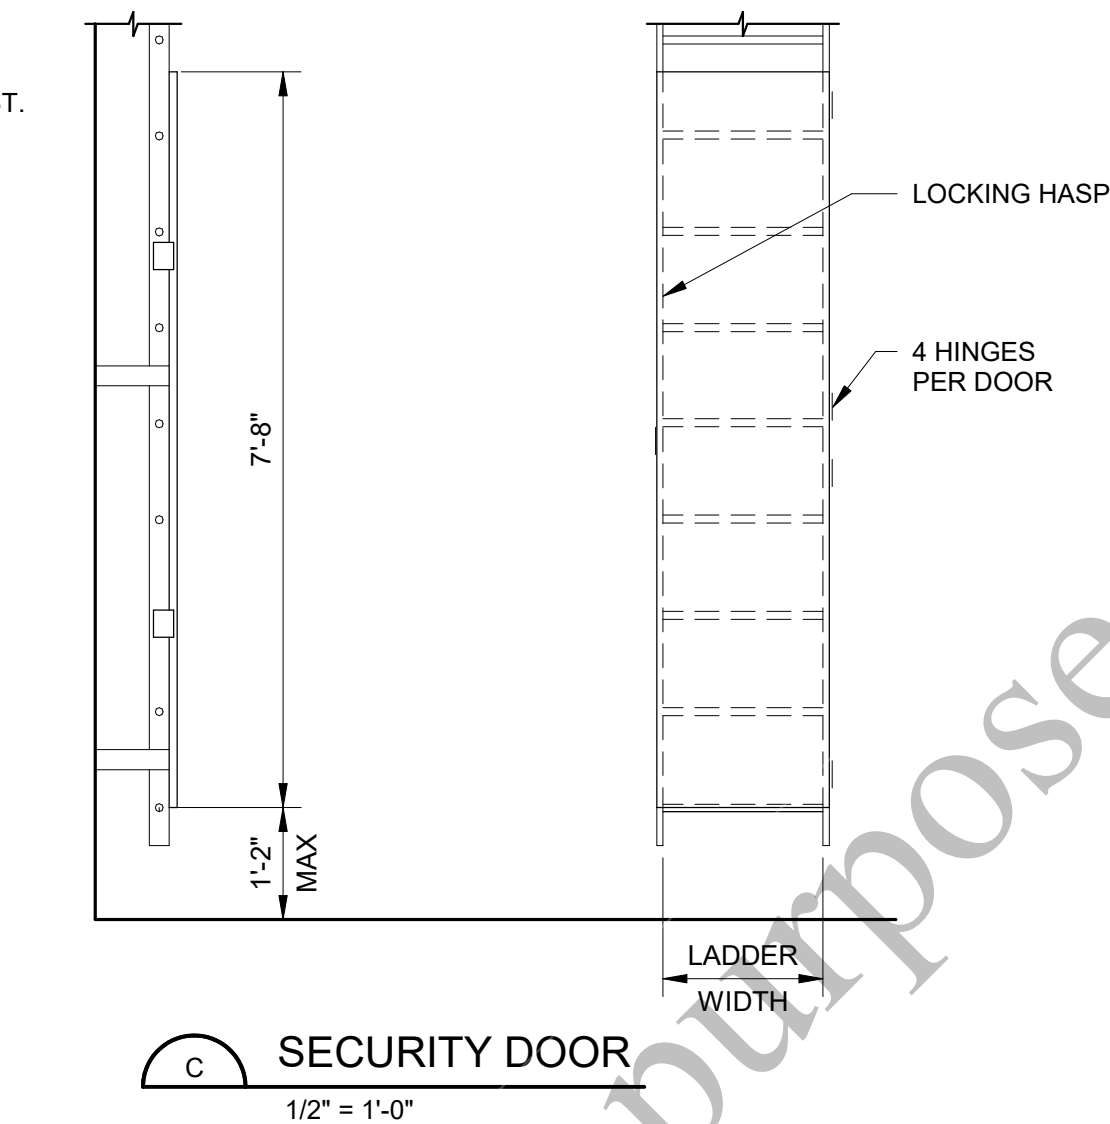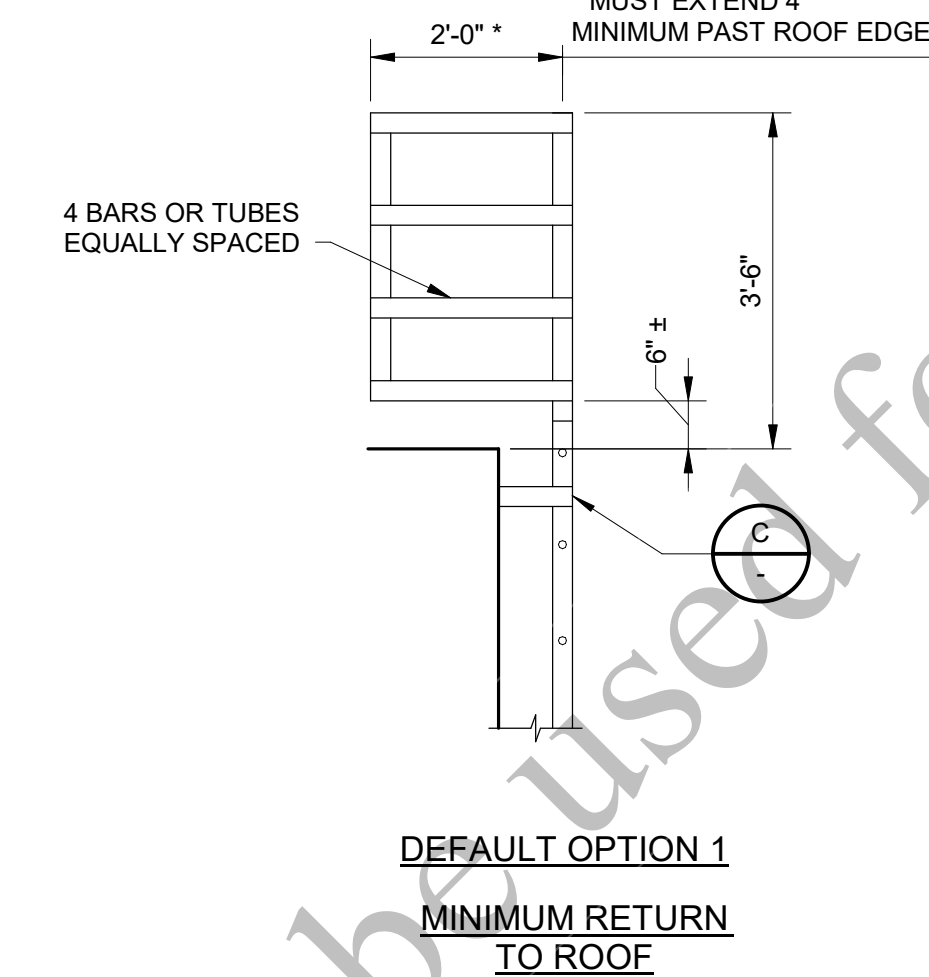

PARAPET RETURN OPTIONS

1/2" = 1'-0"

USE OPTION 1 IF NONE INDICATED

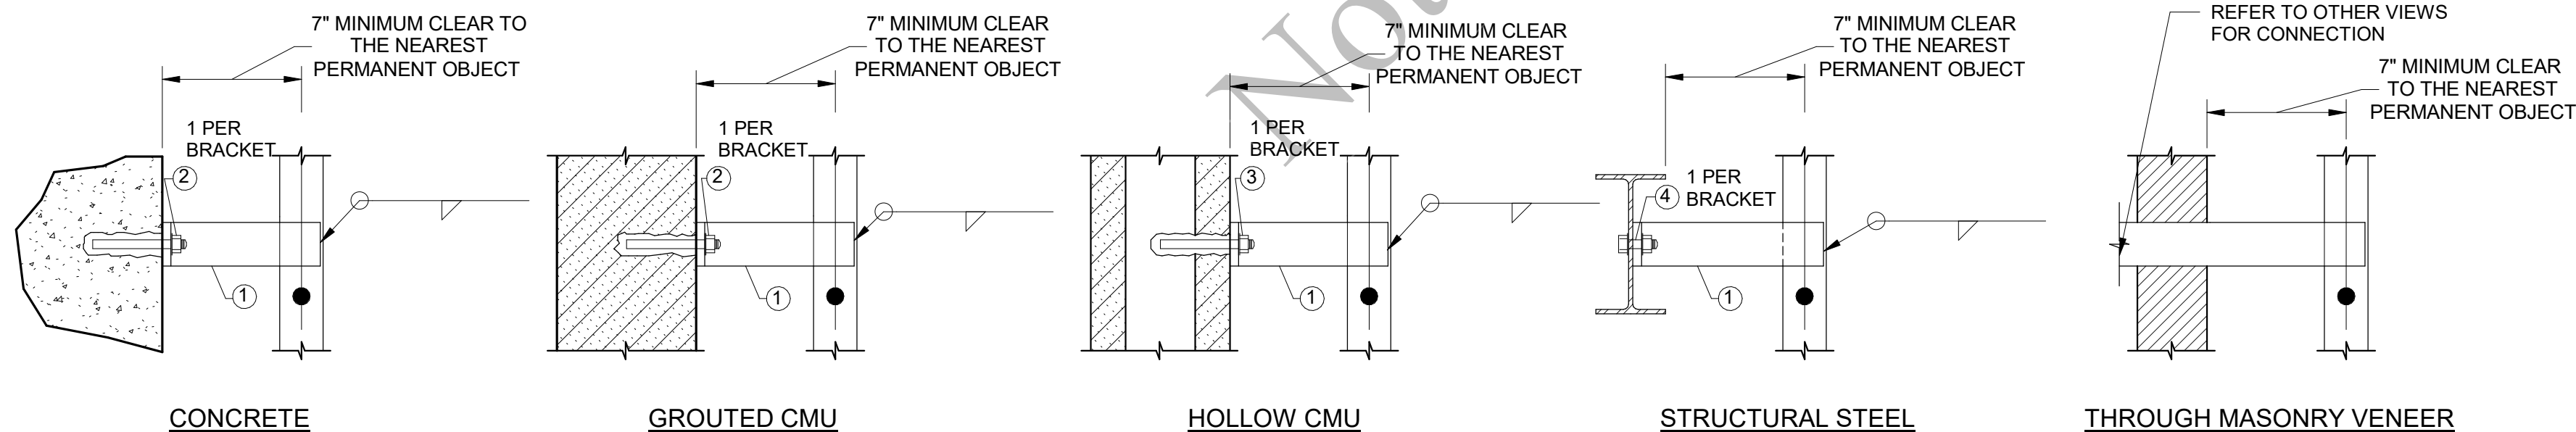

- LADDER BRACKET BY LADDER SUPPLIER, WITH HOLES FOR CONNECTION TO STRUCTURE. ADJUSTABLE BRACKETS SHALL BE PROVIDED WHERE REQUIRED TO COMPENSATE FOR IRREGULAR OR OFFSET WALL SURFACES.
- 1/2" MIN STAINLESS STEEL ADHESIVE OR EXPANSION ANCHORS. MINIMUM EMBEDMENT PER THE ANCHOR MANUFACTURER'S ICC-ES REPORT.
- 1/2" MIN DIAMETER STAINLESS STEEL ADHESIVE ANCHORS WITH SCREEN TUBES. MINIMUM EMBEDMENT PER THE ANCHOR MANUFACTURER'S ICC-ES REPORT.
- IF LADDER IS PAINTED OR GALVANIZED STEEL, USE 3/4" GALVANIZED STEEL, USE 3/4" MIN GALVANIZED HIGH STRENGTH STEEL BOLTS WITH COMPATIBLE NUT AND WASHERS. IF LADDER IS STAINLESS STEEL OR ALUMINUM, USE 3/4" MIN STAINLESS STEEL BOLTS WITH COMPATIBLE NUTS AND WASHERS.

TYPICAL LADDER BRACKET CONNECTIONS

1/2" = 1'-0"

GENERAL SHEET NOTES:

- ALL LADDERS AND FALL PROTECTION SAFETY SYSTEM SHALL BE DESIGNED AND FABRICATED BY THE LADDER SUPPLIER IN CONFORMANCE WITH THE LATEST ISSUE OF OSHA ANSI A14.3, SECTION 1910.27 APPLICABLE BUILDING CODE STANDARDS FOR FIXED WALL LADDERS, AND THE REQUIREMENTS OF THE CONTRACT DRAWINGS AND SPECIFICATIONS. GENERAL CONFIGURATION AND DETAILS SHALL CONFORM WITH THIS DRAWING.
- LADDER AND ALL APPURTENANCES TO BE MATERIAL AS NOTED ON DRAWINGS. COORDINATE MATERIALS AND FABRICATION WITH THE SPECIFICATIONS FOR METAL FABRICATIONS AND FIBERGLASS, AS APPLICABLE.
STEEL (PAINTED) - ASTM A36, SHOP PRIME PAINTED.
STEEL (GALVANIZED) - ASTM A36, ZINC COATED IN ACCORDANCE WITH ASTM A123.
ALUMINUM - ASTM A6061-T6 ALLOY WITH MILL FINISH UNLESS NOTED OTHERWISE.
STAINLESS STEEL - ASTM TYPE 316L.
FIBERGLASS - FIBERGLASS REINFORCED PULTRUDED TUBE, UV PROTECTED.
- LADDER RUNGS TO BE MIN 1" DIAMETER BARS OR PREFABRICATED FLAT TOP LADDER TREADS WITH MINIMUM 1" WIDE SLIP RESISTANT SURFACES. SPACE RUNGS AT 12". LADDER SIDE RAILS SHALL BE FLAT STOCK.
- FURNISH LADDERS IN CONFIGURATIONS REQUIRED TO FIT THE LOCATIONS INDICATED ON THE DESIGN DRAWINGS. CONTRACTOR SHALL VERIFY FINAL DIMENSIONS BEFORE FABRICATION.
- LADDER SHOP DRAWINGS SHALL BE SEALED BY A PROFESSIONAL ENGINEER REGISTERED IN THE STATE OF THE PROJECT. IF REQUESTED, CALCULATIONS OR TEST REPORTS VERIFYING THE LADDERS COMPLIANCE WITH APPLICABLE STANDARDS SHALL BE SUBMITTED, AND SHALL BE SEALED BY A PROFESSIONAL ENGINEER REGISTERED IN THE STATE OF THE PROJECT.
- IF A LADDER CONFIGURATION INDICATED ON THE DRAWINGS REQUIRES THAT THE LADDER SPAN A GREATER DISTANCE BETWEEN SUPPORTS THAN INDICATED ON THE TYPICAL DETAILS, THE LADDER SUPPLIER SHALL DESIGN THE LADDER, THE LADDER BRACKET, AND THE LADDER BRACKET CONNECTIONS FOR THE INDICATED SPAN IN ACCORDANCE WITH NOTE 1 ABOVE. THE BRACKET CONNECTIONS SHALL BE AT LEAST EQUAL TO THE TYPICAL CONNECTIONS INDICATED.
- IF INTERRUPTION OF GUARDRAIL IS REQUIRED, SEE SELF-CLOSING SWING GATE DETAIL ON STANDARD GUARDRAIL DRAWING. SELF-CLOSING GATES SHALL BE UTILIZED AT ALL LADDER ENTRANCES EXCEPT LANDING (REST) PLATFORMS FOR CONTINUOUS LADDER CLIMBS.
- A FALL PROTECTION SAFETY SYSTEM SHALL BE PROVIDED ON LADDERS AS INDICATED IN THE DRAWINGS AND WHERE THE LENGTH OF CLIMBING IS MORE THAN 24 FEET OR WHERE THE LENGTH OF CLIMB IS LESS THAN 24 FEET, BUT THE TOP OF THE LADDER IS MORE THAN 24 FEET ABOVE GROUND LEVEL, FLOOR OR ROOF. THE LADDER FALL PROTECTION SAFETY SYSTEM SHALL BE OSHA APPROVED. LADDER AND ANCHORAGES SHALL BE DESIGNED TO SUPPORT OSHA REQUIRED FALL PROTECTION LOADS AND ANY LOADS INDICATED IN THE FALL PROTECTION SAFETY SYSTEM'S PRODUCT LITERATURE.
- WHERE A FALL PROTECTION SAFETY SYSTEM IS REQUIRED AND THE LADDER TERMINATES BELOW AN ACCESS HATCH, THE FALL PROTECTION SAFETY SYSTEM SHALL INCORPORATE A TELESCOPING ANCHOR EXTENSION WHICH IS INTEGRAL WITH THE SAFETY SYSTEM. THE TELESCOPING ANCHOR EXTENSION SHALL REPLACE THE REQUIREMENT FOR THE EXTENDING LADDER SAFETY POST.



Black & Veatch Corporation
Chicago, Illinois
ILLINOIS PROFESSIONAL
DESIGN FIRM - 184.002143-0006



**AEROBIC GRANULAR
SLUDGE - PHASE 1**

REVISIONS AND RECORD OF ISSUE

DESIGNED:	SKA
DETAILED:	UBS
CHECKED:	CG
APPROVED:	TNG
DATE:	12/20/2022
PROJECT NO.:	411752


DETAILS

STRUCTURAL

**STANDARD LADDER
DETAILS**

99-S-507

137
OF
163

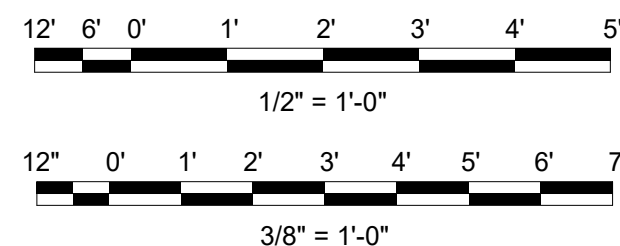


(SCALE BAR IS 4" AT FULL SCALE)

STEEL DECKING SCHEDULE														
BUILDING	LOCATION	DECKING					SUPPORT FASTENERS			SIDELAP FASTENERS			EDGE ZONE WIDTH	PERIMETER ATTACHMENTS PARALLEL TO SIDELAP FASTENERS
		DEPTH	TYPE NOTE 1	GAUGE	SHOP COATING NOTE 2	MIN SPANS NOTE 3	TYPE NOTE 4	FIELD PATTERN	PERIMETER PATTERN	TYPE NOTE 4	FIELD SPACING	PERIMETER SPACING		
AGS SUPPORT FACILITY	ROOF	1 1/2"	B	20	G90	3	HILTI X-ENP-19-L15	36/4	36/4	HILTI S-SLC-01-M-MWH	12" OC	6" OC	3 FEET	HILTI X-ENP-19-L15

NOTES:

- DECKING TYPE THAT INCLUDES "A" SHALL BE ACOUSTICAL DECKING.
- "G60" AND "G90" INDICATE GALVANIZING THICKNESS, "PRIME" INDICATES PRIME PAINTING. SEE STEEL DECKING SPECIFICATION.
- DECKING SHEETS SHALL BE CUT TO COVER AT LEAST THE NUMBER OF SPANS INDICATED.
- "SCREWS", "POWER-ACTUATED", AND "PUNCHED" SHALL BE AS DESCRIBED IN THE STEEL DECKING SPECIFICATION.


A STEEL DECKING SCHEDULE
NO SCALE

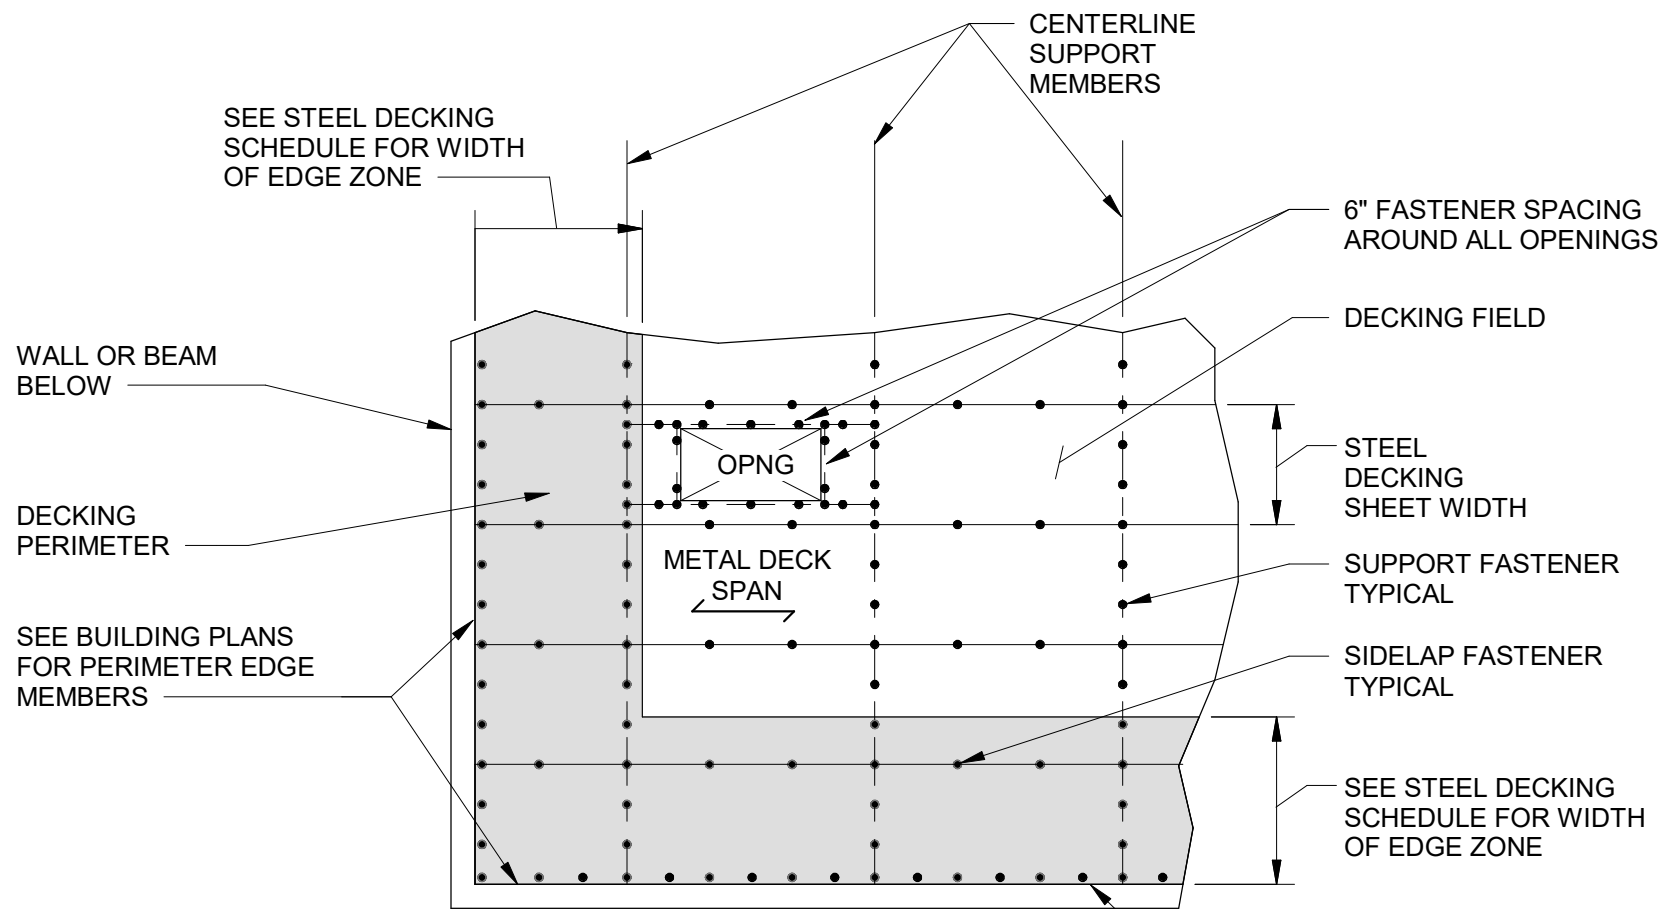


NOTE:

SEE STEEL DECKING SCHEDULE FOR TYPE AND SPACING OF SUPPORT FASTENERS AND SIDELAP FASTENERS.


C STEEL DECKING FASTENER DETAIL
1/2" = 1'-0"

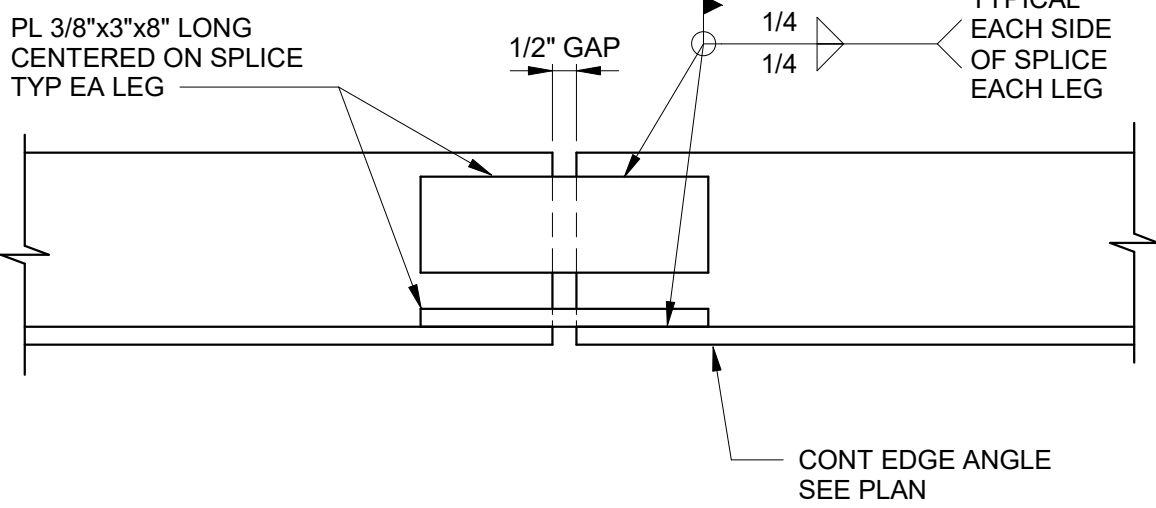

E EDGE ANGLE SPLICE DETAIL
3" = 1'-0"

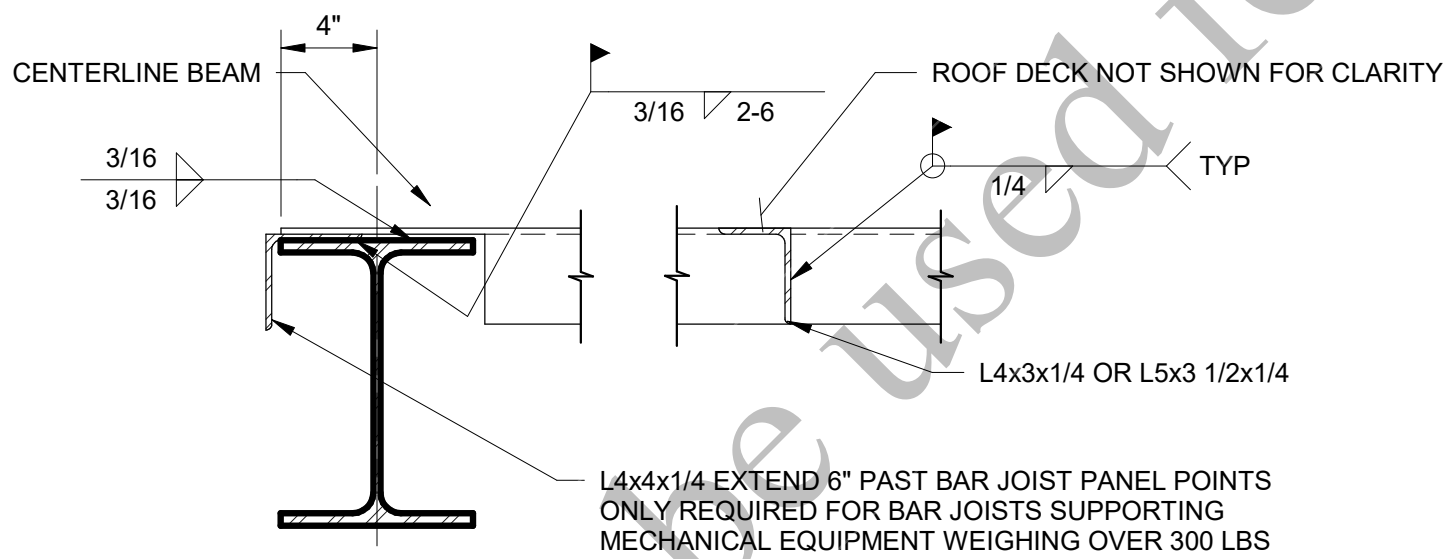


1 SECTION
99-S-508 1 1/2" = 1'-0"

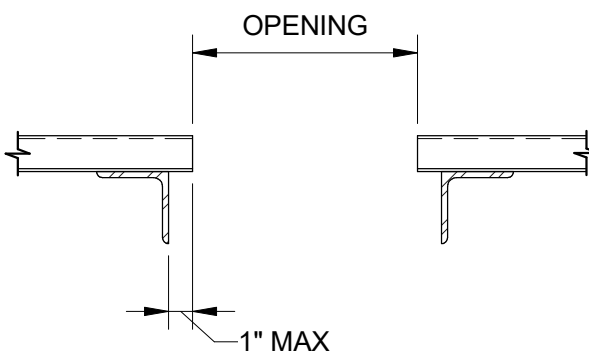


2 SECTION
99-S-508 1 1/2" = 1'-0"

1 99-S-508

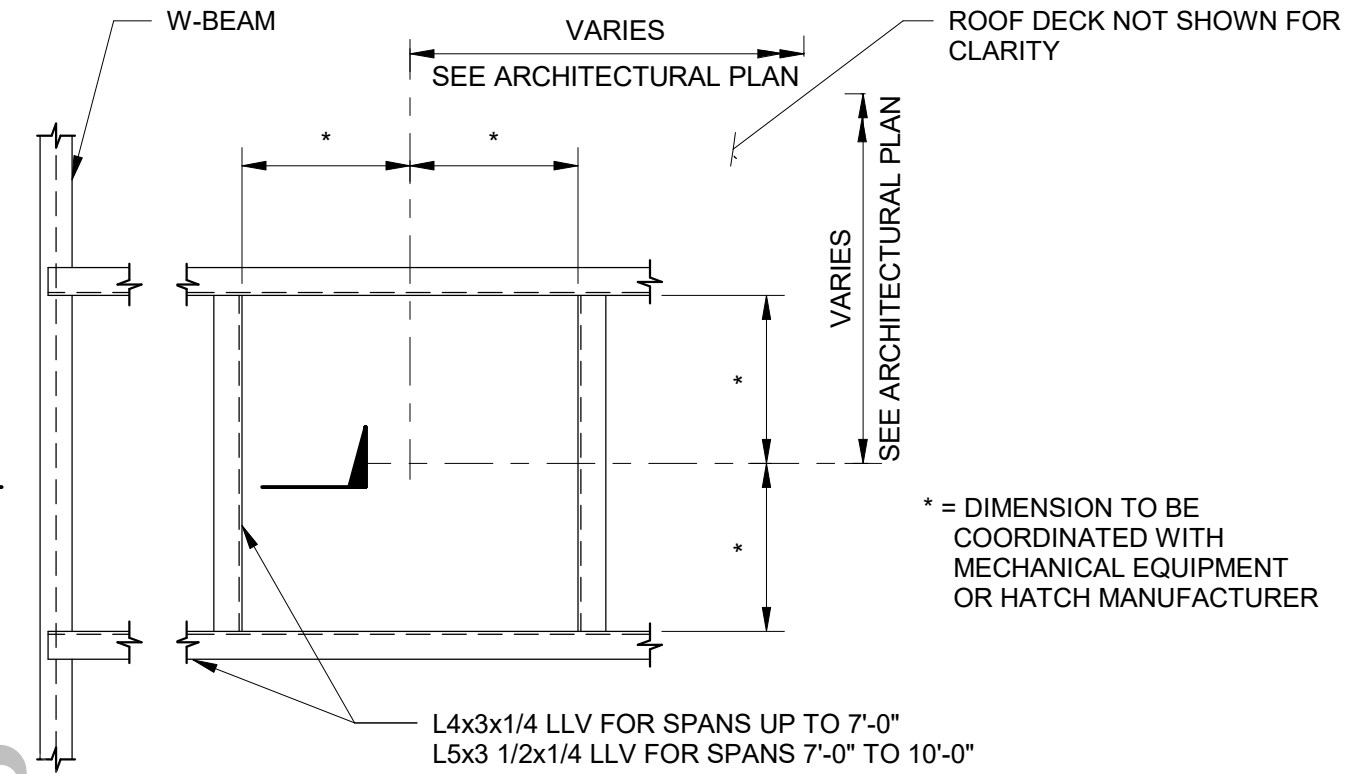

B TYPICAL STEEL DECK OPENING FRAMING DETAIL
1/2" = 1'-0"

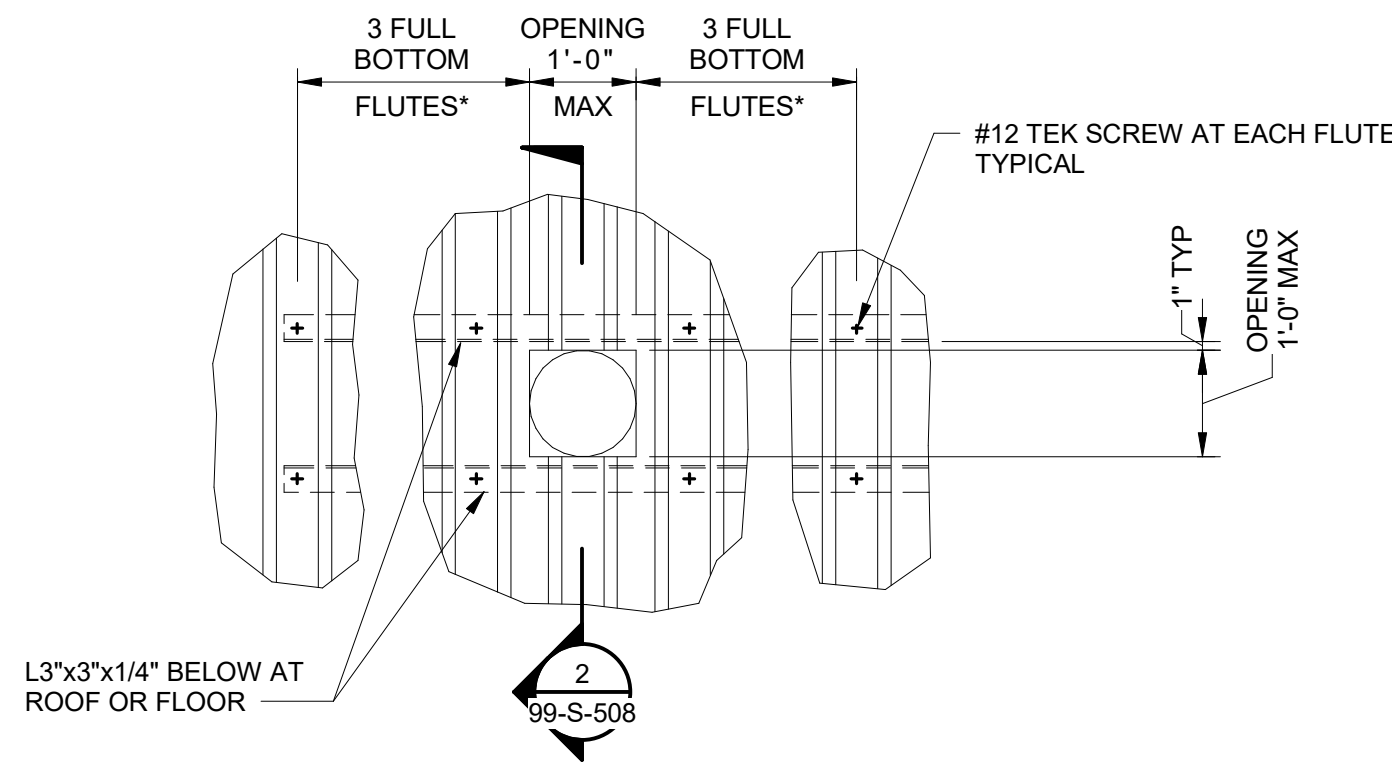


PLAN VIEW

NOTES:

- SEE ARCHITECTURAL, PROCESS MECHANICAL, AND ELECTRICAL DRAWINGS FOR LOCATION OF OPENINGS.
- SEE ARCHITECTURAL DRAWINGS FOR FLASHING DETAILS.
- * DENOTES TO CONNECT TO BEAM.

FRAMING FOR ROOF OPENING ≤ 1'-0"x1'-0" WITHOUT EQUIPMENT WEIGHT

F ROOF OPENING DETAIL
NO SCALE

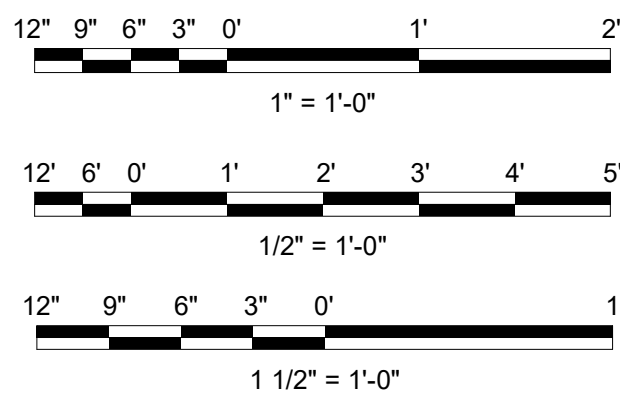

REVISIONS AND RECORD OF ISSUE

DESIGNED:	SKA
DETAILED:	UBS
CHECKED:	CG
APPROVED:	TNG
DATE:	12/20/2022

PROJECT NO.: 411752

DETAILS

STRUCTURAL

TYPICAL METAL DECK
DETAILS


REVISIONS AND RECORD OF ISSUE	
DESIGNED:	SKA
DETAILED:	UBS
CHECKED:	CG
APPROVED:	TNG
DATE:	12/20/2022
PROJECT NO.:	411752

DETAILS

STRUCTURAL

STEEL ROOF TO CMU
WALL CONNECTION
DETAILS

99-S-509

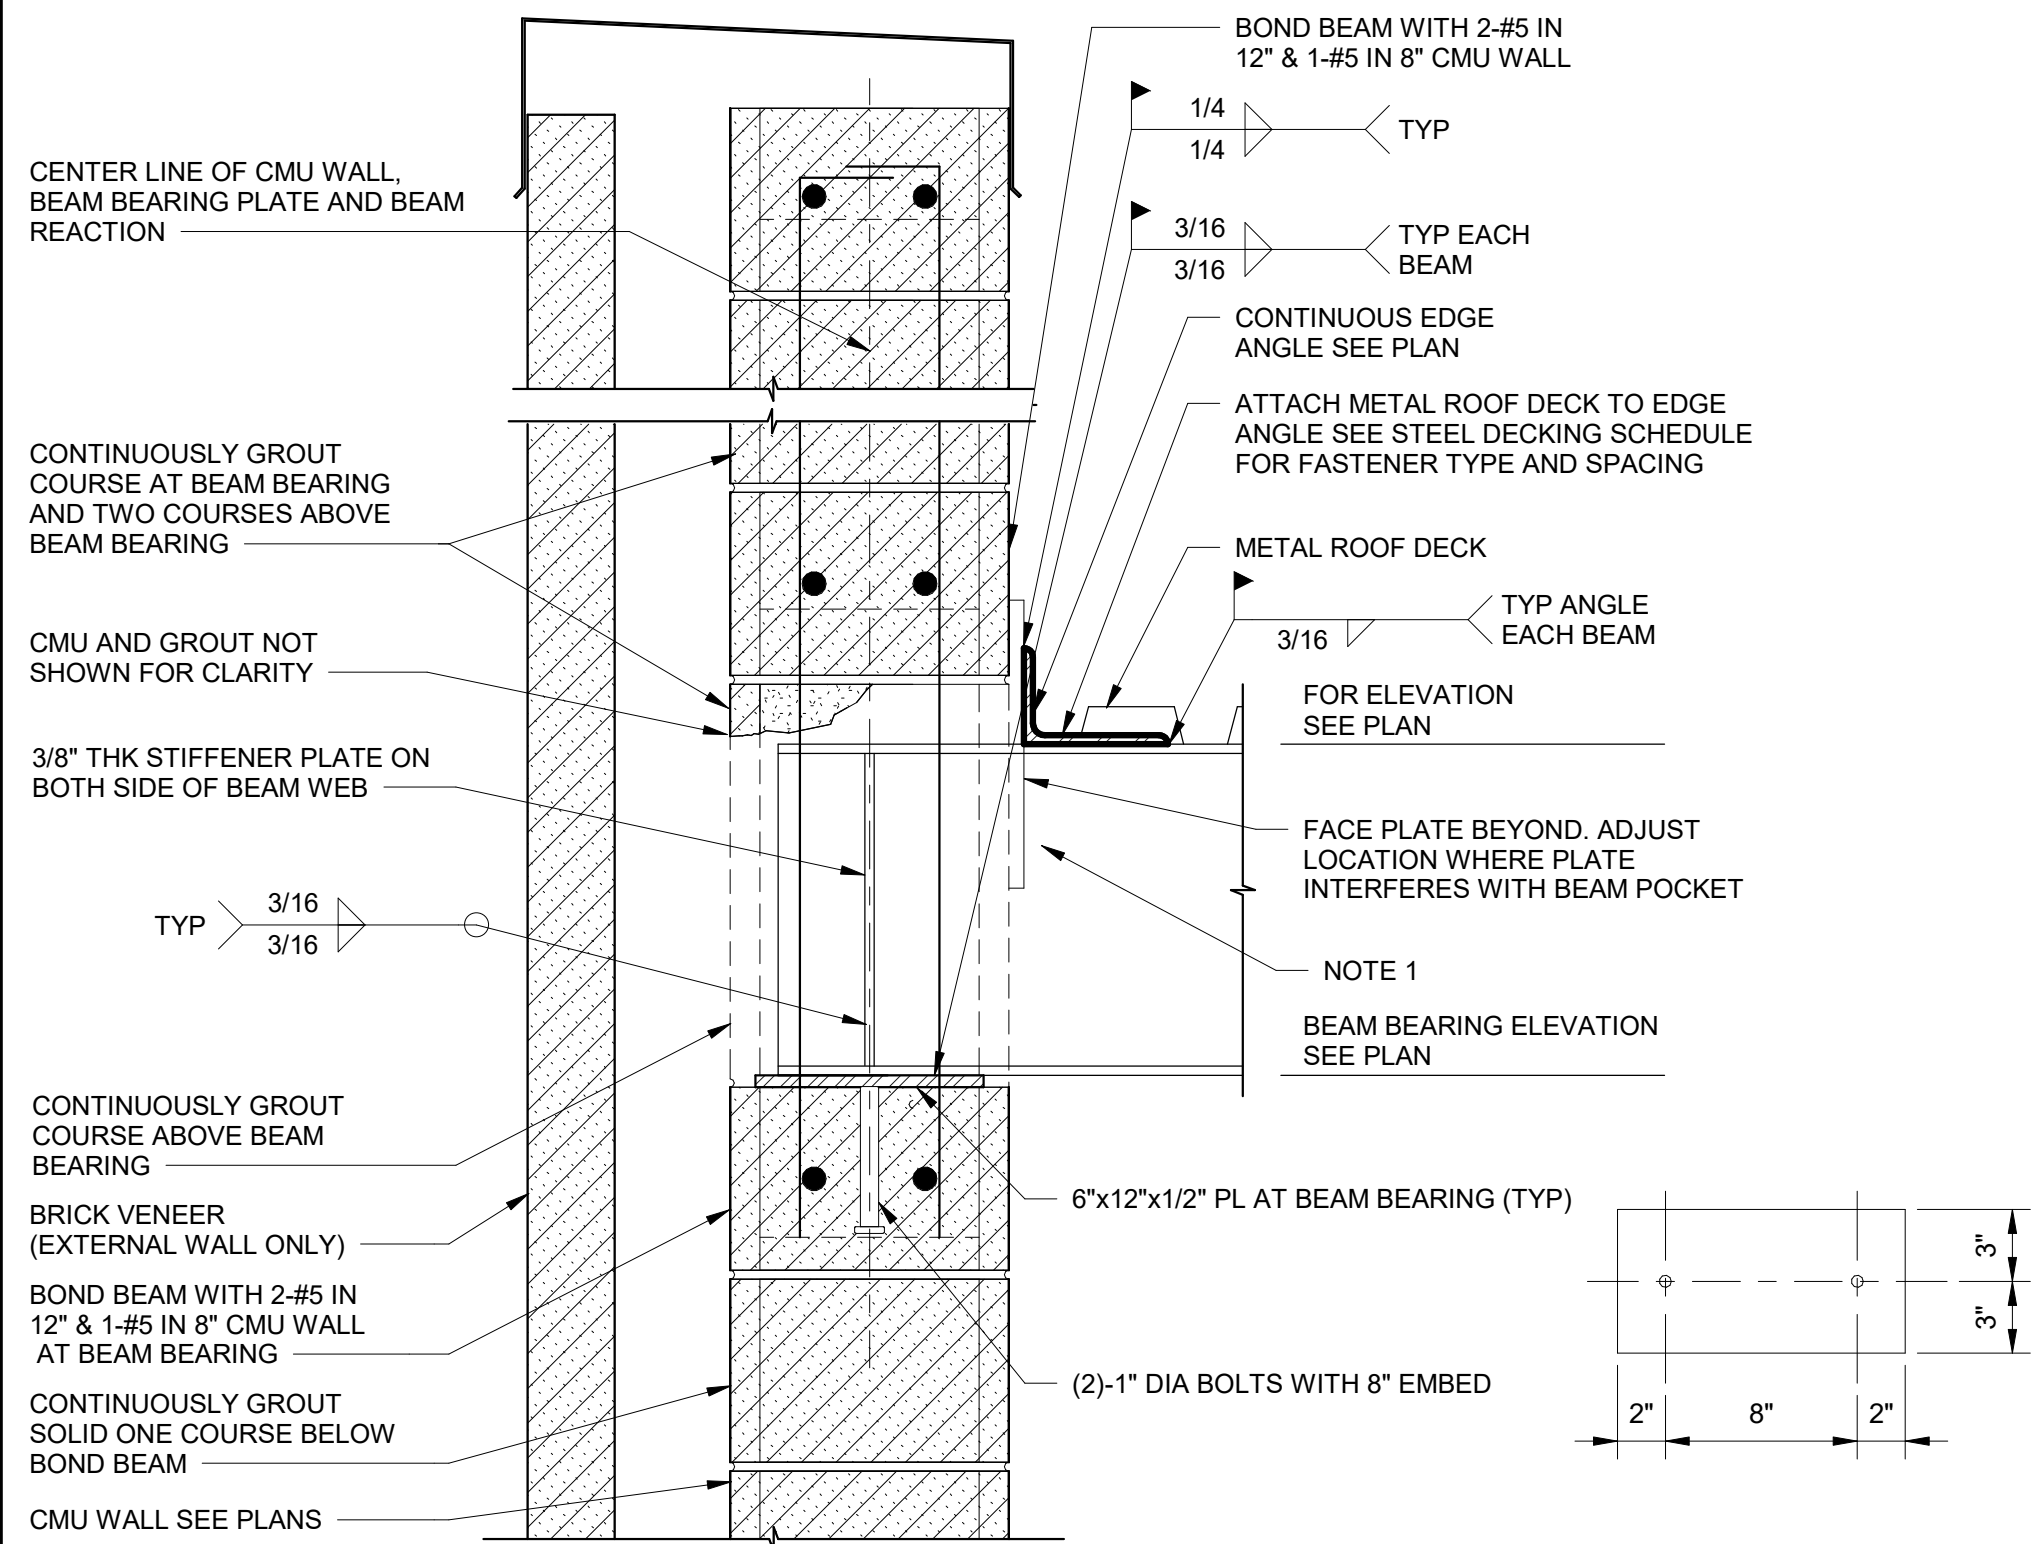
139
OF
163

NOTE:

- WHERE BEAM POCKETS ARE USED, POCKET LENGTH SHALL NOT EXCEED 16". FILL POCKET WITH GROUT AFTER BEAM INSTALLATION.

A STEEL BEAM BEARING ON CMU WALL (12"/8" CMU)

1 1/2" = 1'-0"

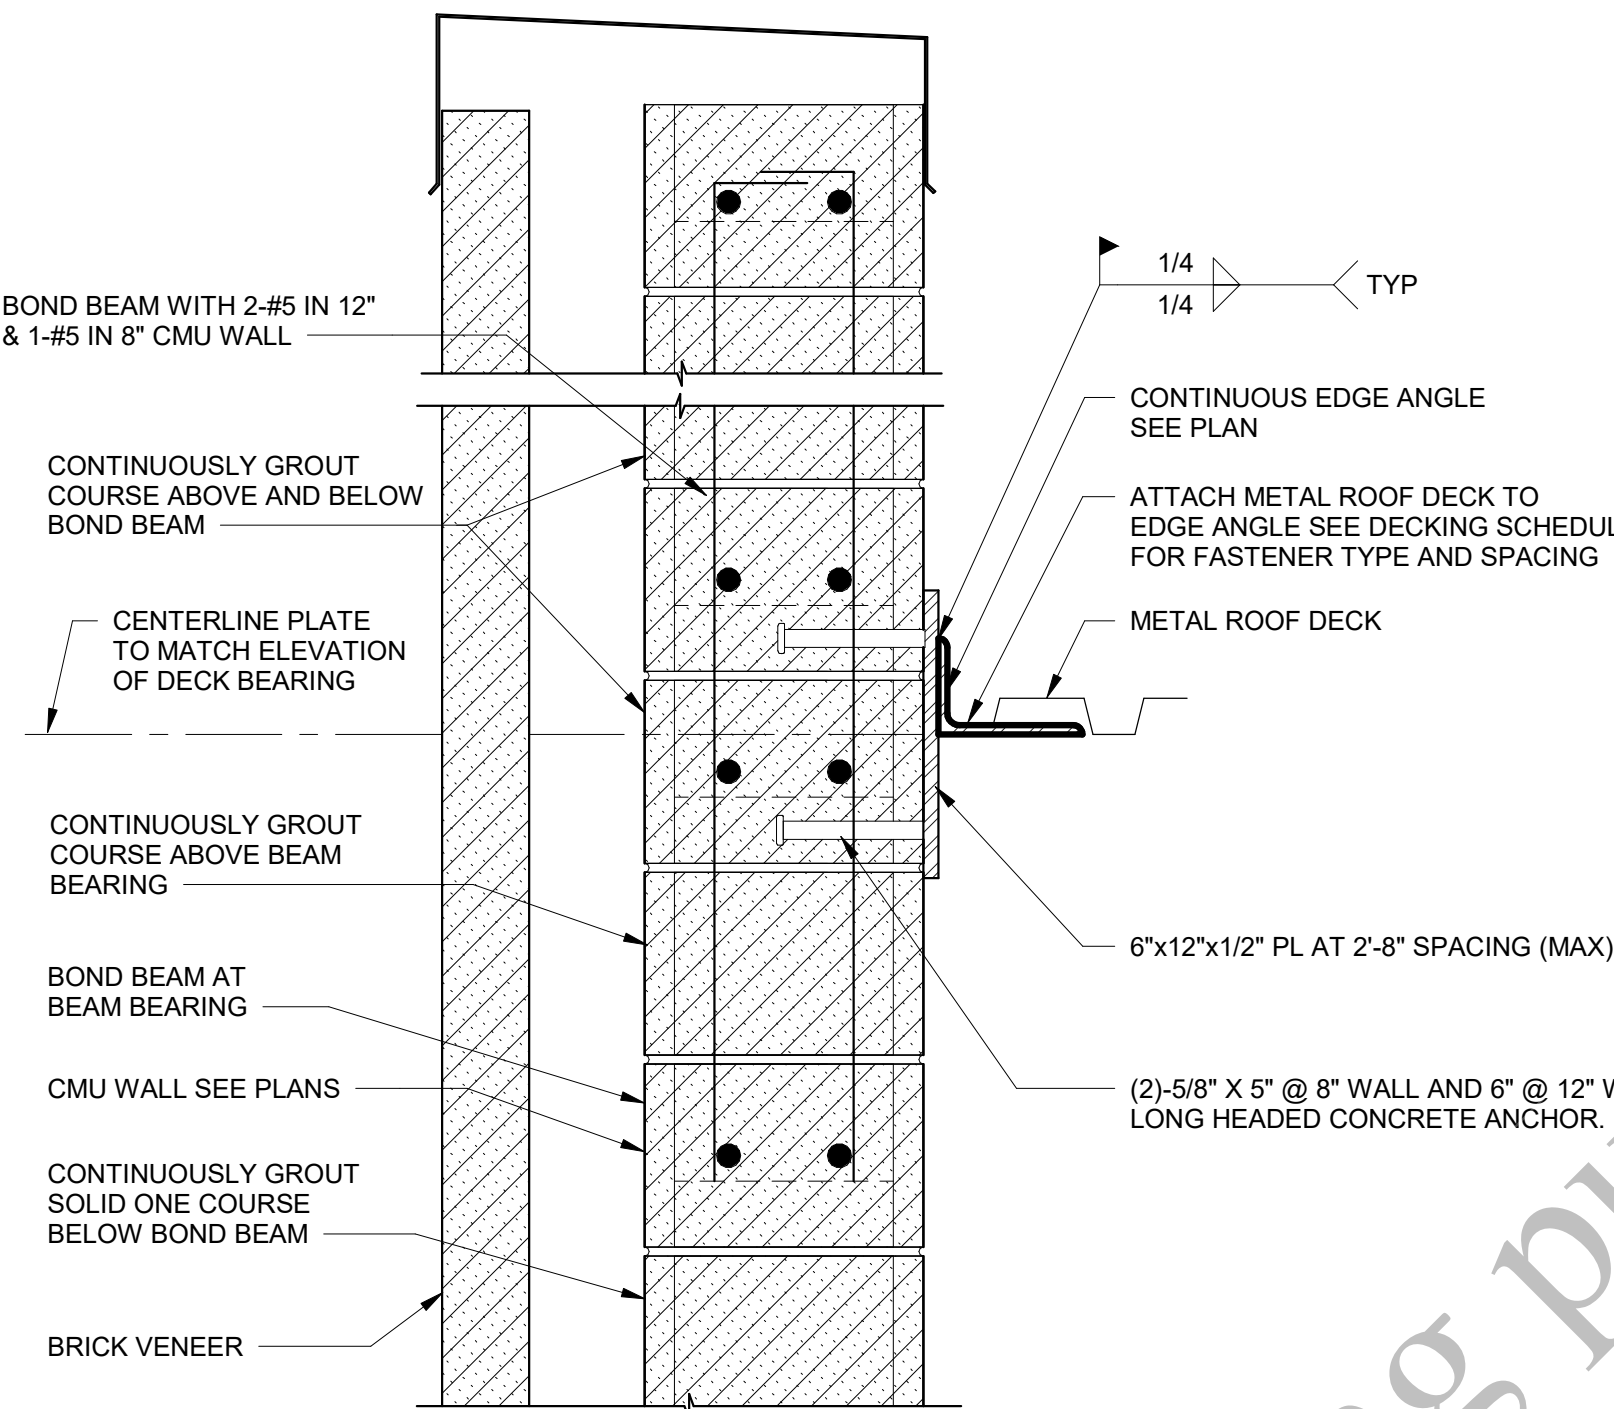


NOTE:

- FIELD ADJUST THE LOCATION OF THE PLATE AS PER THE LOCATION OF ROOF BEAM/JOIST.

B EDGE SUPPORT BETWEEN BEAMS (12" CMU)


1 1/2" = 1'-0"

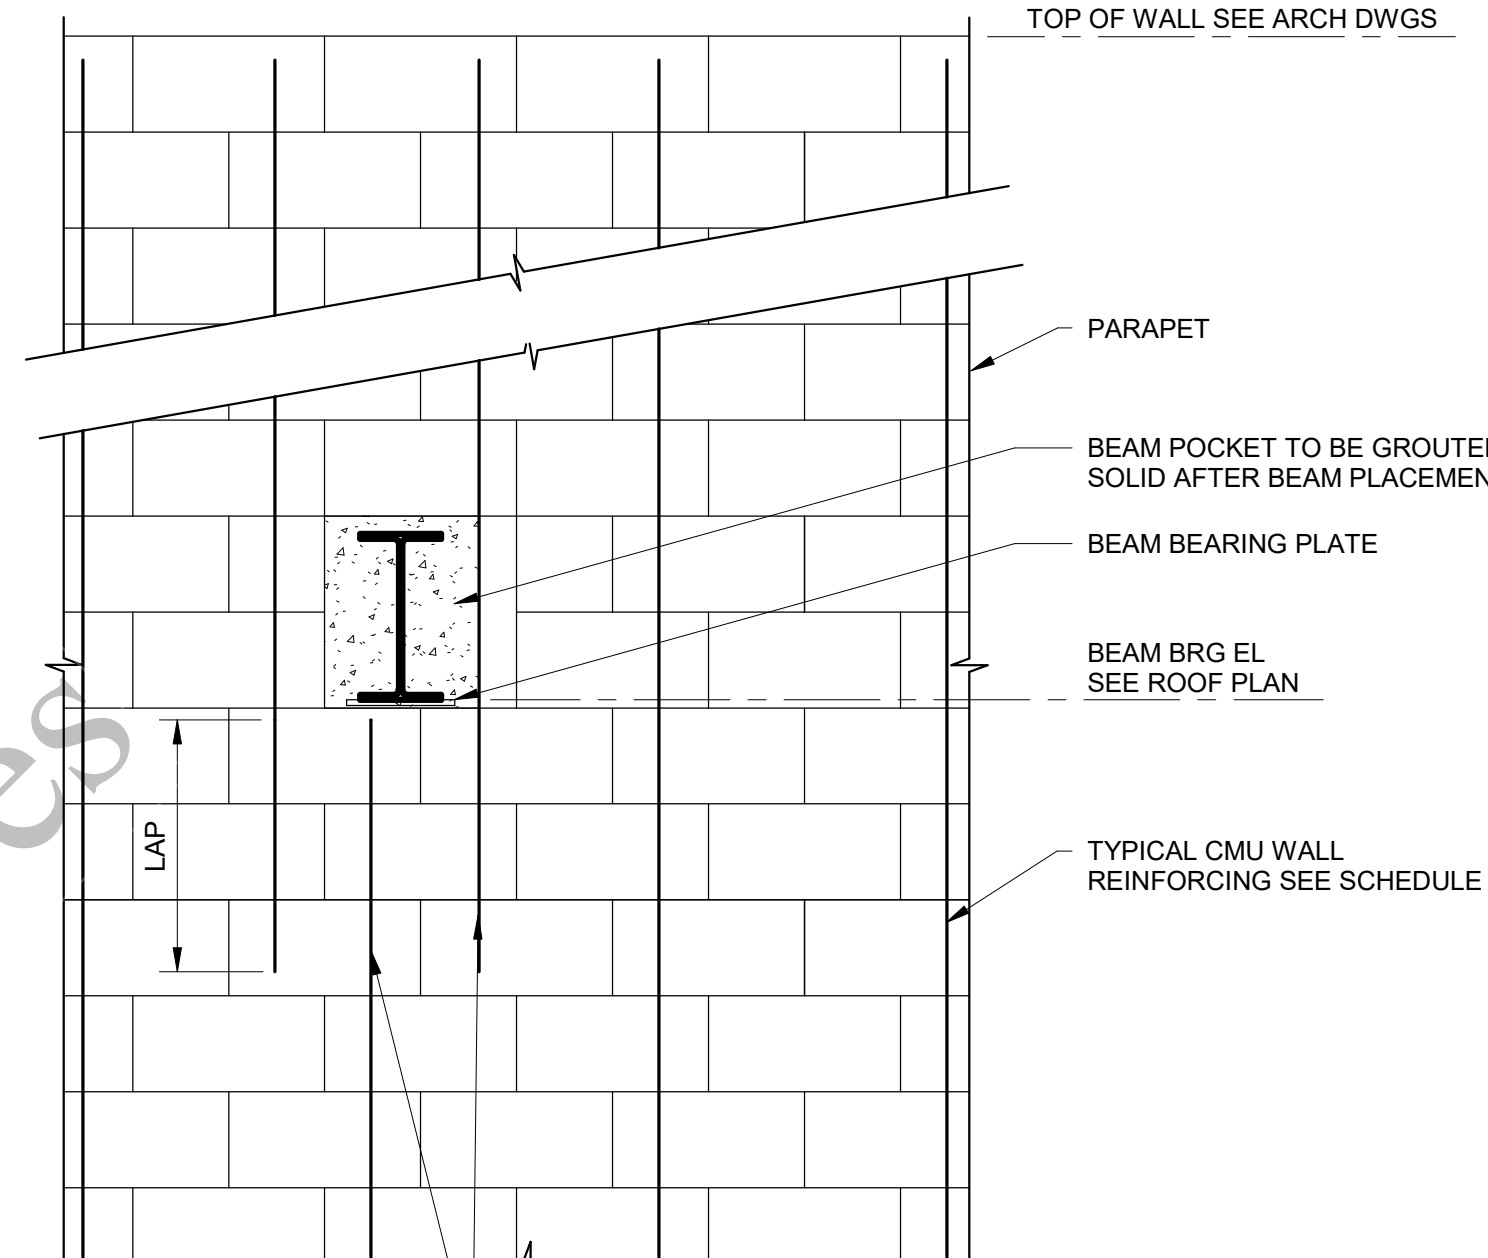

WHERE BEAM BEARING PLATE INTERFERES WITH CMU WALL REINFORCING, PROVIDE 1-#5 BAR EACH SIDE OF BEAM BEARING ADJACENT TO BEARING PLATE. LAP REINFORCING AS SHOWN AND CONTINUE REINFORCING TO TOP OF CMU WALL, TYP

C TYPICAL WALL REINFORCING AT BEAM BEARING PLATE

3/4" = 1'-0"

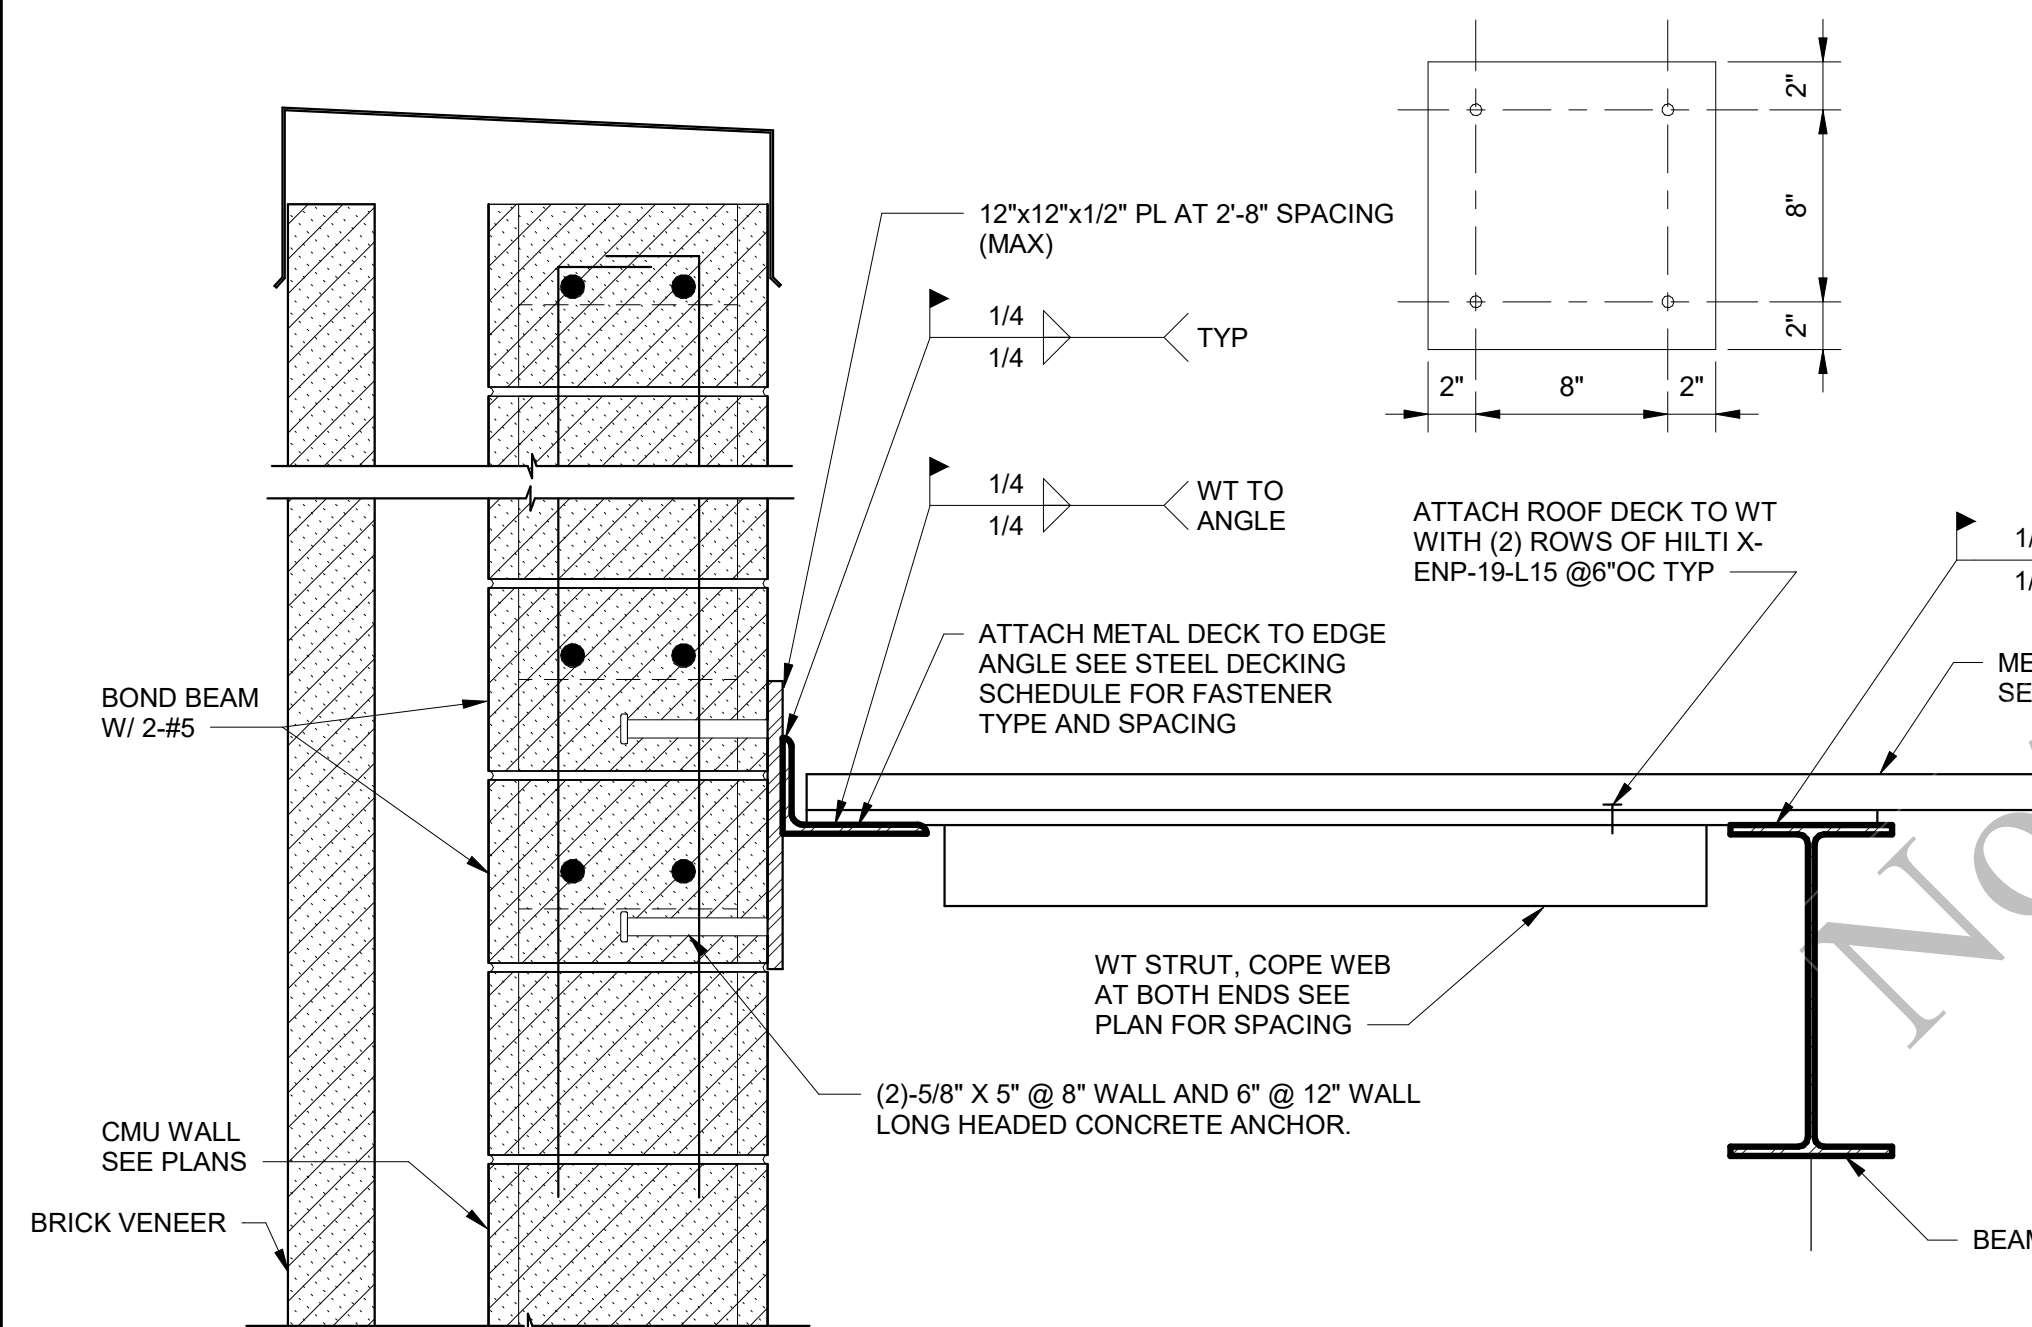


NOTES:

- WHERE WT IS PLACED ON EACH SIDE OF BEAM, COPE AND WELD WT AS SHOWN FOR WT PLACED IN SINGLE BAY.
- FIELD ADJUST THE LOCATION OF THE PLATE AS PER THE LOCATION OF WT STRUT.

D STRUT CONNECTION DETAIL (8" CMU/12" CMU)

1 1/2" = 1'-0"

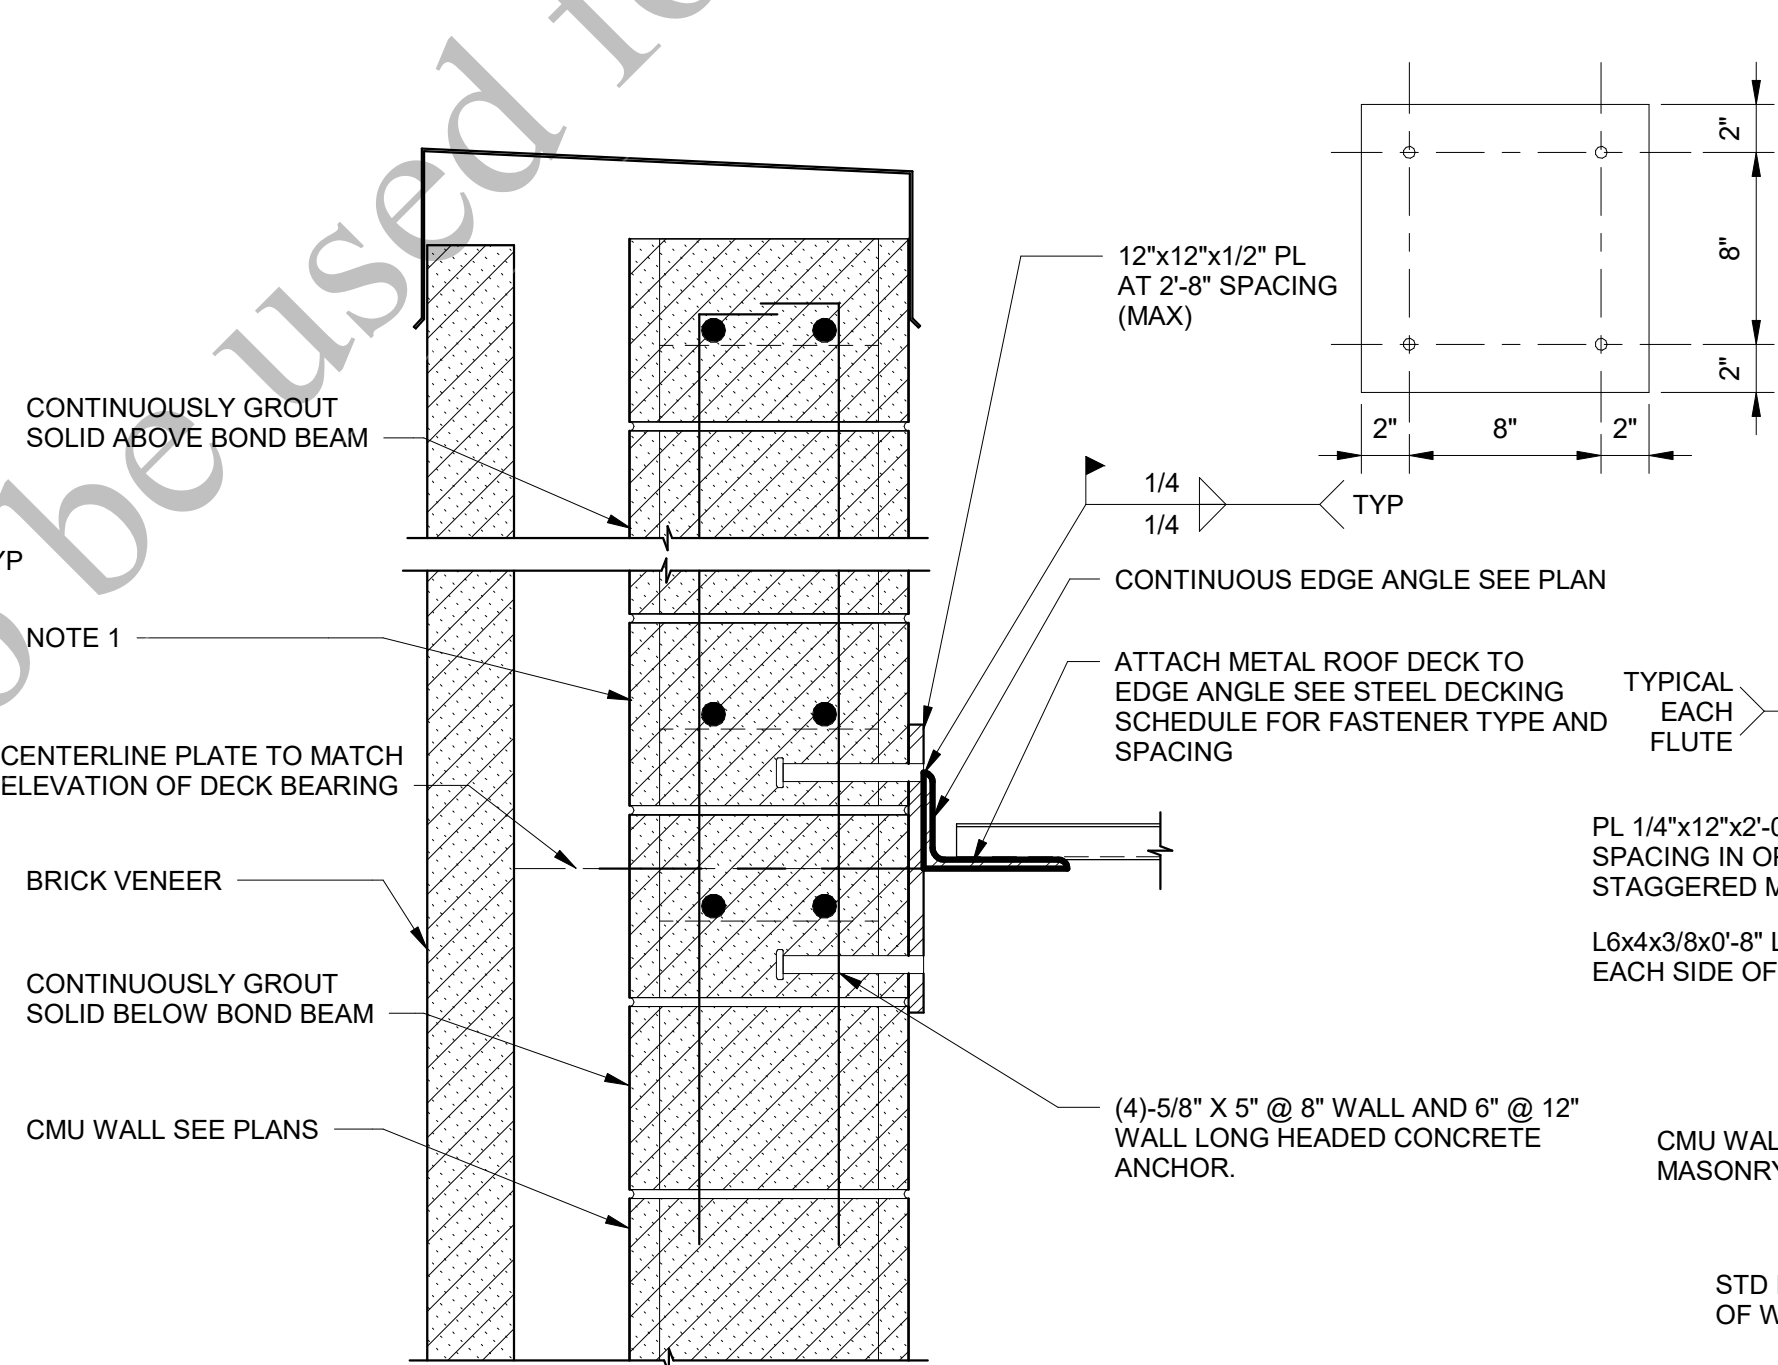


NOTES:

- MAINTAIN 2 BOND BEAMS WITH 1-#5 AT EMBED PLATE. PROVIDE STEPPED BOND BEAM AT SLOPED ROOFS.
- FIELD ADJUST THE LOCATION OF THE PLATE AS PER THE LOCATION OF WT STRUT.

E STEEL DECKING EDGE SUPPORT (8" CMU/12" CMU)

1 1/2" = 1'-0"

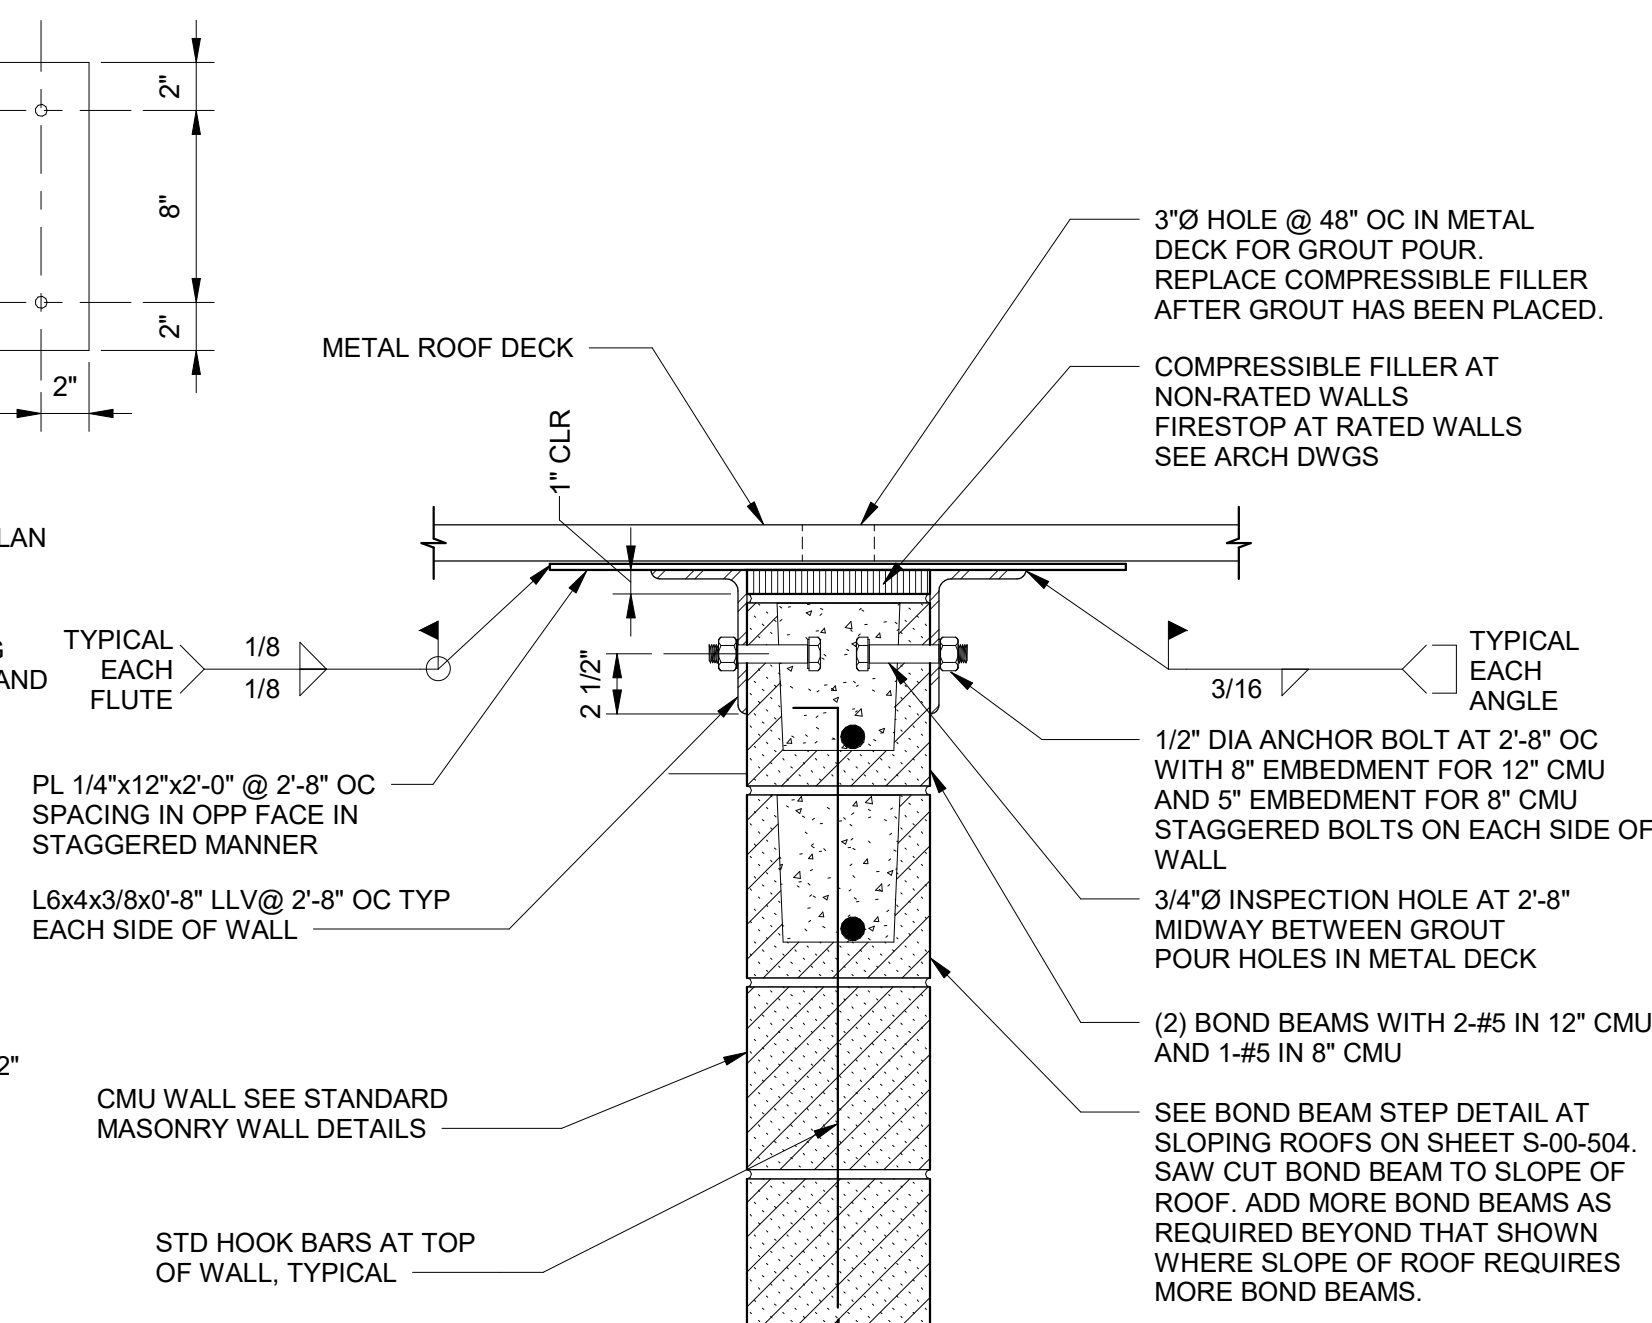

(CMU WALL PERPENDICULAR TO DECK SPAN)

F NON-LOAD BEARING CMU WALL BRACE DETAIL

1 1/2" = 1'-0"



(SCALE BAR IS 4" AT FULL SCALE)

REVISIONS AND RECORD OF ISSUE	
DESIGNED:	SKA
DETAILED:	UBS
CHECKED:	CG
APPROVED:	TNG
DATE:	12/20/2022
PROJECT NO.:	411752


DETAILS

STRUCTURAL

HOLLOWCORE ROOF
SLAB CONNECTION
DETAILS

99-S-510

140
OF
163

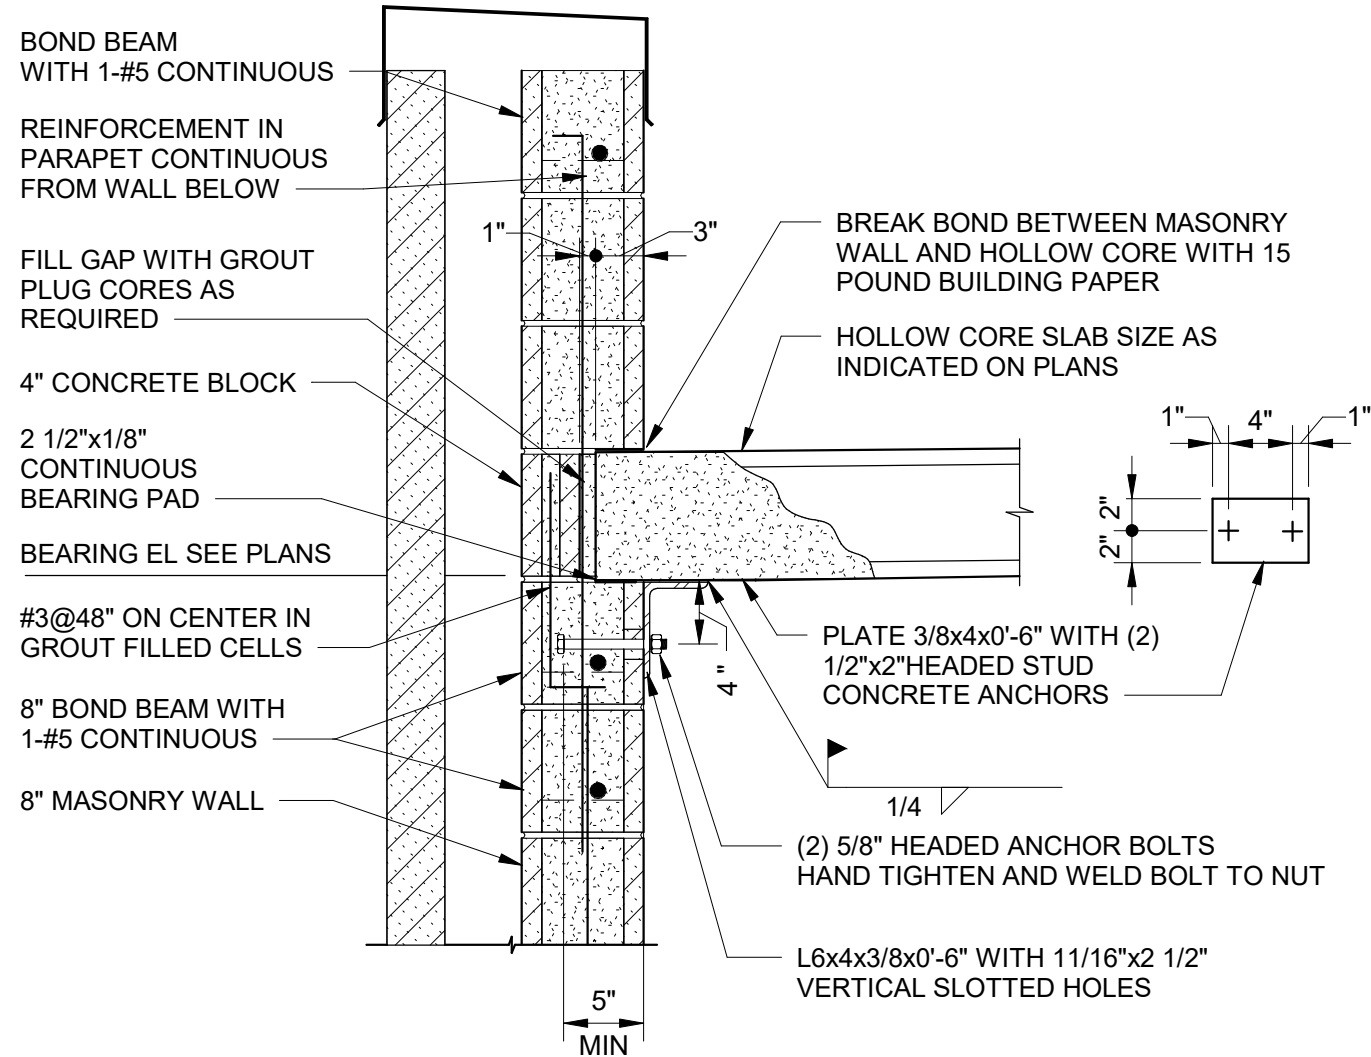

NOTES:

1. EMBEDDED PLATE AND HEADED CONCRETE ANCHORS SHOWN ARE REPRESENTATIVE. EMBEDDED PLATE AND HEADED CONCRETE ANCHORS SHALL BE DESIGNED BY THE PRECAST MANUFACTURER FOR THE FOLLOWING CONTROLLING STRENGTH LEVEL LOADS AND MOMENTS:

WIND LOADS

- 1.5 KIPS, 6.0 KIP-INCHES (PARALLEL TO WALL)
2.4 KIPS, 10.0 KIP-INCHES (PERPENDICULAR TO WALL)


SEISMIC LOADS

- 1.5 KIPS, 6.0 KIP-INCHES (PARALLEL TO WALL)
1.5 KIPS, 6.0 KIP-INCHES (PERPENDICULAR TO WALL)

2. UNLESS INDICATED OTHERWISE ON PLANS, PROVIDE ABOVE CONNECTIONS AT 4'-0" ON CENTER (MAXIMUM). PRECAST MANUFACTURER SHALL OMIT VOIDS DURING MANUFACTURE OR GROUT VOIDS AFTER MANUFACTURE TO DEVELOP THE REQUIRED CAPACITY OF THE EMBED PLATES AND HEADED STUDS.

3. CONTRACTOR SHALL COORDINATE CONNECTION LOCATIONS WITH HOLLOW CORE SHOP DRAWINGS.

HOLLOW CORE BEARING ON 8" MASONRY WALL WITH
PARAPET MECHANICAL CONNECTION DETAIL
1" = 1'-0"

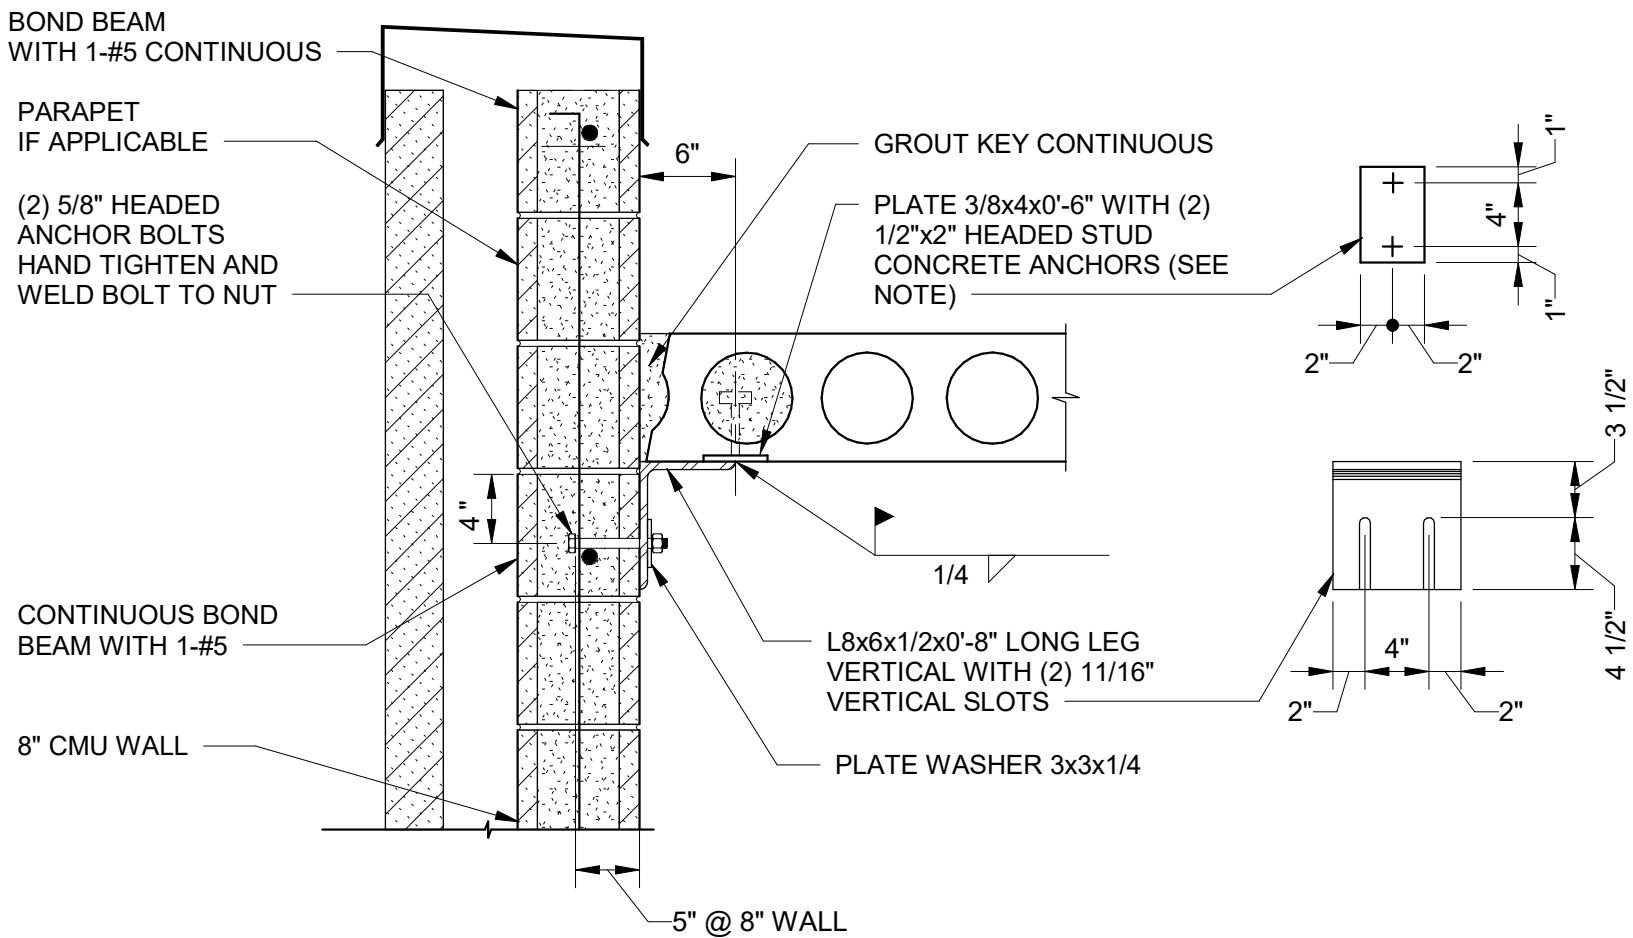

NOTES:

1. EMBEDDED PLATE AND HEADED CONCRETE ANCHORS SHOWN ARE REPRESENTATIVE. EMBEDDED PLATE AND HEADED CONCRETE ANCHORS SHALL BE DESIGNED BY THE PRECAST MANUFACTURER FOR THE FOLLOWING CONTROLLING STRENGTH LEVEL LOADS AND MOMENTS:

WIND LOADS

- 1.5 KIPS, 6.0 KIP-INCHES (PARALLEL TO WALL)
2.4 KIPS, 10.0 KIP-INCHES (PERPENDICULAR TO WALL)


SEISMIC LOADS

- 1.5 KIPS, 6.0 KIP-INCHES (PARALLEL TO WALL)
1.5 KIPS, 6.0 KIP-INCHES (PERPENDICULAR TO WALL)

2. UNLESS INDICATED OTHERWISE ON PLANS, PROVIDE ABOVE CONNECTIONS AT 4'-0" ON CENTER (MAXIMUM). PRECAST MANUFACTURER SHALL OMIT VOIDS DURING MANUFACTURE OR GROUT VOIDS AFTER MANUFACTURE TO DEVELOP THE REQUIRED CAPACITY OF THE EMBED PLATES AND HEADED STUDS.

3. CONTRACTOR SHALL COORDINATE CONNECTION LOCATIONS WITH HOLLOW CORE SHOP DRAWINGS.


HOLLOW CORE SUPPORTING 8" MASONRY WALL
MECHANICAL CONNECTION DETAIL
1" = 1'-0"

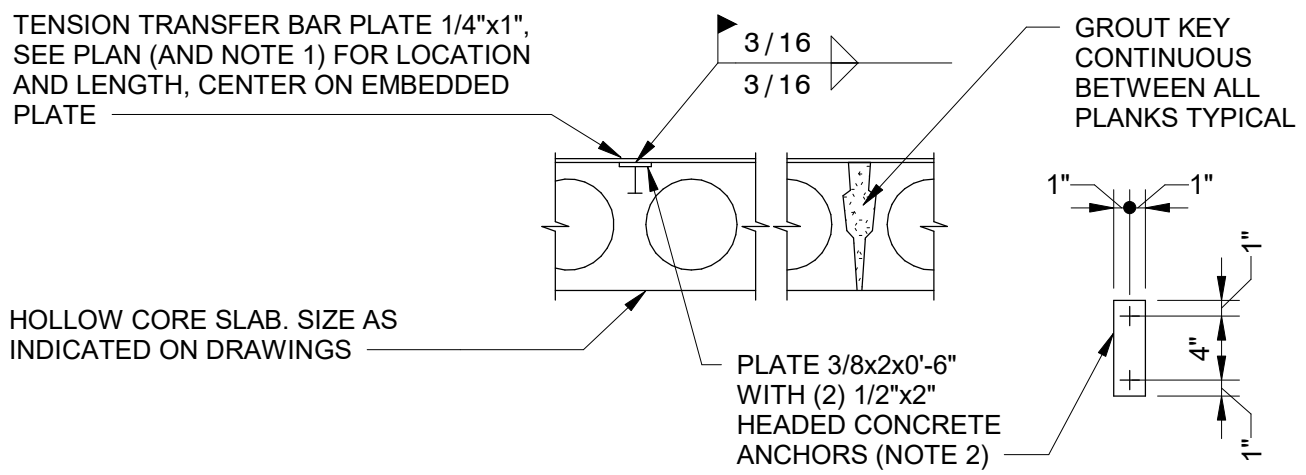


NOTES:

1. TENSION TRANSFER BAR SHALL BE MINIMUM LENGTH SHOWN ON PLANS, BUT SHALL EXTEND A MINIMUM OF 2' BEYOND THE CENTERLINE OF THE FARTHEST EMBEDDED PLATE.
2. PLATE IN HOLLOW CORE MAY BE CAST IN DURING MANUFACTURE AS SHOWN IN THE DETAIL, OR MAY BE GROUTED IN A HOLLOW CORE VOID BY THE PRECASTER AFTER CASTING; GROUT IN VOID SHALL EXTEND A MINIMUM OF 6" BEYOND HEADED ANCHOR CENTERLINE EACH WAY. IN EITHER CASE, THE PLATE SHALL BE AS CLOSE TO THE MIDDLE OF THE HOLLOW CORE AS POSSIBLE AND SHALL BE IN THE SAME RELATIVE LOCATION IN EACH HOLLOW CORE THAT WOULD BE WITHIN THE LENGTH OF THE TENSION TRANSFER BAR. IF NEED BE, THE TENSION TRANSFER BAR SHALL BE LONGER AS REQUIRED TO OBTAIN THE CORRECT LOCATION OF THE EMBEDDED PLATE IN THE FARTHEST HOLLOW CORE.


HOLLOW CORE PANEL TO PANEL MECHANICAL
CONNECTION DETAIL
NO SCALE

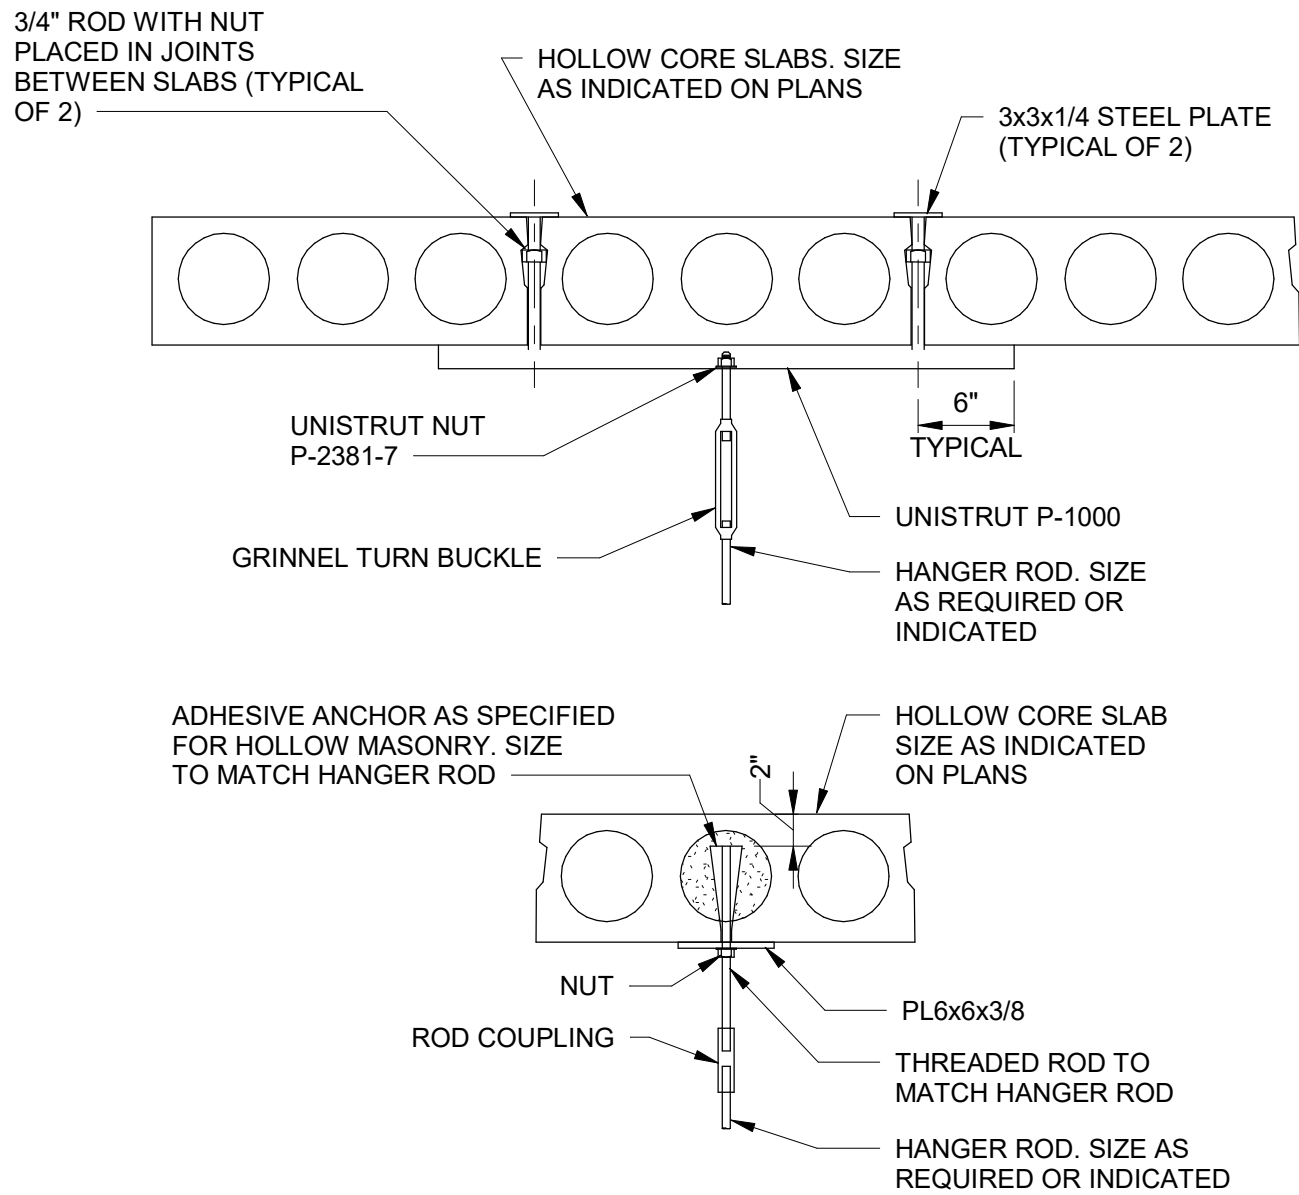


UTILITY SUPPORT DETAILS
NO SCALE

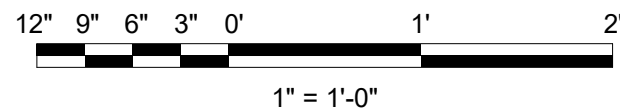


PLOTTED: 12/19/2022 4:26:29 PM
 FILE: BIM 360/1409469- Aerobic Granular Sludge Phase 1409469 - AGS.rvt
 D11000

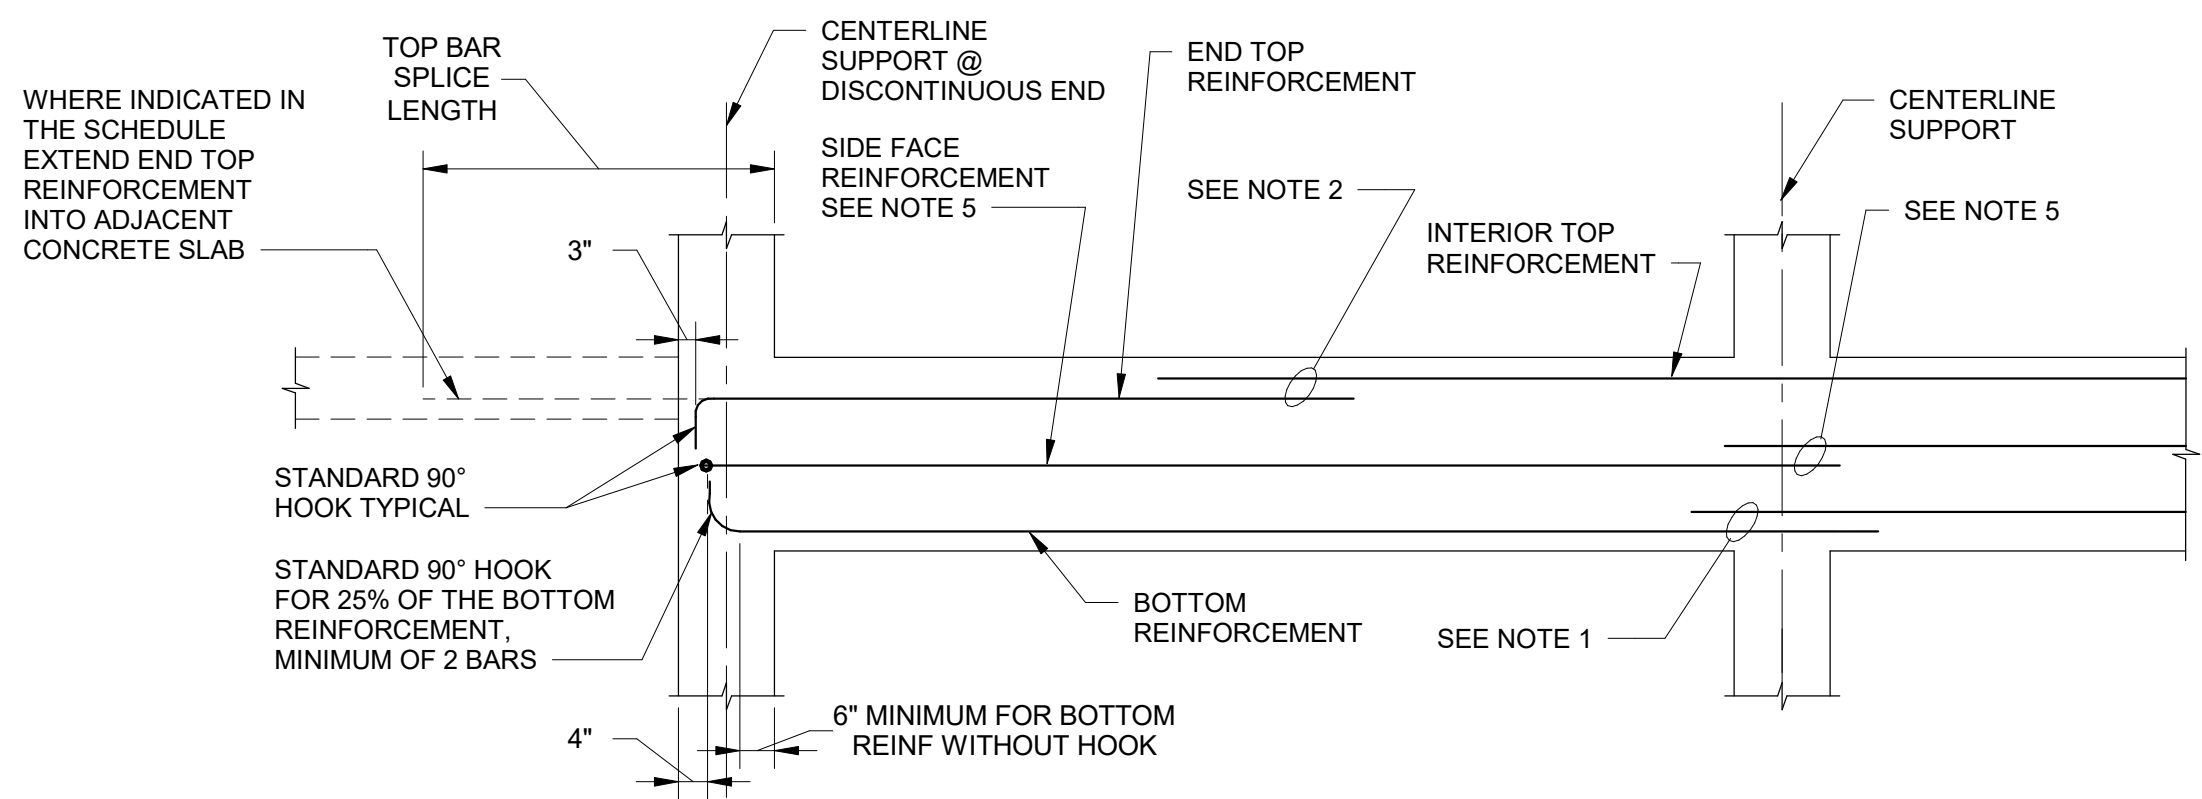


TYPE E-END SPAN

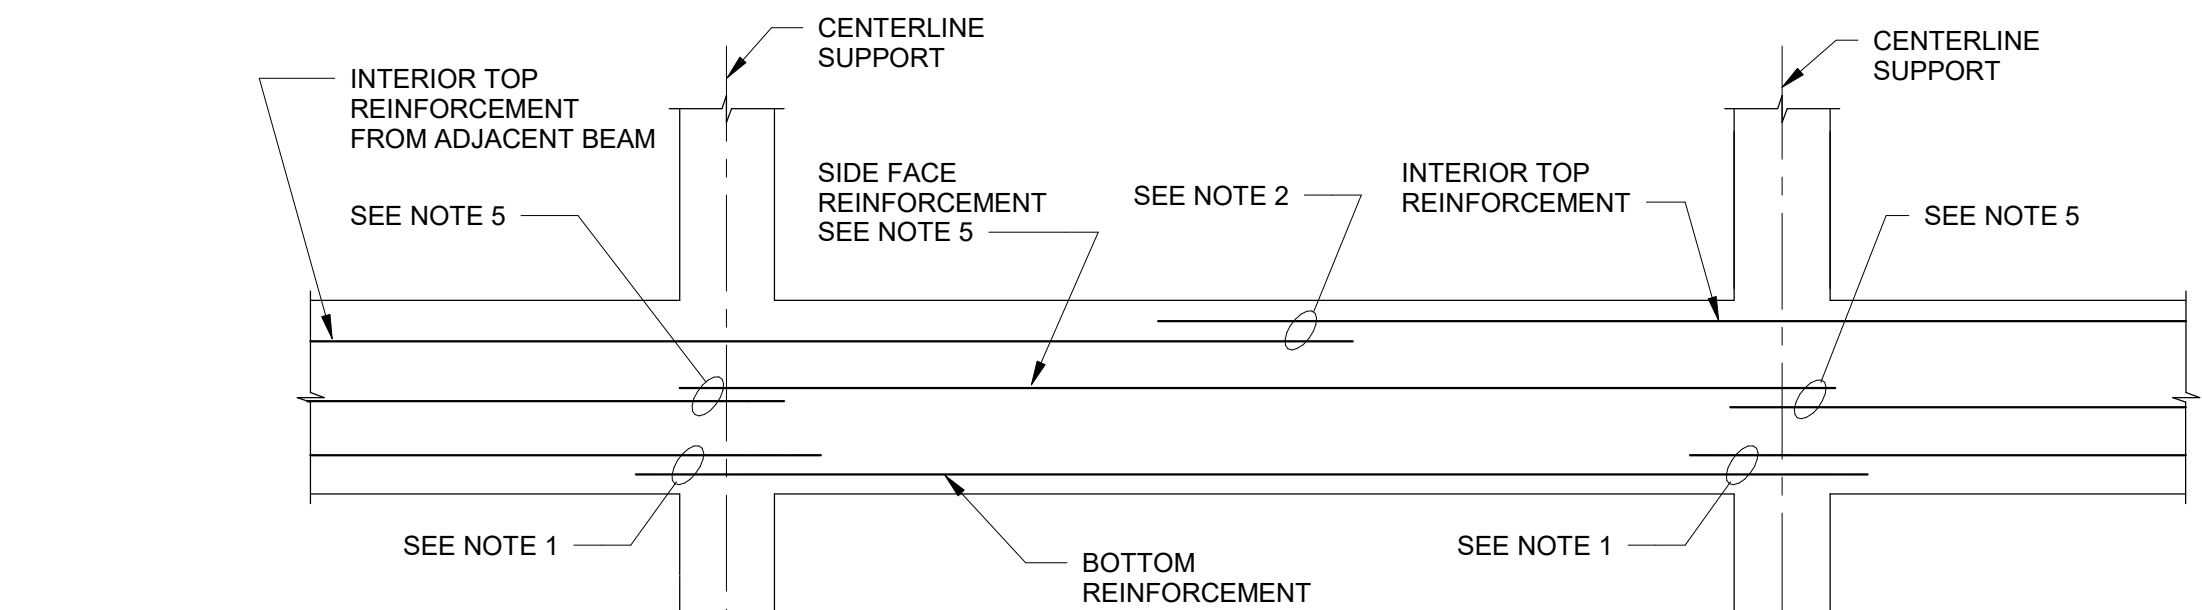


TYPE I-INTERIOR SPAN

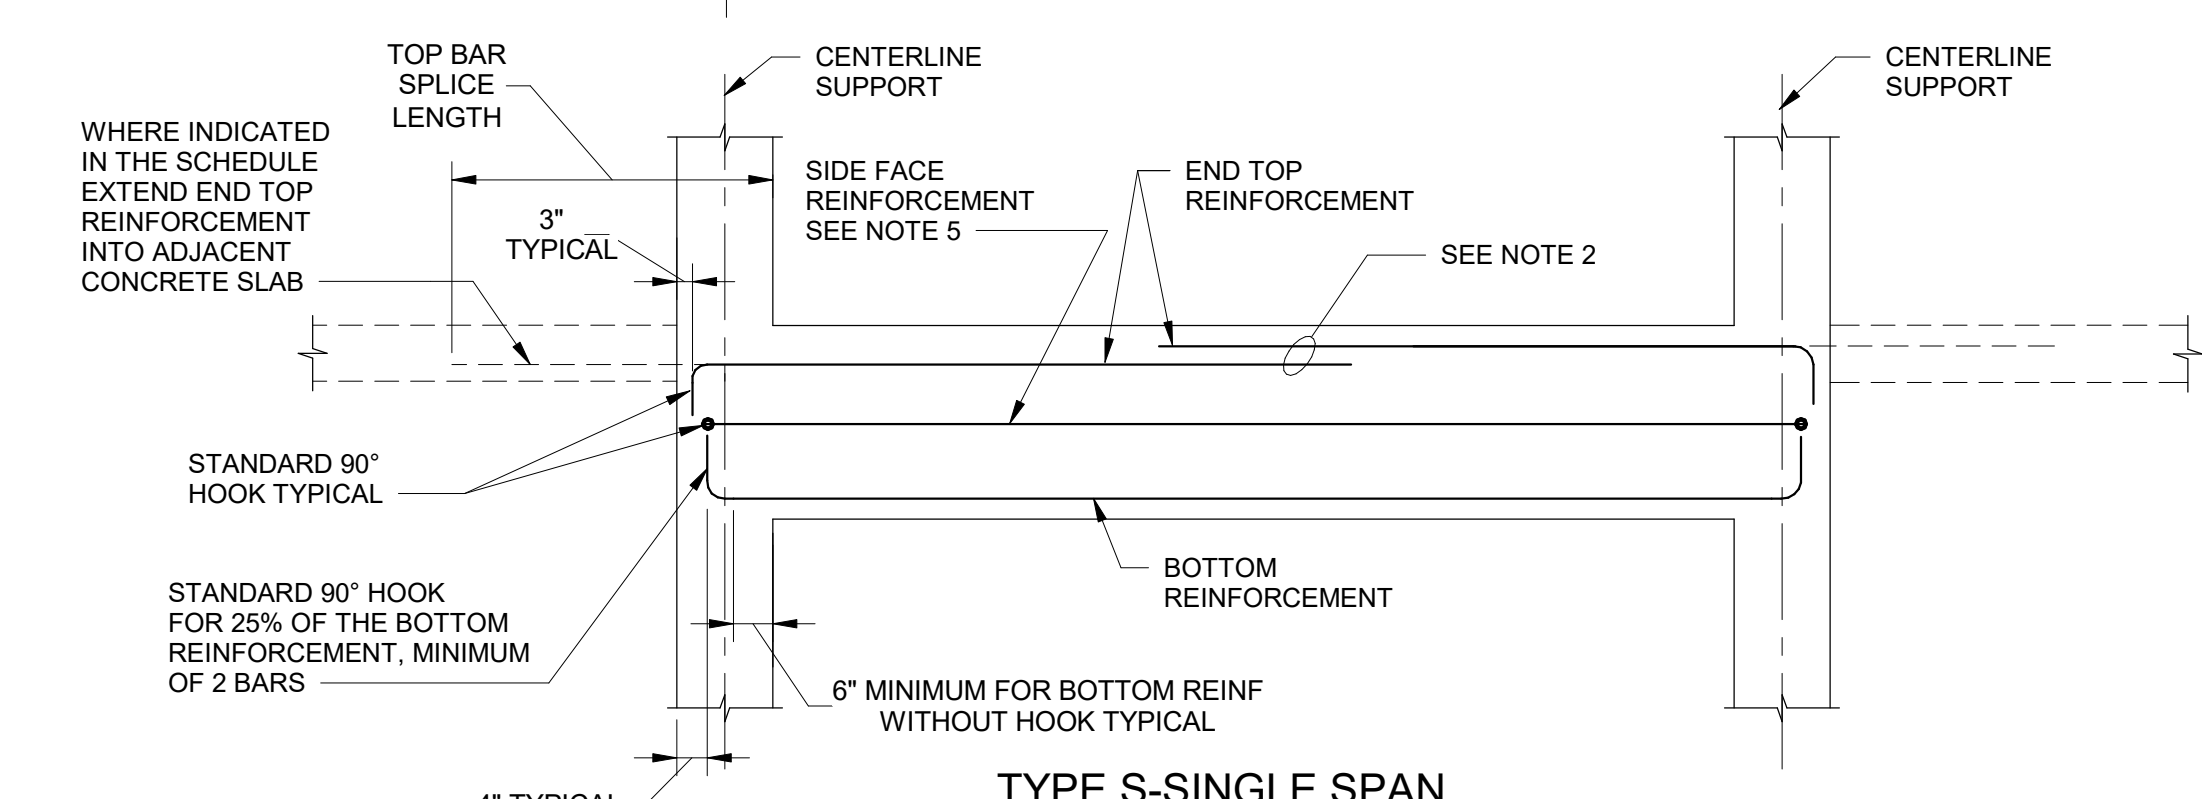


TYPE S-SINGLE SPAN

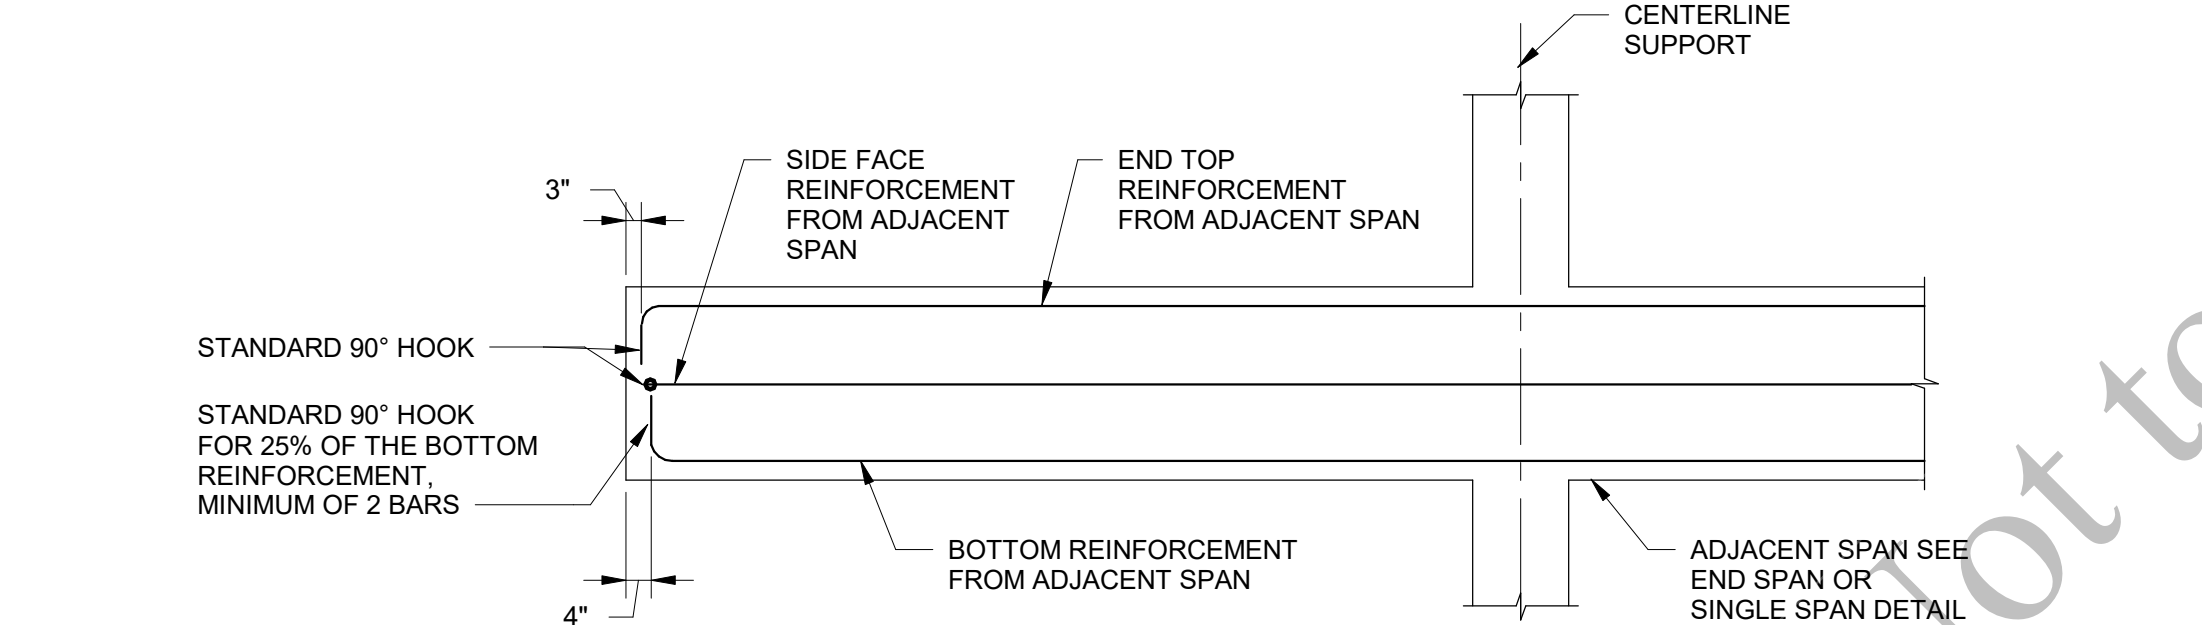


TYPE C-CANTILEVER SPAN

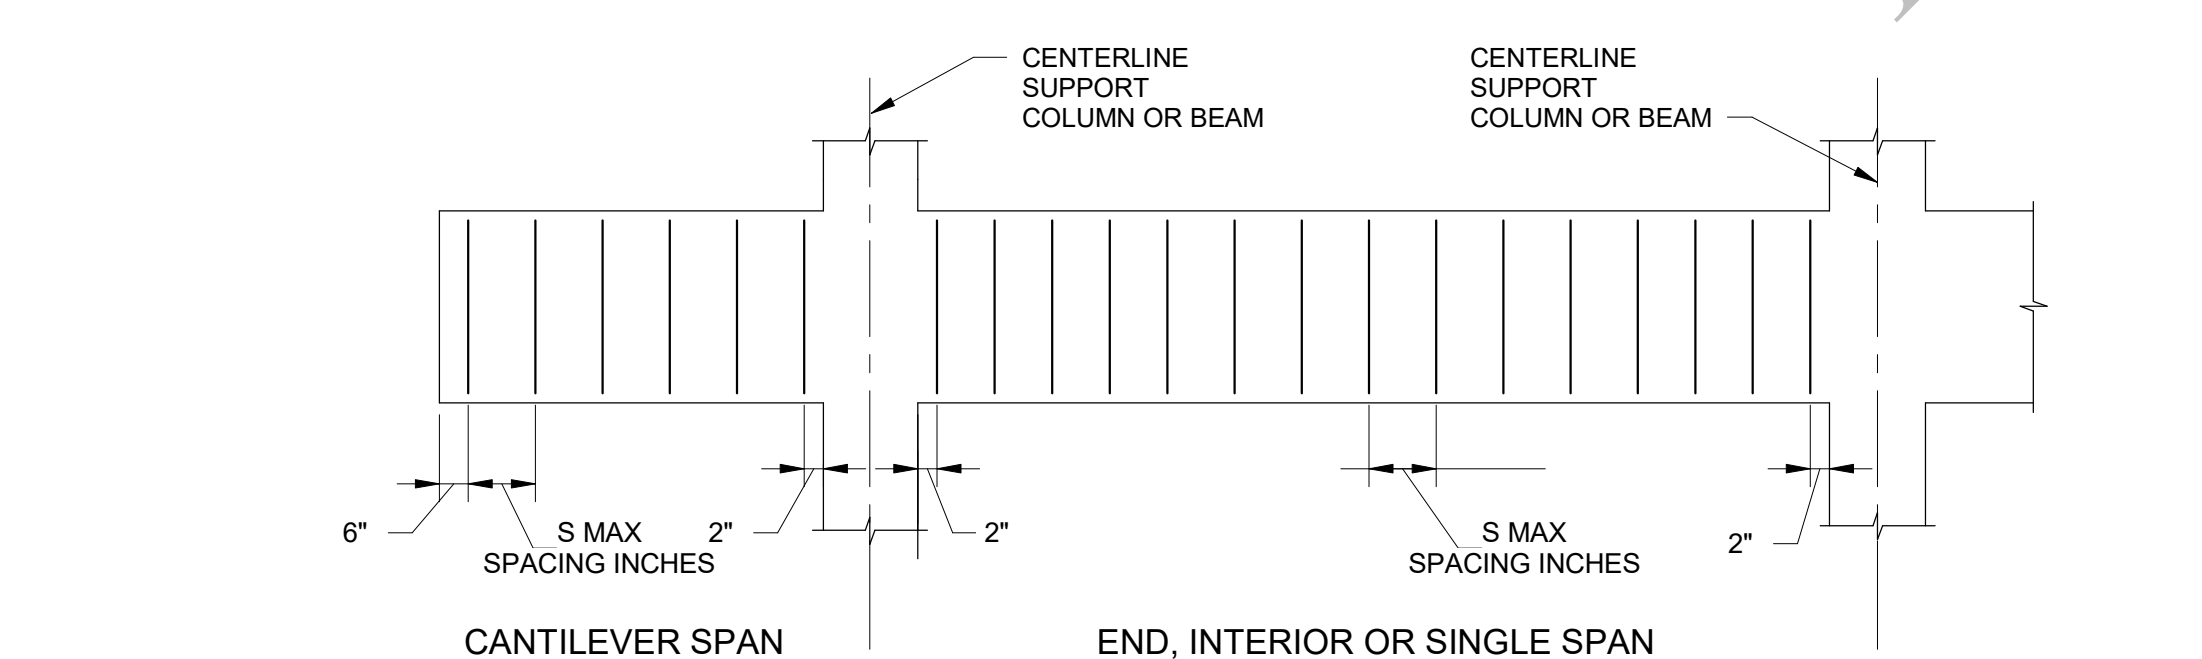


STIRRUP SPACING LAYOUT

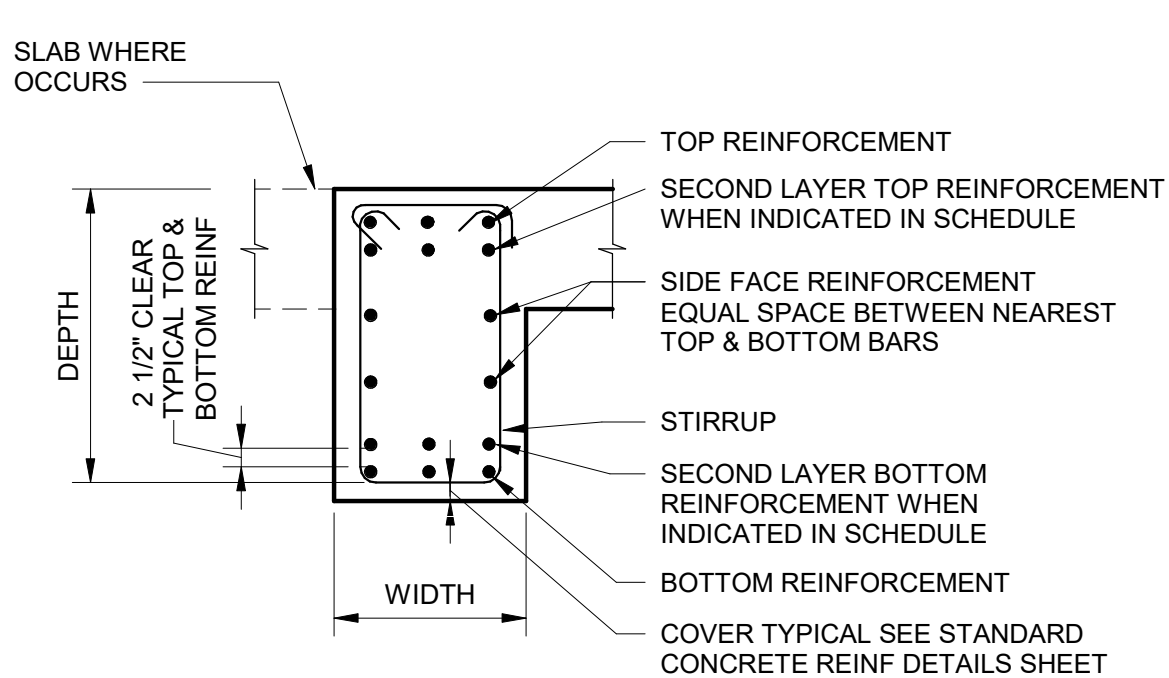

TYPICAL BEAM SECTION

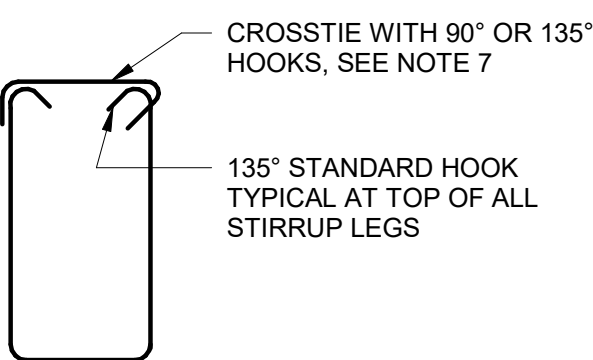


TYPE SA

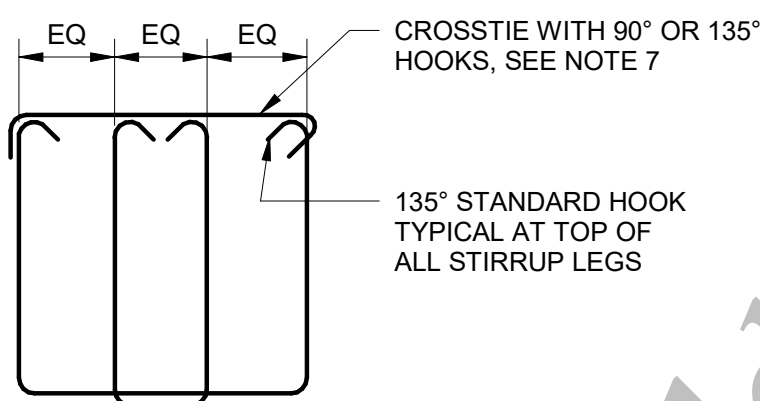


TYPE SB

STIRRUP DETAILS

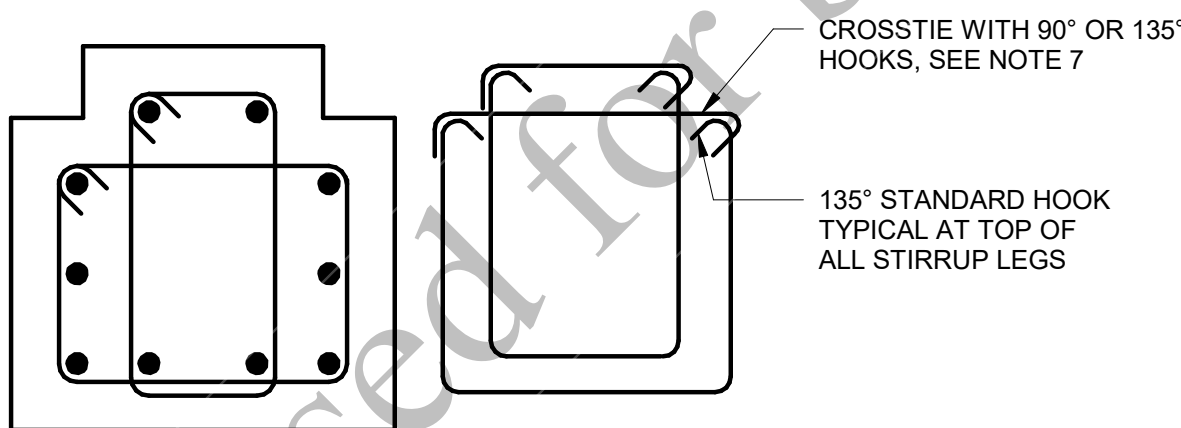

TYPICAL SECTION FOR BEAM B10 AND B11

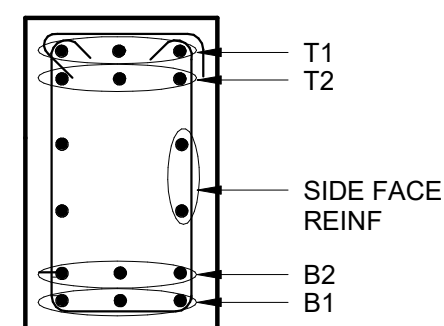

LEGEND

GENERAL SHEET NOTE:

1. WORK THIS DRAWING WITH THE STANDARD CONCRETE BEAM SCHEDULE AND NOTES SHEET.

BEAM SCHEDULE

MARK	TYPE	BEAM SIZE		BOTTOM REINF	END TOP REINF	INT TOP REINF	SIDE FACE REINF EF	STIRRUPS			REMARKS
		WIDTH	DEPTH					TYPE	SIZE	S	
AGS REACTORS AND PIPE GALLERY											
B01, B02, B05, B06 B07, B08, B09	S	24"	36"	4-#6(B1) + 2-#6(B2)	4-#6(T1) + 2-#6(T2)	4-#6(T1) + 2-#6(T2)	2-#5	SB	#4	12"	TOP AND BOTTOM TWO LAYERS
B03, B04	S	18"	24"	3-#6(B1) + 3-#6(B2)	3-#6(T1) + 3-#6(T2)	3-#6(T1) + 3-#6(T2)	2-#5	SB	#4	6"	TOP AND BOTTOM TWO LAYERS
B10	S	18"	24"	4-#6	2-#6(T1) + 2-#6(T2)	2-#6(T1) + 2-#6(T2)	2-#5	SB	#4	6"	TOP TWO LAYERS
B11	S	20"	24"	4-#6	2-#6(T1) + 2-#6(T2)	2-#6(T1) + 2-#6(T2)	2-#5	SB	#4	6"	TOP TWO LAYERS

BEAM SCHEDULE NOTES:

- UNLESS INDICATED OTHERWISE IN BEAM SCHEDULE, BOTTOM REINFORCEMENT SHALL HAVE LAP SPLICES CENTERED ON THE CENTERLINE OF THE SUPPORT USING THE LAP SPLICE LENGTH INDICATED ON THE STANDARD CONCRETE REINFORCING DETAILS SHEET. USE THE LAP SPLICE REQUIREMENT OF THE SMALLER BOTTOM BAR IF BAR SIZES IN ADJACENT SPANS DIFFER. AT THE CONTRACTOR'S OPTION, BOTTOM REINFORCEMENT MAY BE MADE CONTINUOUS, WITHOUT SPLICING, ACROSS THE SUPPORT IF BARS IN THE ADJACENT SPAN ARE EQUAL IN SIZE AND QUANTITY.
- END AND INTERIOR TOP REINFORCEMENT SHALL BE LAPPED AT MID SPAN BETWEEN SUPPORTS USING THE LAP SPLICE LENGTH INDICATED ON THE STANDARD CONCRETE REINFORCING DETAILS SHEET. USE THE LAP SPLICE REQUIREMENT OF THE SMALLER TOP BAR, IF THE BAR SIZES EACH SIDE OF MID SPAN DIFFER. AT THE CONTRACTOR'S OPTION, TOP REINFORCEMENT MAY BE MADE CONTINUOUS, WITHOUT SPLICING, IF THE TOP BARS EACH SIDE OF MID SPAN ARE EQUAL IN SIZE AND QUANTITY.
- TOP AND BOTTOM BARS SHALL BE PLACED IN THE BEAM SECTION SUCH THAT ONE OF THE BARS IS LOCATED IN EACH CORNER OF THE BEAM STIRRUPS.
- ALL TOP AND BOTTOM BARS SHALL BE PLACED IN ONE LAYER UNLESS INDICATED OTHERWISE. WHERE MORE THAN ONE LAYER IS NOTED, PROVIDE 2.5 INCHES CLEAR BETWEEN LAYERS, AND PLACE HALF OF THE BARS IN EACH LAYER.
- SIDE FACE REINFORCEMENT SHALL BE CONTINUOUS WITH LAP SPLICES CENTERED AT THE CENTERLINE OF THE SUPPORT. A 90° STANDARD HOOK SHALL BE PROVIDED AT THE EXTERIOR ENDS OF END SPANS AND AT BOTH ENDS OF SINGLE SPANS. SIDE FACE REINFORCEMENT SHALL BE SPACED EQUALLY ON EACH FACE.
- PROVIDE MINIMUM #5 STIRRUP SUPPORT BARS IN ALL CORNERS OF STIRRUPS WHEN TOP OR BOTTOM BARS ARE NOT PRESENT. LAP #5 BARS 1'-8" MINIMUM TO SCHEDULED REINFORCEMENT.
- UNLESS INDICATED OTHERWISE, CONSECUTIVE STIRRUP CROSSTIES SHALL HAVE THEIR 90° HOOK PLACED ON OPPOSITE SIDES. IN THE EVENT THAT A SLAB FRAMES INTO ONLY ONE SIDE OF A BEAM, THEN THE 90 DEGREE HOOK SHALL BE PLACED ON THE SLAB SIDE CONSISTENTLY. IN THE EVENT A BEAM IS NOT CONFINED BY A SLAB ON EITHER SIDE, THE STIRRUP CROSSTIE SHALL HAVE TWO 135° HOOKS AND NO 90° HOOK.
- HEADED REINFORCEMENT IN ACCORDANCE WITH ACI 318 MAY BE USED INSTEAD OF STD. HOOKS.
- ABBREVIATIONS USED:
CL = CENTERLINE
EF = EACH FACE
INT = INTERIOR
STD = STANDARD
TYP = TYPICAL
DEG = DEGREE
EQ = EQUAL
REINF = REINFORCEMENT



Black & Veatch Corporation
Chicago, Illinois
ILLINOIS PROFESSIONAL
DESIGN FIRM - 184.002143-0006



AEROBIC GRANULAR
SLUDGE - PHASE 1

REVISIONS AND RECORD OF ISSUE	
DESIGNED:	SKA
DETAILED:	UBS
CHECKED:	CG
APPROVED:	TNG
DATE:	12/20/2022
PROJECT NO.:	411752

DETAILS

STRUCTURAL

STANDARD CONCRETE
BEAM AND SLAB
SCHEDULE AND DETAILS

99-S-511

141
OF
163

(SCALE BAR IS 4" AT FULL SCALE) 0 1/2 1 2 3 4

REVISIONS AND RECORD OF ISSUE	
DESIGNED:	SKA
DETAILED:	UBS
CHECKED:	CG
APPROVED:	TNG
DATE:	12/20/2022
PROJECT NO.:	411752

DETAILS

STRUCTURAL

MISCELLANEOUS
DETAILS


99-S-512

142
OF
163


GRATING THICKNESS 'T'	L SIZE AxAx1/4 INCHES	L SIZE 'B' INCHES	'C' ANCHOR DIA MIN 'E'	
1"	1 3/4 x 1 3/4"	2 1/2x2 1/2x1/4	1/2"	3 1/4"
1 1/4"	1 3/4 x 1 3/4"	2 1/2x2 1/2x1/4	1/2"	3 1/4"
1 1/2"	1 3/4 x 1 3/4	2 1/2x2 1/2x1/4	1/2"	3 1/4"
1 3/4"	2x2	3x3x3/8	3/4"	4 3/4"
2"	2 1/2x2 1/2"	3x3x3/8	3/4"	4 3/4"
2 1/4"	2 1/2x2 1/2	3x3x3/8	3/4"	4 3/4"
2 1/2"	3x3"	3x3x3/8	3/4"	4 3/4"

* TRIM AND BEVEL UPSTANDING LEG TO FIT

NOTE:
1. ALL GRATING SUPPORTED ON CONCRETE SHALL HAVE AN EMBEDDED ANGLE RECESSED AS SHOWN UNLESS NOTED OTHERWISE. GRATING SUPPORTED BY THE FACE MOUNTED ANGLE SHALL BE USED WHERE THE CONCRETE EXTENDS ABOVE THE TOP OF THE GRATING OR AT EXISTING STRUCTURES.

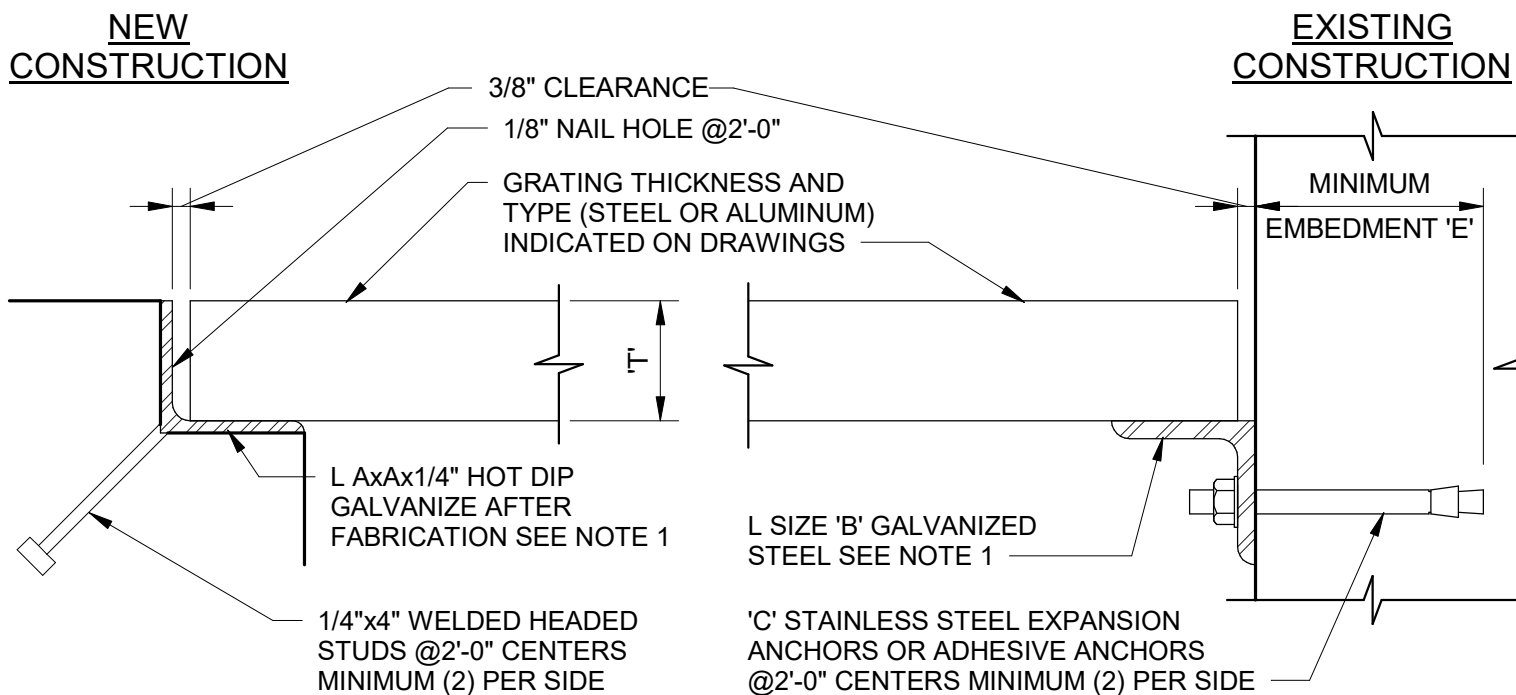


A GRATING SUPPORT
3\"/>

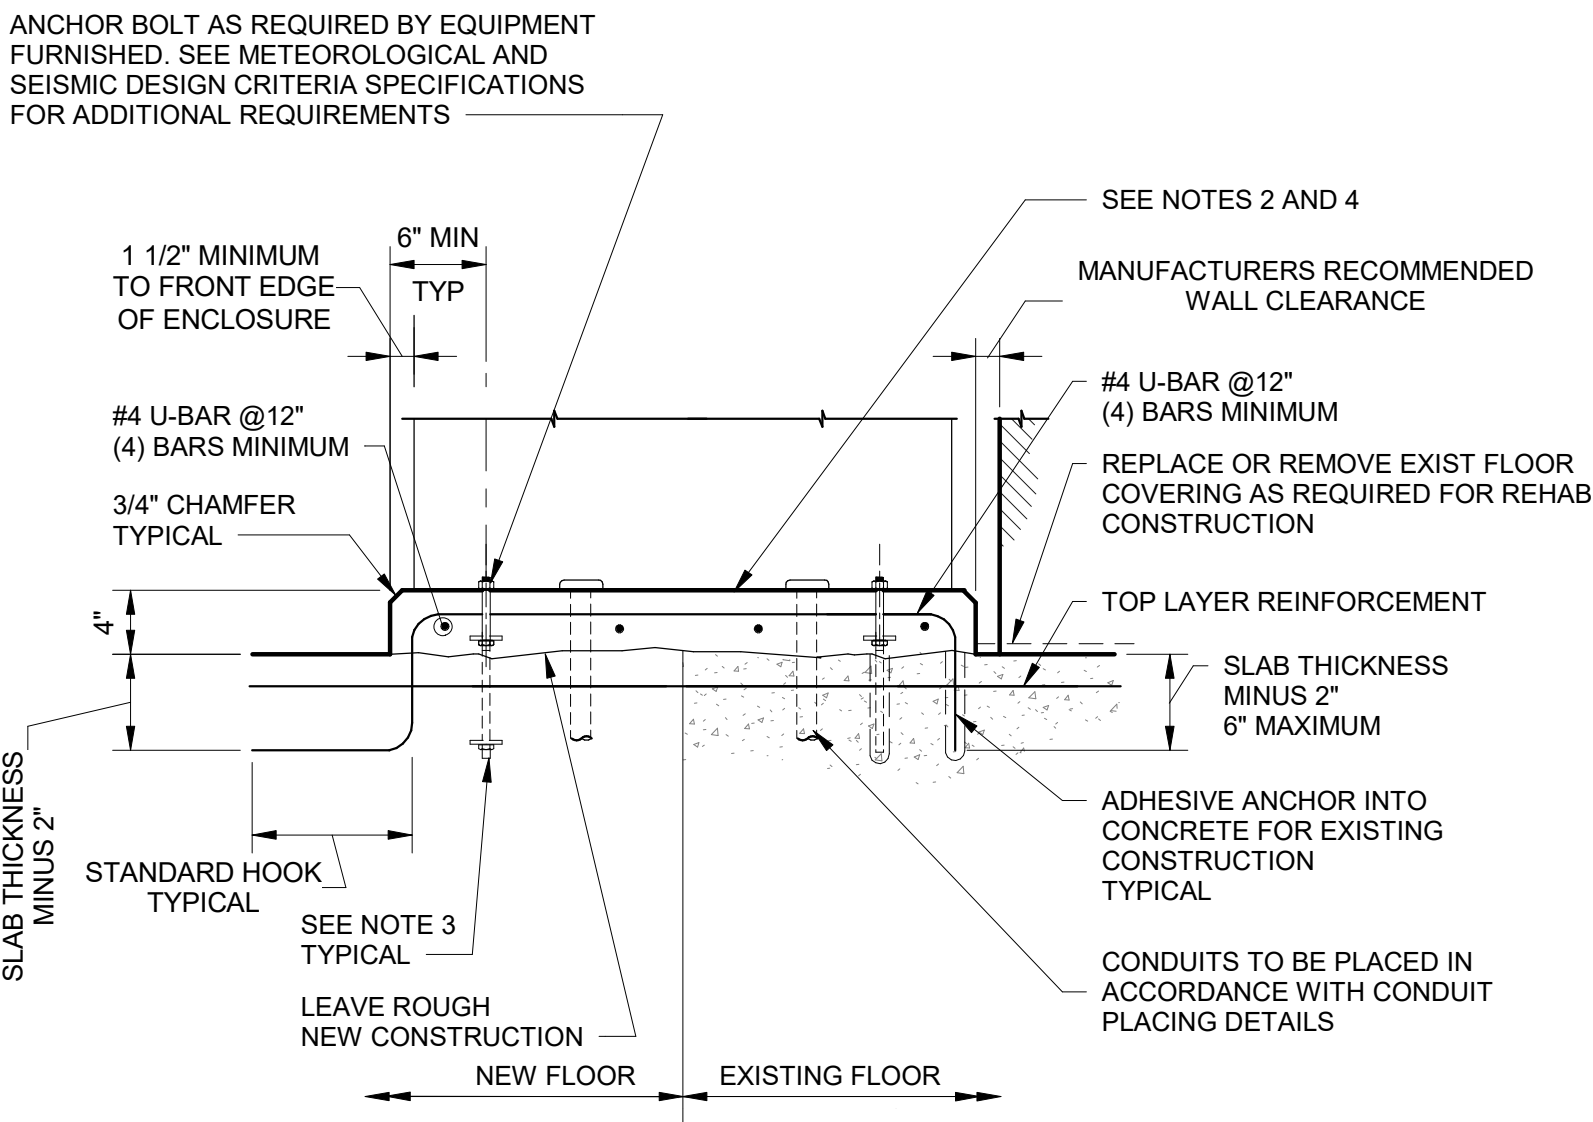


NOTES:

- UNLESS OTHERWISE NOTED, ALL INDOOR FLOOR MOUNTED ELECTRICAL EQUIPMENT, INCLUDING SWITCHGEAR, SWITCHBOARDS, MOTOR CONTROL CENTERS, ADJUSTABLE FREQUENCY DRIVES, INSTRUMENT CABINETS, ECT., SHALL BE PROVIDED WITH EQUIPMENT BASES.
- CONTRACTOR AND SUPPLIER SHALL COORDINATE FINAL LOCATION AND SIZE OF PADS WITH EQUIPMENT FURNISHED. COORDINATE ANCHOR BOLT REQUIREMENTS FOR REQUIRED EMBEDMENT DEPTHS AND CONCRETE EDGE DISTANCES.
- WHERE THE DESIGN ANCHOR BOLT EMBEDMENT IS GREATER THAN THE CONCRETE EQUIPMENT BASE THICKNESS, THEN THE REQUIRED DEPTH OF EMBEDMENT SHALL BE MEASURED FROM THE TOP OF STRUCTURAL SLAB AND NOT THE TOP OF THE EQUIPMENT BASE.
- EQUIPMENT BASE SHALL USE STRUCTURAL CONCRETE AS INDICATED IN THE CAST-IN-PLACE CONCRETE SPECIFICATION.
- ANCHOR BOLTS AND REINFORCING WILL BE INSPECTED IN ACCORDANCE WITH THE CODE REQUIRED SPECIAL INSPECTIONS AND PROCEDURES SPECIFICATION.


B ELECTRICAL EQUIPMENT BASE
1\"/>

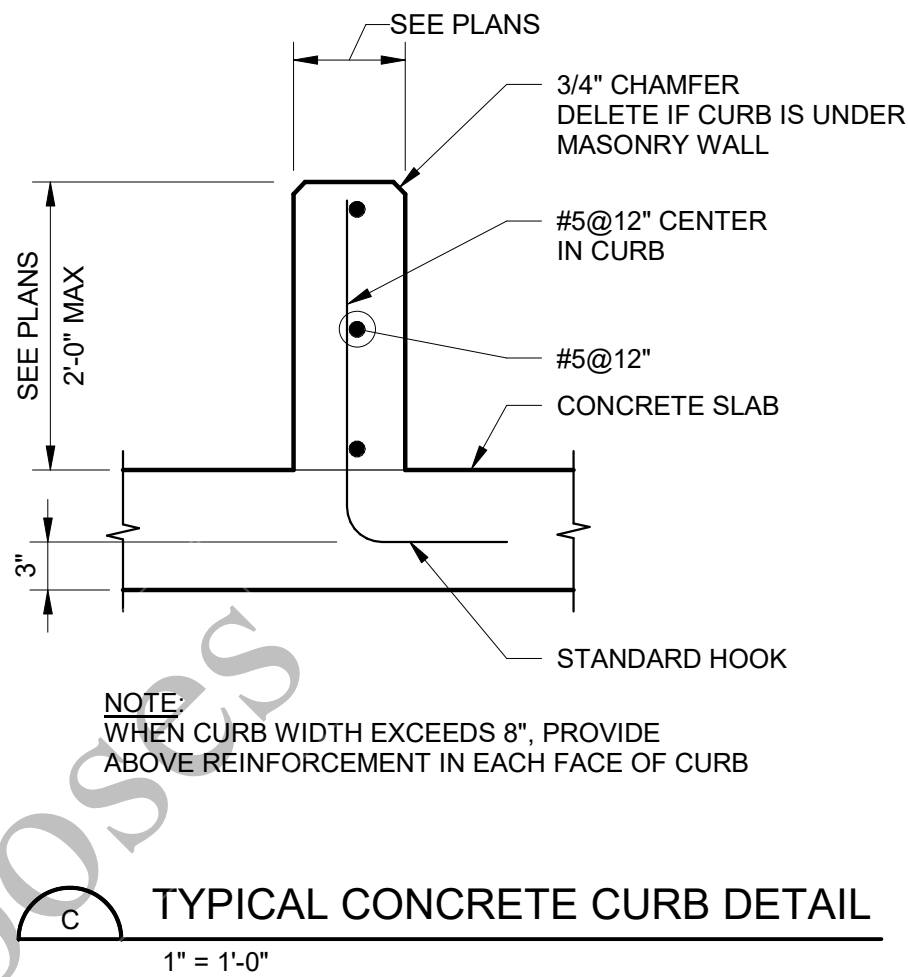

C TYPICAL CONCRETE CURB DETAIL
1\"/>

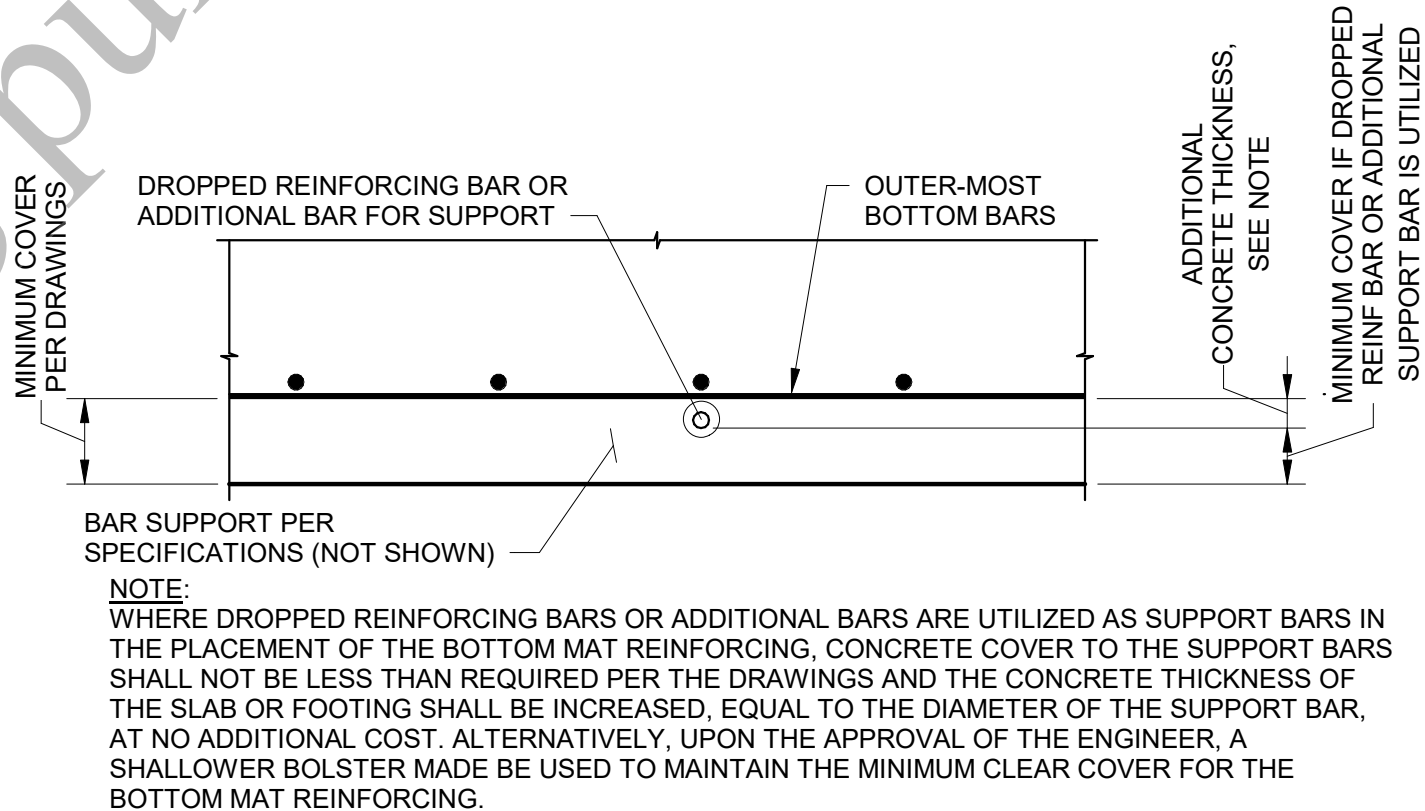

D REINFORCING SUPPORT DETAIL
1\"/>

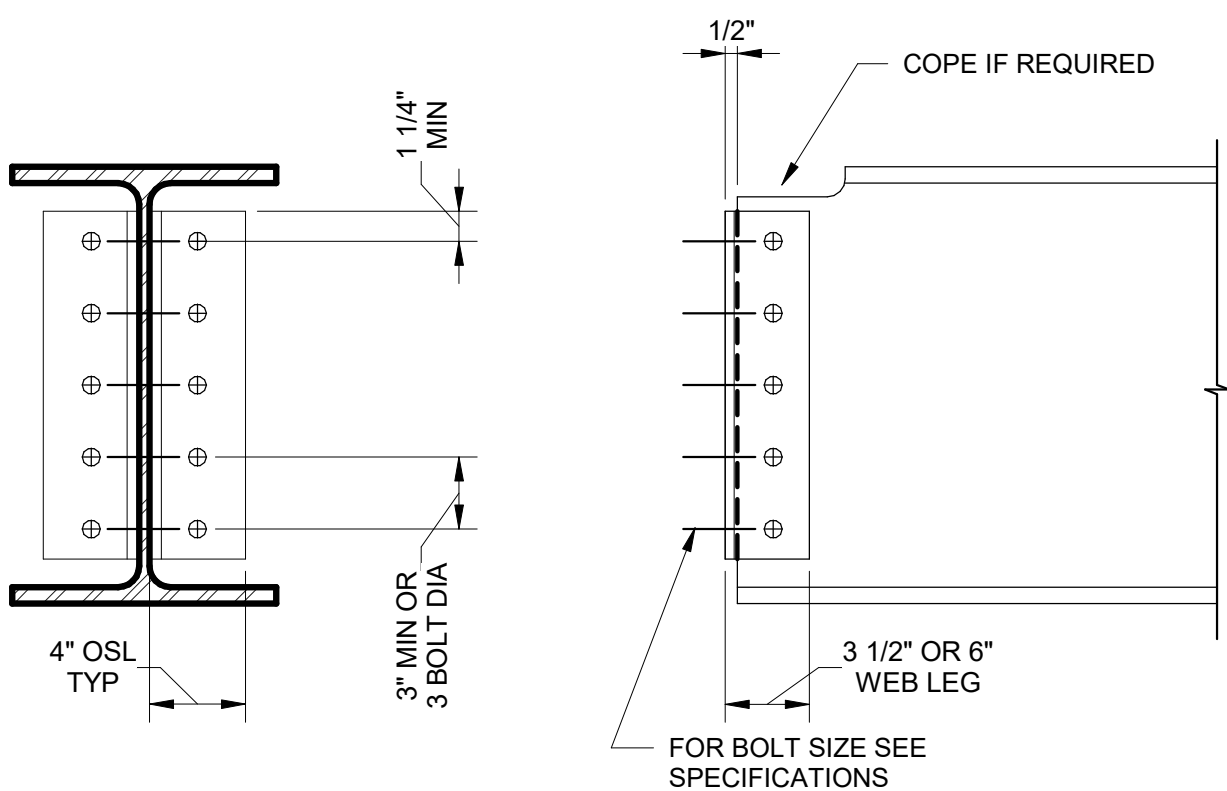


E STANDARD STEEL FRAMING CONNECTION DETAILS
NO SCALE


SHOP BOLTED - FIELD BOLTED		
BEAM SIZE (ALL WEIGHTS)	NO OF BOLTS	
	OSL	IN WEB
W36	20	10
W33	18	9
W30	16	8
W27	14	7
W24 & S24	12	6
W21 & S20	10	5
W16 & W18, S15 & S18, C15, MC18	8	4
W12 & W14, M12 & M14, S12, C12, MC12 & MC13	6	3
W8 & W10, M8 & M10, S8 & S10 C8, C9 & C10, MC8, MC9 & MC10	4	2
W6, M6, S6 & S7 C6 & C7, MC6 & MC7	2	2
		ANGLE SIZE
W36		2L'S 4x3 1/2x3/8
W33		2L'S 4x3 1/2x3/8
W30		2L'S 4x3 1/2x3/8
W27		2L'S 4x3 1/2x3/8
W24 & S24		2L'S 4x3 1/2x3/8
W21 & S20		2L'S 4x3 1/2x3/8
W16 & W18, S15 & S18, C15, MC18		2L'S 4x3 1/2x3/8
W12 & W14, M12 & M14, S12, C12, MC12 & MC13		2L'S 4x3 1/2x3/8
W8 & W10, M8 & M10, S8 & S10 C8, C9 & C10, MC8, MC9 & MC10		2L'S 4x3 1/2x3/8
W6, M6, S6 & S7 C6 & C7, MC6 & MC7		2L'S 6x4x3/8

SHOP WELDED - FIELD BOLTED		
BEAM SIZE (ALL WEIGHTS)	NO OF BOLTS	
	IN OSL	
W36	20	2L'S 4x3x3/8
W33	18	2L'S 4x3x3/8
W30	16	2L'S 4x3x3/8
W27	14	2L'S 4x3x3/8
W24 & S24	12	2L'S 4x3x3/8
W21 & S20	10	2L'S 4x3x3/8
W16 & W18, S15 & S18, C15, MC18	8	2L'S 4x3x3/8
W12 & W14, M12 & M14, S12, C12, MC12 & MC13	6	2L'S 4x3x3/8
W8 & W10, M8 & M10, S8 & S10 C8, C9 & C10, MC8, MC9 & MC10	4	2L'S 4x3x3/8
W6, M6, S6 & S7 C6 & C7, MC6 & MC7	2	2L'S 4x3x3/8


NOTE: FABRICATOR SHALL PROVIDE ADDITIONAL CLIPS, SEATS, BOLTS, ETC AS REQUIRED TO COMPLY WITH OSHA SAFETY STANDARDS FOR STEEL ERECTION.
OSL = OUTSTANDING LEG

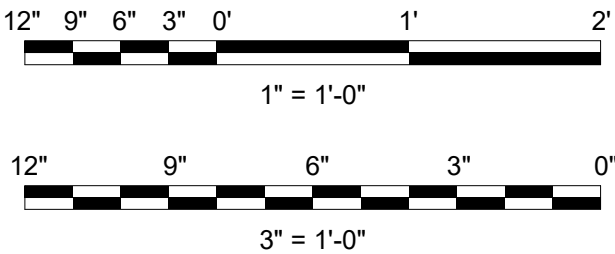

(SCALE BAR IS 4\"/>

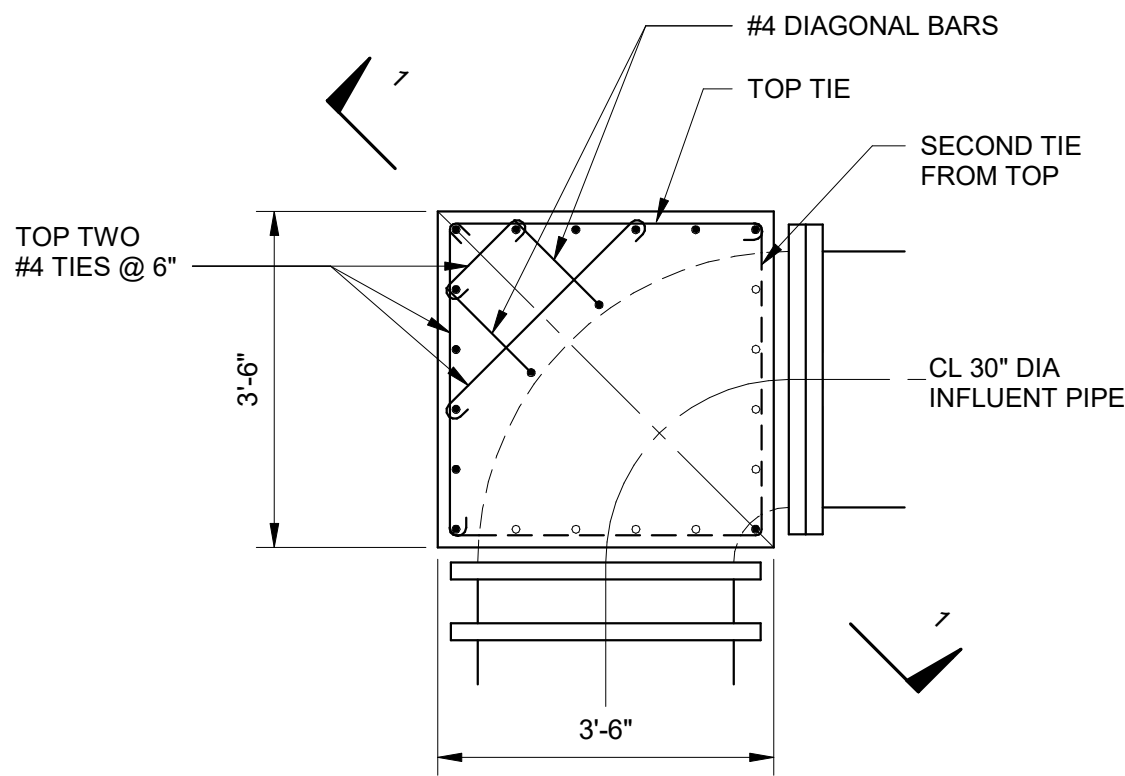


PLAN AT PIPE BEARING

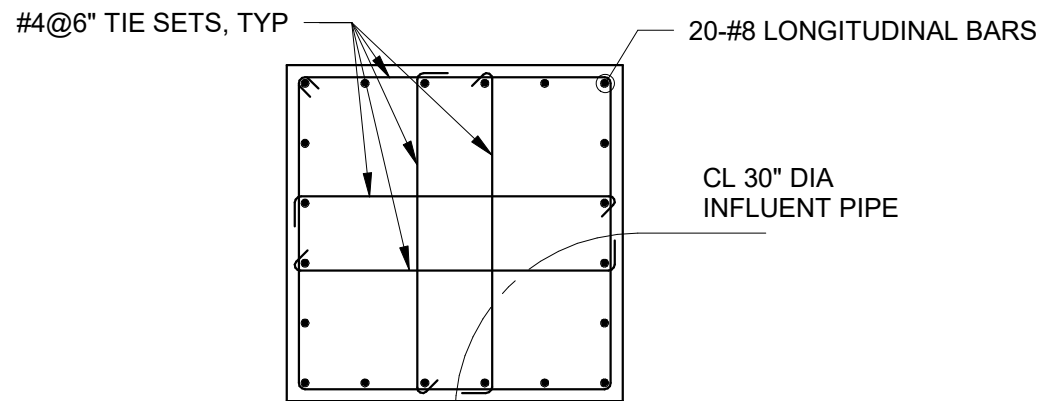


PLAN BELOW PIPE BEARING

30" INFLUENT PIPE THRUST BLOCK DETAILS (PS-6)
1/2" = 1'-0"

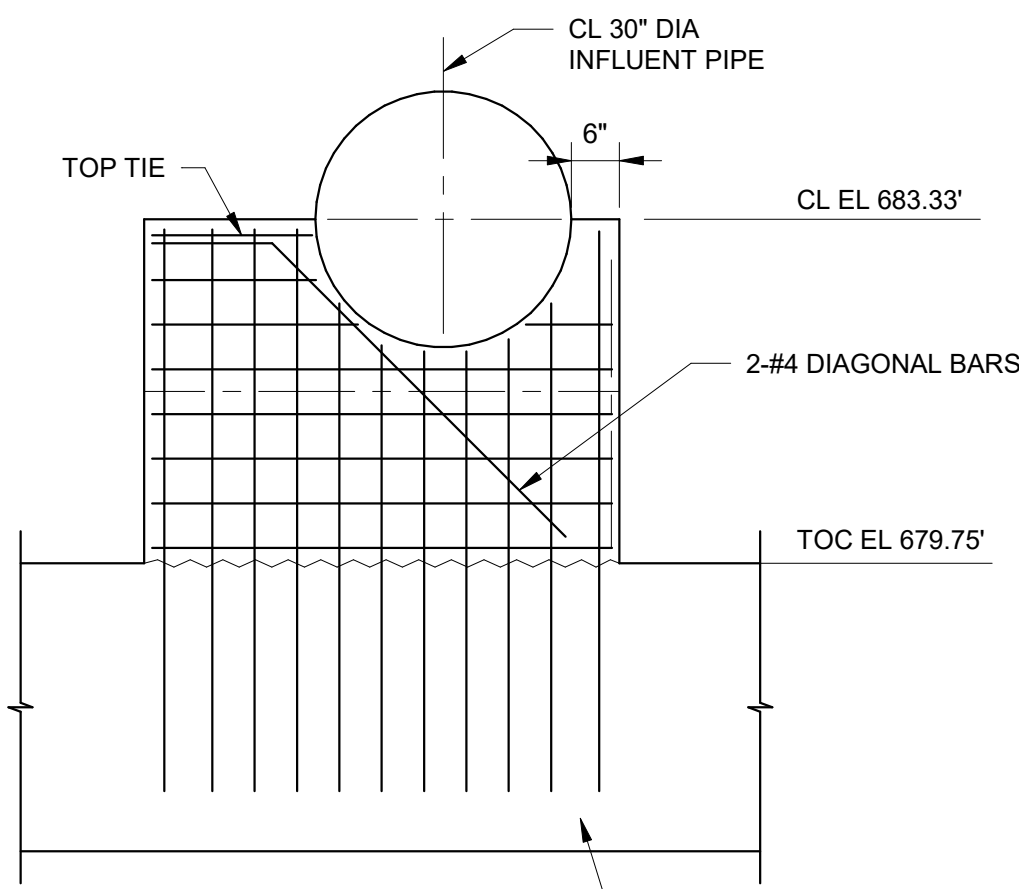

SECTION 1-1

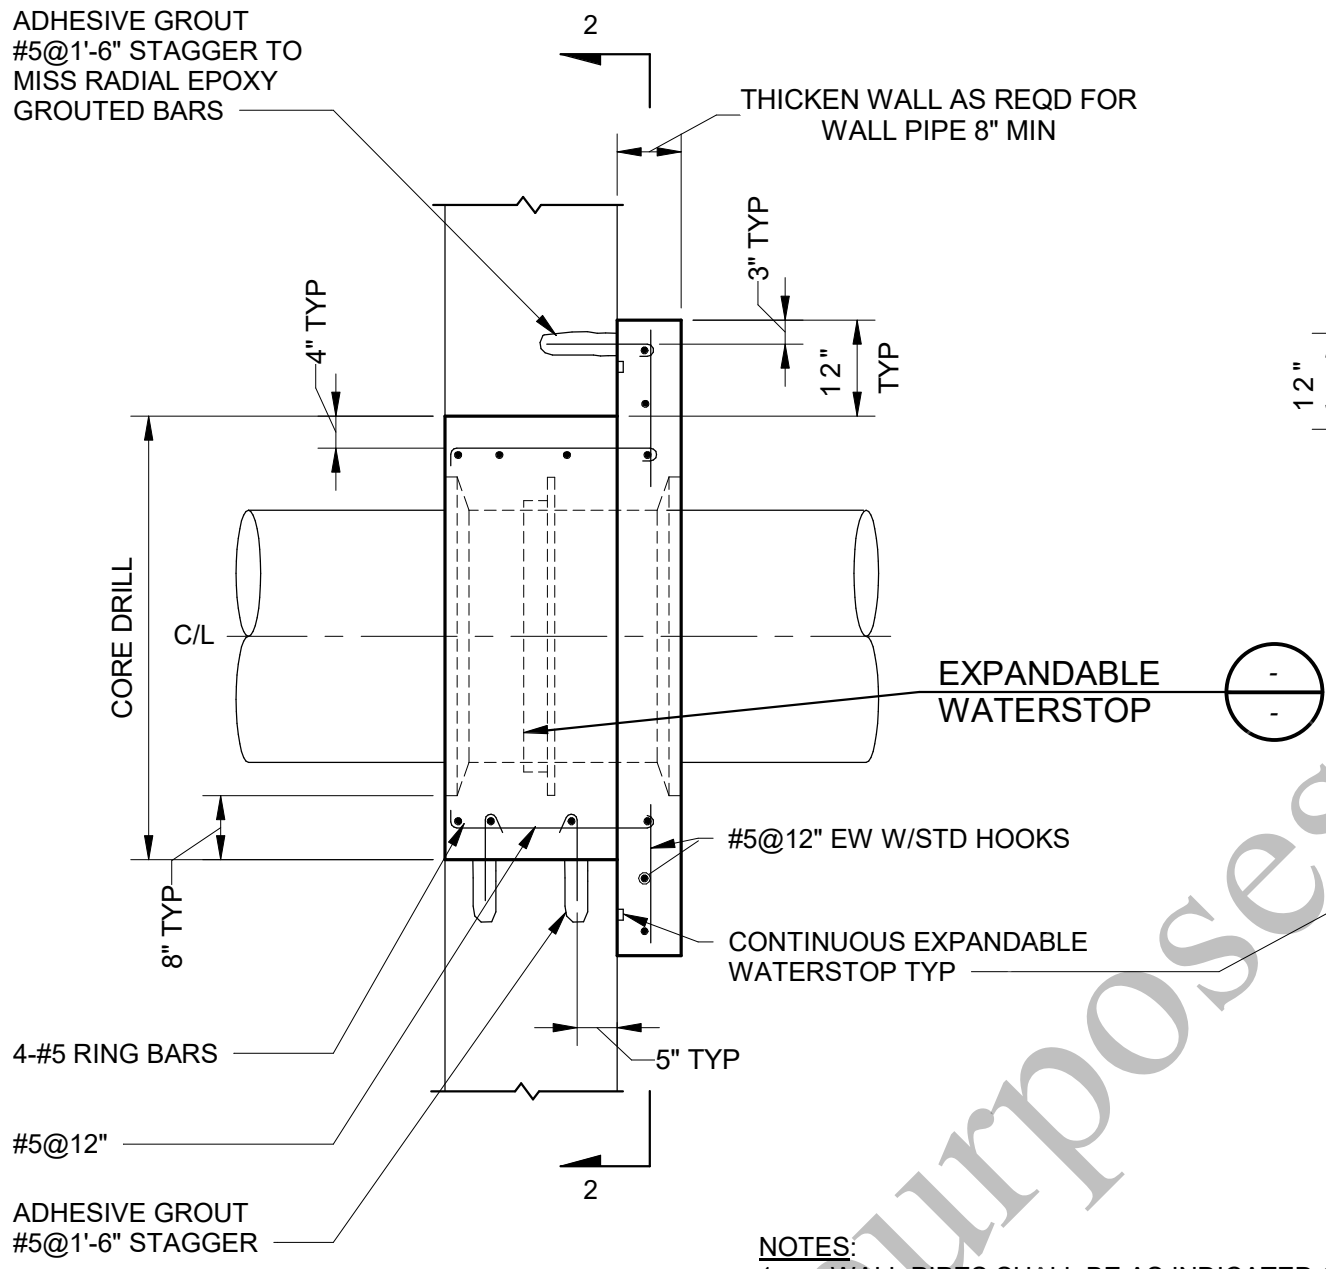



- NOTES:
1. WALL PIPES SHALL BE AS INDICATED ON PLANS.
 2. WHERE PIPE IS REQUIRED ON ONE SIDE ONLY, PROVIDE MJ X PE WALL PIPE.
 3. WALL PIPE MATERIAL SHALL BE DUCTILE IRON OR STEEL AS INDICATED ON DRAWINGS.
 4. FOR BURIED PIPING, CONTRACTOR SHALL PROVIDE AN ADDITIONAL FIELD JOINT AS CLOSE AS PRACTICAL TO FACE OF WALL, BUT NO MORE THAN 5 FEET.
 5. USE WAX TAPE TO PROTECT ALL BURIED FERROUS SURFACES INCLUDING PAINTED SURFACES. FOR PROTECTION OF ADJACENT PIPE BARREL SURFACES, SHRINK WRAP MAY BE USED IN LIEU OF WAX TAPE. SEE SPECIFICATIONS.

EXISTING WALL PENETRATION
1/2" = 1'-0"

GENERAL SHEET NOTE:

1. PS-X REPRESENT PIPE SUPPORT TYPE. FOR PIPE SUPPORT SCHEDULE, SEE SHEET 99-M-502. SEE MECHANICAL PIPING SHEETS FOR PIPE SUPPORT TYPE AND LOCATIONS.

SECTION 2-2

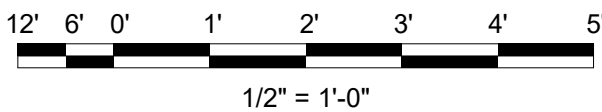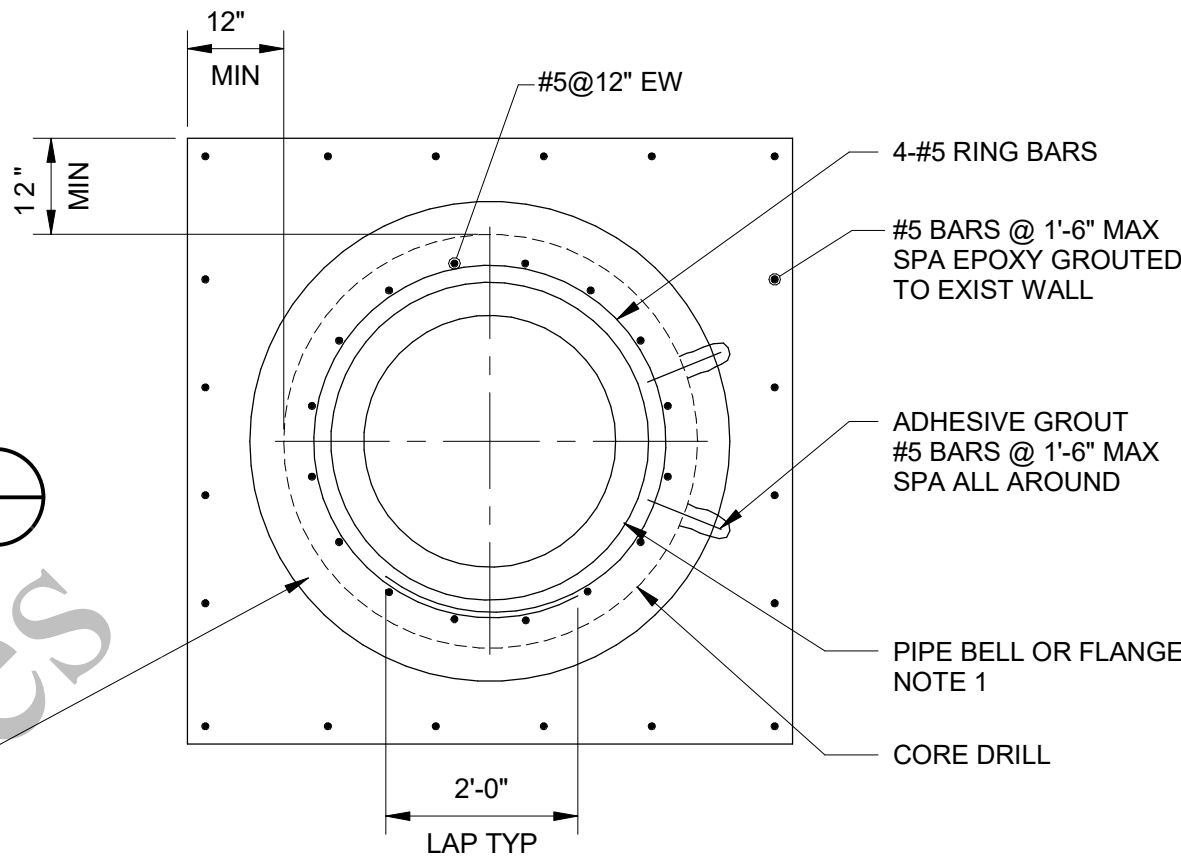

(SCALE BAR IS 4" AT FULL SCALE) 0 1/2 1 2 3 4



Black & Veatch Corporation
Chicago, Illinois
ILLINOIS PROFESSIONAL
DESIGN FIRM - 184.002143-0006



AEROBIC GRANULAR
SLUDGE - PHASE 1

REVISIONS AND RECORD OF ISSUE	
DESIGNED:	SKA
DETAILED:	UBS
CHECKED:	CG
APPROVED:	TNG
DATE:	12/20/2022
PROJECT NO.:	411752


DETAILS

STRUCTURAL


PIPE SUPPORT DETAILS
2 OF 4

99-S-514


144
OF
163

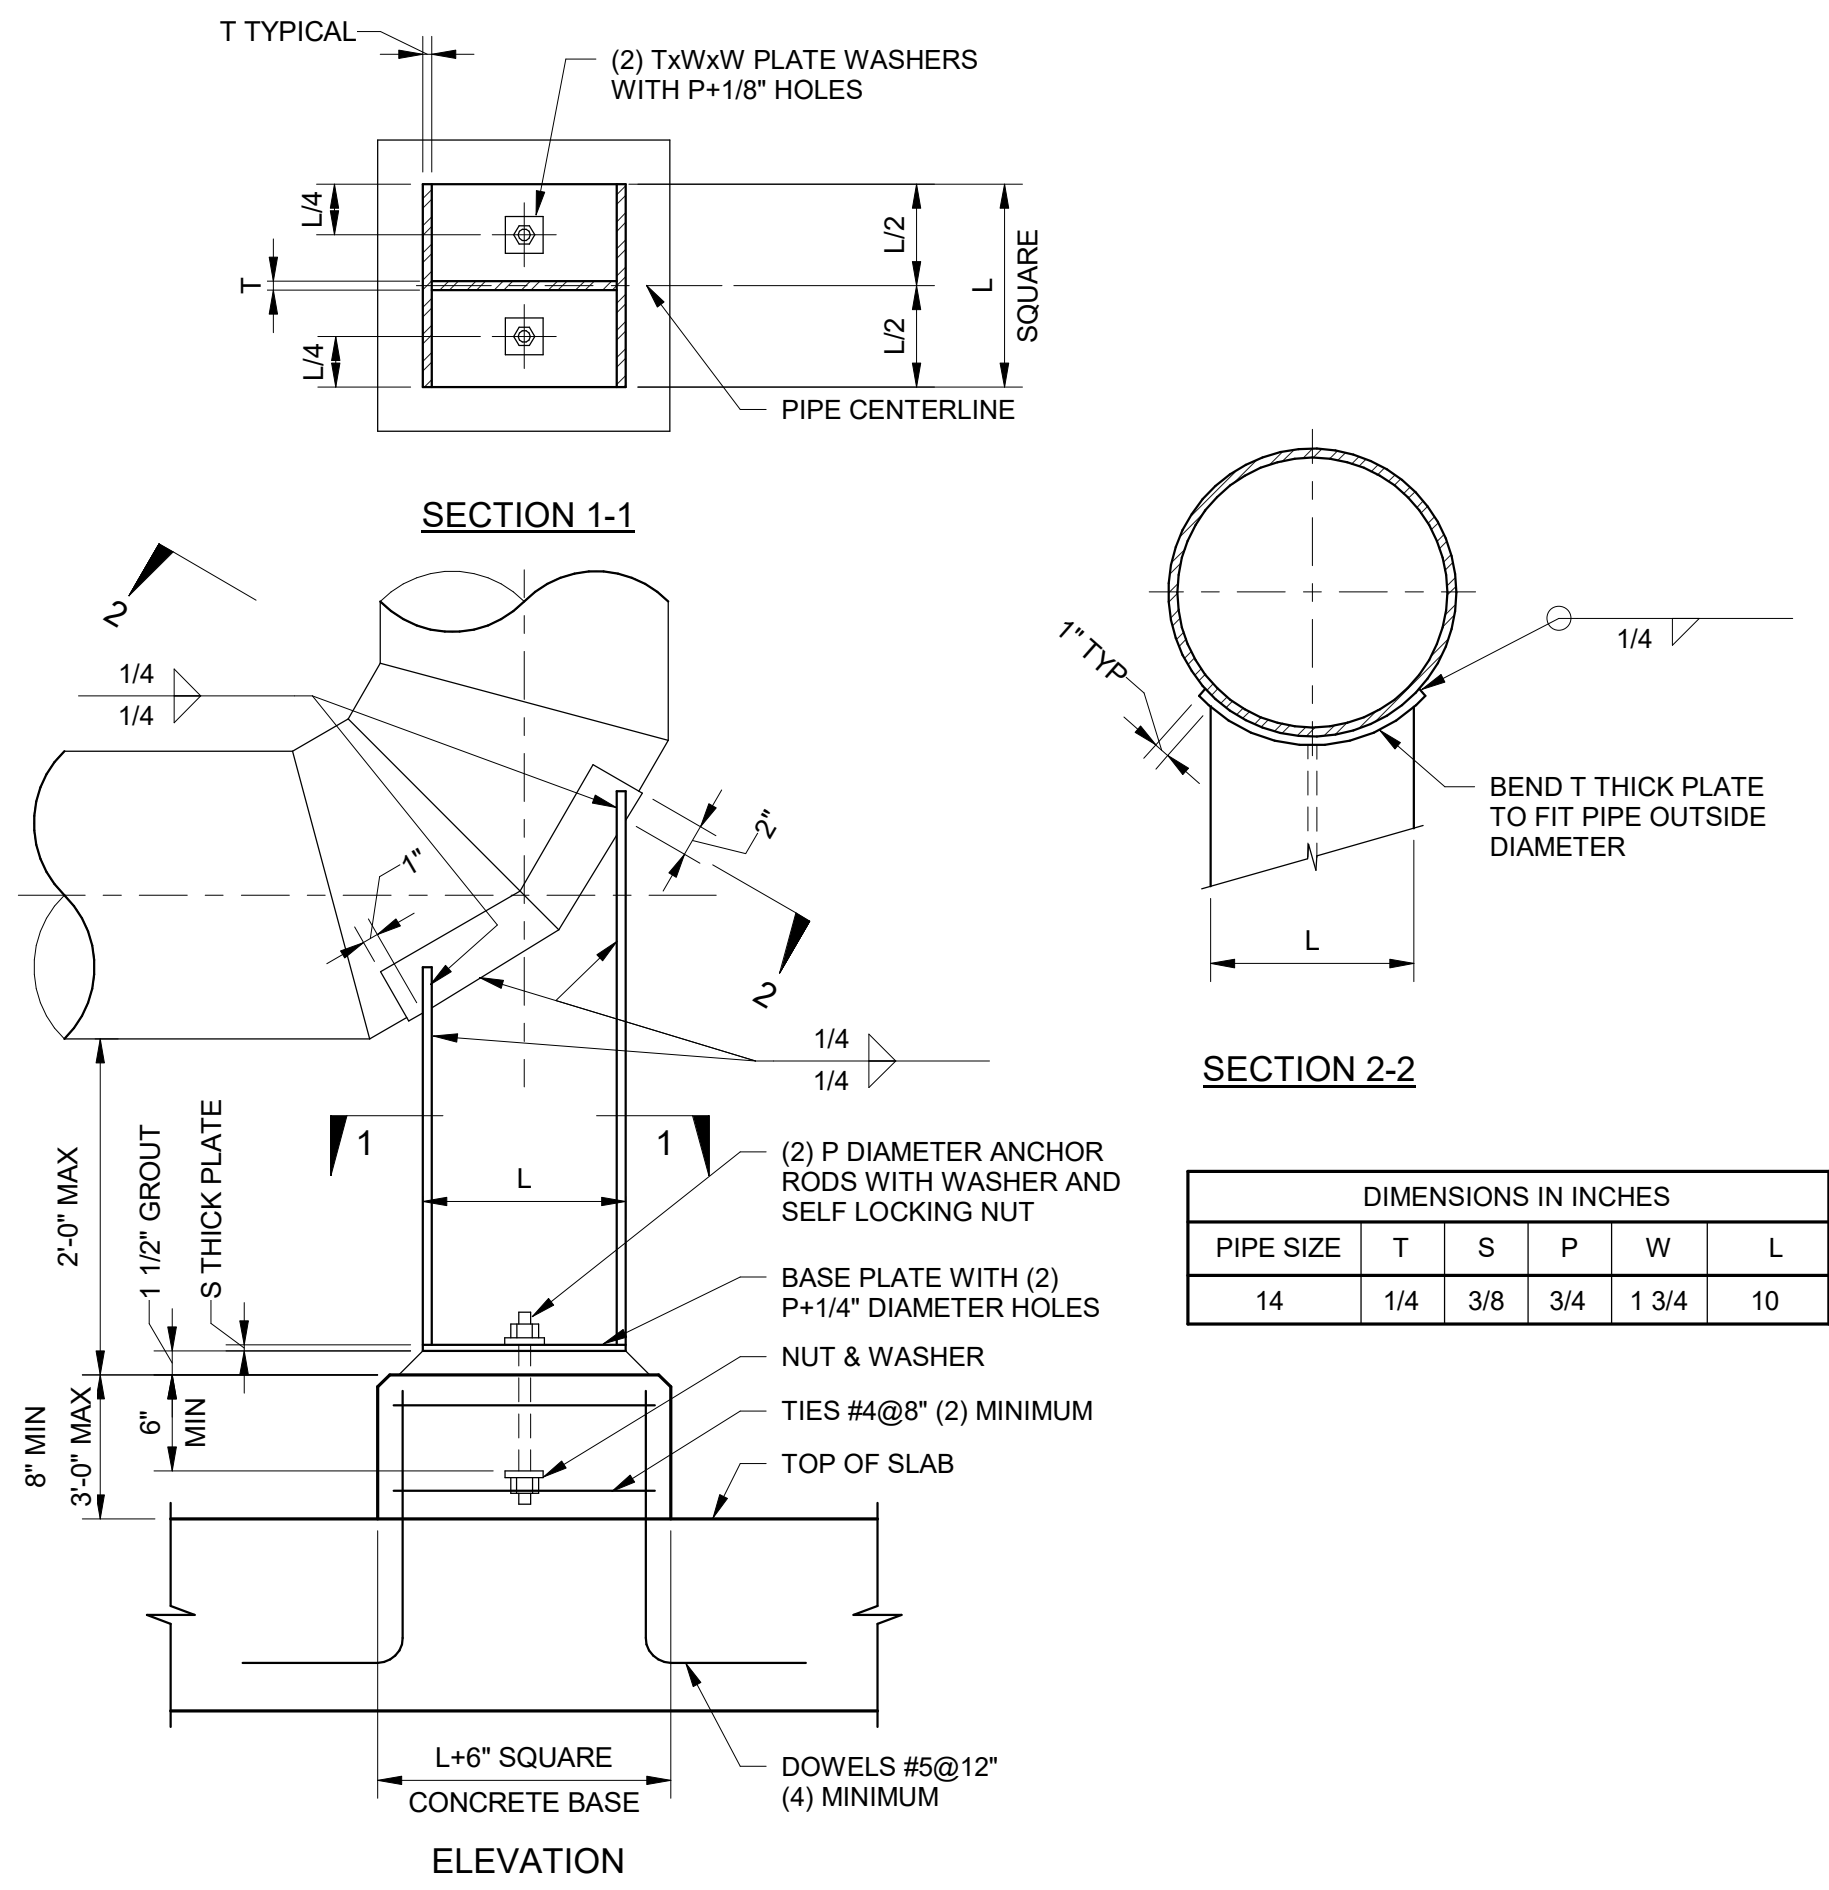


90 DEGREE STEEL PIPE BASE ELBOW SUPPORT (PS-13 (A))
1\"/>

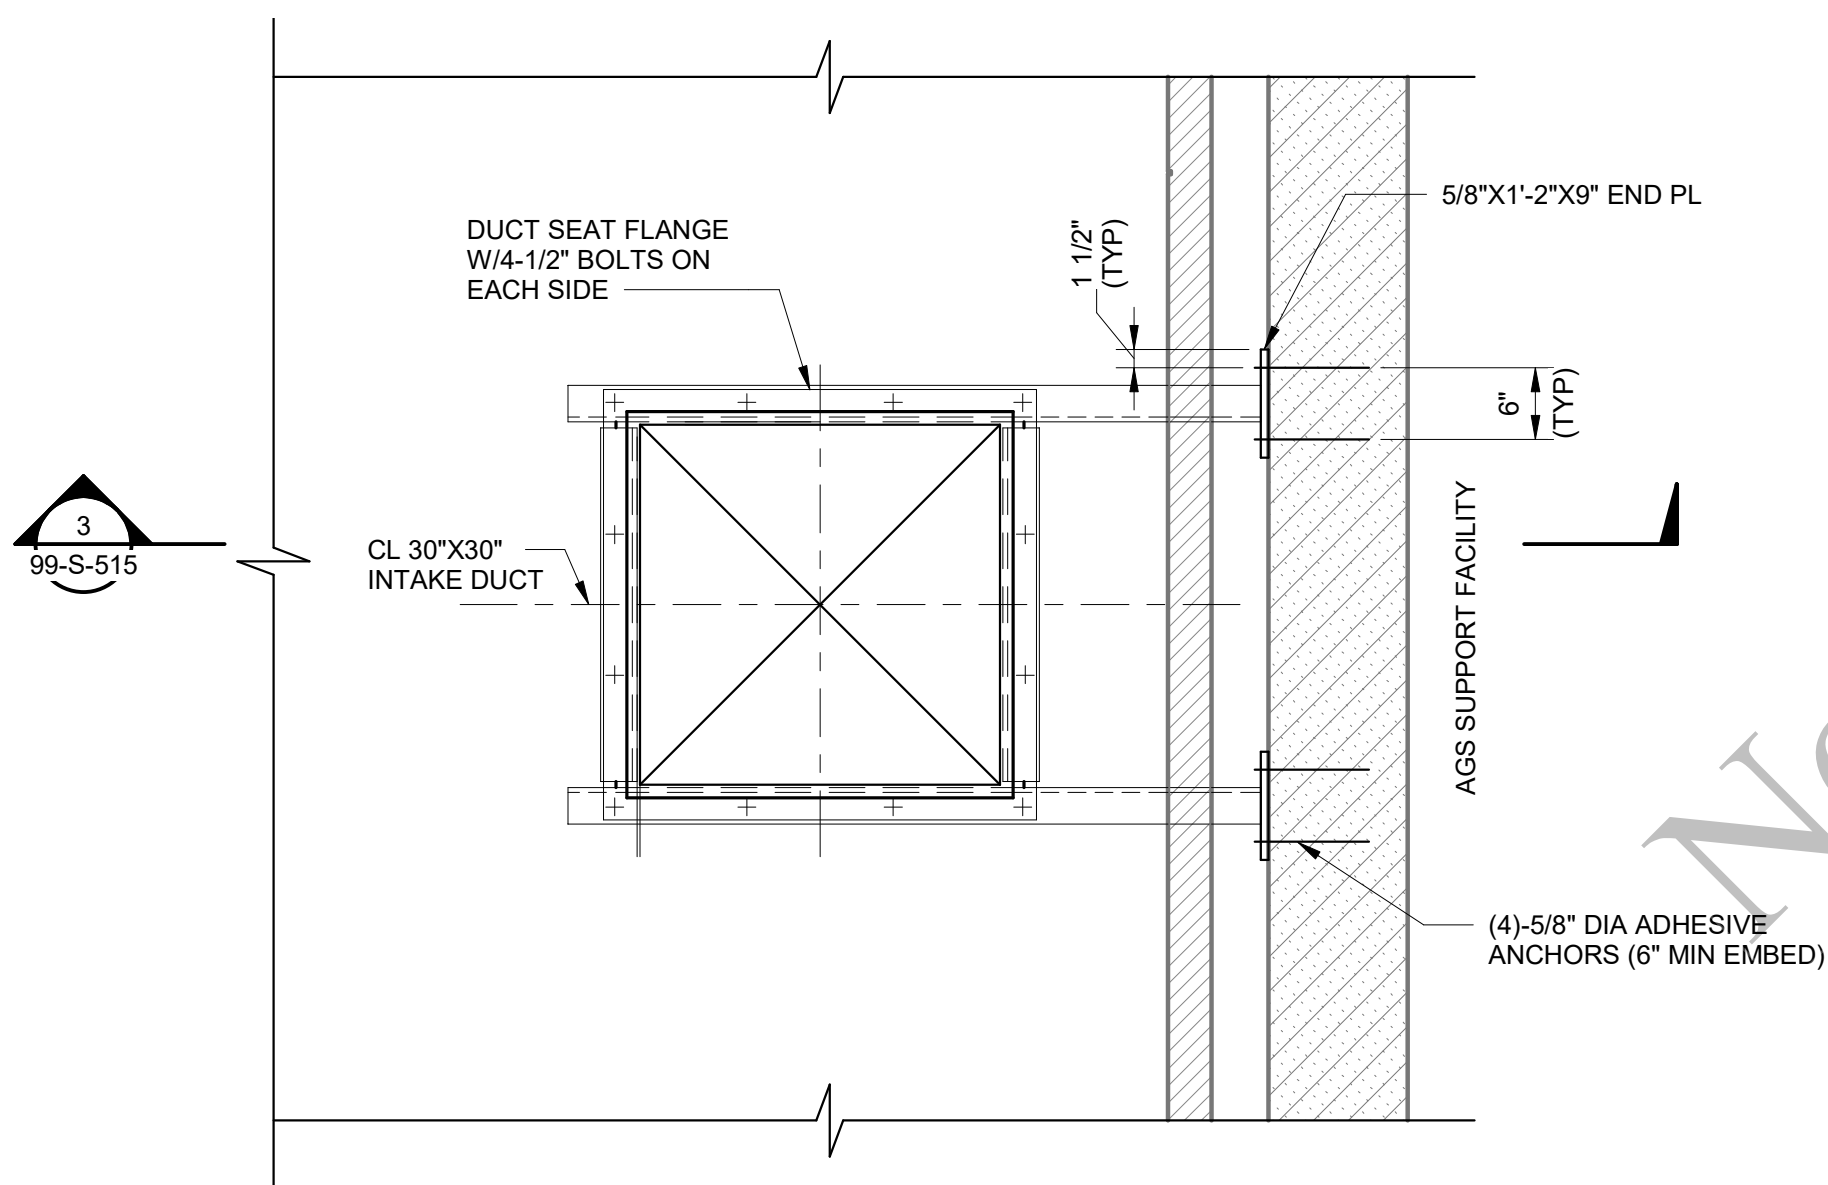

INTAKE DUCT SUPPORT (PS-9)
99-S-515 3/4\"/>

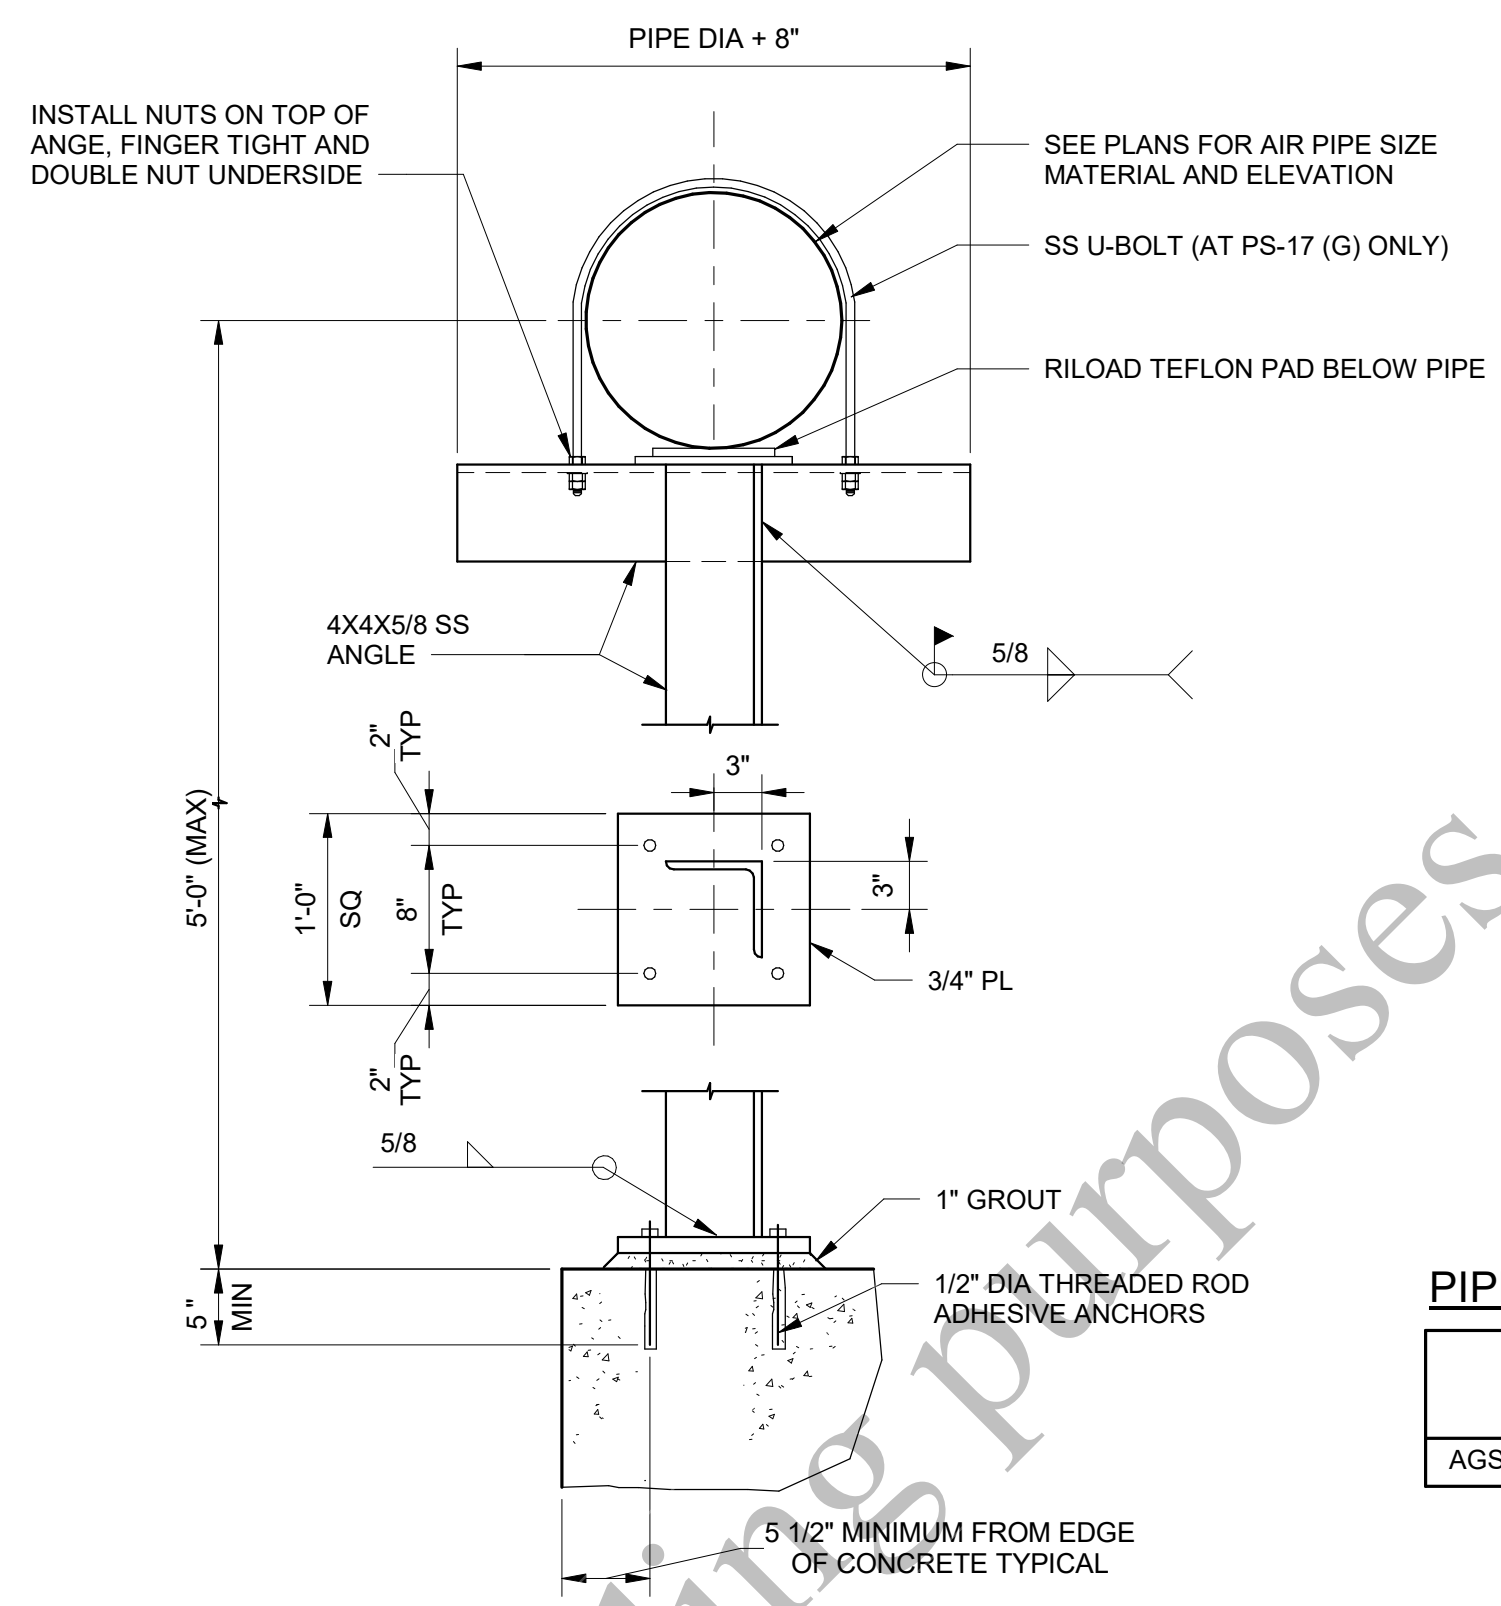


ANGLE TEE STANCHION SUPPORT (PS-17 (G) & PS-18 (V))
1\"/>

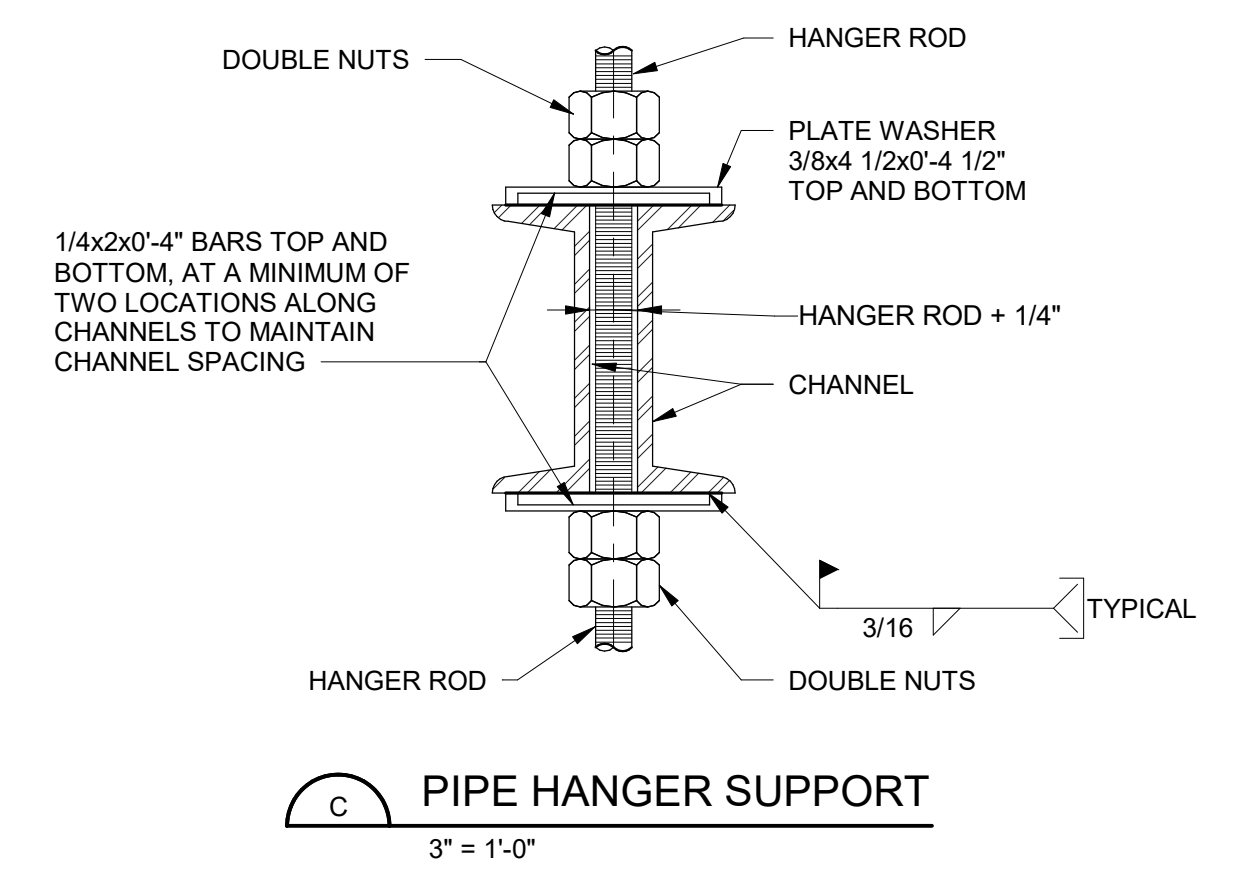

PIPE HANGER SCHEDULE

LOCATION	CHANNEL MEMBER	HANGER ROD DIA (IN)	REQUIRED LOAD RATING AT EACH LEVEL (LBS)	MATERIAL
AGS TANK PIPE GALLERY TRAPEZE	MC6X12	3/4	3,000	GALV STEEL

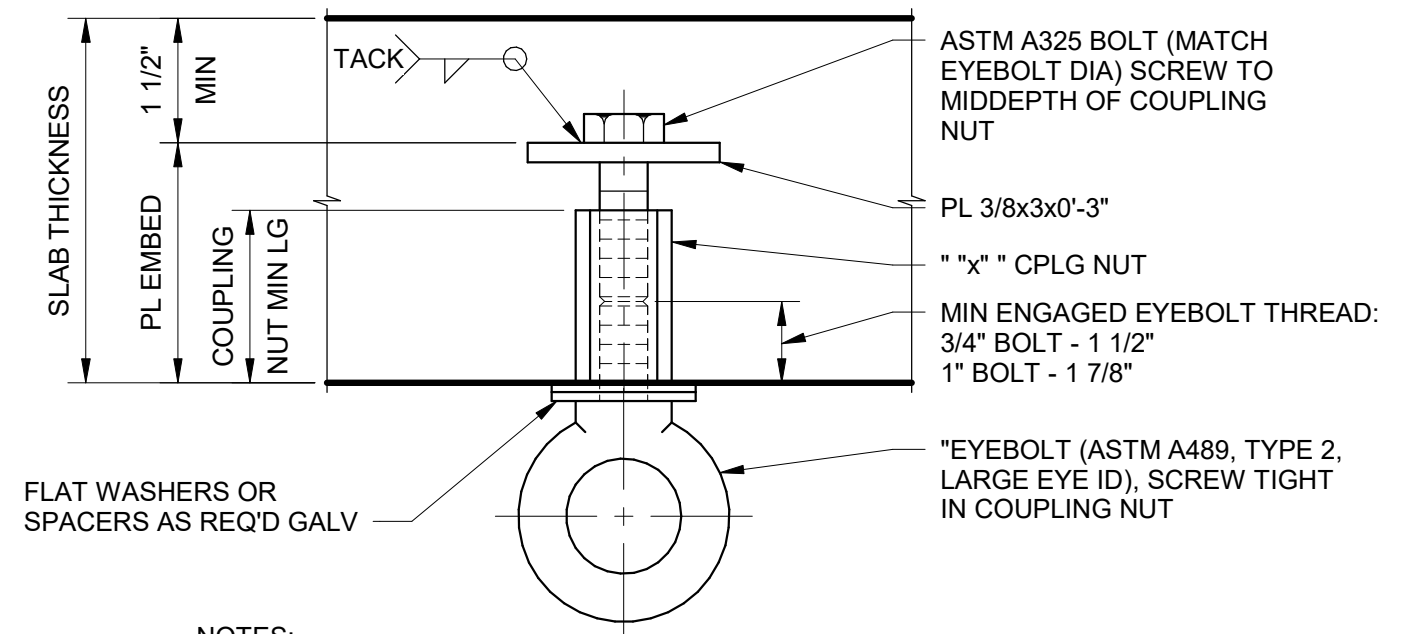


- NOTES:**
- ALIGN EYEBOLT PLANE WITH DIRECTION OF LOADING. SEAT SHOULDER FIRMLY AGAINST MATING SURFACE; USE WASHERS OR SPACERS AS REQUIRED.
 - DO NOT PAINT OR GALVANIZE EYEBOLT.
 - TAG EYEBOLT AS INDICATED BELOW. TAG AND WIRE TO BE CORROSION RESISTANT METAL.

SAFE VERTICAL WORKING LOAD (LBS)	SAFE WORKING LOAD AT 45° MAX (LBS)	MINIMUM SLAB THICKNESS (IN)	MINIMUM PLATE THICKNESS (IN)	COUPLING NUT SIZE DIA x MIN LENGTH (IN)	EYEBOLT SIZE (IN)
6000	1500	8	6	3/4 x 3 1/2	3/4

TYPICAL EYEBOLT


LIFTING EYE BOLT DETAIL
NO SCALE

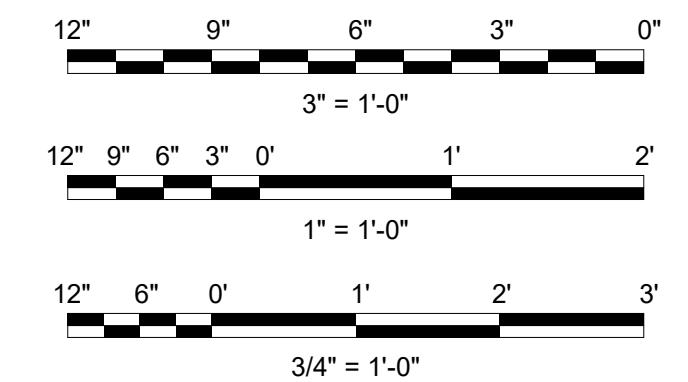

(SCALE BAR IS 4\"/>

REVISIONS AND RECORD OF ISSUE	
DESIGNED:	SKA
DETAILED:	UBS
CHECKED:	CG
APPROVED:	TNG
DATE:	12/20/2022
PROJECT NO.:	411752

PLOTTED: 12/19/2022 5:10:49 PM
 FILE: BIM 360/1409469- Aerobic Granular Sludge Phase 1409469 - AGS.rvt
 D11000

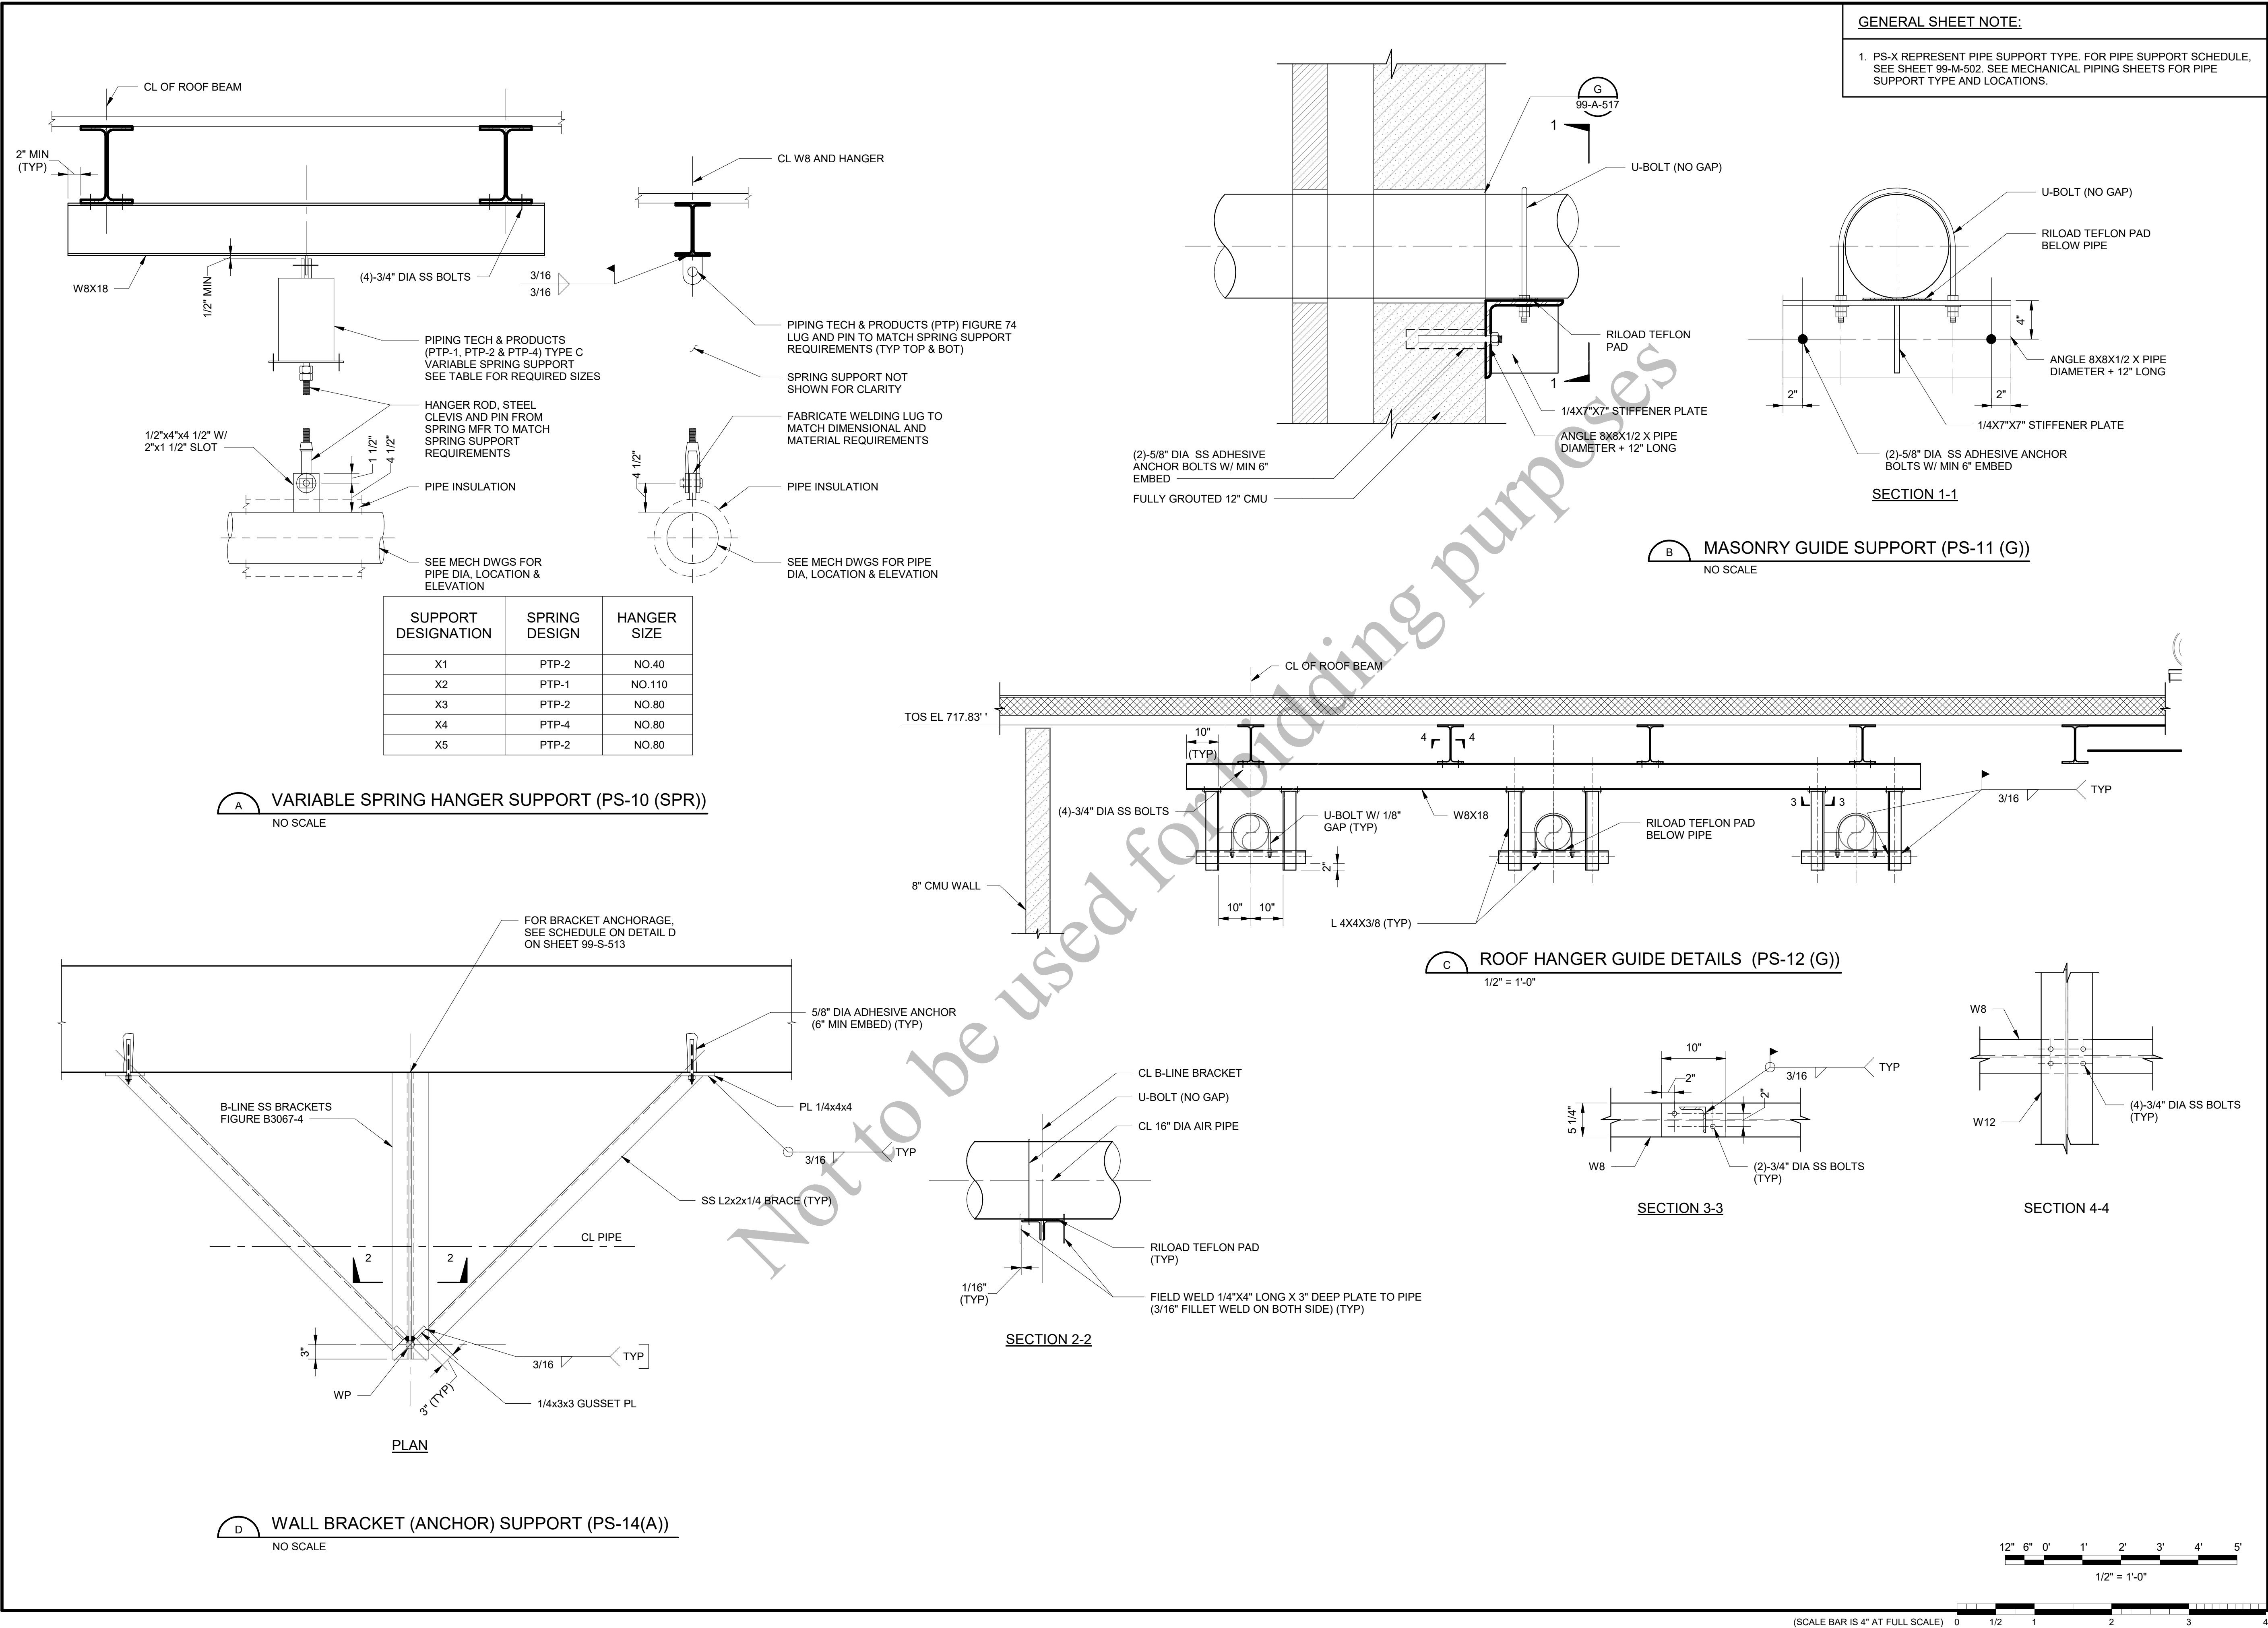

GENERAL SHEET NOTE:
 1. PS-X REPRESENT PIPE SUPPORT TYPE. FOR PIPE SUPPORT SCHEDULE, SEE SHEET 99-M-502. SEE MECHANICAL PIPING SHEETS FOR PIPE SUPPORT TYPE AND LOCATIONS.



Black & Veatch Corporation
Chicago, Illinois
ILLINOIS PROFESSIONAL
DESIGN FIRM - 184.002143-0006

Four Rivers
Sanitation Authority

AEROBIC GRANULAR
SLUDGE - PHASE 1

REVISIONS AND RECORD OF ISSUE	
DESIGNED:	SKA
DETAILED:	UBS
CHECKED:	CG
APPROVED:	TNG
DATE:	12/20/2022
PROJECT NO.:	411752


DETAILS

STRUCTURAL

PIPE SUPPORT DETAILS
4 OF 4

99-S-516


146
OF
163

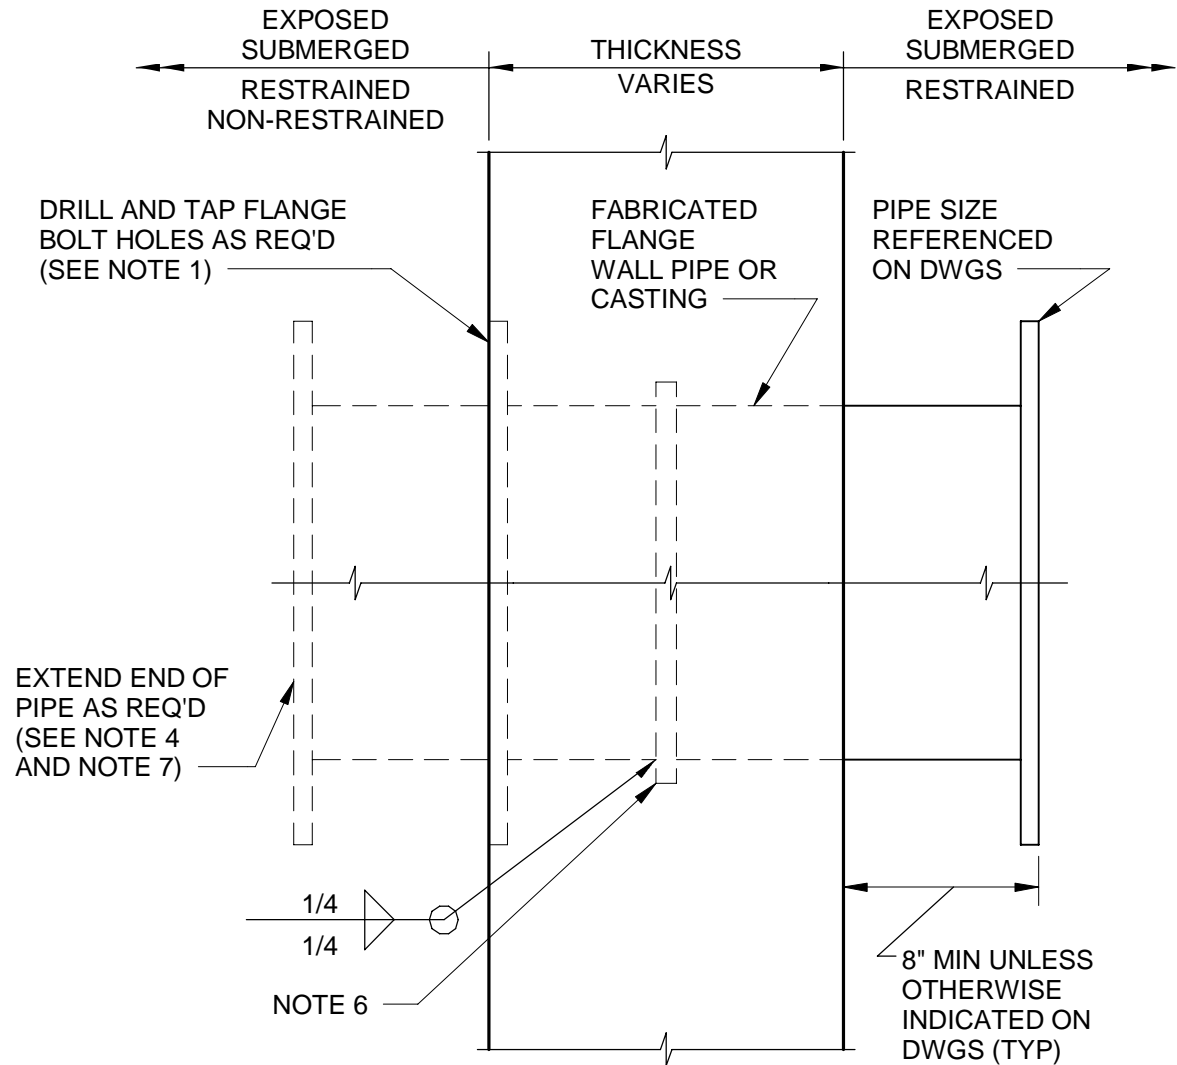

NOTES:

- WALL PIPE MATERIAL SHALL BE DUCTILE IRON, STEEL OR AS INDICATED ON THE DRAWINGS. STEEL PIPE SHALL BE SCHEDULE 40 FOR PIPE 20 INCHES AND SMALLER, 3/8" FOR PIPE LARGER THAN 20", AND COATINGS SAME AS CONNECTING PIPE.
- IF CONNECTING STEEL PIPE THICKNESS IS GREATER THAN 3/8", STEEL WALL PIPE THICKNESS SHALL BE INCREASED TO MATCH CONNECTING PIPE.
- ANNULAR COLLAR SHALL BE SAME MATERIAL AS PIPE, 1/4" X 2" FOR PIPE 20" AND SMALLER, AND 3/8" X 3" FOR PIPE LARGER THAN 20".
- WALL PIPE MAY BE FLUSH WITH FACE OF WALL OR EXTENDED WITH END AS REQUIRED OR INDICATED ON DRAWINGS.
- WALL PIPE SHALL BE ORIENTED SO THAT THE BOLT HOLES STRADDLE THE TOP CENTERLINE.
- FOR AIR PIPE WALL ANCHORS (SUPPORT DESIGNATION PS-16 (A)), WELD A SINGLE FLANGE BETWEEN PROCESS PIPE. FLANGE MATERIAL AND SIZE SHALL MATCH PROCESS PIPE.
- WHERE PIPE IS REQUIRED ON ONE SIDE ONLY, PROVIDE FLGxPE WALL PIPE.


A FLANGED WALL PIPE
NO SCALE

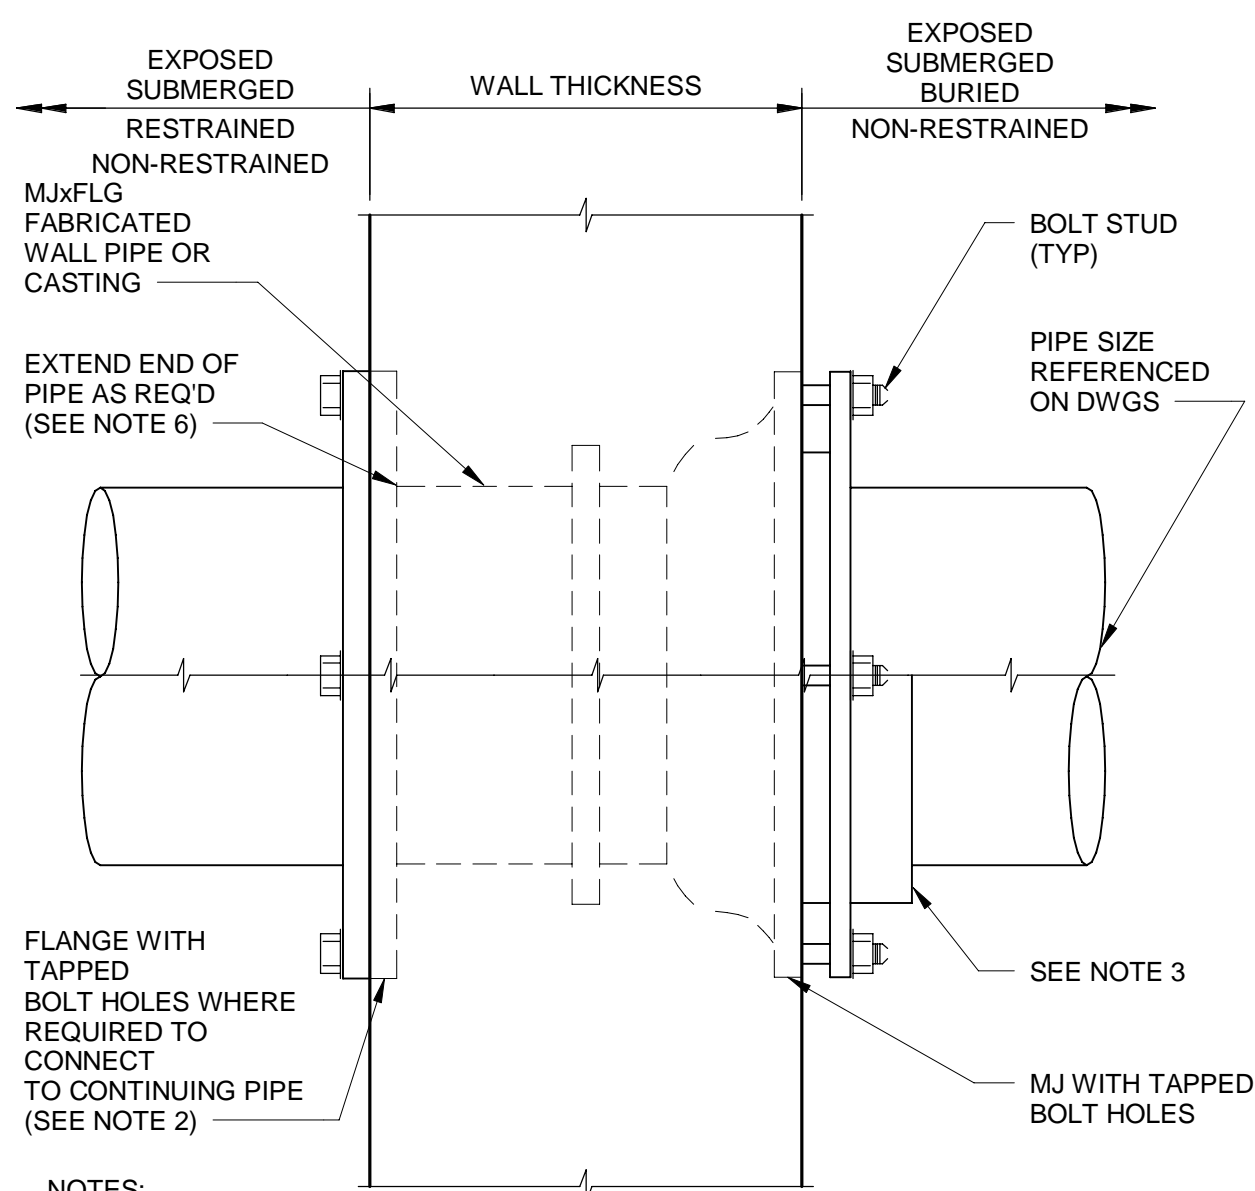

NOTES:

- WALL PIPE SHALL BE ORIENTED SO THAT THE BOLT HOLES STRADDLE THE TOP CENTERLINE.
- WHERE PIPE IS REQUIRED ON ONE SIDE ONLY, PROVIDE M/JxPE WALL PIPE.
- FOR STEEL PIPE APPLICATIONS BUILD UP END OF STEEL PIPE TO FIT MJ WALL PIPE.
- FOR BURIED PIPING, CONTRACTOR SHALL PROVIDE AN ADDITIONAL FIELD JOINT AS CLOSE AS PRACTICAL TO FACE OF WALL, BUT NO MORE THAN 5 FEET.
- USE WAX TAPE TO PROTECT ALL BURIED FERROUS SURFACES, INCLUDING PAINTED SURFACES. FOR PROTECTION OF ADJACENT PIPE BARREL SURFACES, SHRINK WRAP MAY BE USED IN LIEU OF WAX TAPE. SEE SPECIFICATIONS.
- WALL PIPE FLANGE MAY BE FLUSH WITH FACE OF WALL OR EXTENDED WITH END AS REQUIRED OR INDICATED ON DRAWINGS.


B FLANGED - MECHANICAL JOINT WALL PIPE
NO SCALE

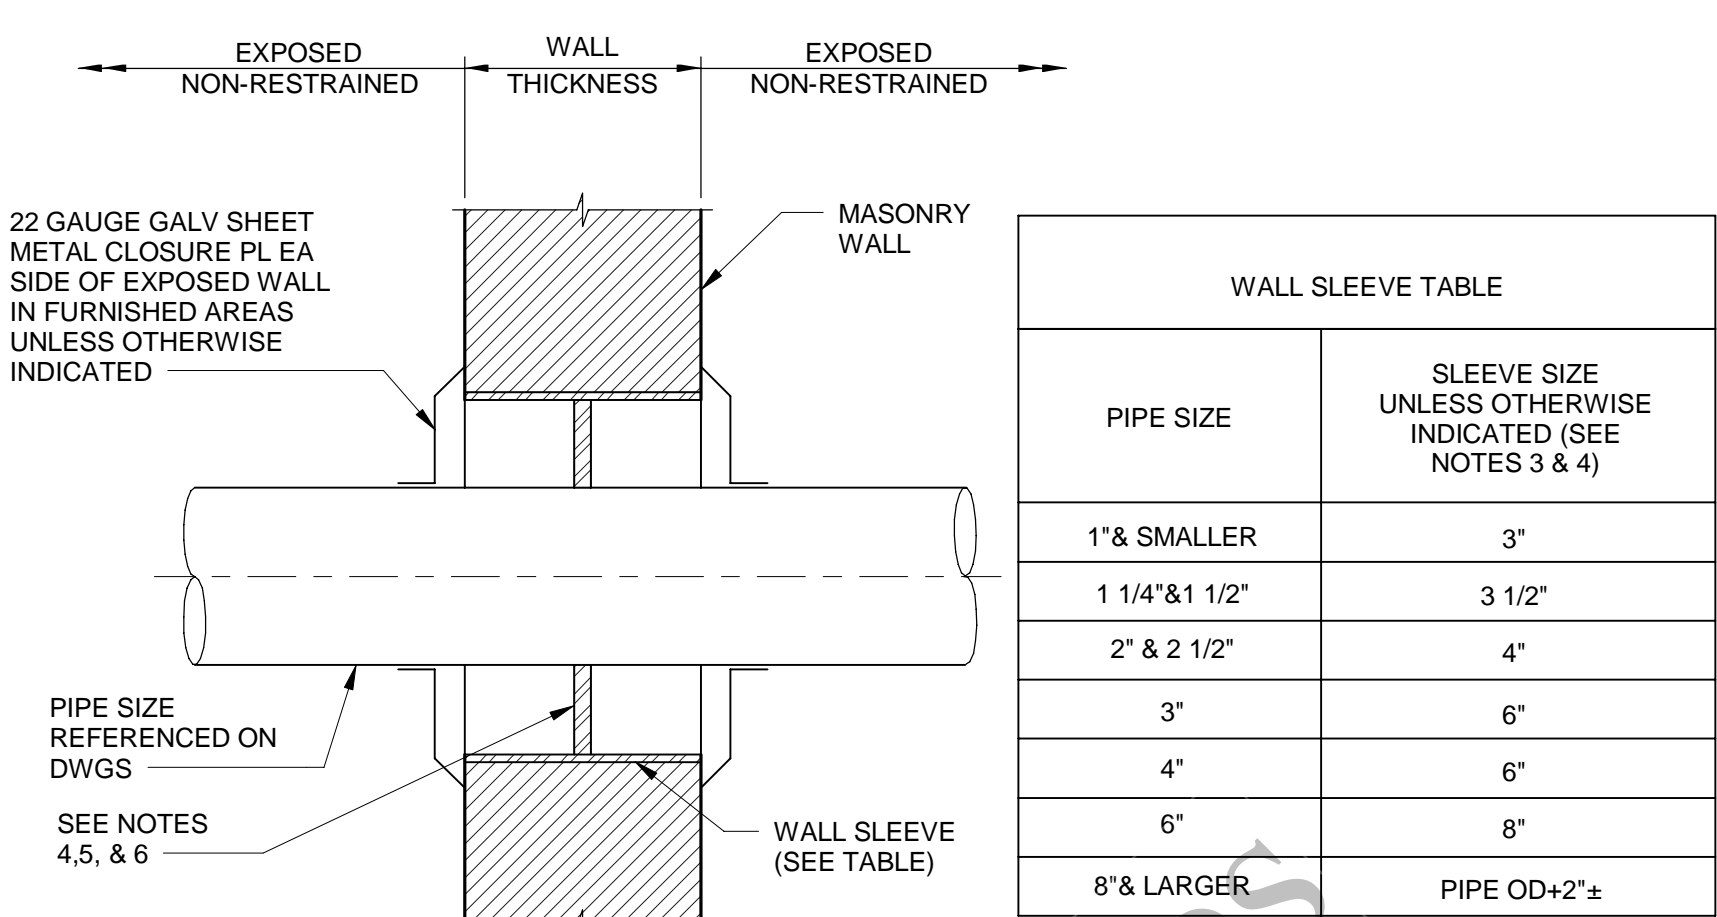

NOTES :

- SCHEDULE 40 GALV STEEL PIPE FOR PIPING SMALLER THAN 3", SCHEDULE 20 GALV STEEL PIPE FOR PIPING SMALLER THAN 6", AND GALV 1/4" MINIMUM WALL THICKNESS FOR PIPING LARGER THAN 6".
- FOR PIPING LARGER THAN 3" PROVIDE PIPE SUPPORT WITHIN 3' OF WALL SLEEVE TO PREVENT THE TRANSFER OF PIPE LOADS TO MASONRY WALL WHEN MODULAR CASING SEALS ARE USED.
- WHERE REQUIRED, USE SLEEVE LARGE ENOUGH FOR FLANGE OR OTHER JOINT RESTRAINT TO PASS THROUGH.
- FOR PIPE SIZES 1 1/2" IN DIAMETER AND SMALLER, CAULK ANNULAR SPACE AROUND PIPE. FOR PIPE LARGER THAN 1 1/2" IN DIAMETER, USE MODULAR CASING SEALS AND COORDINATE SLEEVE SIZE WITH CASING SEAL MANUFACTURER.
- PROVIDE MODULAR CASING SEALS ON ALL SLEEVES AT CHLORINE AND AMMONIA FEED AND STORAGE ROOMS AND WHERE INDICATED ON THE DRAWINGS. COORDINATE SLEEVE SIZE WITH CASING SEAL MANUFACTURER.
- FIRESAFING TO BE PROVIDED AT ALL RATED WALLS INDICATED ON THE DRAWINGS AND INSTALLED PER ACCEPTED UL RATED SYSTEMS.

C MASONRY WALL SLEEVE
NO SCALE

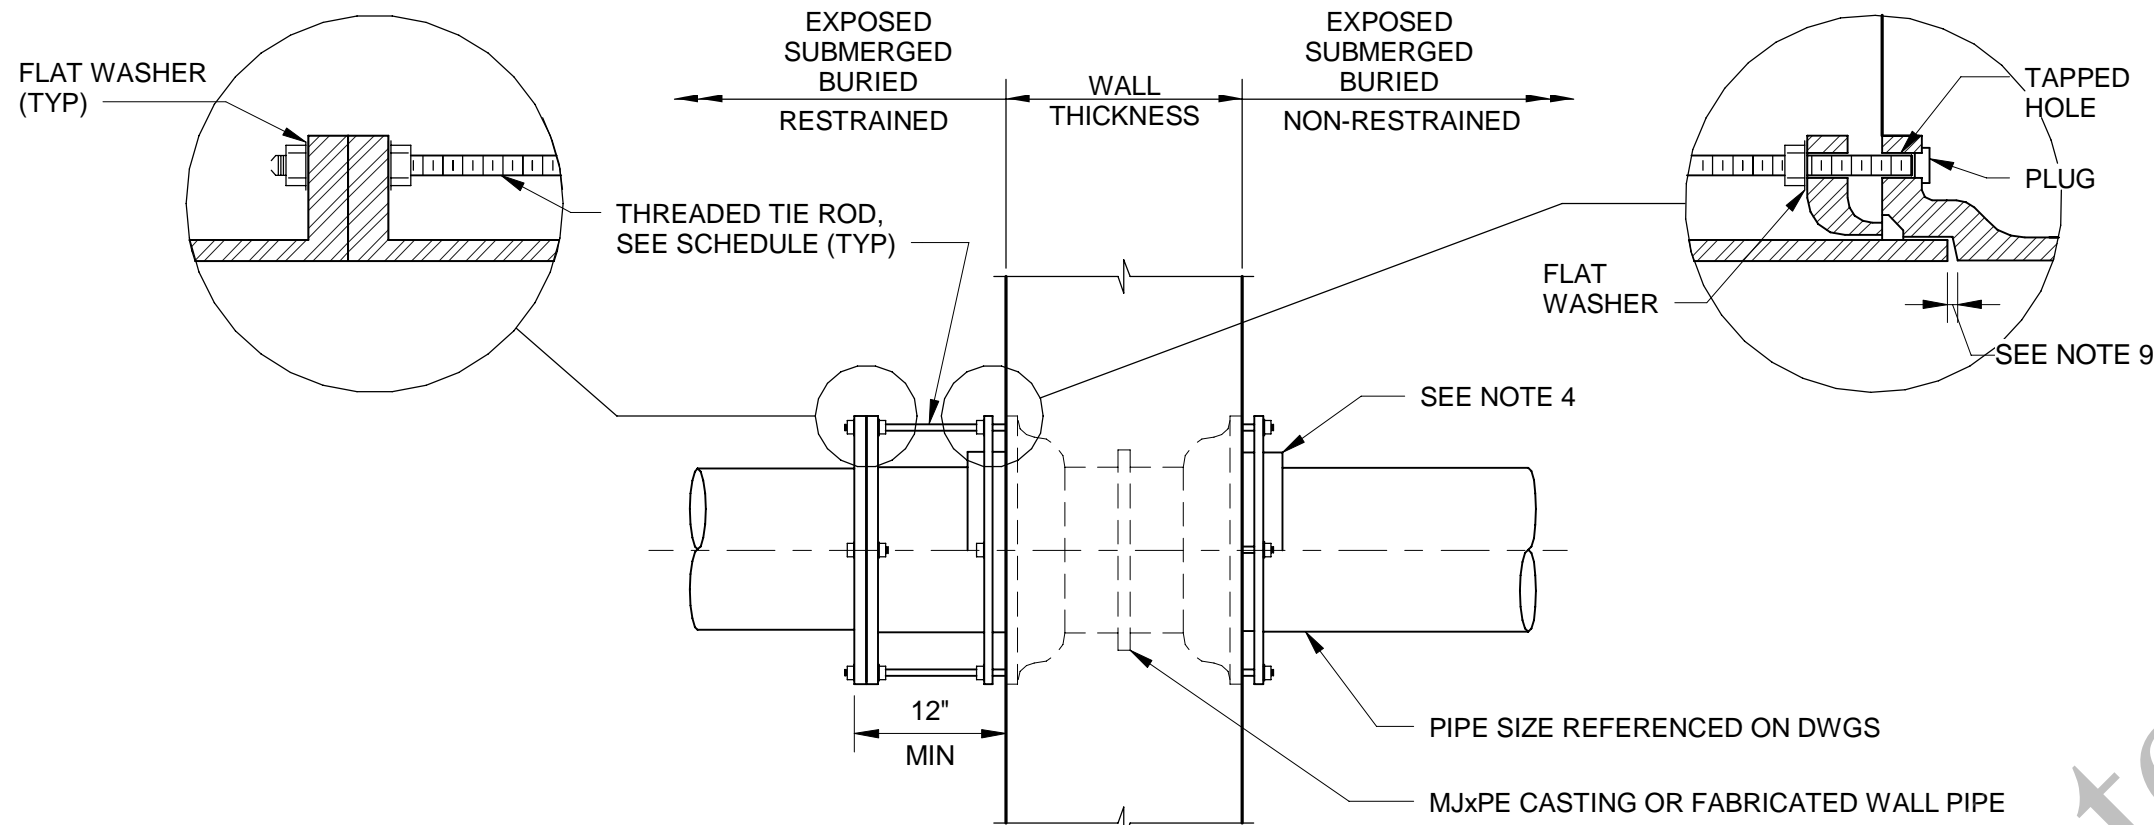

NOTES :

- PRESSURE SHALL BE THE PRESSURE AT WHICH THE PIPE IS HYDROSTATICALLY TESTED, OR IF THERE IS NO HYDROSTATIC FIELD TEST, IT SHALL BE THE SPECIFIED SHOP TEST PRESSURE.
- UNLESS OTHERWISE INDICATED, TIE RODS SHALL BE SPACED UNIFORMLY AROUND THE PIPE, BEGINNING WITH THE FIRST TWO AT THE HORIZONTAL CENTERLINE OF THE PIPE, SUBJECT TO THE APPROVAL OF THE ENGINEER.
- EXCEPT WHERE TIE RODS ARE REQUIRED, BOLTS FOR FOLLOWER RINGS SHALL BE BOLT-STUDS ON WALL PIPE. ALL BOLT HOLES IN WALL PIPE SHALL BE TAPPED. WALL PIPES SHALL BE ORIENTED SO THAT THE BOLT HOLES STRADDLE THE TOP CENTERLINE.

FOR STEEL PIPE APPLICATIONS, BUILD UP END OF STEEL PIPE TO FIT MJ WALL PIPE.
- FOR BURIED PIPING, CONTRACTOR SHALL PROVIDE AN ADDITIONAL FIELD JOINT AS CLOSE AS PRACTICAL TO FACE OF WALL, BUT NO MORE THAN 5 FEET.
- USE WAX TAPE TO PROTECT ALL BURIED FERROUS SURFACES, INCLUDING PAINTED SURFACES. FOR PROTECTION OF ADJACENT PIPE BARREL SURFACES, SHRINK WRAP MAY BE USED IN LIEU OF WAX TAPE. SEE SPECIFICATIONS.
- WHERE PIPE IS REQUIRED ON ONE SIDE ONLY, PROVIDE M/JxPE WALL PIPE.
- FOR PIPING FLEXIBILITY, PROVIDE GAP LARGE ENOUGH TO FACILITATE PIPE ASSEMBLY AND DISASSEMBLY AT ASSOCIATED FLANGE PIPE JOINTS.
- FOR PENETRATION AT EXISTING WALL, REFER TO EXISTING WALL PENETRATION DETAIL.

D MECHANICAL JOINT WALL PIPE WITH TIE RODS
NO SCALE

TIE ROD SCHEDULE			
NOMINAL PIPE SIZE (INCHES)	MAX. PRESSURE (PSI) (NOTE 1)	TIE BOLTS	
		NO. OF RODS (NOTE 2)	DIA OF RODS (INCHES)
6	250 OR LESS	2	3/4
8	150 OR LESS	2	3/4
10	200 OR LESS 350	2 6	3/4
12	150 OR LESS 300	2 4	3/4
14	100 OR LESS 200	2 4	3/4
16	75 OR LESS 150	2 4	3/4
18	75 OR LESS 150	2 4	3/4
20	50 OR LESS	2	3/4
24	75	4	3/4
30	50 OR LESS	4	1
36	50 OR LESS 100	4 8	1
42	50 OR LESS	4	1 1/4

REVISIONS AND RECORD OF ISSUE

DESIGNED:	JL
DETAILED:	KDG
CHECKED:	AM/JH
APPROVED:	MR
DATE:	12/20/2022
PROJECT NO.:	411752

DETAILS

PROCESS MECHANICAL

MECHANICAL DETAILS
1 OF 4


PLOTTED: 12/16/2022 11:54:59 AM
 FILE: BIM 360/409469 - Aerobic Granular Sludge Phase 1/409469 - AGS.rvt
 D11000

PIPE SUPPORT SCHEDULE					
SUPPORT DESIGNATION	SUPPORT TYPE	LOCATION	PIPE	SUPPORT DETAIL/ SHEET	MATERIAL
PS-1	CONCRETE SADDLE	AGS REACTOR PIPE GALLERY	30" AGS INFLUENT	A/ 99-S-513	CONCRETE
PS-2	TRAPEZE	AGS REACTOR PIPE GALLERY	14" WAGS/ WLC	B/ 99-S-513	GALV STEEL
PS-3	ROOF HANGER	AGS REACTOR PIPE GALLERY	14" WAGS/ WLC	C/ 99-S-513	GALV STEEL
PS-4	WALL BRACKET	AGS REACTOR PIPE GALLERY	14" WAGS/ WLC	D/ 99-S-513	GALV STEEL
PS-5	CONCRETE SADDLE AT TEE	AGS REACTOR PIPE GALLERY	30" AGS INFLUENT	E/ 99-S-513	CONCRETE
PS-6	CONCRETE THRUST BLOCK AT ELBOW	AGS REACTOR PIPE GALLERY	30" AGS INFLUENT	A/ 99-S-514	CONCRETE
PS-7	WALL BRACKET	WAGS/ WLC WETWELL	14" WAGS/ WLC	D/ 99-S-513	STAINLESS STEEL (SEE NOTE 1)
PS-8	CONCRETE SADDLE W/ STRAP	WAGS/ WLC WETWELL	14" WAGS/ WLC	F/ 99-S-513	STAINLESS STEEL STRAP (SEE NOTE 1)
PS-9	INTAKE DUCT SUPPORT	AGS SUPPORT FACILITY	30" X 30" DUCT	D/ 99-S-515	GALV STEEL
PS-10 (SPR)	SPRING HANGER	AGS SUPPORT FACILITY	6", 12" & 16" AIR	A/ 99-S-516	GALV STEEL
PS-11 (G)	MASONRY GUIDE SUPPORT W/ NO GAP	AGS SUPPORT FACILITY	10", 14" & 16" AIR	B/ 99-S-516	GALV STEEL
PS-12 (G)	ROOF HANGER GUIDE SUPPORT W/ 1/8" GAP	AGS SUPPORT FACILITY	10" AIR	C/ 99-S-516	GALV STEEL
PS-13 (A)	BASE ELBOW SUPPORT	AGS SUPPORT FACILITY	14" AIR	A/ 99-S-515	GALV STEEL
PS-14 (A)	WALL BRACKET ANCHOR SUPPORT	AGS REACTOR TANK	16" AIR	D/ 99-S-516	STAINLESS STEEL (SEE NOTE 1)
PS-15 (G)	WALL BRACKET GUIDE SUPPORT W/ 1/4" GAP	AGS REACTOR TANK	12" & 16" AIR	D/ 99-S-513	STAINLESS STEEL (SEE NOTE 1)
PS-16 (G)	WALL BRACKET GUIDE SUPPORT W/ 1/2" GAP	AGS REACTOR TANK	16" AIR	D/ 99-S-513	STAINLESS STEEL (SEE NOTE 1)
PS-17 (G)	ANGLE TEE STANCHION GUIDE SUPPORT W/ 1/4" GAP	AGS REACTOR TANK	12" & 16" AIR	B/ 99-S-515	STAINLESS STEEL (SEE NOTE 1)
PS-18 (V)	ANGLE TEE STANCHION WITHOUT U CLAMPS	AGS REACTOR TANK	12" AIR	B/ 99-S-515	STAINLESS STEEL (SEE NOTE 1)
PS-19 (A)	WALL ANCHOR	AGS REACTOR TANK	16" AIR	A/ 99-M-501	STAINLESS STEEL (SEE NOTE 1)


NOTE:

- PIPE SUPPORTS IN SUBMERGED LOCATIONS SHALL BE COMPATIBLE WITH CHLORIDE CONCENTRATIONS UP TO 300 MG/L.

B PIPE SUPPORT SCHEDULE
NO SCALE

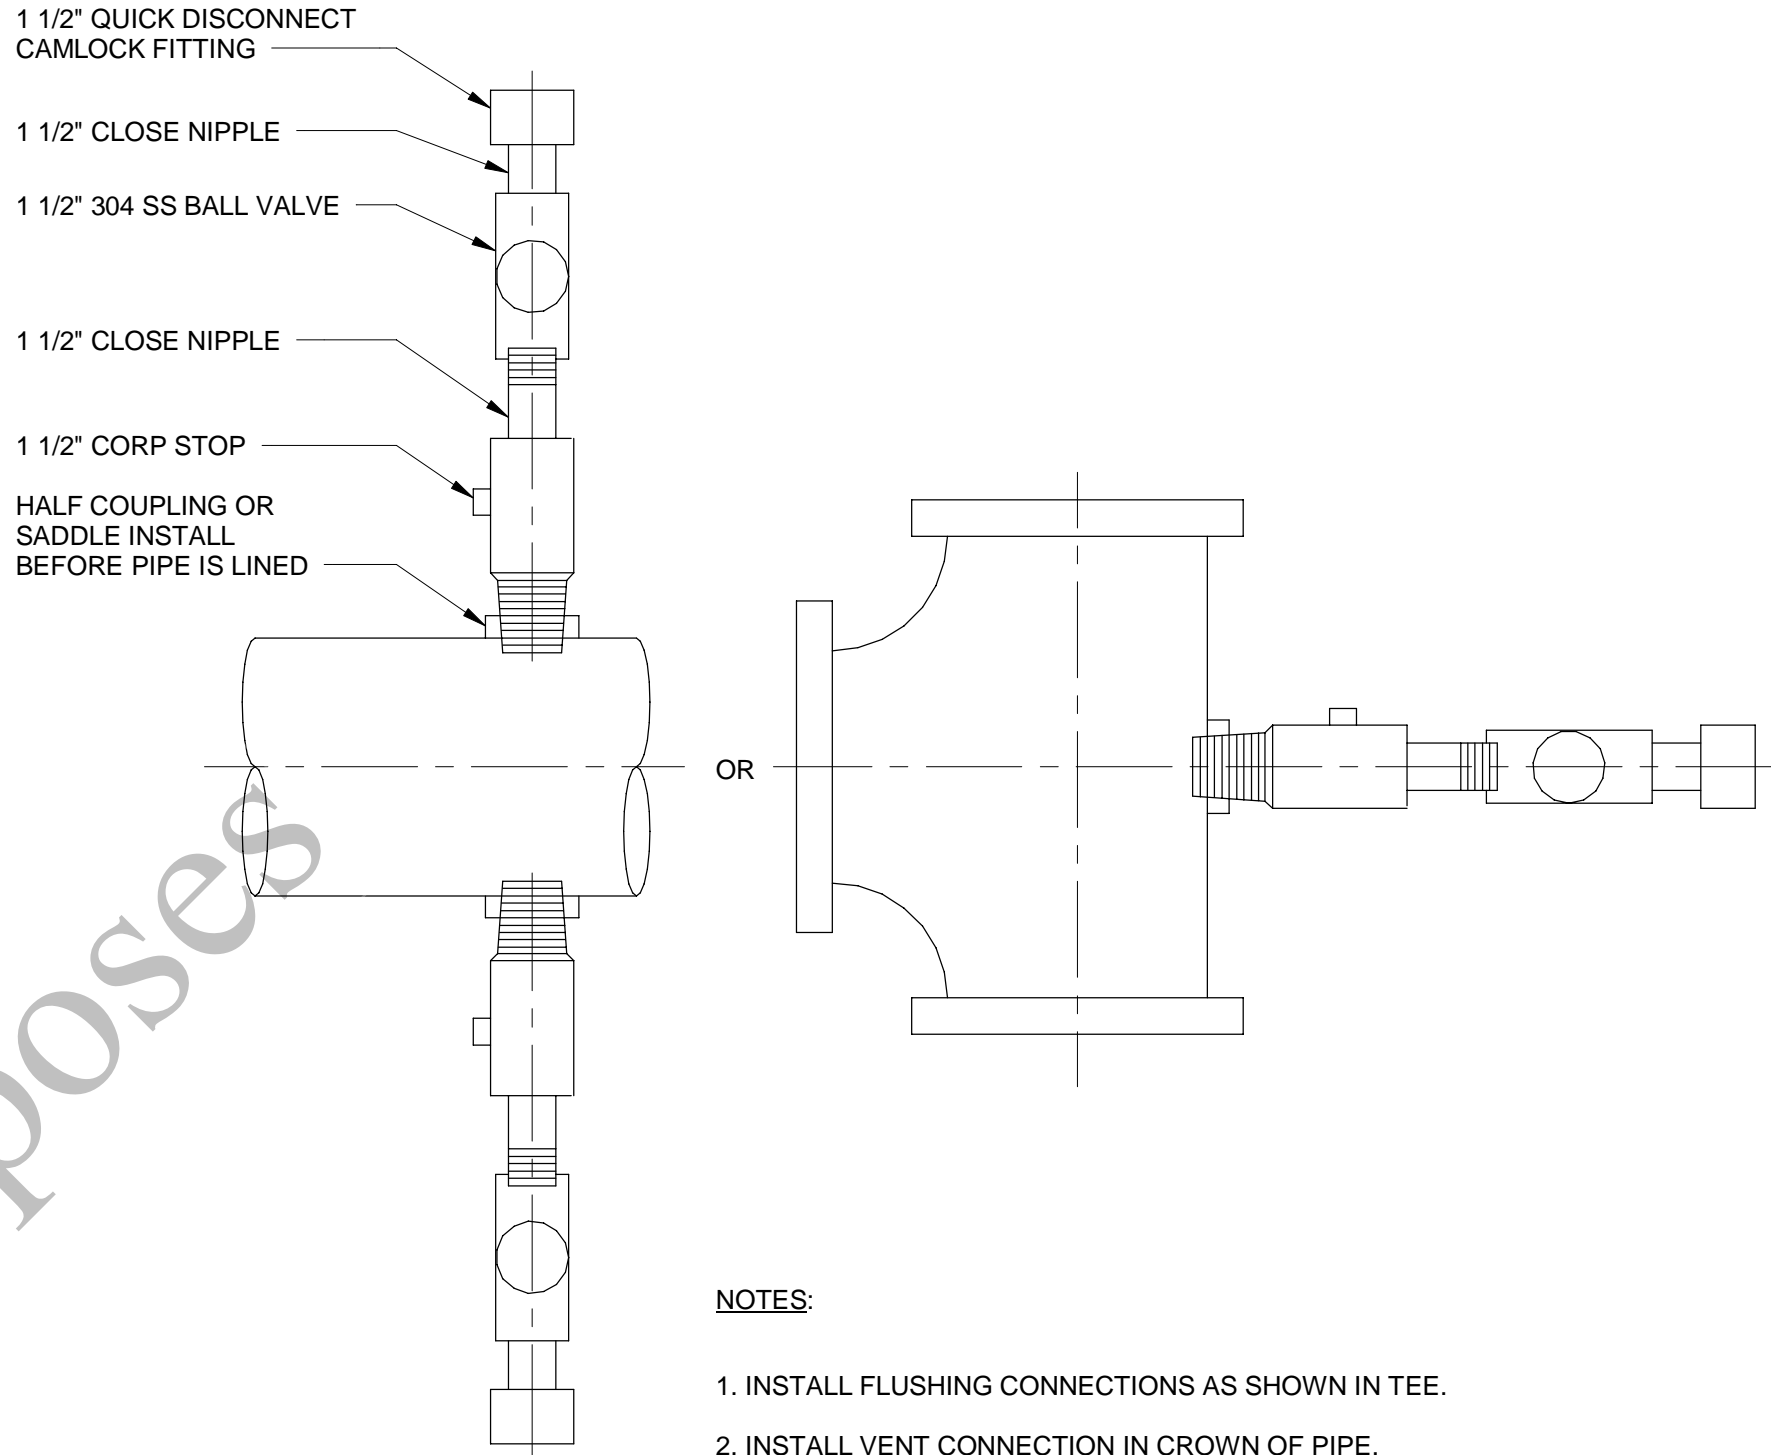


C FLUSHING/DRAIN/VENT CONNECTION
NO SCALE

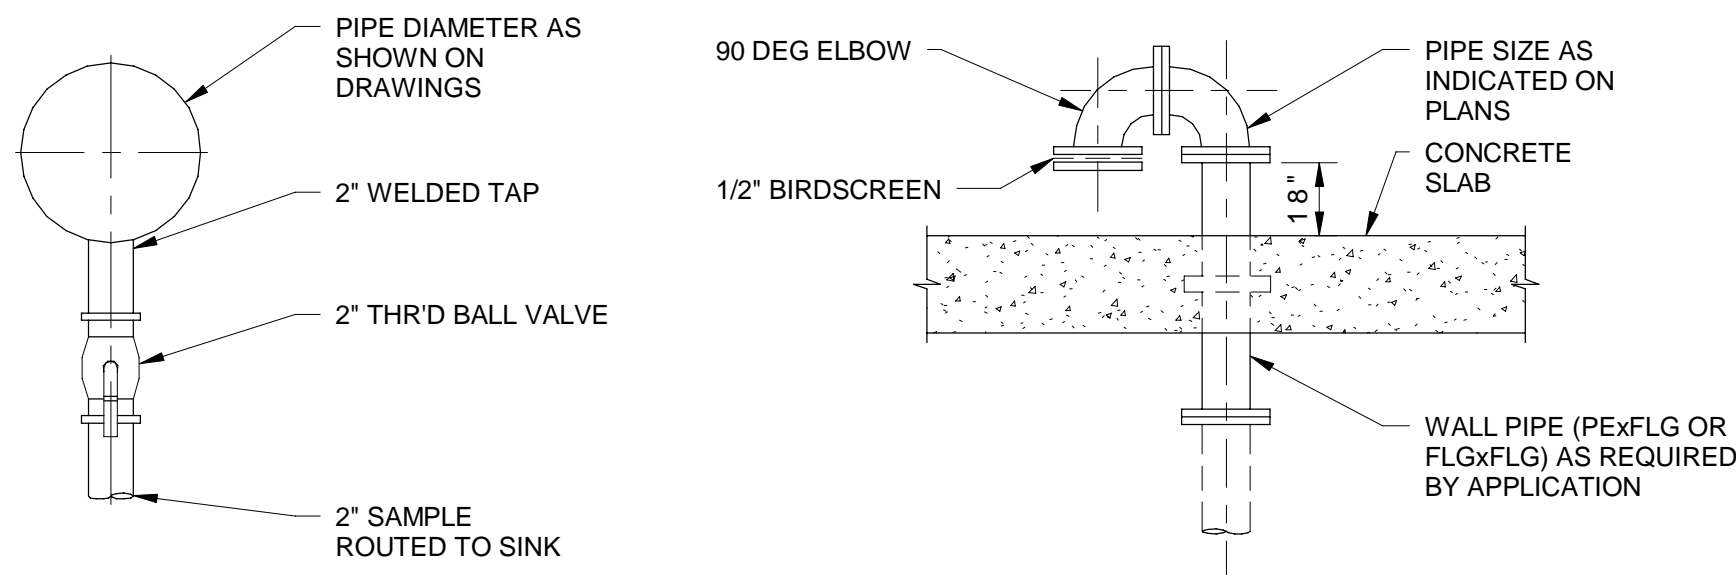

D 2" SAMPLE TAP
NO SCALE


E GOOSENECK VENT
NO SCALE

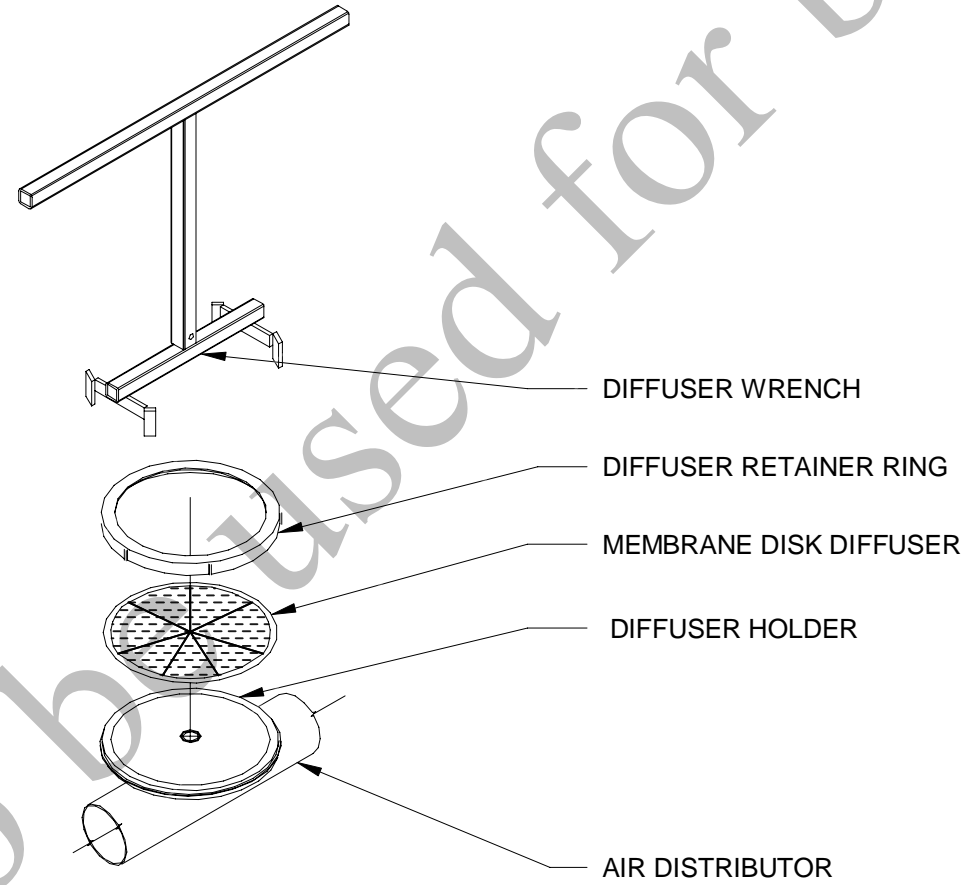

NOTES:

- THIS DETAIL IS PROVIDED FOR REFERENCE ONLY BY THE AGS SYSTEM SUPPLIER IDENTIFIED IN THE BASE BID (TYPE III) MATERIAL AND EQUIPMENT SCHEDULE. FINAL INSTALLATION DETAILS ARE TO BE COORDINATED BY THE CONTRACTOR BASED ON THE ACTUAL EQUIPMENT SUPPLIED AND AGS SYSTEM SUPPLIER SUBMITTAL PACKAGE.


F AGS REACTOR MEMBRANE DISK DIFFUSER ASSEMBLY
NO SCALE

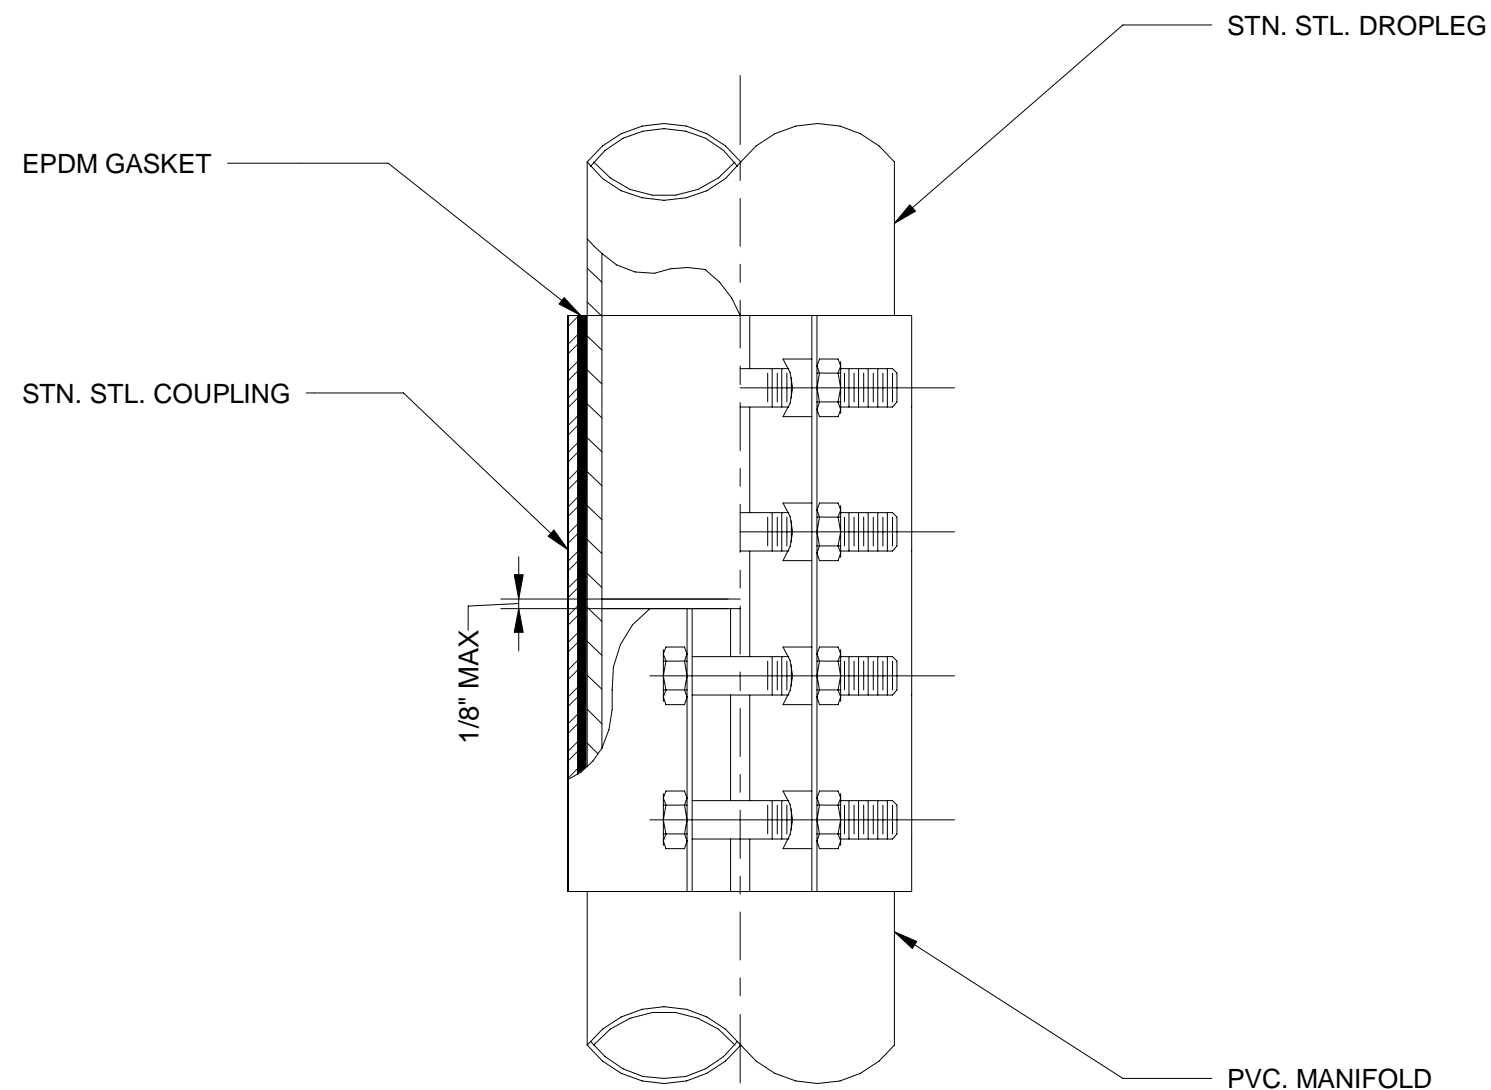

NOTES:

- THIS DETAIL IS PROVIDED FOR REFERENCE ONLY BY THE AGS SYSTEM SUPPLIER IDENTIFIED IN THE BASE BID (TYPE III) MATERIAL AND EQUIPMENT SCHEDULE. FINAL INSTALLATION DETAILS ARE TO BE COORDINATED BY THE CONTRACTOR BASED ON THE ACTUAL EQUIPMENT SUPPLIED AND AGS SYSTEM SUPPLIER SUBMITTAL PACKAGE.

G AGS REACTOR RISER COUPLING
NO SCALE

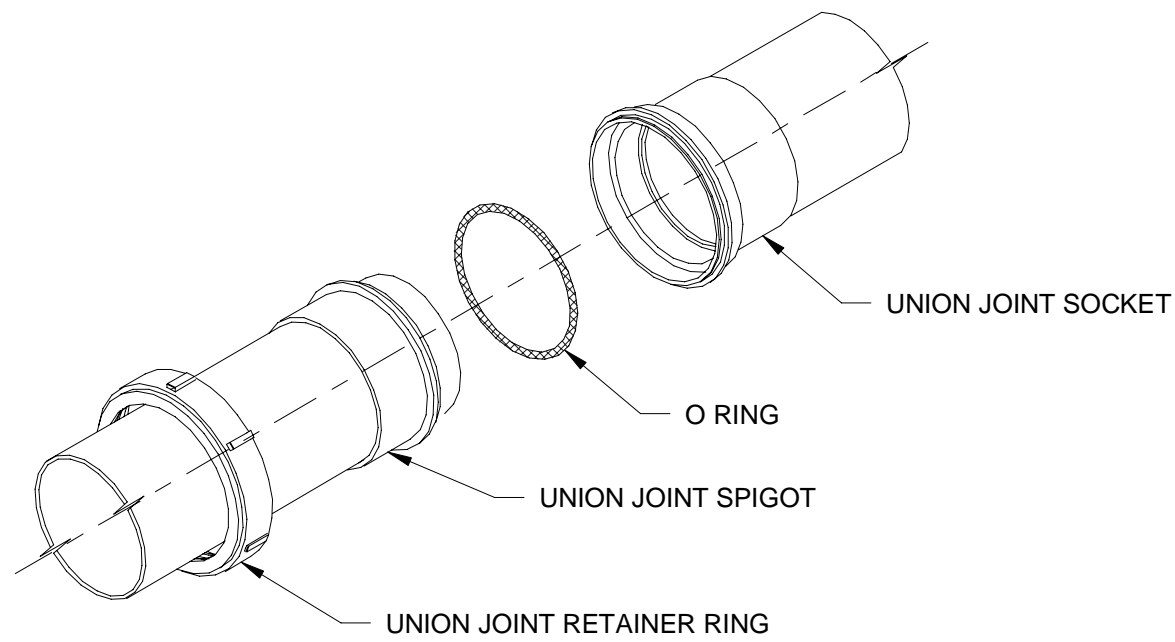

NOTES:

- THIS DETAIL IS PROVIDED FOR REFERENCE ONLY BY THE AGS SYSTEM SUPPLIER IDENTIFIED IN THE BASE BID (TYPE III) MATERIAL AND EQUIPMENT SCHEDULE. FINAL INSTALLATION DETAILS ARE TO BE COORDINATED BY THE CONTRACTOR BASED ON THE ACTUAL EQUIPMENT SUPPLIED AND AGS SYSTEM SUPPLIER SUBMITTAL PACKAGE.

H AGS REACTOR RISER AIR DISTRIBUTOR UNION JOINT ASSEMBLY
NO SCALE

AEROBIC GRANULAR
SLUDGE - PHASE 1


REVISIONS AND RECORD OF ISSUE	
DESIGNED:	JL
DETAILED:	NN
CHECKED:	AM/JH
APPROVED:	MR
DATE:	12/20/2022
PROJECT NO.:	411752

ETAILS

PROCESS MECHANICAL


MECHANICAL DETAILS
3 OF 4

99-M-503

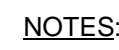49
DF
63


1. THIS DETAIL IS PROVIDED FOR REFERENCE ONLY BY THE AGS SYSTEM SUPPLIER IDENTIFIED IN THE BASE BID (TYPE III) MATERIAL AND EQUIPMENT SCHEDULE. FINAL INSTALLATION DETAILS ARE TO BE COORDINATED BY THE CONTRACTOR BASED ON THE ACTUAL EQUIPMENT SUPPLIED AND AGS SYSTEM SUPPLIER SUBMITTAL PACKAGE.

AGS REACTOR MANIFOLD SUPPORT ASSEMBLY

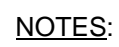


1. THIS DETAIL IS PROVIDED FOR REFERENCE ONLY BY THE AGS SYSTEM SUPPLIER IDENTIFIED IN THE BASE BID (TYPE III) MATERIAL AND EQUIPMENT SCHEDULE. FINAL INSTALLATION DETAILS ARE TO BE COORDINATED BY THE CONTRACTOR BASED ON THE ACTUAL EQUIPMENT SUPPLIED AND AGS SYSTEM SUPPLIER SUBMITTAL PACKAGE.

 AGS REACTOR AIR DISTRIBUTOR ANCHOR SUPPORT ASSEMBLY
NO SCALE

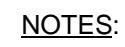


1. THIS DETAIL IS PROVIDED FOR REFERENCE ONLY BY THE AGS SYSTEM SUPPLIER IDENTIFIED IN THE BASE BID (TYPE III) MATERIAL AND EQUIPMENT SCHEDULE. FINAL INSTALLATION DETAILS ARE TO BE COORDINATED BY THE CONTRACTOR BASED ON THE ACTUAL EQUIPMENT SUPPLIED AND AGS SYSTEM SUPPLIER SUBMITTAL PACKAGE.

AGS REACTOR RISER MANIFOLD SUPPORT ASSEMBLY - ALL THREAD

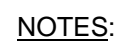

1. THIS DETAIL IS PROVIDED FOR REFERENCE ONLY BY THE AGS SYSTEM SUPPLIER IDENTIFIED IN THE BASE BID (TYPE III) MATERIAL AND EQUIPMENT SCHEDULE. FINAL INSTALLATION DETAILS ARE TO BE COORDINATED BY THE CONTRACTOR BASED ON THE ACTUAL EQUIPMENT SUPPLIED AND AGS SYSTEM SUPPLIER SUBMITTAL PACKAGE.

AGS REACTOR RISER AIR DISTRIBUTOR GUIDE SUPPORT ASSEMBLY

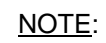

1. AGS SYSTEM SUPPLIER EFFLUENT CHANNEL SIZED BY OTHER FOR FREE FLOW.

AGS REACTOR EFFLUENT LATERAL DETAILS



EFFLUENT CHANNEL CONNECTION



WALL SUPPORT

- NOTE:

1. THIS DETAIL IS PROVIDED FOR REFERENCE ONLY BY THE AGS SYSTEM SUPPLIER IDENTIFIED IN THE BASE BID (TYPE III) MATERIAL AND EQUIPMENT SCHEDULE. FINAL INSTALLATION DETAILS ARE TO BE COORDINATED BY THE CONTRACTOR BASED ON THE ACTUAL EQUIPMENT SUPPLIED AND AGS SYSTEM SUPPLIER SUBMITTAL PACKAGE.

SUPPORT DETAIL

(SCALE BAR IS 4" AT FULL SCALE)

REVISIONS AND RECORD OF ISSUE	
DESIGNED:	MD
DETAILED:	NN
CHECKED:	JL
APPROVED:	MR
DATE:	12/20/2022
PROJECT NO.:	411752


DETAILS

PROCESS MECHANICAL

MECHANICAL DETAILS
4 OF 4

99-M-504


150
OF
163

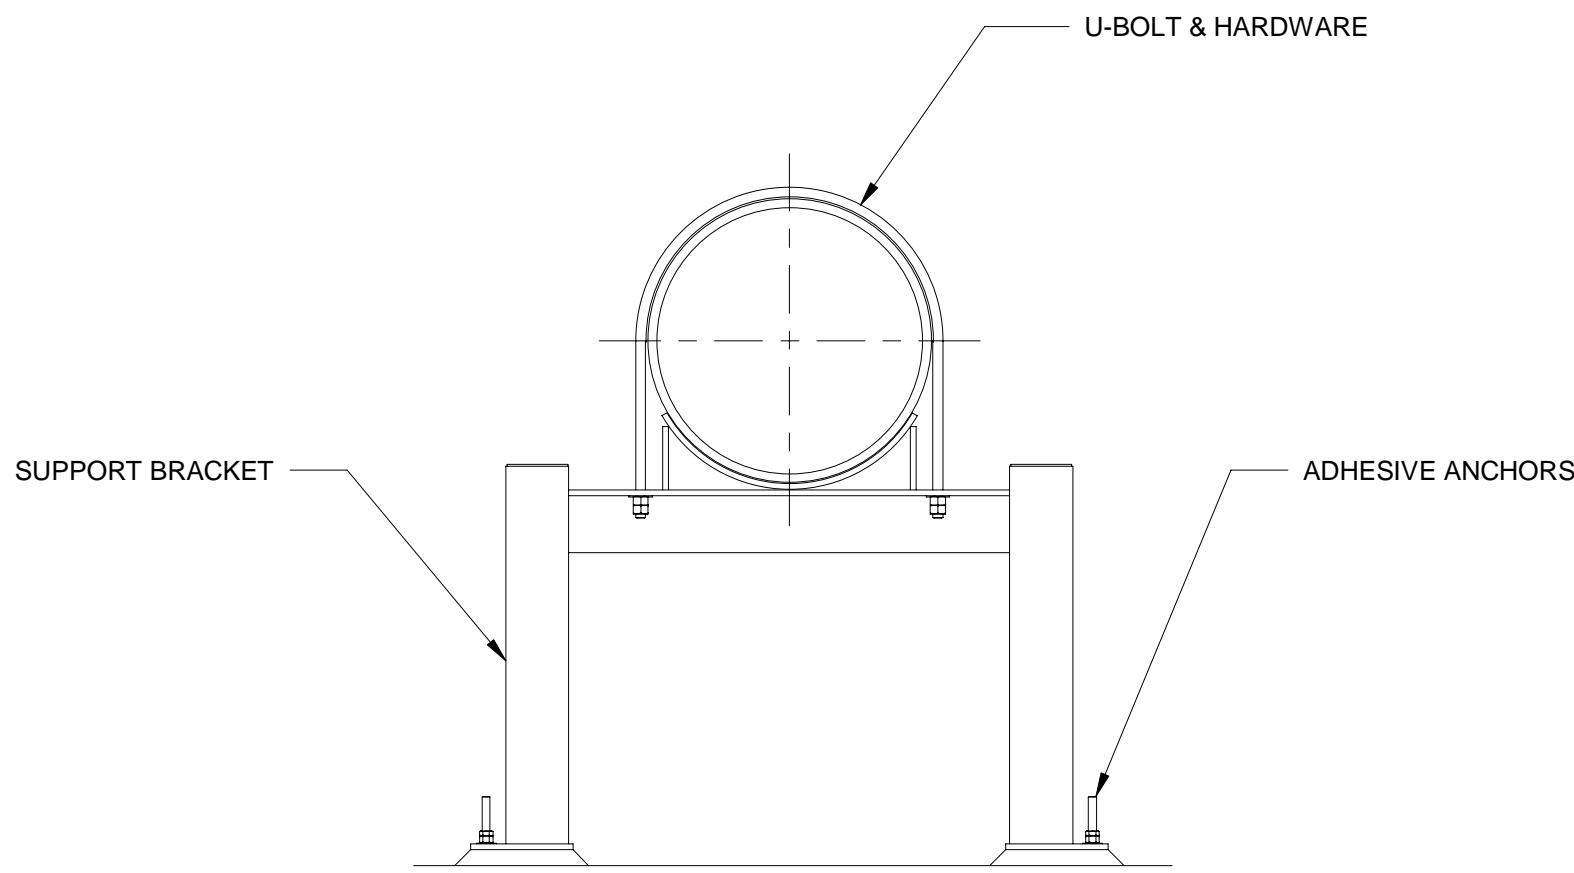

NOTES:

1. THIS DETAIL IS PROVIDED FOR REFERENCE ONLY BY THE AGS SYSTEM SUPPLIER IDENTIFIED IN THE BASE BID (TYPE III) MATERIAL AND EQUIPMENT SCHEDULE. FINAL INSTALLATION DETAILS ARE TO BE COORDINATED BY THE CONTRACTOR BASED ON THE ACTUAL EQUIPMENT SUPPLIED AND AGS SYSTEM SUPPLIER SUBMITTAL PACKAGE.


A AGS REACTOR INFLUENT HEADER SUPPORT DETAIL
NO SCALE

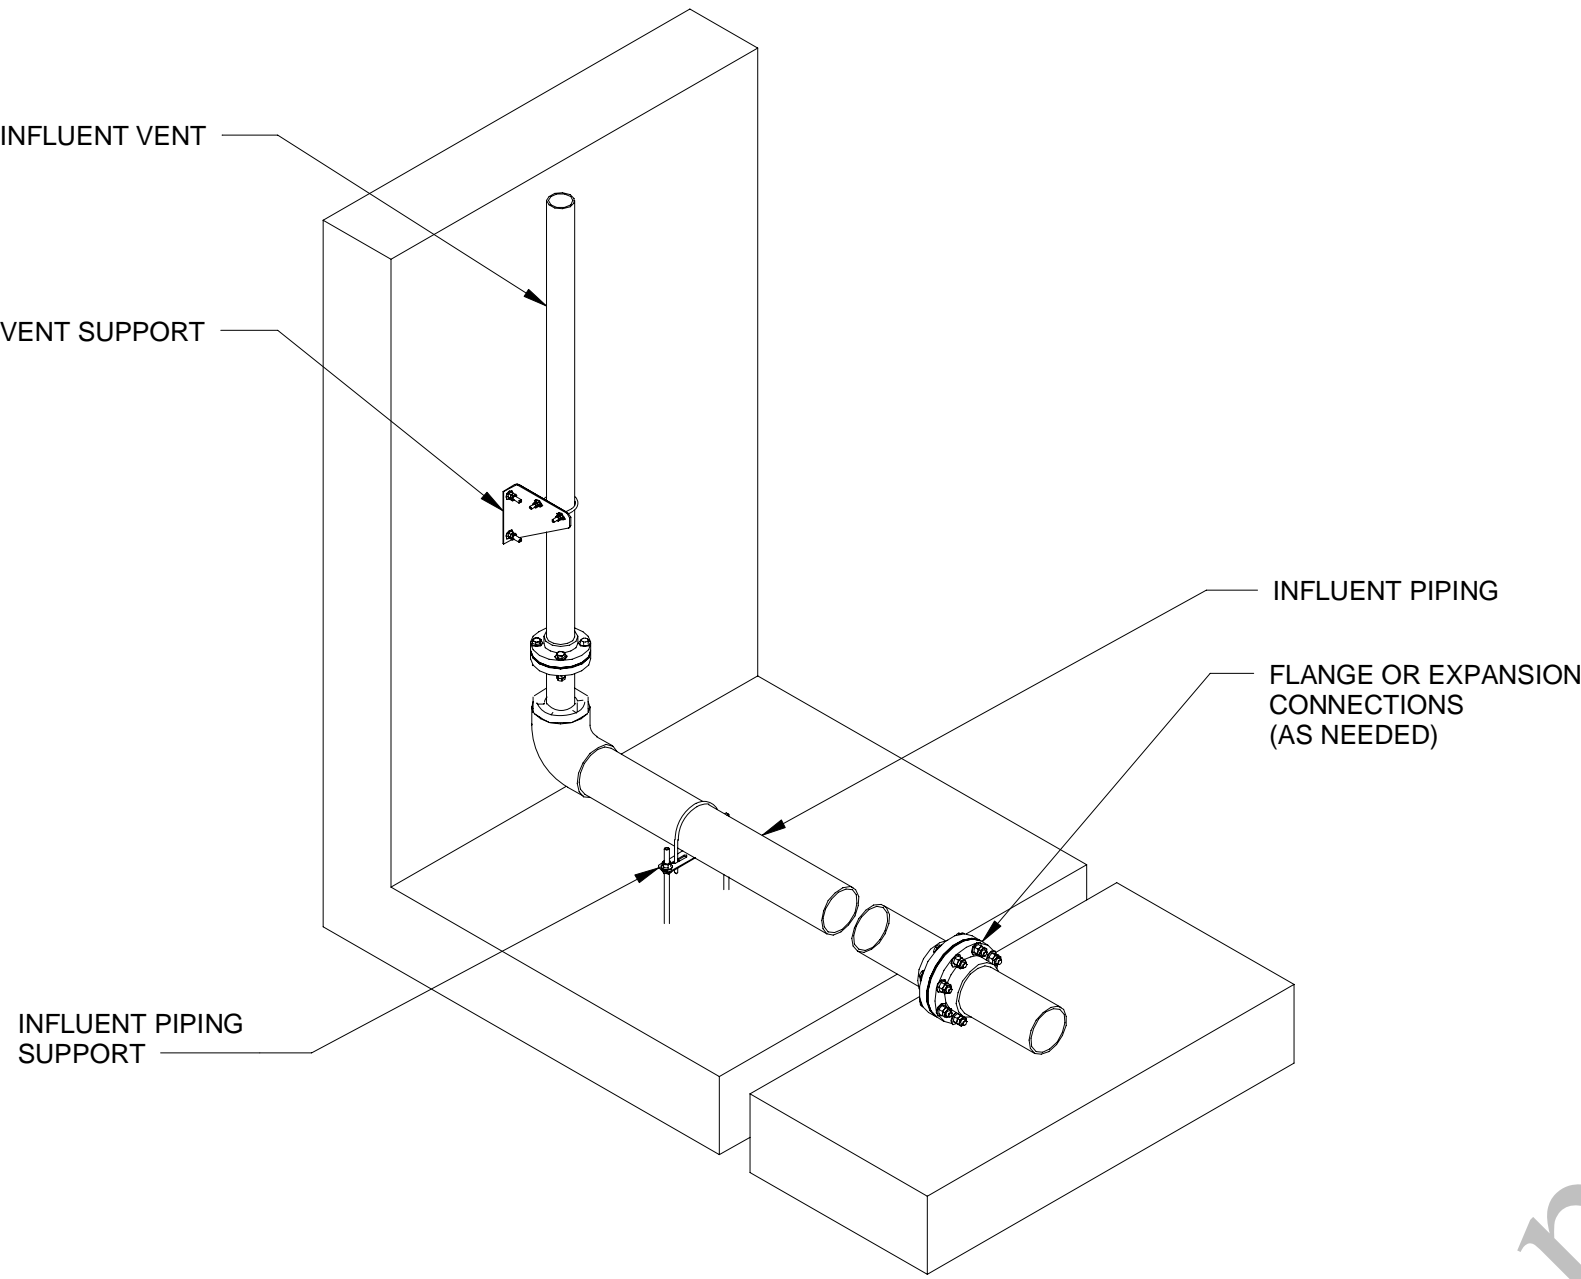

NOTES:

1. THIS DETAIL IS PROVIDED FOR REFERENCE ONLY BY THE AGS SYSTEM SUPPLIER IDENTIFIED IN THE BASE BID (TYPE III) MATERIAL AND EQUIPMENT SCHEDULE. FINAL INSTALLATION DETAILS ARE TO BE COORDINATED BY THE CONTRACTOR BASED ON THE ACTUAL EQUIPMENT SUPPLIED AND AGS SYSTEM SUPPLIER SUBMITTAL PACKAGE.

B AGS REACTOR INFLUENT LATERAL SUPPORT DETAIL
NO SCALE

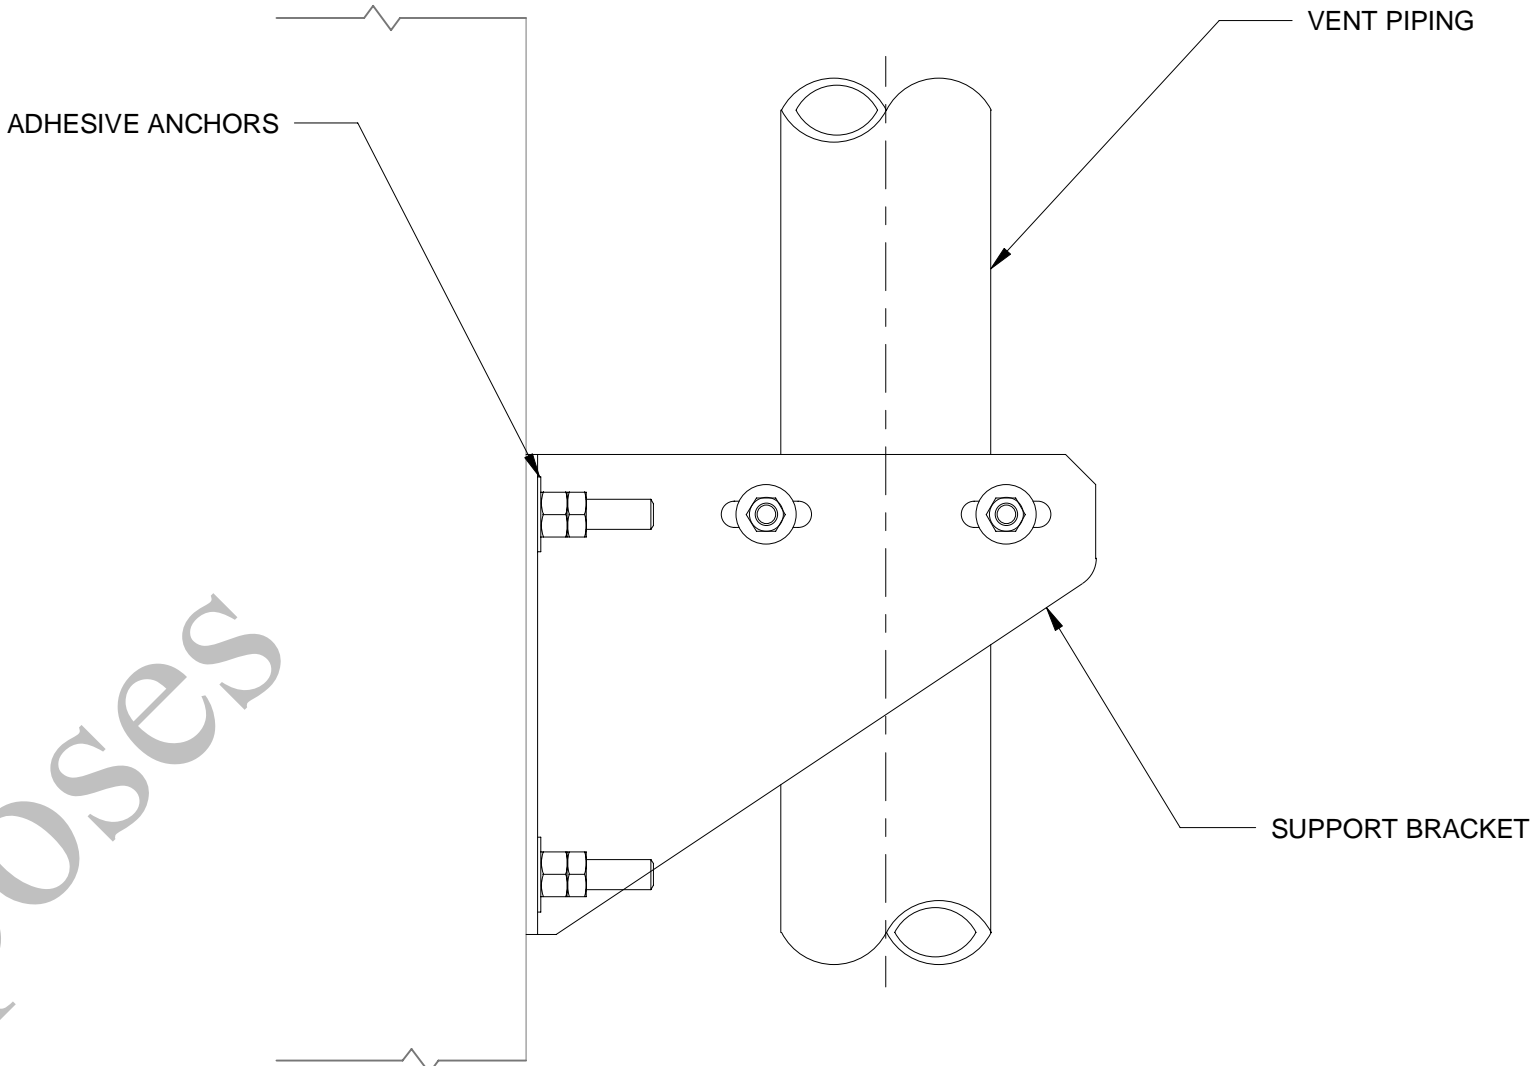

NOTES:

1. THIS DETAIL IS PROVIDED FOR REFERENCE ONLY BY THE AGS SYSTEM SUPPLIER IDENTIFIED IN THE BASE BID (TYPE III) MATERIAL AND EQUIPMENT SCHEDULE. FINAL INSTALLATION DETAILS ARE TO BE COORDINATED BY THE CONTRACTOR BASED ON THE ACTUAL EQUIPMENT SUPPLIED AND AGS SYSTEM SUPPLIER SUBMITTAL PACKAGE.

C AGS REACTOR VENT SUPPORT DETAIL
NO SCALE

INFLUENT DISTRIBUTION ASSEMBLY	
LATERALS	
LATERAL SIZE	8 IN
TOTAL LENGTH OF LATERAL PIPES	1,728 FT
NO. OF INFLUENT PIPING SUPPORTS	289
LATERAL MATERIAL	PVC
LATERAL VENT SIZE	3 IN
NO. OF VENT SUPPORTS	144
VENT MATERIAL	PVC
HEADERS	
HEADER SIZE	36 IN
TOTAL LENGTH OF HEADER	77 FT
NO. OF HEADER SUPPORTS	2
HEADER MATERIAL	HDPE
HEADER VENT SIZE	8 IN
NO. OF VENTS SUPPORTS	6
VENT MATERIAL	PVC


EFFLUENT WEIR ASSEMBLY	
LATERALS	
TOTAL LENGTH OF LATERALS	304 FT
NO. OF INTERMEDIATE SUPPORTS	8
NO. OF WALL SUPPORTS	16
LATERAL MATERIAL	316 SS
CHANNEL (BY OTHERS)	
LENGTH OF CHANNEL	73 FT
CHANNEL MATERIAL	CONCRETE

NOTES:


1. ALL SIZES ARE NOMINAL AND MAY BE ADJUSTED AT TIME OF ORDER.
2. ALL QUANTITIES AND LENGTHS ARE APPROXIMATE AND MAY VARY +/- 10%.
3. THIS DETAIL IS PROVIDED FOR REFERENCE ONLY BY THE AGS SYSTEM SUPPLIER IDENTIFIED IN THE BASE BID (TYPE III) MATERIAL AND EQUIPMENT SCHEDULE. FINAL INSTALLATION DETAILS ARE TO BE COORDINATED BY THE CONTRACTOR BASED ON THE ACTUAL EQUIPMENT SUPPLIED AND AGS SYSTEM SUPPLIER SUBMITTAL PACKAGE.

SOLIDS WASTE SYSTEM	
LATERALS	
LATERAL SIZE	8 IN
TOTAL LENGTH OF LATERALS	80 FT
LATERAL MATERIAL	HDPE
SOLIDS WASTE LATERALS MAY BE SUPPORTED WITH THE INTERMEDIATE EFFLUENT WEIR SUPPORTS	
HEADERS	
HEADER SIZE (H1)	16 IN
LENGTH OF HEADER (H1)	64 FT
NO. OF HEADER SUPPORTS	5
HEADER MATERIAL	HDPE


PLOTTED: 12/16/2022 11:48:43 AM
 FILE: BIM 360/409469 - Aerobic Granular Sludge Phase 1/409469 - AGS.rvt
 D11000

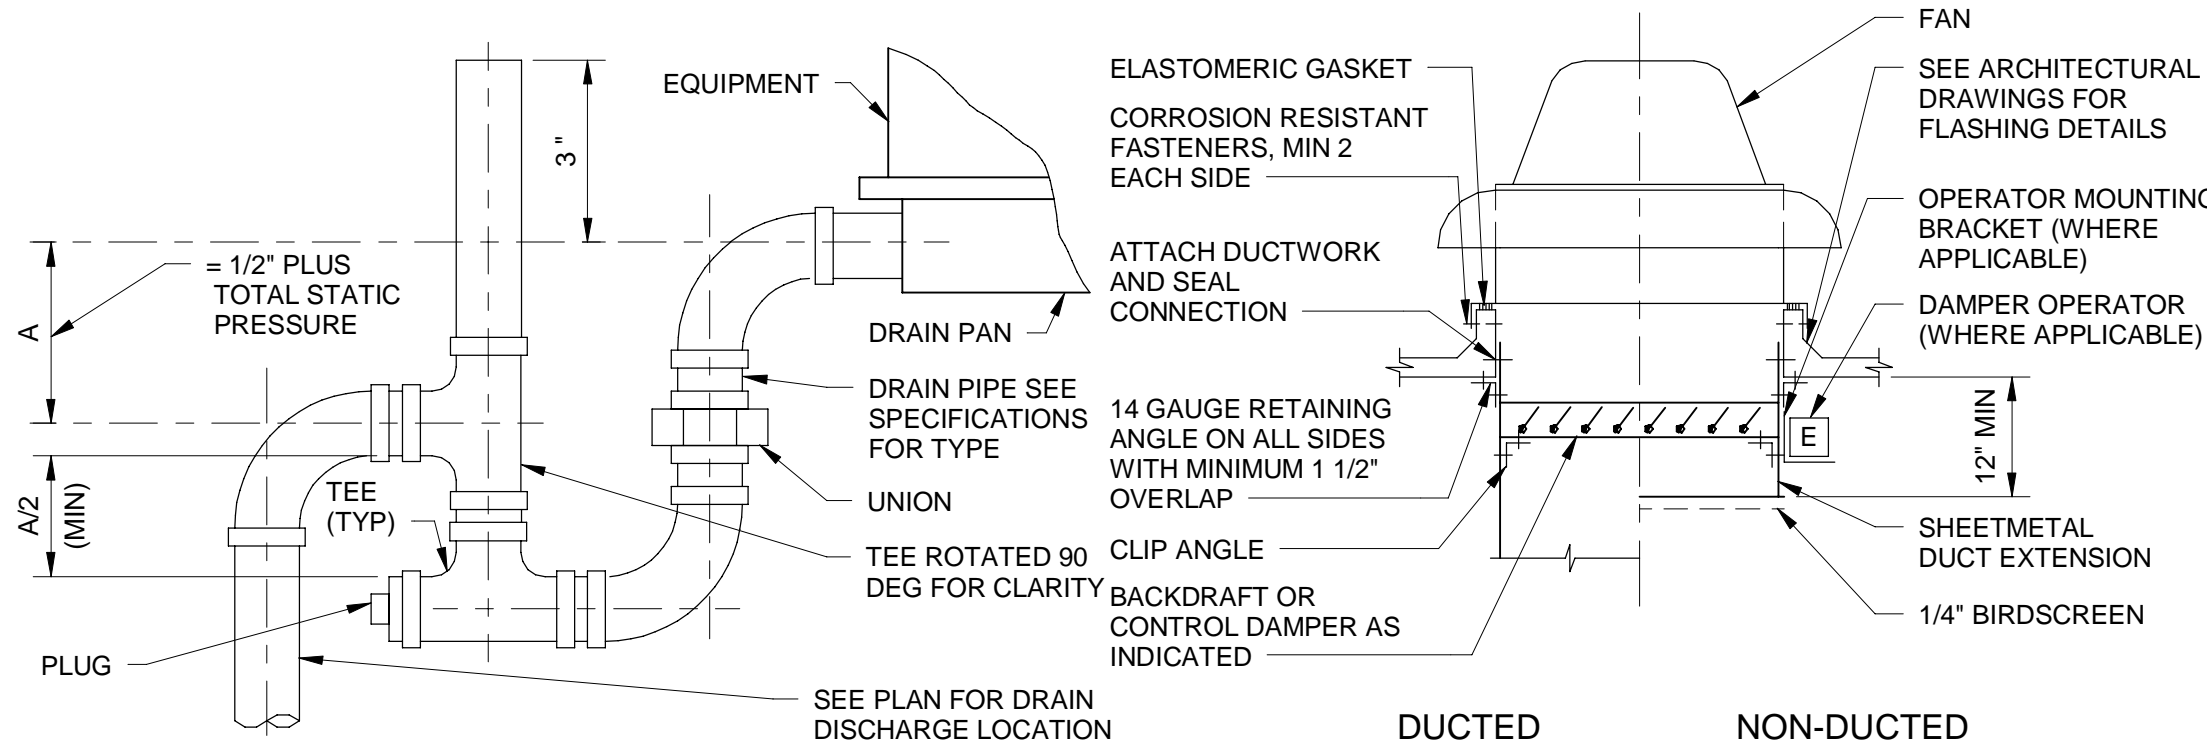


A DRAIN PAN TRAP - DRAW THROUGH
 NO SCALE

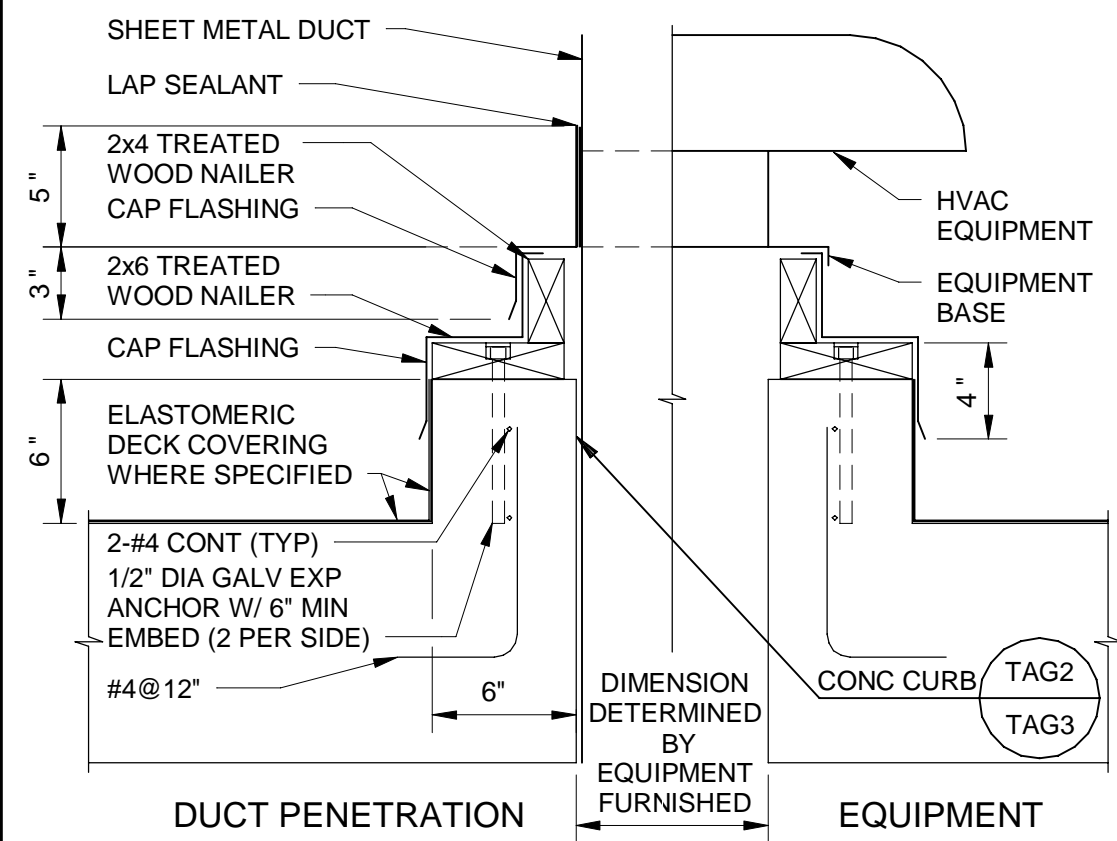


F HVAC EQUIPMENT CURB
 NO SCALE

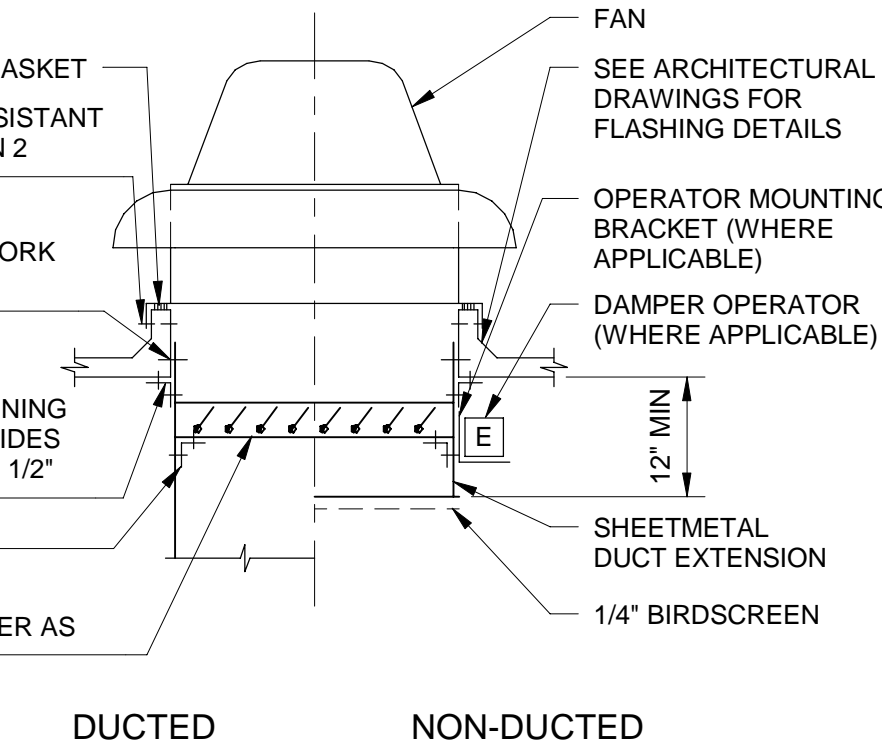


B ROOF MOUNTED FAN
 NO SCALE

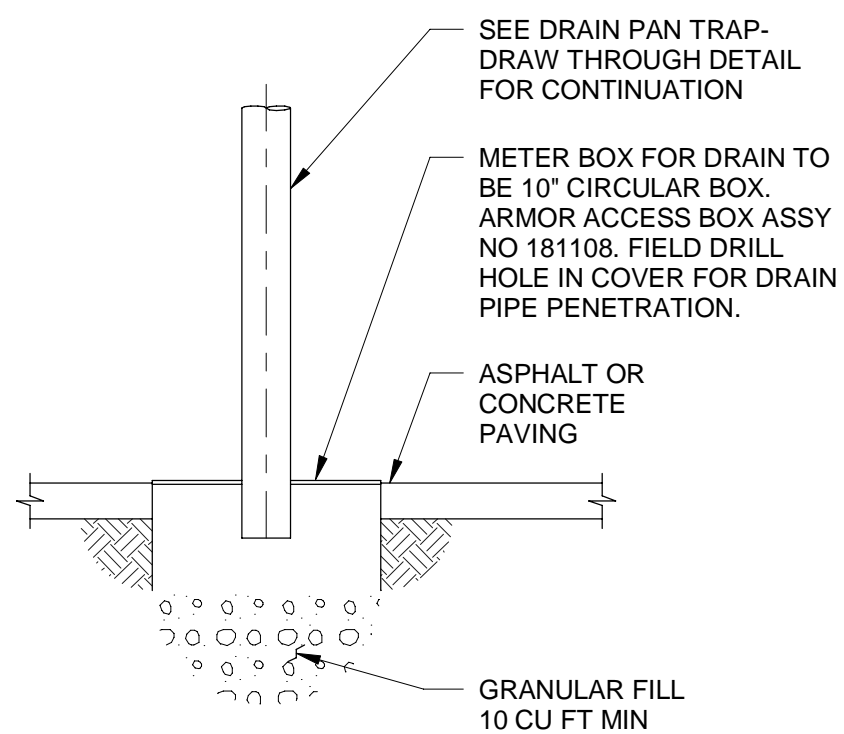


G CONDENSATE DRAIN SUMP
 NO SCALE

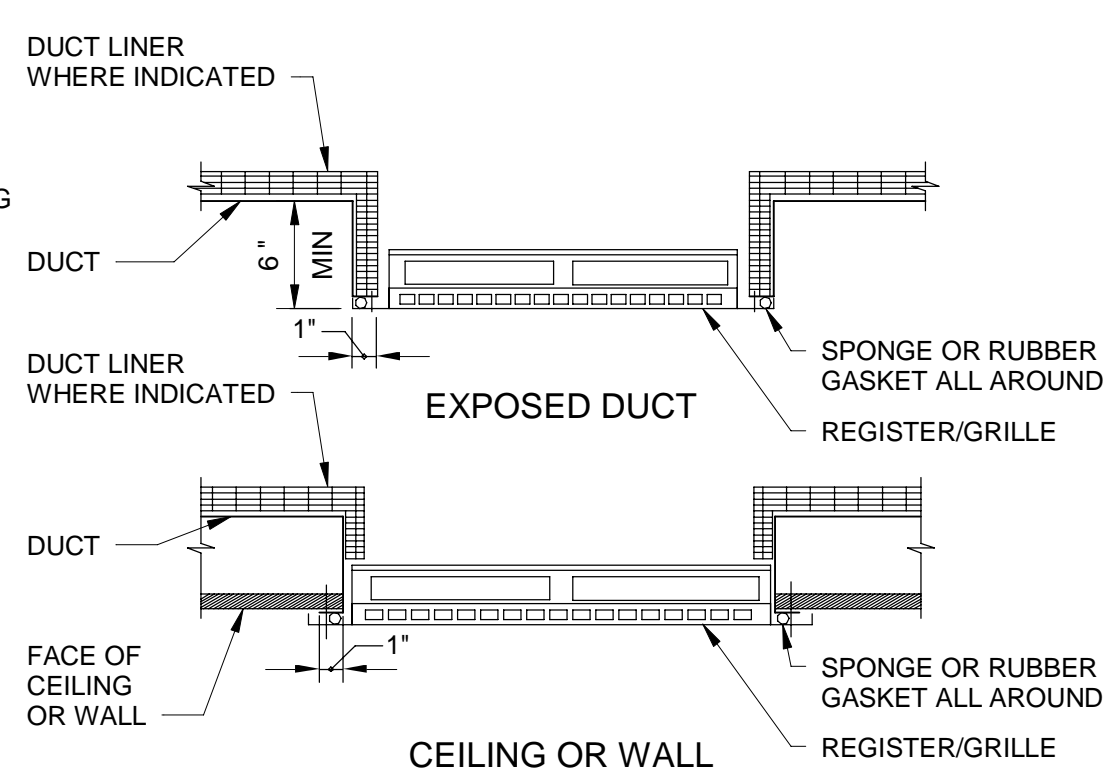

C REGISTER/GRILLE
 NO SCALE

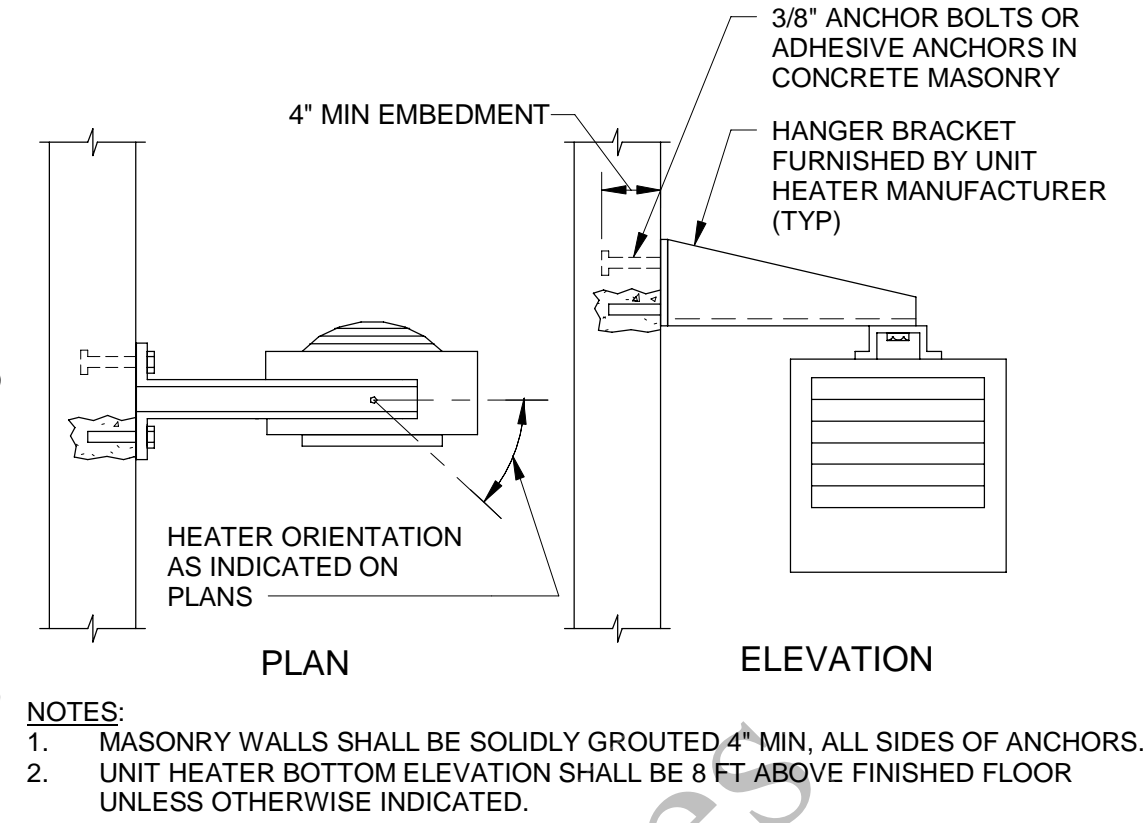

D ELECTRIC UNIT HEATER SUPPORT
 NO SCALE

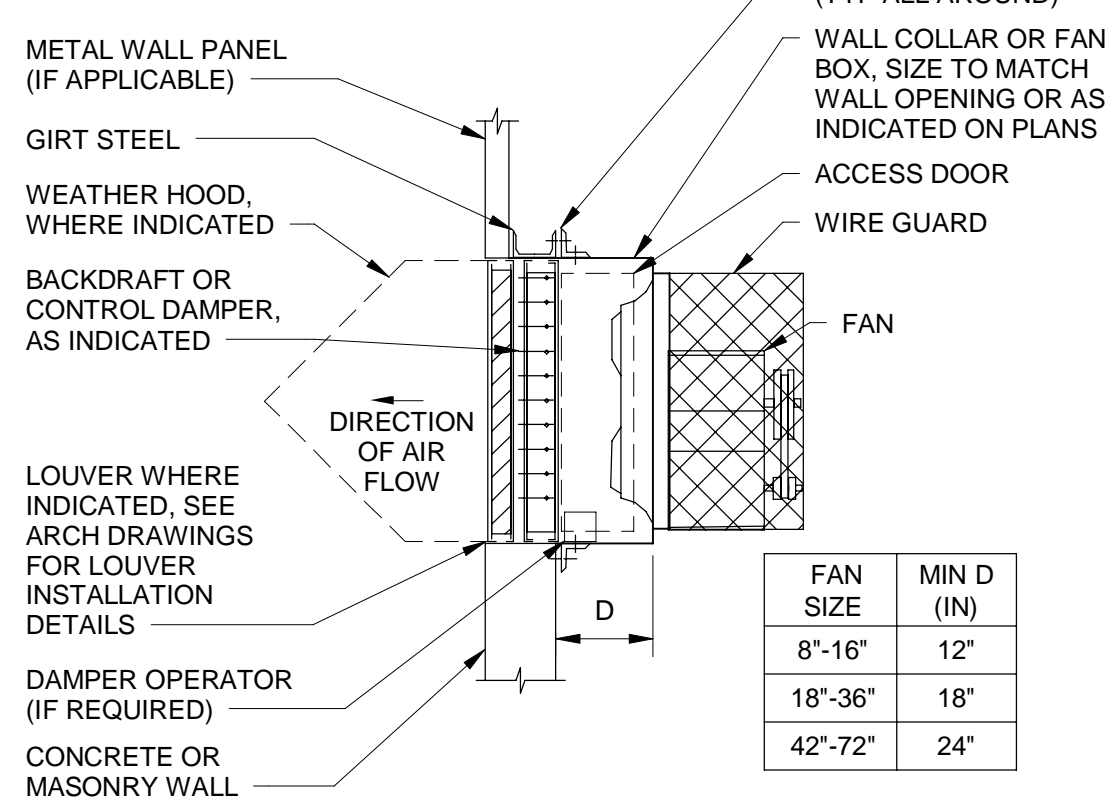

E PROPELLER FAN
 NO SCALE

FAN SIZE	MIN D (IN)
8"-16"	12"
18"-36"	18"
42"-72"	24"

- NOTES:
 1. MASONRY WALLS SHALL BE SOLIDLY GROUTED 4" MIN, ALL SIDES OF ANCHORS.
 2. UNIT HEATER BOTTOM ELEVATION SHALL BE 8 FT ABOVE FINISHED FLOOR UNLESS OTHERWISE INDICATED.

REVISIONS AND RECORD OF ISSUE	
DESIGNED:	VSS
DETAILED:	AJP
CHECKED:	KMC
APPROVED:	SP
DATE:	12/20/2022
PROJECT NO.:	411752

HVAC SEQUENCE OF OPERATIONS:

1. GENERAL SYSTEM OPERATIONS.

1.1. TEMPERATURE CONTROL PANEL(S). FRSA AGS BUILDINGS ARE CONTROLLED AND MONITORED BY DDC SYSTEM. THE SYSTEM HIERARCHY BUILT SUCH AS LOCAL PANELS 01-TCP-0001, 02-TCP-0001, 01-ECP-0001 ARE CONNECTED TO 01-DDC-0001 PANEL LOCATED IN THE MCC ROOM. THE DDC PANEL TIED IN WITH EXISTING PLANT DDC SYSTEM. ALL PANELS SHOULD HAVE NECESSARY CONTROLLERS AND COMPONENTS FOR EQUIPMENT MONITORING, REMOTE ACCESS, AND REMOTE COMMANDING. TEMPERATURE CONTROL PANEL(S) (TCP) AND EQUIPMENT CONTROL PANELS (ECP) IDENTIFIED IN THE SEQUENCE OF OPERATION SHALL BE PROVIDED WITH THE INDICATING LIGHTS, RUNNING LIGHTS, ALARM LIGHTS, AUDIBLE ALARMS, TIMERS, AND SELECTOR SWITCHES FOR CONTROL AND STATUS INDICATION OF THE EQUIPMENT SERVED. WHERE NO CONTROL PANELS ARE PROVIDED FOR EQUIPMENT, THE LIGHTS AND SWITCHES SHALL BE AT THE STARTER OR MCC. RUNNING LIGHTS SHALL BE PROVIDED TO INDICATE BOTH ENERGIZED AND DE-ENERGIZED CONDITIONS FOR THE EQUIPMENT AND SHALL POSITIVELY INDICATE EQUIPMENT CONDITIONS FROM THE MOTOR STARTER OR CURRENT SENSOR. SWITCH POSITION SHALL NOT BE USED FOR LIGHT ILLUMINATION. INDICATING AND RUNNING LIGHTS SHALL BE LOCATED DIRECTLY ABOVE EACH RESPECTIVE SELECTOR SWITCH WITH LIGHT COLORS AS FOLLOWS:

RED -DE-ENERGIZED
 GREEN -ENERGIZED
 AMBER -ALARM
 WHITE -STATUS

INDICATING LIGHTS AND SELECTOR SWITCHES SHALL BE LOCATED ON THE FACE OF THE TEMPERATURE CONTROL PANEL SERVING THE RESPECTIVE EQUIPMENT. IN ADDITION TO THE LIGHTS, TIMERS, AND SELECTOR SWITCHES DESCRIBED IN THE SEQUENCE OF OPERATION FOR THE INDIVIDUAL EQUIPMENT, EACH CONTROL PANEL SHALL BE PROVIDED WITH THE FOLLOWING:

CONTROL POWER ON STATUS LIGHT
 INDICATING LIGHT TEST PUSHBUTTON
 ALARM SILENCE PUSHBUTTON
 ALARM RESET PUSHBUTTON (WHERE APPLICABLE)

CONTROL PANELS SPECIFIED TO BE PROVIDED WITH ALARM CONDITION INDICATING LIGHTS SHALL BE PROVIDED WITH AN ELECTRICALLY ISOLATED CONTACT TO PROVIDE A COMMON ALARM TO THE PLANT CONTROL SYSTEM (PCS).

TEMPERATURE CONTROL PANELS SHALL COME WITH PHENOLIC NAMEPLATES FOR EACH CONTROL SWITCH INDICATING SWITCH TYPE, EQUIPMENT CONTROLLED, ROOM OR AREA SERVED, AND SWITCH AUTOMATIC POSITION EQUIPMENT INTERLOCK

1.2. SYSTEM INTERLOCKS AND ALARMS

UNLESS OTHERWISE INDICATED, ALL EQUIPMENT INTERLOCKING DEVICES AS DESCRIBED HEREIN SHALL BE PROVIDED WITHIN THE RESPECTIVE TEMPERATURE/EQUIPMENT CONTROL PANEL (TCP/ECP).

1.3 LOW LIMIT TEMPERATURE ALARM PROVIDED BY THE DUCT SENSOR T-01-0001 WITH AUTO-RESET. ALARM SETPOINT: 38F

1.4. VENTILATION SYSTEM FAILURE.

1.4.1. VENTILATION SYSTEM FAILURE (AIRFLOW SWITCHES). VENTILATION SYSTEM FAILURE PRESSURE DIFFERENTIAL SWITCHES SHALL BE LOCATED IN THE SYSTEMS INDICATED BELOW. IN THE EVENT THAT AIRFLOW IS NOT ATTAINED OR LOST AS DETERMINED BY THE PRESSURE DIFFERENTIAL FLOW SWITCH, A "VENTILATION SYSTEM FAILURE" SIGNAL SHALL BE TRANSMITTED THE FIRE ALARM SIGNAL SHALL BE RECEIVED BY DDC SYSTEM AND IF A ZONE ALARM IS WHERE THE HVAC EQUIPMENT LOCATED, DDC SYSTEM SHALL DISABLE THE EQUIPMENT UNTIL ALARM CLEARED HAVE A NORMALLY OPEN CONTACT FOR TRANSMITTING A SIGNAL TO THE RESPECTIVE TEMPERATURE/EQUIPMENT CONTROL PANEL ILLUMINATING AN ALARM INDICATING LIGHT FOR THE RESPECTIVE EQUIPMENT.

EQUIPMENT	VENTILATION FAILURE ALARM DESTINATION	TEMPERATURE/EQUIPMENT CONTROL PANEL
01-EF-0001	01-PDS-0001	01-ECP-0001
01-EF-0002	01-PDS-0002	01-ECP-0001

1.4.2. VENTILATION SYSTEM FAILURE (CURRENT SENSOR SWITCHES). MOTOR CURRENT SENSOR SWITCHES SHALL BE INSTALLED ON THE EQUIPMENT OR AT THE EQUIPMENT MOTOR STARTER TO INDICATE VENTILATION SYSTEM FAILURE INCLUDING DETECTION OF BELT LOSS OR FAN MOTOR FAILURE. IN THE EVENT THAT THE EQUIPMENT FAILS TO OPERATE AS DETERMINED BY THE CURRENT SENSOR SWITCH, A "VENTILATION SYSTEM FAILURE" SIGNAL SHALL BE TRANSMITTED TO THE FIRE ALARM SIGNALING SYSTEM. BELOW, WHEN THE SIGNAL IS TRANSMITTED TO THE FIRE ALARM SIGNALING SYSTEM, A VISUAL ALARM SHALL BE ILLUMINATED AND AUDIBLE ALARM SHALL SOUND AT EACH ROOM ENTRANCE AND WITHIN THE ROOM. THE FIRE ALARM SIGNALING SYSTEMS SHALL HAVE A NORMALLY OPEN CONTACT FOR TRANSMITTING A SIGNAL TO THE RESPECTIVE TEMPERATURE/EQUIPMENT CONTROL PANEL ILLUMINATING A "VENTILATION FAILURE" INDICATING LIGHT FOR THE RESPECTIVE EQUIPMENT. WHEN THE SIGNAL IS TRANSMITTED TO THE PCS, A SIGNAL SHALL ALSO BE SENT TO THE RESPECTIVE TEMPERATURE/EQUIPMENT CONTROL PANEL ILLUMINATING A "VENTILATION FAILURE" INDICATING LIGHT FOR THE RESPECTIVE EQUIPMENT.

EQUIPMENT	VENTILATION FAILURE ALARM DESTINATION	TEMPERATURE/EQUIPMENT CONTROL PANEL
02-EF-0001	BUILT-IN	01-TCP-0001
02-EF-0002	BUILT-IN	01-TCP-0001

2. HEATING SYSTEMS.

2.1. ELECTRIC UNIT HEATERS. UNIT HEATERS SHALL BE CONTROLLED BY THEIR RESPECTIVE WALL-MOUNTED THERMOSTATS.

THE THERMOSTAT SHALL ENABLE THE RESPECTIVE UNIT HEATER TO MAINTAIN THE ROOM SETPOINT TEMPERATURE. UPON REACHING OF THE REQUIRED SETPOINT, THE UNIT HEATER SHALL BE DISABLED.

2.2. ELECTRIC FAN FORCED WALL HEATERS. WALL HEATERS SHALL BE CONTROLLED BY THEIR BUILT-IN THERMOSTATS. UPON REACHING THE SETPOINT, A WALL HEATER SHALL BE DISABLED.

3. VENTILATING/EXHAUST SYSTEMS.

3.1. "ON-OFF-AUTO" EQUIPMENT CONTROL. EQUIPMENT INDICATED FOR "ON-OFF-AUTO" CONTROL SHALL EACH BE CONTROLLED BY AN INDIVIDUAL "ON-OFF-AUTO" FAN SELECTOR SWITCH. THE SWITCH LOCATION SHALL BE AS INDICATED BELOW. WHEN THE SWITCH IS PLACED IN THE "AUTO" POSITION, THE FAN SHALL BE INTERLOCKED AND CONTROLLED BY THE FAN INTERLOCK. WHEN THE SWITCH IS PLACED IN THE "ON" POSITION, THE FAN SHALL BE ENERGIZED. BEFORE A FAN CAN OPERATE, THE CONTROL DAMPER 02-CD-0001 SHALL BE PROVEN OPEN FIRST. WHERE THE FAN IS INTERLOCKED WITH ANOTHER FAN OR EQUIPMENT WITH A FAN, THE FANS SHALL BE ENERGIZED SIMULTANEOUSLY AFTER ALL ASSOCIATED CONTROL DAMPERS ARE PROVEN OPEN. WHEN THE FAN IS DE-ENERGIZED, THE CONTROL DAMPER 02-CD-0002 SHALL RETURN TO NORMALLY CLOSED POSITION AT LAST UNLESS OTHERWISE INDICATED.

EQUIPMENT	SWITCH LOCATION	FAN INTERLOCK	CONTROL DAMPER(S)
01-EF-0001	01-TCP-0001	01-MAU-0001	01-CD-0001
01-EF-0002	01-TCP-0001	01-MAU-0001	01-CD-0002
01-EF-0003	01-TCP-0001	T-01-0002	01-CD-0003
01-EF-0004	01-TCP-0001	T-01-0003	01-CD-0004
02-EF-0001	02-TCP-0001	T-02-0001	02-CD-0001, 02-CD-0004 02-CD-0002, 02-CD-0003
02-EF-0002	02-TCP-0001	T-02-0002	

4. HEATING AND VENTILATING SYSTEMS.

4.1. MAKEUP AIR UNIT (100% OUTSIDE AIR). MAKEUP AIR UNIT SHALL BE CONTROLLED BY AN INDIVIDUAL "SUMMER/OFF-WINTER" SYSTEM SELECTOR SWITCH. THE SWITCH LOCATION SHALL BE AS INDICATED BELOW. WHEN THE SWITCH IS PLACED IN THE "WINTER" POSITION, THE FAN SHALL OPERATE AND THE SUPPLY AIR SENSOR/THERMOSTAT SHALL MODULATE THE HEATING OUTPUT OF THE UNIT TO MAINTAIN THE DESIRED SUPPLY AIR TEMPERATURE. BEFORE THE FAN CAN OPERATE, THE CONTROL DAMPERS SHALL BE PROVEN OPEN. WHEN THE OUTSIDE AIR TEMPERATURE IS GREATER THAN THE HEATING CHANGEOVER TEMPERATURE SETPOINT AS DETECTED BY THE OUTDOOR AIR SENSOR/THERMOSTAT, THE HEATING SHALL BE LOCKED OUT. WHEN THE SWITCH IS PLACED IN THE "SUMMER" POSITION, THE FAN SHALL OPERATE AND THE HEATING SHALL BE LOCKED OUT. WHEN THE UNIT IS DE-ENERGIZED, THE CONTROL DAMPER(S) SHALL CLOSE, AND INTERLOCKED EQUIPMENT 01-EF-0001, 01-EF-0002 SHALL BE DE-ENERGIZED.

THE MAKEUP AIR UNIT FAN SHALL BE PROVIDED WITH A TWO-SPEED MOTOR OR VARIABLE FREQUENCY DRIVE. THE FAN MOTOR SHALL OPERATE AT FULL SPEED WHEN OUTDOOR AIR TEMPERATURE IS ABOVE THE CHANGEOVER SETPOINT AS DETECTED BY THE OUTDOOR AIR SENSOR, OR THE BUILDING IS OCCUPIED AS DETECTED BY A SIGNAL FROM THE DDC SYSTEM BUILDING LIGHTS, DOOR SWITCHES, COMBUSTIBLE GAS IS DETECTED AS INDICATED BY A SIGNAL FROM THE DDC SYSTEM COMBUSTIBLE GAS DETECTOR (WHERE INSTALLED). AT ALL OTHER CONDITIONS THE FAN SHALL OPERATE AT HALF SPEED. THE 01-MAU-0001 SHALL BE INTERLOCKED WITH 01-EF-0001 AND 01-EF-0002 WITH SPEED INTERLOCK. WHEN SUPPLY FAN IN HALF SPEED, BOTH EXHAUST FANS ARE IN HALF SPEED ALSO. PIPE GALLERY VENTILATION SYSTEM SHALL MAINTAIN THE ROOM UNDER POSITIVE 0.1" W.C. PRESSURE TO PREVENT OUTDOOR ODORS INFILTRATE THE ROOM. THE BALANCING CONTRACTOR TO SET THE AIRFLOW TO MEET THE REQUIRED ROOM PRESSURE.

EQUIPMENT	SWITCH LOCATION	SUPPLY AIR THERMOSTAT	CONTROL DAMPER(S)
01-MAU-0001	01-ECP-0001	T-01-0001	BUILT-IN

AIR DEVICE SCHEDULE								
SYMBOL	MANUFACTURER	MODEL	FRAME/BORDER	MODULE SIZE	MATERIAL	FINISH	DAMPER TYPE	NOTES
ER-1	TITUS	3F	SURFACE MOUNT	---	ALUMINUM	BAKED WHITE ENAMEL	OPPOSED BLADE	1
SR-1	TITUS	271	SURFACE MOUNT	---	ALUMINUM	BAKED WHITE ENAMEL	OPPOSED BLADE	1

HEAT PUMP BRANCH SELECTOR UNIT SCHEDULE						
UNIT NUMBER	MANUFACTURER	MODEL	POWER SUPPLY		MINIMUM CIRCUIT AMPACITY	NOTES
			VOLTS	PHASE		
02-BS-0001	MITSUBISHI	TAC-MKA32BC	208	1	0.01	---

HEAT PUMP SCHEDULE															
UNIT NUMBER	LOCATION	MANUFACTURER	MODEL	COOLING				HEATING OUTPUT RATED CAPACITY (BTU/H)	POWER SUPPLY		MINIMUM CIRCUIT AMPACITY	ARI MINIMUM EFFICIENCY	MATCHED WITH INDOOR UNIT	APPROX WEIGHT (LBS)	NOTES
				MAX RATED CAPACITY (BTU/H)	MIN RATED CAPACITY (BTU/H)	SUCTION TEMPERATURE (F)			VOLTS	PHASE					
						MINIMUM	MAXIMUM								
02-HP-0001	MCC (02-101)	MITSUBISHI	NTXSH42A152AA	38000	15500	45	55	27600	208	1	42	EER 13.4	02-FC-0001 & 02-FC-0002	300	1

FAN COIL SCHEDULE															
UNIT NUMBER	LOCATION	MANUFACTURER	MODEL	AIRFLOW (CFM)	AIR PD (IN WC)	EAT		LAT (FDB)	CAPACITY (BTU/H)			POWER SUPPLY			NOTES
						(FDB)	(FWB)		COOLING	HEATING	MCA	VOLTS	PHASE	APPROX WEIGHT (LBS)	
02-FC-0001	MCC (02-101)	MITSUBISHI	TPLA0A0241EA70B	710	0.25	80	67	55.8	19000	13800	1.0	208	1	100	1,2
02-FC-0002	MCC (02-101)	MITSUBISHI	TPLA0A0241EA70B	710	0.25	80	67	55.8	19000	13800	1.0	208	1	100	1,2

FAN SCHEDULE																
UNIT NUMBER	LOCATION	MANUFACTURER	MODEL	FAN TYPE	AIRFLOW (CFM)	ESP (IN WC)	BRAKE HP	MOTOR HP	POWER SUPPLY		MINIMUM WHEEL DIAMETER (IN)	WHEEL TYPE	DRIVE	VIBRATION ISOLATION	APPROX WEIGHT (LBS)	NOTES
									VOLTS	PHASE						
01-EF-0001	PIPE GALLERY ROOF (01-001)	GREENHECK	CUBE-240-10	PRV	3900	0.375	0.52	1	480	3	24	C	BELT	INTERNAL	300	1,2
01-EF-0002	PIPE GALLERY ROOF (01-001)	GREENHECK	CUBE-240-10	PRV	3900	0.375	0.52	1	480	3	24	C	BELT	INTERNAL	300	1,2
01-EF-0003	STAIR NO.1 (01-002)	GREENHECK	SE1-14-440-VG	PF	1100	0.675	0.41	1/2	208	1	14	P	DIRECT	INTERNAL	100	1,2,3
01-EF-0004	STAIR NO.1 (01-003)	GREENHECK	SE1-14-440-VG	PF	1100	0.675	0.41	1/2	208	1	14	P	DIRECT	INTERNAL	100	1,2,3
02-EF-0001	BLOWERS ROOM (02-102)	GREENHECK	CUBE-300-20	PRV	7200	0.75	1.67	3	480	3	30	C	BELT	INTERNAL	300	1,2
02-EF-0002	BLOWERS ROOM (02-102)	GREENHECK	CUBE-300-20	PRV	7200	0.75	1.67	3	480	3	30	C	BELT	INTERNAL	300	1,2

HEATER SCHEDULE														
UNIT NUMBER	LOCATION	MANUFACTURER	MODEL	TYPE	UNIT ORIENTATION	EAT (F)	AIR FLOW (CFM)	OUTPUT CAPACITY		MOTOR HP	POWER SUPPLY		APPROX WEIGHT (LBS)	NOTES
								(BTU/H)	(KW)		VOLTS	PHASE		
01-EUH-0001	PIPE GALLERY (01-001)	CHROMALOX	HD3D	EUHCR	VERTICAL	60	1180	---	10	1/15	480	3	100	2
01-EUH-0002	PIPE GALLERY (01-001)	CHROMALOX	HD3D	EUHCR	VERTICAL	60	1180	---	10	1/15	480	3	100	2
01-EUH-0003	PIPE GALLERY (01-001)	CHROMALOX	HD3D	EUHCR	VERTICAL	60	1180	---	10	1/15	480	3	100	2
01-EUH-0004	PIPE GALLERY (01-001)	CHROMALOX	HD3D	EUHCR	VERTICAL	60	1180	---	10	1/15	480	3	100	2
01-EUH-0005	PIPE GALLERY (01-001)	CHROMALOX	HD3D	EUHCR	VERTICAL	60	1180	---	10	1/15	480	3	100	2
01-EUH-0006	PIPE GALLERY (01-001)	CHROMALOX	HD3D	EUHCR	VERTICAL	60	1180	---	10	1/15	480	3	100	2
01-EUH-0007	PIPE GALLERY (01-001)	CHROMALOX	HD3D	EUHCR	VERTICAL	60	1180	---	10	1/15	480	3	100	2
01-EUH-0008	PIPE GALLERY (01-001)	CHROMALOX	HD3D	EUHCR	VERTICAL	60	1180	---	10	1/15	480	3	100	2
01-WH-0001	STAIR NO.1 (01-002)	INDEECO	933U05000U	WH	VERTICAL	60	160	---	5	---	480	3	100	1
01-WH-0001	STAIR NO.2 (01-003)	INDEECO	933U05000U	WH	VERTICAL	60	160	---	5	---	480	3	100	1
02-EUH-0001	BLOWERS ROOM (02-102)	CHROMALOX	HD3D	EUHCR	VERTICAL	60	1180	---	10	1/15	480	3	100	2
02-EUH-0002	BLOWERS ROOM (02-102)	CHROMALOX	HD3D	EUHCR	VERTICAL	60	1180	---	10	1/15	480	3	100	2

MAKEUP AIR UNIT SCHEDULE																
UNIT NUMBER	LOCATION	MANUFACTURER	MODEL	HEATING TYPE	AIRFLOW (CFM)	ESP (IN WC)	MOTOR HP	POWER SUPPLY		OUTPUT CAPACITY (BTU/H OR (KW))	MINIMUM WHEEL DIA (IN)	FILTER DATA			APPROX WEIGHT (LBS)	NOTES
								VOLTS	PHASE			TYPE	THICKNESS (IN)	VIBRATION ISOLATION		
01-MAU-0001	PIPE GALLERY	HASTINGS	SBD215	DF	7200	0.75	7.5	480	3	505000	15	PLEATED	2	INTERNAL	1300	1,2,3,4,5,6

SCHEDULE NOTES

SEE DRAWINGS 00-H-001 FOR LEGEND, ABBREVIATIONS AND GENERAL NOTES.

AIR DEVICE SCHEDULE:

NOTES:

1. SEE DRAWINGS FOR DEVICE LENGTH, WIDTH, AND SUPPLY PATTERN.

HEAT PUMP SCHEDULE:

OUTDOOR COIL ENTERING AIR TEMPERATURE:
 COOLING – 91° F DESIGN / 0° F MIN
 HEATING – -13° F (HEAT PUMP)

NOTES:

1. UNIT IS SUBJECT TO CORROSION FROM A HYDROGEN SULFIDE LADEN ATMOSPHERE. ALL AIRSTREAM COMPONENTS AND EXPOSED HEAT TRANSFER COMPONENTS SHALL BE GIVEN A PROTECTIVE SPECIAL COATING OF HERESITE OR APPROVED EQUAL. CONTROLS PANELS, WIRING CONNECTIONS AND OTHER SENSITIVE ELECTRONICS SHALL HAVE A CONFORMAL COATING APPLIED.

FAN COIL SCHEDULE:

NOTES:

1. UNIT IS SUBJECT TO CORROSION FROM A HYDROGEN SULFIDE LADEN ATMOSPHERE. ALL AIRSTREAM COMPONENTS AND EXPOSED HEAT TRANSFER COMPONENTS SHALL BE GIVEN A PROTECTIVE SPECIAL COATING OF HERESITE OR APPROVED EQUAL. CONTROLS PANELS, WIRING CONNECTIONS AND OTHER SENSITIVE ELECTRONICS SHALL HAVE A CONFORMAL COATING APPLIED.
 2. INDOOR UNIT POWERED BY OUTDOOR UNIT.

FAN SCHEDULE:

FAN TYPE ABBREVIATIONS:
 PRV - POWER ROOF VENTILATOR

WHEEL TYPE ABBREVIATIONS:


A - AXIAL
 C - CENTRIFUGAL
 P - PROPELLER

NOTES:


1. UNIT IS SUBJECT TO CORROSION FROM A HYDROGEN SULFIDE LADEN ATMOSPHERE. ALL AIRSTREAM COMPONENTS AND EXPOSED HEAT TRANSFER COMPONENTS SHALL BE GIVEN A PROTECTIVE SPECIAL COATING OF HERESITE OR APPROVED EQUAL. CONTROLS PANELS, WIRING CONNECTIONS AND OTHER SENSITIVE ELECTRONICS SHALL HAVE A CONFORMAL COATING APPLIED.
 2. CONSTRUCTION A) ALUMINUM FAN BLADES B) STEEL FAN BLADES.
 3. EC TYPE SPEED CONTROLLER SHALL BE PROVIDED BY MANUFACTURER

HEATER SCHEDULE:


TYPE ABBREVIATIONS:

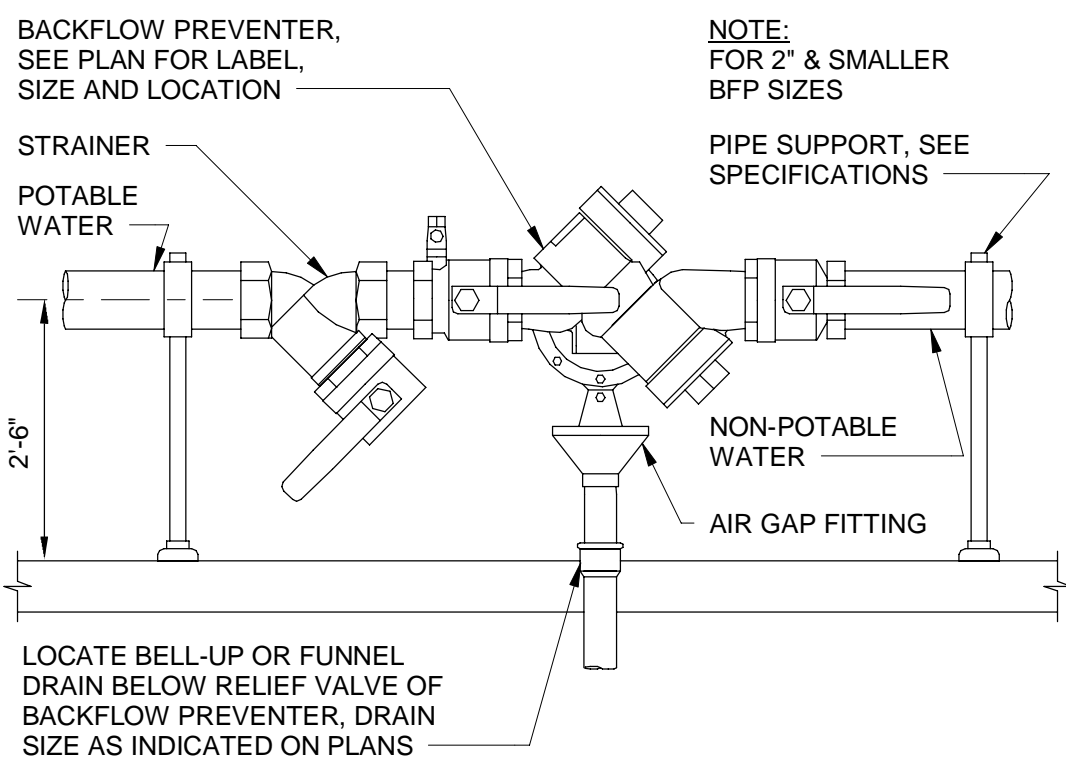


A BACKFLOW PREVENTER
NO SCALE

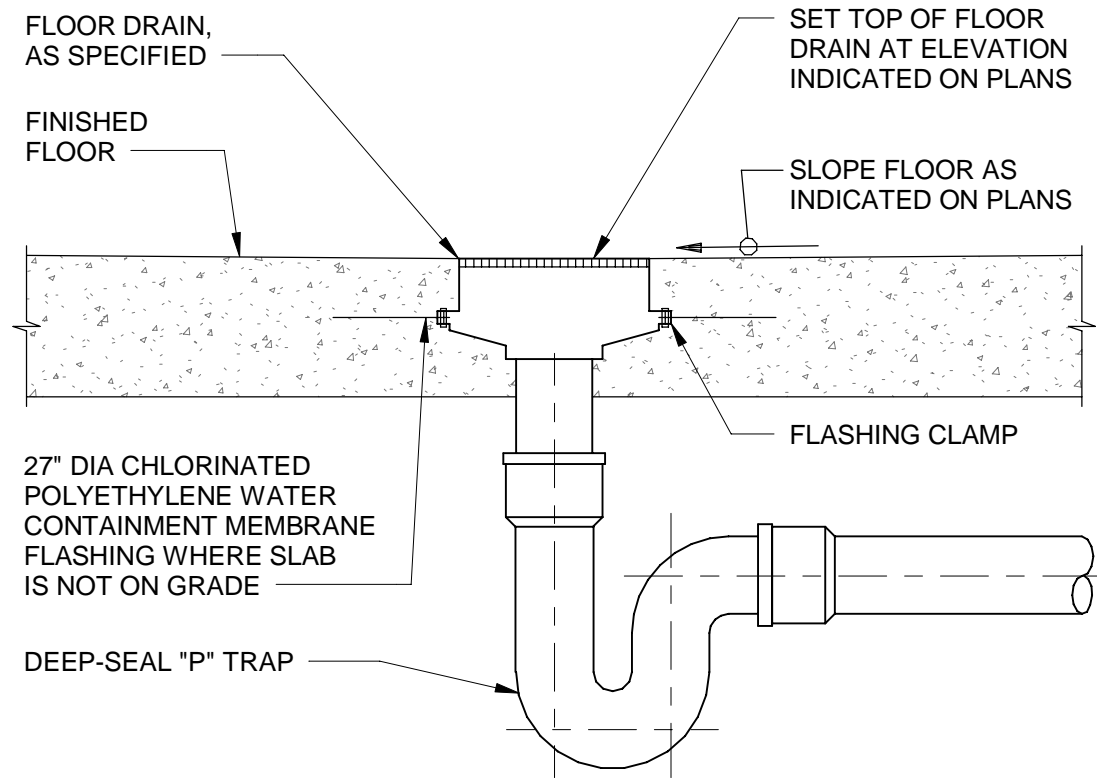


B FLOOR DRAIN - NEW FLOOR
NO SCALE

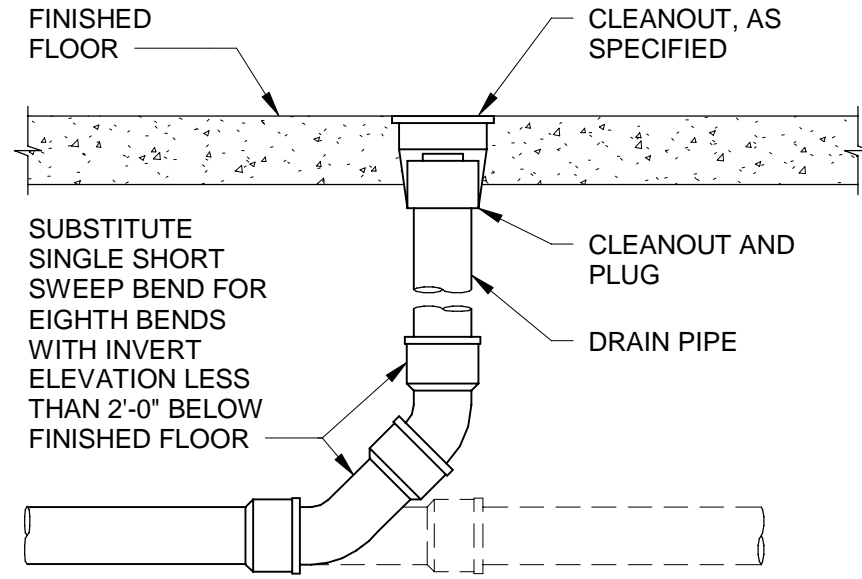


C FLOOR CLEANOUT - NEW FLOOR
NO SCALE

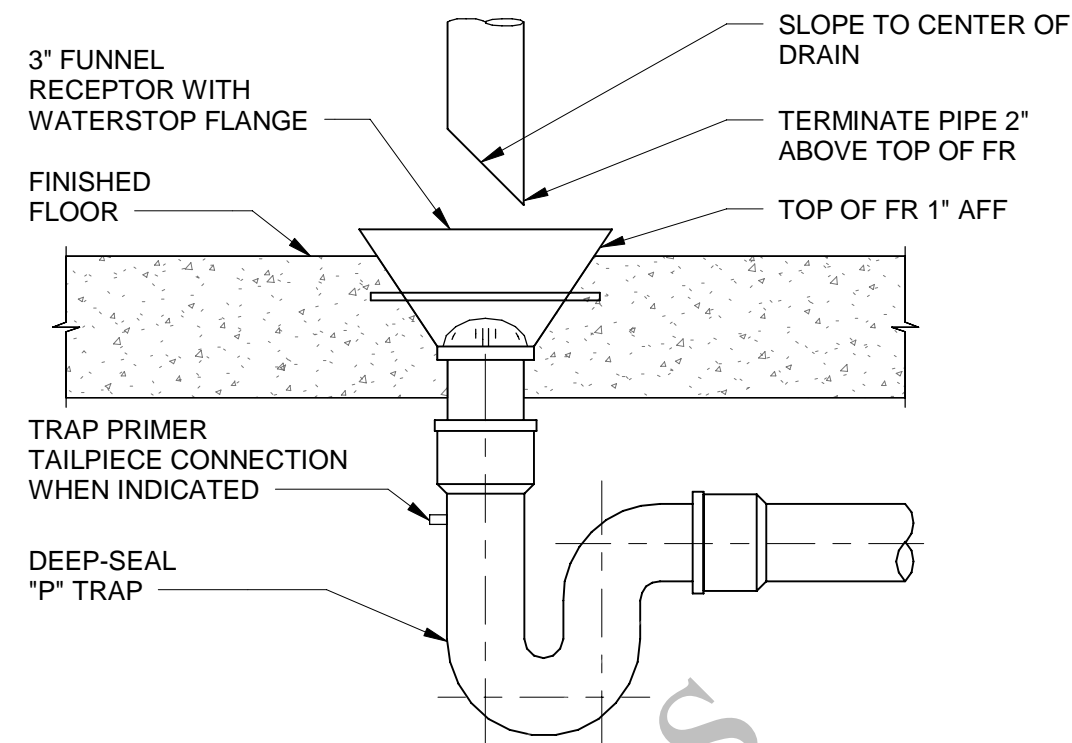


D FUNNEL DRAIN - NEW FLOOR
NO SCALE

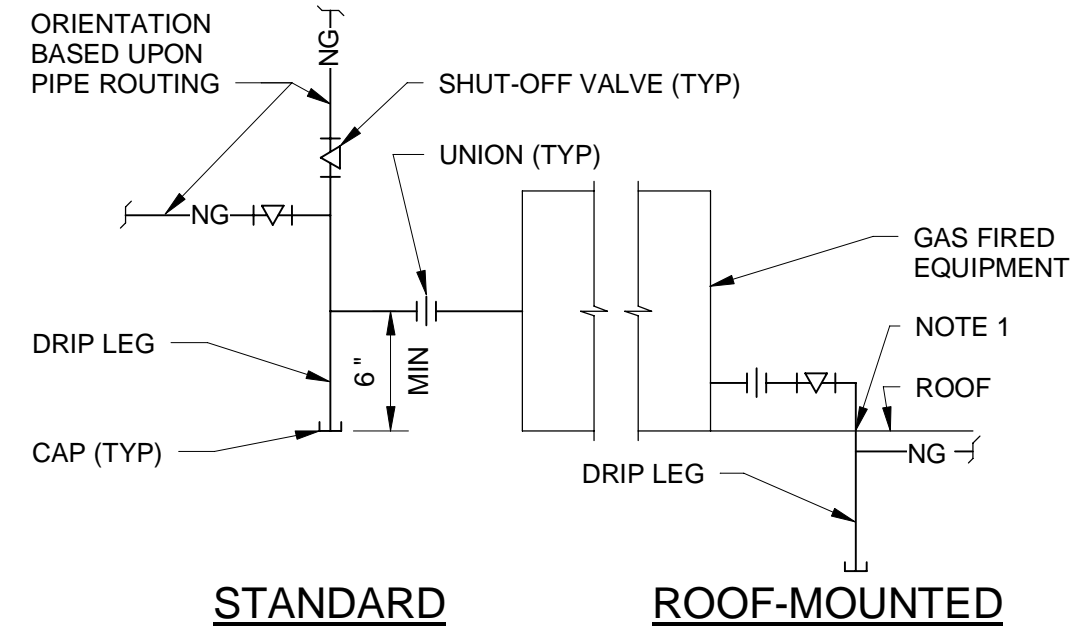


E FUEL GAS PIPING CONNECTION AT EQUIPMENT
NO SCALE

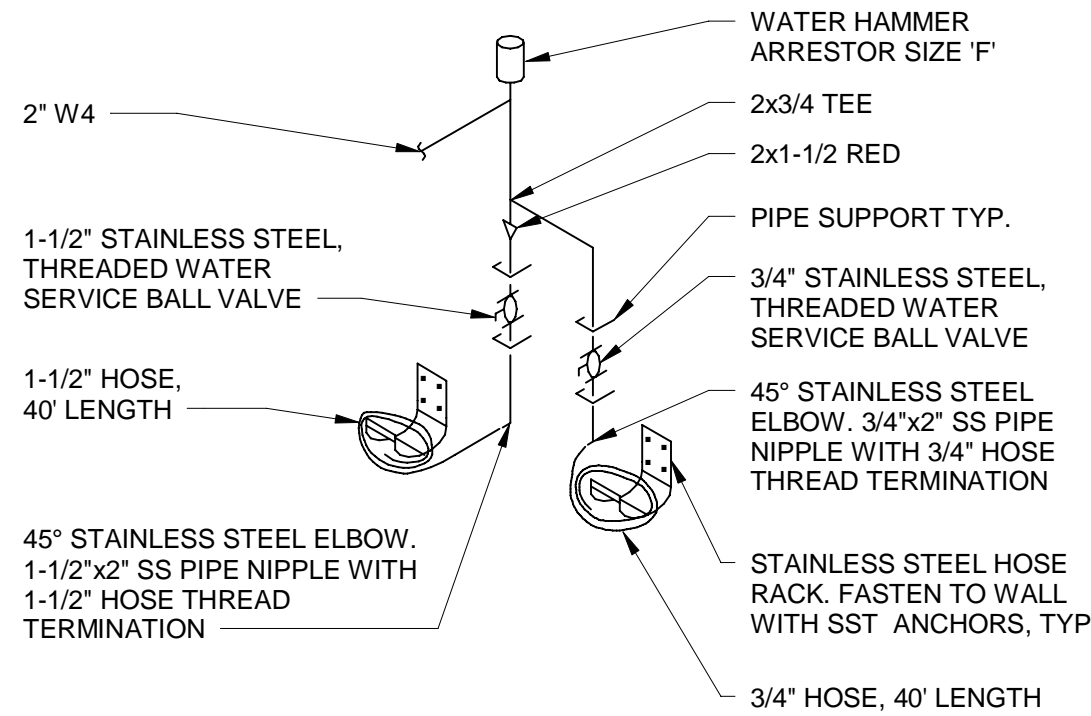



F HOSE CONNECTION DETAIL
NO SCALE

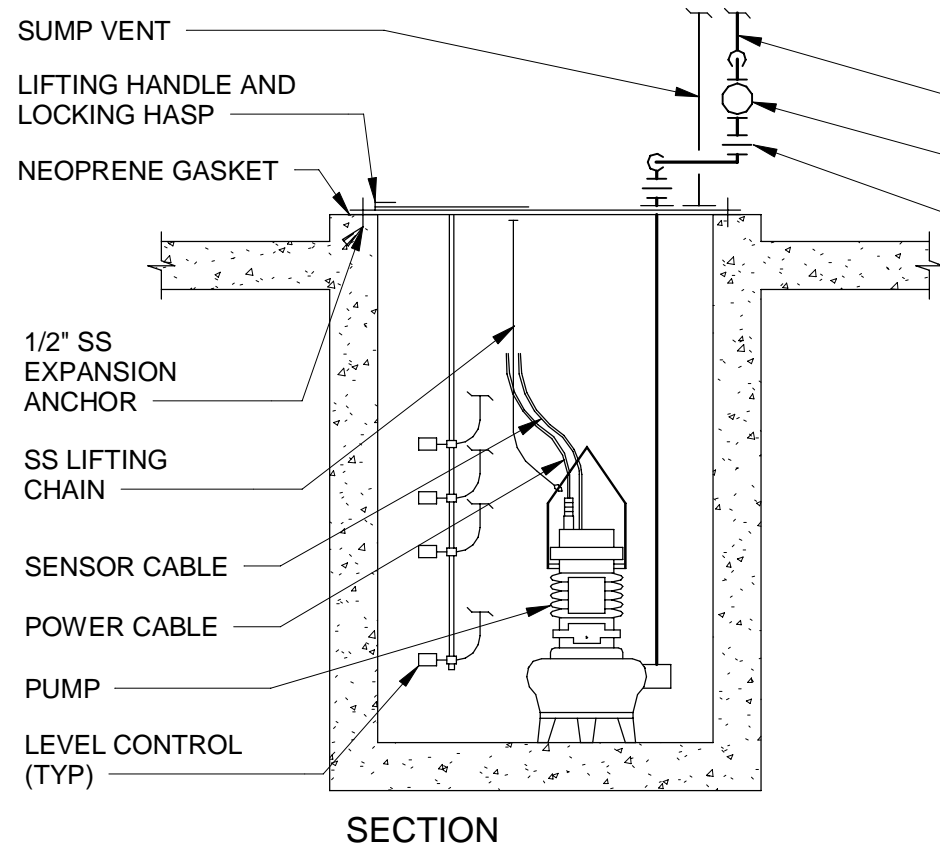


G SUBMERSIBLE SUMP PUMP - FLOOR MOUNTED
NO SCALE

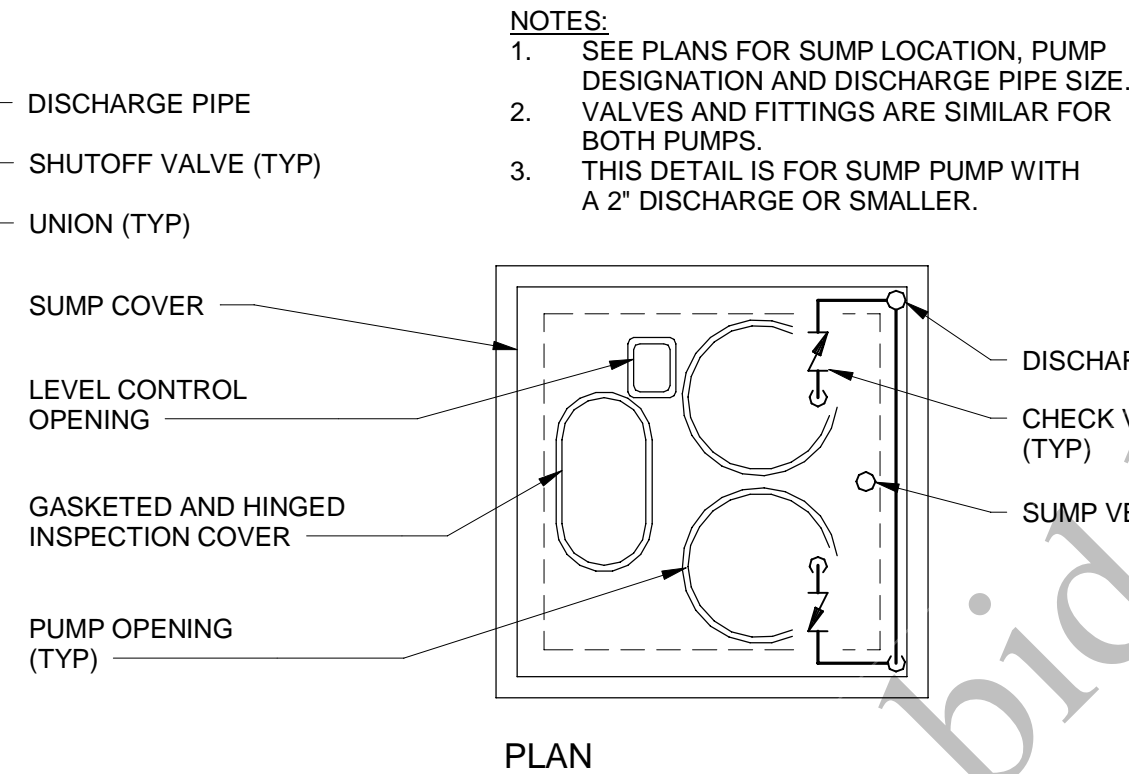

H PRESSURE REDUCING STATION
NO SCALE

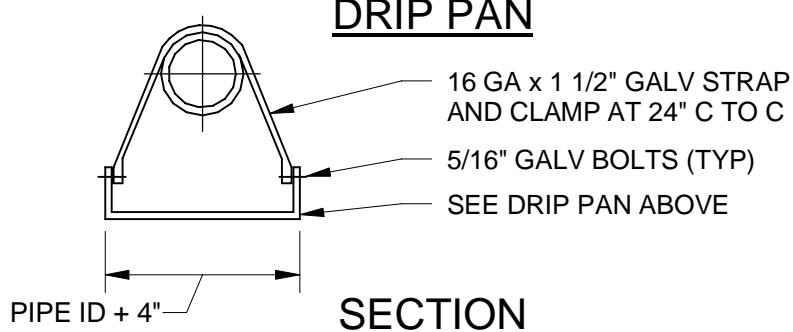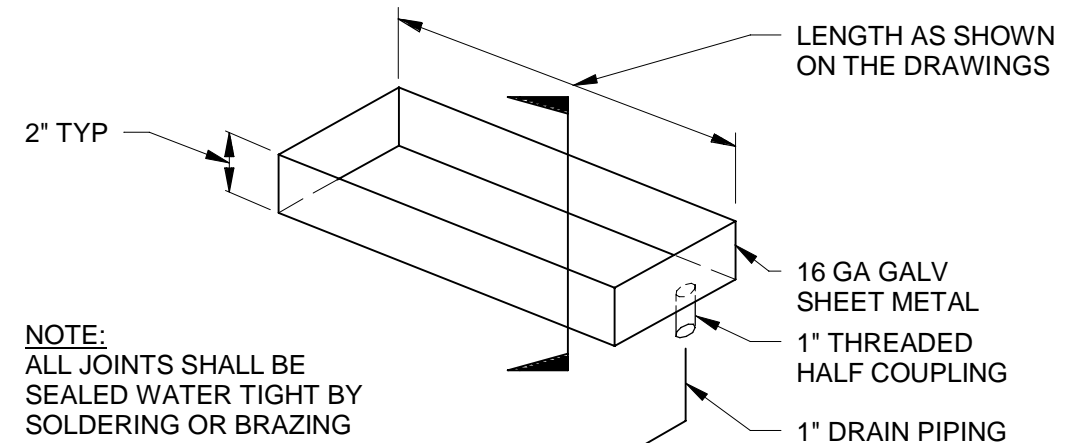

I DRIP PAN
J DRIP SHIELD
NO SCALE

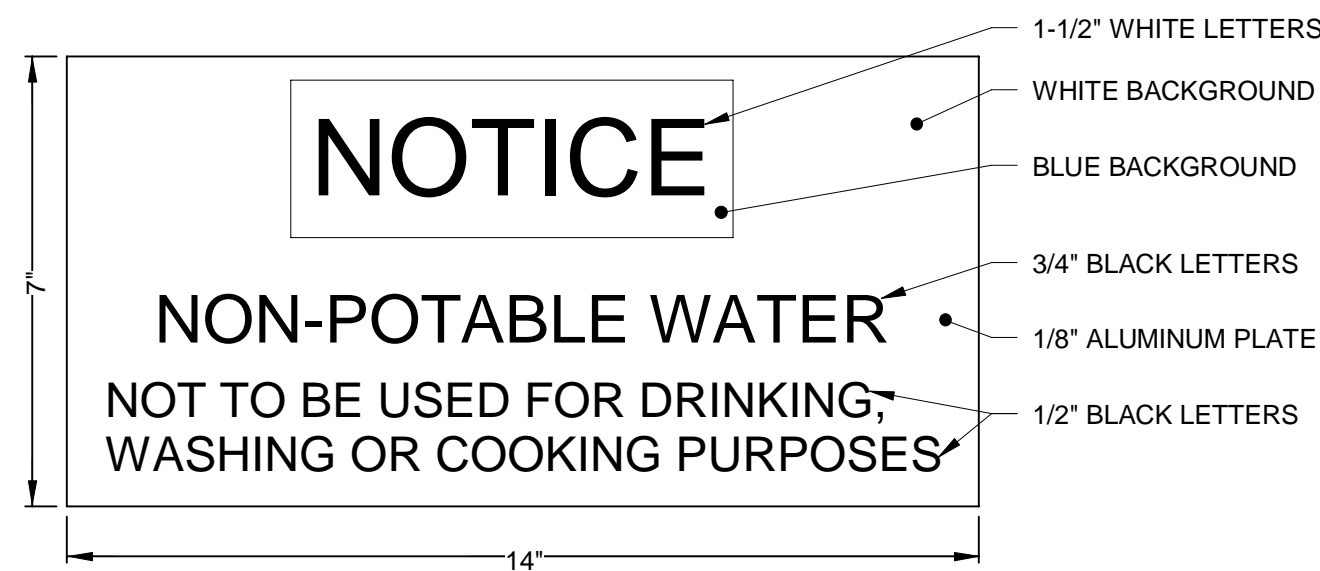

K NON-POTABLE WATER SIGN
NO SCALE

REVISIONS AND RECORD OF ISSUE	
DESIGNED:	SAM
DETAILED:	AJP
CHECKED:	DAV
APPROVED:	SP
DATE:	12/20/2022
PROJECT NO.:	411752

BACKFLOW PREVENTER SCHEDULE						
UNIT NUMBER	SERVICE	BODY SIZE (IN)	MAXIMUM FLOW (GPM)	MAXIMUM PRESSURE DIFFERENTIAL (PSI)	MANUFACTURER	NOTES
BFP- 1001	BLOWERS BUILDING	2	50	14	WATTS #LF009	---

PIPING ACCESSORIES SCHEDULE				
UNIT NUMBER	MANUFACTURER	MODEL	DESCRIPTION	NOTES
FCD-1	SMITH	4111 SERIES	HEAVY DUTY FLOOR CLEANOUT, SECURED ROUND ADJUSTABLE NICKEL BRONZE TOP	---
FD-1	SMITH	2141 SERIES	HEAVY DUTY CAST IRON FLOOR DRAIN, ADJUSTABLE TOP, LOOSE SET CAST IRON GRATE	---
FD-2	SMITH	2310 SERIES	MEDIUM DUTY CAST IRON FLOOR DRAIN, ADJUSTABLE TOP, LOOSE SET CAST IRON GRATE	---
FD-3	SMITH	2310-D SERIES	MEDIUM DUTY CAST IRON FLOOR DRAIN, ADJUSTABLE TOP, DOME GRATE	---
FR-1	SMITH	SERIES 3800 FIGURE SQ-3-1793-DBS	MEDIUM DUTY CAST IRON FUNNEL RECEPTOR, WATERSTOP FLANGE, THREADED OR NO-HUB CONNECTION	---
ORD-1	SMITH	1010-E SERIES	CAST IRON OVERFLOW ROOF DRAIN WITH 1" STANDPIPE	---
RD-1	SMITH	1010-E SERIES	CAST IRON PRIMARY ROOF DRAIN.	---

PLUMBING EQUIPMENT SCHEDULE			
UNIT NUMBER	DESCRIPTION	MANUFACTURER	NOTES
TPP - 1001	ELECTRONIC TRAP PRIMING MANIFOLD, SURFACE MOUNTED, 3/4" NPT INLET, 1/2" PEX TUBE CONNECTIONS, 120 VOLT, 1 PHASE, 60Hz, (10 CONNECTIONS)	PRECISION PLUMBING PRODUCTS, INC. PRIME-TIME PT-10	---
TPP - 1002	ELECTRONIC TRAP PRIMING MANIFOLD, SURFACE MOUNTED, 3/4" NPT INLET, 1/2" PEX TUBE CONNECTIONS, 120 VOLT, 1 PHASE, 60Hz, (2 CONNECTIONS)	PRECISION PLUMBING PRODUCTS, INC. PRIME-TIME PT-2	---
TPP - 1003	ELECTRONIC TRAP PRIMING MANIFOLD, SURFACE MOUNTED, 3/4" NPT INLET, 1/2" PEX TUBE CONNECTIONS, 120 VOLT, 1 PHASE, 60Hz, (2 CONNECTIONS)	PRECISION PLUMBING PRODUCTS, INC. PRIME-TIME PT-2	---

PLUMBING FIXTURE SCHEDULE							
UNIT NUMBER	MANUFACTURER	DESCRIPTION	WATER (IN)		WASTE (IN)		NOTES
			HOT	COLD	WASTE	VENT	
SS-1	SINK: ADVANCED TABCO FS-WM-2721-F FAUCET: K-160	SERVICE SINK, 24"x20", WALL MOUNTED, STAINLESS STEEL WITH TUBULAR SUPPORT, SINGLE BOWL, BLANK BACK, SPLASH MOUNTED 6" SWIVEL SPOUT FAUCET	---	1/2 "	3 "	---	1

PRESSURE REDUCING VALVE SCHEDULE										
UNIT NUMBER	SERVICE	TYPE	FLOW RATE (GAS-SCFH)			REDUCED PRESSURE SETPOINT(PSI)	INLET PRESSURE (PSI)		MINIMUM PRESSURE AT MAXIMUM FLOW (PSI)	NOTES
			MINIMUM	MAXIMUM	ORDINARY		MINIMUM	MAXIMUM		
PRV-1001	NATURAL GAS	DIRECT ACTING	0	978	978	0.43	4.5	5	0.5	1

SUBMERSIBLE SUMP PUMP SCHEDULE															
UNIT NUMBER	LOCATION	PUMP TYPE	CAPACITY (GPM)	TOTAL HEAD (FT)	MAXIMUM SPEED (RPM)	MOTOR HP	POWER SUPPLY		DISCHARGE SIZE (IN)	SUMP LEVEL (IN)				MANUFACTURER / MODEL	NOTES
							VOLTS	PHASE		OFF	LEAD	LAG	HWA		
SSP-1001	PIPE GALLERY	DUPLEX, SUBMERSIBLE, HEAVY DUTY SUMP PUMP	30.0	31	1750	1.5	480	3	2"	2	2.63	2.96	3.3	WEIL #1413	1,2,3,4,5
SSP-1002	PIPE GALLERY	DUPLEX, SUBMERSIBLE, HEAVY DUTY SUMP PUMP	30.0	31	1750	1.5	480	3	2"	2	2.63	2.96	3.3	WEIL #1413	1,2,3,4,5

SCHEDULE NOTES

SEE DRAWINGS 00-P-001 FOR LEGEND, ABBREVIATIONS AND GENERAL NOTES.

PLUMBING FIXTURE SCHEDULE:

NOTES:
1. PROVIDE ONLY COLD WATER SUPPLY.

PRESSURE REDUCING VALVE SCHEDULE:

NOTES:
1. PRESSURE REDUCEING VALVE SCHEDULE MODEL 325L SERIES LEVER-ACTING NUMBERS BASED ON MAXITROL.

SUMP AND SEWAGE PUMP SCHEDULE:

SUMP LEVELS: PUMPS OFF, LEAD PUMP START, LAG PUMP START AND HIGH WATER ALARM ELEVATIONS ARE AS MEASURED FROM THE BOTTOM OF THE SUMP

NOTES:
1. HIGH WATER ALARM.
2. FLOOR MOUNTED.
3. SUMP COVER REQUIRED.
4. CUTLESS RUBBER LOWER BEARING.
5. STAINLESS STEEL LIFTING CHAIN REMOVAL SYSTEM.



Black & Veatch Corporation
Chicago, Illinois
ILLINOIS PROFESSIONAL
DESIGN FIRM - 184.002143-0006



AEROBIC GRANULAR
SLUDGE - PHASE 1

REVISIONS AND RECORD OF ISSUE	
DESIGNED:	SAM
DETAILED:	AJP
CHECKED:	DAV
APPROVED:	SP
DATE:	12/20/2022

PROJECT NO.: 411752


AGS REACTORS AND PIPE
GALLERY

PLUMBING

SCHEDULES

99-P-601

154
OF
163

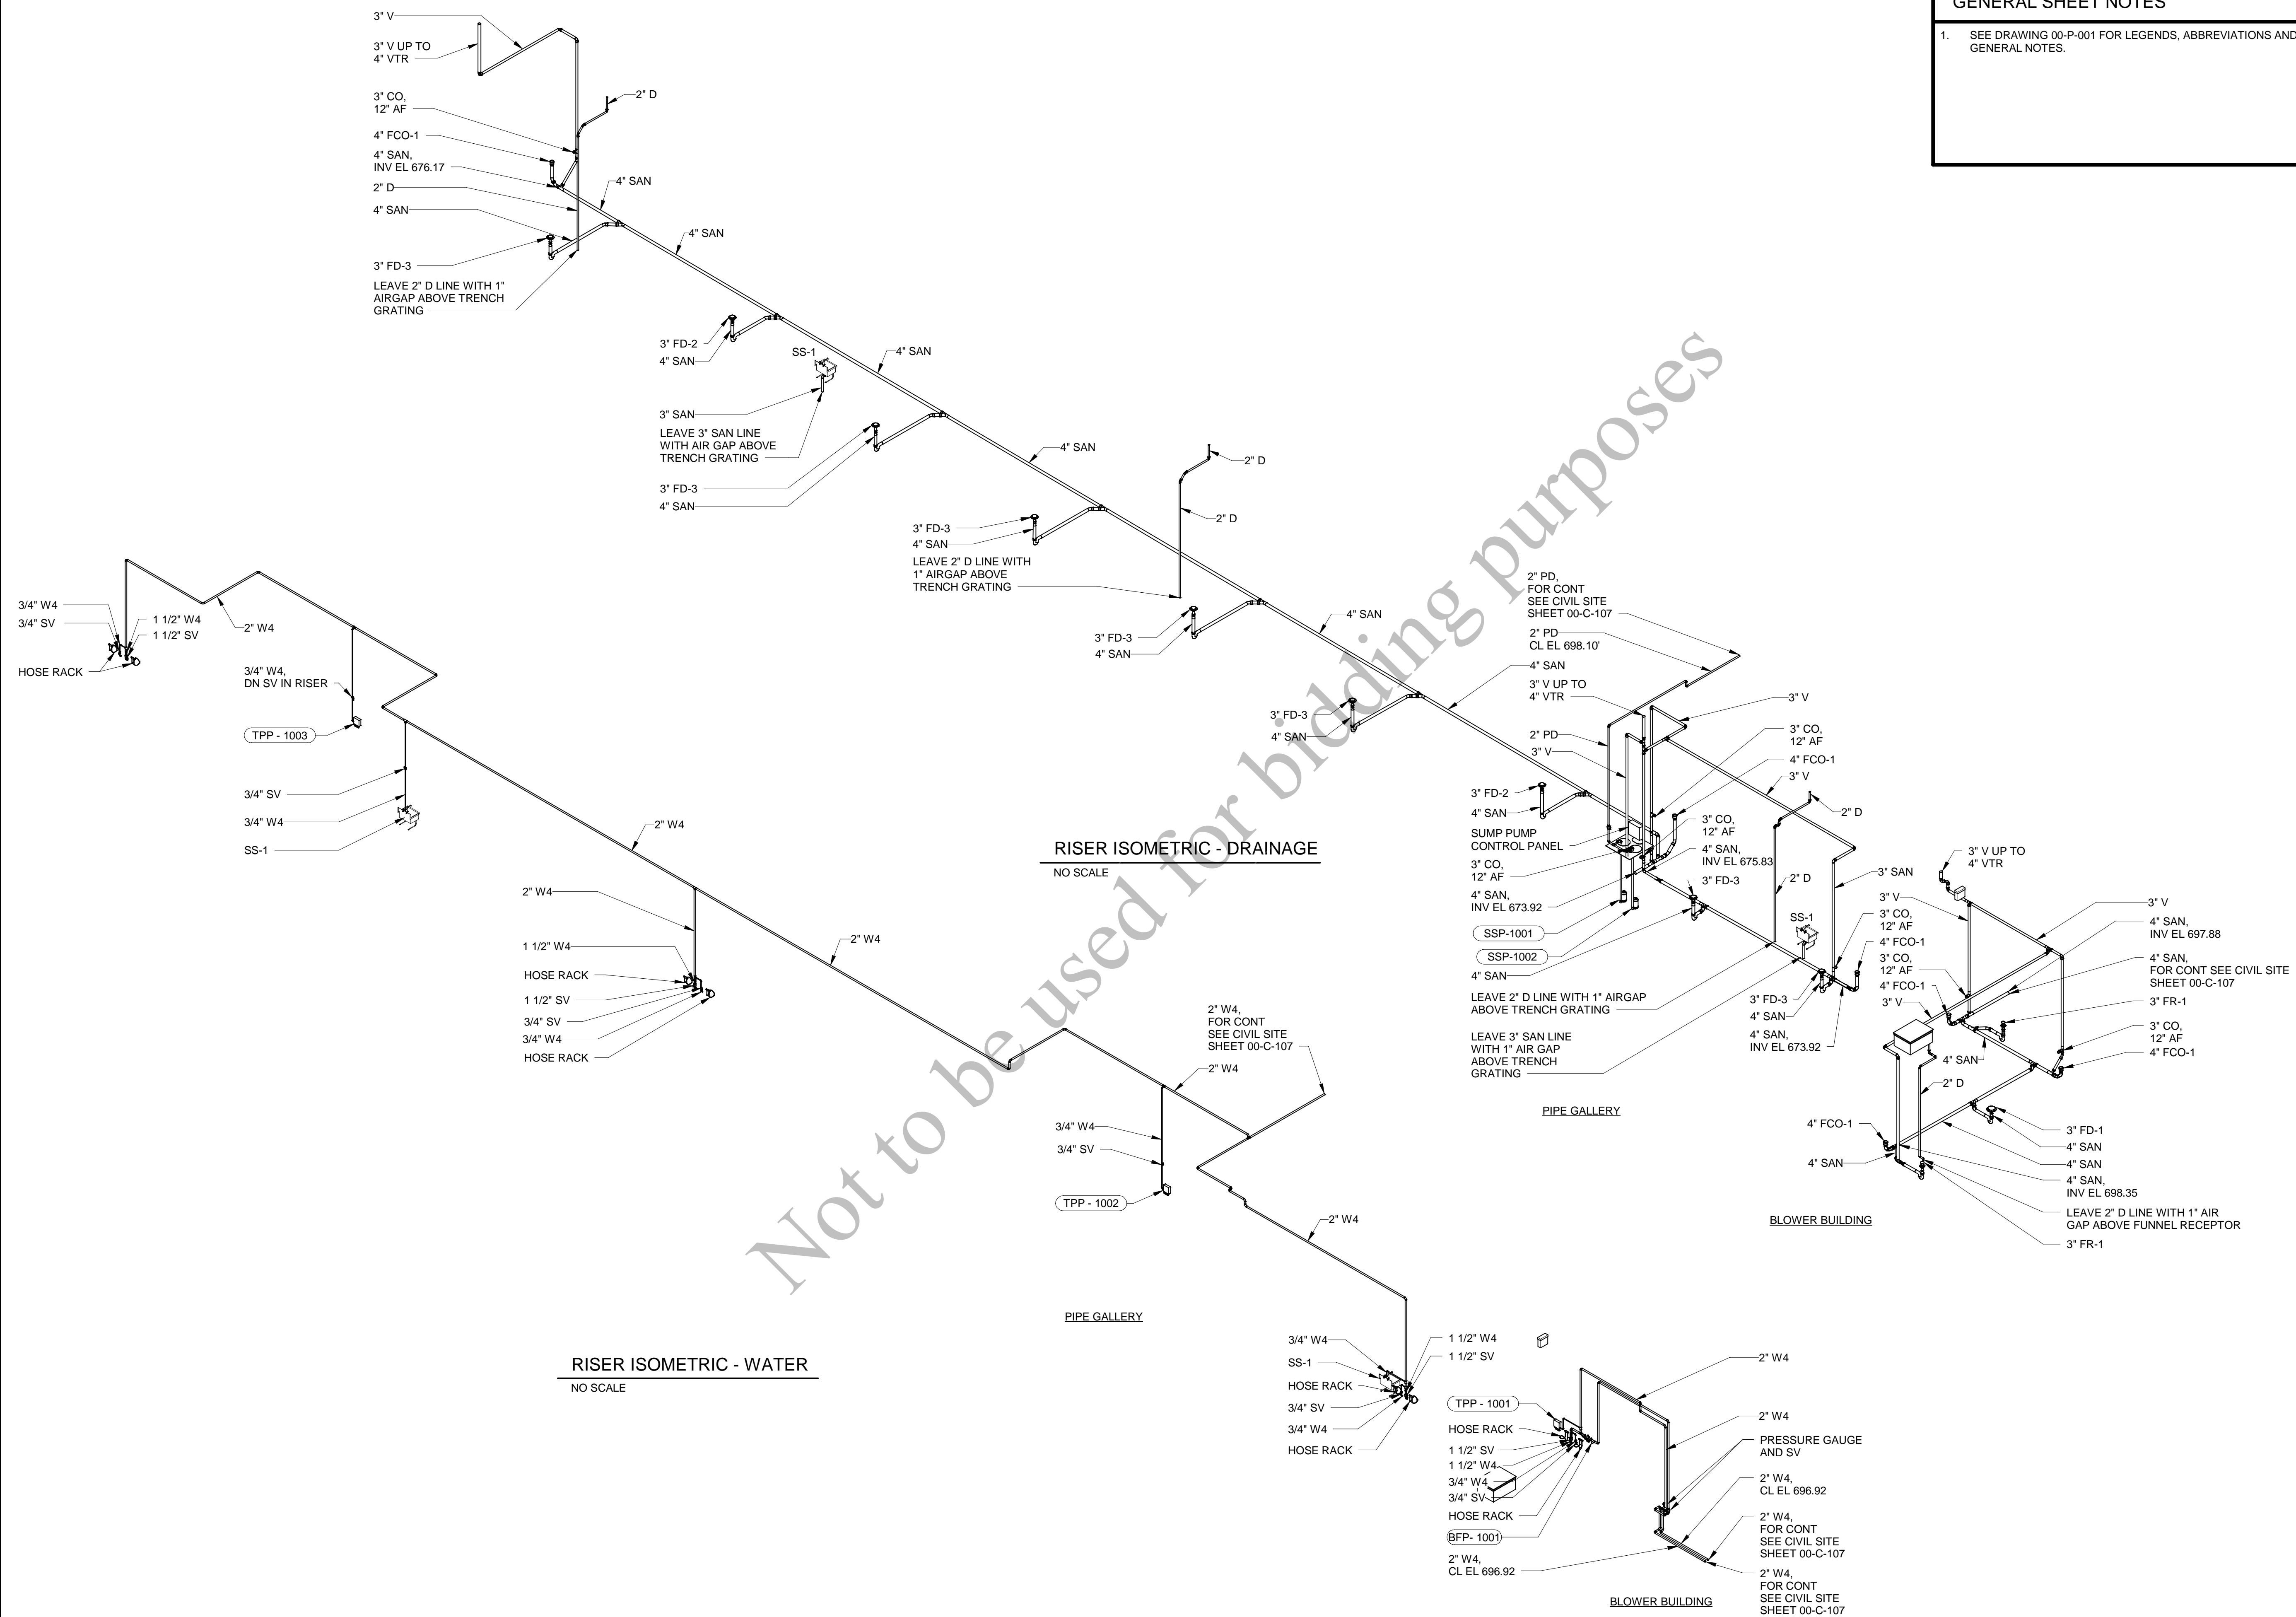

GENERAL SHEET NOTES

1. SEE DRAWING 00-P-001 FOR LEGENDS, ABBREVIATIONS AND GENERAL NOTES.



Black & Veatch Corporation
Chicago, Illinois
ILLINOIS PROFESSIONAL
DESIGN FIRM - 184.002143-0006



AEROBIC GRANULAR SLUDGE - PHASE 1

REVISIONS AND RECORD OF ISSUE

DESIGNED:	SAM
DETAILED:	AJP
CHECKED:	DAV
APPROVED:	SP
DATE:	12/20/2022

PROJECT NO.: 411752


AGS REACTORS AND PIPE GALLERY

PLUMBING


WATER AND DRAINAGE ISOMETRICS

99-P-901


155
OF
163

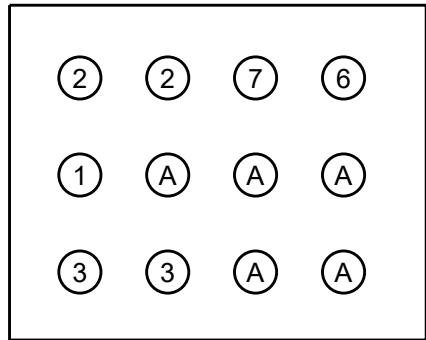


SECTION A
00-E-101
02-E-101

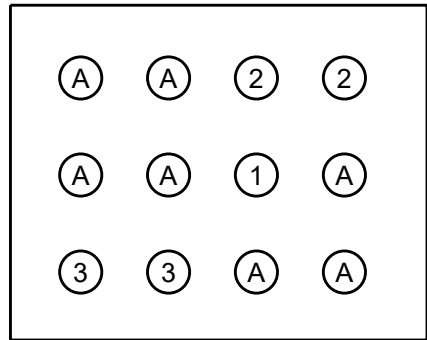


SECTION B
00-E-101

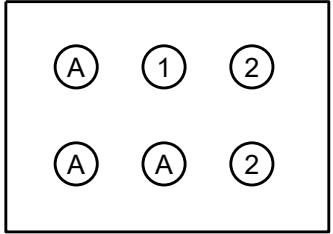


SECTION C
00-E-101

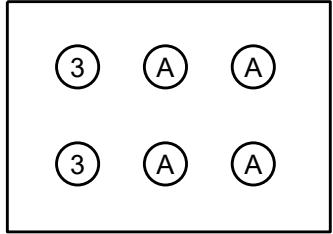


SECTION D
00-E-101

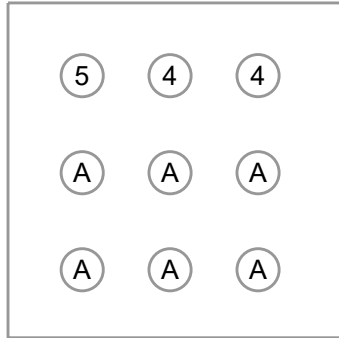


SECTION E
00-E-101

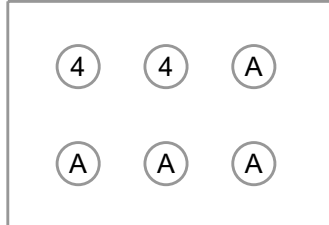


SECTION F
00-E-101

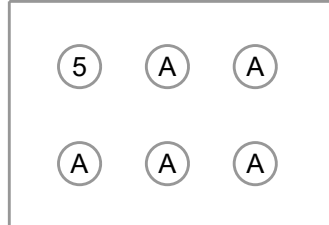


SECTION G
00-E-101

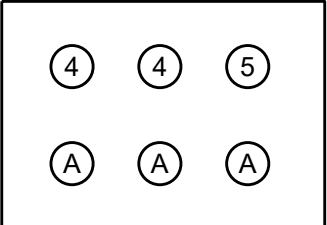

SECTION H
00-E-101

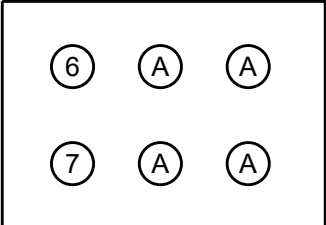

SECTION J
00-E-101

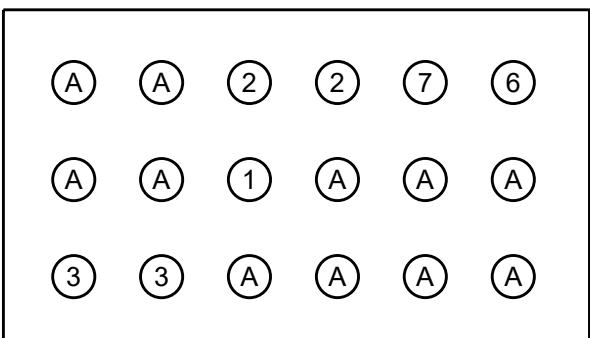

SECTION K
00-E-101

DUCT BANK SCHEDULE			
COND.	SIZE	CIRCUIT NUMBER	REMARKS
A	4"	PULLSTRING	SPARE
1	4"	FPP-001-1	FIBER OPTIC
2	4"	SWGR3-1	AGS PHASE 1
3	4"	SWGR6-1	AGS PHASE 1
4	4"	MCC-1	3 - 500KCMIL XHHW-2 CABLES AND #2AWG GROUND
5	4"	AQUA AEROBICS	3 - 500KCMIL XHHW-2 CABLES AND #2AWG GROUND
6	4"	MCC-1501-22	DISTRIBUTION CHAMBER VALVE POWER
7	4"	GSD-1651-1	DISTRIBUTION CHAMBER VALVE CONTROL

GENERAL SHEET NOTES

- SEE DRAWINGS 00-E-001 AND 00-E-002 FOR LEGENDS, ABBREVIATIONS AND NOTES.
- CONTRACTOR SHALL DEMOLISH CABLES IN CONDUITS 4 AND 5 AS SHOWN IN EXISTING DUCT BANK SECTION CUTS. NEW CABLES OF EQUIVALENT SIZE AND TYPE SHALL BE INSTALLED INTO NEW DUCT BANK AND EXISTING DUCT BANKS AS NECESSARY TO REPLACE DEMOLISHED CABLES.



Black & Veatch Corporation
Chicago, Illinois
ILLINOIS PROFESSIONAL
DESIGN FIRM - 184.002143 -0006



AEROBIC GRANULAR
SLUDGE - PHASE 1

AGS SUPPORT FACILITIES

ELECTRICAL


DETAILS

99-E-501


156
OF
163

NOTES:

- EARTHEN CONCRETE FORMING WILL NOT BE PERMITTED UNLESS APPROVED BY THE FOUR RIVERS SANITATION AUTHORITY (FRSA).
- WOOD OR MANUFACTURED FORMS SHALL BE PROVIDED THE FULL LENGTH OF THE DUCT BANK, AND SHALL BE BRACED AND TIED TO PROVIDE THE STRUCTURAL CAPACITY REQUIRED TO PRODUCE FINISHED CONCRETE TO THE LINES AND GRADES SHOWN ON THE PLANS.
- FORMS SHALL REMAIN IN PLACE FOR 24 HOURS OR AS DIRECTED BY THE FRSA.
- NO CONCRETE SHALL BE PLACED ON ICE, SNOW, OR FROZEN FOUNDATION MATERIAL.
- CONCRETE SHALL BE PLACED IN A MANNER SO AS TO AVOID SEGREGATION OR SEPARATION OF AGGREGATES OR THE DISPLACEMENT OF REINFORCEMENT.
- CONCRETE SHALL BE IDOT CLASS DS PER SECTION 1020 OF THE IDOT STANDARD SPECIFICATIONS FOR ROAD AND BRIDGE CONSTRUCTION, CURRENT EDITION.
- CONCRETE SHALL HAVE RED DYE BROOMED INTO TOP OF DUCT BANK.
- ONE (1) WARNING TAPE SHALL BE PROVIDED FOR DUCT BANKS UP TO 24" WIDE. TWO (2) WARNING TAPES SHALL BE PROVIDED FOR DUCT BANKS GREATER THEN 24" WIDE.

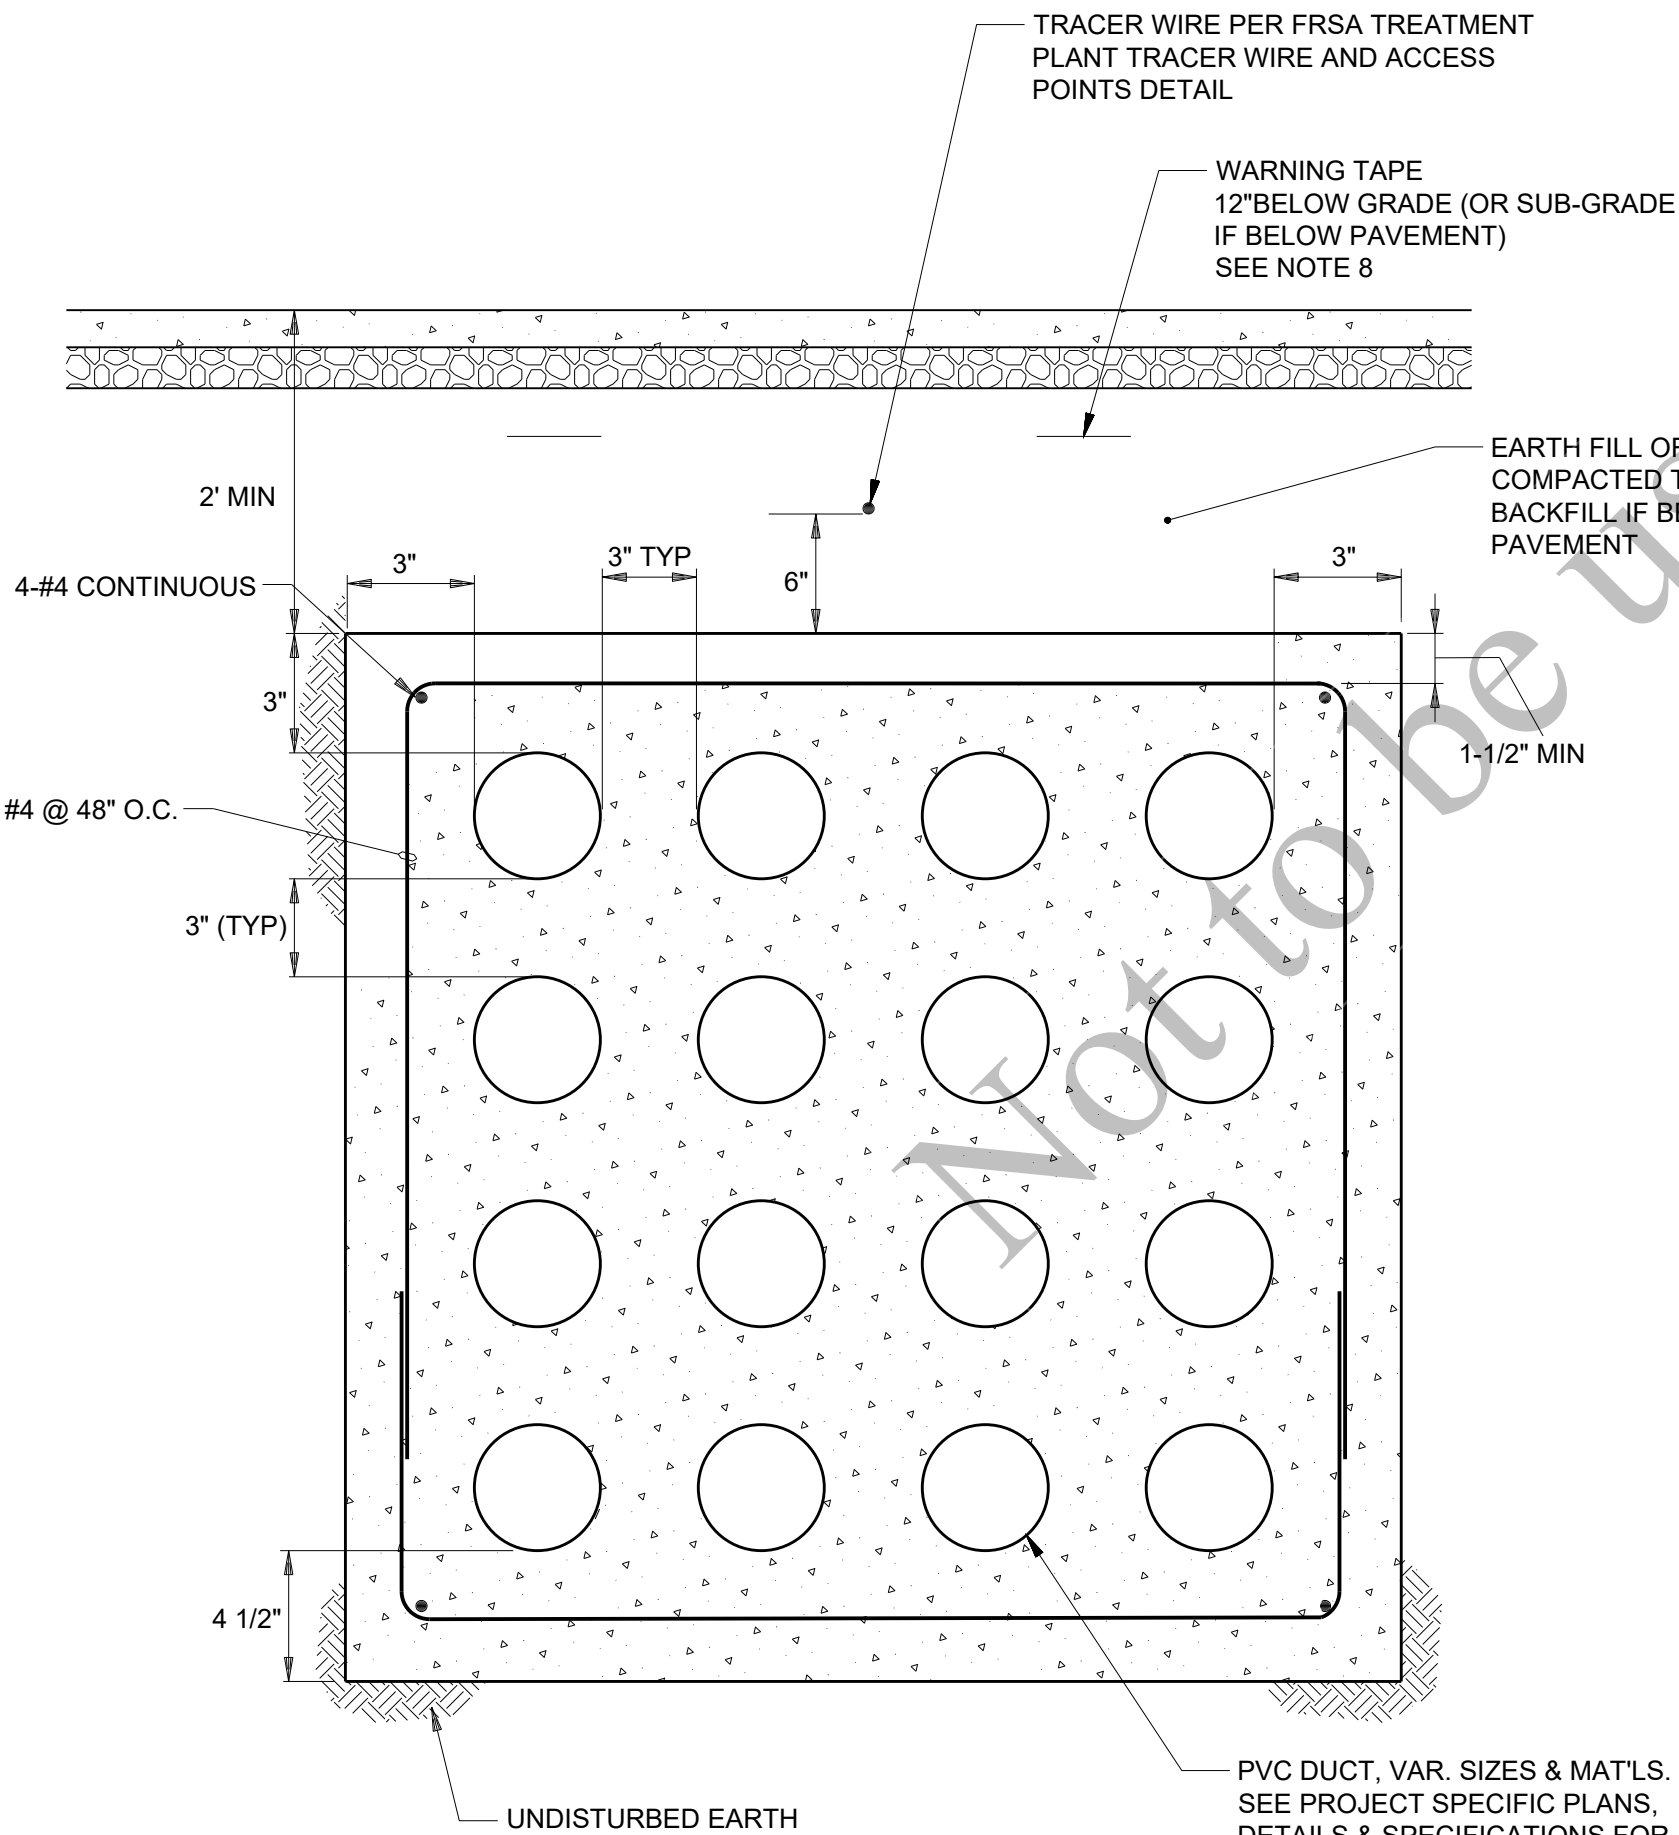

FRSA TREATMENT PLANT CONCRETE DUCT BANK DETAIL
NO SCALE

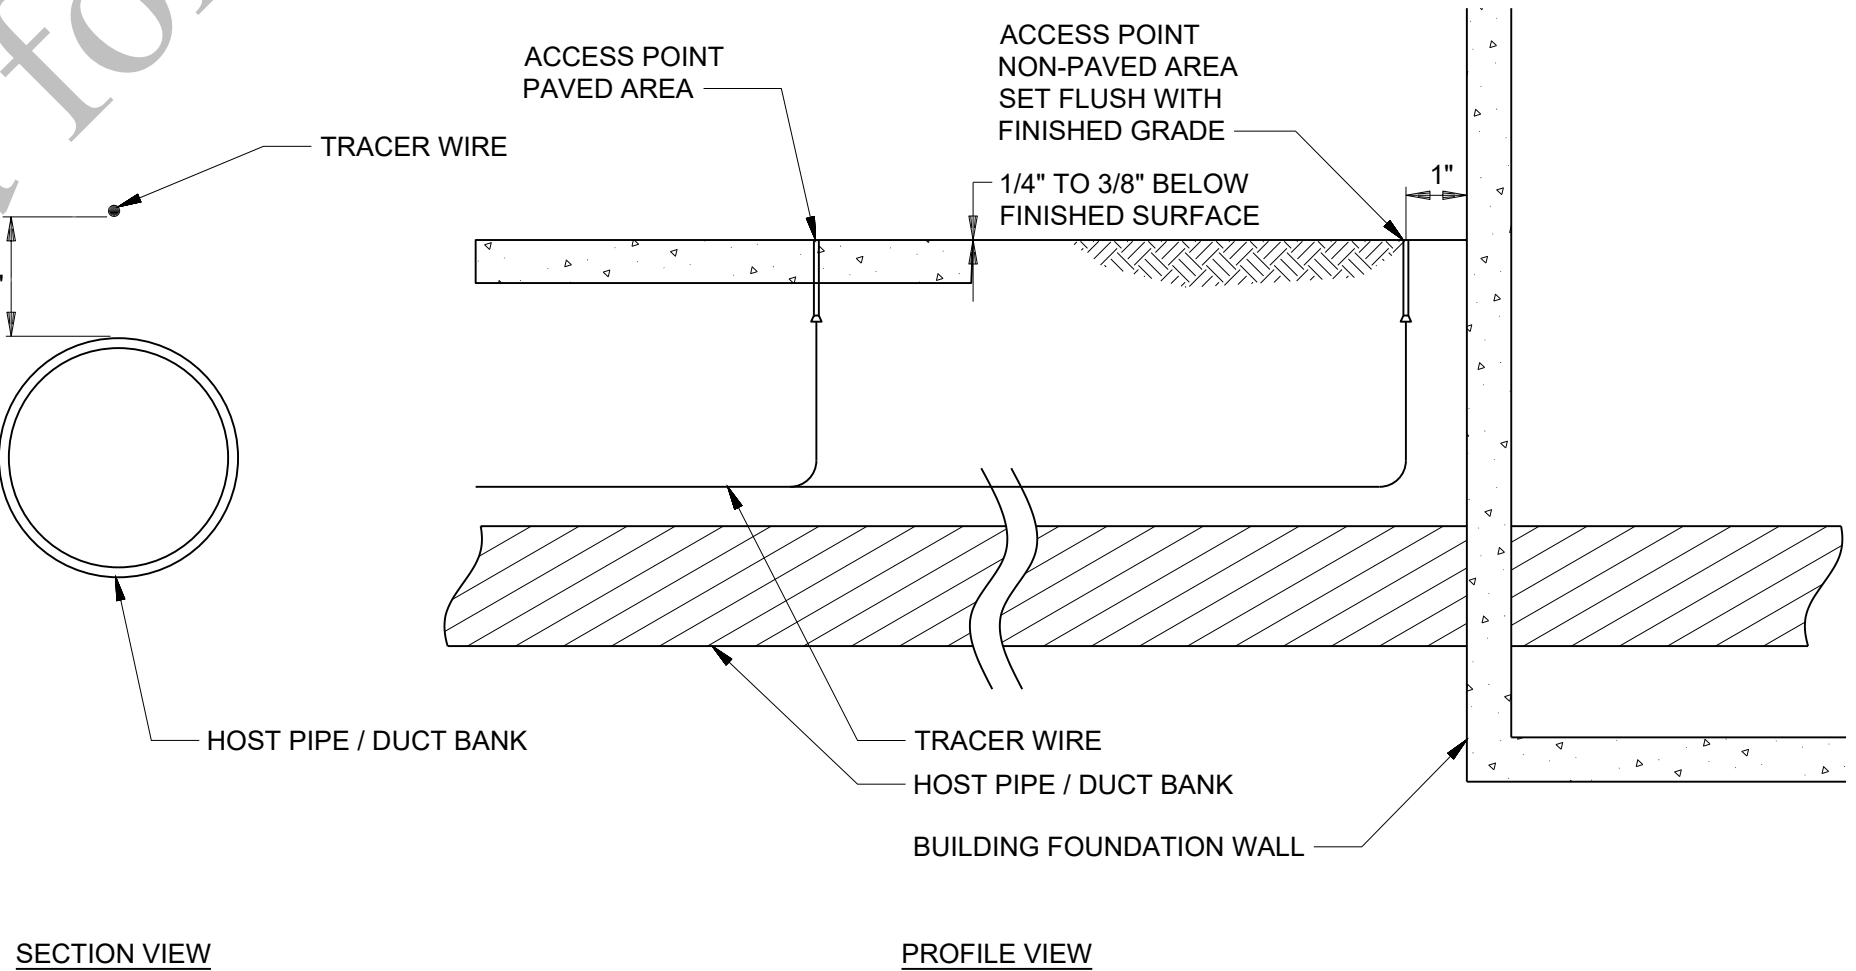

NOTES:

- ALL NEW UNDERGROUND PIPING AND DUCT BANKS SHALL BE BURIED WITH LOCATING TRACER WIRE APPROXIMATELY 6 INCHES ABOVE THE TOP OF PIPE. TRACER WIRES SHALL BE TERMINATED AS SHOWN ON THE PLANS OR AS DIRECTED.
- TRACER WIRE SHALL BE COPPER-CLAD STEEL HIGH STRENGTH 12 AWG AS MFG BY COPPERHEAD INDUSTRIES AND SHALL BE COLOR CODED PER APWA UNIFORM COLOR CODE.
- ACCESS POINTS SHALL BE PROVIDED AT EACH END OF NEW PIPING, OR IN BETWEEN ENDS OF PIPING IF REQUIRED. THE MAXIMUM LINEAR DISTANCE BETWEEN ACCESS POINTS SHALL BE 800 FEET. ACCESS POINTS IN NON-PAVED AREAS SHALL BE SNAKEPIT LITE DUTY ADJUSTABLE SINGLE TERMINAL ACCESS POINTS AS MFG BY COPPERHEAD INMUSTRIES, AND SHALL BE INSTALLED FLUSH WITH FINISHED GROUND ELEVATION. ACCESS POINTS IN PAVED AREAS SHALL BE SNAKEPIT ROADWAY SINGLE TERMINAL CAST IRON LID ACCESS POINTS AS MFG BY COPPERHEAD INDUSTRIES, AND SHALL BE INSTALLED 1/4" TO 3/8" BELOW FINAL PAVEMENT ELEVATION.

FRSA TREATMENT PLANT TRACER WIRE & ACCESS POINTS DETAIL
NO SCALE

(SCALE BAR IS 4" AT FULL SCALE) 0 1/2 1 2 3 4

REVISIONS AND RECORD OF ISSUE	
DESIGNED:	EJB
DETAILED:	SFR
CHECKED:	SDS
APPROVED:	EJB
DATE:	12/20/2022
PROJECT NO.:	411752

ELECTRICAL

DETAILS

57
OF
63



NOTE: IN ALL LOCATIONS, USE STAINLESS STEEL BOLTS, NUTS, WASHERS, AND ANCHOR BOLTS.



TYPICAL WEATHERPROOF RECEPTACLE
MOUNTING DETAIL
NO SCALE




NOTE: UNLESS OTHERWISE NOTED, ALL INDOOR FLOOR MOUNTED ELECTRICAL EQUIPMENT, INCLUDING SWITCHGEAR, SWITCHBOARDS, MOTOR CONTROL CENTERS, ADJUSTABLE FREQUENCY DRIVES, HARMONIC FILTERS, INSTRUMENT CABINETS, ETC., SHALL BE PROVIDED WITH EQUIPMENT BASES.



1. CABLE AND CONDUIT SUPPORTS SHALL BE SPACED AT 2'-0" HORIZONTAL CENTERS IN WALLS AND SHALL BEGIN 2'-0" FROM FLOOR.
2. SUPPORTS IN CEILINGS SHALL RUN FROM WALL TO WALL.
3. OPENING SHALL BE PROVIDED IN MANHOLE WALLS FOR CONDUIT BANK ENTRANCE AS REQUIRED.
4. ALL REINFORCING ON THIS DETAIL SHALL BE #5@12" UNLESS NOTED OTHERWISE. CENTER VERTICAL REINFORCING IN THE WALLS.
5. CONCRETE TO BE ROUGH AND CLEAN AT CONSTRUCTION JOINT FACES.


ELECTRICAL MANHOLE SECTION
 O SCALE NOT SUITABLE FOR ROADWAY LOCATIONS

PLOTTED: 12/16/2022 12:23 PM
 FILE: C:\pw_working\bwv_america\495380\99-E-503.dwg
 PLOTTED: 12/16/2022 12:23 PM
 FILE: C:\pw_working\bwv_america\495380\99-E-503.dwg

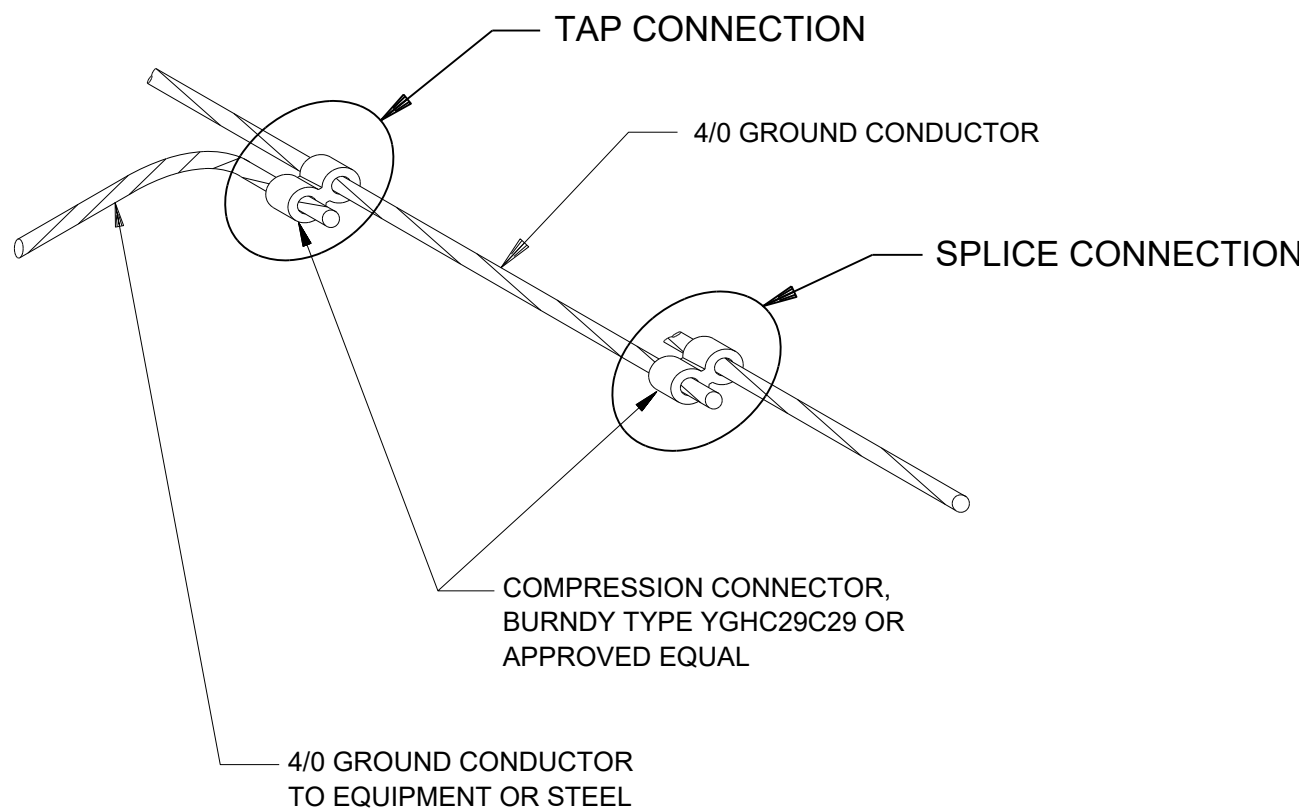


NOTE:
CONTRACTOR SHALL APPLY AN OXIDE-INHIBITING JOINT COMPOUND TO THE INSIDE CONTACT SURFACE OF THE COMPRESSION CONNECTOR PRIOR TO INSTALLING THE COMPRESSION CONNECTOR.

TYPICAL COMPRESSION FITTING TEE CONNECTION

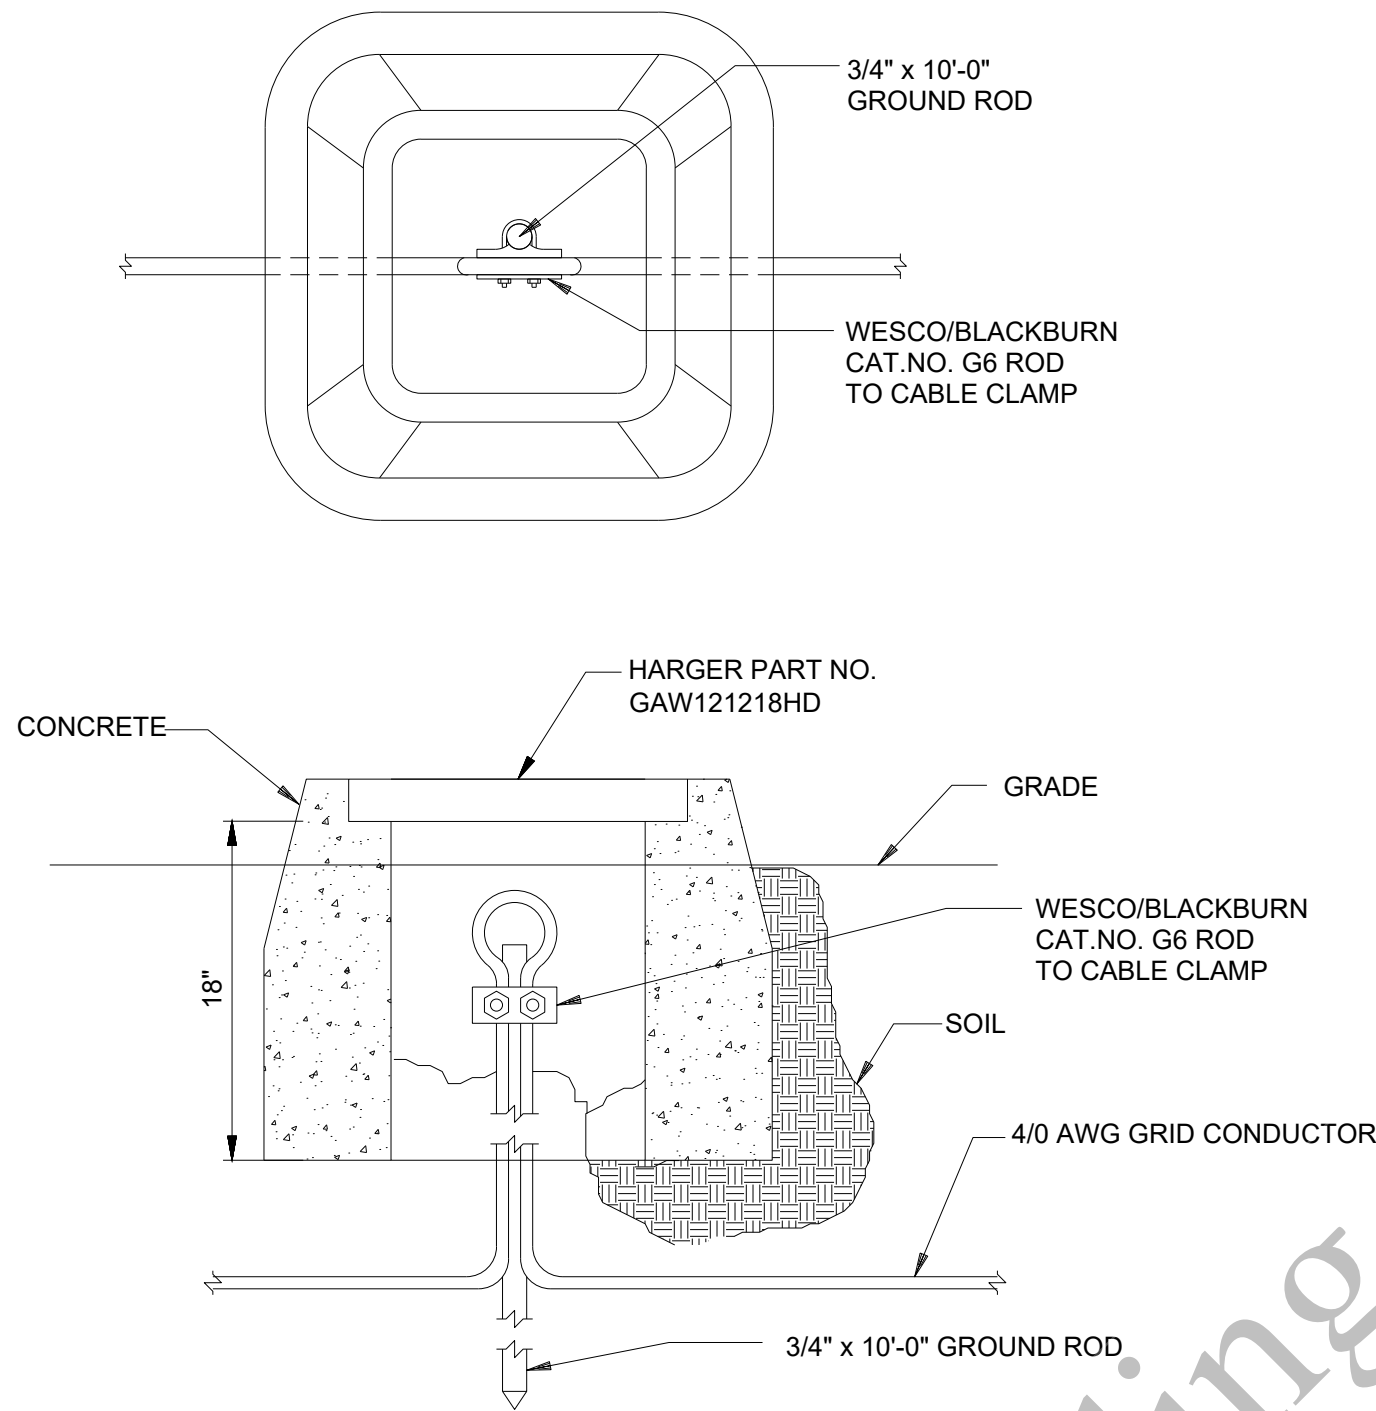


ELEVATION
TYPICAL GROUND TEST STATION

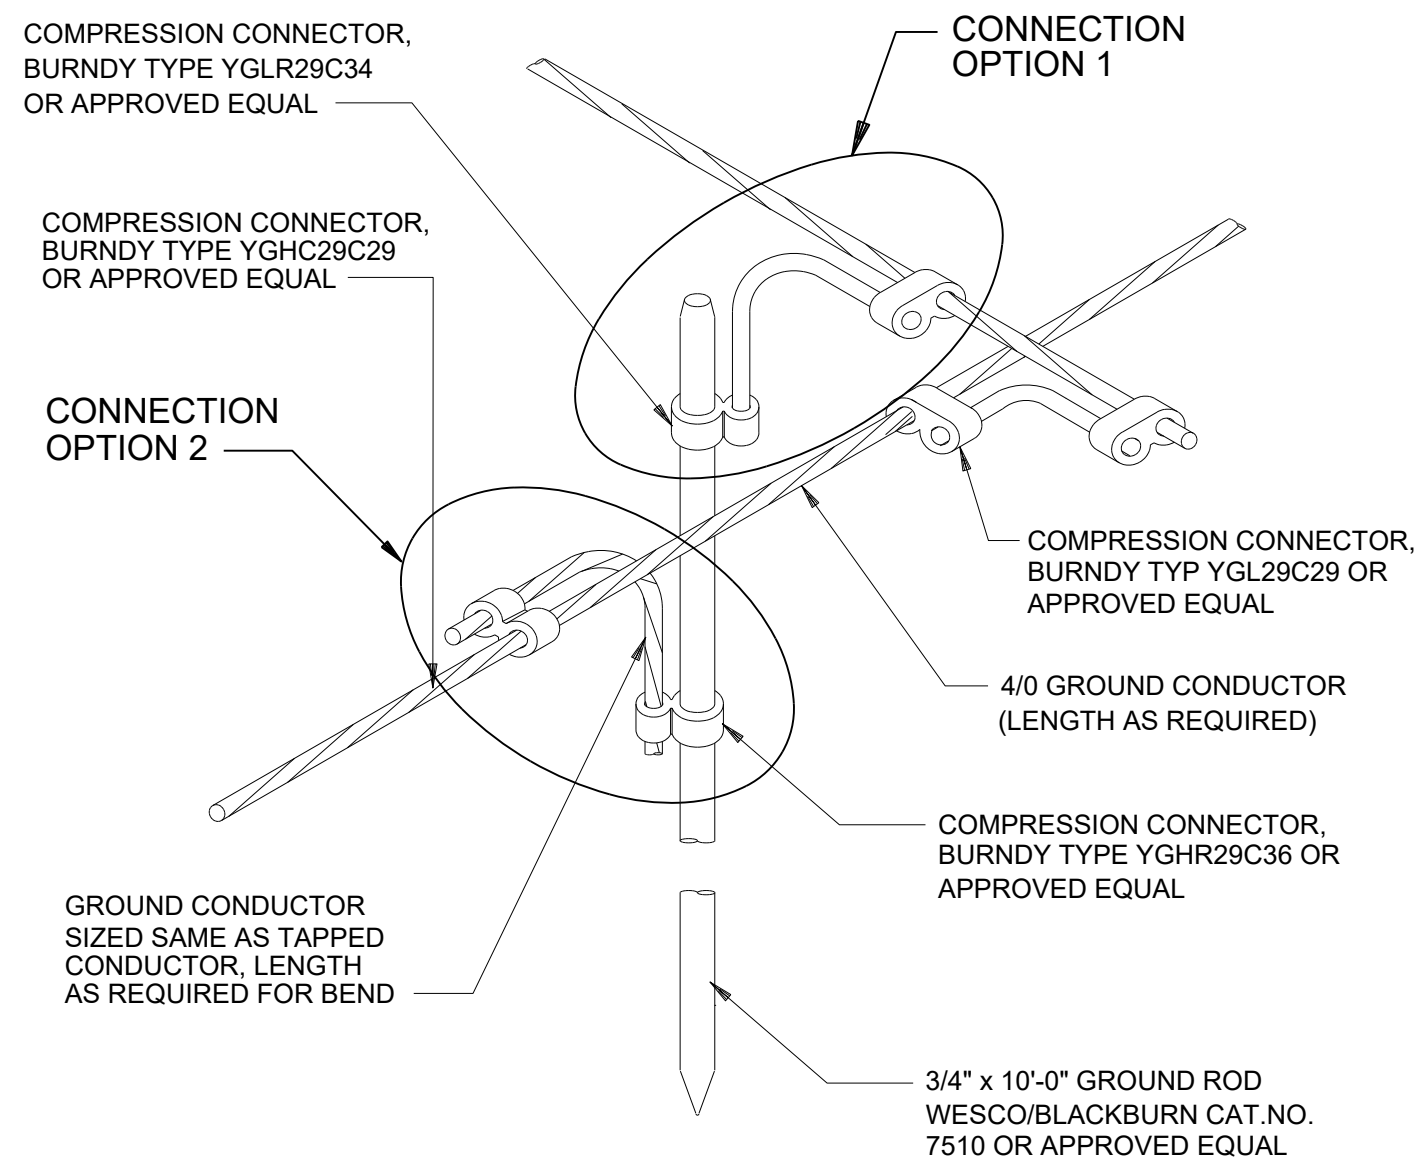


NOTE:
CONTRACTOR SHALL APPLY AN OXIDE-INHIBITING JOINT COMPOUND TO THE INSIDE CONTACT SURFACE OF THE COMPRESSION CONNECTORS PRIOR TO INSTALLING THE COMPRESSION CONNECTORS.

TYPICAL COMPRESSION FITTING
GROUND ROD TO CONNECTION AT CROSS OR TEE
(TWO CONNECTION OPTIONS SHOWN)

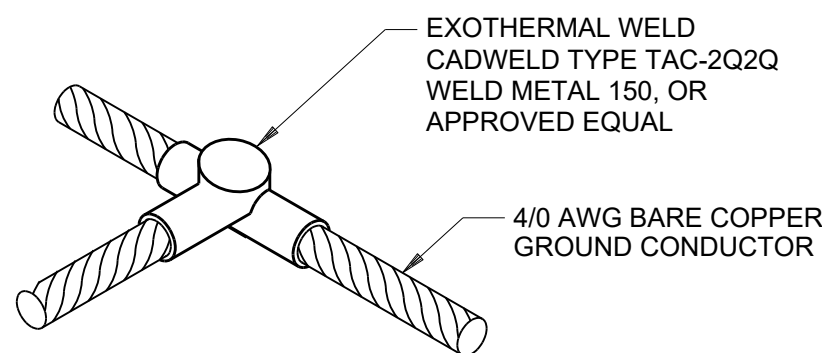

TYPICAL EXOTHERMAL WELD
TEE CONNECTION

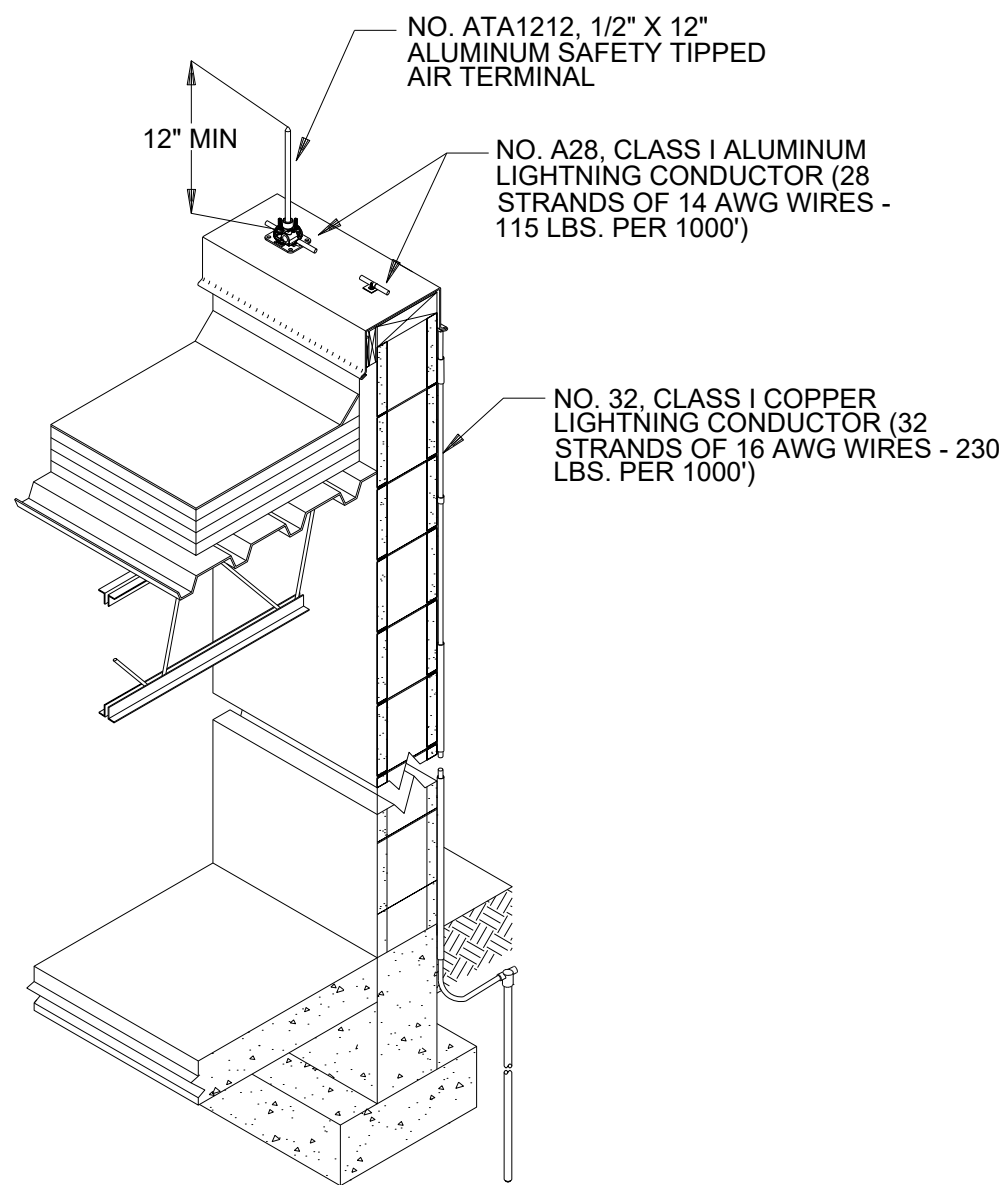

NOTE - ALL SPECIFIED EQUIPMENT AND INSTALLATION CONFIGURATIONS TO BE FINALIZED AND APPROVED BY QUALIFIED LIGHTNING PROTECTION ENGINEER.

LIGHTNING PROTECTION AIR
TERMINAL AND DOWN CONDUCTOR

REVISIONS AND RECORD OF ISSUE	
DESIGNED:	EJB
DETAILED:	SFR
CHECKED:	SDS
APPROVED:	EJB
DATE:	12/20/2022
PROJECT NO.:	411752

AEROBIC GRANULAR
SLUDGE - PHASE 1

REVISIONS AND RECORD OF ISSUE


DESIGNED:	MJP
DETAILED:	DHH
CHECKED:	SAY
APPROVED:	MJP
DATE:	12/20/2022
PROJECT NO.:	411752

DETAILS

INSTRUMENTATION

INSTRUMENT
INSTALLATION DETAILS
1 OF 4


99-I-501

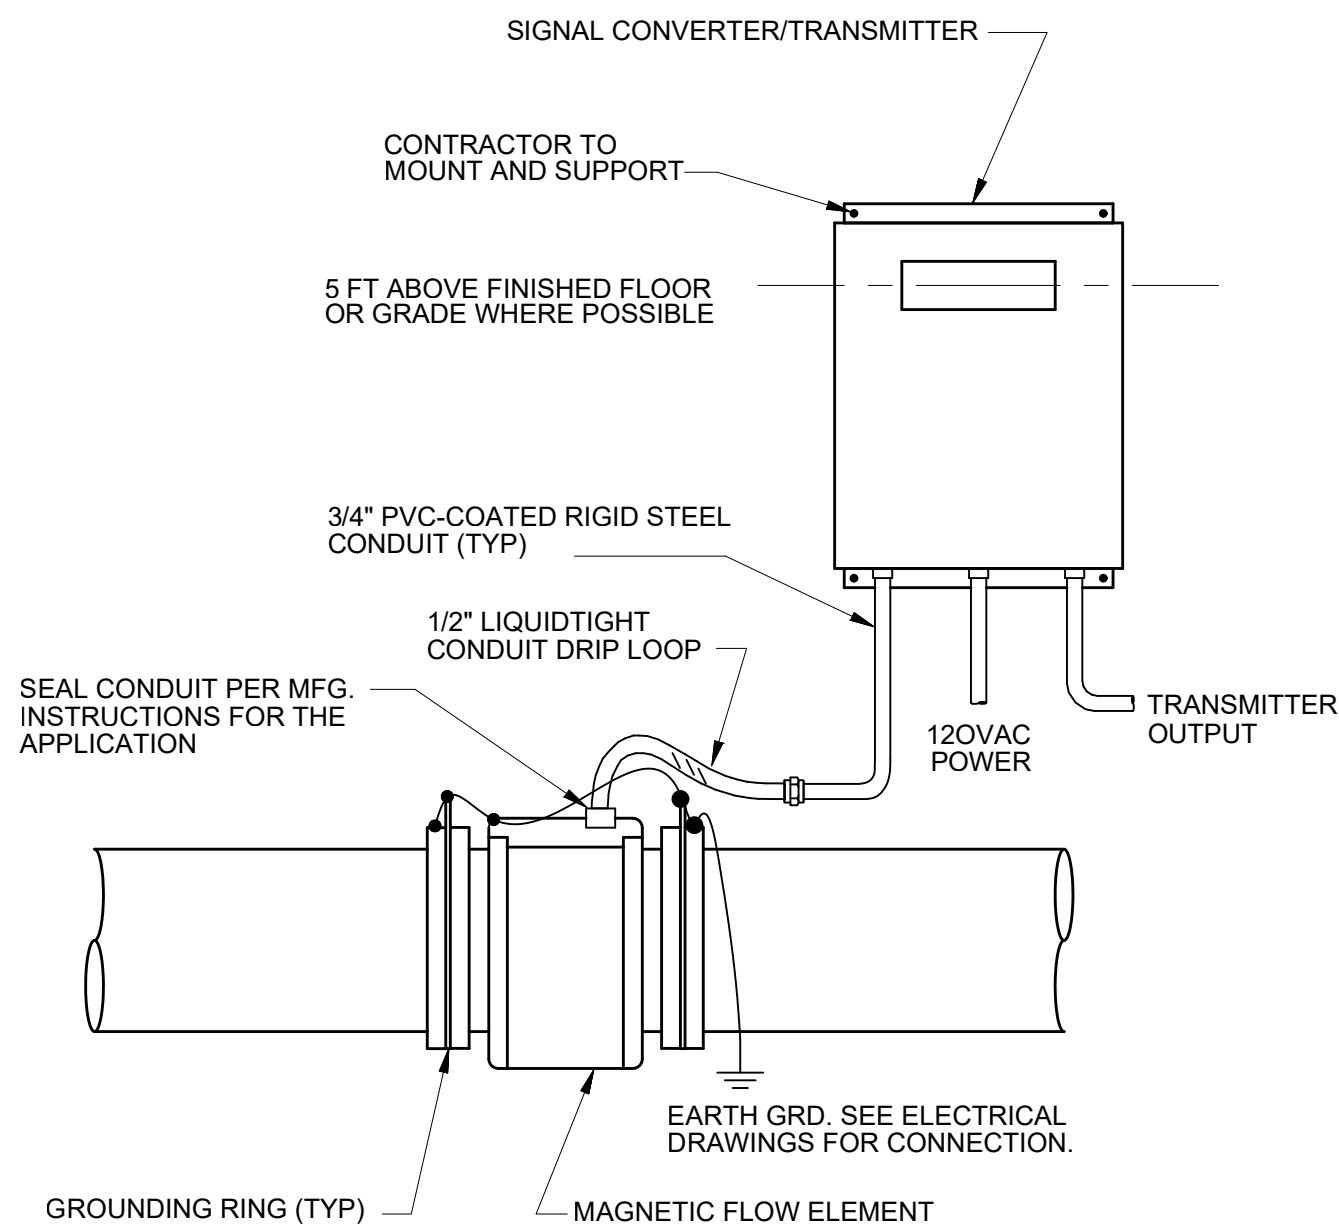159
OF
163

A MAGNETIC FLOWMETER
NO SCALE

NOTES:


1. PIPE TO BE SUPPORTED ON BOTH SIDES OF METER.

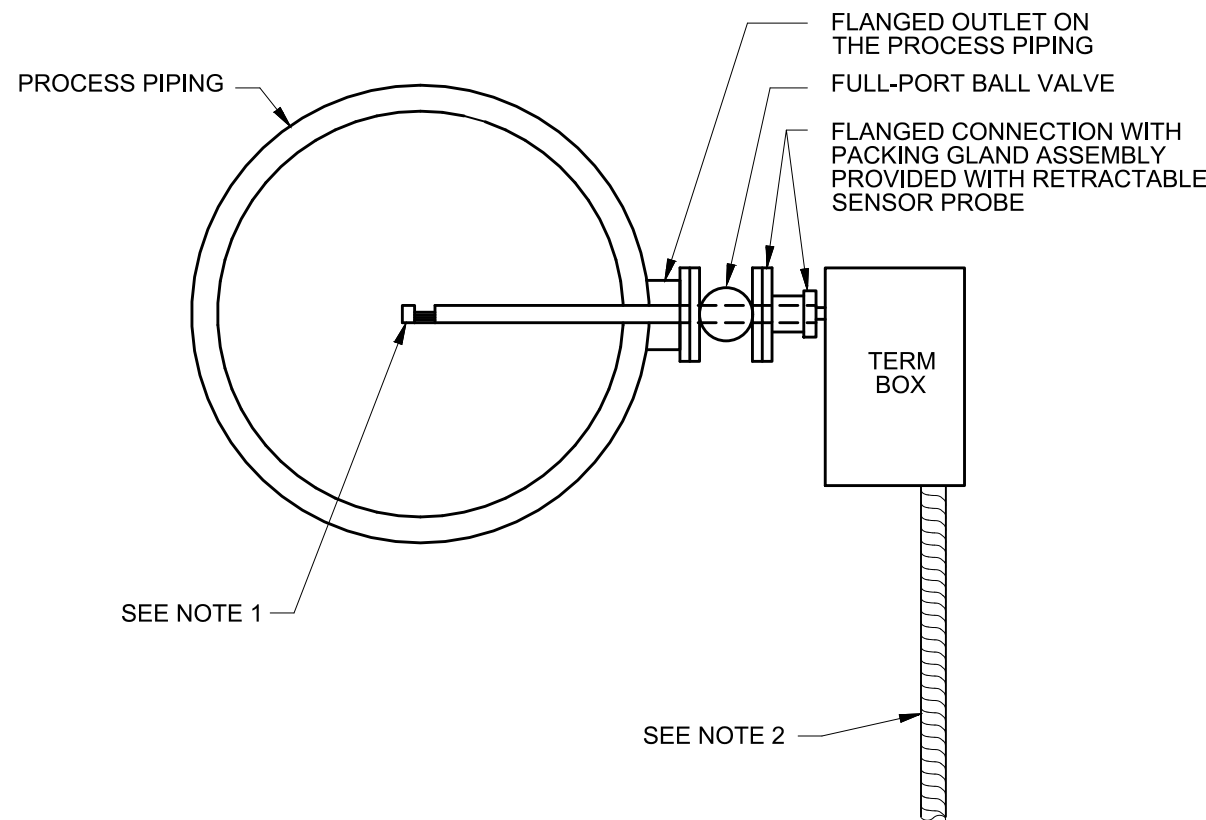

B THERMAL DISPERSION FLOWMETER
(HOT-TAP TYPE SENSOR)
NO SCALE

NOTES:


1. PROBE LENGTH AND ORIENTATION OF PROBE TO FLOW PROFILE SHALL CONFORM TO MANUFACTURER RECOMMENDATIONS.
2. LENGTH OF LIQUIDTIGHT FLEXIBLE METAL CONDUIT TO INDICATOR/TRANSMITTER AS REQUIRED TO ALLOW EASY REMOVAL OF SENSOR, CABLE BETWEEN PROBE AND INDICATOR/TRANSMITTER SHALL BE MANUFACTURER SUPPLIED.

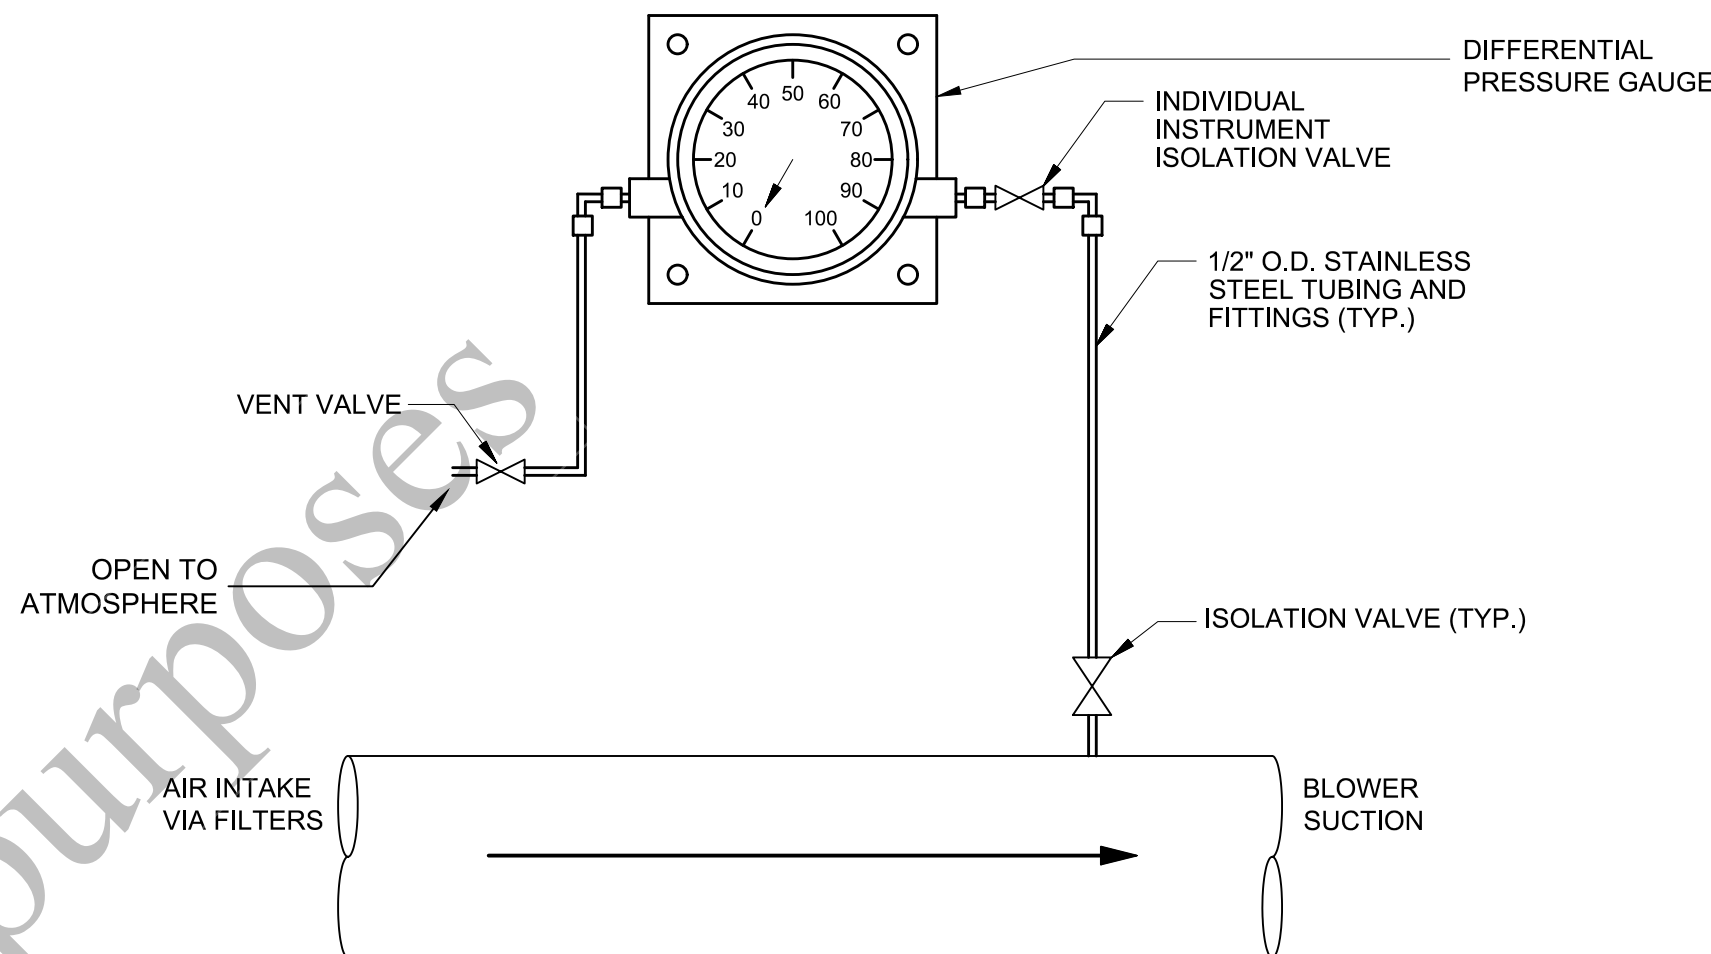

C DIFFERENTIAL PRESSURE GAUGE
NO SCALE

NOTES:


1. DETAIL SHOWS SCHEMATIC REPRESENTATION OF PRESSURE CONNECTIONS. PROVIDE MFR BRACKETS, UNISTRUTS, OR OTHER SUPPORTS AS NECESSARY.
2. INSTRUMENTATION SHALL BE MOUNTED AS TO BE EASILY VISIBLE AND SERVICED.

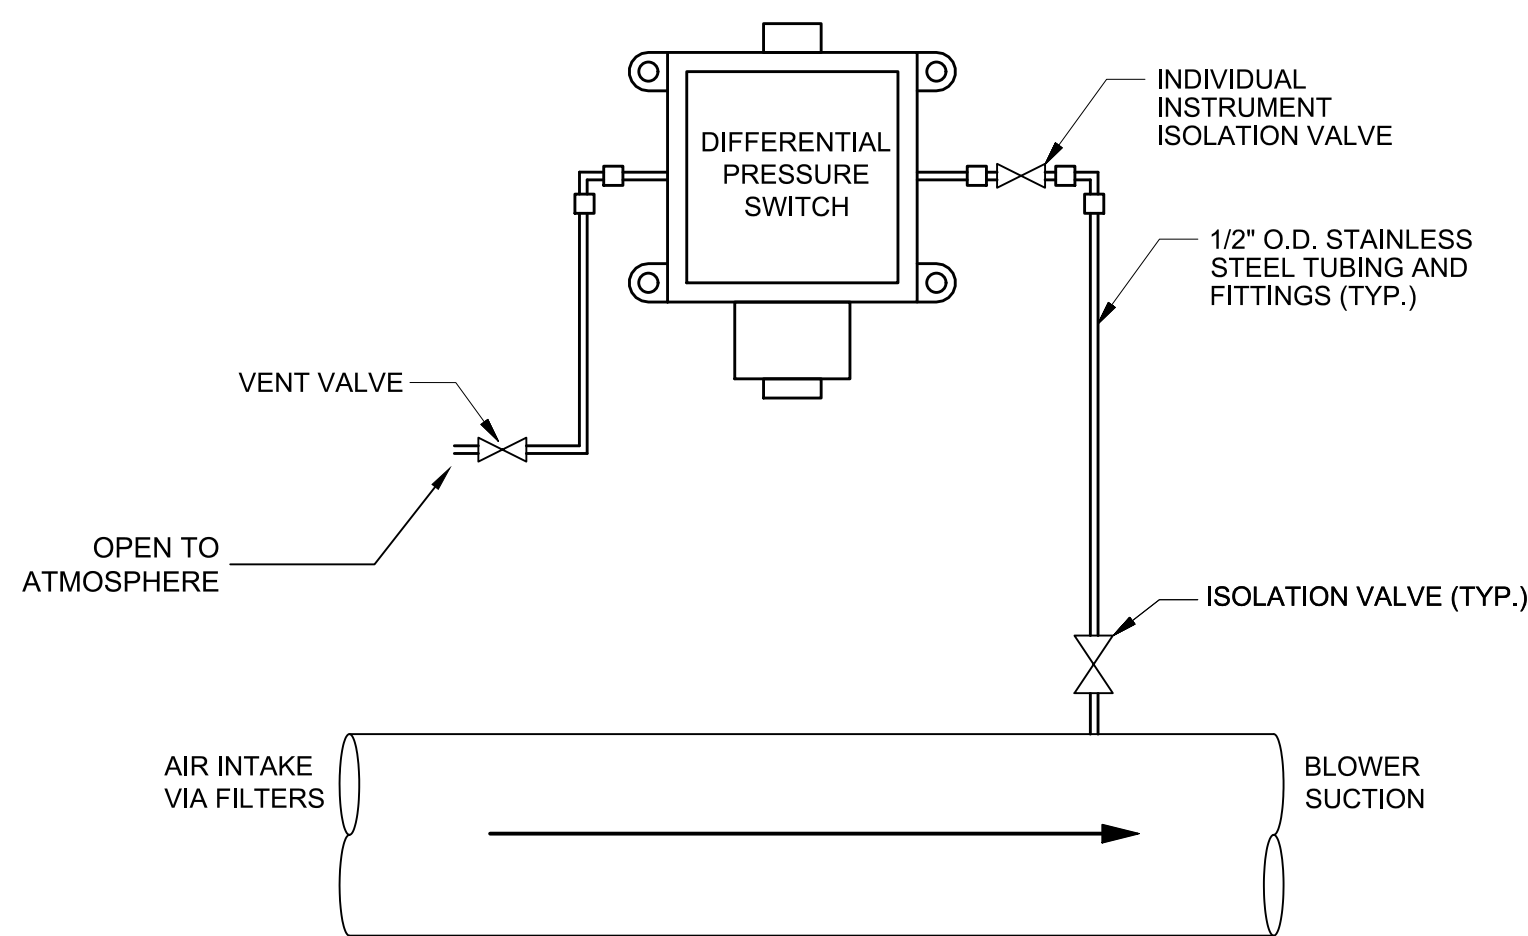

D DIFFERENTIAL PRESSURE SWITCH
NO SCALE

NOTES:


1. DETAIL SHOWS SCHEMATIC REPRESENTATION OF PRESSURE CONNECTIONS. PROVIDE MFR BRACKETS, UNISTRUTS, OR OTHER SUPPORTS AS NECESSARY.
2. INSTRUMENTATION SHALL BE MOUNTED AS TO BE EASILY VISIBLE AND SERVICED.

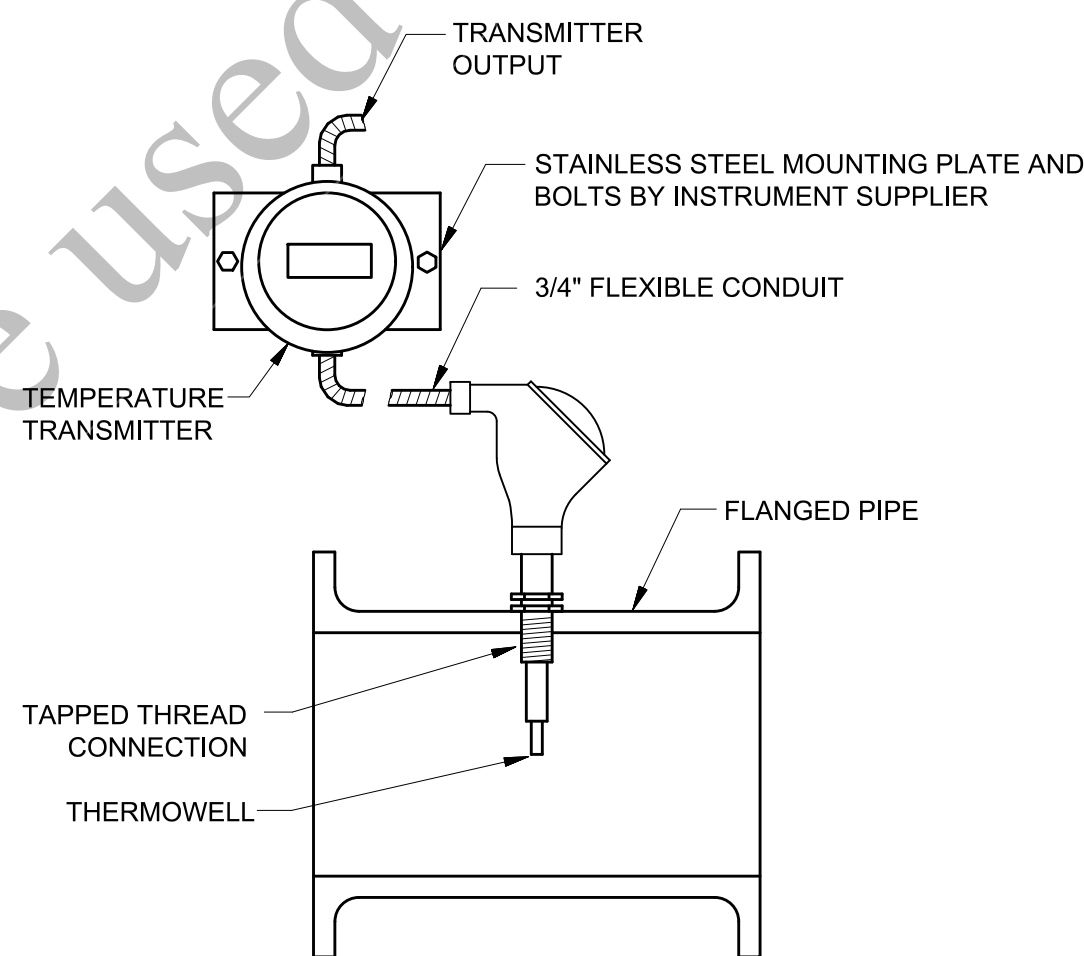

E TEMPERATURE TRANSMITTER (REMOTE-MOUNT)
NO SCALE

NOTES:


1. THERMOWELLS SHALL BE EITHER WELD-TYPE OR THREADED. SITE CONNECTIONS OR APPLICATION SHALL DETERMINE TYPE.
2. THERMOWELLS AND RTS'S TO BE SIZED FOR THE INSERTION DEPTH OF THE PIPE.

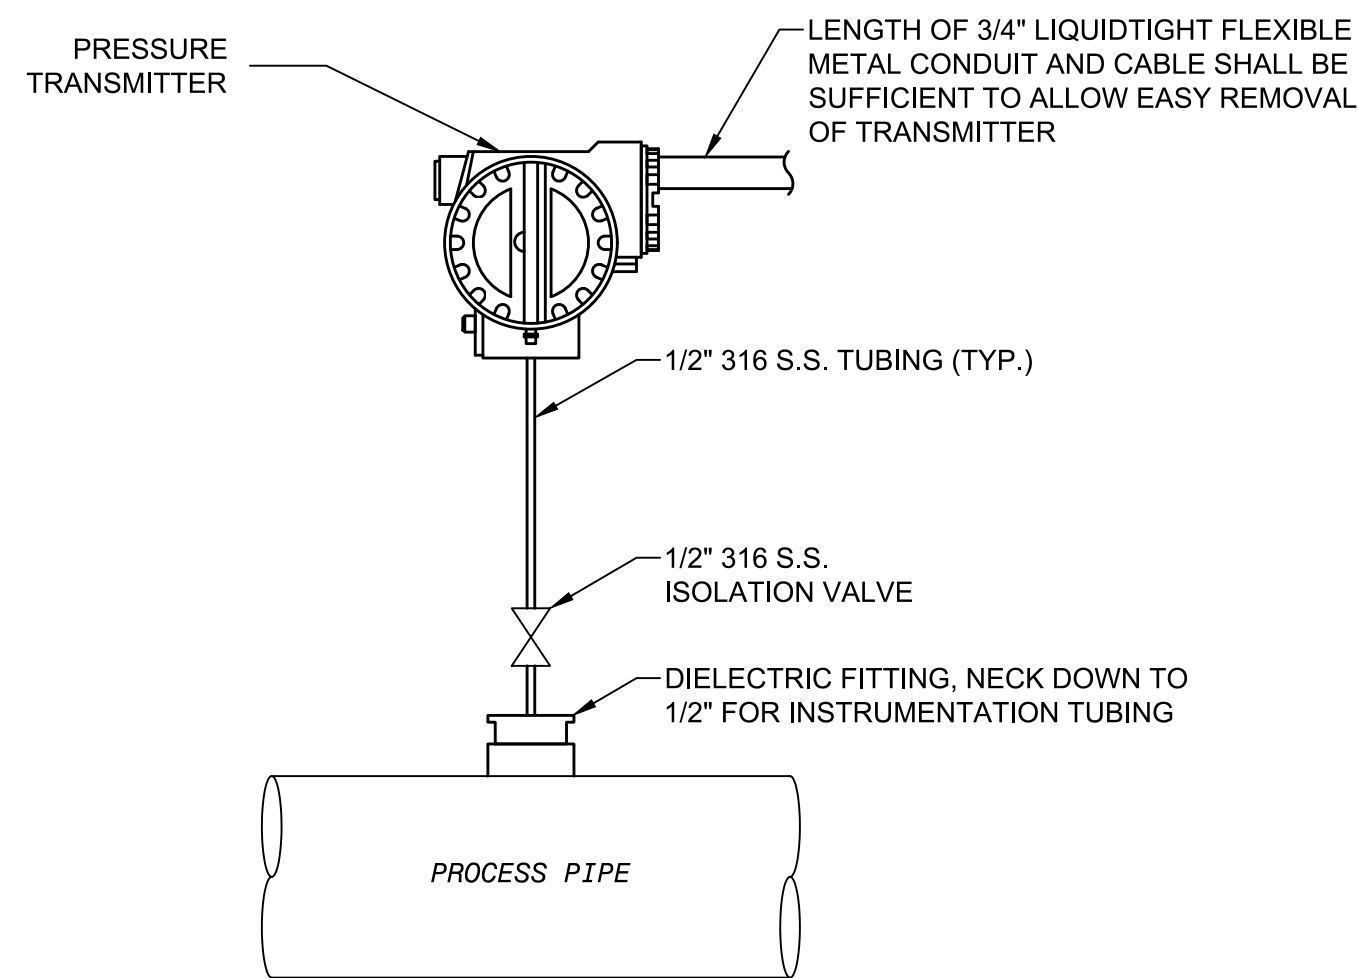

F PRESSURE TRANSMITTER
NO SCALE


NOTES:

1. PROVIDE MFR BRACKET OR UNISTRUT SUPPORT FOR PRESSURE INSTRUMENTATION AS REQUIRED.

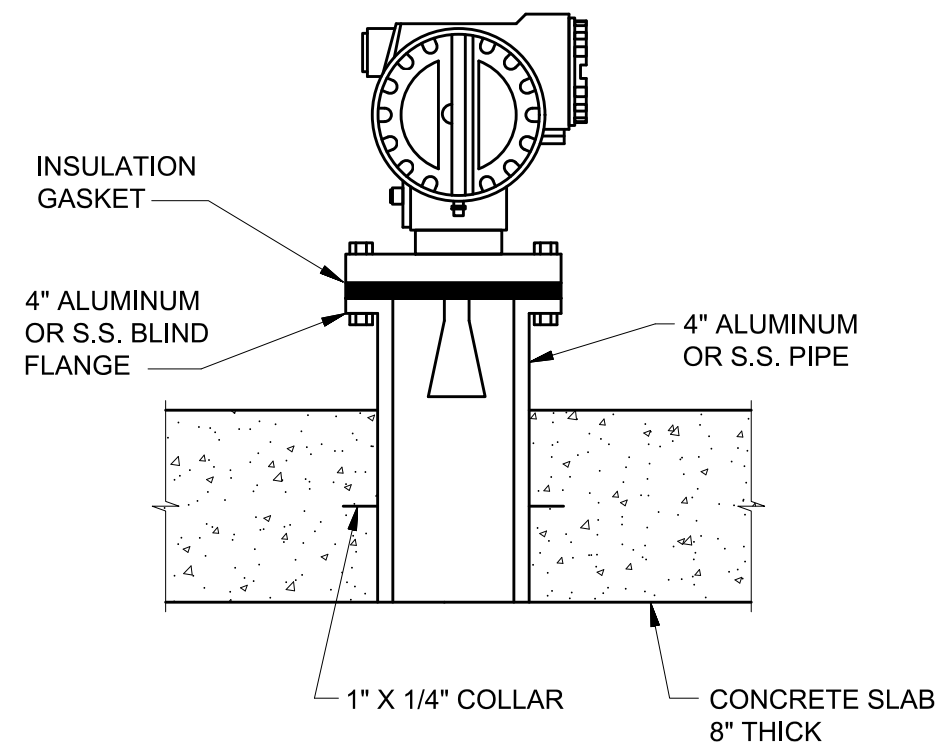


G **RADAR LEVEL TRANSMITTER**
NO SCALE

- NOTES:
1. THIS DETAIL ALSO APPLIES FOR LEVEL TRANSMITTERS ON THE GROUNDWATER BASIN DRAIN VALVE PIPING AS INDICATED ON 01-I-601. NOTE THAT FOR THIS APPLICATION, THE RADAR LEVEL TRANSMITTERS SHALL BE INSTALLED ON VERTICAL 8" STEEL PIPE EXTENDING OUT OF THE BASIN WALL. THIS 8" STEEL PIPE SHALL BE ROUTED THROUGH THE BASIN WALL TO THE 10" PERFORATED PVC PIPING.

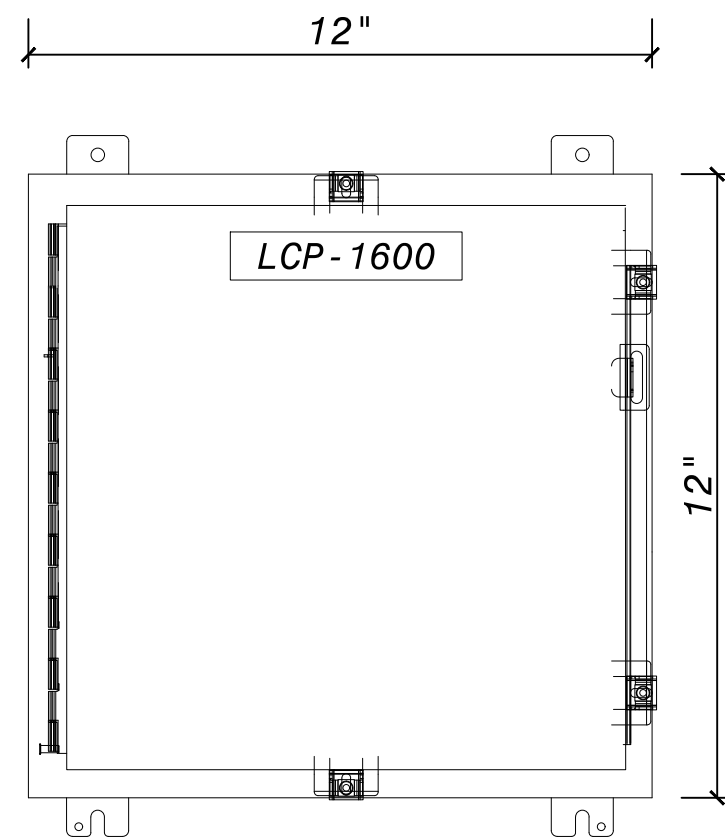


J **LOW WATER CUTOFF RELAY PANEL**
NO SCALE

- NOTES:
1. SEE PANEL SCHEMATIC ON DRAWING 02-E-708.
 2. PANEL SHALL BE STAINLESS STEEL RATED NEMA 4X WITH A MINIMUM SIZE OF 12"H X 12"W X 6"D.

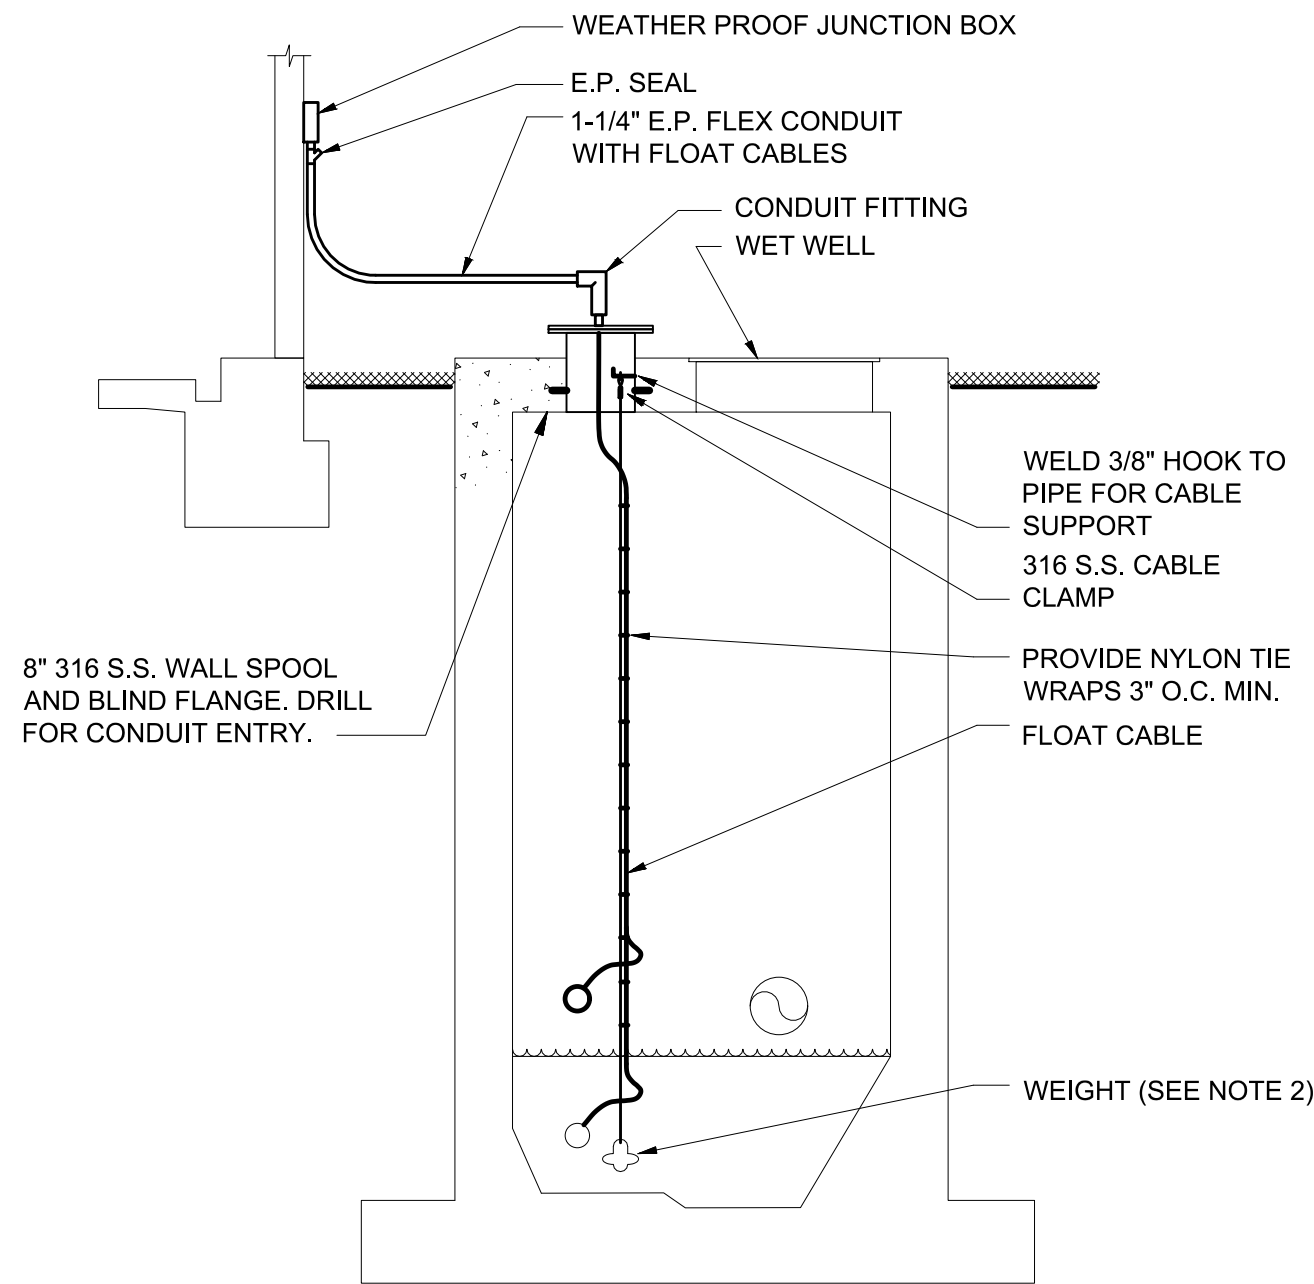


H **FLOAT SWITCH (CABLE-MOUNT)**
NO SCALE

- NOTES:
1. SEE DEVICE SCHEDULE AND SCHEMATICS FOR ELEVATIONS, CONTACT REQUIREMENTS, AND NUMBER OF FLOAT SWITCHES.
 2. CONTRACTOR SHALL PROVIDE A WEIGHT TO KEEP THE FLOATS IN POSITION. THE WEIGHT MATERIAL SHALL BE COMPATIBLE WITH THE PROCESS CONDITIONS WITHIN WETWELL AND A CHLORIDE CONCENTRATION OF 300 MG/L. WEIGHT AND FLOAT CABLE SHALL BE INCLUDED WITH THE FLOAT LEVEL SWITCH SUBMITTAL FOR REVIEW BY ENGINEER.

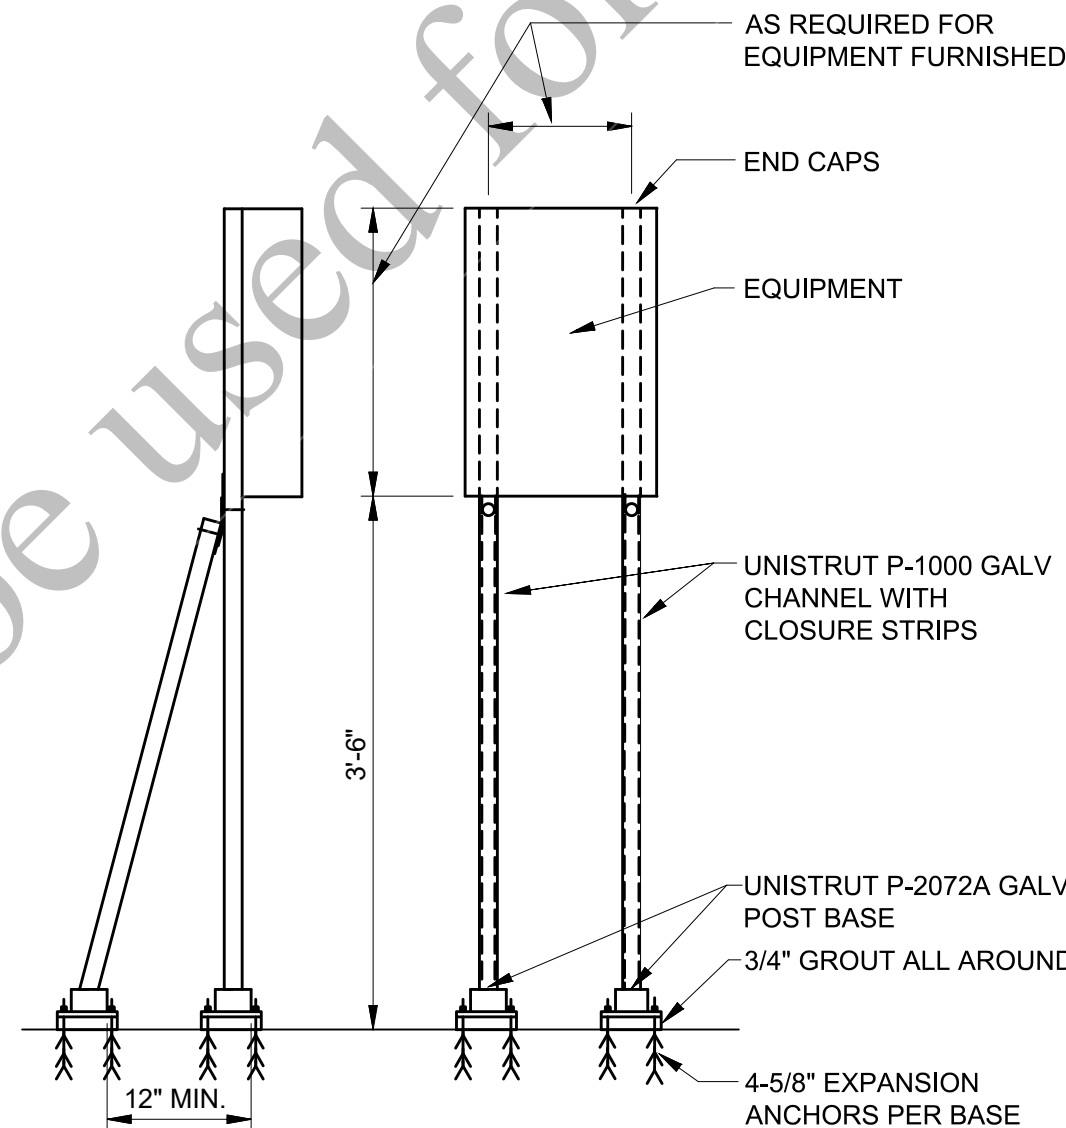

K **TYPICAL EQUIPMENT MOUNTING**
NO SCALE

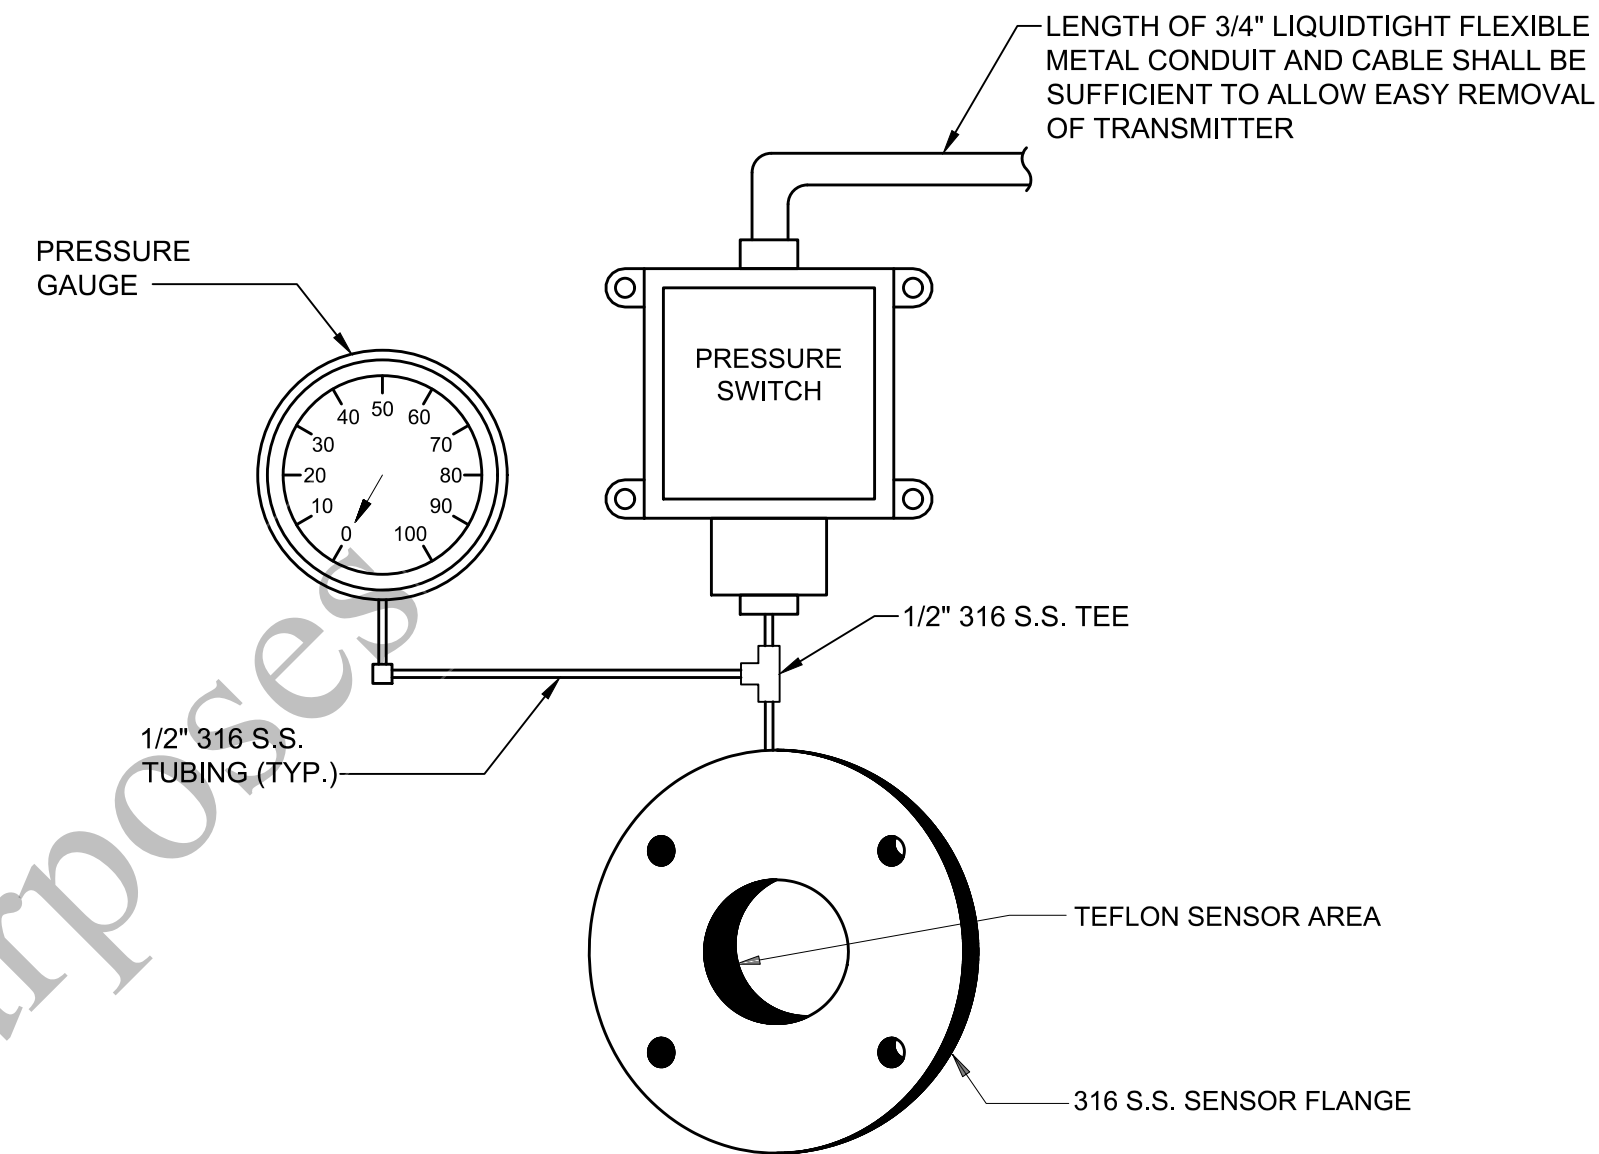


I **PRESSURE SWITCH / GAUGE WITH ANNULAR SEAL**
NO SCALE

- NOTES:
1. PROVIDE MFR BRACKET OR UNISTRUT SUPPORT FOR PRESSURE INSTRUMENTATION AS REQUIRED.


REVISIONS AND RECORD OF ISSUE	
DESIGNED:	MJP
DETAILED:	DHH
CHECKED:	SAY
APPROVED:	MJP
DATE:	12/20/2022
PROJECT NO.:	411752

12/19/2022 1:41:45 PM
C:\USERS\HOT0633\APPDATA\LOCAL\AUTODESK\AUTOCAD PLANT 3D\COLLABORATION\CACHE\411752PID DWG\984-503.DWG
PLOT: FDI1000
D11000

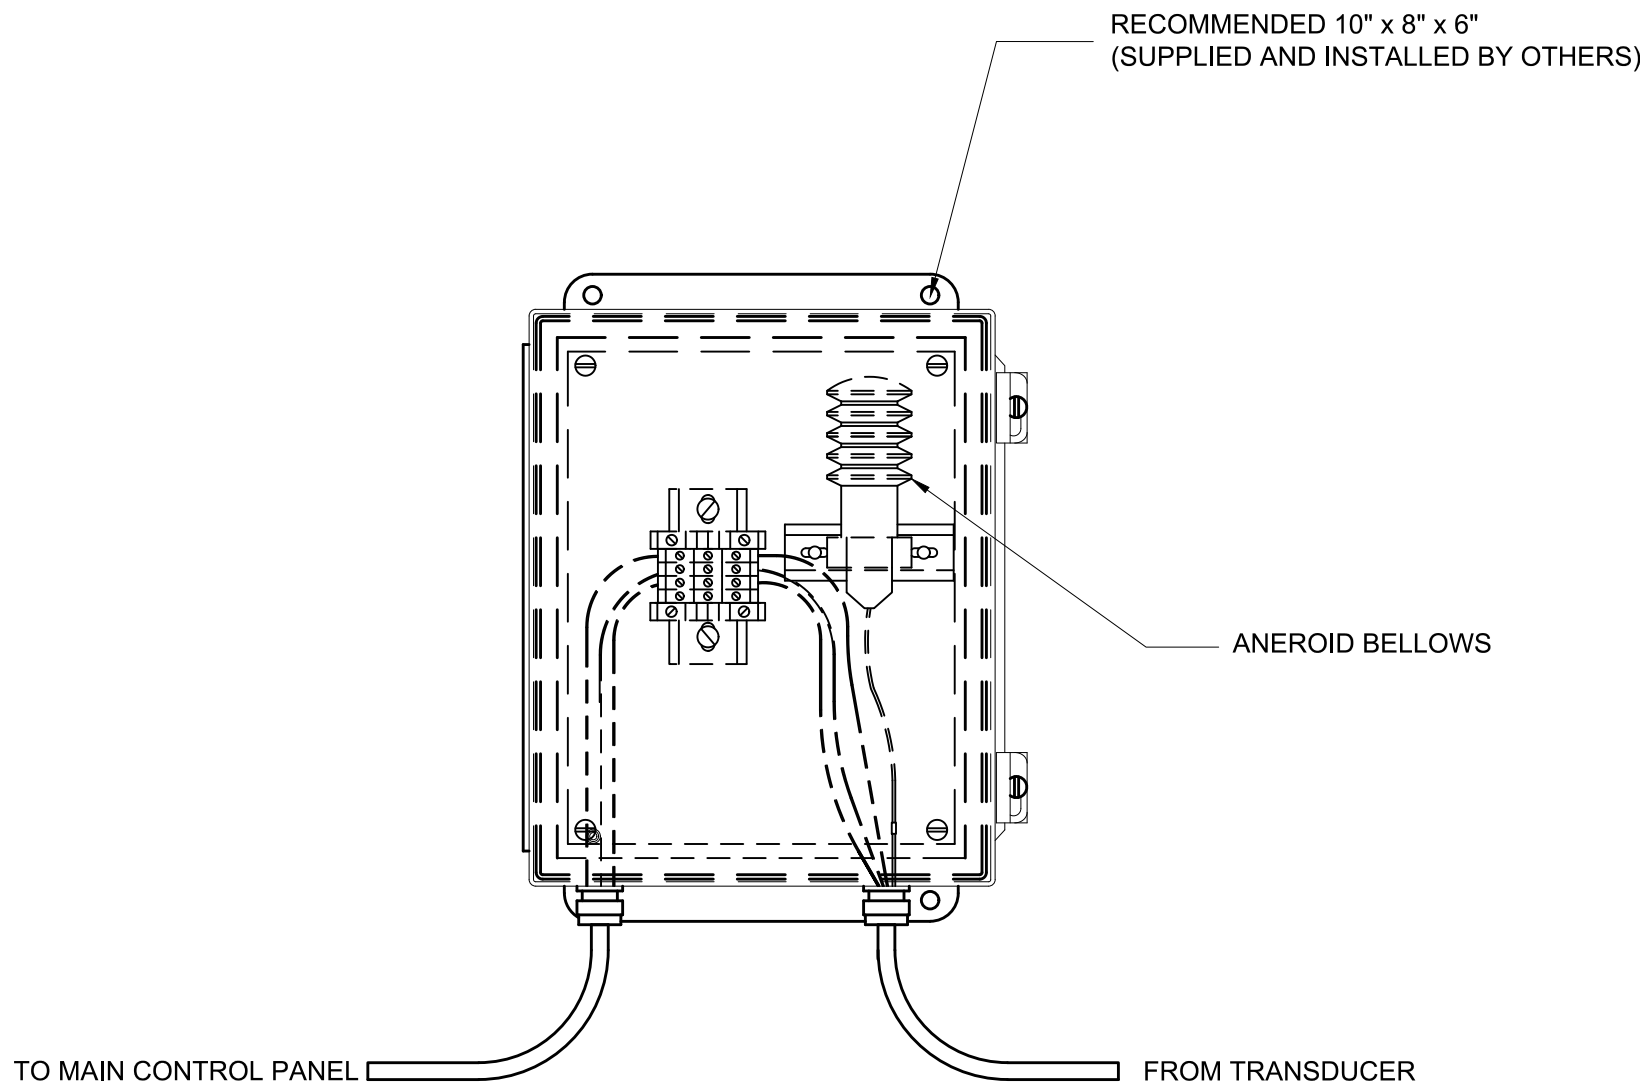


L AGS REACTOR JUNCTION BOX
NO SCALE

NOTES:
1. THIS DETAIL IS PROVIDED FOR REFERENCE ONLY BY THE AGS SYSTEM SUPPLIER IDENTIFIED IN THE BASE BID (TYPE III) MATERIAL AND EQUIPMENT SCHEDULE. FINAL INSTALLATION DETAILS ARE TO BE COORDINATED BY THE CONTRACTOR BASED ON THE ACTUAL EQUIPMENT SUPPLIED AND AGS SYSTEM SUPPLIER SUBMITTAL PACKAGE.

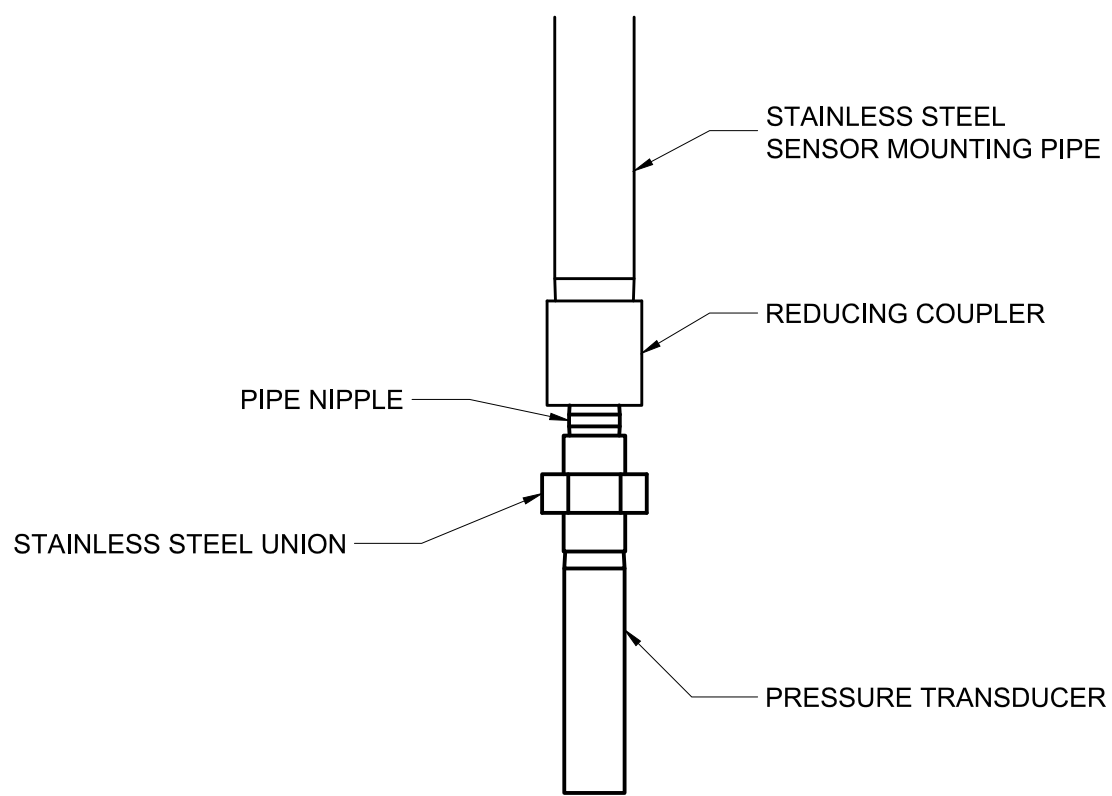


O AGS REACTOR PRESSURE TRANSDUCER
ENLARGED SENSOR ASSEMBLY
NO SCALE

NOTES:
1. THIS DETAIL IS PROVIDED FOR REFERENCE ONLY BY THE AGS SYSTEM SUPPLIER IDENTIFIED IN THE BASE BID (TYPE III) MATERIAL AND EQUIPMENT SCHEDULE. FINAL INSTALLATION DETAILS ARE TO BE COORDINATED BY THE CONTRACTOR BASED ON THE ACTUAL EQUIPMENT SUPPLIED AND AGS SYSTEM SUPPLIER SUBMITTAL PACKAGE.

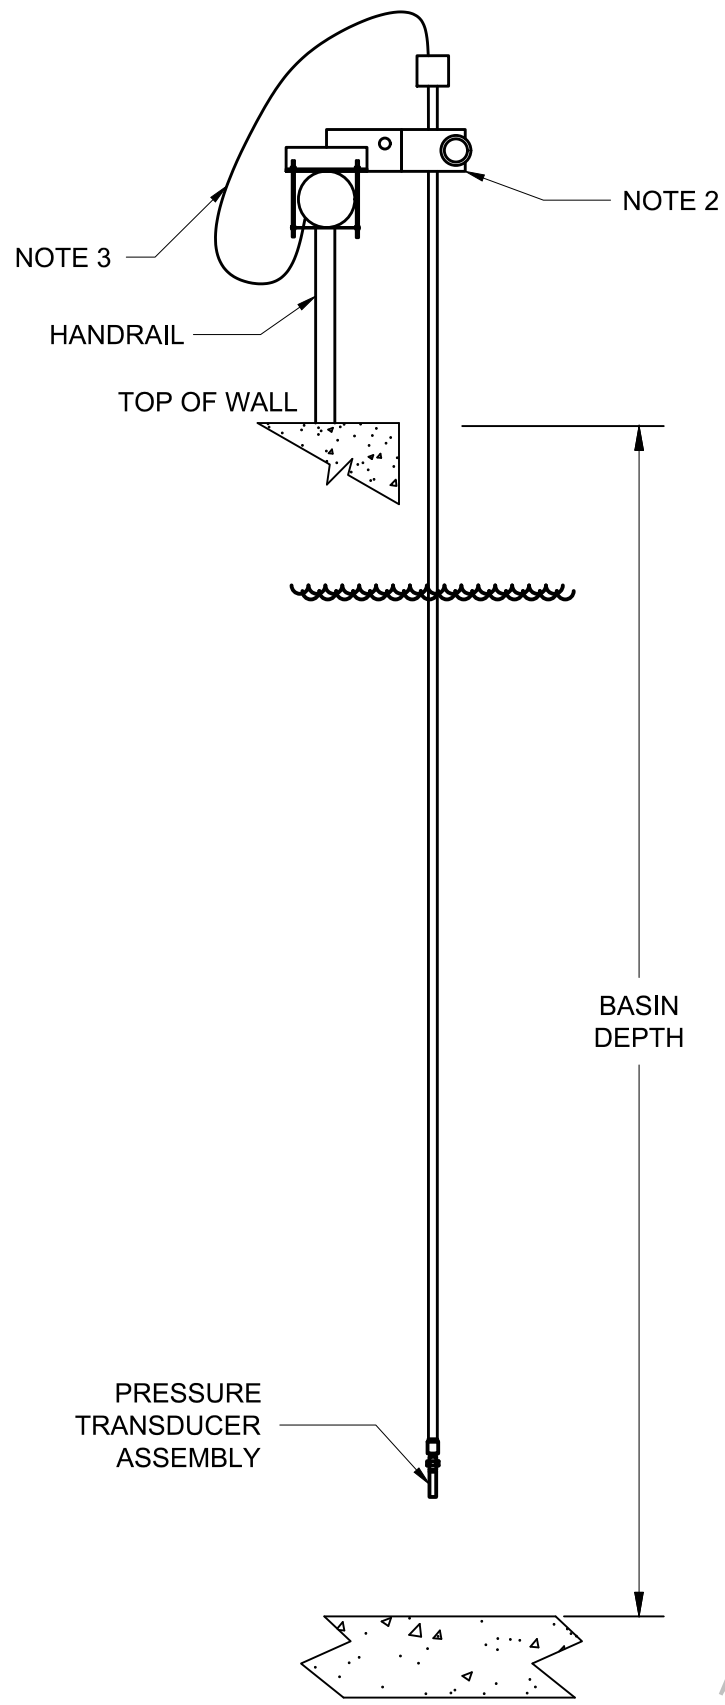


M AGS REACTOR PRESSURE TRANSDUCER
NO SCALE

NOTES:
1. THIS DETAIL IS PROVIDED FOR REFERENCE ONLY BY THE AGS SYSTEM SUPPLIER IDENTIFIED IN THE BASE BID (TYPE III) MATERIAL AND EQUIPMENT SCHEDULE AND REVISED BY ENGINEER TO MEET OWNER REQUESTS. FINAL INSTALLATION DETAILS ARE TO BE COORDINATED BY THE CONTRACTOR BASED ON THE ACTUAL EQUIPMENT SUPPLIED AND AGS SYSTEM SUPPLIER SUBMITTAL PACKAGE.
2. PROVIDE AND INSTALL A BRACKET THAT IS SECURED TO TOP HORIZONTAL RAIL OF HANDRAIL AND HOLDS PRESSURE TRANSDUCER ASSEMBLY. BRACKET SHALL BE CONSTRUCTED OF STAINLESS STEEL AND USE STAINLESS STEEL U-BOLTS, NUTS, AND WASHERS.
3. SENSOR CABLE ROUTED IN CONDUIT TO AGS REACTOR JUNCTION BOX.

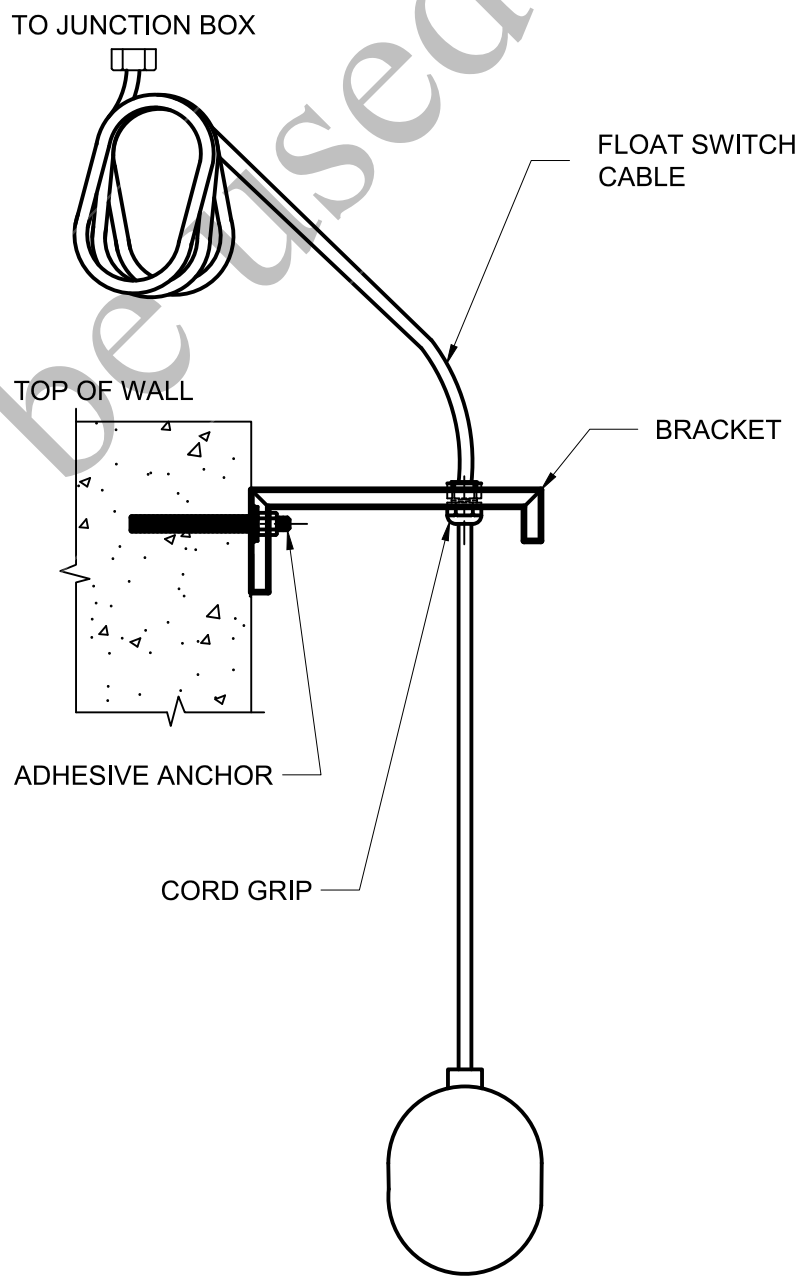

P FLOAT SWITCH DETAILS
NO SCALE

NOTES:
1. THIS DETAIL IS PROVIDED FOR REFERENCE ONLY BY THE AGS SYSTEM SUPPLIER IDENTIFIED IN THE BASE BID (TYPE III) MATERIAL AND EQUIPMENT SCHEDULE. FINAL INSTALLATION DETAILS ARE TO BE COORDINATED BY THE CONTRACTOR BASED ON THE ACTUAL EQUIPMENT SUPPLIED AND AGS SYSTEM SUPPLIER SUBMITTAL PACKAGE.

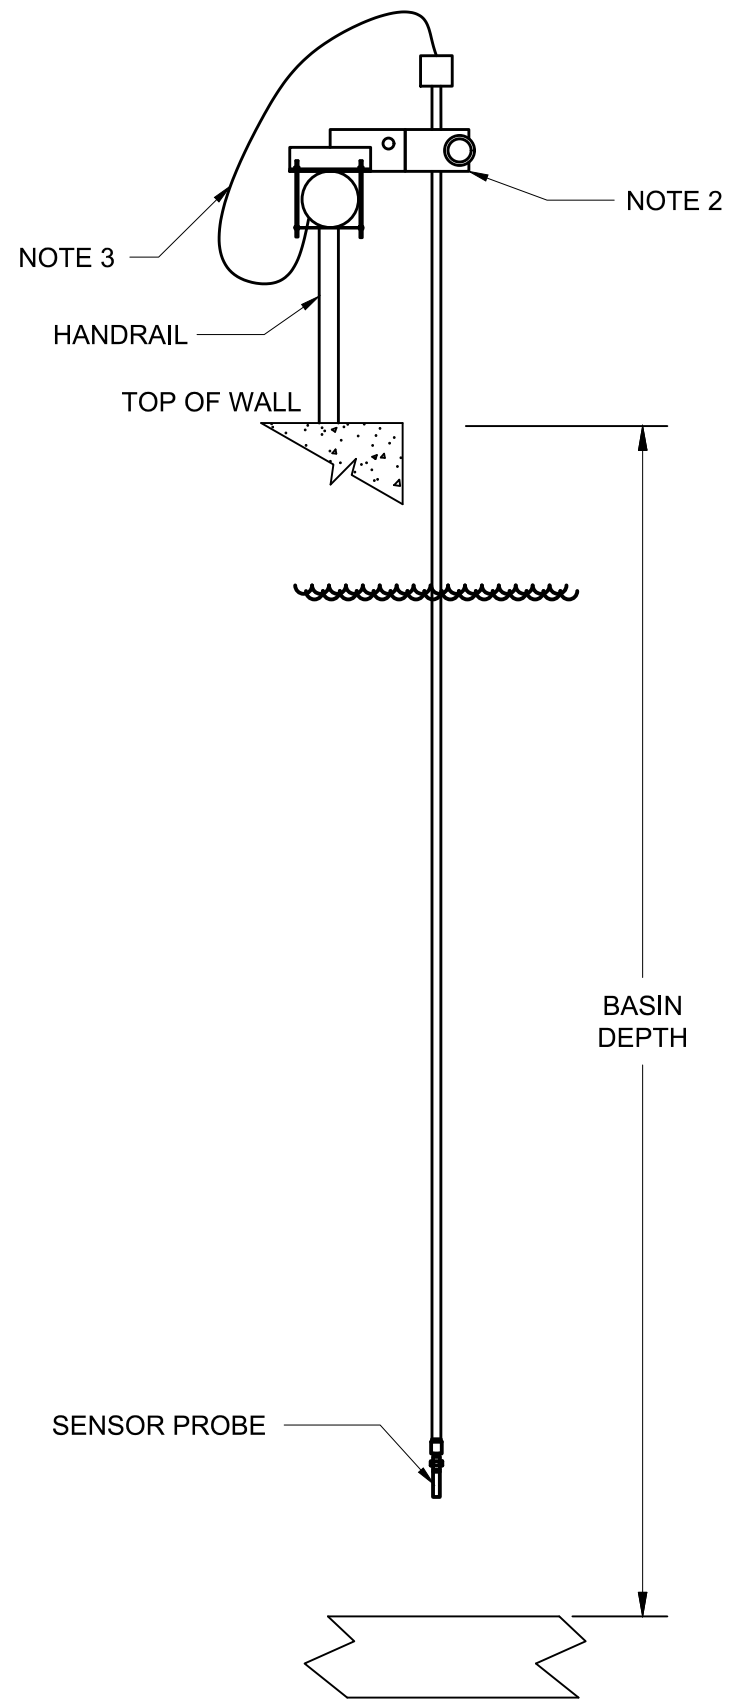

N AGS REACTOR PROBE
NO SCALE

NOTES:
1. THIS DETAIL IS PROVIDED FOR REFERENCE ONLY BY THE AGS SYSTEM SUPPLIER IDENTIFIED IN THE BASE BID (TYPE III) MATERIAL AND EQUIPMENT SCHEDULE AND REVISED BY ENGINEER TO MEET OWNER REQUESTS. FINAL INSTALLATION DETAILS ARE TO BE COORDINATED BY THE CONTRACTOR BASED ON THE ACTUAL EQUIPMENT SUPPLIED AND AGS SYSTEM SUPPLIER SUBMITTAL PACKAGE.
2. PROVIDE AND INSTALL A BRACKET THAT IS SECURED TO TOP HORIZONTAL RAIL OF HANDRAIL AND HOLDS REACTOR SENSOR PROBE AND AMMONIUM OR PHOSPHATE ANALYZER. BRACKET SHALL BE CONSTRUCTED OF STAINLESS STEEL AND USE STAINLESS STEEL U-BOLTS, NUTS, AND WASHERS.
3. SENSOR CABLE ROUTED IN CONDUIT TO AGS REACTOR JUNCTION BOX.

REVISIONS AND RECORD OF ISSUE	
DESIGNED:	MJP
DETAILED:	DHH
CHECKED:	SAY
APPROVED:	MJP
DATE:	12/20/2022
PROJECT NO.:	411752

DETAILS

INSTRUMENTATION

INSTRUMENT
INSTALLATION DETAILS
3 OF 4

99-I-503

161
OF
163

REVISIONS AND RECORD OF ISSUE	
DESIGNED:	MJP
DETAILED:	DHH
CHECKED:	SAY
APPROVED:	MJP
DATE:	12/20/2022
PROJECT NO.:	411752


DETAILS

INSTRUMENTATION

INSTRUMENT
INSTALLATION DETAILS
4 OF 4


99-I-504

162
OF
163

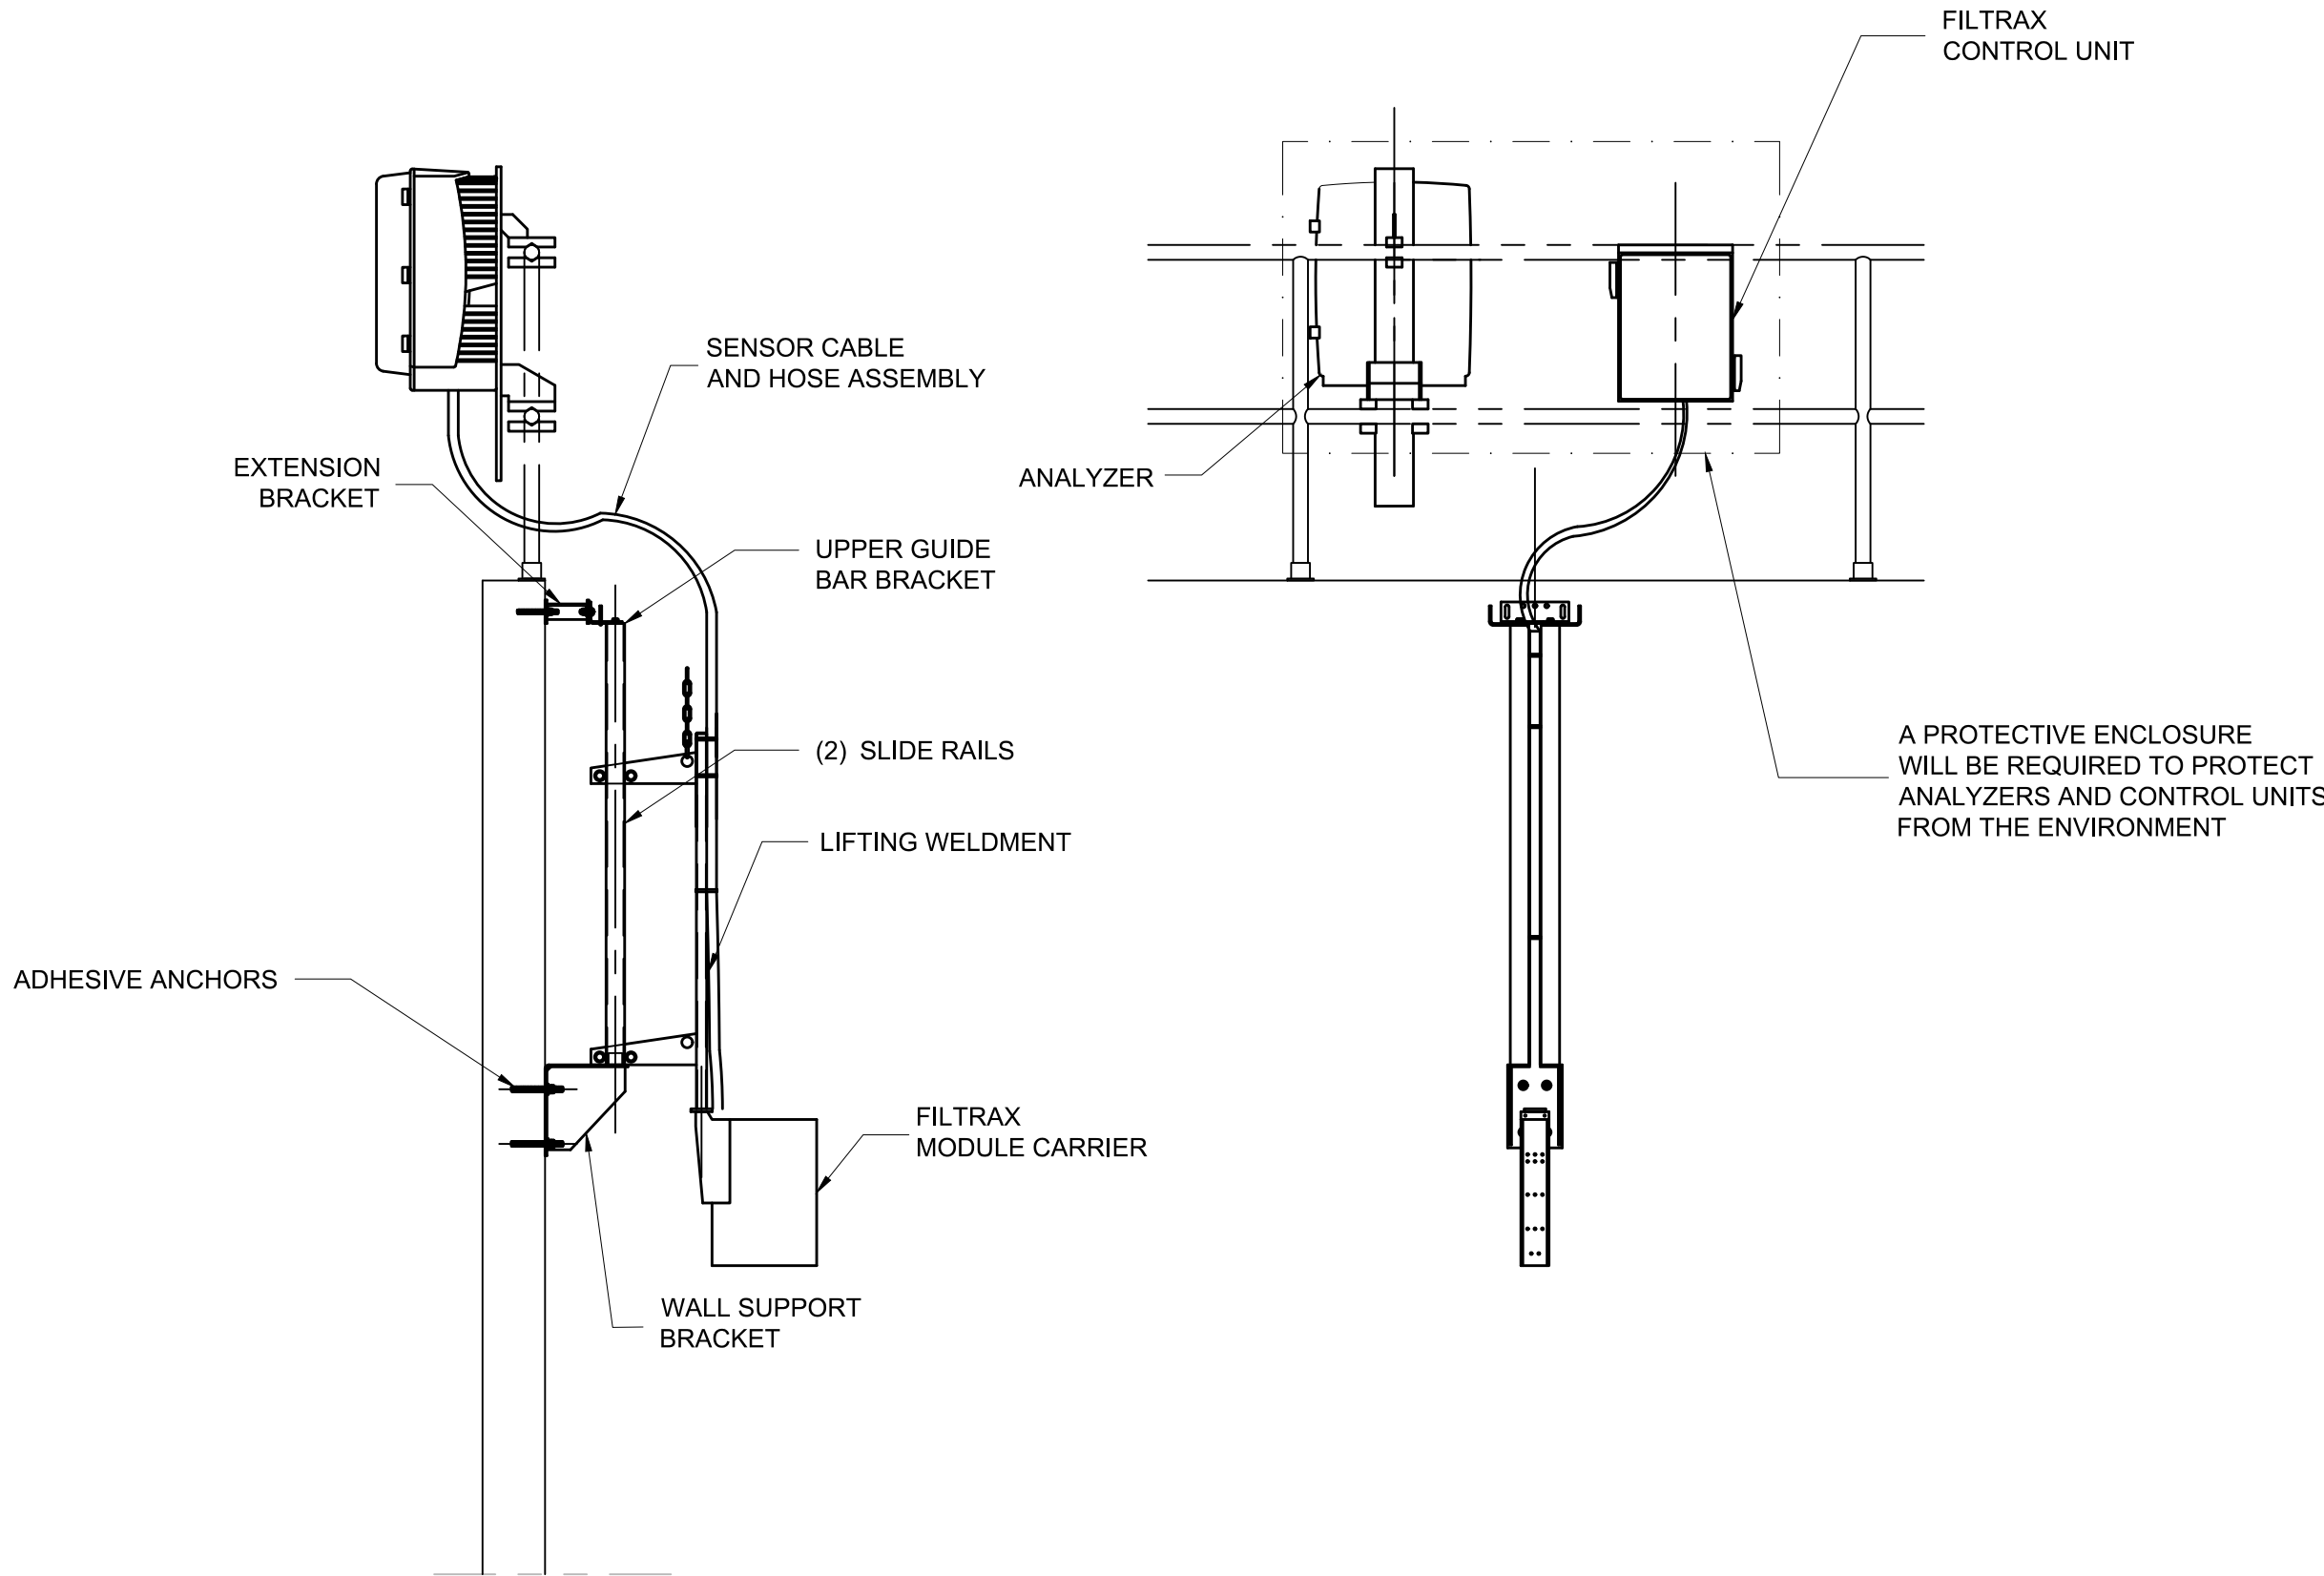

Q AGS REACTOR FILTRAX
NO SCALE

- NOTES:
- THIS DETAIL IS PROVIDED FOR REFERENCE ONLY BY THE AGS SYSTEM SUPPLIER IDENTIFIED IN THE BASE BID (TYPE III) MATERIAL AND EQUIPMENT SCHEDULE. FINAL INSTALLATION DETAILS ARE TO BE COORDINATED BY THE CONTRACTOR BASED ON THE ACTUAL EQUIPMENT SUPPLIED AND AGS SYSTEM SUPPLIER SUBMITTAL PACKAGE.

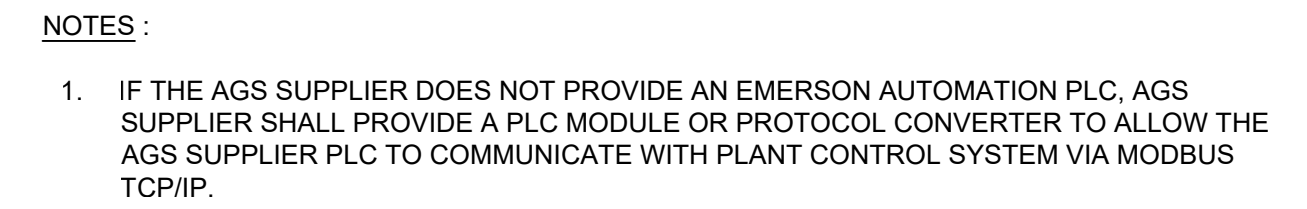

Four Rivers
Sanitation Authority

REVISIONS AND RECORD OF ISSUE	
DESIGNED:	MJP
DETAILED:	DHH
CHECKED:	SAY
APPROVED:	MJP
DATE:	12/20/2022
PROJECT NO.:	411752

163
OF
163